Form 3160-4

# UNITED STATES

FORM APPROVED

(August 2007)			DEPAR' BUREAU							UC,	D Ar	tesia				004-0137		
	WELL C	OMPLE							RT	AND LO	G			ase Serial N MLC06592				
la. Type of	_	Oil Well	☑ Gas \				Ot						6. If	Indian, Allo	ottee or	r Tribe Na	ame	=
b. Type of	Completion	☑ Ne Other		□ Wo	rk Ove	er [	Dee	epen [	Plug	Back [	) Diff. R	esvr.	·7. Ur N	nit or CA A MNM1387	greem	ent Name	and No.	_
2. Name of COG OF	Operator PERATING	LLC	E	-Mail: a				IANDA AV	'ERY					ase Name a			AL COM	—- 707Н
3. Address	600 W ILL MIDLAND							3a. Pho Ph: 57		. (include ar 3-6940	ea code)		9. Al	PI Well No.		15-45164	1-00-S1	<del></del> .
4. Location	of Well (Rep Sec 33	T26S R2	9E Mer NN	ИP				_	nents)	*			10. F	ield and Po URPLE SA	ol, or l AGE-V	Explorato VOLFCA	iry MP (GA	(S)
At top pr	ce Lot 9.2 rod interval r		1FWL 32.0 Sec low Lot 9	33 T26	S R2	9E Me	r NMI	Р	at. 10	3.995580 V	V Lon		11. S	lec., T., R., r Area Sec	M., or c 33 T	Block an 26S R29	d Survey E Mer N	1MP
At total of	Sec	28 T26S	R29E Mer NL 968FW	NMP										County or Pa	arish	13. S	State IM	
14. Date Sp 10/31/20				ate T.D. /09/201		hed			D&.	Completed A <b>⊠</b> Re 2/2019	ady to Pi	rod.	17. E	Elevations (1 286	DF, KI 33 GL	B, RT, GI	_)*	
18. Total De	epth:	MD TVD	17175 10050		19.	Plug Ba	ack T.		ID VD	1699 1005		20. Dep	oth Brid	dge Plug Se			17093 10050	_
21. Type El	ectric & Oth	er Mechan	ical Logs R	un (Sub	mit co	opy of e	ach)			22		vell cored OST run? tional Sur		🔯 No	☐ Yes	s (Submit	analysis) analysis) analysis)	)
3. Casing an	d Liner Reco	ord (Repor	t all strings				· .									Т		_
Hole Size	Size/Gi	rade	Wt. (#/ft.)	To (M)	-	Botte (MI		Stage Cerr Depth		No. of S Type of C		Slurry (BB		Cement ?	Гор*	Amoi	unt Pulled	đ
14.750		750 L80	45.5		0		590				750	<del> </del>			0	<del>†                                     </del>		_
9.875	<del> </del>	625 L80	29.7		0	1	9322		2707		2594				0	<del></del>		
6.750	5.50	00 P110	23.0		0	1	7165				1583	<del> </del>			0			
																		_
24. Tubing	Dagged			<u></u>		<u> </u>				<u></u>				<u> </u>				
	Depth Set (M	ID) Pa	cker Depth	(MD)	Si	ze	Depth	1 Set (MD)	P	acker Depth	(MD)	Size	De	pth Set (Ml	D)	Packer D	Depth (MI	 D)
2.875	(	9385		9375														
25. Producir	ng Intervals						26.	Perforation	Reco	rd		,						
	rmation		Тор		Во	ttom	<u> </u>	Perfo		Interval		Size	1	No. Holes		Perf. S	tatus	
A) B)	WOLFC	AMP	1	0117		17004	+-		1	0117 TO 1	7004		+	1248	OPE	N		· ——
C)				- 1							`		<u> </u>					
<u>)                                    </u>																		
	acture, Treat	<del></del>	ent Squeeze	e, Etc.								fatania1		N.	M O	IL CO	NSER	WATI
1	Depth Interva		04 SEE AT	TACHE	D				Ai	nount and T	ype of M	ateriai					A DISTR	
																SEP	2 3 20	110
																		<u>~\</u> h
28 Producti	ion - Interval	A	!													QF(	EIVE	
ate First	Test	Hours	Test	Oil		Gas		Vater	Oil Gr		Gas		Product	ion Method	<del>.,:</del>	7 Nove 644	Marie C. Danie	<u> </u>
roduced 05/22/2019	Date 05/22/2019	Tested 24	Production	BBL 308	1	MCF 2650.		3BL 2642.0	Corr.	API	Gravity	<b>'</b>			GAS L	_IFT		
hoke	Tbg. Press.	Csg.	24 Hr.	Oil	寸	Gas	V	Vater	Gas:O	il	Well S	tus or	, E.D.	דבח בי			וחמו	
	Flwg. 2700 SI	Press. 2800.0	Rate	BBL 308		MCF 2650		3642 2642	Ratio		P	┟╬╙┞	,CT	TED F	UN	וובטנ	עטן	
	tion - Interva	1 B	<u> </u>															_
Date First Produced	Test Date	Hours Tested	Test Production	Ģil BBL		Gas MCF		Vater BBL	Oil Gr Corr.		Gas Gravity	,	Product	EP -	1 29	)19	4	
	Tbg. Press. Flwg.	Csg. Press.	24 Hr. Rate	Oil BBL		Gas MCF		Vater BBL	Gas:O Ratio	îl	Well St	1 1	NL	uch	9t	laric	et	<u>→</u>
	****5	. 1000.					12		1		1	I ₽/	SPA I	OF LAND	RARRI	MACUE	AIT I	

(See Instructions and spaces for additional data on reverse side)
ELECTRONIC SUBMISSION #470384 VERIFIED BY THE BLM WELL INFORMATION SYSTEM

\*\* BLM REVISED \*\* BLM REVISED \*\* BLM REVISED \*\* BLM REVISED \*\*

BUREAU OF LAND MANAGEMENT

Produced   Date   Tested   Production   BBL   MCF   BBL   Cerr AFI   Gravity	•
Size   Fiving   Free   Fixe   Fact	
Sicentified   Production   Interval D   Duse First   Test   Hours   Test   Production   BBL   MCF   BBL   Corr. AFI   Gravity   Gas   Production   Method   Gravity   Corr. AFI   Gravity   Gas   Production   Method   Gas	
Date   Test   Production   Date   Tested   Production   BBL   Discovery   Date   Discovery   Date   Discovery   Date   Discovery   Date   Discovery   Date   Discovery   Date	
Producted   Date   Tested   Production   BBL   MCF   BBL   Corr. API   Gravity	
Size Five Five Press. Rate BBL MCF BBL Fairo.  29. Disposition of Gas(Sold, used for fuel, vented, etc.)  SOLD  30. Summary of Porous Zones (Include Aquifers): Show all important zones of porosity and contents thereof: Cored intervals and all drill-stem tests, including depth interval tested, cushion used, time tool open, flowing and shut-in pressures and recoveries.  Formation Top Bottom Descriptions, Contents, etc. Name  LAMAR BELL CANYON 2763 CHERRY CANYON 3631 BRUSHY CANYON 4916 BONE SPRING LIME 6466 BONE SPRING IST 7380 BONE SPRING SND 8196 BONE SPRING SND 9247  32. Additional remarks (include plugging procedure): WOLFCAMP 9597  33. Circle enclosed attachments:  1. Electrical/Mechanical Logs (I full set req'd.)  2. Geologic Report 3. DST Report 4	
Size Five Five Press. Rate BBL MCF BBL Fairo.  29. Disposition of Gas(Sold, used for fuel, vented, etc.)  SOLD  30. Summary of Porous Zones (Include Aquifers): Show all important zones of porosity and contents thereof: Cored intervals and all drill-stem tests, including depth interval tested, cushion used, time tool open, flowing and shut-in pressures and recoveries.  Formation Top Bottom Descriptions, Contents, etc. Name  LAMAR BELL CANYON 2763 CHERRY CANYON 3631 BRUSHY CANYON 4916 BONE SPRING LIME 6466 BONE SPRING IST 7380 BONE SPRING SND 8196 BONE SPRING SND 9247  32. Additional remarks (include plugging procedure): WOLFCAMP 9597  33. Circle enclosed attachments:  1. Electrical/Mechanical Logs (I full set req'd.)  2. Geologic Report 3. DST Report 4	
SoLD  30. Summary of Porous Zones (Include Aquifers): Show all important zones of porosity and contents thereof: Cored intervals and all drill-stem tests, including depth interval tested, cushion used, time tool open, flowing and shut-in pressures and recoveries.  Formation  Top Bottom Descriptions, Contents, etc. Name  LAMAR BELL CANYON 2763 BELL CANYON 3631 BELL CANYON 3631 BELL CANYON BRUSHY CANYON 4916 BONE SPRING LIME BONE SPRING LIME BONE SPRING SPRING 1ST 7380 BONE SPRING 2ND BONE SPRING 3RD  32. Additional remarks (include plugging procedure): WOLFCAMP 9597  33. Circle enclosed attachments:  1. Electrical/Mechanical Logs (1 full set req'd.) 2. Geologic Report 3. DST Report 4	
30. Summary of Porous Zones (Include Aquifers): Show all important zones of porosity and contents thereof: Cored intervals and all drill-stem tests, including depth interval tested, cushion used, time tool open, flowing and shut-in pressures and recoveries.  Formation  Top Bottom Descriptions, Contents, etc.  Name  LAMAR BELL CANYON 2763 CHERRY CANYON 3631 BRUSHY CANYON BONE SPRING LIME 6466 BONE SPRING LIME BONE SPRING IST T380 BONE SPRING SND BONE SPRING S	
tests, including depth interval tested, cushion used, time tool open, flowing and shut-in pressures and recoveries.  Formation Top Bottom Descriptions, Contents, etc. Name  LAMAR BELL CANYON 2763 BELL CANYON 3631 BELL CANYON 3631 BOLL SPRING 18T BONE SPRING LIME 6466 BONE SPRING LIME BONE SPRING LIME BONE SPRING LIME BONE SPRING BONE SPRING SP	<u> </u>
LAMAR BELL CANYON 2763 CHERRY CANYON 3631 BRUSHY CANYON 4916 BONE SPRING LIME 6466 BONE SPRING 1ST 7380 BONE SPRING 2ND 8196 BONE SPRING 3RD 9247  32. Additional remarks (include plugging procedure): WOLFCAMP 9597  33. Circle enclosed attachments:  1. Electrical/Mechanical Logs (I full set req'd.)  2. Geologic Report 3. DST Report 4	
LAMAR BELL CANYON 2763 CHERRY CANYON 3631 BRUSHY CANYON 4916 BONE SPRING LIME 6466 BONE SPRING 1ST 7380 BONE SPRING 2ND 8196 BONE SPRING 3RD 9247  32. Additional remarks (include plugging procedure): WOLFCAMP 9597  33. Circle enclosed attachments:  1. Electrical/Mechanical Logs (I full set req'd.)  2. Geologic Report 3. DST Report 4	Тор
BELL CANYON CHERRY CANYON 3631 BRUSHY CANYON BONE SPRING LIME BONE SPRING STD BONE SPRING STD BONE SPRING 3RD  32. Additional remarks (include plugging procedure): WOLFCAMP 9597  33. Circle enclosed attachments:  1. Electrical/Mechanical Logs (1 full set req'd.)  2. Geologic Report 3. DST Report 4	Meas. Deptl
CHERRY CANYON BRUSHY CANYON BRUSHY CANYON BONE SPRING LIME BONE SPRING ST BONE SPRING ST BONE SPRING 3RD BONE SPRING 3RD  32. Additional remarks (include plugging procedure): WOLFCAMP  33. Circle enclosed attachments:  1. Electrical/Mechanical Logs (1 full set req'd.)  2. Geologic Report  3. DST Report  4	2703 2763
BONE SPRING LIME BONE SPRING 1ST 7380 BONE SPRING 2ND BONE SPRING 3RD  32. Additional remarks (include plugging procedure): WOLFCAMP 9597  33. Circle enclosed attachments:  1. Electrical/Mechanical Logs (1 full set req'd.) 2. Geologic Report 3. DST Report 4	3631 4916
BÔNE SPRING 2ND BONE SPRING 3RD  8196 9247  8196 9247  80NE SPRING 3RD  80NE SPRING 2ND 80NE SPRING 3RD  32. Additional remarks (include plugging procedure): WOLFCAMP 9597  33. Circle enclosed attachments: 1. Electrical/Mechanical Logs (I full set req'd.) 2. Geologic Report 3. DST Report 4	6466
32. Additional remarks (include plugging procedure): WOLFCAMP 9597  33. Circle enclosed attachments: 1. Electrical/Mechanical Logs (1 full set req'd.) 2. Geologic Report 3. DST Report 4	7380 8196
WOLFCAMP 9597  33. Circle enclosed attachments:  1. Electrical/Mechanical Logs (1 full set req'd.)  2. Geologic Report  3. DST Report  4	9247
WOLFCAMP 9597  33. Circle enclosed attachments:  1. Electrical/Mechanical Logs (1 full set req'd.)  2. Geologic Report  3. DST Report  4	
WOLFCAMP 9597  33. Circle enclosed attachments:  1. Electrical/Mechanical Logs (1 full set req'd.)  2. Geologic Report  3. DST Report  4	
WOLFCAMP 9597  33. Circle enclosed attachments:  1. Electrical/Mechanical Logs (1 full set req'd.)  2. Geologic Report  3. DST Report  4	
WOLFCAMP 9597  33. Circle enclosed attachments:  1. Electrical/Mechanical Logs (1 full set req'd.)  2. Geologic Report  3. DST Report  4	
WOLFCAMP 9597  33. Circle enclosed attachments:  1. Electrical/Mechanical Logs (1 full set req'd.)  2. Geologic Report  3. DST Report  4	'
WOLFCAMP 9597  33. Circle enclosed attachments:  1. Electrical/Mechanical Logs (1 full set req'd.)  2. Geologic Report  3. DST Report  4	
E. Coro Anglicia de Maria de Maria and coment continutor 6. Coro Anglicia 7. Other	. Directional Survey
5. Sundry Notice for plugging and cement verification 6. Core Analysis 7 Other:	
34. I hereby certify that the foregoing and attached information is complete and correct as determined from all available records (see attached	d instructions):
Electronic Submission #470384 Verified by the BLM Well Information System.	,
For COG OPERATING LLC, sent to the Carlsbad Committed to AFMSS for processing by DEBORAH HAM on 07/02/2019 (19DMH0083SE)	
Name (please print) AMANDA AVERY  Title AUTHORIZED REPRESENTATIVE	
u /	
Signature (Electronic Submission) Date 06/24/2019	
Title 18 U.S.C. Section 1001 and Title 43 U.S.C. Section 1212, make it a crime for any person knowingly and willfully to make to any depart	

State of New Mexico DISTRICT I
1625 N. FRENCH DR., HOBBS, NM 88240
Phone: (675) 393-6161 Fax: (576) 393-0720

Energy, Minerals & Natural Resources Department OIL CONSERVATION DIVISION

1220 SOUTH ST. FRANCIS DR. Santa Fe, New Mexico 87505

Form C-102 Revised August 1, 2011 Submit one copy to appropriate District Office

DISTRICT III 1000 RIO BRAZOS RD., AZTEC, NM 87410 Phone: (505) 334-6178 Fax: (505) 334-6170

DISTRICT IV 1220 S. ST. FRANCIS DR., SANTA FE, NM 87505 Phone: (505) 476-3460 Fax: (505) 476-3462

□ AMENDED REPORT

WELL:	LOCATION	AND	ACREAGE	DEDICATION	PLAT

		HELD BOOMMICH HAVE HOLDEN	
	API Number	Pool Code	Pool Name
30-015-45164		98220	Purple Sage; Wolfcamp (Gas)
	Property Code	Property Name	Well Number
	322243	LITTLEFIELD 33 FEDERAL CO	<b>DM</b> 707H
·	OGRID No.	Operator Name	Elevation
	229137	COG OPERATING, LLC	2863.4'

### Surface Location

UL or lot No.	Section	Township	Range	Lot Idn	Feet from the	North/South line	Feet from the	East/West line	County
9	33	26-S	29-E		250 .	SOUTH	811	WEST	EDDY

## Bottom Hole Location If Different From Surface


UL or lot No.	Section	Township	Range	Lot ldn	Feet from the	North/South line	Feet from the	East/West line	County
D -,	28	26-S	29-E		210.	NORTH	968	WEST	EDDY
Dedicated Acres	Joint o	r Infill (	Consolidation	Code Or	der No.				

NO ALLOWABLE WILL BE ASSIGNED TO THIS COMPLETION UNTIL ALL INTERESTS HAVE BEEN CONSOLIDATED OR A NON-STANDARD UNIT HAS BEEN APPROVED BY THE DIVISION

SEE PAGE 2 PAGE 1 OF 2 W.O. #19-992

Property Code	Property Name	Well Number
322243	LITTLEFIELD 33 FEDERAL COM	707H ·
OGRID No.	Operator Name	Elevation
229137	COG OPERATING, LLC	2863.4

NAD 83 NME BOTTOM HOLE LOCATION Y=371389.6 N X=646259.4 E LAT.=32.0020578° N LONG.=103.994788° W

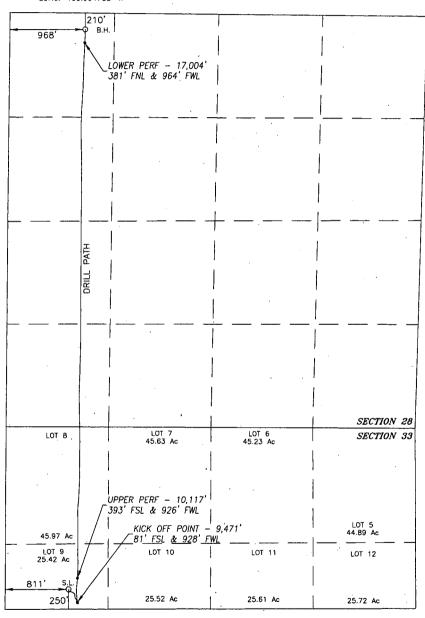

NAD 83 NME SURFACE LOCATION Y=364195.2 N X=646036.3 E LAT.=32.000803' N LONG.=103.995580° W BOREPATH SHOWN HEREON IS BASED ON DIRECTIONAL SURVEY REPORT PROVIDED BY COG OPERATING, LLC FOR THE LITTLEFIELD 33 FEDERAL COM #707H SUPPLIED TO HARCROW SURVEYING, LLC ON MAY 23, 2019

1200 1200 0 SCALE: 1"=1200'

## OPERATOR CERTIFICATION

OPERATOR CERTIFICATION

I hereby certify that the information
herein is true and complete to the best of
my knowledge and belief, and that this
organization either owns a working interest
or unleased mineral interest in the land
including the proposed bottom hole location
or has a right to drill this well at this
location pursuant to a contract with an
owner of such mineral or working interest,
or to a voluntary pooling agreement or a
compulsory pooling order heretofore entered
by the division.

6/24/19

Signature

Date

Amanda Avery

Printed Name

aavery@concho.com

E-mail Address

#### SURVEYOR CERTIFICATION

I hereby certify that the well location shown on this plat was plotted from field notes of actual surveys made by me or under my supervision, and that the same is true and correct to the best of my belief.

SEPT. 12, 2018/DEC. 26, 2018

Date of Survey/Date of Geographic Survey

Signature & Seal of Professional Surveyor



PAGE 2 OF 2

W.O. #19-992

DRAWN BY: WN