

UNITED STATES  
DEPARTMENT OF THE INTERIOR  
BUREAU OF LAND MANAGEMENT

FORM APPROVED  
OMB No. 1004-0137  
Expires: January 31, 2018

**SUNDRY NOTICES AND REPORTS ON WELLS**  
**Do not use this form for proposals to drill or to re-enter an abandoned well. Use Form 3160-3 (APD) for such proposals.**

5. Lease Serial No.  
NMNM 109386 & NMNM 117562

6. If Indian, Allottee or Tribe Name

N/A

**SUBMIT IN TRIPLICATE - Other instructions on page 2**

1. Type of Well

☒ Oil Well ☐ Gas Well ☐ Other

2. Name of Operator

Encana Oil & Gas (USA) Inc.

3a. Address

370 17th Street, Suite 1700  
Denver, CO 80202

3b. Phone No. (include area code)

(720) 876-3533

7. If Unit of CA/Agreement, Name and/or No.  
NMNM 135367X

8. Well Name and No.

VCU 103H FKA Lybrook P03-2206 02H

9. API Well No.

30-043-21220

10. Field and Pool or Exploratory Area

Lybrook Gallup

4. Location of Well (Footage, Sec., T., R., M., or Survey Description)

SHL: 439' FSL, 1192' FEL Section 3, Township 22N, Range 6W  
BHL: 2344' FNL, 753' FEL Section 15, Township 22N, Range 6W

11. Country or Parish, State

Sandoval County, NM

**12. CHECK THE APPROPRIATE BOX(ES) TO INDICATE NATURE OF NOTICE, REPORT OR OTHER DATA**

TYPE OF SUBMISSION	TYPE OF ACTION			
<input checked="" type="checkbox"/> Notice of Intent	<input type="checkbox"/> Acidize	<input type="checkbox"/> Deepen	<input type="checkbox"/> Production (Start/Resume)	<input type="checkbox"/> Water Shut-Off
<input type="checkbox"/> Subsequent Report	<input type="checkbox"/> Alter Casing	<input type="checkbox"/> Hydraulic Fracturing	<input type="checkbox"/> Reclamation	<input type="checkbox"/> Well Integrity
<input type="checkbox"/> Final Abandonment Notice	<input type="checkbox"/> Casing Repair	<input type="checkbox"/> New Construction	<input type="checkbox"/> Recomplete	<input checked="" type="checkbox"/> Other
	<input type="checkbox"/> Change Plans	<input type="checkbox"/> Plug and Abandon	<input type="checkbox"/> Temporarily Abandon	Well Name Change
	<input type="checkbox"/> Convert to Injection	<input type="checkbox"/> Plug Back	<input type="checkbox"/> Water Disposal	

13. Describe Proposed or Completed Operation: Clearly state all pertinent details, including estimated starting date of any proposed work and approximate duration thereof. If the proposal is to deepen directionally or recompleat horizontally, give subsurface locations and measured and true vertical depths of all pertinent markers and zones. Attach the Bond under which the work will be performed or provide the Bond No. on file with BLM/BIA. Required subsequent reports must be filed within 30 days following completion of the involved operations. If the operation results in a multiple completion or recompleat in a new interval, a Form 3160-4 must be filed once testing has been completed. Final Abandonment Notices must be filed only after all requirements, including reclamation, have been completed and the operator has determined that the site is ready for final inspection.)

Encana Oil & Gas (USA) Inc. (Encana) recently received approval for the formation of a 4,320 acre Federal exploratory unit named the Venado Canyon Unit, effective November 1, 2014. The Lybrook P03-2206 02H will be included within the boundaries of this unit. Therefore, Encana is requesting that the name be changed from Lybrook P03-2206 02H to VCU 103H. An updated As-Drilled plat is attached with this sundry.

OIL CONS. DIV DIST. 3

APR 01 2016

**BLM'S APPROVAL OR ACCEPTANCE OF THIS ACTION DOES NOT RELIEVE THE LESSEE AND OPERATOR FROM OBTAINING ANY OTHER AUTHORIZATION REQUIRED FOR OPERATIONS ON FEDERAL AND INDIAN LANDS**

14. I hereby certify that the foregoing is true and correct. Name (Printed/Typed)

Katie Wegner

Title Regulatory Analyst

Signature

Date

03/22/2016

**THE SPACE FOR FEDERAL OR STATE OFFICE USE**

Approved by

William Tambekou

Title

Petroleum Engineer

Date

03/29/2016

Conditions of approval, if any, are attached. Approval of this notice does not warrant or certify that the applicant holds legal or equitable title to those rights in the subject lease which would entitle the applicant to conduct operations thereon.

Office

FFD

Title 18 U.S.C Section 1001 and Title 43 U.S.C Section 1212, make it a crime for any person knowingly and willfully to make to any department or agency of the United States any false, fictitious or fraudulent statements or representations as to any matter within its jurisdiction.

(Instructions on page 2)

NMOCDV



DISTRICT I  
1625 N. French Dr., Hobbs, N.M. 88240  
Phone: (505) 393-6161 Fax: (505) 393-0720

DISTRICT II  
811 S. First St., Artesia, N.M. 88210  
Phone: (505) 746-1283 Fax: (505) 746-9720

DISTRICT III  
1000 Rio Bravo Rd., Aztec, N.M. 87410  
Phone: (505) 334-6178 Fax: (505) 334-6170

DISTRICT IV  
1220 S. St. Francis Dr., Santa Fe, NM 87505  
Phone: (505) 476-3460 Fax: (505) 476-3462

State of New Mexico  
Energy, Minerals & Natural Resources Department

Form C-102  
Revised August 1, 2011

Submit one copy to appropriate  
District Office

OIL CONSERVATION DIVISION  
1220 South St. Francis Dr.  
Santa Fe, NM 87505

☐ AMENDED REPORT  
☒ AS-DRILLED

WELL LOCATION AND ACREAGE DEDICATION PLAT

1 API Number 30-043-21220		2 Pool Code 42289		3 Pool Name LYBROOK GALLUP	
4 Property Code 316075		5 Property Name VCU		6 Well Number 103H	
7 OGRID No. 282327		8 Operator Name ENCANA OIL & GAS (USA) INC.		9 Elevation 7124.1'	

10 Surface Location

UL or lot no.	Section	Township	Range	Lot Idn	Feet from the	North/South line	Feet from the	WEST/West line	County
P	3	22N	6W		439'	SOUTH	1192'	EAST	SANDOVAL

11 Bottom Hole Location If Different From Surface

UL or lot no.	Section	Township	Range	Lot Idn	Feet from the	North/South line	Feet from the	WEST/West line	County
H	15	22N	6W		2344'	NORTH	753'	EAST	SANDOVAL

12 Dedicated Acres UNDIVIDED UNIT - 4320 ACRES - ALL SEC 11-14; S2 & NE4 SEC 10; N2 & SW4 SEC 15; W2 SEC 23; NE4 SEC 24, T22N, R6W, PENETRATED UNITS. E2E2 SEC 10 & E2NE4 SEC 15 (240 ACRES)		13 Joint or Infill		14 Consolidation Code		15 Order No. R-14067 (4,320 ACRES)	
--	--	--------------------	--	-----------------------	--	---------------------------------------	--

NO ALLOWABLE WILL BE ASSIGNED TO THIS COMPLETION UNTIL ALL INTERESTS HAVE BEEN CONSOLIDATED  
OR A NON-STANDARD UNIT HAS BEEN APPROVED BY THE DIVISION

16

1 LAT. 36.160110° N (NAD83)  
LONG. 107.464533° W (NAD83)  
LAT. 36.160095° N (NAD27)  
LONG. 107.464533° W (NAD27)

2 LAT. 36.145423° N (NAD83)  
LONG. 107.464846° W (NAD83)  
LAT. 36.145408° N (NAD27)  
LONG. 107.464242° W (NAD27)

3 LAT. 36.138078° N (NAD83)  
LONG. 107.465026° W (NAD83)  
LAT. 36.138063° N (NAD27)  
LONG. 107.464422° W (NAD27)

4 LAT. 36.159800° N (NAD83)  
LONG. 107.446799° W (NAD83)  
LAT. 36.159785° N (NAD27)  
LONG. 107.446195° W (NAD27)


5 LAT. 36.145101° N (NAD83)  
LONG. 107.447099° W (NAD83)  
LAT. 36.145086° N (NAD27)  
LONG. 107.446495° W (NAD27)

6 LAT. 36.137751° N (NAD83)  
LONG. 107.447260° W (NAD83)  
LAT. 36.137736° N (NAD27)  
LONG. 107.446656° W (NAD27)

AB-WELL FLAG  
LAT. 36.161076° N (NAD83)  
LONG. 107.450817° W (NAD83)  
LAT. 36.161061° N (NAD27)  
LONG. 107.450213° W (NAD27)

AB-ENTRY POINT  
LAT. 36.158884° N (NAD83)  
LONG. 107.449356° W (NAD83)  
LAT. 36.158869° N (NAD27)  
LONG. 107.448752° W (NAD27)

AB-BOTTOM HOLE  
LAT. 36.138713° N (NAD83)  
LONG. 107.449787° W (NAD83)  
LAT. 36.138698° N (NAD27)  
LONG. 107.449183° W (NAD27)

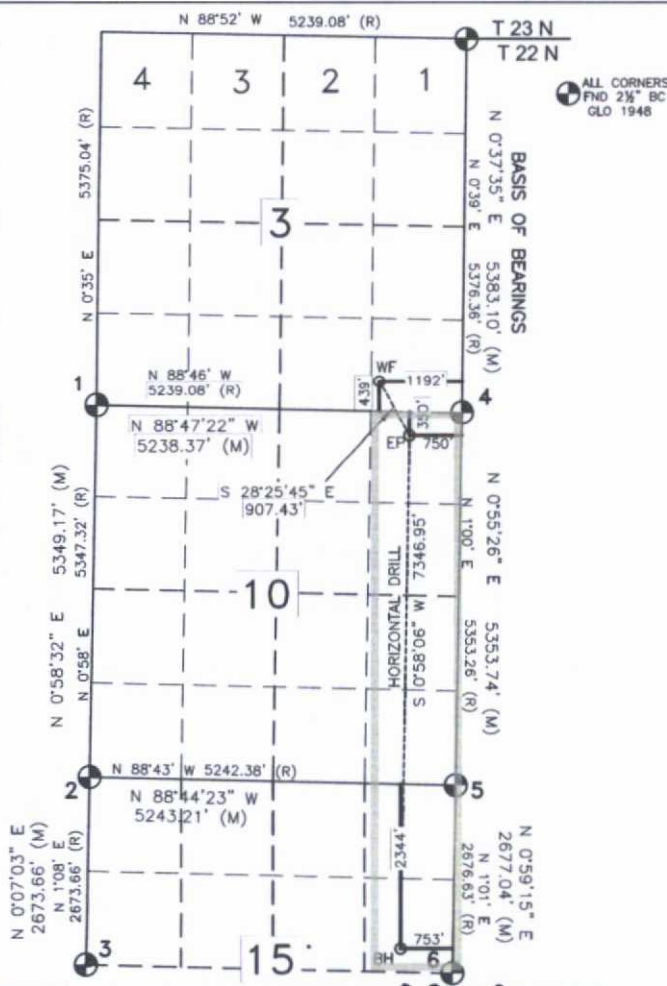

17 OPERATOR CERTIFICATION

I hereby certify that the information contained herein is true and complete to the best of my knowledge and belief, and that this organization either owns a working interest or unleased mineral interest in the land including the proposed bottom hole location or has a right to drill this well at this location pursuant to a contract with an owner of such a mineral or working interest, or to a voluntary pooling agreement or a compulsory pooling order heretofore entered by the division.

*Katie Wegner* 03/22/16  
Signature Date

Katie Wegner  
Printed Name  
katie.wegner@encana.com  
E-mail Address


SURVEYOR CERTIFICATION

I hereby certify that the well location shown on this plat was plotted from field notes of actual surveys made by me or under my supervision, and that the same is true and correct to the best of my belief.

DATE OF ASBUILT SURVEY - DECEMBER 30, 2014  
DATE OF SURVEY - SEPTEMBER 9, 2013

Date of Survey

Signature and Seal of Professional Surveyor:

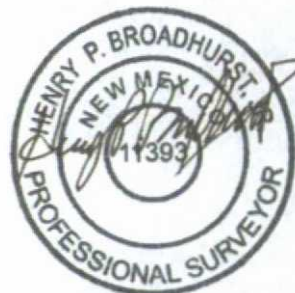

NMOC Effective date of change 10-29-15 per order R-14067

**DISTRICT I**

1625 N. French Dr., Hobbs, N.M. 88240  
Phone: (575) 393-6181 Fax: (575) 393-0720

**DISTRICT II**

811 S. First St., Artesia, N.M. 88210  
Phone: (575) 748-1283 Fax: (575) 748-0720

**DISTRICT III**

1000 Rio Branos Rd., Aztec, N.M. 87410  
Phone: (505) 334-6178 Fax: (505) 334-6170

**DISTRICT IV**

1220 S. St. Francis Dr., Santa Fe, NM 87505  
Phone: (505) 476-3460 Fax: (505) 476-3462

State of New Mexico  
Energy, Minerals & Natural Resources Department

**OIL CONSERVATION DIVISION**

1220 South St. Francis Dr.  
Santa Fe, NM 87505

ENCANA OIL & GAS (USA) INC.  
VENADO CANYON 103H

Form C-102  
Revised August 1, 2011

Submit one copy to appropriate  
District Office

☐ AMENDED REPORT  
☒ AS-DRILLED

