

RECEIVED

JUL 03 2017

Form 3160-5  
(June 2015)UNITED STATES  
DEPARTMENT OF THE INTERIOR  
BUREAU OF LAND MANAGEMENTFarmington Field Office  
Bureau of Land ManagementFORM APPROVED  
OMB No. 1004-0137  
Expires: January 31, 2018**SUNDRY NOTICES AND REPORTS ON WELLS**  
**Do not use this form for proposals to drill or to re-enter an abandoned well. Use Form 3160-3 (APD) for such proposals.**5. Lease Serial No.  
NMNM 16760 & NMNM 36473  
6. If Indian, Allottee or Tribe Name  
N/A**SUBMIT IN TRIPLICATE - Other instructions on page 2**

1. Type of Well

☒ Oil Well ☐ Gas Well ☐ Other

2. Name of Operator

Encana Oil &amp; Gas (USA) Inc.

3a. Address

370 17th Street, Suite 1700  
Denver, CO 80202

3b. Phone No. (include area code)

(720) 876-3533

4. Location of Well (Footage, Sec., T., R., M., or Survey Description)

SHL: 1730' FSL and 310' FWL Sec 17, T24N, R9W  
BHL: 2196' FSL and 337' FWL Sec 18, T24N, R9W

7. If Unit of CA/Agreement, Name and/or No.

NMNM 136924X

8. Well Name and No.

Good Times Unit 301H (fka Escrito L17-2409 01H)

9. API Well No.

30-045-35487

10. Field and Pool or Exploratory Area

Good Times; Mancos (oil)

11. Country or Parish, State

San Juan County, NM

**12. CHECK THE APPROPRIATE BOX(ES) TO INDICATE NATURE OF NOTICE, REPORT OR OTHER DATA**

## TYPE OF SUBMISSION

## TYPE OF ACTION

☒ Notice of Intent☐ Subsequent Report☐ Final Abandonment Notice☐ Acidize☐ Alter Casing☐ Casing Repair☐ Change Plans☐ Convert to Injection☐ Deepen☐ Hydraulic Fracturing☐ New Construction☐ Plug and Abandon☐ Plug Back☐ Production (Start/Resume)☐ Reclamation☐ Recomplete☐ Temporarily Abandon☐ Water Disposal☐ Water Shut-Off☐ Well Integrity☒ Other - Name Change

13. Describe Proposed or Completed Operation: Clearly state all pertinent details, including estimated starting date of any proposed work and approximate duration thereof. If the proposal is to deepen directionally or recompleat horizontally, give subsurface locations and measured and true vertical depths of all pertinent markers and zones. Attach the Bond under which the work will be performed or provide the Bond No. on file with BLM/BIA. Required subsequent reports must be filed within 30 days following completion of the involved operations. If the operation results in a multiple completion or recompleat in a new interval, a Form 3160-4 must be filed once testing has been completed. Final Abandonment Notices must be filed only after all requirements, including reclamation, have been completed and the operator has determined that the site is ready for final inspection.)

Encana Oil & Gas (USA) Inc. (Encana) recently finalized the formation of a 14,706.50 acre Federal exploratory unit named the Good Times Unit. The Good Times Unit hearing occurred on October 1, 2015 at the New Mexico Oil Conservation Division in Santa Fe, in which, Encana requested an undivided unit be formed that would also encompass its own unique oil pool designation. The unit was approved by the BLM on May 5, 2017 with an effective date of March 1, 2014.

The Escrito L17-2409 01H well, which was approved by the BLM on November 18, 2013, will now be a part of the Good Times Unit. Encana is submitting this sundry to change the well name from the Escrito L17-2409 01H to the Good Times Unit 301H.

OIL CONS. DIV DIST. 3

JUL 21 2017

14. I hereby certify that the foregoing is true and correct. Name (Printed/Typed)

Katie Wegner

Title Senior Regulatory Analyst

Signature



Date

06/30/2017

**THE SPACE FOR FEDERAL OR STATE OFFICE USE**

Approved by



Title

AFM-min

Date

7/5/17

Conditions of approval, if any, are attached. Approval of this notice does not warrant or certify that the applicant holds legal or equitable title to those rights in the subject lease which would entitle the applicant to conduct operations thereon.

Office

BLM-FDO

Title 18 U.S.C Section 1001 and Title 43 U.S.C Section 1212, make it a crime for any person knowingly and willfully to make to any department or agency of the United States any false, fictitious or fraudulent statements or representations as to any matter within its jurisdiction.

(Instructions on page 2)

NMOCD PV

3

## DISTRICT I

1625 N. French Dr., Hobbs, N.M. 88240  
Phone: (575) 393-6161 Fax: (575) 393-0720

## DISTRICT II

811 S. First St., Artesia, N.M. 88210  
Phone: (575) 748-1283 Fax: (575) 748-9720

## DISTRICT III

1000 Rio Brazos Rd., Aztec, N.M. 87410  
Phone: (505) 334-6176 Fax: (505) 334-6170

## DISTRICT IV

1220 S. St. Francis Dr., Santa Fe, NM 87505  
Phone: (505) 476-3460 Fax: (505) 476-3468State of New Mexico  
Energy, Minerals & Natural Resources Department

## OIL CONSERVATION DIVISION

1220 South St. Francis Dr.  
Santa Fe, NM 87505Submit one copy to appropriate  
District Office☐ AMENDED REPORT  
☒ AS-DRILLED

## WELL LOCATION AND ACREAGE DEDICATION PLAT

*API Number 30-045-35487		*Pool Code 98193	*Pool Name GOOD TIMES; MANCOS
*Property Code 40267 319412	*Property Name GOOD TIMES UNIT		*Well Number 301H
*GRID No. 282327	*Operator Name ENCANA OIL & GAS (USA) INC.		*Elevation 6792'

## 10 Surface Location

UL or lot no.	Section	Township	Range	Lot Idn	Feet from the	North/South line	Feet from the	East/West line	County
L	17	24N	9W		1730'	SOUTH	310'	WEST	SAN JUAN


## 11 Bottom Hole Location If Different From Surface

UL or lot no.	Section	Township	Range	Lot Idn	Feet from the	North/South line	Feet from the	East/West line	County
L	18	24N	9W	3	2196'	SOUTH	337'	WEST	SAN JUAN

*Dedicated Acres 319.73 ACRES	PROJECT AREA S/2 SEC. 18	*Joint or Infill	*Consolidation Code	*Order No. R-14094 (14,706.5 acres)
----------------------------------	-----------------------------	------------------	---------------------	--

NO ALLOWABLE WILL BE ASSIGNED TO THIS COMPLETION UNTIL ALL INTERESTS HAVE BEEN CONSOLIDATED  
OR A NON-STANDARD UNIT HAS BEEN APPROVED BY THE DIVISION

16

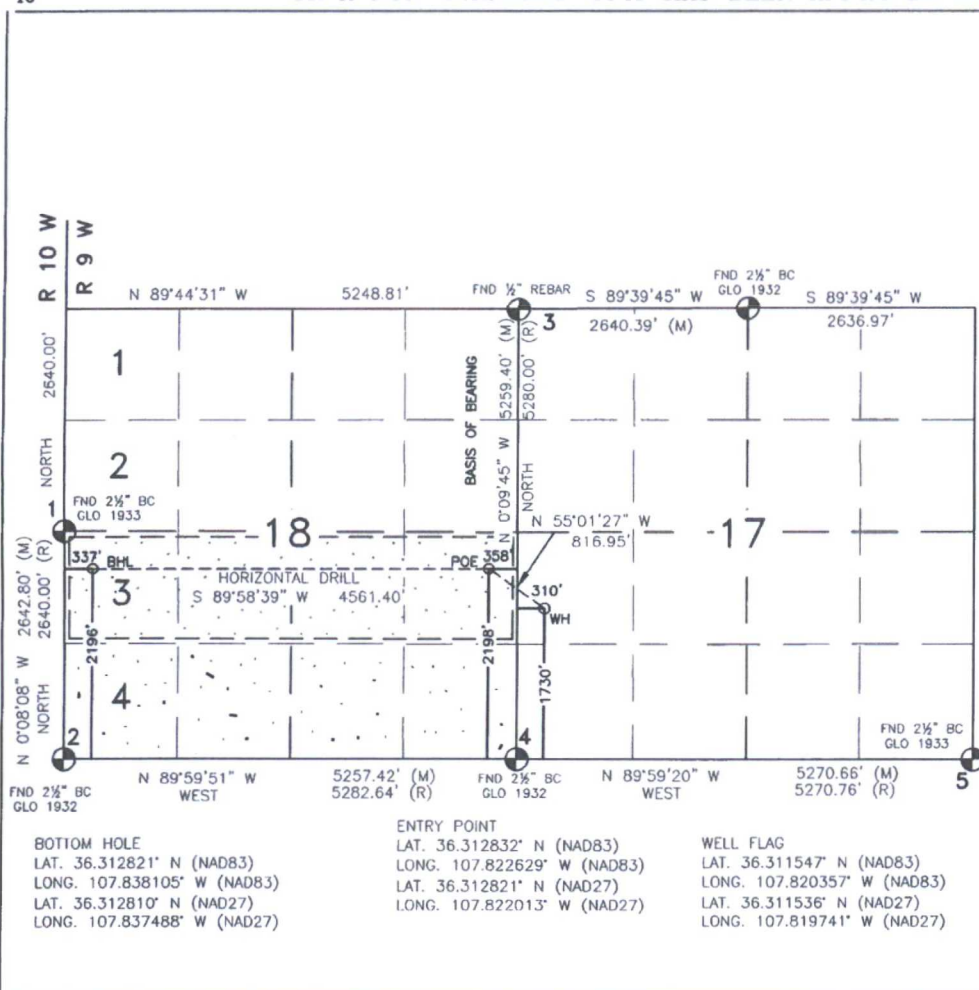

## 17 OPERATOR CERTIFICATION

I hereby certify that the information contained herein is true and complete to the best of my knowledge and belief, and that this organization either owns a working interest or unleased mineral interest in the land including the proposed bottom hole location or has a right to drill this well at this location pursuant to a contract with an owner of such a mineral or working interest, or to a voluntary pooling agreement or a compulsory pooling order heretofore entered by the Division.

*Katie Wegner* 6/30/17  
Signature Date

Katie Wegner  
Printed Name

katie.wegner@encana.com  
E-mail Address

## SURVEYOR CERTIFICATION

I hereby certify that the well location shown on this plat was plotted from field notes of actual surveys made by me or under my supervision, and that the same is true and correct to the best of my belief.

AS-BUILT - APRIL 14, 2014  
SURVEYED - MARCH 15, 2013

Date of Survey

Signature and Seal of Professional Surveyor:

*David Russell*  
DAVID R. RUSSELL  
REGISTERED PROFESSIONAL LAND SURVEYOR  
NEW MEXICO  
10201

DAVID RUSSELL  
Certificate Number 10201



1625 N. French Dr., Hobbs, N.M. 88240  
Phone: (575) 393-8161 Fax: (575) 393-0720

811 S. First St., Artesia, N.M. 88210  
Phone: (575) 748-1283 Fax: (575) 748-9720

1000 Rio Brazos Rd., Artec, N.M. 87410  
Phone: (505) 334-6178 Fax: (505) 334-6170

1220 S. St. Francis Dr., Santa Fe, NM 87505  
Phone: (505) 476-3460 Fax: (505) 476-3462

State of New Mexico  
Energy, Minerals & Natural Resources Department

Form C-102  
Revised August 1, 2011

**Submit one copy to appropriate  
District Office**

## OIL CONSERVATION DIVISION

1220 South St. Francis Dr.  
Santa Fe, NM 87505

☐ AMENDED REPORT  
☒ AS DRILLED

ENCANA OIL & GAS (USA) INC.  
GOOD TIMES UNIT #301H

WELL FLAG

LAT. 36.311547° N (NAD83)  
LONG. 107.820357° W (NAD83)  
LAT. 36.311536° N (NAD27)  
LONG. 107.819741° W (NAD27)

## ENTRY POINT


LAT. 36.312832° N (NAD83)  
LONG. 107.822629° W (NAD83)  
LAT. 36.312821° N (NAD27)  
LONG. 107.822013° W (NAD27)

BOTTOM HOLE

LAT. 36.312821° N (NAD83)  
LONG. 107.838105° W (NAD83)  
LAT. 36.312810° N (NAD27)  
LONG. 107.837488° W (NAD27)

OIL CONS. DIV DIST. 3

JUL 21 2017

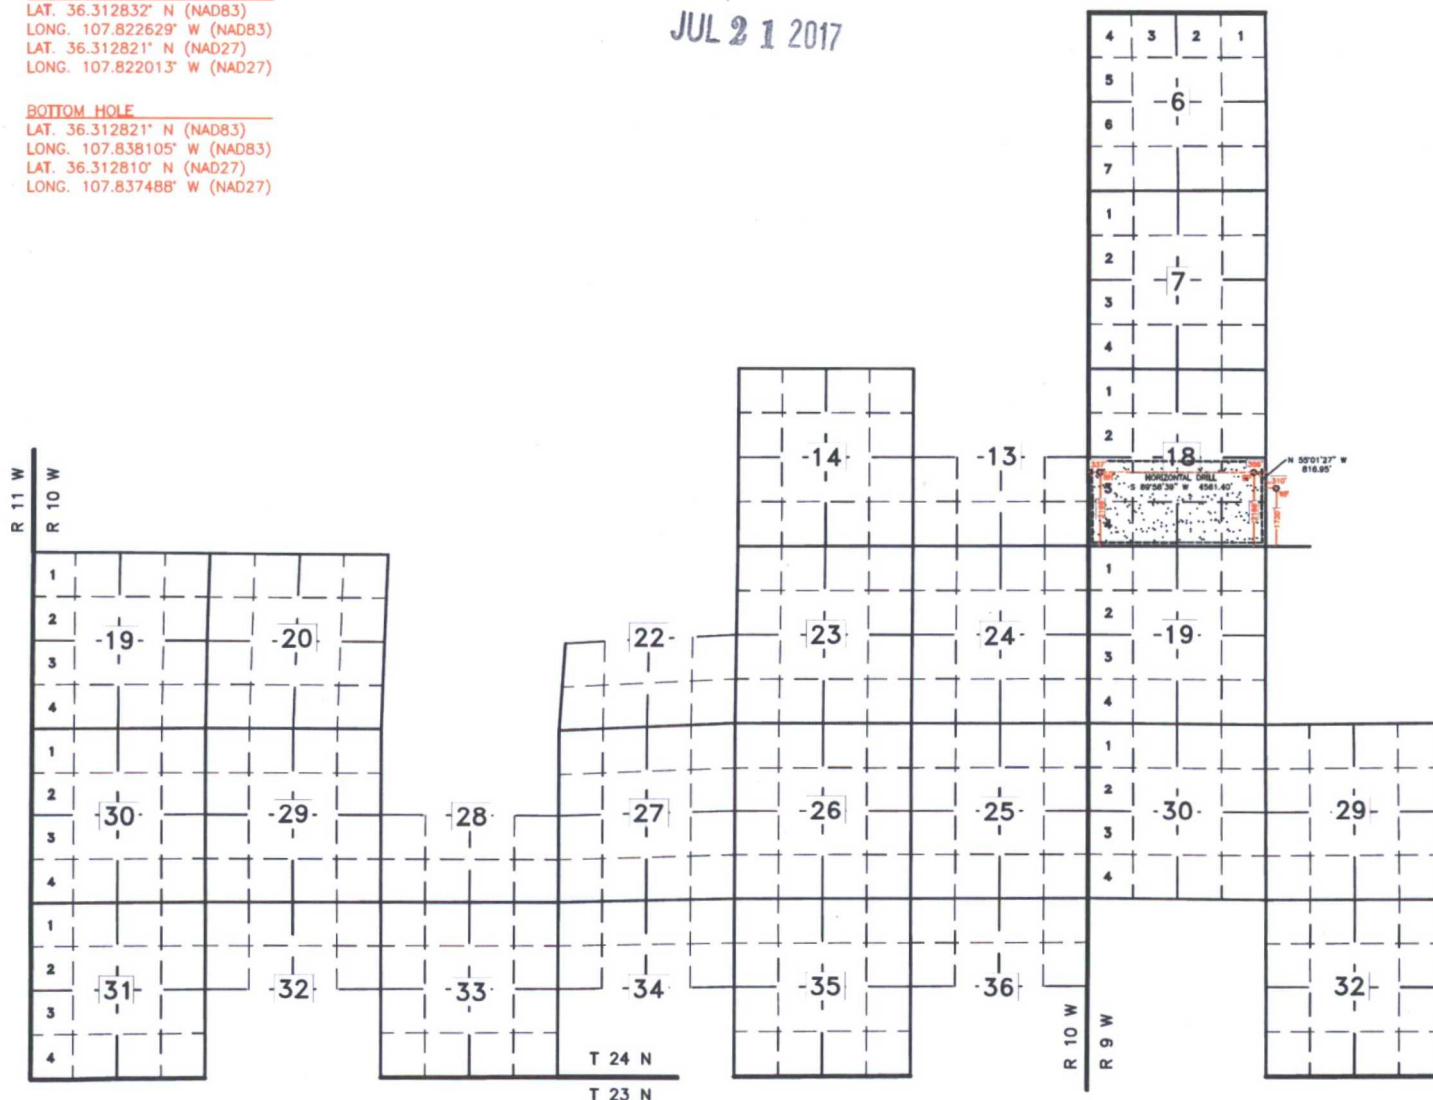

**PENETRATED SPACING UNIT; S/2 SEC. 18 (319.73 ACRES)**  
TOTAL 14,706.50 ACRES: T24N R10W SEC. 14, 19, 20, 23-27, 29-31, 33  
& 35 (ALL); SEC. 13, 22 & 28 (S/2); SEC. 32, 34 & 36 (N/2); T24N  
R9W SEC. 6, 7, 18, 19, 29, 30 & 32 (ALL) - UNDIVIDED UNIT