

UNITED STATES
DEPARTMENT OF THE INTERIOR
GEOLOGICAL SURVEY

APPLICATION FOR PERMIT TO DRILL, DEEPEN, OR PLUG BACK

1a. TYPE OF WORK

DRILL ☒DEEPEN ☐PLUG BACK ☐

b. TYPE OF WELL

OIL
WELL ☒GAS
WELL ☐

OTHER

SINGLE
ZONE ☐MULTIPLE
ZONE ☒

2. NAME OF OPERATOR

Corinne Grace

3. ADDRESS OF OPERATOR

P.O. Box 1418, Carlsbad, New Mexico

4. LOCATION OF WELL (Report location clearly and in accordance with any State requirements.)*

At surface

2020' 1980' FNL, 1980' FEL, Sec. 3, T. 21 N., R. 3 W. N.M.P.M.

At proposed prod. zone

CHANGED LOCATION BY SURVEYOR
MISTAKE

14. DISTANCE IN MILES AND DIRECTION FROM NEAREST TOWN OR POST OFFICE

Approx. 13 miles WNW of Cuba, New Mexico

10. DISTANCE FROM PROPOSED*

LOCATION TO NEAREST
PROPERTY OR LEASE LINE, FT.
(Also to nearest drilg. unit line, if any)

1980'

18. DISTANCE FROM PROPOSED*

TO NEAREST WELL, DRILLING, COMPLETED,
OR APPLIED FOR, ON THIS LEASE, FT.

none

16. NO. OF ACRES IN LEASE

1,455.36

19. PROPOSED DEPTH

7500 DAKOTA

21. ELEVATIONS (Show whether DF, RT, GR, etc.)

7324 GR

23.

PROPOSED CASING AND CEMENTING PROGRAM

SIZE OF HOLE	SIZE OF CASING	WEIGHT PER FOOT	SETTING DEPTH	QUANTITY OF CEMENT
12 1/2	8-5/8	24	300	Cir. to surf.
7-7/8				

Hole will be spudded and surface casing - 8-5/8 - set by A&M drilling Co. of Grants, New Mexico. Hole will be completed by a larger rig as soon as one is available. Adequate blowout preventer will be furnished for larger rig.

APPROVED SUBJECT TO THE ATTACHED BLM
STIPULATIONS AND SPECIAL CONSIDERATION REGARDING
WATER LINE AND STOCK TRAILING

IN ABOVE SPACE DESCRIBE PROPOSED PROGRAM: If proposal is to deepen or plug back, give data on present productive zone and proposed new productive zone. If proposal is to drill or deepen directionally, give pertinent data on subsurface locations and measured and true vertical depths. Give blowout preventer program, if any.

24.

SIGNED

TITLE

Geologist

DATE

December 29, 1973

(This space for Federal or State office use)

PERMIT NO.

APPROVAL DATE

APPROVED
CONDITIONS OF APPROVAL, IF ANY:

FEB 1

JERRY W. LON

TITLE

DATE

*See Instructions On Reverse Side

R4

30-043-20151

5. LEASE DESIGNATION AND SERIAL NO.	6. IF INDIAN, ALLOTTEE OR TRIBE NAME
7. UNIT AGREEMENT NAME	8. FARM OR LEASE NAME
9. WELL NO.	10. FIELD AND POOL, OR WILDCAT
11. SEC., T., R., M., OR BLK. AND SURVEY OR AREA	12. COUNTY OR PARISH
13. STATE	

NM 0510062

Divide 1

wildcat

Sec. 3, T. 21 N., R. 3 W.

Sandoval

New Mex.

40

rotary

Jan. 30, 1974

vertical

2/19
copy to
BLM
MOC

NEW MEXICO OIL CONSERVATION COMMISSION WELL LOCATION AND ACERAGE DEDICATION PLAT

All distances must be from the outer boundaries of the Section

Operator <u>Grace Oil Company</u>		Lease		Divide		Well No. <u>1</u>
Unit Letter <u>G</u>	Section <u>3</u>	Township <u>21 North</u>	Range <u>3 West</u>	County <u>Sandoval</u>		
Actual Footage Location of Well:						
<u>2020</u> feet from the <u>North</u> line and		<u>1720</u> feet from the <u>East</u> line				
Ground Level Elev. <u>7326</u>	Producing Formation		Pool	Dedicated Acreage:		Acres

1. Outline the acreage dedicated to the subject well by colored pencil or hatchure marks on the plat below.
2. If more than one lease is dedicated to the well, outline each and identify the ownership thereof (both as to working interest and royalty),
3. If more than one lease of different ownership is dedicated to the well, have the interests of all owners been consolidated by communitization, unitization, force-pooling, etc?

() Yes () No If answer is "yes," type of consolidation _____

If answer is "no," list the owners and tract descriptions which have actually consolidated. (Use reverse side of this Form if necessary.) _____

No allowable will be assigned to the well until all interests have been consolidated (by communitization, unitization, forced-pooling, or otherwise) or until a non standard unit, eliminating such interests, has been approved by the Commission.

CERTIFICATION


I hereby certify that the information contained herein is true and complete to the best of my knowledge and belief.

Name _____
Position _____
Company _____
Date _____

I hereby certify that the well location shown on this plat was plotted from field notes of actual survey made by me, or under my supervision, and that the same is true and correct to the best of my knowledge and belief.

Date Surveyed January 25, 1974
Registered Professional Engineer and/or Land Surveyor

E. V. Echohawk
Certificate No. 3602
E. V. Echohawk LS

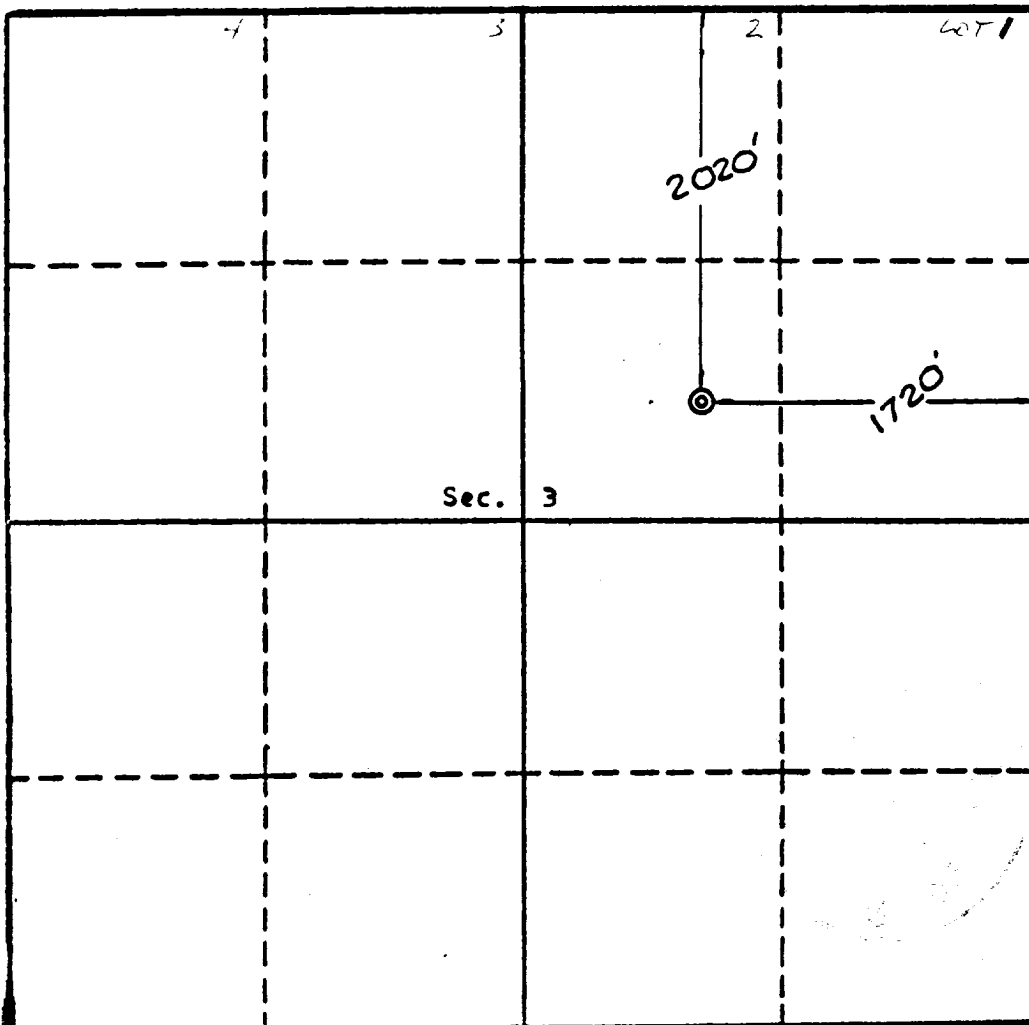

Scale, 1 inch = 1,000 feet