## 1 15


## (SUBMIT IN TRIPLICATE)

## UNITED STATES DEPARTMENT OF THE INTERIOR GEOLOGICAL SURVEY

Land Office ST	a fe,	New	iox Loq
Lease No.	78066		
Unit			

## SUNDRY NOTICES AND REPORTS ON WELLS

NOTICE OF INTENTION TO TEST WATER SHUT-OFF	SUBSEQUENT REPORT OF RE-DRILLING OR REPAIR SUBSEQUENT REPORT OF ABANDONMENT
NOTICE OF INTENTION TO ABANDON WELL	
(INDICATE ABOVE BY CHECK	MARK NATURE OF REPORT, NOTICE, OR OTHER DATA)
Sec. and Sec. No.) (Twp.)	from \{\begin{align*}{c} \begin{align*}{c} \begi
The elevation of the derrick floor above se	
. Urill li hale to 200'+.	
	200's with sufficient cement to reach surface.
	<del></del>
<ul> <li>hun and cement 9 5/8* casing at</li> <li>brill 7 7/8* hole to a total dep</li> <li>If commercial production is obta</li> </ul>	<del></del>
<ul> <li>hun and cement 9 5/8* casing at</li> <li>brill 7 7/8* hole to a total dep</li> <li>If commercial production is obta</li> </ul>	oth of 48501.
<ul> <li>hun and cement 9 5/8* casing at</li> <li>brill 7 7/8* hole to a total dep</li> <li>If commercial production is obtained, otherwise, plug and aband</li> <li>Surface formation is 0je Alama.</li> </ul>	oth of 48501.
<ul> <li>hun and cement 9 5/8* casing at</li> <li>brill 7 7/8* hole to a total dep</li> <li>If commercial production is obtained, otherwise, plug and aband</li> <li>Surface formation is 0je Alama.</li> </ul>	oth of 4850  Lined a supplementary completion notice will be  don in accordance with 9.5.0.5. regulations.
<ul> <li>hum and cessent 9 5/8° casing at</li> <li>brill 7 7/8° hole to a total deg</li> <li>If commercial production is obtatiled, otherwise, plug and aband</li> <li>Surface formation is lip Alama.</li> <li>I understand that this plan of work must receive approach</li> <li>Company Shell Oll Company</li> </ul>	timed a supplementary completion notice will be don in accordance with 9.5.0.5. regulations.
<ul> <li>hum and cessent 9 5/8* casing at</li> <li>brill 7 7/8* hole to a total dep</li> <li>If commercial production is obtained, otherwise, plug and about filed, otherwise, plug and about Surface formation is 0 je Alama.</li> </ul>	oth of 4850  Lined a supplementary completion notice will be  don in accordance with 9.5.0.5. regulations.

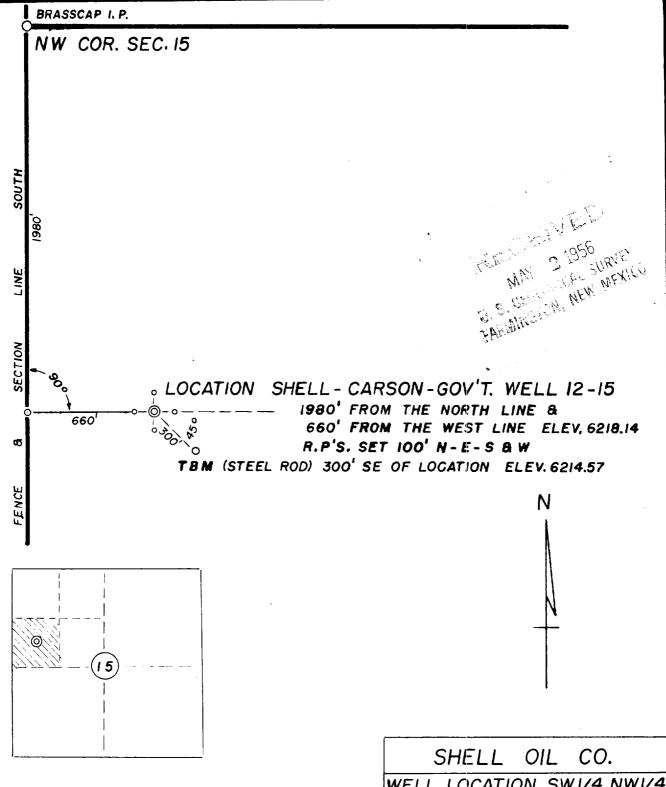

THIS IS TO CERTIFY THAT THE ABOVE PLAT WAS PREPARED FROM FIELD NOTES OF ACTUAL SURVEYS MADE BY ME OR UNDER MY SUPERVISION AND THAT THE SAME ARE TRUE AND CORRECT TO THE BEST OF MY KNOWLEDGE AND BELIEF.

JAMES P. LEESE

REGISTERED LAND SURVEYOR REG. NO. 1463 NEW MEX.

WELL LOCATION SWI/4 NWI/4 SECTION 15 T25N RI2W NMPM SAN JUAN COUNTY NEW MEX

APRIL 22 1956 SCALE I" = 500'

DRAWN BY W.C.

SAN JUAN ENGINEERING CO. FARMINGTON NEW MEXICO

Z16-522-1