

NEW MEXICO OIL CONSERVATION COMMISSION
Santa Fe, New Mexico

30-045-08564

NOTICE OF INTENTION TO DRILL ~~OR RECOMPLETION~~

Notice must be given to the District Office of the Oil Conservation Commission and approval obtained before drilling or recompleting begins. If changes in the proposed plan are considered advisable, a copy of this notice showing such changes will be returned to the sender. Submit this notice in QUINTUPLICATE. One copy will be returned following approval. See additional instructions in Rules and Regulations of the Commission.

Farmington, New Mexico
(Place)

February 2, 1955
(Date)

OIL CONSERVATION COMMISSION
SANTA FE, NEW MEXICO

Gentlemen:

You are hereby notified that it is our intention to commence the (Drilling) ~~(Recompletion)~~ of a well to be known as

Stanolind Oil and Gas Company
(Company or Operator)

Nye Gas Unit
(Lease)

Well No. 1, in H (Unit) The well is

located 1750 feet from the North line and 790 feet from the

East

line of Section 7, T. 29-N, R. 9-W, NMPM.

(GIVE LOCATION FROM SECTION LINE) Blanco-Mesaverte Pool, San Juan County

D	C	B	A
E	F	G	H
L	K	J	I
M	N	O	P

If State Land the Oil and Gas Lease is No.

If patented land the owner is Pasquel Valencia
Address Blanco, New Mexico

We propose to drill well with drilling equipment as follows:

Rotary tools will be used to total depth.

The status of plugging bond is

Drilling Contractor Keating Drilling Company
National Bank of Tulsa Building
Tulsa, Oklahoma

We intend to complete this well in the Mesaverte
formation at an approximate depth of 5100

CASING PROGRAM

We propose to use the following strings of Casing and to cement them as indicated:

Size of Hole	Size of Casing	Weight per Foot	New or Second Hand	Depth	Sacks Cement
<u>12-1/4"</u>	<u>9-5/8"</u>	<u>32.3#</u>	<u>New</u>	<u>250'</u>	<u>125</u>
<u>8-3/4"</u>	<u>7"</u>	<u>20#</u>	<u>New</u>	<u>4300'</u>	<u>150</u>

If changes in the above plans become advisable we will notify you immediately.

ADDITIONAL INFORMATION (If recompleting give full details of proposed plan of work.)

Designated Drilling Unit 8/2 N/2 N/2; 3/2 N/2; N/2 S/2, Sec. 7, T-29-N, R-9-W,
per NMOC Order R-364.

Approved.....
Except as follows:

2-3, 1955

Sincerely yours,

Stanolind Oil and Gas Company
(Company or Operator)

By.....

Position Field Superintendent
Send Communications regarding well to

Name Mr. L. O. Speer, Jr.

Address Box 487, Farmington, New Mexico



OIL CONSERVATION COMMISSION

By.....

Title

Oil and Gas Inspector Dist. #3.

OIL CONSERVATION COMMISSION		
AZTEC DISTRICT OFFICE		
No. Copies Received 8 5		
DISTRIBUTION		
	NO. FURNISHED	
Operator	1	
Santa Fe	1	
Proclamation Office		
State Land Office		
U. S. G. S.	2	
Transporter		
File	1	✓

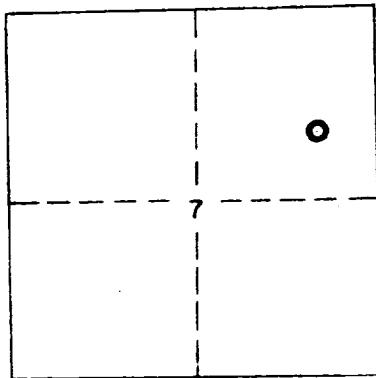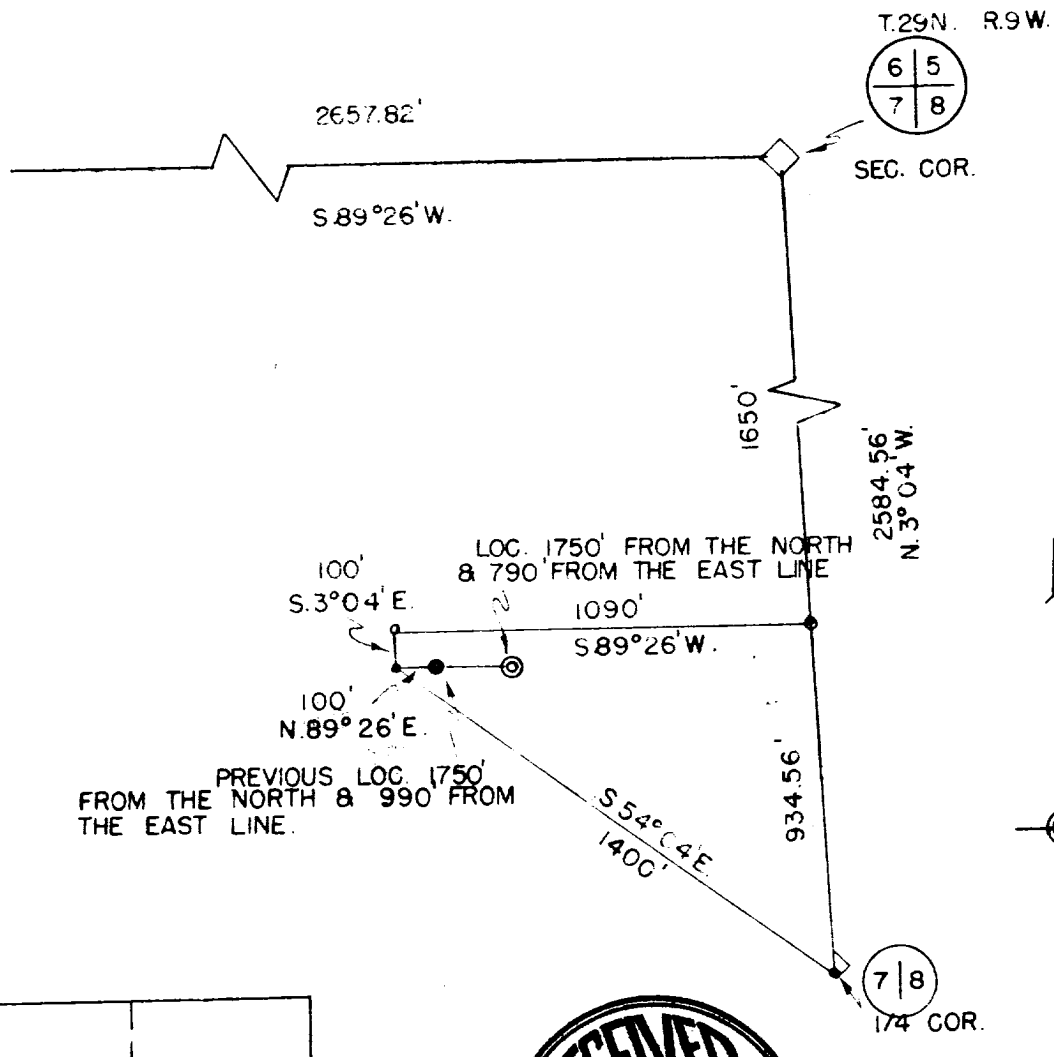

This is to certify that the above plat was prepared from field notes of actual surveys made by me or under my supervision and that the same are true and correct to the best of my knowledge and belief.

James P. Leese
James P. Leese
Reg. Land Surveyor
N. Mex. Reg. No. 1463

STANOLIND OIL & GAS CO.

WELL LOCATION NE 1/4
SEC. 7, T.29N., R.9W. N.M.P.M.
SAN JUAN CO. NEW MEXICO

OCT 15, 1954

SCALE 1"=500'

DRAWN BY: DEL A. TALLEY

OIL CONSERVATION COMMISSION	
AZTEC DISTRICT OFFICE	
No. Copies Received	
DISTRIBUTION	
	No. COPIES
Director	
Santa Fe	
Promotion Office	
State Land Office	
U. S. G. S.	
Transporter	
File	