

UNITED STATES
DEPARTMENT OF THE INTERIOR
BUREAU OF LAND MANAGEMENT

SUBMIT IN TRIPLICATE*
(Other instructions on re-
verse side)

Form approved.
Budget Bureau No. 1004-0135
Expires August 31, 1985

SUNDRY NOTICES AND REPORTS ON WELLS

(Do not use this form for proposals to drill or to deepen or plug back to a different reservoir.
Use "APPLICATION FOR PERMIT—" for such proposals.)

1. OIL WELL ☐ GAS WELL ☐ OTHER ☒	7. UNIT AGREEMENT NAME
2. NAME OF OPERATOR <i>Blackwood & Nichols</i> <i>Meridian Oil Inc.</i>	8. FARM OR LEASE NAME <i>Northeast Blanco Uni</i>
3. ADDRESS OF OPERATOR <i>Post Office Box 4289, Farmington, NM 87499</i>	9. WELL NO. <i>411</i>
4. LOCATION OF WELL (Report location clearly and in accordance with any State requirements.* See also space 17 below.) At surface <i>1470' N, 1450' E</i> <i>1465 1350</i>	10. FIELD AND POOL, OR WILDCAT <i>Basin Fruitland Coal</i>
14. PERMIT NO.	11. SEC. T., R., M., OR BLK. AND SURVEY OR AREA <i>Sec. 10, T-30-N, R-7 -W</i> <i>N.M.P.M.</i>
15. ELEVATIONS (Show whether DF, RT, GR, etc.) <i>6265' GL</i>	12. COUNTY OR PARISH <i>Rio Arriba</i>
	13. STATE <i>NM</i>

Check Appropriate Box To Indicate Nature of Notice, Report, or Other Data

NOTICE OF INTENTION TO:

SUBSEQUENT REPORT OF:

TEST WATER SHUT-OFF ☐	PULL OR ALTER CASING ☐	WATER SHUT-OFF ☐	REPAIRING WELL ☐
FRACTURE TREAT ☐	MULTIPLE COMPLETE ☐	FRACTURE TREATMENT ☐	ALTERING CASING ☐
SHOOT OR ACIDIZE ☐	ABANDON* ☐	SHOOTING OR ACIDIZING ☐	ABANDONMENT* ☐
REPAIR WELL ☐	CHANGE PLANS ☐	(Other) ☐	

(NOTE: Report results of multiple completion on Well Completion or Recompletion Report and Log form.)

17. DESCRIBE PROPOSED OR COMPLETED OPERATIONS (Clearly state all pertinent details, and give pertinent dates, including estimated date of starting any proposed work. If well is directionally drilled, give subsurface locations and measured and true vertical depths for all markers and zones pertinent to this work.)

Attached is a copy of the C-102 and cut and fill diagram, showing the revised location of this well. Also attached is a revised well pad laydown.

RECEIVED

JUN 20 1989

BUREAU OF LAND MANAGEMENT
FARMINGTON RESOURCE AREA

RECEIVED
AUG 04 1989

APPROVED

AUG 1 1989

AREA MANAGER

18. I hereby certify that the foregoing is true and correct

SIGNED *[Signature]* TITLE *Regulatory Affairs ()* DATE *06-19-89*

(This space for Federal or State office use)

APPROVED BY _____ TITLE _____ DATE _____
CONDITIONS OF APPROVAL, IF ANY: _____

*See Instructions on Reverse Side

Submit to Appropriate
District Office
State Lease - 4 copies
Fee Lease - 3 copies

State of New Mexico
Energy, Minerals and Natural Resources Department

Form C-102
Revised 1-1-89

OIL CONSERVATION DIVISION

P.O. Box 2088
Santa Fe, New Mexico 87504-2088

DISTRICT I
P.O. Box 1980, Hobbs, NM 88240

DISTRICT II
P.O. Drawer DD, Artesia, NM 88210

DISTRICT III
1000 Rio Brazos Rd., Aztec, NM 87410

WELL LOCATION AND ACREAGE DEDICATION PLAT

All Distances must be from the outer boundaries of the section

Operator Meridian Oil Inc.			Lease (SF-079001A) North East Blanco Unit		Well No. 411
Unit Letter G	Section 10	Township 30 North	Range 7 West	County Rio Arriba	
Actual Footage Location of Well: 1465 feet from the North line and 1350 feet from the East line					
Ground level Elev. 6260'	Producing Formation Fruitland Coal		Pool Basin	Dedicated Acreage: 320 Acres	

1. Outline the acreage dedicated to the subject well by colored pencil or ballpoint marks on the plat below.

2. If more than one lease is dedicated to the well, outline each and identify the ownership thereof (both as to working interest and royalty).

3. If more than one lease of different ownership is dedicated to the well, have the interest of all owners been consolidated by communitization, unitization, force-pooling, etc.?

☒ Yes ☐ No If answer is "yes" type of consolidation unitization

If answer is "no" list the owners and tract descriptions which have actually been consolidated. (Use reverse side of this form if necessary.)

No allowable will be assigned to the well until all interests have been consolidated (by communitization, unitization, forced-pooling, or otherwise) or until a non-standard unit, eliminating such interest, has been approved by the Division.

Reissued to show
moved location 6-8-89

RECEIVED

JUN 20 1989

BUREAU OF LAND MANAGEMENT
FARMINGTON RESOURCE AREA

OPERATOR CERTIFICATION

I hereby certify that the information contained herein is true and complete to the best of my knowledge and belief.

Peggy Bradfield
Signature

Peggy Bradfield

Printed Name
Regulatory Affairs

Position
Meridian Oil Inc.

Company
6-19-89

Date

SURVEYOR CERTIFICATION

I hereby certify that the well location shown on this plat was plotted from field notes or actual surveys made by me or under my supervision, and that the same is true and correct to the best of my knowledge and belief.

6-8-89
Date Surveyed
Neale C. Edwards

Signature of Sealing Professional Surveyor

REGISTERED LAND SURVEYOR

Certificate No.

6857


0 330 660 990 1320 1650 1980 2310 2640 2970 3300 3630 3960 4290 4620 4950 5280 5610 5940 6270 6600 6930 7260 7590 7920 8250 8580 8910 9240 9570 9900 0

MERIDIAN OIL

WELL NAME

NO.1 WEBU #411

1465'FNL, 1350'FEL,
Sec.10, T30N, R7W, NMPM,
Rio Arriba County, NM

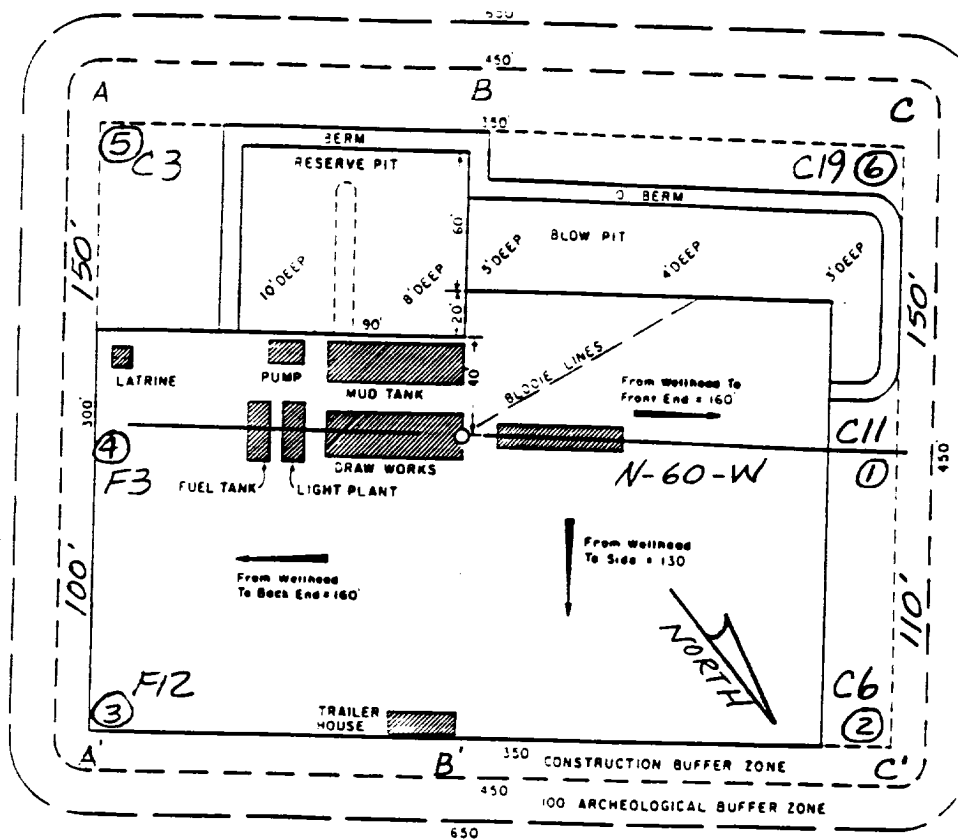

A - A'

Vert. 1" = 30'

Horiz. 1" = 50'

C/L

6270

6260

6250

B - B'

C/L

6270

6260

6250


C - C'

C/L

6270

6260

6250

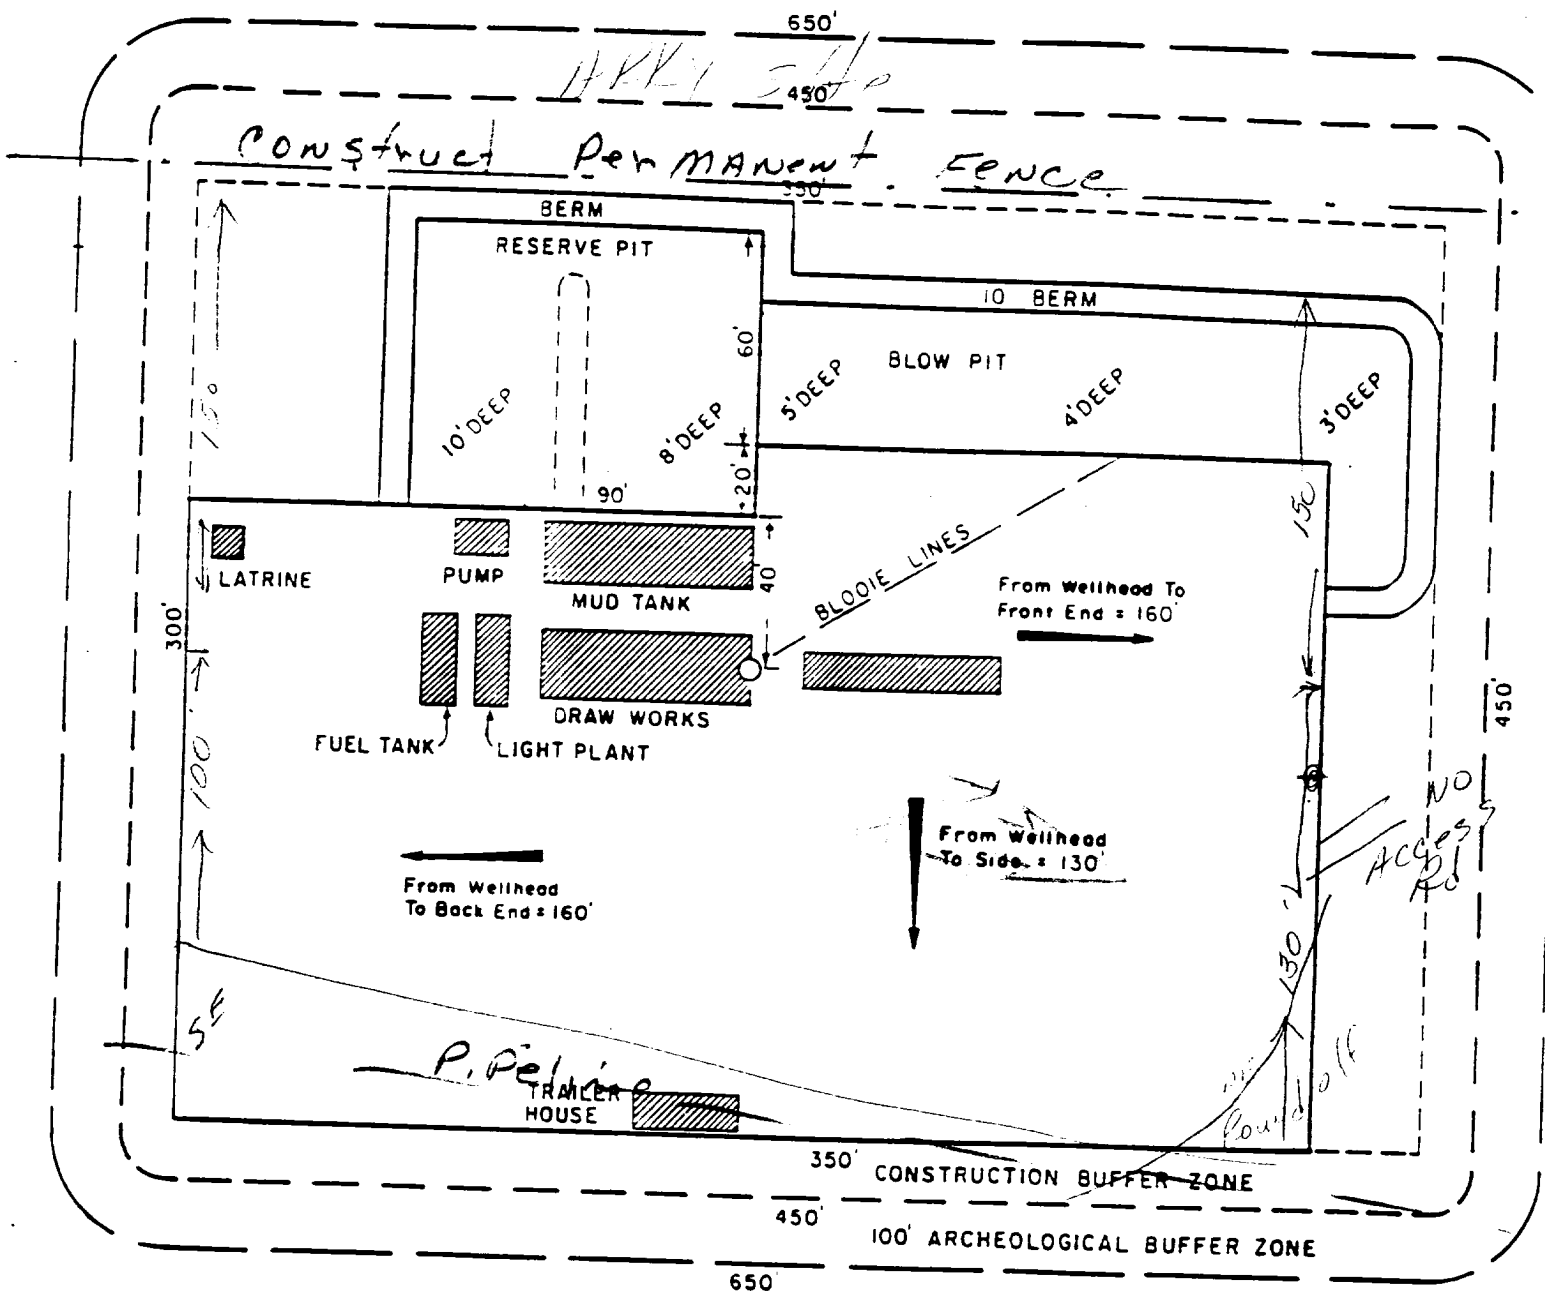

NEBU #411
 1465 N - 1350 E
 10-30-7

RT.	SEP.	DATE	TO	W.O.	ENG. REC.	DATE
					DRAWN	R.C. 12/88
					CHECKED	
					CHECKED	
					PROJ. APP.	
					DESIGN	

PRINT RECORD

SCALE: 1" = 100' DWG.

MERIDIAN OIL INC.
 TYPICAL LOCATION PLAT FOR
 FRUITLAND COAL DRILL SITE