

UNITED STATES
DEPARTMENT OF THE INTERIOR
BUREAU OF LAND MANAGEMENT

SUBMIT IN TRIPLICATE*
(Other instructions on re-
verse side)

Form approved.
Budget Bureau No. 1004-0135
Expires August 31, 1985

Printout cancelled BUREAU OF LAND MANAGEMENT

SUNDRY NOTICES AND REPORTS ON WELLS

(Do not use this form for proposals to drill or to deepen or plug back to a different reservoir.
Use "APPLICATION FOR PERMIT—" for such proposals.)

1. OIL WELL ☐ GAS WELL ☐ OTHER ☒	7. UNIT AGREEMENT NAME
2. NAME OF OPERATOR	San Juan 30-6 Unit
3. ADDRESS OF OPERATOR	8. FARM OR LEASE NAME
El Paso Natural Gas Company	San Juan 30-6 Unit
4. LOCATION OF WELL (Report location clearly and in accordance with any State requirements.* See also space 17 below.) At surface	9. WELL NO.
Post Office Box 4289, Farmington, NM 87499 1140'S, 960'W	473
14. PERMIT NO.	10. FIELD AND POOL, OR WILDCAT
	Basin Fruitland Coa
15. ELEVATIONS (Show whether DP, RT, GR, etc.)	11. SEC., T., R., M., OR BLK. AND SURVEY OR AREA
6410'GL	Sec. 22, T-30-N, R-6 -
	N.M.P.M.
	12. COUNTY OR PARISH 13. STATE
	Rio Arriba NM

Check Appropriate Box To Indicate Nature of Notice, Report, or Other Data

NOTICE OF INTENTION TO:

TEST WATER SHUT-OFF	☐	RELL OR ALTER CASING	☐
FRACTURE TREAT	☐	MULTIPLE COMPLETE	☐
SHOOT OR ACIDIZE	☐	ABANDON*	☐
REPAIR WELL	☐	CHANGE PLANS	☐
(Other)	☐		☐

SUBSEQUENT REPORT OF:

WATER SHUT-OFF	☐	REPAIRING WELL	☐
FRACTURE TREATMENT	☐	ALTERING CASING	☐
SHOOTING OR ACIDIZING	☐	ABANDONMENT*	☐
(Other)	☐		☐

(NOTE: Report results of multiple completion on Well Completion or Recompletion Report and Log form.)

17. DESCRIBE PROPOSED OR COMPLETED OPERATIONS (Clearly state all pertinent details, and give pertinent dates, including estimated date of starting any proposed work. If well is directionally drilled, give subsurface locations and measured and true vertical depths for all markers and zones pertinent to this work.)*

Attached is a copy of the C-102 and cut and fill showing the revised location of this well.

RECEIVED

JUN 14 1989

RECEIVED

RECEIVED

JUL 23 1989

RECEIVED

18. I hereby certify that the foregoing is true and correct

SIGNED [Signature]

TITLE Regulatory Affairs (DATE 06-12-89)

(This space for Federal or State office use)

APPROVED BY [Signature]
CONDITIONS OF APPROVAL, IF ANY:

TITLE Ken Townsend DATE JUN 14 1989

FOR Ken Townsend

FARMINGTON, NEW MEXICO

*See Instructions on Reverse Side

MMOCD

Submit to Appropriate
District Office
State Lease - 4 copies
Fee Lease - 3 copies

State of New Mexico
Energy, Minerals and Natural Resources Department

Form C-102
Revised 1-1-89

OIL CONSERVATION DIVISION

P.O. Box 2088
Santa Fe, New Mexico 87504-2088

DISTRICT I
P.O. Box 1980, Hobbs, NM 88240

DISTRICT II
P.O. Drawer DD, Artesia, NM 88210

DISTRICT III
1000 Rio Brazos Rd., Aztec, NM 87410

WELL LOCATION AND ACREAGE DEDICATION PLAT

All Distances must be from the outer boundaries of the section

Operator <u>El Paso Natural Gas</u>		Lease <u>(NM-04052)</u>		Well No. <u>473</u>
Unit Letter <u>M</u>	Section <u>22</u>	Township <u>30 North</u>	Range <u>6 West</u>	County <u>Rio Arriba</u>
Actual Footage Location of Well: <u>1140</u> feet from the <u>South</u> line and <u>960</u> feet from the <u>West</u> line				
Ground level Elev. <u>6410'</u>	Producing Formation <u>Fruitland Coal</u>		Pool <u>Basin</u>	Dedicated Acreage: <u>14</u> 320 Acres

1. Outline the acreage dedicated to the subject well by colored pencil or machine marks on the plat below.
 2. If more than one lease is dedicated to the well, outline each and identify the ownership thereof (both as to working interest and royalty).
 3. If more than one lease of different ownership is dedicated to the well, have the interest of all owners been consolidated by communitization, unitization, force-pooling, etc.?
☒ Yes ☐ No If answer is "yes" type of consolidation unitization
If answer is "no" list the owners and tract descriptions which have actually been consolidated. (Use reverse side of this form if necessary).
- No allowable will be assigned to the well until all interests have been consolidated (by communitization, unitization, force-pooling, or otherwise) or until a non-standard unit, eliminating such interest, has been approved by the Division.

OPERATOR CERTIFICATION

I hereby certify that the information contained herein is true and complete to best of my knowledge and belief.


Signature
Peggy Bradfield
Printed Name
Regulatory Affairs
Position
El Paso Natural Gas
Company
6-12-89
Date

SURVEYOR CERTIFICATION

I hereby certify that the well location shown on this plat was plotted from field notes actual surveys made by me or under my supervision, and that the same is true and correct to the best of my knowledge and belief.

Date Surveyed
NEALE C. EDWARDS
Signature of Seal of Professional Surveyor
357


REGISTERED LAND SURVEYOR
Certificate No.
6857

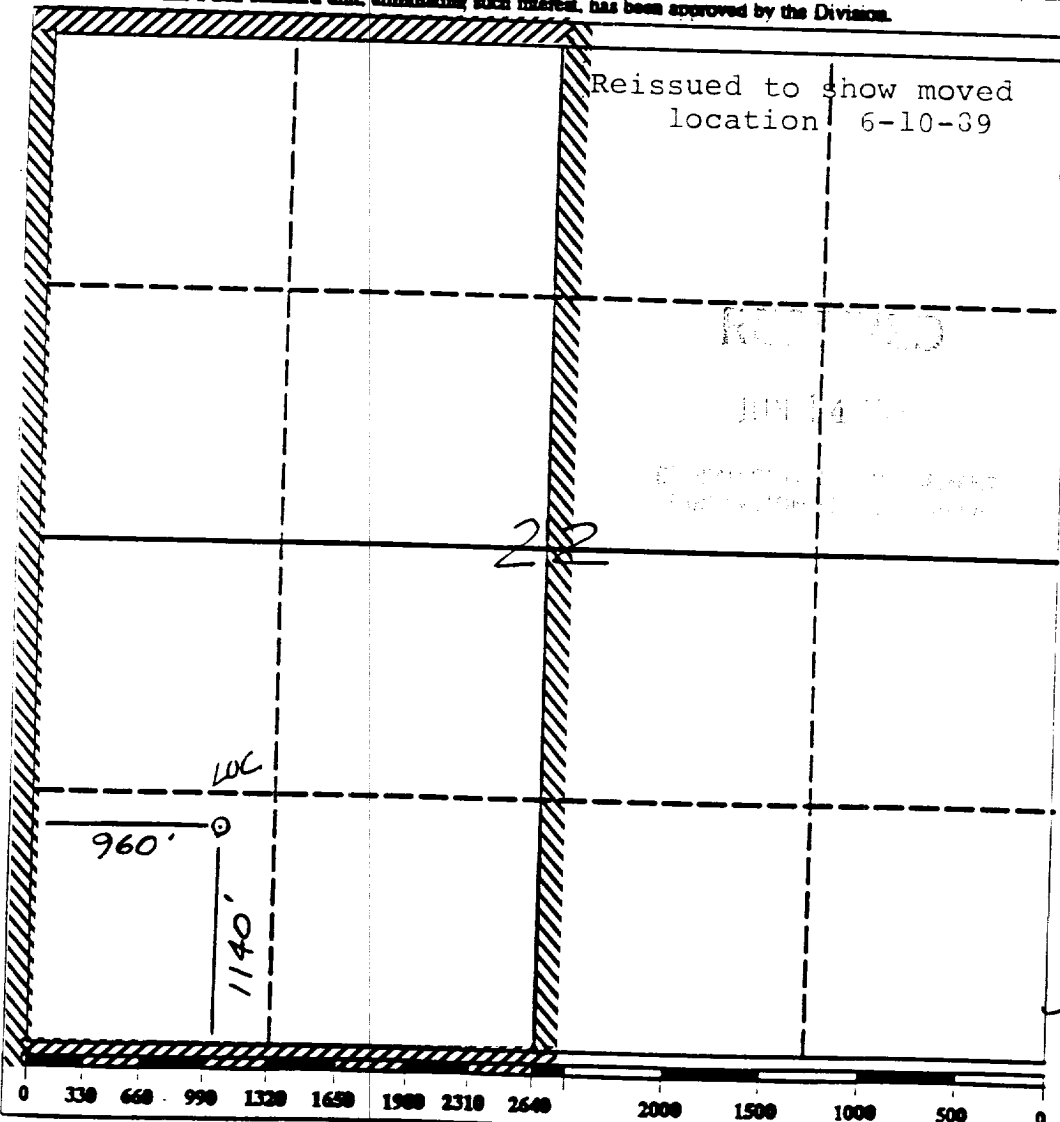

MERIDIAN OIL

WELL NAME

EPNG San Juan 30-6 Unit
 1140' FSL, 960' FWL, Unit # 473
 Sec. 22, T30N, R6W, NMPM,
 Rio Arriba County, NM

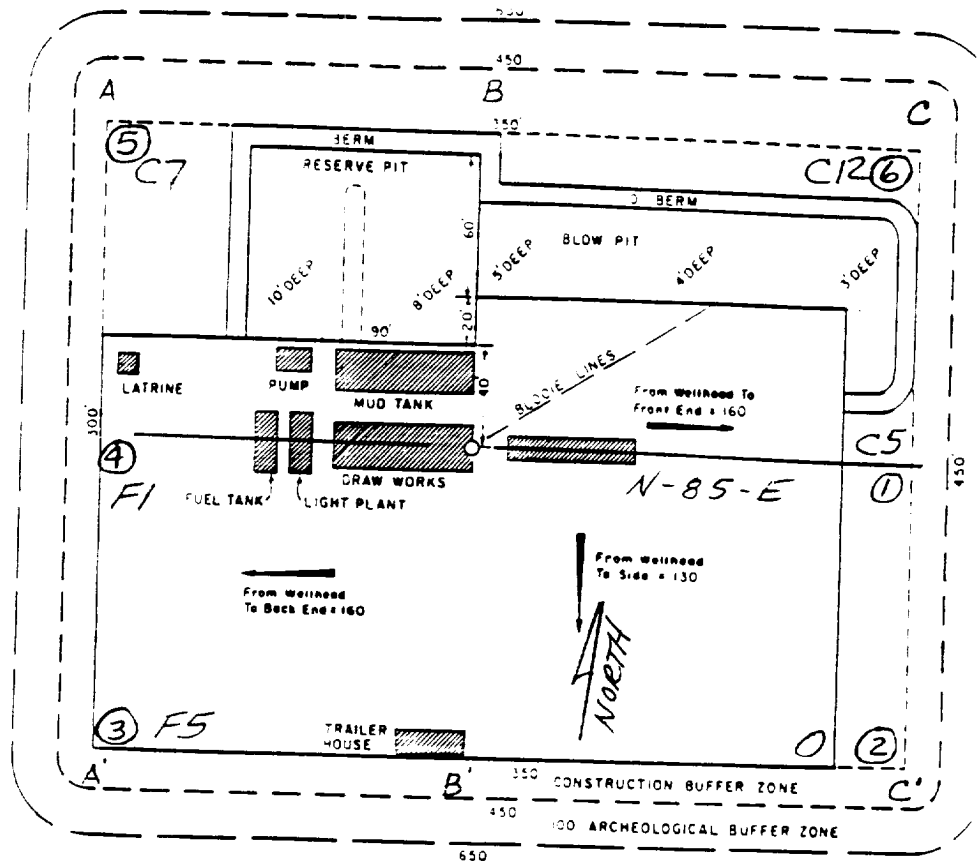

A - A'

Vert. 1" = 30'

Horiz. 1" = 50'

C/L

6420

6410

6400

B - B'

C/L

6420

6410

6400

C - C'

C/L

6420

6410

6400