

Submit 3 Copies
to Appropriate
District Office

State of New Mexico
Energy, Minerals and Natural Resources Department

Form C-103
Revised 1-1-89

DISTRICT I
P.O. Box 1980, Hobbs, NM 88240

DISTRICT II
P.O. Drawer DD, Artesia, NM 88210

DISTRICT III
1000 Rio Brazos Rd., Aztec, NM 87410

OIL CONSERVATION DIVISION

P.O. Box 2088
Santa Fe, New Mexico 87504-2088

WELL API NO.

80-045-28170

5. Indicate Type of Lease

STATE ☐

FEE ☒

6. State Oil & Gas Lease No.

SUNDRY NOTICES AND REPORTS ON WELLS
(DO NOT USE THIS FORM FOR PROPOSALS TO DRILL OR TO DEEPEN OR PLUG BACK TO A
DIFFERENT RESERVOIR. USE "APPLICATION FOR PERMIT"
(FORM C-101) FOR SUCH PROPOSALS.)

1. Type of Well:

OIL
WELL ☐

GAS

WELL ☒

OTHER

2. Name of Operator

BHP Petroleum (Americas), Inc.

3. Address of Operator

5847 San Felipe Suite 3600 Houston, Texas 77057

4. Well Location

Unit Letter D : 978 Feet From The North Line and 1148 Feet From The West Line

Section 28 Township 20N Range 12W NMPM San Juan County

10. Elevation (Show whether DF, RKB, RT, GR, etc.)

5329' GR

7. Lease Name or Unit Agreement Name

Gallegos Canyon Unit

8. Well No.

509

9. Pool name or Wildcat

W. Kutz Pictured Cliffs

11.

Check Appropriate Box to Indicate Nature of Notice, Report, or Other Data

NOTICE OF INTENTION TO:

PERFORM REMEDIAL WORK ☐

PLUG AND ABANDON ☐

TEMPORARILY ABANDON ☐

CHANGE PLANS ☐

PULL OR ALTER CASING ☐

OTHER: Move location ☒

SUBSEQUENT REPORT OF:

REMEDIAL WORK ☐ ALTERING CASING ☐

COMMENCE DRILLING OPNS. ☐ PLUG AND ABANDONMENT ☐

CASING TEST AND CEMENT JOB ☐

OTHER: ☐

12. Describe Proposed or Completed Operations (Clearly state all pertinent details, and give pertinent dates, including estimated date of starting any proposed work) SEE RULE 1103.

BHP proposes to move the subject well from its originally approved location of 990' FNL & 1130' FWL to satisfy the surface owner's request.

RECEIVED
NOV 23 1990
OIL CON. DIV.
DIST. 3

I hereby certify that the information above is true and complete to the best of my knowledge and belief.

SIGNATURE

Chuck Williams

TITLE Field Services Administrator DATE 11/20/90

TYPE OR PRINT NAME

Chuck Williams

TELEPHONE NO. (713) 780-5448

(This space for State Use)

APPROVED BY

Emile B. ...

DEPUTY OIL & GAS INSPECTOR, DIST. #3

TITLE

DATE

DEC 03 1990

CONDITIONS OF APPROVAL, IF ANY:

Submit to Appropriate
District Office
State Lease - 4 copies
Fee Lease - 3 copies

State of New Mexico
Energy, Minerals and Natural Resources Department

Form C-162
Revised 1-1-89

OIL CONSERVATION DIVISION

P.O. Box 2088
Santa Fe, New Mexico 87504-2088

DISTRICT I
P.O. Box 1980, Hobbs, NM 88240

DISTRICT II
P.O. Drawer DD, Artesia, NM 88210

DISTRICT III
1000 Rio Brazos Rd., Aztec, NM 87410


WELL LOCATION AND ACREAGE DEDICATION PLAT

All Distances must be from the outer boundaries of the section

Operator BHP PETROLEUM (AMERICAS) INC.			Lease GALLEGOS CANYON UNIT		Well No. 509
Unit Letter D	Section 28	Township 29 N	Range 12 W	County San Juan	
Actual Footage Location of Well: 978 feet from the North line and 1148 feet from the West line					
Ground level Elev. 5329	Producing Formation Pictured Cliffs		Pool W. Kutz Pictured Cliffs		Dedicated Acreage: 160 Acres

1. Outline the acreage dedicated to the subject well by colored pencil or hatchure marks on the plat below.
2. If more than one lease is dedicated to the well, outline each and identify the ownership thereof (both as to working interest and royalty).
3. If more than one lease of different ownership is dedicated to the well, have the interest of all owners been consolidated by communitization, unitization, force-pooling, etc.?
☐ Yes ☐ No If answer is "yes" type of consolidation _____
If answer is "no" list the owners and tract descriptions which have actually been consolidated. (Use reverse side of this form if necessary).
No allowable will be assigned to the well until all interests have been consolidated (by communitization, unitization, forced-pooling, or otherwise) or until a non-standard unit, eliminating such interest, has been approved by the Division.

0 330 660 990 1320 1650 1980 2310 2640 2970 3300 3630 3960 4290 4620 4950 5280 5610 5940 6270 6600

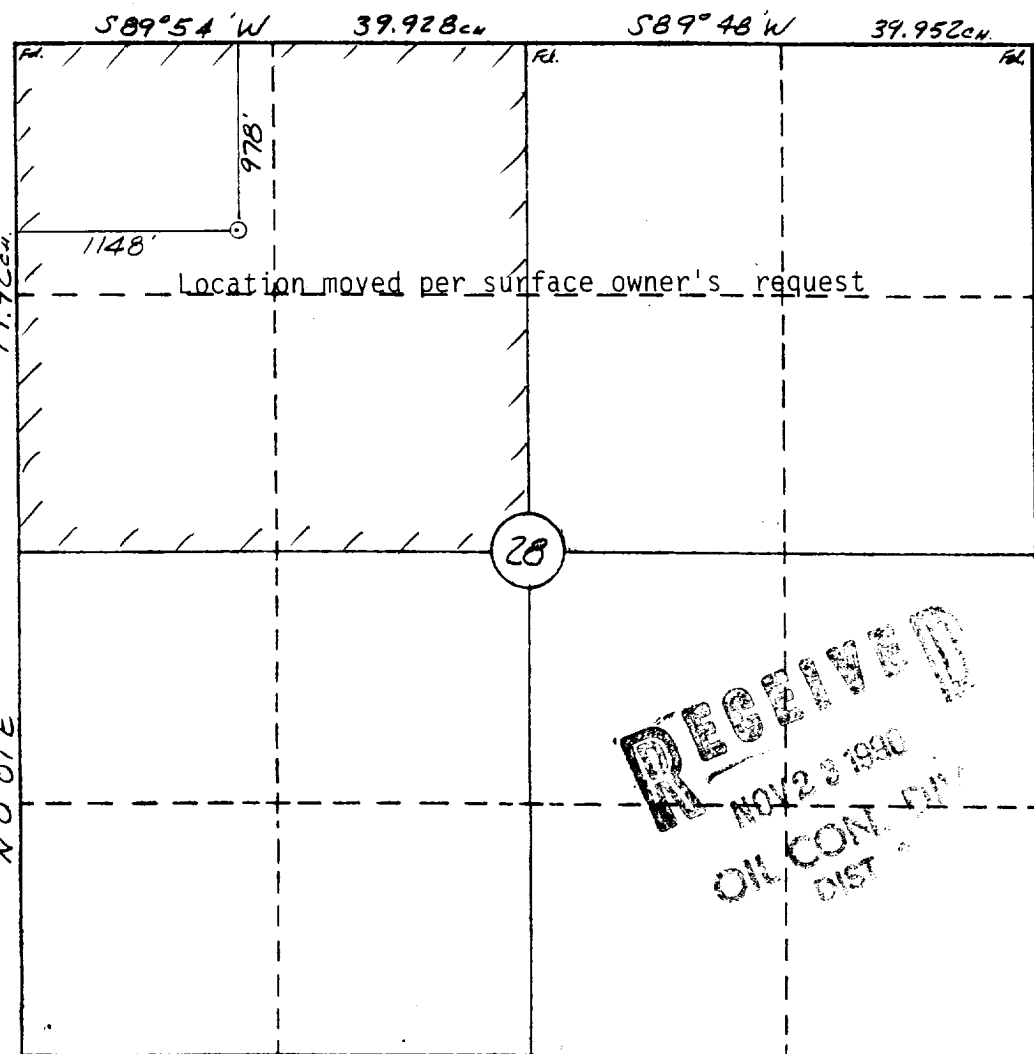

OPERATOR CERTIFICATION

I hereby certify that the information contained herein is true and complete to the best of my knowledge and belief.

Signature: *Chuck Williams*
Printed Name: **Chuck Williams**
Position: **Field Services Administrator**
Company: **BHP Petroleum (Americas) Inc.**
Date: **Nov 20, 1990**

SURVEYOR CERTIFICATION


I hereby certify that the well location shown on this plat was plotted from field notes of actual surveys made by me or under my supervision, and that the same is true and correct to the best of my knowledge and belief.
11-19-90

Date Surveyed: **William G. Mankie, II**

Signature & Seal of Professional Surveyor

#8466
Certificate No. **8466**

BHP PETROLEUM (AMERICAS) INC.
 GALLEGOS CANYON UNIT #509
 978'FNL & 1148'FWL
 Sec.28, T29N, R12W
 San Juan Co., N.M.

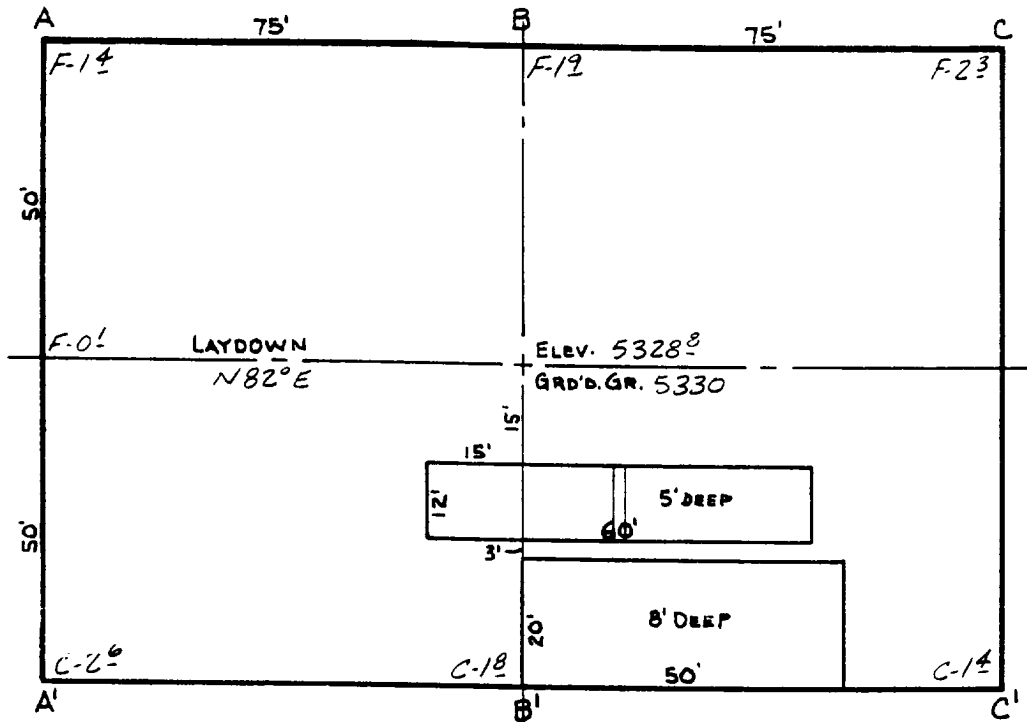

SCALE: 1" = 30'



A-A'		Vert.: 1" = 30'		Horiz.: 1" = 50'		C/L	
5330							
5320							

B-B'		Vert.: 1" = 30'		Horiz.: 1" = 50'		C/L	
5330							
5320							

C-C'		Vert.: 1" = 30'		Horiz.: 1" = 50'		C/L	
5330							
5320							

