



Amoco Production Company

Petroleum Center Building
501 Airport Drive
Farmington, New Mexico 87401

L. O. Speer, Jr.
Area Superintendent

October 9, 1975

File: LOS-407-400.1

Mr. A. R. Kendrick
New Mexico Oil Conservation Commission
1000 Rio Brazos Road
Aztec, New Mexico 87410

Dear Mr. Kendrick:

Re: Bradenhead Test Report
E. E. Elliott "A" No. 1



We are forwarding to you the bradenhead test report on the following well:

<u>Name</u>	<u>Location</u>
E. E. Elliott "A" No. 1	Unit L, Section 15, T-30N, R-9W

As can be seen by the attached bradenhead test report, this well did not flow up the bradenhead but did flow up the annulus between the intermediate casing string and the production casing string.

Attachment 1 is a wellbore diagram for the E. E. Elliott "A" No. 1 and shown on this attachment are the cement tops in the 4-1/2" production casing string and the 7" intermediate casing string. These cement tops were taken off a cement bond log on the 4-1/2" casing and a temperature survey on the 7" casing string. Cement on the surface casing string, the 9-5/8", was circulated and should have good bond all the way to surface.

We feel that as the bradenhead did not flow there is no need to take any remedial action on this well. If you concur with this we will not attempt to stop this flow thru the intermediate casing string and will closely monitor the bradenhead to make sure that no flow up this side develops.

If you have any questions regarding this, please contact us.

Yours very truly,

L. O. Speer, Jr.
DAN/en
Attachments




Amoco Production Company

ENGINEERING CHART

SHEET NO. _____ OF _____
FILE _____
APPN _____
DATE _____
BY _____

SUBJECT E. E. Elliott "A" No. 1
Wellbore Diagram

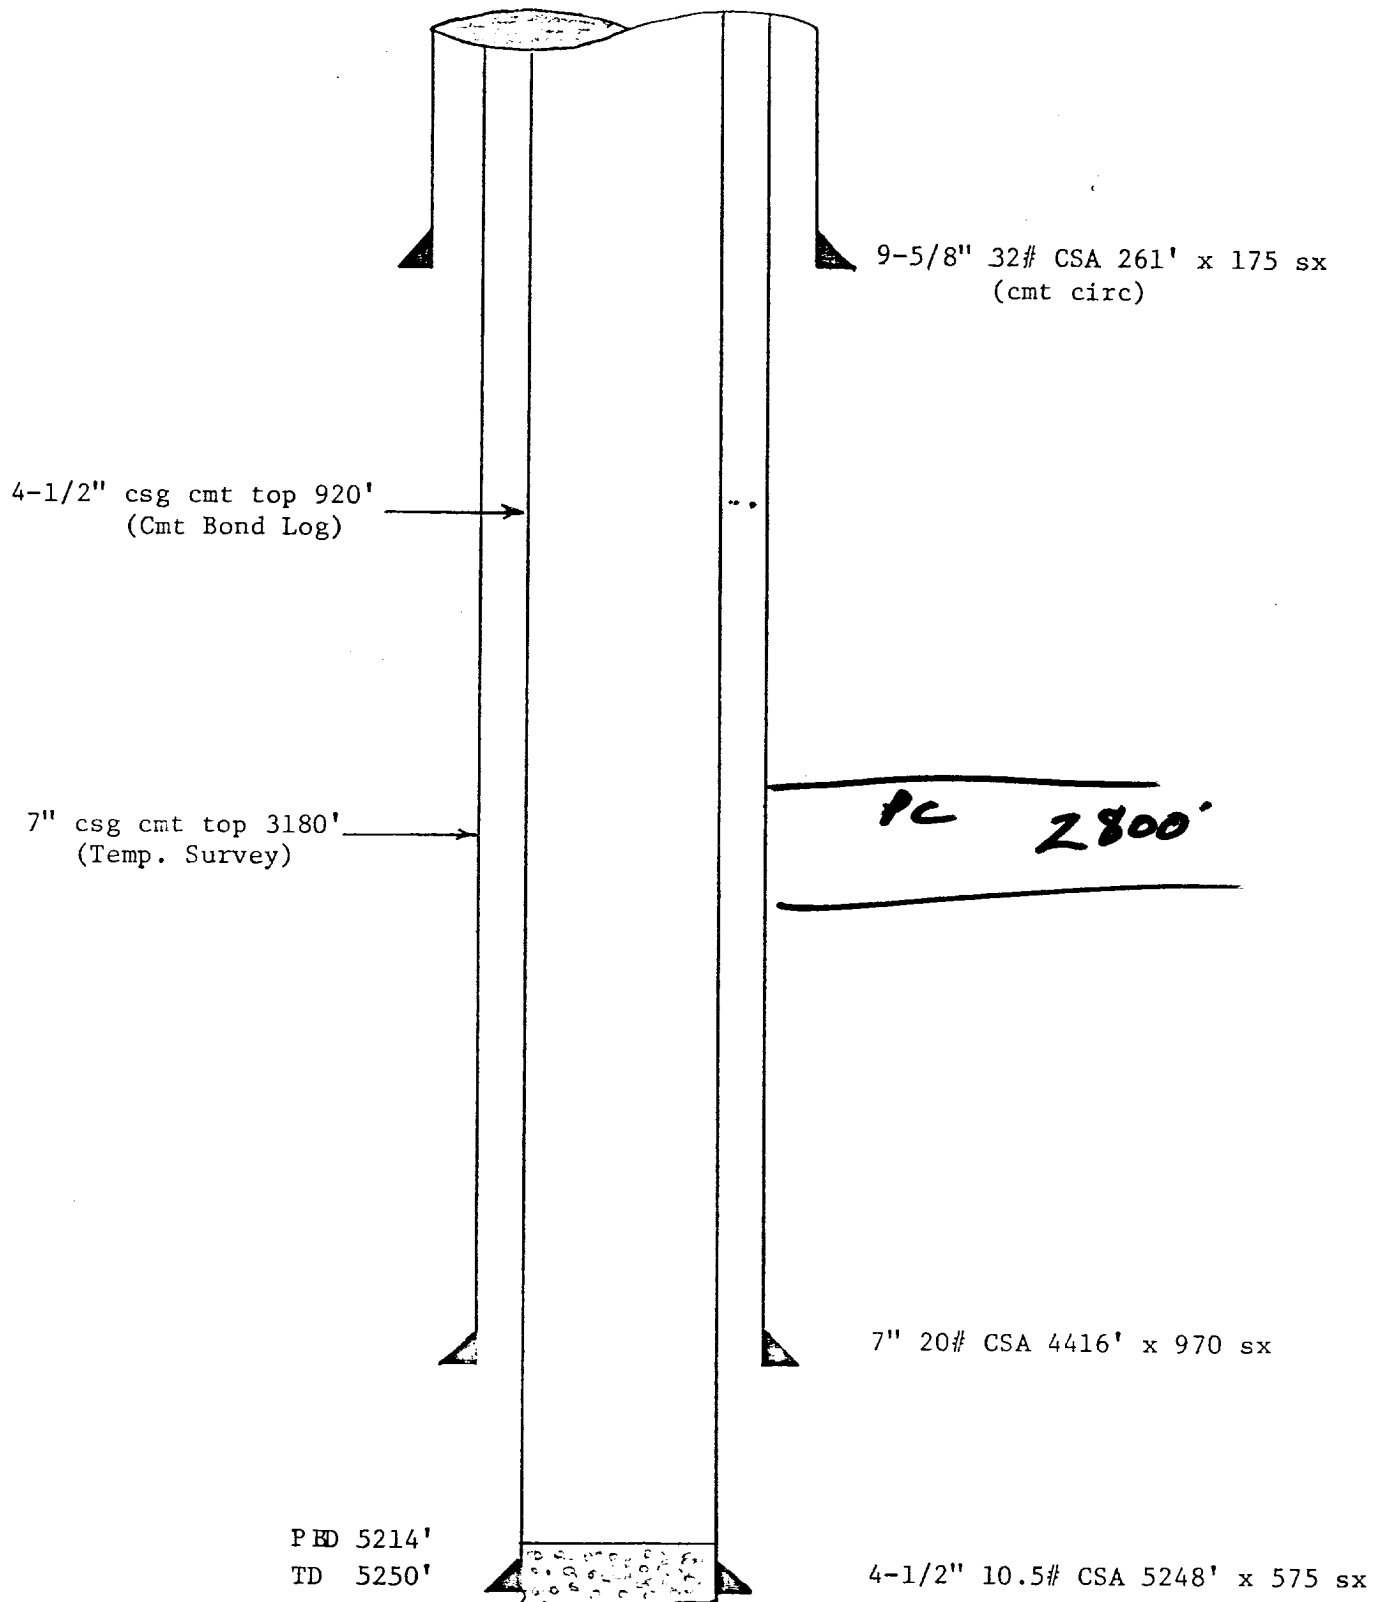

NEW MEXICO OIL CONSERVATION COMMISSION
1000 Rio Brazos Road
Aztec, New Mexico

BRADENHEAD TEST REPORT

(Submit 3 copies to above address)

Date of Test 9-5-75 Operator AMOCO PRODUCTION COMPANY

Lease Name E. E. Elliott "A" Well No. 1 Location U L Sec. 15 Twp. 30N Rge. 9W

Pressure (Shut-in or Flowing) Dwt. Casing Intermediate
~~Tubing~~ 342 Casing 342 Bradenhead 0

OPEN BRADENHEAD TO ATMOSPHERE FOR 15 MINUTES.

Intermediate
~~Bradenhead~~ Flowed:

Casing or Tubing Pressure, Dwt.

5 Min. 300

Steady Flow X

10 Min. _____

Surges _____

15 Min. _____

Down to Nothing _____

20 Min. _____

Nothing _____

25 Min. _____

Gas X

30 Min. _____

Gas & Water _____

Water _____

If Bradenhead flowed water check description below:

Clear _____

Remarks: Blew intermediate string

Fresh _____


through 1/2", intermediate flowed

Salty _____

but not the bradenhead.

Sulfur _____

Black _____

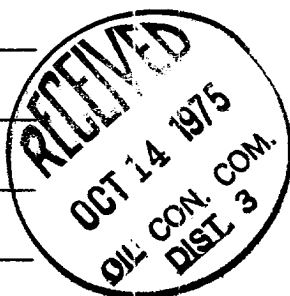

By JK Montgomery

Area Engineer
Position

Witness None