




Heater
Treater

120'

NO SPILL IN THIS AREA

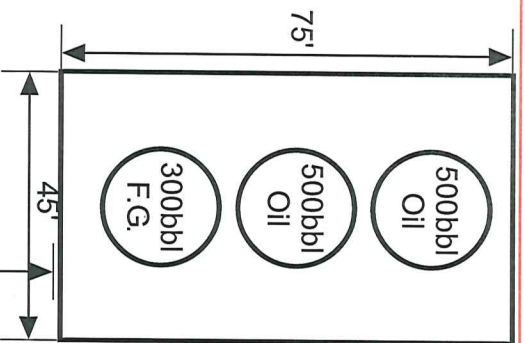

150'

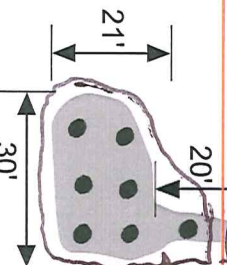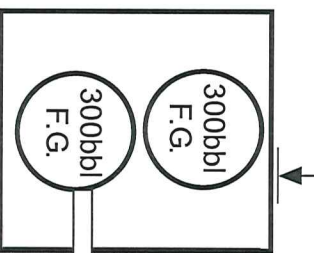

Remove soil
4' below ground level

Scrape
location
6" to 12"

North

Scale: 1" = 30'

Sample
Points

Location Border

RECEIVED
By JKeyes at 8:09 am, Apr 06, 2016

Please provide sidewall samples.

**Wattam Battery &
SWD Station**