

From: Tucker, Shelly
To: [Ben J. Arguijo](#)
Cc: [Yu, Olivia, EMNRD](#)
Subject: Re: Backfill Request - Covington A Federal 0002 (1RP-4816)
Date: Wednesday, March 21, 2018 6:14:30 AM

Thank you for the updated information. BLM concurs with NMOCD approval to backfill.

If you have any questions or concerns, please do not hesitate to contact me.

Sincerely,

Shelly J Tucker

Environmental Protection Specialist
O&G Spill/Release Coordinator

Bureau of Land Management
620 E. Greene St
Carlsbad, NM 88220

575.234.5905 - Direct
575.361.0084 - Cellular
575.234.6235 - Emergency Spill Number

stucker@blm.gov

The **BLM acceptance/approval does not** relieve the operator of liability should their operations have failed to adequately investigate and remediate contamination that may pose a threat to groundwater, surface water, human health or the environment or if the location fails to reclaim properly. In such an event that the location does not revegetate, or future issues with contaminants are encountered, the operator will be asked to address the issues until the contaminant issues are fully mitigated and the location is successfully reclaimed. In addition, BLM approval does not relieve the operator of responsibility for compliance with any other federal, state or local laws/regulations.

Confidentiality Warning: This message along with any attachments are intended only for use of the individual or entity to which it is addressed and may contain information that is privileged or confidential and exempt from disclosure under applicable law. If the reader of this message is not the intended recipient or the employee or agent responsible for delivering this message to the intended recipient, you are hereby notified that any dissemination, distribution, or copying of this communication is strictly prohibited. If you have received this communication in error, please notify the sender immediately.

On Tue, Mar 20, 2018 at 12:57 PM, Ben J. Arguijo <ben@trinityoilfieldservices.com> wrote:
Olivia/Shelly,

It was brought to my attention a little while ago that the "Sample Location Map" included with the Backfill Request lists the wrong site, RP #, and county in the title block (although the correct site *is* depicted). I evidently forgot to update that portion of the layout template, and nobody caught it before I sent it out.

An updated map with the correct site name, RP, and county is attached. I apologize for any

confusion.

Thanks.

Ben

Ben J. Arguijo
Environmental Project Manager
Trinity Oilfield Services
P.O. Box 2587
Hobbs, NM 88241
[\(575\)390-7208](tel:(575)390-7208)
ben@trinityoilfieldservices.com

On Thu, Mar 15, 2018 at 9:28 AM, Yu, Olivia, EMNRD <Olivia.Yu@state.nm.us> wrote:

Good morning Mr. Arguijo:

NMOCD grants backfill approval for 1RP-4816. Please provide photo documentation of the remedial activities, including photos of a properly keyed and situated, minimal 20 mil liner for the area represented by SP-4 and SP-5.

Like approval from BLM required.

Thanks,

Olivia

From: Ben J. Arguijo [mailto:ben@trinityoilfieldservices.com]
Sent: Monday, March 12, 2018 3:15 PM
To: Yu, Olivia, EMNRD <Olivia.Yu@state.nm.us>; Tucker, Shelly <stucker@blm.gov>
Cc: Wade Dittrich <wade_dittrich@oxy.com>; Todd Roberson <todd@trinityoilfieldservices.com>; Duskie Bennett <duskie@trinityoilfieldservice.com>
Subject: Backfill Request - Covington A Federal 0002 (1RP-4816)

Olivia/Shelly,

Attached please find the "Environmental Site Summary & Backfill Request" for the Covington A Federal 002 release site (1RP-4816).

If you have any questions, please do not hesitate to contact me.

Thank you for your time and consideration.

Respectfully,

Ben J. Arguijo

Ben J. Arguijo

Environmental Project Manager


Trinity Oilfield Services

P.O. Box 2587

Hobbs, NM 88241

[\(575\)390-7208](tel:(575)390-7208)

ben@trinityoilfieldservices.com

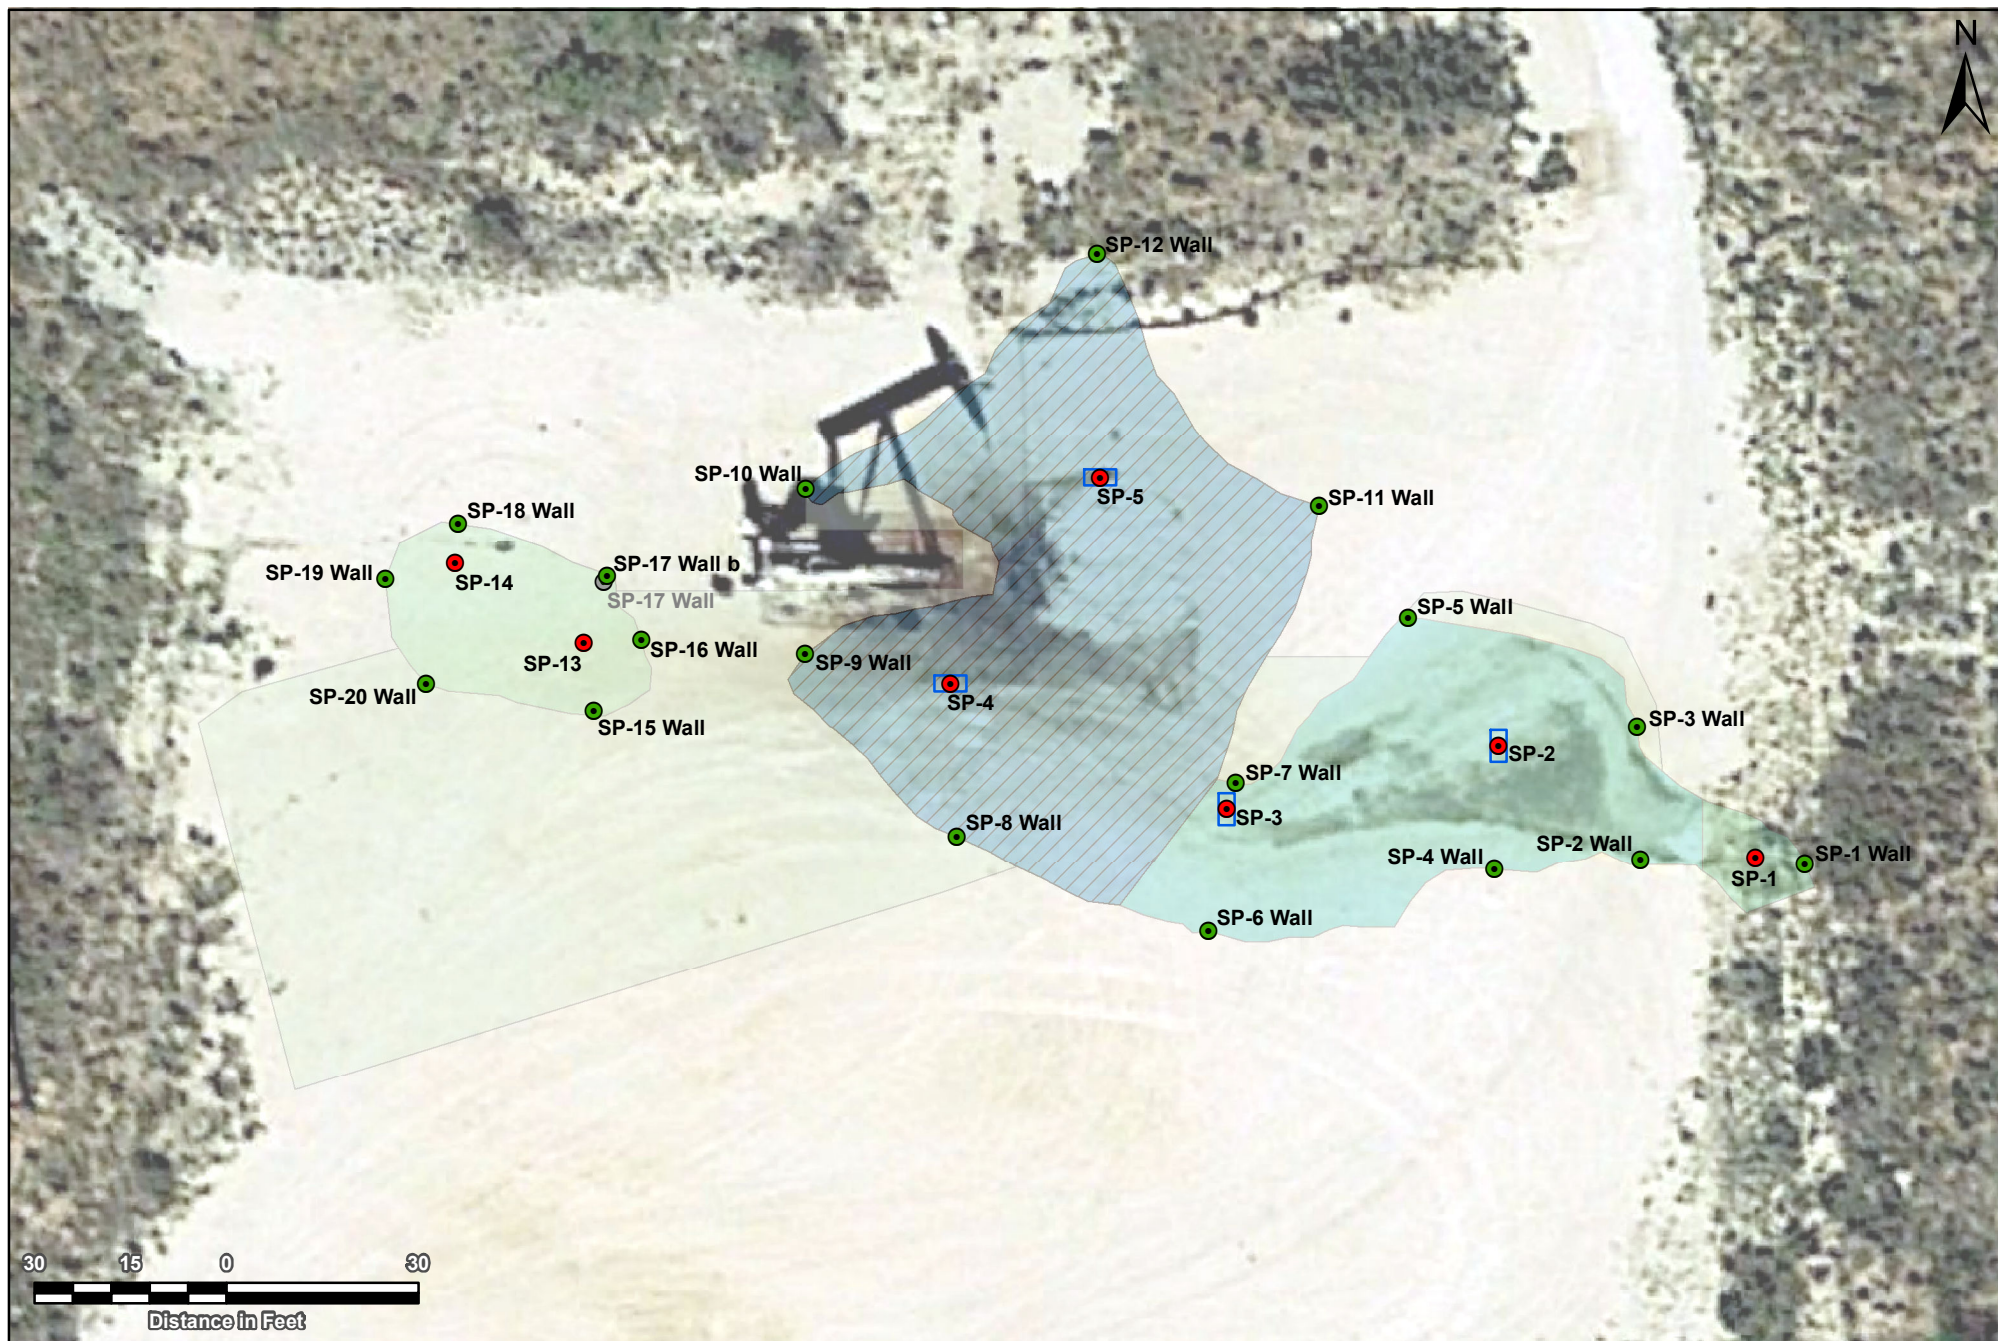

Legend	
Excavation Depth	
3" - 6" bgs	Proposed Liner
1' bgs	Delineation Trench
1.5' - 2' bgs	Auger Hole
2' bgs	Sample Location
4' bgs	Excavated Sample

Figure 2
Sample Location Map
OXY USA, Inc.
Covington A Federal 0002
Lea County, New Mexico
NMOCD Reference #: 1RP-4816



Trinity Oilfield Services & Rentals, LLC
P.O. Box 2587
Hobbs, NM 88241

Drawn By: BJA	Checked By: CTR
March 20, 2018	Scale: 1" = 30'