
State of New Mexico DISTRICT I 1623 N. FRENCH DE., HOBBS, NW 88240 Energy, Minerals & Natural Resources Department Form C-102 CONSERVATION DIVISION 1220 SOUTH ST. FRANCIS DR. DISTRICT II 811 S. FIRST ST., ARTESIA, Phone: (575) 748-1283 Pax: (575 Revised August 1, 2011 Submit one copy to appropriate DISTRICT III 1000 RIO BRAZOS RD., AZTEC, NM 57410 FB 27 2020 Phone: (505) 334-6178 Fax: (505) 334-6176 FB 27 2020 District Office Santa Fe, New Mexico 87505 DISTRICT IV ☐ AMENDED REPORT DISTRICT: IV
1220 S. ST. FRANCE DR., SANTA F., NM 67505
Phone: (606) 476-3460 Pax: (506) 476-3462
RECEIVEDATION AND ACREAGE DEDICATION PLAT
Pool Nai Pool Name 30-025-45793 98116 WC-025 G-09 S253402N; WOLFCAMP Property Code Well Number Property Name BASEBALL CAP FEDERAL COM 319803 701H OGRID No. Operator Name Elevation COG OPERATING, LLC 229137 3377.1 Surface Location Feet from the North/South line UL or lot No. Section Township Range Lot Idn Feet from the East/West line County Ρ 25 24-S 34-E 430 SOUTH 1110 **EAST** LEA Bottom Hole Location If Different From Surface UL or lot No. Section Range Lot Idn Feet from the North/South line Feet from the East/West line Township County Α 24 34-E **NORTH** 945 24-S 202 **EAST** LEA Dedicated Acres Joint or Infill Consolidation Code Order No. 320 NO ALLOWABLE WILL BE ASSIGNED TO THIS COMPLETION UNTIL ALL INTERESTS HAVE BEEN CONSOLIDATED OR A NON-STANDARD UNIT HAS BEEN APPROVED BY THE DIVISION SEE PAGE 2

PAGE 1 OF

DRAWN BY: WN

W.O. # 20-280

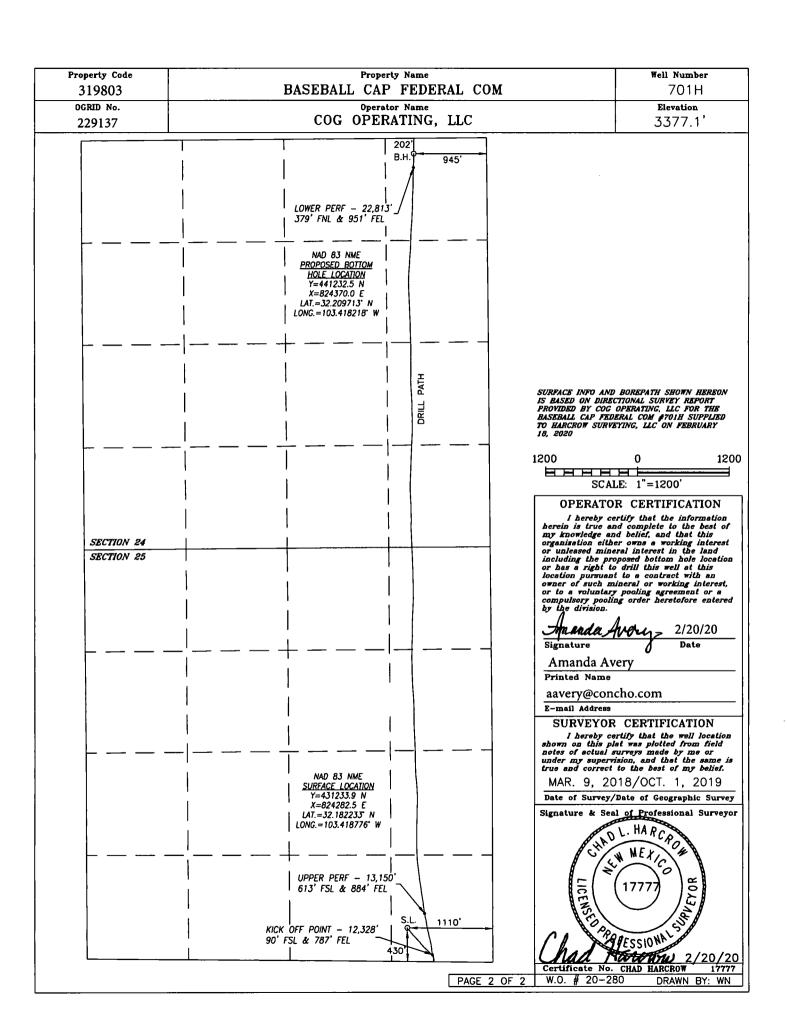

Inten	t	As Dril	led	x										
API#		_												
	)25-4579					Dro	norty A	lama					Well Number	
Operator Name: COG OPERATING, LLC						Property Name: BASEBALL CAP FEDERAL COM						N.4	701H	
COG OFERATING, LLC						BASEBALL CAP FEDERAL COM							70111	
Kick (	Kick Off Point (KOP)													
UL	Section	Township	Range	Lot	Feet		From N		Feet		n E/W	County	•	
P	25	248	34E		90	ıdo	SOU	Н	787	EAS	51	NAD NAD		
32.181283					•	Longitude NA -103.417737 83								
1.00														
First 7	First Take Point (FTP)													
UL	Section	Township	Range	Lot	Feet		From N		Feet	Fron	n E/W	County		
Р	25	248	34E		613		SOU	ГН	884	EAS	ST	LEA		
Latitude						ide 1119	NAD							
32.182727					-103.	-103.418041   83								
1 7		. /I TD\												
Last I	ake Poin	t (LIP)												
UL	Section 24	Township 24S	Range 34E	Lot	Feet 379		m N/S ORTH	Feet 951		rom E/W AST	Count	ty		
A	J	245	34E		Longitu		חואל	951		ASI	NAD			
32.209227					_	-103.418238								
Is this well the defining well for the Horizontal Spacing Unit? Yes														
Is this well an infill well?														
	If infill is yes please provide API if available, Operator Name and well number for Defining well for Horizontal Spacing Unit.													
			-											
API#														
Operator Name:						Property Name:							Well Number	

KZ 06/29/2018