

Drone Imagery Date: May 23, 2023



N

U.S. Feet

Scale 1"=60'

|  |                |                            |               |
|--|----------------|----------------------------|---------------|
| Rev. 5 - Issued for Information Updated Plan | Sept. 27, 2023 | Drafted by: Marcos Barriga | (Elite Optz.) |
| Preliminary Version 0                        |                | Reviewed by:               | (Elite Optz.) |
| Rev. 6 - Issued for Information Updated Plan | Oct. 11, 2023  | Drafted by: Marcos Barriga | (Elite Optz.) |
| Preliminary Version 0                        |                | Reviewed by:               | (Elite Optz.) |
| Rev. 7 - Issued for Information Updated Plan | Nov. 6, 2023   | Drafted by: Marcos Barriga | (Elite Optz.) |
| Preliminary Version 0                        |                | Reviewed by:               | (Elite Optz.) |
| Job. #: 21-EliteOptz-0031-Rev7               |                | Page 1 of 4                |               |


Aerial As-Built Overview of  
**Caza Petroleum, LLC.**  
Sioux 36 State 1H & 5H  
Tank Battery  
Unit D. Sec. 36, T25S, R35E  
1H (API #30-025-43752) & 5H (API #30-025-44508)



Disclaimer: This drawing is intended for Caza Petroleum, LLC. internal purposes only and is not to be relied upon as a boundary survey or to establish real property interests. Survey information shown on this drawing was gathered between the dates of: Feb. 17, 2021 and Nov. 1, 2023. Survey information was collected using a combination of GNSS observations and geo-referenced aerial drone imagery when required. Observations refer to: NAD83 (2011) Datum, New Mexico State Plane Coordinate System, East Zone (3001), US Survey Feet, CSF=0.99990909. This drawing includes additional information that was collected from various sources including first hand observations, walk-through photos when applicable and third party information as well as information provided by Caza Petroleum, LLC. Caza Petroleum, LLC. is to verify the accuracy of all information as presented on this drawing. Elite Optimization, LP. is not responsible for design by engineer of records, erection or operation of any facilities represented by this drawing. This drawing is not an official engineering drawing or land survey drawing; this drawing is not to be used for construction.



Equipment Layout Plan up to date as of: Nov. 1, 2023

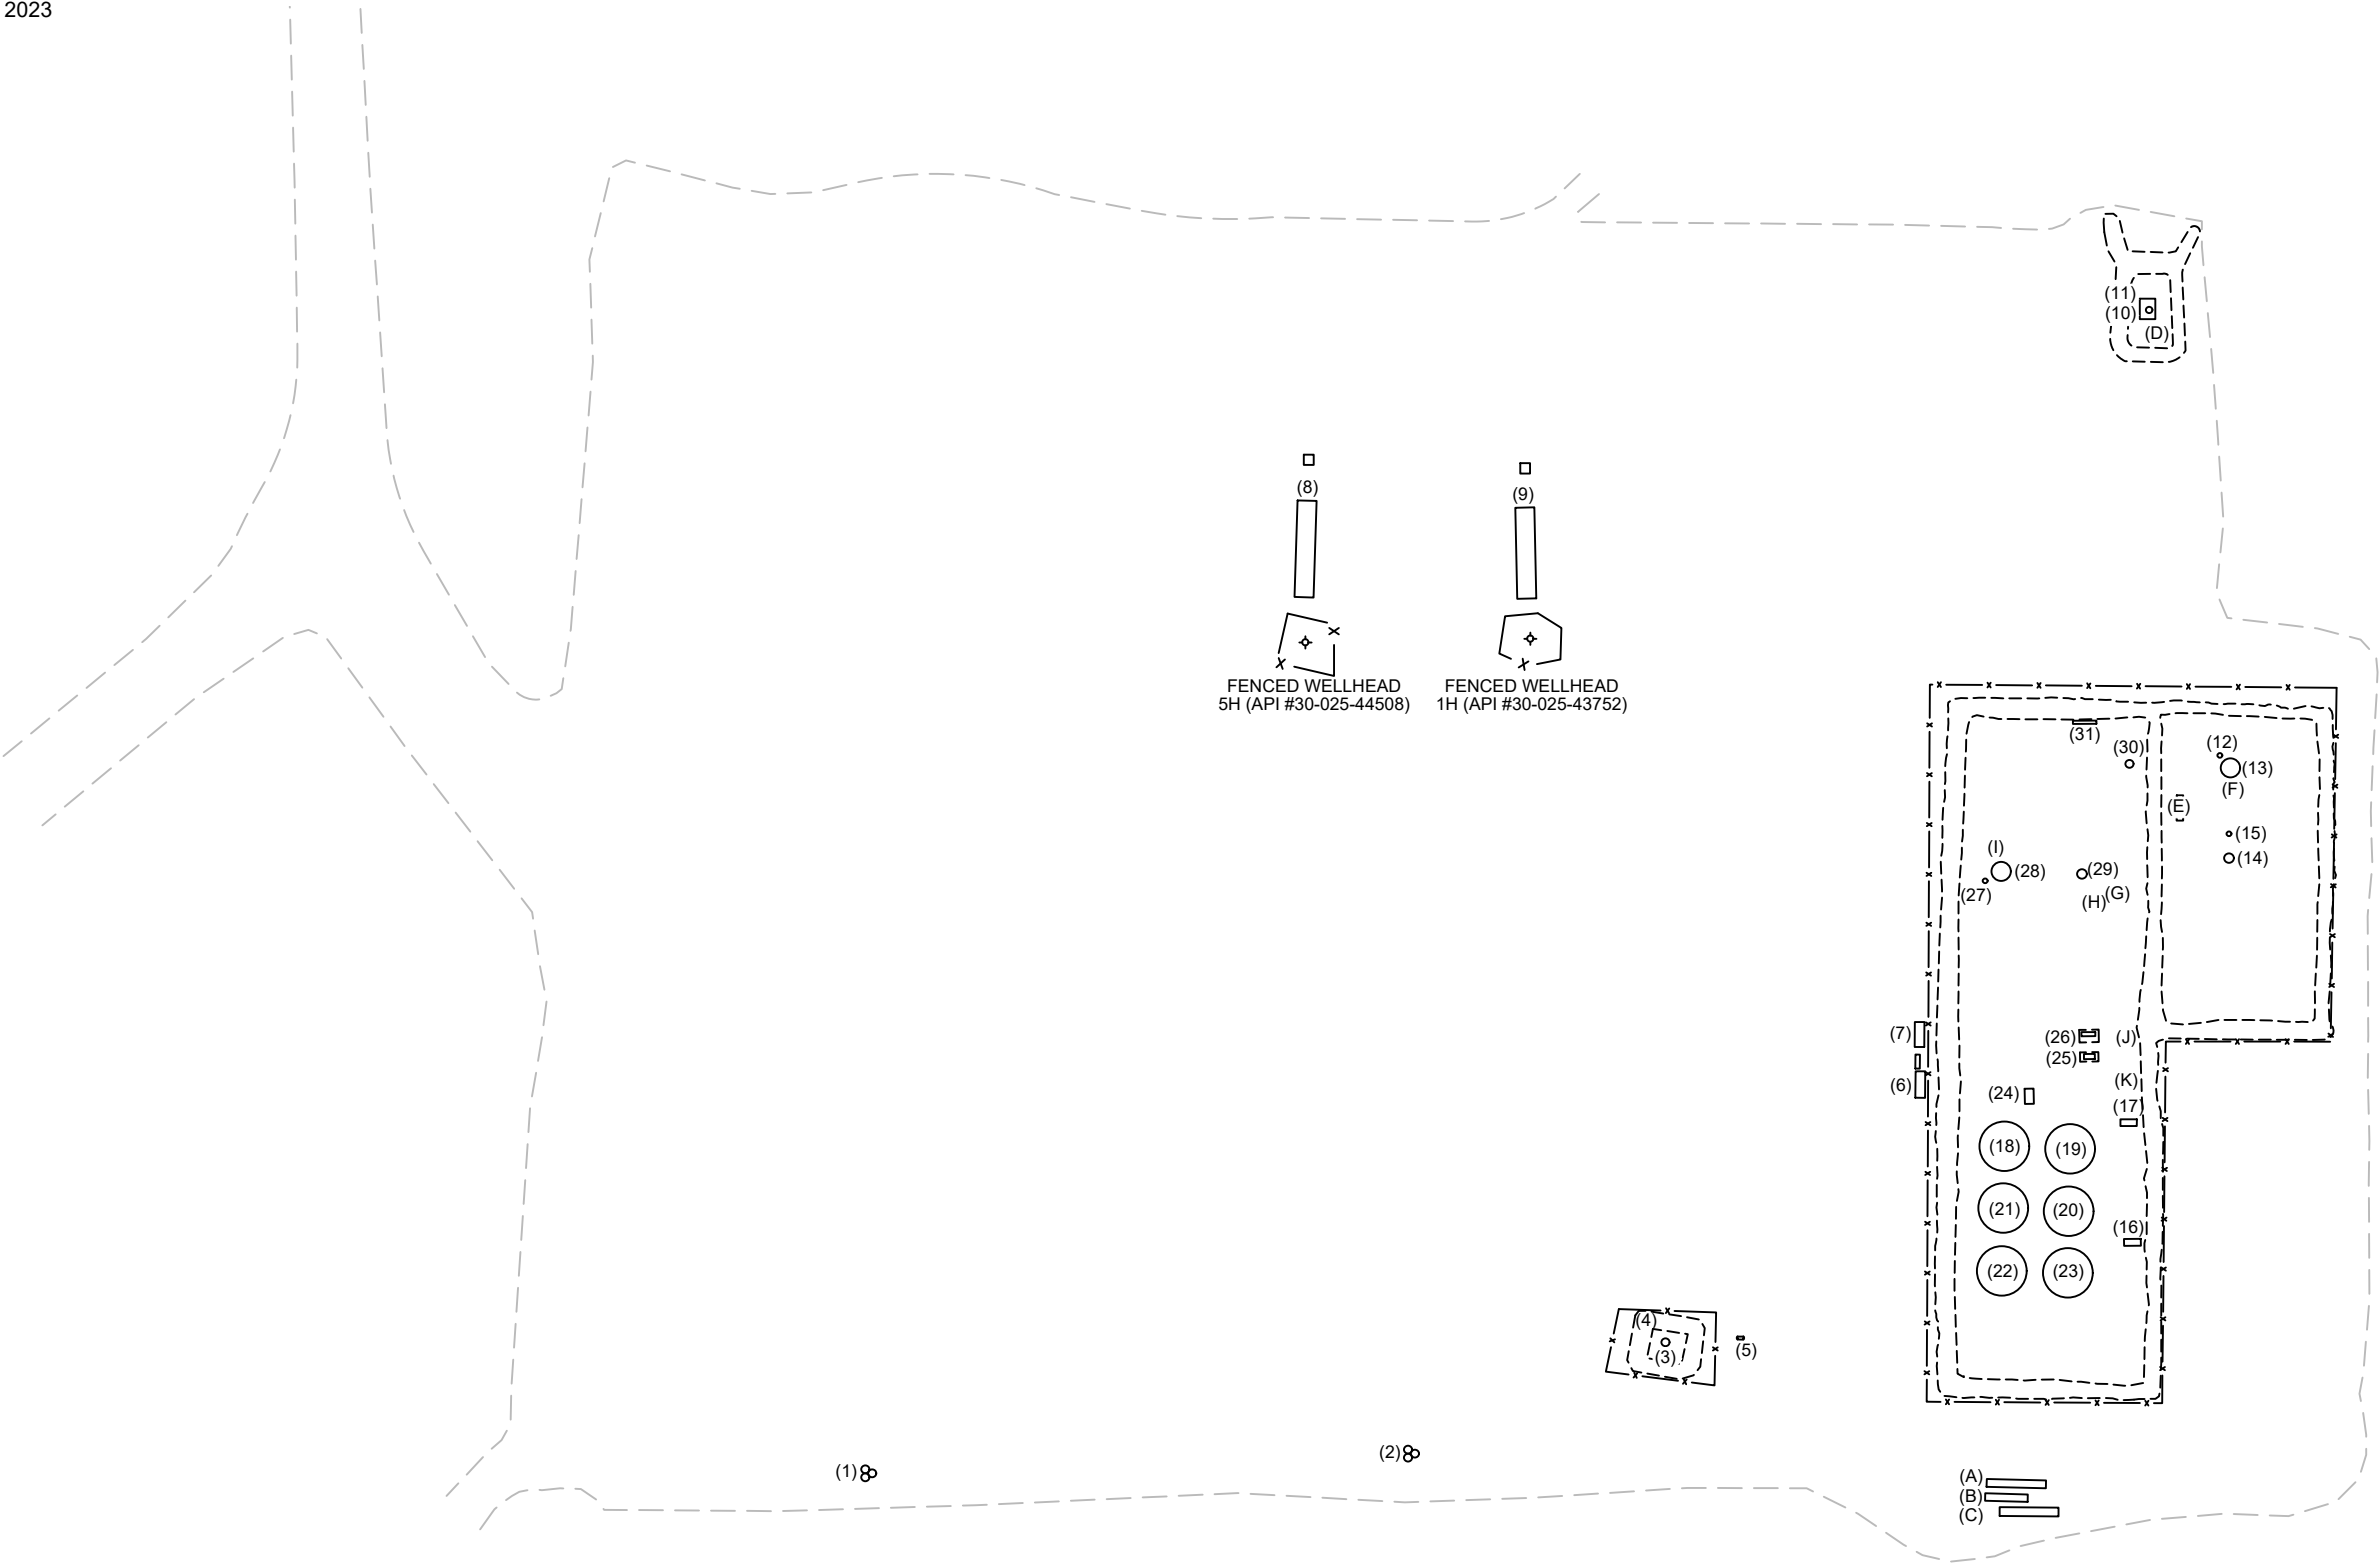

**LEGEND:**  
Berms/Containments/Skids are shown thus:.....  
Pad Edge/Approaches are shown thus:.....  
Fences are shown thus:..... x .....

N

U.S. Feet  
Scale 1"=60'

|  |                |                            |               |
|--|----------------|----------------------------|---------------|
| Rev. 5 - Issued for Information Updated Plan | Sept. 27, 2023 | Drafted by: Marcos Barriga | (Elite Optz.) |
| Preliminary Version 0                        |                | Reviewed by:               | (Elite Optz.) |
| Rev. 6 - Issued for Information Updated Plan | Oct. 11, 2023  | Drafted by: Marcos Barriga | (Elite Optz.) |
| Preliminary Version 0                        |                | Reviewed by:               | (Elite Optz.) |
| Rev. 7 - Issued for Information Updated Plan | Nov. 6, 2023   | Drafted by: Marcos Barriga | (Elite Optz.) |
| Preliminary Version 0                        |                | Reviewed by:               | (Elite Optz.) |
| Job. #: 21-EliteOptz-0031-Rev7               |                | Page 2 of 4                |               |


As-Built Equipment Layout Plan for  
Caza Petroleum, LLC.  
Sioux 36 State 1H & 5H  
Tank Battery  
Unit D. Sec. 36, T25S, R35E  
1H (API #30-025-43752) & 5H (API #30-025-44508)



Disclaimer: This drawing is intended for Caza Petroleum, LLC. internal purposes only and is not to be relied upon as a boundary survey or to establish real property interests. Survey information shown on this drawing was gathered between the dates of: Feb. 17, 2021 and Nov. 1, 2023. Survey information was collected using a combination of GNSS observations and geo-referenced aerial drone imagery when required. Observations refer to: NAD83 (2011) Datum, New Mexico State Plane Coordinate System, East Zone (3001), US Survey Feet, CSF=0.99990909. This drawing includes additional information that was collected from various sources including first hand observations, walk-through photos when applicable and third party information as well as information provided by Caza Petroleum, LLC. Caza Petroleum, LLC. is to verify the accuracy of all information as presented on this drawing. Elite Optimization, LP. is not responsible for design by engineer of records, erection or operation of any facilities represented by this drawing. This drawing is not an official engineering drawing or land survey drawing; this drawing is not to be used for construction.

| Ref. | Piece                  | Year | Manufacturer                                  | Serial No.    | Model No.                    | Dimensions          | Additional Info.              | Long.       | Lat.      |
|------|------------------------|------|---|---------------|------------------------------|---------------------|-------------------------------|-------------|-----------|
| 1    | Transformer (No Meter) | --   | --  | --            | --                           | --                  | (3) 37.5 kVa                  | -103.329133 | 32.093246 |
| 2    | Transformer (No Meter) | --   | --  | No Meter      | --                           | --                  | (3) 75 kVA                    | -103.328506 | 32.093196 |
| 3    | Combustor              | --   | --  | N/A           | --                           | --                  | --                            | -103.328327 | 32.093355 |
| 4    | Flare Control          | --   | Ignition Management System / Platinum Control | 2019042200055 | Edge-600                     | --                  | --                            | -103.328340 | 32.093368 |
| 5    | Jatco Pot              | --   | Jatco Inc.                                    | N/A           | J-5000CX                     | --                  | --                            | -103.328248 | 32.093354 |
| 6    | Elec. Panel            | --   | --  | --            | --                           | --                  | South Panel                   | -103.328069 | 32.093573 |
| 7    | Elec. Panel            | --   | --  | --            | --                           | --                  | North Panel                   | -103.328068 | 32.093618 |
| 8    | Pumping Unit           | 2019 | Artificial Lift Machinery                     | SLS19-1079    | C12000-305-240TH             | --                  | --                            | -103.328678 | 32.094037 |
| 9    | Pumping Unit           | 2017 | Precision Transmissions                       | AT17-0231     | C9120-365-192TH              | --                  | --                            | -103.328458 | 32.094031 |
| 10   | Flare - HP             | --   | Wenco Energy Corp.                            | 0218-86       | 700-TIL-603-D-31C            | --                  | --                            | -103.327831 | 32.094238 |
| 11   | Flare Control          | --   | Ignition Management System / Platinum Control | 2019082600020 | Edge-600                     | --                  | --                            | -103.327852 | 32.094267 |
| 12   | Fuel Pot               | --   | --  | --            | --                           | --                  | Heater Treater EMT-1245       | -103.327756 | 32.093862 |
| 13   | Vert. Heater Treater   | 2016 | Edge Manufacturing                            | EMT-1245      | --                           | 6 x 20              | WP 125 psi, 5H Well           | -103.327752 | 32.093843 |
| 14   | Vert. Separator        | 2023 | Pessco  | 2516          | --                           | 6 x 10              | WP 250 TP 325                 | -103.327754 | 32.093766 |
| 15   | Fuel Pot               | --   | --  | --            | --                           | --                  | Scrubber 02516                | -103.327754 | 32.093786 |
| 16   | Pump - Recycle         | --   | --  | No Tag.       | --                           | --                  | 1.5HP                         | -103.327862 | 32.093437 |
| 17   | Pump - Transfer        | --   | Centripump                                    | 170235321     | MTX                          | --                  | 1.5x3-10, 40HP                | -103.327858 | 32.093539 |
| 18   | Tank                   | 2017 | Azteca Fabrication                            | CA1869        | --                           | 15.5 x 16 - 500 BBL | --                            | -103.327982 | 32.093522 |
| 19   | Tank                   | 2017 | Azteca Fabrication                            | CA1868        | --                           | 15.5 x 16 - 500 BBL | --                            | -103.327915 | 32.093519 |
| 20   | Tank                   | 2017 | Azteca Fabrication                            | CA1872        | --                           | 15.5 x 16 - 500 BBL | --                            | -103.327922 | 32.093466 |
| 21   | Tank                   | 2017 | Azteca Fabrication                            | CA1871        | --                           | 15.5 x 16 - 500 BBL | --                            | -103.327987 | 32.093469 |
| 22   | Tank                   | 2017 | Azteca Fabrication                            | CA1873        | --                           | 15.5 x 16 - 500 BBL | --                            | -103.327986 | 32.093414 |
| 23   | Tank                   | 2017 | Azteca Fabrication                            | CA1870        | --                           | 15.5 x 16 - 500 BBL | --                            | -103.327922 | 32.093409 |
| 24   | Oxygen Tank            | --   | --  | N/A           | --                           | --                  | --                            | -103.327959 | 32.093561 |
| 25   | Recycle Pump           | --   | Gorman-Rupp                                   | 1654277       | GMS 1/2GH3-B /S2             | --                  | 1.5 HP                        | -103.327895 | 32.093597 |
| 26   | Pump - Transfer        | --   | Summit  | 02003819-1    | 2196 STO                     | --                  | 1x3-6                         | -103.327896 | 32.093614 |
| 27   | Fuel Pot               | --   | --  | --            | --                           | --                  | Heater Treater CA1875         | -103.328001 | 32.093745 |
| 28   | Vert. Heater Treater   | 2017 | Azteca Fabrication                            | CA1875        | --                           | --                  | MAWP 125 psi @ 120 F, 1H Well | -103.327985 | 32.093756 |
| 29   | Vert. Separator        | 2023 | Pessco  | 2515          | --                           | 30 x 10             | WP 250, TP 325                | -103.327903 | 32.093754 |
| 30   | Scrubber               | 2007 | Permian Tank                                  | 26368         | --                           | 30 x 10             | WP 125 psi, 2PH               | -103.327856 | 32.093848 |
| 31   | Inlet Header           | --   | --  | N/A           | --                           | --                  | --                            | -103.327898 | 32.093881 |
| A    | Meter - Gas            | --   | Daniel  | 160000115     | --                           | --                  | ABB T173894190                | -103.327973 | 32.093231 |
| B    | Meter - Gas            | --   | Daniel  | 150085706     | --                           | --                  | ABB T173995299                | -103.327981 | 32.093218 |
| C    | Meter - Gas            | --   | Daniel  | 160141964     | --                           | --                  | ABB T194288663                | -103.327972 | 32.093205 |
| D    | Meter - Flare          | --   | Turbines Inc.                                 | Not Available | --                           | --                  | Decommissioned (top missing)  | -103.327834 | 32.094209 |
| E    | Meter - Gas            | --   | Precision Solo Flow                           | SF19615       | Precision 14.3               | --                  | ABB T180609895                | -103.327797 | 32.093812 |
| F    | Meter - Oil            | --   | Micromotion                                   | 3439558       | --                           | --                  | --                            | -103.327740 | 32.093830 |
| G    | Meter - Water          | --   | Rosemount                                     | 14921618      | 8750WDMT2M1FTSA020CA1/Z5M4G1 | --                  | --                            | -103.327867 | 32.093737 |
| H    | Meter - Water          | --   | NuFlo   | 12184365005   | --                           | --                  | --                            | -103.327884 | 32.093729 |
| I    | Meter - Oil            | --   | Endress + Hauser                              | TA0C1716000   | --                           | --                  | Heater Treater CA1875         | -103.327987 | 32.093767 |
| J    | Meter - Oil            | 2018 | Yokogawa                                      | S5U509521 821 | AXR100C                      | --                  | --                            | -103.327866 | 32.093615 |
| K    | Meter - Water          | --   | Rosemount                                     | 12175116      | 8732EMT2M1N5DA1M4            | --                  | --                            | -103.327866 | 32.093568 |

|                                |                                 |                |                            |               |   |  |   |
|--------------------------------|---------------------------------|----------------|----------------------------|---------------|---|--|---|
|                                | Rev. 5 - Issued for Information | Sept. 27, 2023 | Drafted by: Marcos Barriga | (Elite Optz.) | <div>As-Built Equipment &amp; Meter List for<br/>Caza Petroleum, LLC.<br/>Sioux 36 State 1H &amp; 5H<br/>Tank Battery<br/>Unit D. Sec. 36, T25S, R35E<br/>1H (API #30-025-43752) &amp; 5H (API #30-025-44508)</div> | <div></div> | <div>Disclaimer: This drawing is intended for Caza Petroleum, LLC. internal purposes only and is not to be relied upon as a boundary survey or to establish real property interests. Survey information shown on this drawing was gathered between the dates of: Feb. 17, 2021 and Nov. 1, 2023.<br/>Survey information was collected using a combination of GNSS observations and geo-referenced aerial drone imagery when required. Observations refer to: NAD83 (2011) Datum, New Mexico State Plane Coordinate System, East Zone (3001), US Survey Feet, CSF=0.99990909<br/>This drawing includes additional information that was collected from various sources including first hand observations, walk-through photos when applicable and third party information as well as information provided by Caza Petroleum, LLC.<br/>Caza Petroleum, LLC. is to verify the accuracy of all information as presented on this drawing. Elite Optimization, LP. is not responsible for design by engineer of records, erection or operation of any facilities represented by this drawing.<br/>This drawing is not an official engineering drawing or land survey drawing; this drawing is not to be used for construction.</div> |
|                                | Updated Plan                    |                | Reviewed by:               | (Elite Optz.) |   |  |   |
|                                | Preliminary Version 0           |                | Approved by:               | (Caza Petro.) |   |  |   |
|                                | Rev. 6 - Issued for Information | Oct. 11, 2023  | Drafted by: Marcos Barriga | (Elite Optz.) |   |  |   |
|                                | Updated Plan                    |                | Reviewed by:               | (Elite Optz.) |   |  |   |
|                                | Preliminary Version 0           |                | Approved by:               | (Caza Petro.) |   |  |   |
|                                | Rev. 7 - Issued for Information | Nov. 6, 2023   | Drafted by: Marcos Barriga | (Elite Optz.) |   |  |   |
|                                | Updated Plan                    |                | Reviewed by:               | (Elite Optz.) |   |  |   |
|                                | Preliminary Version 0           |                | Approved by:               | (Caza Petro.) |   |  |   |
| Job. #: 21-EliteOptz-0031-Rev7 |                                 |                |                            | Page 3 of 4   |   |  |   |

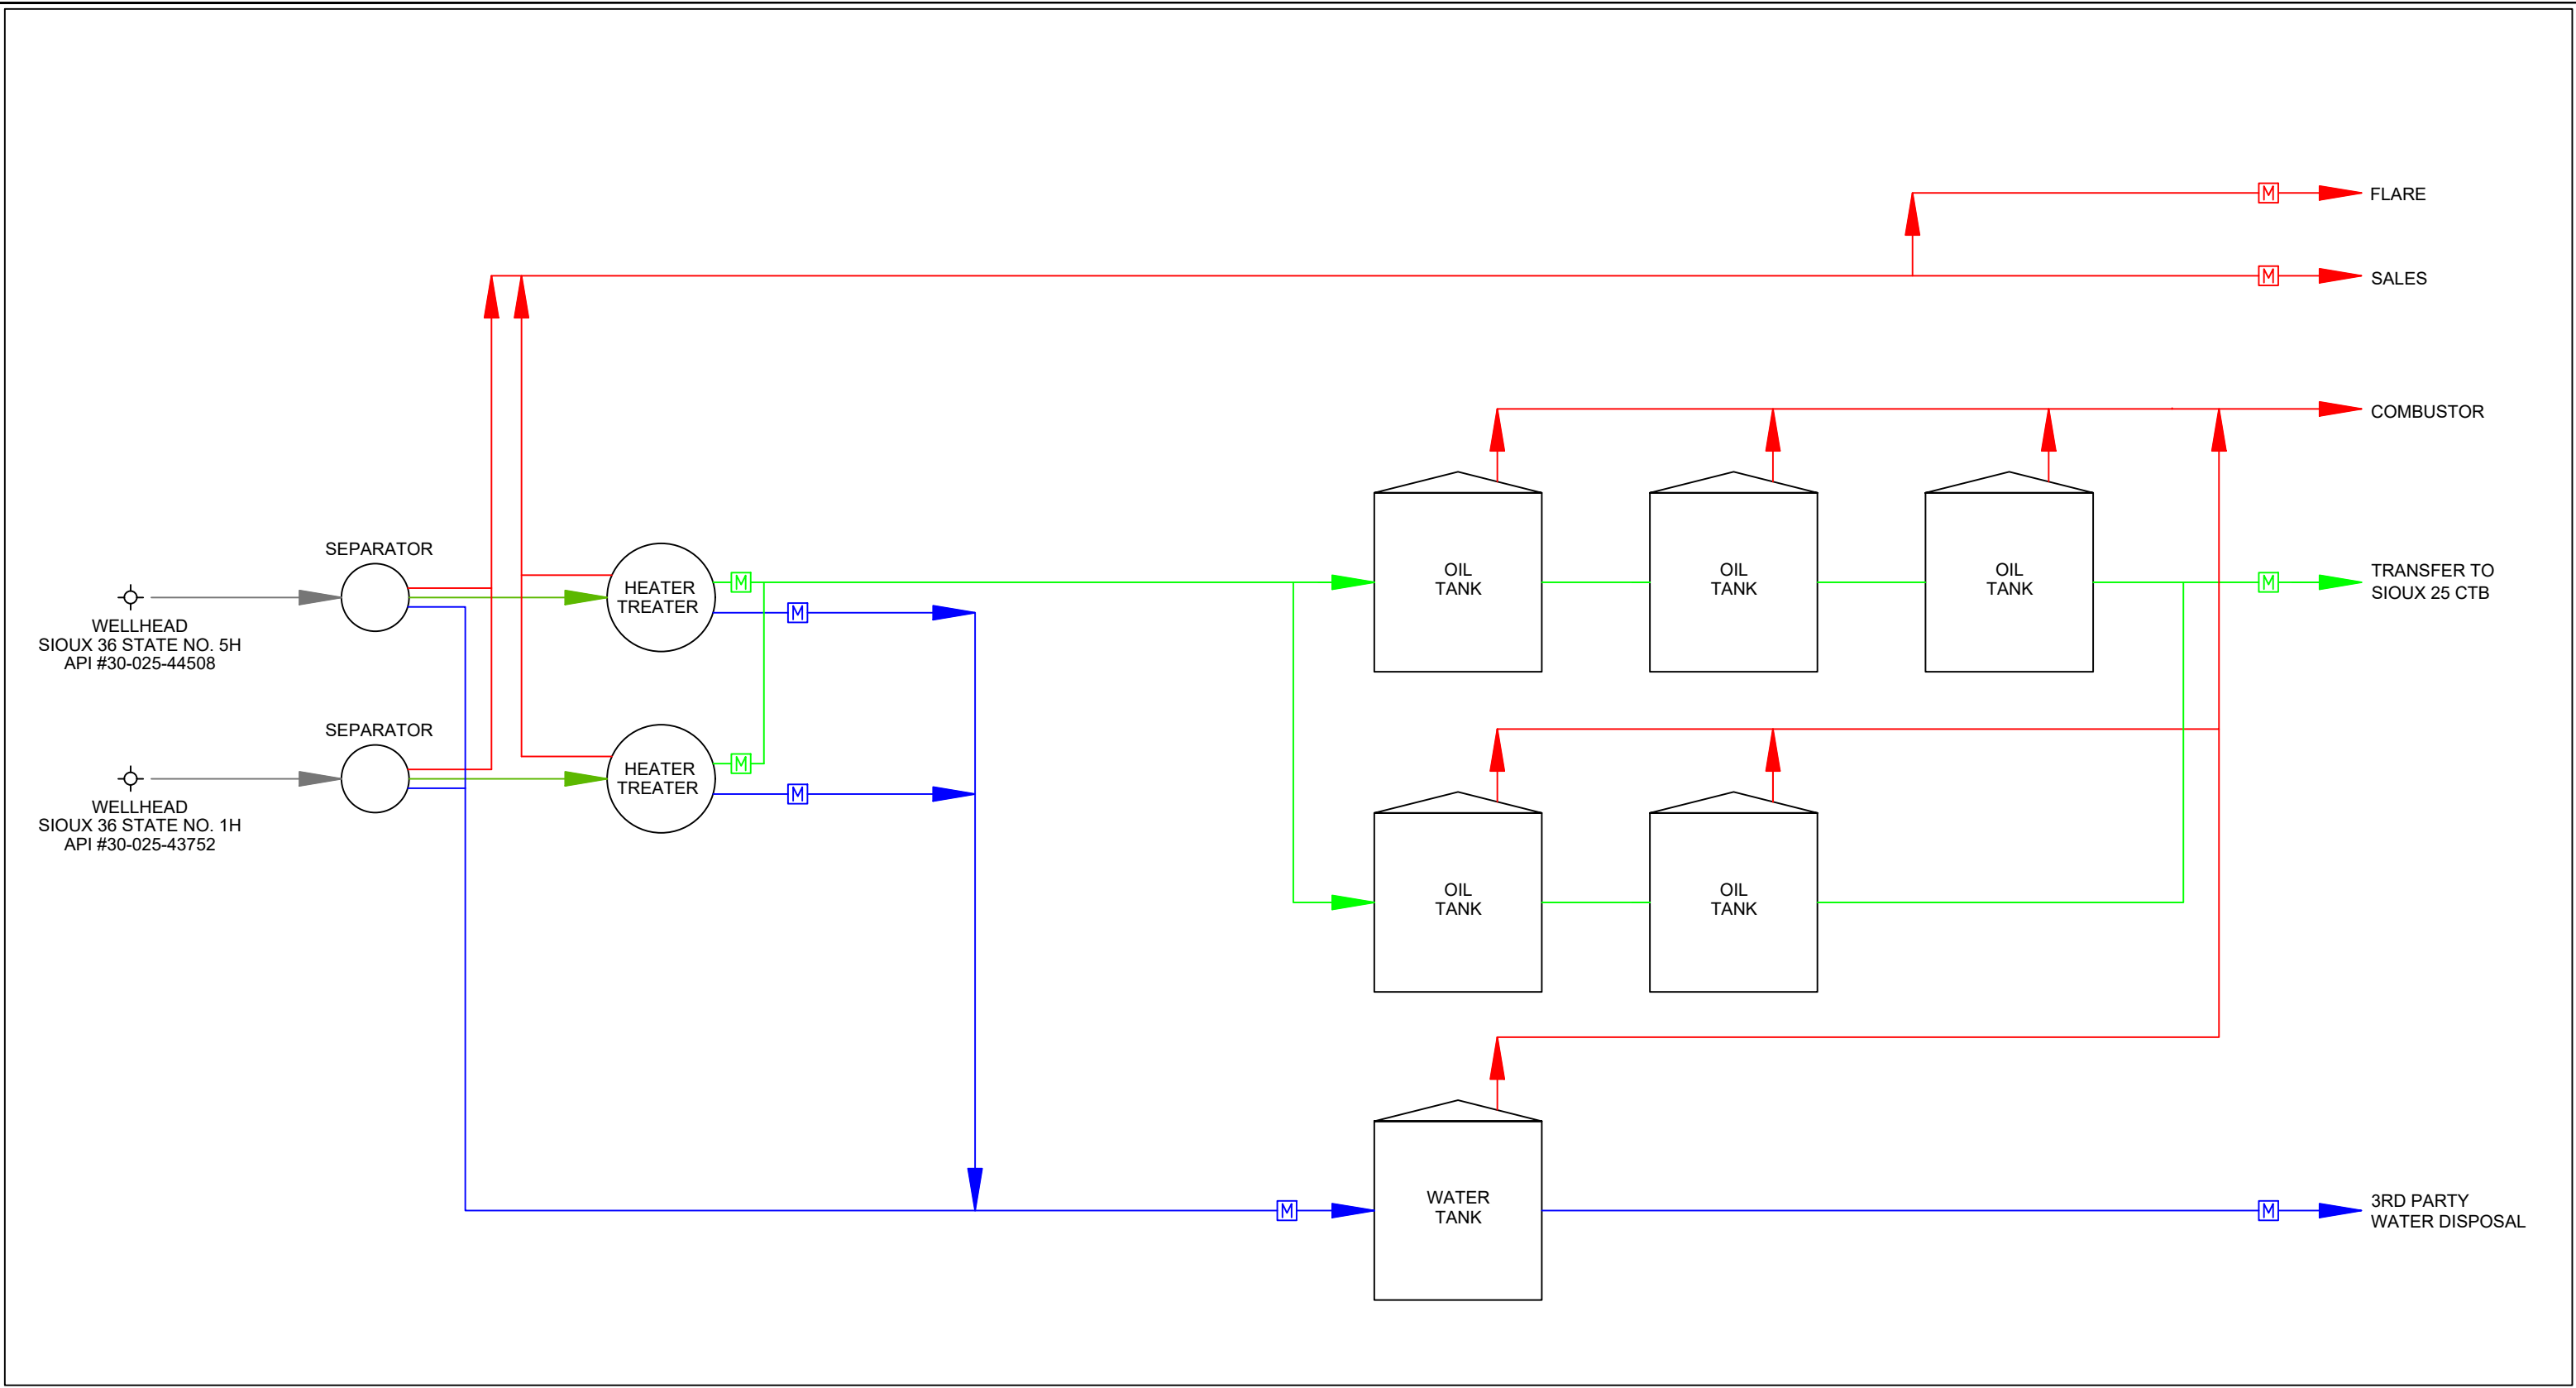

**LEGEND:**

Wellstream is shown thus:.....

Gas is shown thus:.....

Oil is shown thus:.....

Water is shown thus:.....

Oil & Water / Bad Oil is shown thus:.....

Gas Meter is shown thus:.....

Oil Meter is shown thus:.....

Water Meter is shown thus:.....

|                                 |                |                            |               |
|---------------------------------|----------------|----------------------------|---------------|
| Rev. 5 - Issued for Information | Sept. 27, 2023 | Drafted by: Marcos Barriga | (Elite Optz.) |
| Updated Plan                    |                | Reviewed by:               | (Elite Optz.) |
| Preliminary Version 0           |                | Approved by:               | (Caza Petro.) |
| Rev. 6 - Issued for Information | Oct. 11, 2023  | Drafted by: Marcos Barriga | (Elite Optz.) |
| Updated Plan                    |                | Reviewed by:               | (Elite Optz.) |
| Preliminary Version 0           |                | Approved by:               | (Caza Petro.) |
| Rev. 7 - Issued for Information | Nov. 6, 2023   | Drafted by: Marcos Barriga | (Elite Optz.) |
| Updated Plan                    |                | Reviewed by:               | (Elite Optz.) |
| Preliminary Version 0           |                | Approved by:               | (Caza Petro.) |

Job. #: 21-EliteOptz-0031-Rev7

Page 4 of 4

**As-Built Process Flow Diagram for**  
**Caza Petroleum, LLC.**  
Sioux 36 State 1H & 5H  
Tank Battery  
Unit D. Sec. 36, T25S, R35E  
1H (API #30-025-43752) & 5H (API #30-025-44508)

Disclaimer: This drawing is intended for Caza Petroleum, LLC. internal purposes only and is not to be relied upon as a boundary survey or to establish real property interests. Survey information shown on this drawing was gathered between the dates of: Feb. 17, 2021 and Nov. 1, 2023. Survey information was collected using a combination of GNSS observations and geo-referenced aerial drone imagery when required. Observations refer to: NAD83 (2011) Datum, New Mexico State Plane Coordinate System, East Zone (3001), US Survey Feet, CSF=0.99990909. This drawing includes additional information that was collected from various sources including first hand observations, walk-through photos when applicable and third party information as well as information provided by Caza Petroleum, LLC. Caza Petroleum, LLC. is to verify the accuracy of all information as presented on this drawing. Elite Optimization, LP. is not responsible for design by engineer of records, erection or operation of any facilities represented by this drawing. This drawing is not an official engineering drawing or land survey drawing; this drawing is not to be used for construction.

**District I**  
1625 N. French Dr., Hobbs, NM 88240  
Phone:(575) 393-6161 Fax:(575) 393-0720  
**District II**  
811 S. First St., Artesia, NM 88210  
Phone:(575) 748-1283 Fax:(575) 748-9720  
**District III**  
1000 Rio Brazos Rd., Aztec, NM 87410  
Phone:(505) 334-6178 Fax:(505) 334-6170  
**District IV**  
1220 S. St Francis Dr., Santa Fe, NM 87505  
Phone:(505) 476-3470 Fax:(505) 476-3462

State of New Mexico  
Energy, Minerals and Natural Resources  
Oil Conservation Division  
1220 S. St Francis Dr.  
Santa Fe, NM 87505

QUESTIONS  
  
Action 392484

QUESTIONS

|   |   |
|---|---|
| Operator:<br>CAZA OPERATING, LLC<br>200 N Loraine St<br>Midland, TX 79701 | OGRID:<br>249099                                  |
|   | Action Number:<br>392484                          |
|   | Action Type:<br>[UF-FAC] TB Registration (TB-REG) |

QUESTIONS

|  |  |
|--|--|
| Facility Details                               |  |
| Please answer all the questions in this group. |  |
| Name of the facility                           | Sioux 36 State 1H-5H Production Facility |
| Date the facility was opened                   | 10/12/2017                               |
| Depth to ground water, if known                | Not answered.                            |

|  |    |
|--|----|
| Verification   |    |
| Does the operator have other facilities with a matching name   | No |
| Are there other facilites located within approximately 50 feet | No |

**District I**  
1625 N. French Dr., Hobbs, NM 88240  
Phone:(575) 393-6161 Fax:(575) 393-0720  
**District II**  
811 S. First St., Artesia, NM 88210  
Phone:(575) 748-1283 Fax:(575) 748-9720  
**District III**  
1000 Rio Brazos Rd., Aztec, NM 87410  
Phone:(505) 334-6178 Fax:(505) 334-6170  
**District IV**  
1220 S. St Francis Dr., Santa Fe, NM 87505  
Phone:(505) 476-3470 Fax:(505) 476-3462

**State of New Mexico**  
**Energy, Minerals and Natural Resources**  
**Oil Conservation Division**  
**1220 S. St Francis Dr.**  
**Santa Fe, NM 87505**

ACKNOWLEDGMENTS  
  
Action 392484

ACKNOWLEDGMENTS

|   |   |
|---|---|
| Operator:<br>CAZA OPERATING, LLC<br>200 N Loraine St<br>Midland, TX 79701 | OGRID:<br>249099                                  |
|   | Action Number:<br>392484                          |
|   | Action Type:<br>[UF-FAC] TB Registration (TB-REG) |

ACKNOWLEDGMENTS

|                                     |  |
|-------------------------------------|--|
| <input checked="" type="checkbox"/> | I certify that I am authorized to register a facility on behalf of the responsible operator. |
| <input checked="" type="checkbox"/> | I certify that I will notify OCD of any changes of ownership for this facility.              |
| <input checked="" type="checkbox"/> | I certify that I will notify OCD when this facility is closed.                               |