

Drone Imagery Date: May. 22, 2022



U.S. Feet  
Scale 1"=50'

Rev. 1 - Issued for Information Updated Plan	Mar. 23, 2023	Drafted by: Marcos Barriga	(Elite Optz.)
Preliminary Version 1	Apr. 12, 2023	Reviewed by: LaVerne Woroschuk	(Elite Optz.)
Rev. 2 - Issued for Information Updated Plan	June 6, 2023	Approved by:	(Caza Petro.)
Preliminary Version 0		Drafted by: Marcos Barriga	(Elite Optz.)
Rev. 3 - Issued for Information Updated Plan	Oct. 12, 2023	Reviewed by:	(Elite Optz.)
Preliminary Version 3		Approved by:	(Caza Petro.)
Job. #: 22-EliteOptz-0010-Rev3		Page 1 of 4	

Aerial As-Built Overview of  
Caza Petroleum, LLC.  
Lynch 8212 JV-P #1  
API #30-025-28743  
Tank Battery




Disclaimer: This drawing is intended for Caza Petroleum, LLC. internal purposes only and is not to be relied upon as a boundary survey or to establish real property interests. Survey information shown on this drawing was gathered between the dates of: May 22, 2022 and Oct. 5, 2023. Survey information was collected using a combination of GNSS observations and geo-referenced aerial drone imagery when required. Observations refer to: NAD83 (2011) Datum, New Mexico State Plane Coordinate System, East Zone (3001), US Survey Feet, CSF=0.99990909. This drawing includes additional information that was collected from various sources including first hand observations, walk-through photos when applicable and third party information as well as information provided by Caza Petroleum, LLC. Caza Petroleum, LLC. is to verify the accuracy of all information as presented on this drawing. Elite Optimization, LP. is not responsible for design by engineer of records, erection or operation of any facilities represented by this drawing. This drawing is not an official engineering drawing or land survey drawing; this drawing is not to be used for construction.





Equipment Layout Plan up to date as of: Oct. 5, 2023

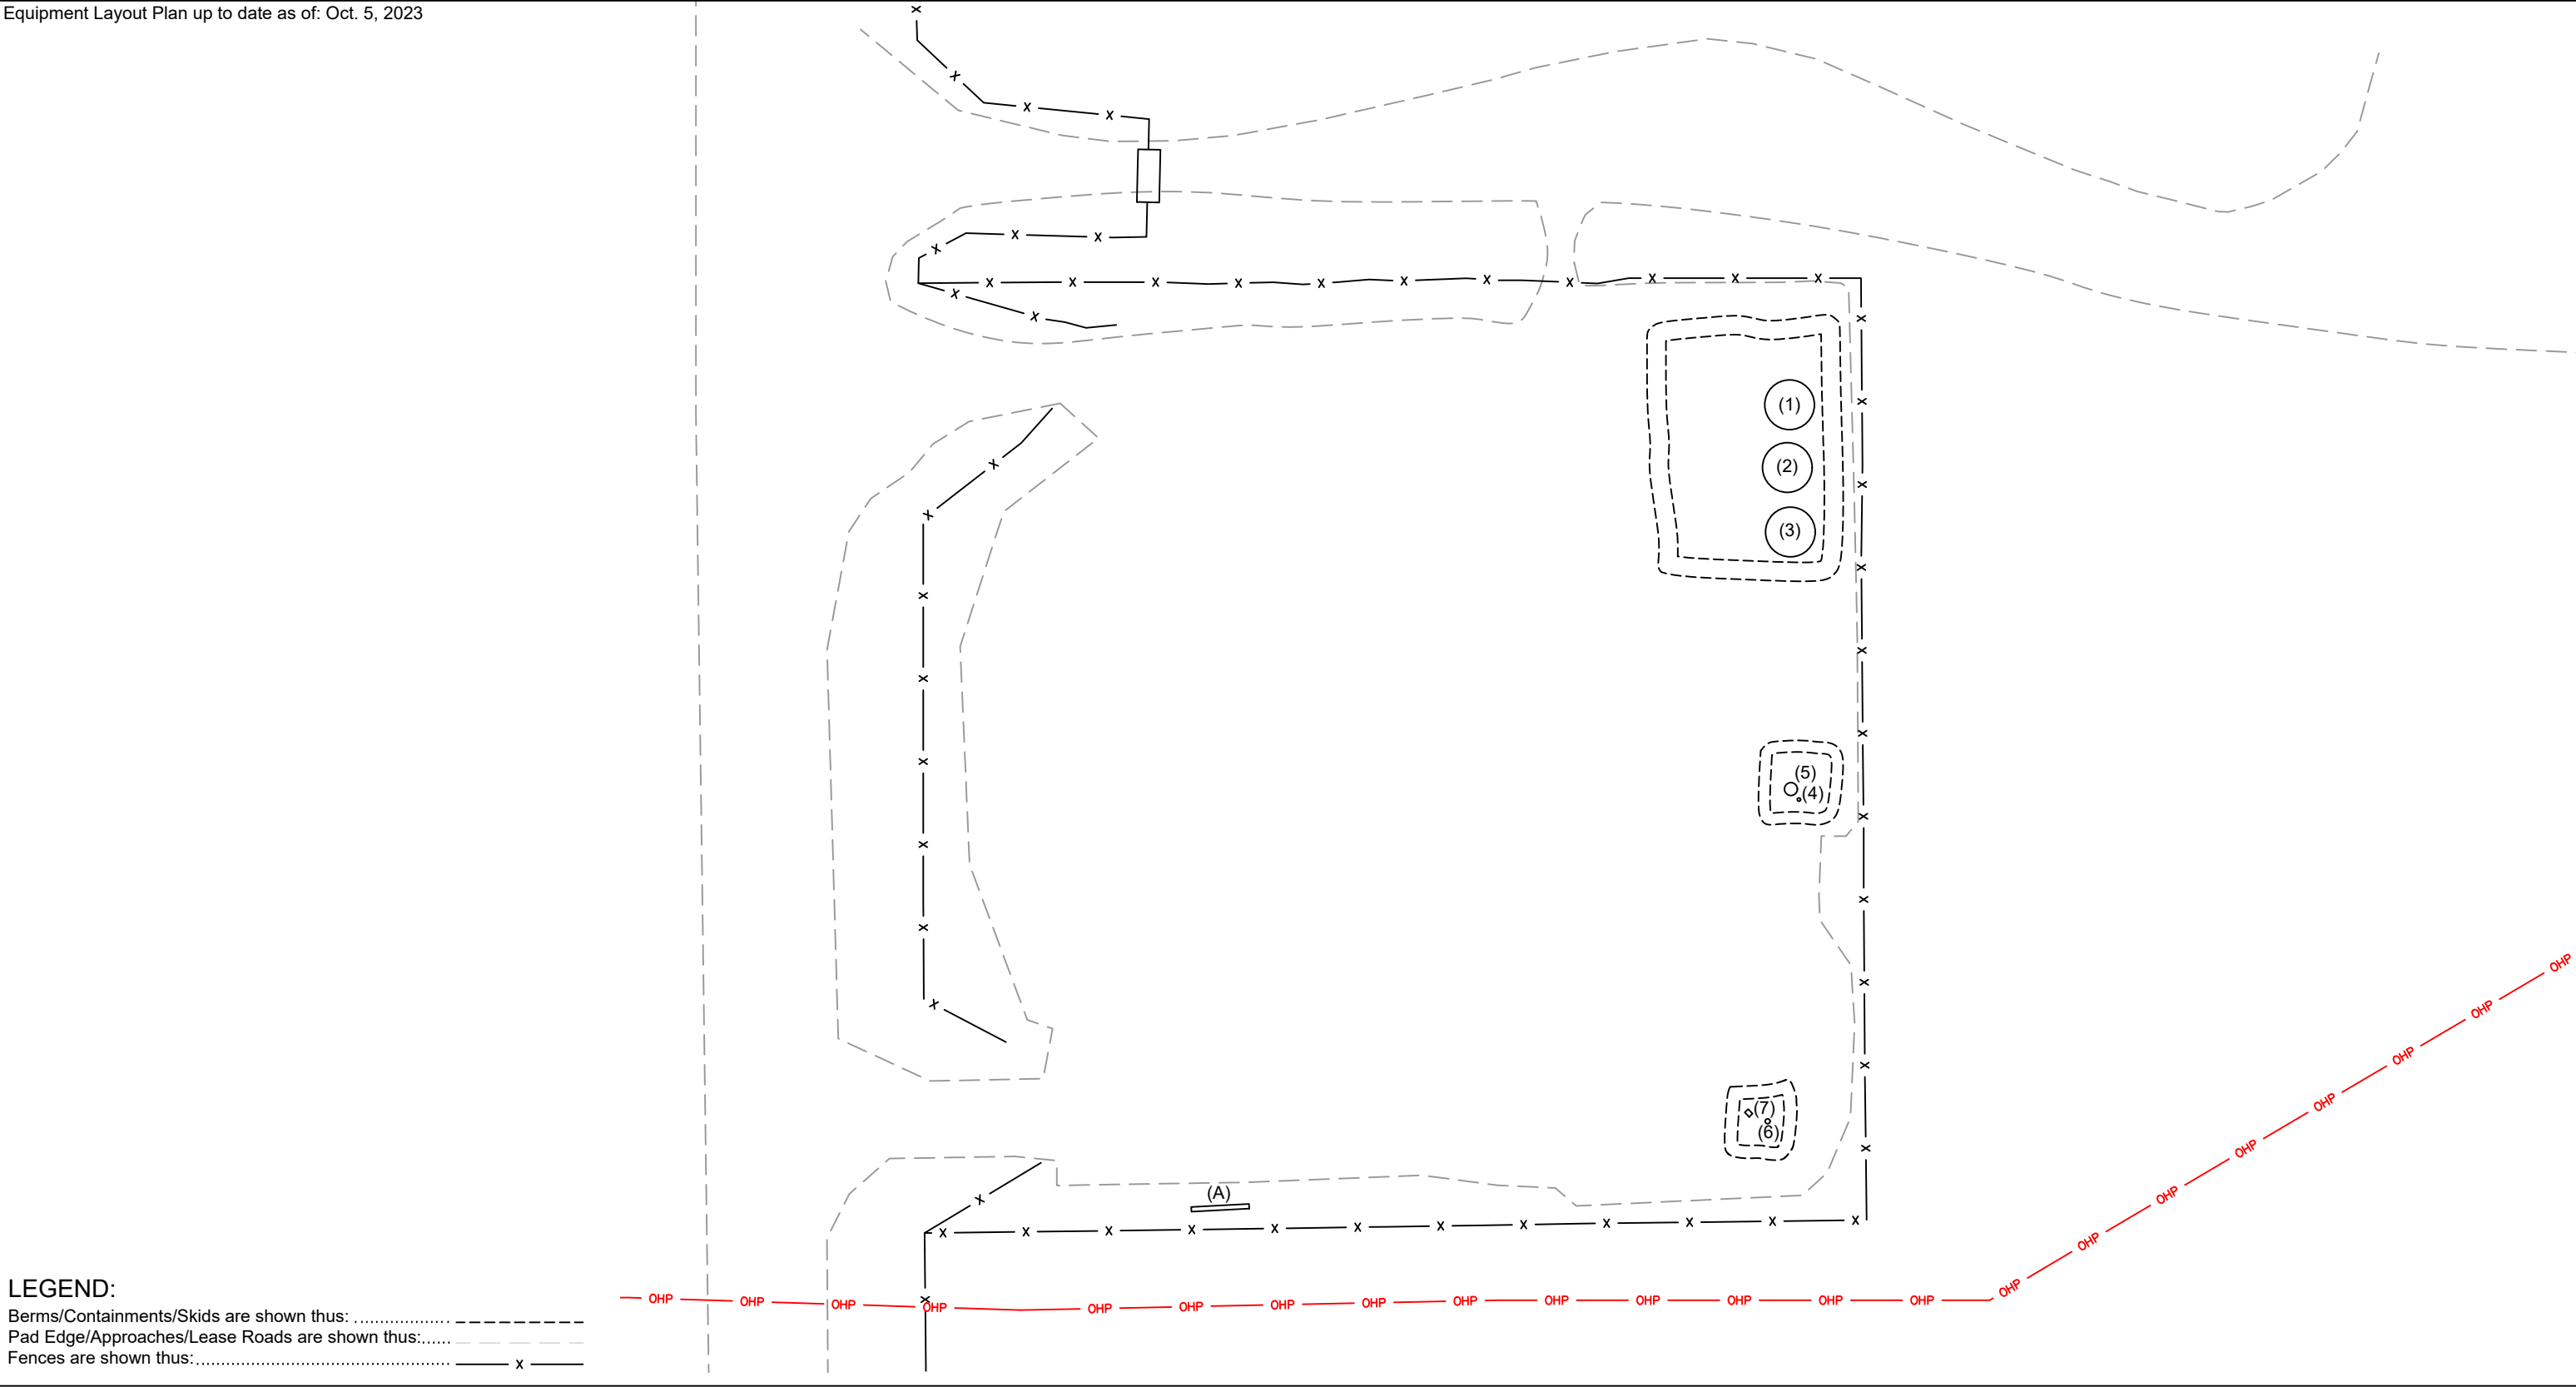

LEGEND:

Berms/Containments/Skids are shown thus: .....  
Pad Edge/Approaches/Lease Roads are shown thus:.....  
Fences are shown thus:..... x .....



U.S. Feet  
Scale 1"=50'

Rev. 1 - Issued for Information Updated Plan	Mar. 23, 2023	Drafted by: Marcos Barriga (Elite Optz.)
Preliminary Version 1	Apr. 12, 2023	Reviewed by: LaVerne Woroschuk (Elite Optz.)
Rev. 2 - Issued for Information Updated Plan	June 6, 2023	Approved by: (Caza Petro.)
Preliminary Version 0		Drafted by: Marcos Barriga (Elite Optz.)
Rev. 3 - Issued for Information Updated Plan	Oct. 12, 2023	Reviewed by: (Caza Petro.)
Preliminary Version 3		Approved by: Marcos Barriga (Elite Optz.)
Job. #: 22-EliteOptz-0010-Rev3		
Page 2 of 4		

 
As-Built Equipment Layout Plan for  
Caza Petroleum, LLC.  
Lynch 8212 JV-P #1  
API #30-025-28743  
Tank Battery



Disclaimer: This drawing is intended for Caza Petroleum, LLC. internal purposes only and is not to be relied upon as a boundary survey or to establish real property interests. Survey information shown on this drawing was gathered between the dates of: May 22, 2022 and Oct. 5, 2023. Survey information was collected using a combination of GNSS observations and geo-referenced aerial drone imagery when required. Observations refer to: NAD83 (2011) Datum, New Mexico State Plane Coordinate System, East Zone (3001), US Survey Feet, CSF=0.99990909. This drawing includes additional information that was collected from various sources including first hand observations, walk-through photos when applicable and third party information as well as information provided by Caza Petroleum, LLC. Caza Petroleum, LLC. is to verify the accuracy of all information as presented on this drawing. Elite Optimization, LP. is not responsible for design by engineer of records, erection or operation of any facilities represented by this drawing. This drawing is not an official engineering drawing or land survey drawing; this drawing is not to be used for construction.



Ref.	Piece	Year	Manufacturer	Serial No.	Model	Dimensions	Additional Information	Lat.	Long.
1	Tank	1966	Sivalls Tanks Inc.	18.755	--	15.5 x 16 - 500 BBL	--	32.556270	-103.521128
2	Tank	1968	Sivalls Tanks Inc	18.741	--	15.5 x 16 - 500 BBL	--	32.556215	-103.521127
3	Tank	--	--	No Tag	--	--	--	32.556160	-103.521128
4	Fuel Pot	--	--	--	--	--	Heater Treater 3412	32.555928	-103.521120
5	Vert. Heater Treater	1986	Area Tanks	3412	--	48 x 20 S\S	--	32.555937	-103.521130
6	Flare	--	--	--	--	--	--	32.555652	-103.521154
7	Flare control	2022	Platinum	2022112800078	Platinum-600	--	--	32.555661	-103.521181
A	Meter - Gas	--	--	No Visible Tag (Painted)	--	--	ABB T190655770	32.555581	-103.521710



Rev. 1 - Issued for Information Updated Plan

Preliminary Version 1

Rev. 2 - Issued for Information Updated Plan

Preliminary Version 0

Rev. 3 - Issued for Information Updated Plan

Preliminary Version 3

Mar. 23, 2023

Apr. 12, 2023

June 6, 2023

Oct. 12, 2023

Drafted by: Marcos Barriga (Elite Optz.)

Reviewed by: LaVerne Woroschuk (Elite Optz.)

Approved by: (Caza Petro.)

Drafted by: Marcos Barriga (Elite Optz.)

Reviewed by: (Elite Optz.)

Approved by: (Caza Petro.)

Drafted by: Marcos Barriga (Elite Optz.)

Reviewed by: (Elite Optz.)

Approved by: (Caza Petro.)

Job. #: 22-EliteOptz-0010-Rev3

Page 3 of 4

As-Built Equipment & Meter List for


Caza Petroleum, LLC.

Lynch 8212 JV-P #1




API #30-025-28743

Tank Battery

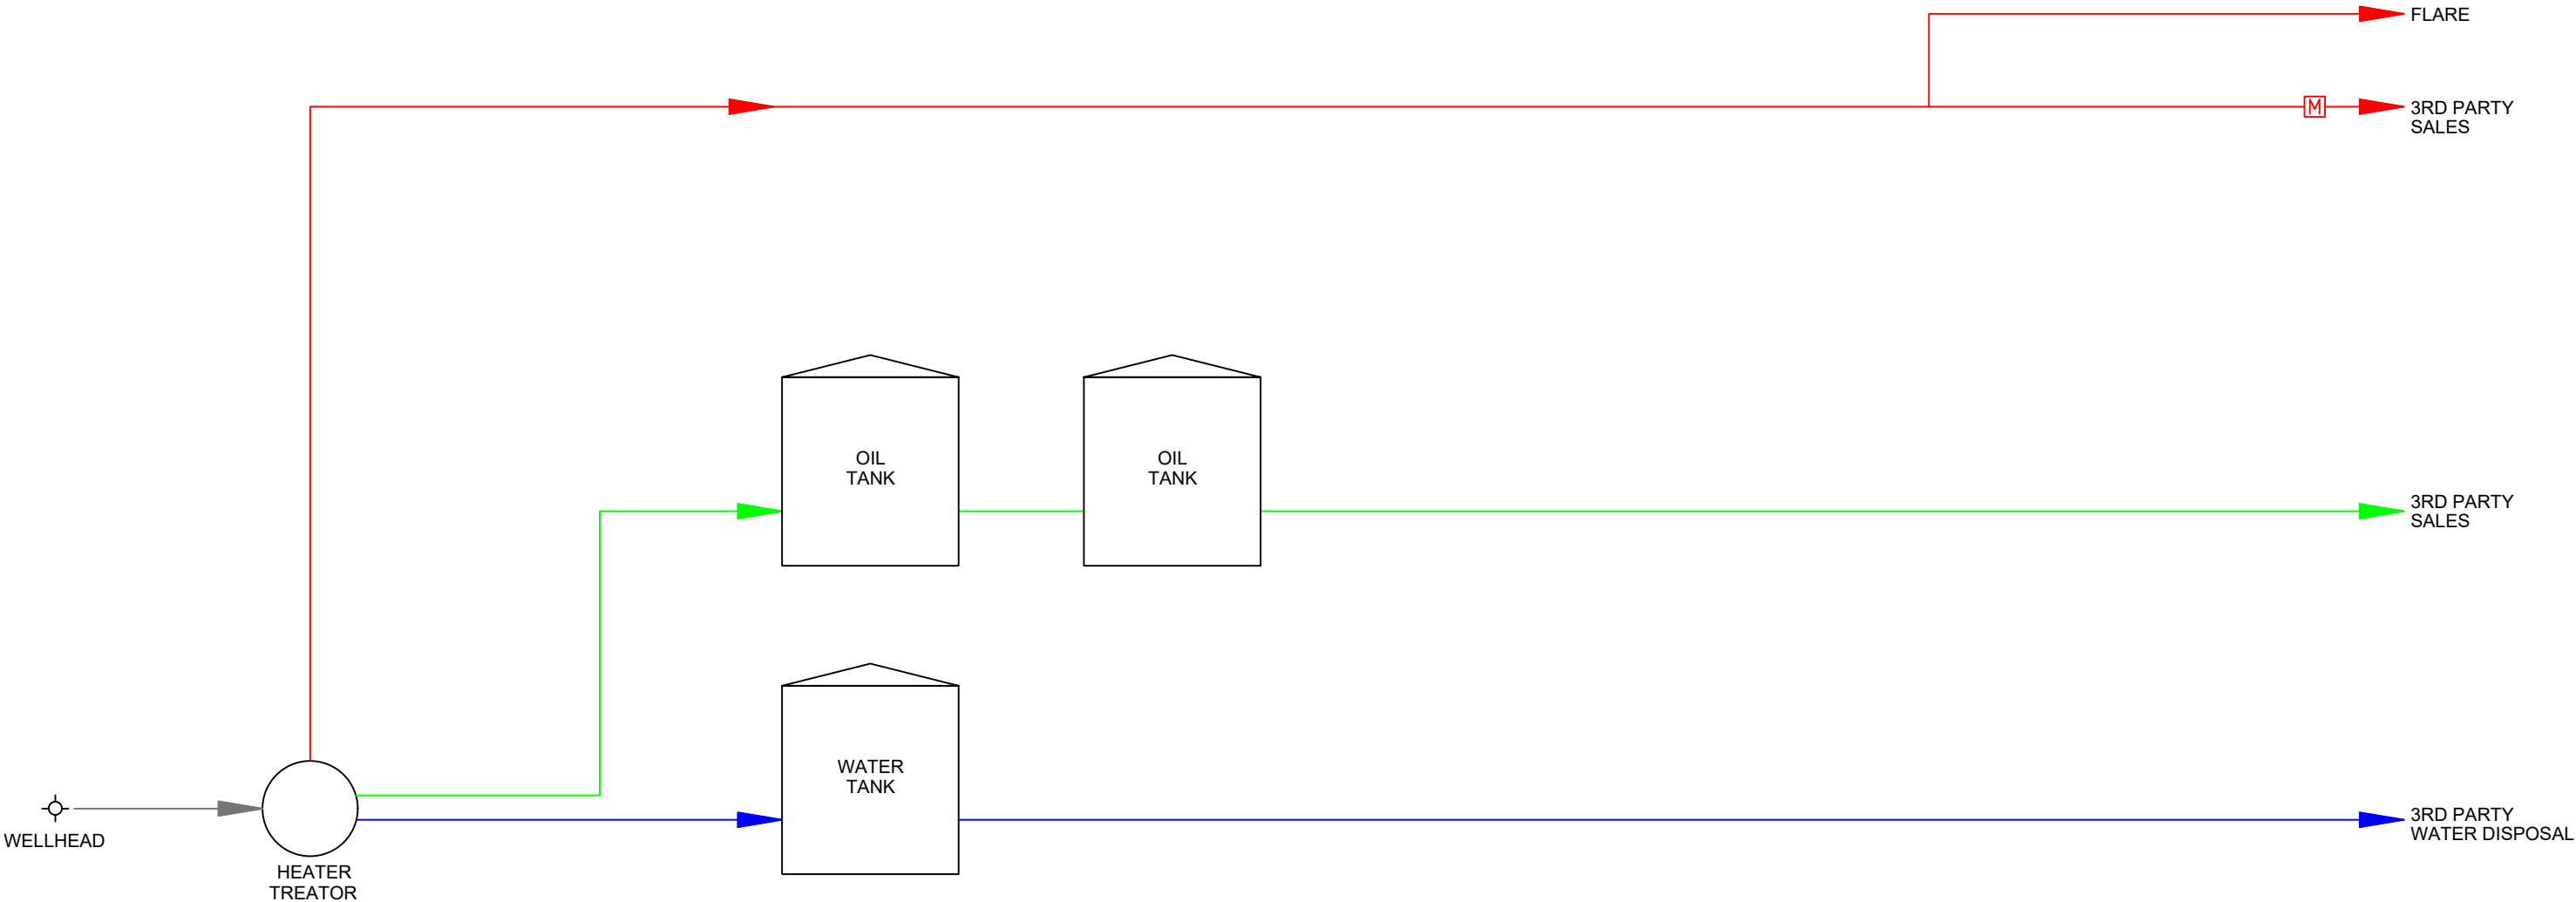Disclaimer: This drawing is intended for Caza Petroleum, LLC. internal purposes only and is not to be relied upon as a boundary survey or to establish real property interests. Survey information shown on this drawing was gathered between the dates of: May 22, 2022 and Oct. 5, 2023. Survey information was collected using a combination of GNSS observations and geo-referenced aerial drone imagery when required. Observations refer to: NAD83 (2011) Datum, New Mexico State Plane Coordinate System, East Zone (3001), US Survey Feet, CSF=0.99990909 This drawing includes additional information that was collected from various sources including first hand observations, walk-through photos when applicable and third party information as well as information provided by Caza Petroleum, LLC. Caza Petroleum, LLC. is to verify the accuracy of all information as presented on this drawing. Elite Optimization, LP. is not responsible for design by engineer of records, erection or operation of any facilities represented by this drawing. This drawing is not an official engineering drawing or land survey drawing; this drawing is not to be used for construction.



**LEGEND:**

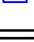
Wellstream is shown thus:.....	—————
Gas is shown thus:.....	—————
Oil is shown thus:.....	—————
Water is shown thus:.....	—————
Oil & Water / Bad Oil is shown thus:.....	—————
Gas Meter is shown thus:.....	
Oil Meter is shown thus:.....	
Water Meter is shown thus:.....	

Rev. 1 - Issued for Information Updated Plan	Mar. 23, 2023	Drafted by: Marcos Barriga (Elite Optz.)
Preliminary Version 1	Apr. 12, 2023	Reviewed by: LaVerne Woroschuk (Elite Optz.)
Rev. 2 - Issued for Information Updated Plan	June 6, 2023	Drafted by: Marcos Barriga (Elite Optz.)
Preliminary Version 0		Reviewed by: (Elite Optz.)
Rev. 3 - Issued for Information Updated Plan	Oct. 12, 2023	Approved by: (Caza Petro.)
Preliminary Version 3		Drafted by: Marcos Barriga (Elite Optz.)
		Reviewed by: (Elite Optz.)
		Approved by: (Caza Petro.)
Job. #: 22-EliteOptz-0010-Rev3		
Page 4 of 4		

As-Built Process Flow Diagram for  
**Caza Petroleum, LLC.**  
Lynch 8212 JV-P #1  
API #30-025-28743  
Tank Battery



Disclaimer: This drawing is intended for Caza Petroleum, LLC. internal purposes only and is not to be relied upon as a boundary survey or to establish real property interests. Survey information shown on this drawing was gathered between the dates of: May 22, 2022 and Oct. 5, 2023. Survey information was collected using a combination of GNSS observations and geo-referenced aerial drone imagery when required. Observations refer to: NAD83 (2011) Datum, New Mexico State Plane Coordinate System, East Zone (3001), US Survey Feet, CSF=0.99990909. This drawing includes additional information that was collected from various sources including first hand observations, walk-through photos when applicable and third party information as well as information provided by Caza Petroleum, LLC. Caza Petroleum, LLC. is to verify the accuracy of all information as presented on this drawing. Elite Optimization, LP. is not responsible for design by engineer of records, erection or operation of any facilities represented by this drawing. This drawing is not an official engineering drawing or land survey drawing; this drawing is not to be used for construction.



**District I**  
1625 N. French Dr., Hobbs, NM 88240  
Phone:(575) 393-6161 Fax:(575) 393-0720  
**District II**  
811 S. First St., Artesia, NM 88210  
Phone:(575) 748-1283 Fax:(575) 748-9720  
**District III**  
1000 Rio Brazos Rd., Aztec, NM 87410  
Phone:(505) 334-6178 Fax:(505) 334-6170  
**District IV**  
1220 S. St Francis Dr., Santa Fe, NM 87505  
Phone:(505) 476-3470 Fax:(505) 476-3462

State of New Mexico  
Energy, Minerals and Natural Resources  
Oil Conservation Division  
1220 S. St Francis Dr.  
Santa Fe, NM 87505

QUESTIONS  
  
Action 394097

QUESTIONS

Operator: CAZA OPERATING, LLC 200 N Loraine St Midland, TX 79701	OGRID: 249099
	Action Number: 394097
	Action Type: [UF-FAC] TB Registration (TB-REG)

QUESTIONS

<b>Facility Details</b>	
<i>Please answer all the questions in this group.</i>	
Name of the facility	Lynch 8212 JV-P #1 Production Facility
Date the facility was opened	04/01/1985
Depth to ground water, if known	Not answered.

<b>Verification</b>	
Does the operator have other facilities with a matching name	No
Are there other facilites located within approximately 50 feet	No

**District I**  
1625 N. French Dr., Hobbs, NM 88240  
Phone:(575) 393-6161 Fax:(575) 393-0720  
**District II**  
811 S. First St., Artesia, NM 88210  
Phone:(575) 748-1283 Fax:(575) 748-9720  
**District III**  
1000 Rio Brazos Rd., Aztec, NM 87410  
Phone:(505) 334-6178 Fax:(505) 334-6170  
**District IV**  
1220 S. St Francis Dr., Santa Fe, NM 87505  
Phone:(505) 476-3470 Fax:(505) 476-3462

State of New Mexico  
Energy, Minerals and Natural Resources  
Oil Conservation Division  
1220 S. St Francis Dr.  
Santa Fe, NM 87505

ACKNOWLEDGMENTS  
  
Action 394097

ACKNOWLEDGMENTS

Operator: CAZA OPERATING, LLC 200 N Loraine St Midland, TX 79701	OGRID: 249099
	Action Number: 394097
	Action Type: [UF-FAC] TB Registration (TB-REG)

ACKNOWLEDGMENTS

<input checked="" type="checkbox"/>	I certify that I am authorized to register a facility on behalf of the responsible operator.
<input checked="" type="checkbox"/>	I certify that I will notify OCD of any changes of ownership for this facility.
<input checked="" type="checkbox"/>	I certify that I will notify OCD when this facility is closed.