

District I
1625 N. French Dr., Hobbs, NM 88240
District II
811 S. First St., Artesia, NM 88210
District III
1000 Rio Brazos Rd., Aztec, NM 87410
District IV
1220 S. St. Francis Dr., Santa Fe, NM 87505

State of New Mexico
Energy, Minerals & Natural
Resources

Form C-104
Revised August 1, 2011

Submit one copy to appropriate District Office

Oil Conservation Division
1220 South St. Francis Dr.

☐ AMENDED REPORT

I. REQUEST FOR ALLOWABLE MINERAL AUTHORIZATION TO TRANSPORT

¹ Operator name and Address EOG RESOURCES INC PO BOX 2267 MIDLAND, TEXAS 79702		² OGRID Number 7377	
		³ Reason for Filing Code/ Effective Date NW 1/18/2021	
⁴ API Number 30 - 025-44500	⁵ Pool Name WC025 G07 S213330F; BONE SPRING		⁶ Pool Code 97927
⁷ Property Code 315138	⁸ Property Name FRUIT LOOP 29 STATE		⁹ Well Number 602H

II. ¹⁰ Surface Location

Ul or lot no. D	Section 29	Township 21S	Range 33E	Lot Idn	Feet from the 309	North/South Line NORTH	Feet from the 815	East/West line WEST	County LEA
--------------------	---------------	-----------------	--------------	---------	----------------------	---------------------------	----------------------	------------------------	---------------

¹¹ Bottom Hole Location

UL or lot no. N	Section 29	Township 21S	Range 33E	Lot Idn	Feet from the 109	North/South line SOUTH	Feet from the 1551	East/West line WEST	County LEA
¹² Lse Code	¹³ Producing Method Code FLOWING	¹⁴ Gas Connection Date	¹⁵ C-129 Permit Number		¹⁶ C-129 Effective Date		¹⁷ C-129 Expiration Date		

III. Oil and Gas Transporters

¹⁸ Transporter OGRID	¹⁹ Transporter Name and Address	²⁰ O/G/W
372812	EOGRM	OIL
151618	ENTERPRISE FIELD SERVICES	GAS
298751	REGENCY FIELD SERVICES	GAS
36785	DCP MIDSTREAM	GAS

IV. Well Completion Data

²¹ Spud Date 08/31/2019	²² Ready Date 01/18/2021	²³ TD 16,864'	²⁴ PBTD 16,864'	²⁵ Perforations 12,221 - 16,864'	²⁶ DHC, MC
²⁷ Hole Size		²⁸ Casing & Tubing Size		²⁹ Depth Set	
17 1/2		13 3/8"		1746'	
12 1/4"		9 5/8"		5204'	
8 1/2"		5 1/2"		16,844'	

V. Well Test Data

³¹ Date New Oil 01/18/2021	³² Gas Delivery Date 01/18/2021	³³ Test Date 01/22/2021	³⁴ Test Length 24 HRS	³⁵ Tbg. Pressure	³⁶ Csg. Pressure 559
³⁷ Choke Size 64	³⁸ Oil 2070	³⁹ Water 6264	⁴⁰ Gas 4215		⁴¹ Test Method
⁴² I hereby certify that the rules of the Oil Conservation Division have been complied with and that the information given above is true and complete to the best of my knowledge and belief. Signature: Kay Maddox			OIL CONSERVATION DIVISION		
Printed name: Kay Maddox			Approved by: PATRICIA MARTINEZ		
Title: SENIOR REGULATORY SPECIALIST			Title: PETROLEUM SPECIALIST		
E-mail Address: kay_maddox@eogresources.com			Approval Date: 6/24/2021		
Date: 02/25/2021		Phone: 432-638-8475			

District I
1625 N. French Dr., Hobbs, NM 88240
Phone: (575) 393-6161 Fax: (575) 393-0720
District II
811 S. First St., Artesia, NM 88210
Phone: (575) 748-1283 Fax: (575) 748-9720
District III
1000 Rio Brazos Road, Aztec, NM 87410
Phone: (505) 334-6178 Fax: (505) 334-6170
District IV
1220 S. St. Francis Dr., Santa Fe, NM 87505
Phone: (505) 476-3460 Fax: (505) 476-3462

State of New Mexico
Energy, Minerals & Natural Resources
Department
OIL CONSERVATION DIVISION
1220 South St. Francis Dr.
Santa Fe, NM 87505

FORM C-102

Revised August 1, 2011

Submit one copy to appropriate

District Office

☐ AMENDED REPORT

WELL LOCATION AND ACREAGE DEDICATION PLAT

¹ API Number 30-025-44500	² Pool Code 31513897927	³ Pool Name WC025 G07 S21330F; BONE SPRING
⁴ Property Code 315138	⁵ Property Name FRUIT LOOP 29 STATE	⁶ Well Number #602H
⁷ GRID No. 7377	⁸ Operator Name EOG RESOURCES, INC.	⁹ Elevation 3752'


¹⁰Surface Location

UL or lot no.	Section	Township	Range	Lot Idn	Feet from the	North/South line	Feet from the	East/West line	County
D	29	21-S	33-E	-	309'	NORTH	815'	WEST	LEA



UL or lot no.	Section	Township	Range	Lot Idn	Feet from the	North/South line	Feet from the	East/West line	County
N	29	21-S	33-E	-	109'	SOUTH	1551'	WEST	LEA

¹² Dedicated Acres 320.00	¹³ Joint or Infill	¹⁴ Consolidation Code	¹⁵ Order No.
---	-------------------------------	----------------------------------	-------------------------

No allowable will be assigned to this completion until all interests have been consolidated or a non-standard unit has been approved by the division.

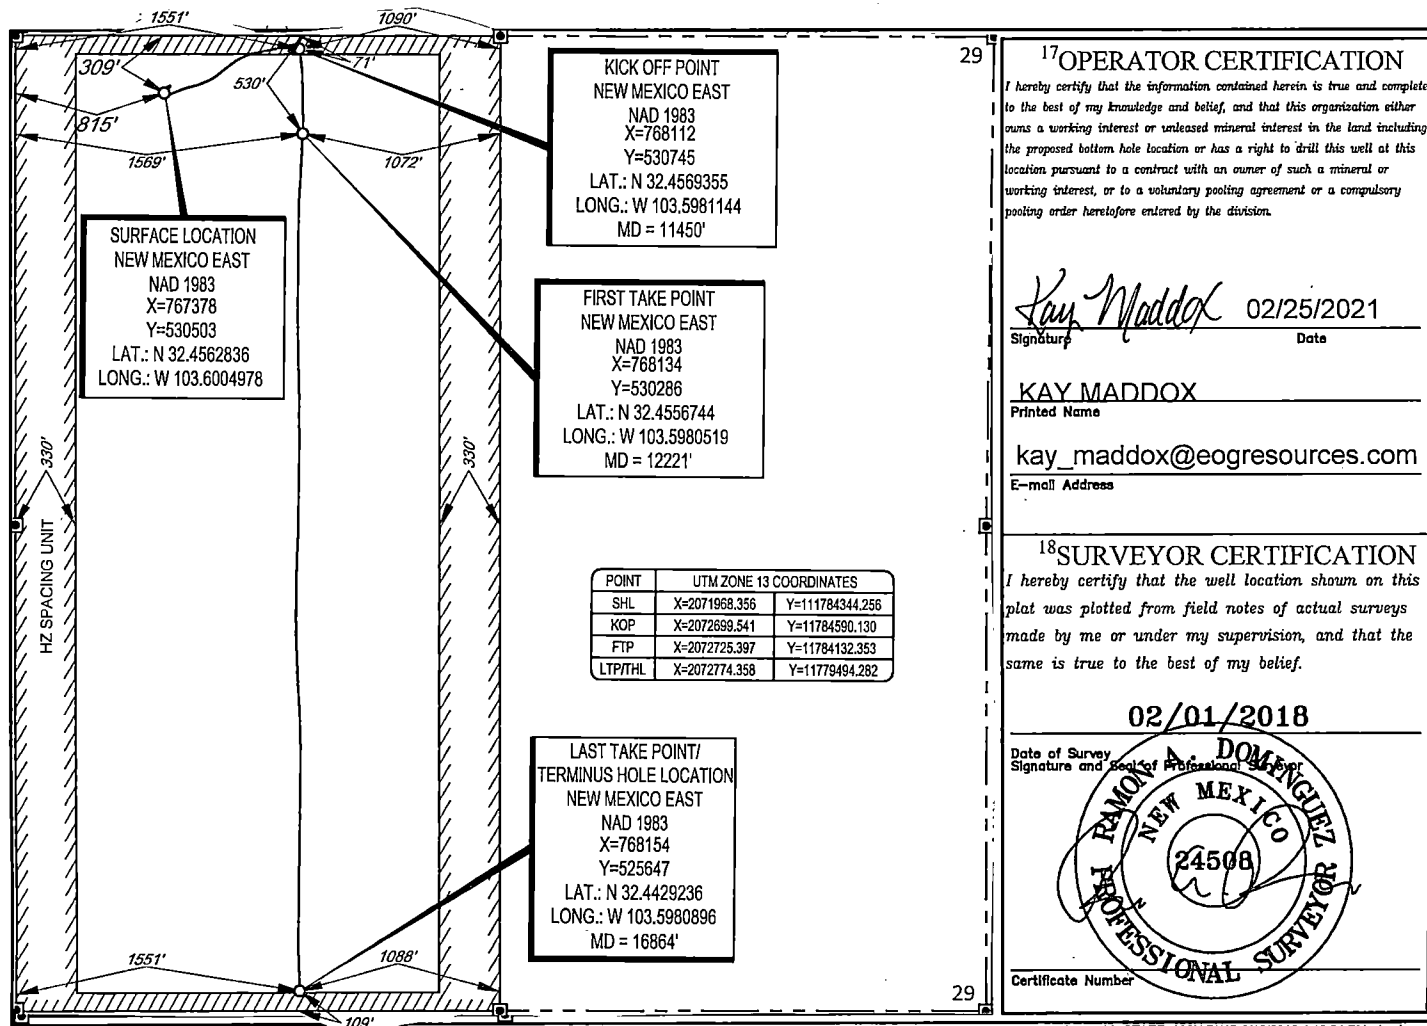

S:\SURVEY\EOG_MIDLAND\FRUIT_LOOP_29_STATE\FINAL_PRODUCTS\ILO_FRUITLOOP29STATE_602H.DWG 8/13/2019 4:10:24 PM rdominguez

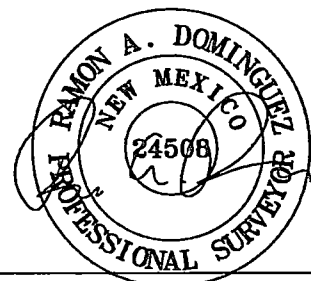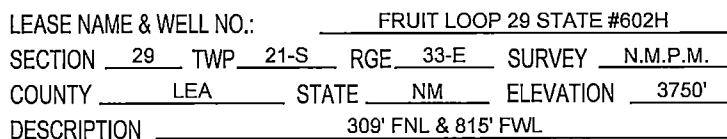

Ramon A. Dominguez, P.S. No. 24508



TOPOGRAPHIC
LOYALTY INNOVATION LEGACY

1400 EVERMAN PARKWAY, Ste. 146 • FT. WORTH, TEXAS 76140
TELEPHONE: (817) 744-7512 • FAX (817) 744-7554
2903 NORTH BIG SPRING • MIDLAND, TEXAS 79705
TELEPHONE: (432) 682-1653 OR (800) 767-1653 • FAX (432) 682-1743
WWW.TOPOGRAPHIC.COM

FRUIT LOOP 29 STATE #602H AS-COMplete	REVISION:		NOTES: 1. ORIGINAL DOCUMENT SIZE: 8.5" X 11" 2. ALL BEARINGS, DISTANCES, AND COORDINATE VALUES CONTAINED HEREIN ARE GRID BASED UPON THE NEW MEXICO COORDINATE SYSTEM OF 1983, EAST ZONE, U.S. SURVEY FEET. 3. THIS WELL LOCATION SHOWN HEREON HAS BEEN SURVEYED ON THE GROUND UNDER MY SUPERVISION AND PREPARED ACCORDING TO THE EVIDENCE FOUND AT THE TIME OF SURVEY, AND DATA PROVIDED BY EOG RESOURCES, INC. THIS CERTIFICATION IS MADE AND LIMITED TO THOSE PERSONS OR ENTITIES SHOWN ON THE FACE OF THIS PLAT AND IS NON-TRANSFERABLE. THIS SURVEY IS CERTIFIED FOR THIS TRANSACTION ONLY.
DATE: 03/02/2020			
FILE:AD_FRUITLOOP29STATE_602H			
DRAWN BY: IMU			
SHEET: 1 OF 1			

S:\SURVEY\EOG MIDLAND\FRUIT LOOP 29 STATE\FINAL PRODUCTS\AD FRUIT LOOP 29 STATE 602H.DWG 3/2/2020 3:36:05 PM rdominguez



EOG Resources - Midland

Lea County, NM (NAD 83 NME)

Fruit Loop 29 State

#602H

OH

Design: OH

Final PVA Report

19 September, 2019



Final PVA Report

Company:	EOG Resources - Midland	Local Co-ordinate Reference:	Well #602H
Project:	Lea County, NM (NAD 83 NME)	TVD Reference:	KB = 25' @ 3777.0usft
Site:	Fruit Loop 29 State	MD Reference:	KB = 25' @ 3777.0usft
Well:	#602H	North Reference:	Grid
Wellbore:	OH	Survey Calculation Method:	Minimum Curvature
Design:	OH	Database:	EDM 5000.14

Project		Lea County, NM (NAD 83 NME)	
Map System:	US State Plane 1983	System Datum:	Mean Sea Level
Geo Datum:	North American Datum 1983		
Map Zone:	New Mexico Eastern Zone		

Site		Fruit Loop 29 State									
Site Position:		Northing:		530,503.00 usft		Latitude:		32° 27' 22.624 N			
From:		Map		Easting:		767,378.00 usft		Longitude:		103° 36' 1.794 W	
Position Uncertainty:		0.0 usft		Slot Radius:		13-3/16 "		Grid Convergence:		0.39 °	

Well		#602H				
Well Position	+N/-S	0.0 usft	Northing:	530,503.00 usft	Latitude:	32° 27' 22.624 N
	+E/-W	0.0 usft	Easting:	767,378.00 usft	Longitude:	103° 36' 1.794 W
Position Uncertainty		0.0 usft	Wellhead Elevation:	usft	Ground Level:	3,752.0 usft

Wellbore	OH				
Magnetics	Model Name	Sample Date	Declination (°)	Dip Angle (°)	Field Strength (nT)
	IGRF2015	8/15/2019	6.75	60.24	47,847.54954924

Design		OH			
Audit Notes:					
Version:	1.0	Phase:	ACTUAL	Tie On Depth:	0.0
Vertical Section:	Depth From (TVD) (usft)		+N/-S (usft)	+E/-W (usft)	Direction (°)
	0.0		0.0	0.0	170.99

Survey Program		Date	9/19/2019		
From (usft)	To (usft)	Survey (Wellbore)	Tool Name	Description	
141.0	16,864.0	Intrepid MWD #1 (OH)	MWD	OWSG MWD - Standard	



Final PVA Report

Company: EOG Resources - Midland
Project: Lea County, NM (NAD 83 NME)
Site: Fruit Loop 29 State
Well: #602H
Wellbore: OH
Design: OH

Local Co-ordinate Reference: Well #602H
TVD Reference: KB = 25' @ 3777.0usft
MD Reference: KB = 25' @ 3777.0usft
North Reference: Grid
Survey Calculation Method: Minimum Curvature
Database: EDM 5000.14

Survey											
MD (usft)	Inc (°)	Azi (grid_north_azim)	TVD (usft)	N/S (usft)	E/W (usft)	DLeg (°/100usft)	Build (°/100usft)	Turn (°/100usft)	High to Plan (usft)	Right to Plan (usft)	
0.0	0.00	0.00	0.0	0.0	0.0	0.00	0.00	0.00	0.0	0.0	
141.0	0.50	15.80	141.0	0.6	0.2	0.35	0.35	0.00	-0.6	0.0	
318.0	3.20	23.80	317.9	5.9	2.4	1.53	1.53	4.52	-6.3	0.2	
492.0	5.60	23.10	491.4	18.1	7.7	1.38	1.38	-0.40	-19.7	0.1	
678.0	3.60	34.90	676.8	31.2	14.6	1.18	-1.08	6.34	-34.0	5.9	
867.0	4.80	79.60	865.3	37.5	25.7	1.79	0.63	23.65	-32.0	32.3	
1,057.0	0.90	132.50	1,055.0	38.0	34.7	2.27	-2.05	27.84	0.1	51.4	
1,247.0	6.20	238.00	1,244.7	31.5	27.1	3.42	2.79	55.53	39.6	-12.5	
1,436.0	4.40	217.00	1,432.9	20.3	14.0	1.39	-0.95	-11.11	24.7	-1.0	
1,626.0	5.10	215.20	1,622.2	7.6	4.8	0.38	0.37	-0.95	9.0	-0.5	
1,701.0	6.10	222.80	1,696.9	1.9	0.2	1.66	1.33	10.13	1.5	-1.2	
1,888.0	3.50	202.90	1,883.2	-10.6	-8.8	1.63	-1.39	-10.64	-15.3	-6.3	
2,078.0	4.80	87.80	2,072.9	-15.6	-3.1	3.70	0.68	-60.58	21.0	-21.0	
2,268.0	6.80	74.60	2,262.0	-12.4	15.7	1.26	1.05	-6.95	33.4	-19.6	
2,458.0	8.40	68.30	2,450.3	-4.2	39.4	0.95	0.84	-3.32	41.7	-16.1	
2,648.0	10.20	67.70	2,637.8	7.3	67.9	0.95	0.95	-0.32	42.5	-14.4	
2,838.0	10.20	68.70	2,824.8	19.8	99.1	0.09	0.00	0.53	39.9	-14.1	
3,027.0	10.20	75.30	3,010.8	30.1	130.9	0.62	0.00	3.49	35.8	-19.4	
3,218.0	9.40	73.10	3,199.0	38.9	162.2	0.46	-0.42	-1.15	35.5	-20.3	
3,408.0	8.80	70.70	3,386.6	48.2	190.7	0.37	-0.32	-1.26	37.6	-19.8	
3,597.0	8.00	68.10	3,573.6	57.9	216.6	0.47	-0.42	-1.38	42.1	-17.6	
3,787.0	8.30	65.10	3,761.7	68.6	241.3	0.27	0.16	-1.58	47.4	-13.4	
3,977.0	8.30	60.10	3,949.7	81.2	265.6	0.38	0.00	-2.63	51.9	-5.0	
4,167.0	10.20	49.50	4,137.2	99.0	290.3	1.34	1.00	-5.58	51.0	13.0	
4,357.0	9.80	50.70	4,324.3	120.2	315.6	0.24	-0.21	0.63	47.9	22.8	
4,547.0	9.40	51.80	4,511.7	140.0	340.3	0.23	-0.21	0.58	46.4	32.0	
4,737.0	9.20	53.50	4,699.2	158.6	364.7	0.18	-0.11	0.89	46.7	40.1	



Final PVA Report

Company:	EOG Resources - Midland	Local Co-ordinate Reference:	Well #602H
Project:	Lea County, NM (NAD 83 NME)	TVD Reference:	KB = 25' @ 3777.0usft
Site:	Fruit Loop 29 State	MD Reference:	KB = 25' @ 3777.0usft
Well:	#602H	North Reference:	Grid
Wellbore:	OH	Survey Calculation Method:	Minimum Curvature
Design:	OH	Database:	EDM 5000.14

Survey										
MD (usft)	Inc (°)	Azi (grid_north_azim)	TVD (usft)	N/S (usft)	E/W (usft)	DLeg (°/100usft)	Build (°/100usft)	Turn (°/100usft)	High to Plan (usft)	Right to Plan (usft)
4,926.0	9.10	57.90	4,885.8	175.6	389.5	0.37	-0.05	2.33	50.1	44.2
5,116.0	9.00	61.10	5,073.4	190.7	415.3	0.27	-0.05	1.68	53.6	47.2
5,150.0	8.70	61.10	5,107.0	193.3	419.8	0.88	-0.88	0.00	54.0	48.1
5,310.0	9.20	68.40	5,265.1	203.8	442.3	0.77	0.31	4.56	61.2	43.3
5,500.0	10.50	76.00	5,452.3	213.6	473.2	0.97	0.68	4.00	65.1	33.7
5,690.0	10.50	79.20	5,639.1	221.0	507.0	0.31	0.00	1.68	63.2	26.1
5,880.0	10.50	78.30	5,825.9	227.8	541.0	0.09	0.00	-0.47	59.2	22.3
6,070.0	10.50	76.90	6,012.7	235.2	574.8	0.13	0.00	-0.74	55.1	19.7
6,260.0	10.10	74.90	6,199.7	243.5	607.8	0.28	-0.21	-1.05	51.7	18.3
6,450.0	9.60	73.40	6,386.9	252.4	639.0	0.30	-0.26	-0.79	50.0	17.4
6,640.0	7.40	78.50	6,574.8	259.3	666.2	1.22	-1.16	2.68	47.9	10.7
6,830.0	5.30	83.70	6,763.6	262.7	686.9	1.14	-1.11	2.74	39.6	4.6
7,020.0	3.60	80.50	6,953.0	264.7	701.5	0.90	-0.89	-1.68	25.8	6.0
7,210.0	3.60	88.30	7,142.6	265.8	713.4	0.26	0.00	4.11	14.5	3.3
7,399.0	3.30	99.40	7,331.3	265.1	724.7	0.39	-0.16	5.87	3.6	1.6
7,589.0	3.40	101.90	7,521.0	263.1	735.6	0.09	0.05	1.32	-7.4	1.6
7,779.0	1.30	96.90	7,710.8	261.6	743.2	1.11	-1.11	-2.63	-15.3	0.5
7,969.0	1.10	116.30	7,900.8	260.6	747.0	0.24	-0.11	10.21	-18.1	6.3
8,159.0	1.20	130.40	8,090.7	258.5	750.2	0.16	0.05	7.42	-19.8	10.9
8,349.0	0.60	336.40	8,280.7	258.1	751.3	0.93	-0.32	-81.05	13.8	-19.4
8,539.0	0.50	324.50	8,470.7	259.7	750.4	0.08	-0.05	-6.26	15.7	-16.3
8,729.0	0.50	317.80	8,660.7	261.0	749.4	0.03	0.00	-3.53	15.8	-14.5
8,919.0	0.10	278.90	8,850.7	261.6	748.6	0.22	-0.21	-20.47	20.6	-1.8
9,109.0	1.10	214.30	9,040.7	260.1	747.5	0.56	0.53	-34.00	8.6	17.7
9,299.0	1.50	201.60	9,230.6	256.3	745.5	0.26	0.21	-6.68	0.2	18.7
9,489.0	1.70	210.90	9,420.6	251.6	743.1	0.17	0.11	4.89	-2.0	18.9
9,680.0	1.20	358.30	9,611.5	251.2	741.6	1.46	-0.26	77.17	12.2	-13.3



Final PVA Report

Company:	EOG Resources - Midland	Local Co-ordinate Reference:	Well #602H
Project:	Lea County, NM (NAD 83 NME)	TVD Reference:	KB = 25' @ 3777.0usft
Site:	Fruit Loop 29 State	MD Reference:	KB = 25' @ 3777.0usft
Well:	#602H	North Reference:	Grid
Wellbore:	OH	Survey Calculation Method:	Minimum Curvature
Design:	OH	Database:	EDM 5000.14

Survey										
MD (usft)	Inc (°)	Azi (grid_north_azim)	TVD (usft)	N/S (usft)	E/W (usft)	DLeg (°/100usft)	Build (°/100usft)	Turn (°/100usft)	High to Plan (usft)	Right to Plan (usft)
9,870.0	1.00	16.40	9,801.5	254.7	742.0	0.21	-0.11	9.53	4.0	-15.8
10,060.0	0.70	11.10	9,991.5	257.5	742.7	0.16	-0.16	-2.79	2.6	-15.5
10,250.0	0.20	322.80	10,181.5	258.9	742.8	0.31	-0.26	-25.42	12.2	-9.3
10,440.0	0.70	219.60	10,371.5	258.2	741.8	0.41	0.26	-54.32	5.1	13.7
10,629.0	0.40	295.20	10,560.5	257.6	740.5	0.38	-0.16	40.00	13.6	-0.5
10,819.0	0.90	302.80	10,750.4	258.7	738.6	0.27	0.26	4.00	11.3	-2.2
11,009.0	1.80	193.10	10,940.4	256.6	736.7	1.19	0.47	-57.74	-4.2	9.9
11,199.0	1.50	192.40	11,130.3	251.3	735.5	0.16	-0.16	-0.37	-9.8	9.8
11,341.0	2.20	191.10	11,272.3	246.8	734.6	0.49	0.49	-0.92	-14.6	9.6
11,439.1	2.40	197.09	11,370.3	243.0	733.6	0.32	0.20	6.11	-17.5	11.2
KOP (Fruit Loop 29 #602H)										
11,441.0	2.40	197.20	11,372.2	242.9	733.6	0.32	0.21	5.59	-17.5	11.3
11,488.0	6.00	176.50	11,419.0	239.5	733.4	8.19	7.66	-44.04	-21.7	4.1
11,536.0	10.40	166.00	11,466.5	232.8	734.6	9.65	9.17	-21.87	-22.8	1.2
11,618.5	17.77	171.53	11,546.5	213.1	738.3	9.08	8.94	6.71	-22.4	7.0
HL Crossing, MD:11618.5', TVD:11546.5', N/S:213.1', E/W:738.3', INC:17.77										
11,631.0	18.90	172.00	11,558.4	209.2	738.9	9.08	9.00	3.74	-22.2	7.7
11,727.0	29.10	170.90	11,646.0	170.7	744.7	10.63	10.62	-1.15	-21.3	13.3
11,822.0	40.40	175.70	11,723.9	117.0	750.7	12.23	11.89	5.05	-20.3	20.5
11,909.1	48.84	178.11	11,785.9	55.9	753.9	9.87	9.68	2.77	-20.3	23.9
FTP (Fruit Loop 29 #602H)										
11,917.0	49.60	178.30	11,791.0	50.0	754.1	9.87	9.71	2.37	-20.3	24.1
12,012.0	57.70	180.00	11,847.3	-26.5	755.2	8.65	8.53	1.79	-18.7	24.9
12,059.0	60.60	178.60	11,871.4	-66.8	755.7	6.68	6.17	-2.98	-16.9	24.9
12,107.0	62.50	178.20	11,894.2	-109.0	756.9	4.03	3.96	-0.83	-12.7	25.7
12,154.0	68.50	180.00	11,913.7	-151.7	757.5	13.23	12.77	3.83	-7.6	26.1
12,202.0	72.70	182.00	11,929.7	-197.0	756.7	9.59	8.75	4.17	-2.7	25.0



Final PVA Report

Company:	EOG Resources - Midland	Local Co-ordinate Reference:	Well #602H
Project:	Lea County, NM (NAD 83 NME)	TVD Reference:	KB = 25' @ 3777.0usft
Site:	Fruit Loop 29 State	MD Reference:	KB = 25' @ 3777.0usft
Well:	#602H	North Reference:	Grid
Wellbore:	OH	Survey Calculation Method:	Minimum Curvature
Design:	OH	Database:	EDM 5000.14

Survey										
MD (usft)	Inc (°)	Azi (grid_north_azim)	TVD (usft)	N/S (usft)	E/W (usft)	DLeg (°/100usft)	Build (°/100usft)	Turn (°/100usft)	High to Plan (usft)	Right to Plan (usft)
12,249.0	77.70	182.30	11,941.7	-242.4	755.0	10.66	10.64	0.64	1.9	22.8
12,297.0	83.30	181.80	11,949.6	-289.7	753.3	11.71	11.67	-1.04	6.1	20.8
12,392.0	88.40	182.20	11,956.5	-384.3	750.0	5.38	5.37	0.42	9.8	16.7
12,483.0	90.10	182.20	11,957.7	-475.3	746.5	1.87	1.87	0.00	8.0	12.5
12,578.0	88.70	184.20	11,958.7	-570.1	741.2	2.57	-1.47	2.11	5.8	6.4
12,673.0	89.00	179.90	11,960.6	-665.0	737.8	4.54	0.32	-4.53	4.6	2.2
12,766.0	89.20	179.80	11,962.0	-757.9	738.1	0.24	0.21	-0.11	3.0	1.7
TGT 1 (Fruit Loop 29 #602H)										
12,767.0	89.20	179.80	11,962.0	-759.0	738.1	0.24	0.21	-0.11	3.0	1.7
12,862.0	88.30	180.40	11,964.1	-854.0	737.9	1.14	-0.95	0.63	3.3	0.7
12,957.0	88.80	180.30	11,966.5	-948.9	737.3	0.54	0.53	-0.11	4.5	-0.6
13,052.0	90.10	179.80	11,967.4	-1,043.9	737.2	1.47	1.37	-0.53	4.2	-1.5
13,147.0	87.60	179.50	11,969.3	-1,138.9	737.8	2.65	-2.63	-0.32	4.9	-1.7
13,242.0	88.80	179.10	11,972.3	-1,233.8	739.0	1.33	1.26	-0.42	6.6	-1.3
13,337.0	90.80	178.30	11,972.6	-1,328.8	741.1	2.27	2.11	-0.84	5.7	0.1
13,432.0	90.90	178.10	11,971.2	-1,423.8	744.1	0.24	0.11	-0.21	3.1	2.3
13,498.3	90.62	178.45	11,970.4	-1,490.0	746.1	0.67	-0.42	0.53	1.4	3.7
TGT 2 (Fruit Loop 29 #602H)										
13,527.0	90.50	178.60	11,970.1	-1,518.7	746.8	0.67	-0.42	0.53	0.8	4.2
13,623.0	89.00	179.10	11,970.5	-1,614.7	748.8	1.65	-1.56	0.52	0.1	5.4
13,718.0	90.20	179.20	11,971.2	-1,709.7	750.2	1.27	1.26	0.11	-0.2	6.0
13,813.0	89.80	179.60	11,971.2	-1,804.7	751.2	0.60	-0.42	0.42	-1.3	6.2
13,908.0	88.90	180.10	11,972.2	-1,899.7	751.4	1.08	-0.95	0.53	-1.2	5.7
14,003.0	89.60	180.20	11,973.5	-1,994.7	751.2	0.74	0.74	0.11	-1.0	4.7
14,097.0	91.00	180.40	11,973.0	-2,088.6	750.7	1.50	1.49	0.21	-2.6	3.4
14,193.0	89.90	180.30	11,972.2	-2,184.6	750.1	1.15	-1.15	-0.10	-4.4	2.0
14,288.0	88.10	180.30	11,973.9	-2,279.6	749.6	1.89	-1.89	0.00	-3.7	0.7



Final PVA Report

Company:	EOG Resources - Midland	Local Co-ordinate Reference:	Well #602H
Project:	Lea County, NM (NAD 83 NME)	TVD Reference:	KB = 25' @ 3777.0usft
Site:	Fruit Loop 29 State	MD Reference:	KB = 25' @ 3777.0usft
Well:	#602H	North Reference:	Grid
Wellbore:	OH	Survey Calculation Method:	Minimum Curvature
Design:	OH	Database:	EDM 5000.14

Survey											
MD (usft)	Inc (°)	Azi (grid_north_azim)	TVD (usft)	N/S (usft)	E/W (usft)	DLeg (°/100usft)	Build (°/100usft)	Turn (°/100usft)	High to Plan (usft)	Right to Plan (usft)	
14,383.0	86.90	181.30	11,978.0	-2,374.5	748.3	1.64	-1.26	1.05	-0.6	-1.4	
14,413.7	87.35	181.30	11,979.6	-2,405.1	747.6	1.47	1.47	0.00	0.6	-2.3	
TGT 3 (Fruit Loop 29 #602H)											
14,478.0	88.30	181.30	11,982.0	-2,469.4	746.1	1.47	1.47	0.00	2.6	-4.3	
14,573.0	89.50	181.20	11,983.8	-2,564.4	744.1	1.27	1.26	-0.11	3.9	-7.2	
14,668.0	90.90	180.60	11,983.5	-2,659.4	742.6	1.60	1.47	-0.63	3.1	-9.4	
14,763.0	90.80	180.30	11,982.1	-2,754.3	741.8	0.33	-0.11	-0.32	1.2	-10.9	
14,858.0	88.80	179.10	11,982.4	-2,849.3	742.3	2.46	-2.11	-1.26	1.0	-11.2	
14,953.0	88.50	177.80	11,984.7	-2,944.3	744.9	1.40	-0.32	-1.37	2.7	-9.4	
15,048.0	89.90	176.90	11,986.0	-3,039.2	749.3	1.75	1.47	-0.95	3.5	-5.8	
15,143.0	88.60	177.20	11,987.2	-3,134.0	754.2	1.40	-1.37	0.32	4.2	-1.7	
15,238.0	88.00	177.00	11,990.1	-3,228.9	759.0	0.67	-0.63	-0.21	6.5	2.3	
15,333.0	89.10	176.10	11,992.5	-3,323.6	764.7	1.50	1.16	-0.95	8.4	7.2	
15,428.0	88.80	177.80	11,994.2	-3,418.5	769.7	1.82	-0.32	1.79	9.6	11.5	
15,523.0	88.40	179.80	11,996.5	-3,513.4	771.7	2.15	-0.42	2.11	11.4	12.7	
15,618.0	89.10	179.10	11,998.6	-3,608.4	772.6	1.04	0.74	-0.74	13.0	12.9	
15,714.0	88.80	180.70	12,000.4	-3,704.4	772.8	1.70	-0.31	1.67	14.2	12.2	
15,808.0	89.90	180.50	12,001.4	-3,798.4	771.8	1.19	1.17	-0.21	14.8	10.5	
15,903.0	88.60	180.80	12,002.7	-3,893.4	770.7	1.40	-1.37	0.32	15.5	8.6	
15,998.0	89.60	180.40	12,004.2	-3,988.3	769.7	1.13	1.05	-0.42	16.5	6.9	
16,093.0	89.00	180.40	12,005.3	-4,083.3	769.1	0.63	-0.63	0.00	17.1	5.4	
16,188.0	90.00	180.60	12,006.1	-4,178.3	768.3	1.07	1.05	0.21	17.5	3.8	
16,246.1	89.39	180.66	12,006.5	-4,236.4	767.6	1.06	-1.05	0.11	17.5	2.7	
TGT 4 (Fruit Loop 29 #602H)											
16,283.0	89.00	180.70	12,007.0	-4,273.3	767.2	1.06	-1.05	0.11	17.9	1.9	
16,378.0	90.20	179.80	12,007.6	-4,368.3	766.8	1.58	1.26	-0.95	18.4	0.8	
16,473.0	89.50	179.80	12,007.9	-4,463.3	767.1	0.74	-0.74	0.00	18.5	0.3	



Final PVA Report

Company:	EOG Resources - Midland	Local Co-ordinate Reference:	Well #602H
Project:	Lea County, NM (NAD 83 NME)	TVD Reference:	KB = 25' @ 3777.0usft
Site:	Fruit Loop 29 State	MD Reference:	KB = 25' @ 3777.0usft
Well:	#602H	North Reference:	Grid
Wellbore:	OH	Survey Calculation Method:	Minimum Curvature
Design:	OH	Database:	EDM 5000.14

Survey											
MD (usft)	Inc (°)	Azi (grid_north_azim)	TVD (usft)	N/S (usft)	E/W (usft)	DLeg (°/100usft)	Build (°/100usft)	Turn (°/100usft)	High to Plan (usft)	Right to Plan (usft)	
16,568.0	89.20	179.30	12,009.0	-4,558.3	767.8	0.61	-0.32	-0.53	19.4	0.3	
16,663.0	90.10	178.80	12,009.5	-4,653.3	769.4	1.08	0.95	-0.53	19.9	1.1	
16,758.0	91.70	178.20	12,008.0	-4,748.2	771.9	1.80	1.68	-0.63	18.2	2.8	
16,804.0	92.70	177.50	12,006.3	-4,794.2	773.6	2.65	2.17	-1.52	16.4	4.1	
Final MWD Survey (MD=16804.0')											
16,864.0	92.70	177.50	12,003.5	-4,854.0	776.2	0.00	0.00	0.00	13.5	6.2	
Final Projection to Bit (MD=16864.0') - PBHL (Fruit Loop 29 #602H)											

Design Annotations					
Measured Depth (usft)	Vertical Depth (usft)	Local Coordinates			
		+N/-S (usft)	+E/-W (usft)	Comment	
11,618.5	11,546.5	213.1	738.3	HL Crossing, MD:11618.5', TVD:11546.5', N/S:213.1', E/W:738.3', INC:17.77	
16,804.0	12,006.3	-4,794.2	773.6	Final MWD Survey (MD=16804.0')	
16,864.0	12,003.5	-4,854.0	776.2	Final Projection to Bit (MD=16864.0')	

Checked By: _____ Approved By: _____ Date: _____

I certify this survey to be true and correct to the best of my belief and knowledge.

Kay Maddox 2/25/2021



Lea County, NM (NAD 83 NME)

Fruit Loop 29 State #602H

Plan #1


PROJECT DETAILS: Lea County, NM (NAD 83 NME)

Geodetic System: US State Plane 1983
Datum: North American Datum 1983
Ellipsoid: GRS 1980
Zone: New Mexico Eastern Zone
System Datum: Mean Sea Level

WELL DETAILS: #602H

KB = 25' @ 3777.0usft 3752.0
Northing 530503.00 Easting 767378.00 Latitude 32° 27' 22.624 N Longitude 103° 36' 1.794 W

Azimuths to Grid North
True North: -0.39°
Magnetic North: 6.36°
Magnetic Field
Strength: 47847.5snT
Dip Angle: 60.24°
Date: 8/15/2019
Model: IGRF2015

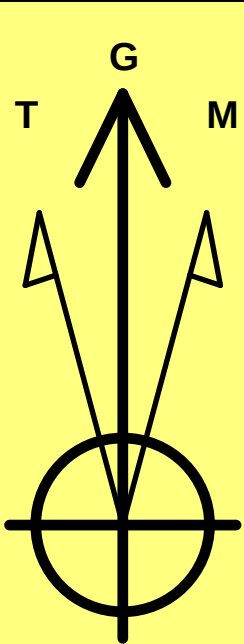








To convert a Magnetic Direction to a Grid Direction, Add 6.36°
To convert a Magnetic Direction to a True Direction, Add 6.75° East
To convert a True Direction to a Grid Direction, Subtract 0.39°

SECTION DETAILS

Sec	MD	Inc	Azi	TVD	+N/-S	+E/-W	Dleg	TFace	VSect	Target
1	0.0	0.00	0.00	0.0	0.0	0.0	0.00	0.00	0.0	
2	1750.0	0.00	0.00	1750.0	0.0	0.0	0.00	0.00	0.0	
3	2225.2	9.50	70.14	2223.0	13.4	37.0	2.00	70.14	-7.4	
4	6437.0	9.50	70.14	6377.0	249.6	691.0	0.00	0.00	-138.3	
5	6912.2	0.00	0.00	6850.0	263.0	728.0	2.00	180.00	-145.7	
6	11433.2	0.00	0.00	11371.0	263.0	728.0	0.00	0.00	-145.7	KOP (Fruit Loop 29 #602H)
7	12314.3	88.12	179.53	11943.6	-291.1	732.5	10.00	179.53	402.3	TGT 1 (Fruit Loop 29 #602H)
8	12781.5	88.12	179.53	11959.0	-758.0	736.4	0.00	0.00	864.0	
9	12838.8	89.26	179.53	11960.3	-815.3	736.8	2.00	0.00	920.6	
10	13513.7	89.26	179.53	11969.0	-1490.1	742.4	0.00	0.00	1588.0	TGT 2 (Fruit Loop 29 #602H)
11	13519.3	89.37	179.53	11969.1	-1495.7	742.4	2.00	0.00	1593.5	
12	14428.9	89.37	179.53	11979.0	-2405.2	749.9	0.00	0.00	2493.0	TGT 3 (Fruit Loop 29 #602H)
13	14444.6	89.69	179.53	11979.1	-2420.9	750.0	2.00	0.00	2508.5	
14	16260.3	89.69	179.53	11989.0	-4236.5	764.9	0.00	0.00	4304.0	TGT 4 (Fruit Loop 29 #602H)
15	16271.3	89.91	179.53	11989.0	-4247.5	765.0	2.00	0.00	4314.9	
16	16878.8	89.91	179.53	11990.0	-4855.0	770.0	0.00	0.00	4915.7	PBHL (Fruit Loop 29 #602H)

WELLBORE TARGET DETAILS (MAP CO-ORDINATES)

Name	TVD	+N/-S	+E/-W	Northing	Easting
KOP (Fruit Loop 29 #602H)	11371.0	263.0	728.0	530766.00	768106.00
TGT 1 (Fruit Loop 29 #602H)	11959.0	-758.0	736.4	529745.00	768114.38
TGT 2 (Fruit Loop 29 #602H)	11969.0	-1490.1	742.4	529012.90	768120.39
TGT 3 (Fruit Loop 29 #602H)	11979.0	-2405.2	749.9	528097.80	768127.90
TGT 4 (Fruit Loop 29 #602H)	11989.0	-4236.5	764.9	526266.50	768142.92
PBHL (Fruit Loop 29 #602H)	11990.0	-4855.0	770.0	525648.00	768148.00
FTP (Fruit Loop 29 #602H)	11944.0	213.0	728.0	530716.00	768106.00

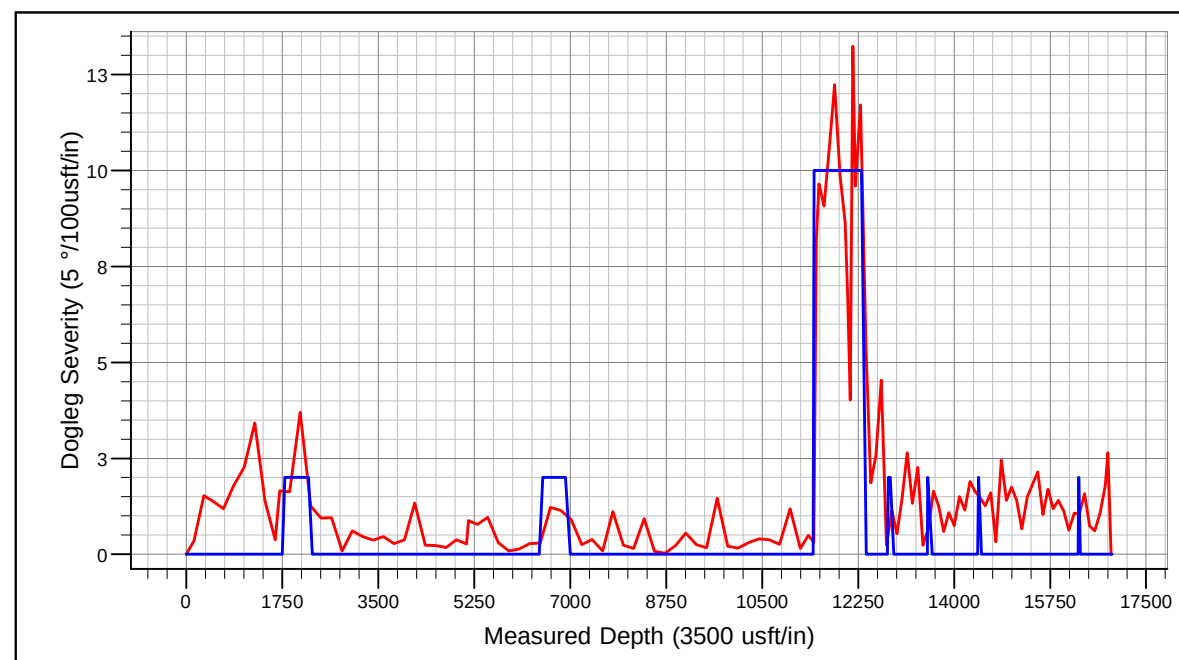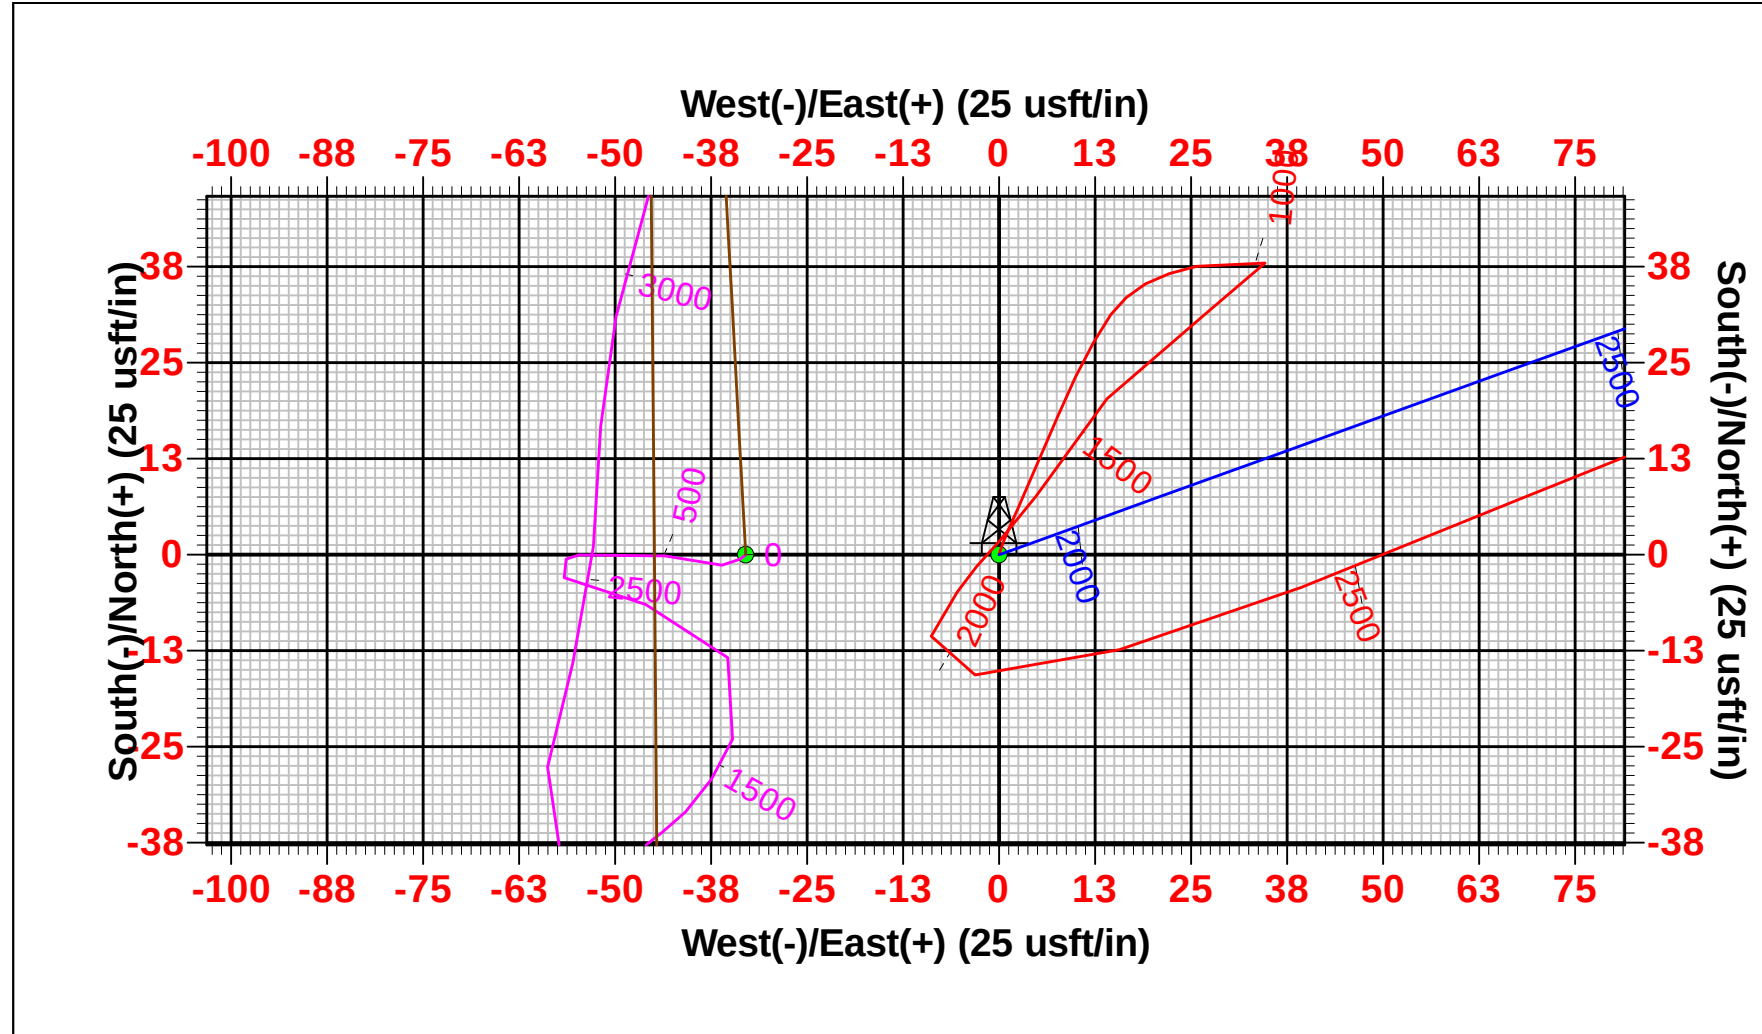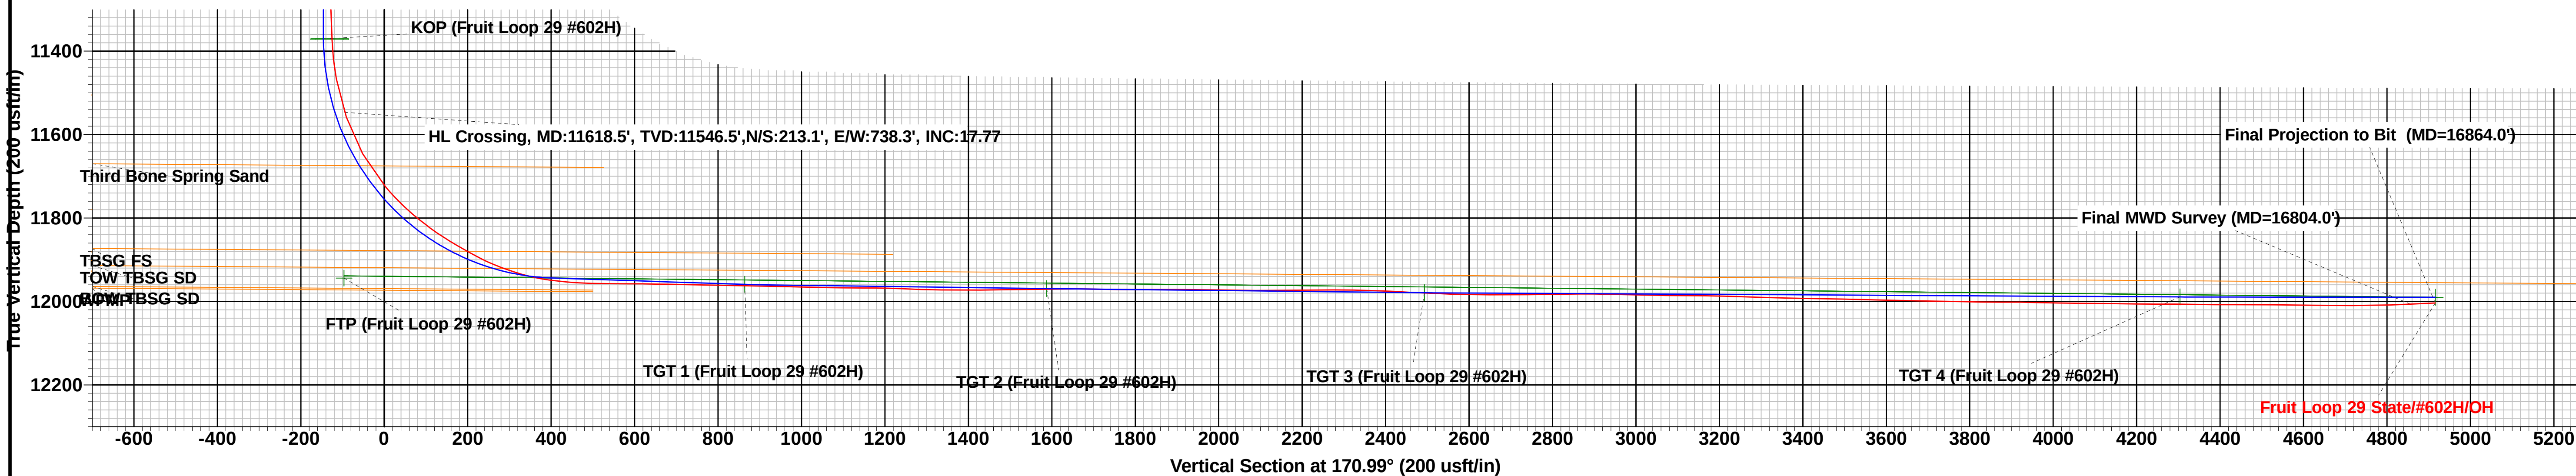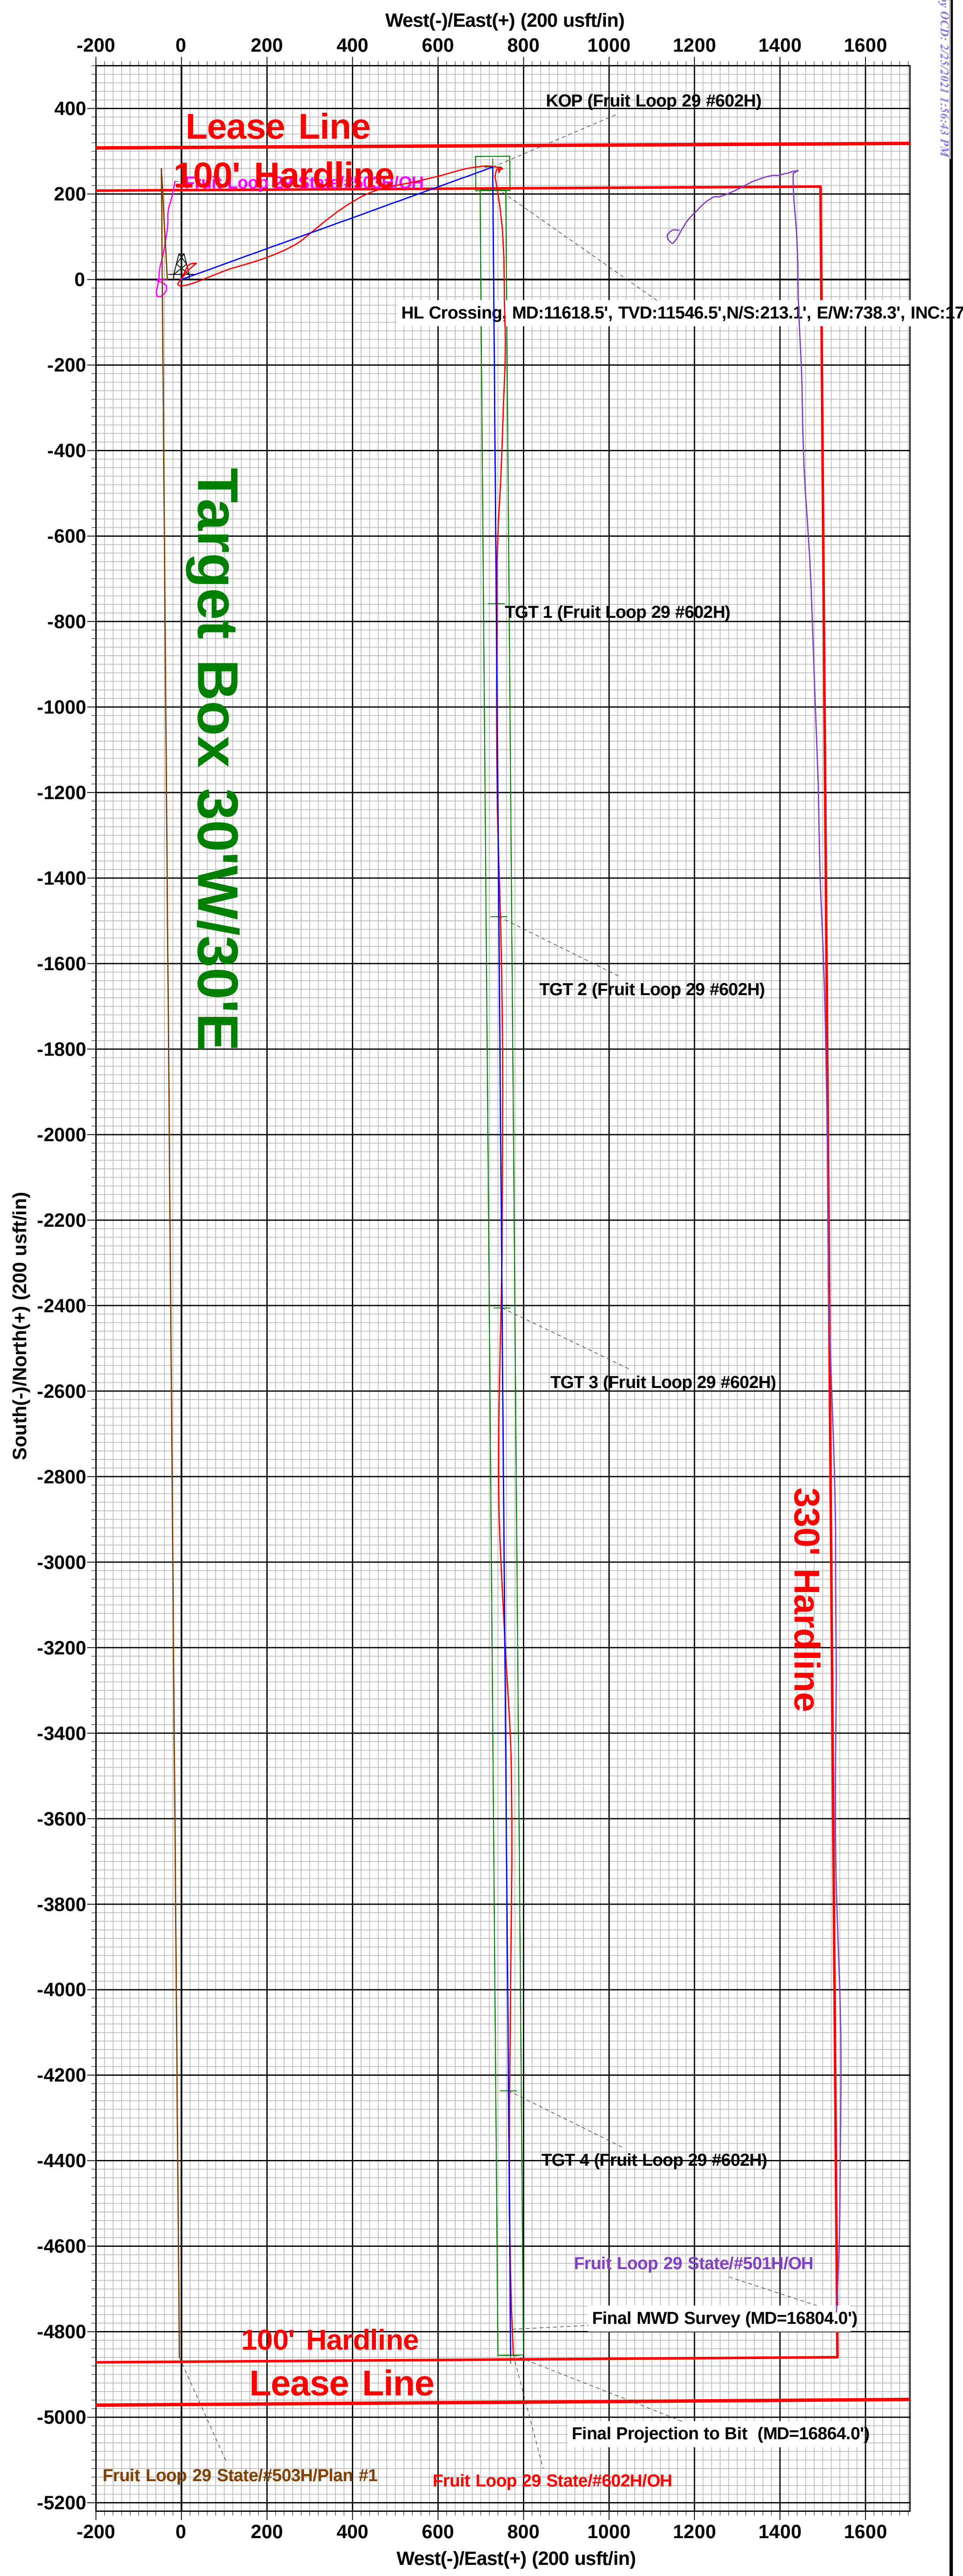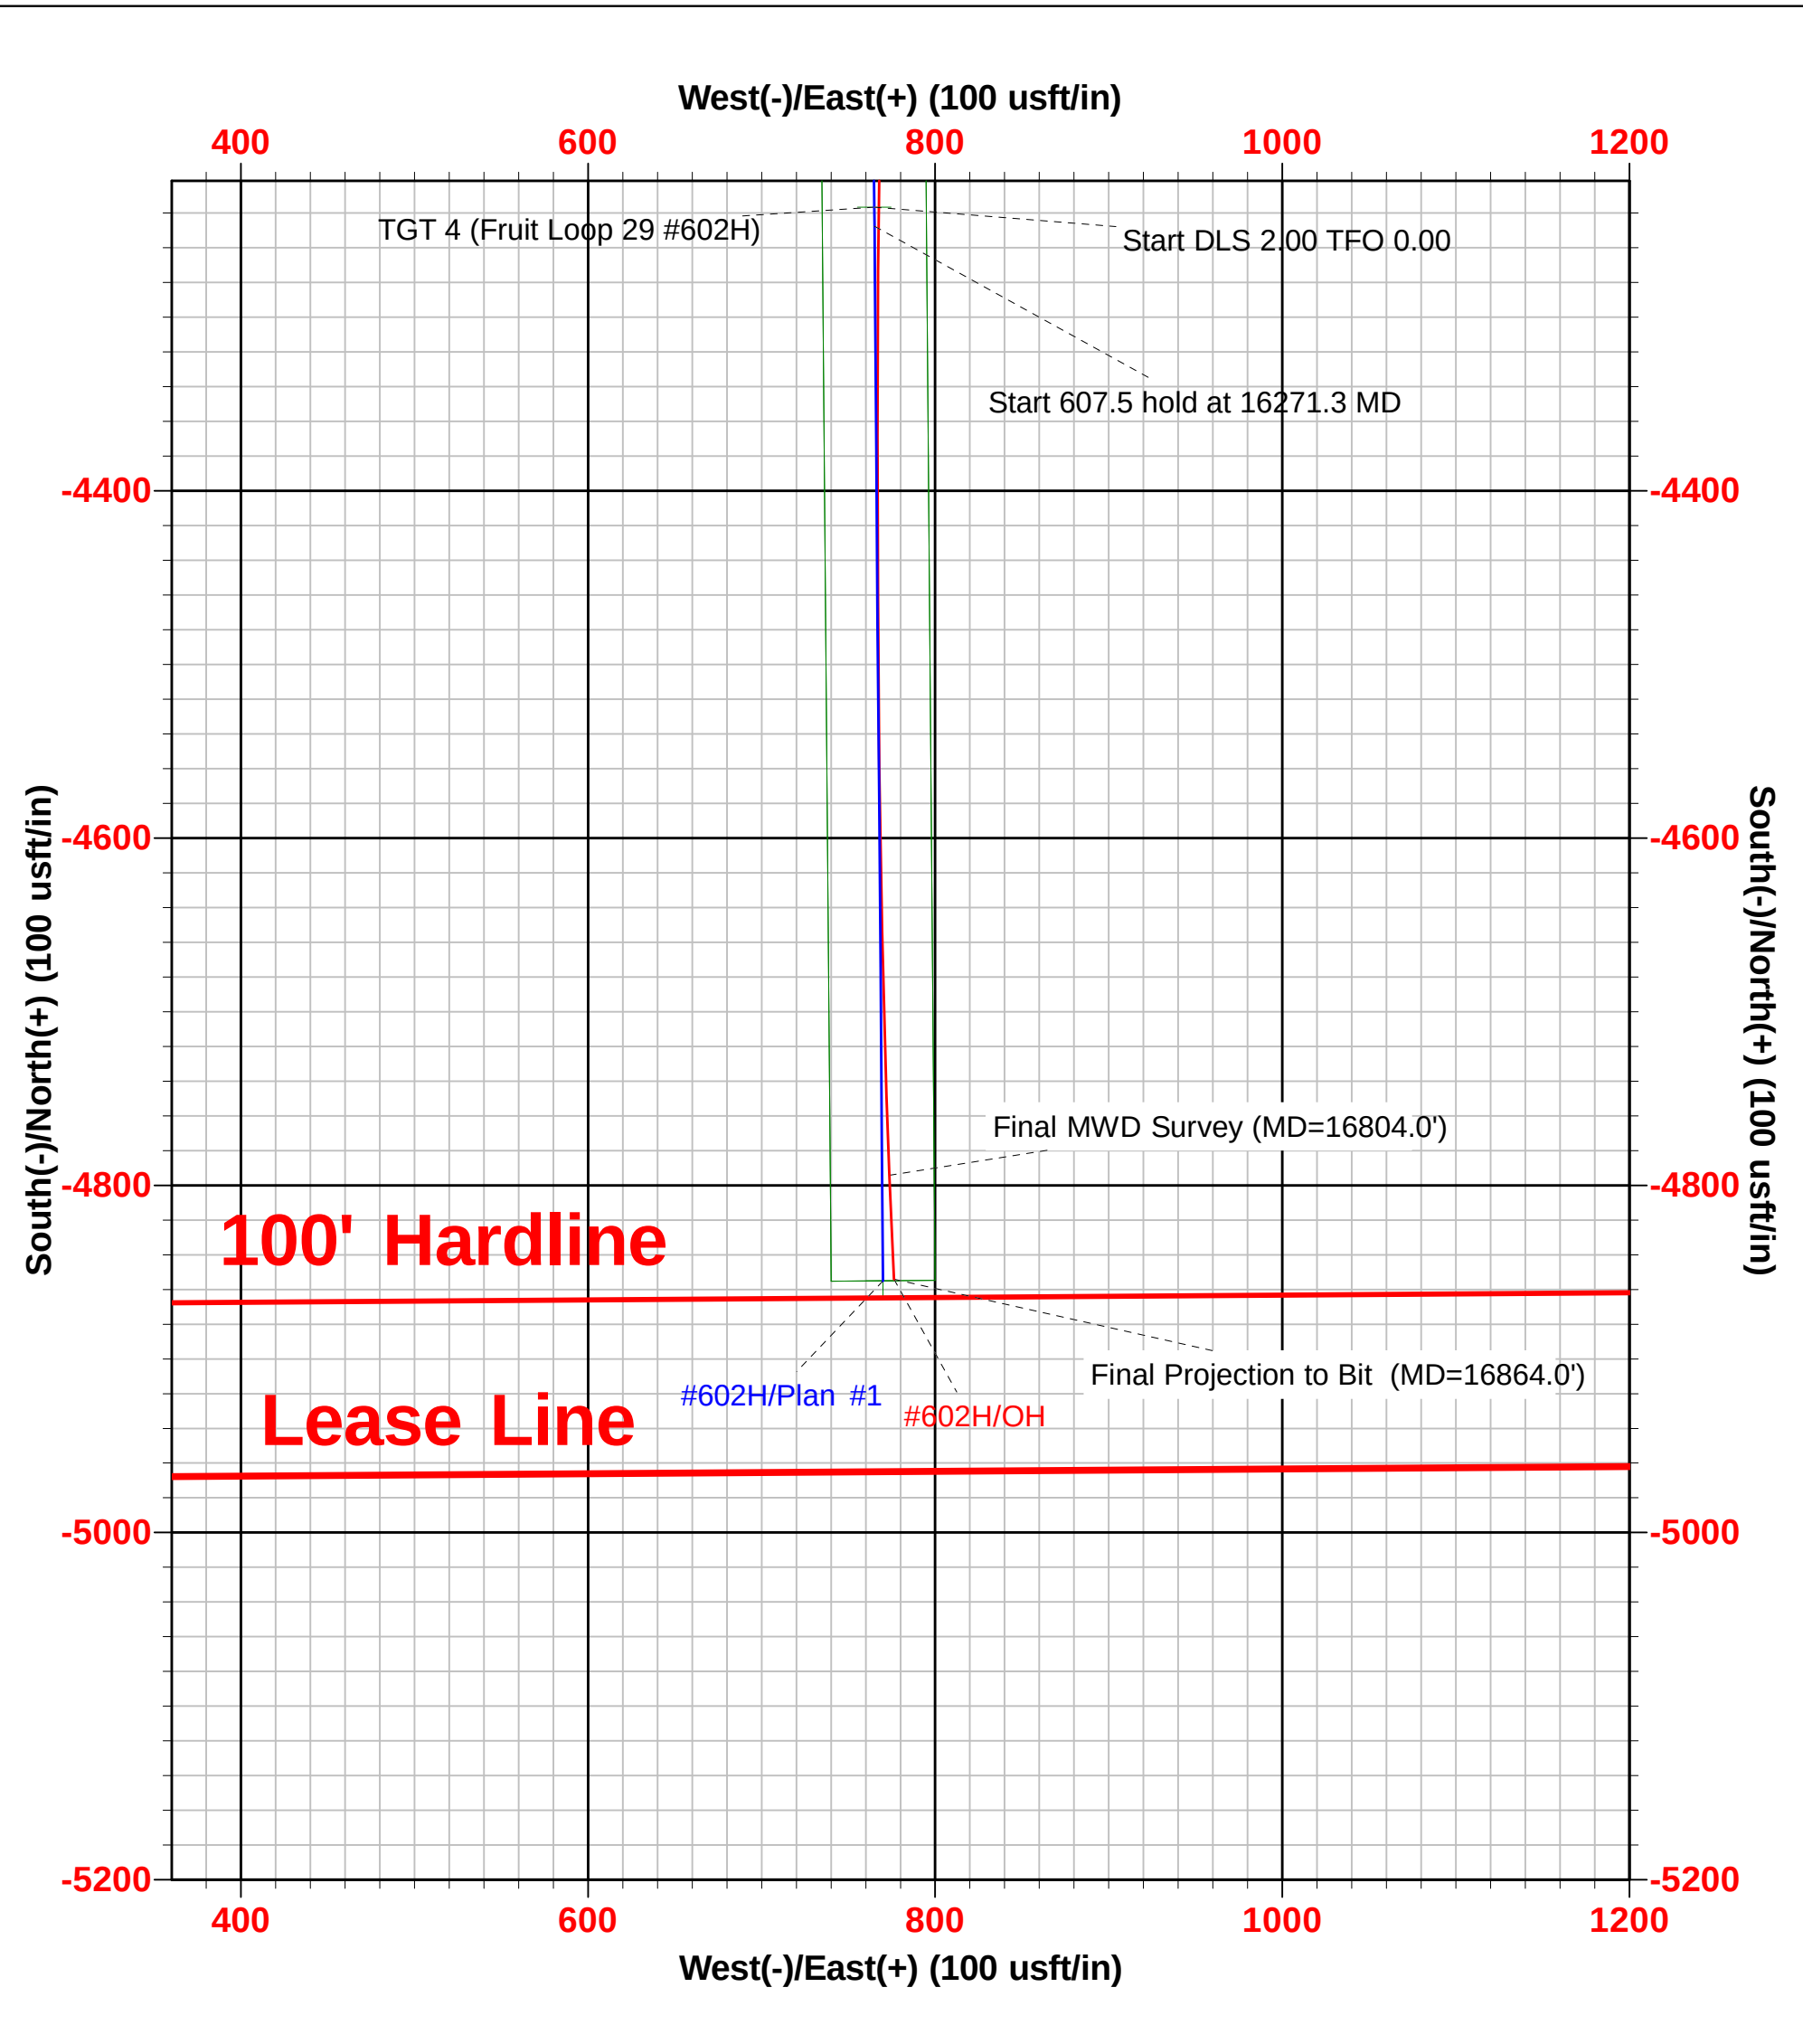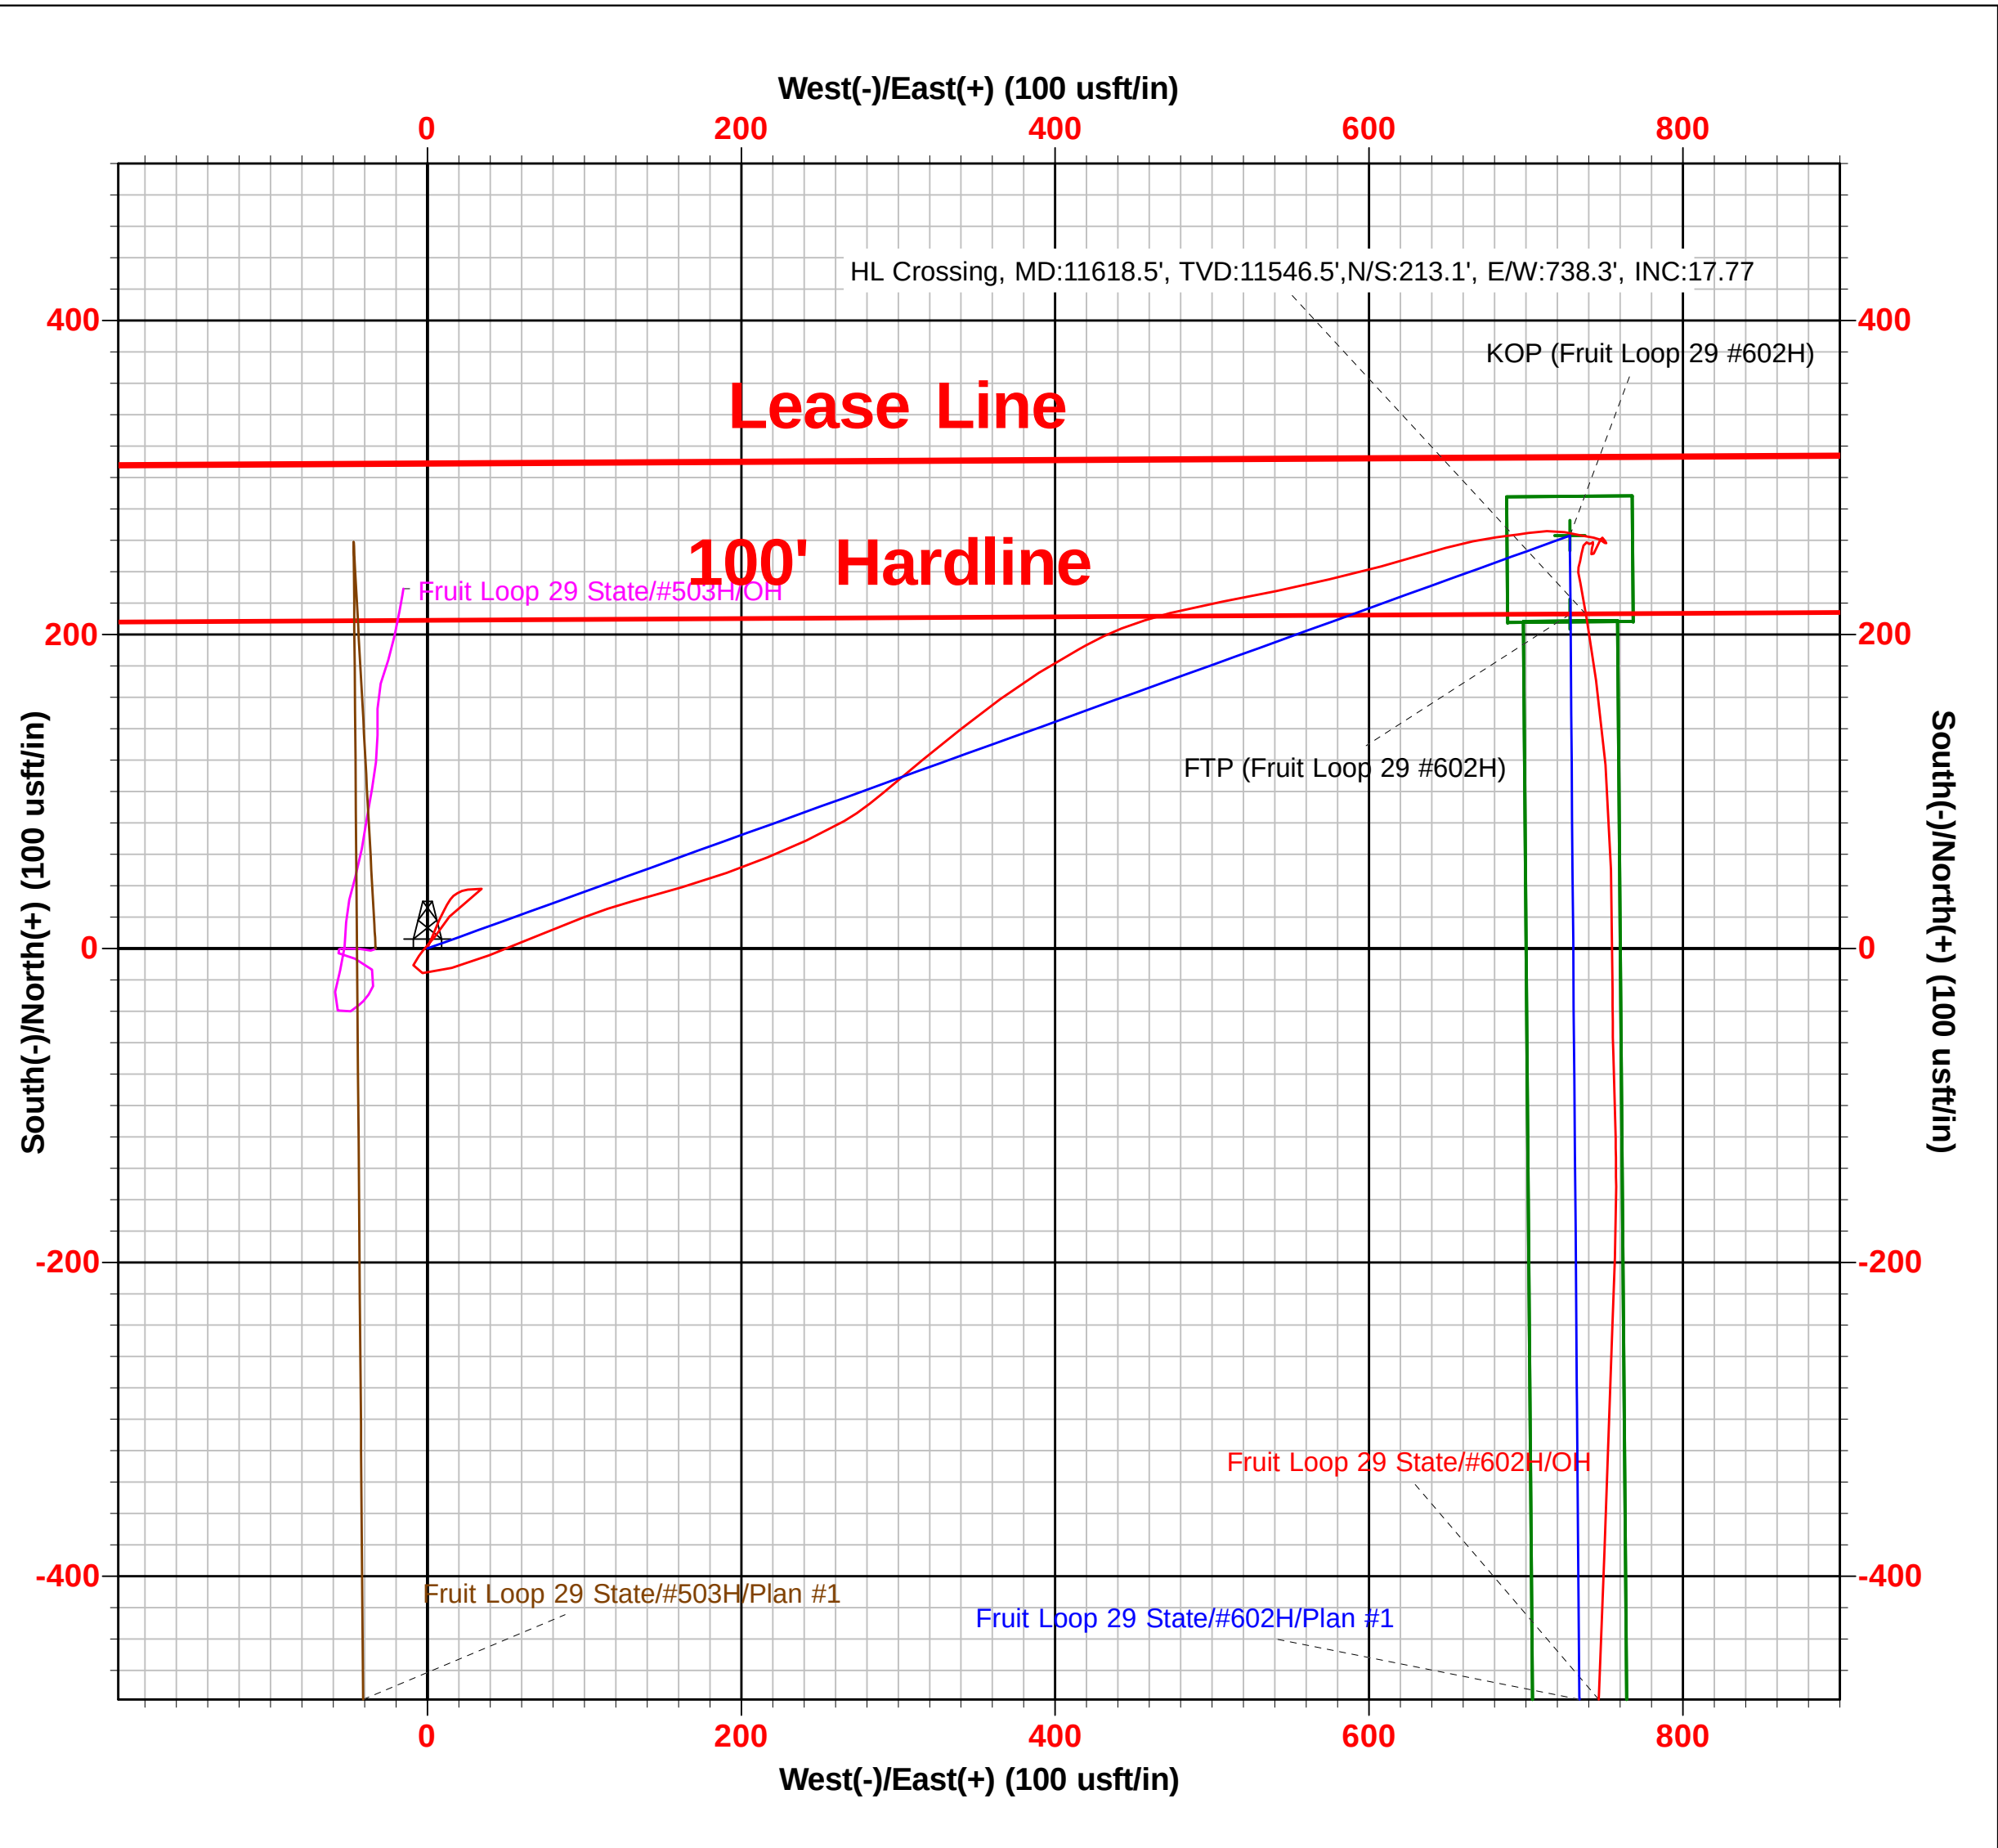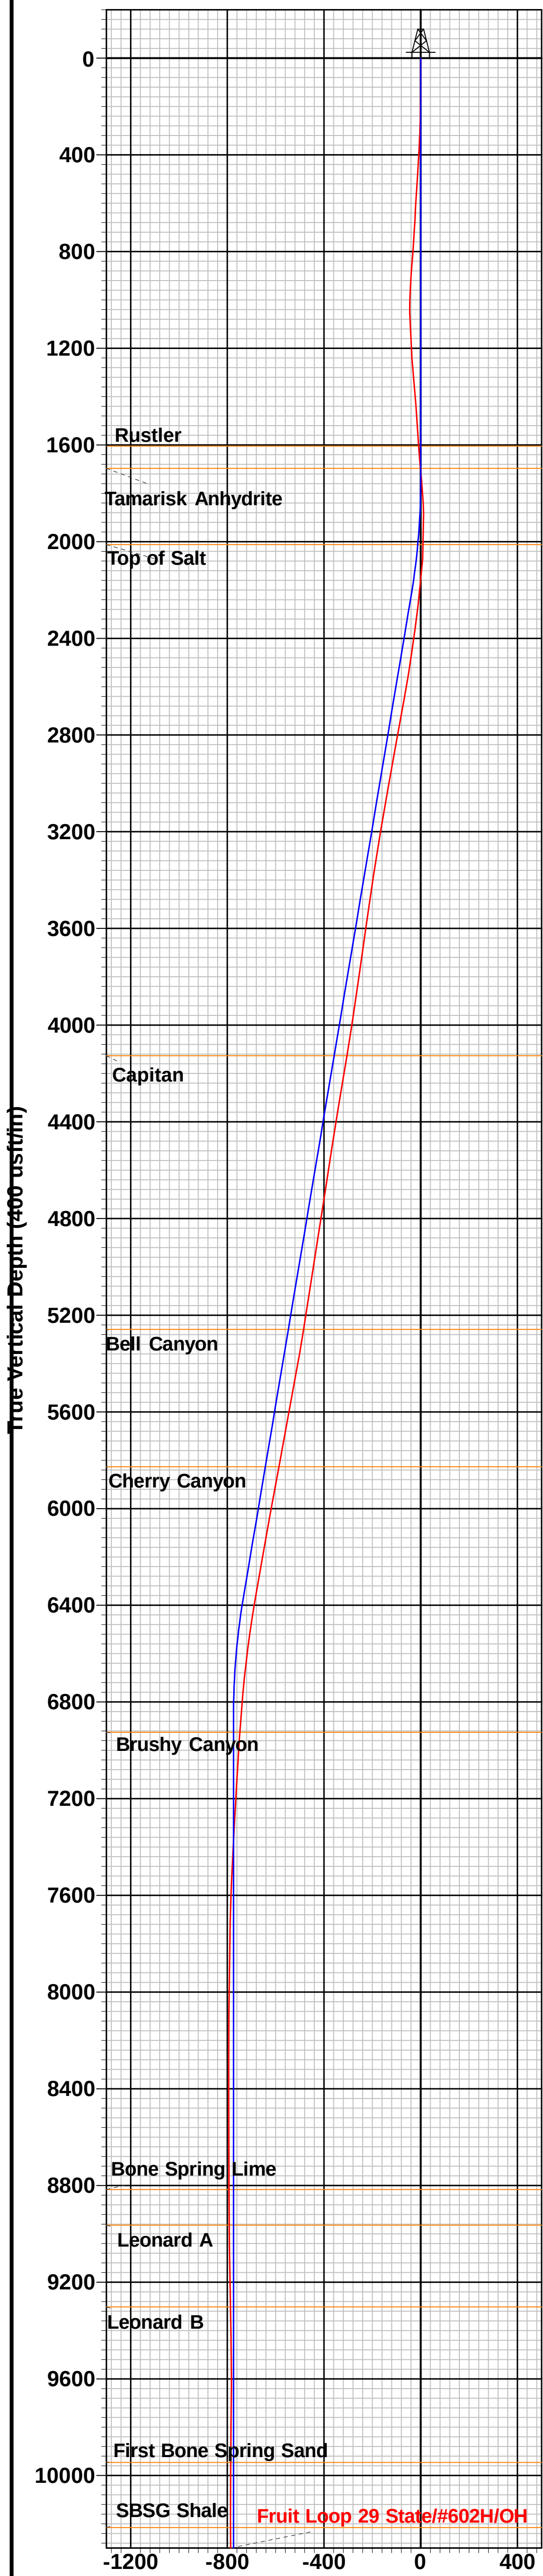

Intent ☐ As Drilled ☐

API #		
Operator Name:	Property Name:	Well Number

Kick Off Point (KOP)

UL	Section	Township	Range	Lot	Feet	From N/S	Feet	From E/W	County
Latitude					Longitude				NAD

First Take Point (FTP)

UL	Section	Township	Range	Lot	Feet	From N/S	Feet	From E/W	County
Latitude					Longitude				NAD

Last Take Point (LTP)

UL	Section	Township	Range	Lot	Feet	From N/S	Feet	From E/W	County
Latitude					Longitude				NAD

Is this well the defining well for the Horizontal Spacing Unit? ☐Is this well an infill well? ☐

If infill is yes please provide API if available, Operator Name and well number for Defining well for Horizontal Spacing Unit.

API #		
Operator Name:	Property Name:	Well Number

KZ 06/29/2018

Submit a Copy To Appropriate District Office
 District I – (575) 393-6161
 1625 N. French Dr., Hobbs, NM 88240
 District II – (575) 748-1283
 811 S. First St., Artesia, NM 88210
 District III – (505) 334-6178
 1000 Rio Brazos Rd., Aztec, NM 87410
 District IV – (505) 476-3460
 1220 S. St. Francis Dr., Santa Fe, NM 87505

State of New Mexico
 Energy, Minerals and Natural Resources

Form C-103
 Revised July 18, 2013

OIL CONSERVATION DIVISION
 1220 South St. Francis Dr.
 Santa Fe, NM 87505

WELL API NO. 30-025-44500
5. Indicate Type of Lease STATE ☒ FEE ☐
6. State Oil & Gas Lease No.
7. Lease Name or Unit Agreement Name FRUIT LOOP 29 STATE
8. Well Number 602H
9. OGRID Number 7377
10. Pool name or Wildcat WC025 G07 S213330F;BONE SPRING

SUNDRY NOTICES AND REPORTS ON WELLS (DO NOT USE THIS FORM FOR PROPOSALS TO DRILL OR TO DEEPEN OR PLUG BACK TO A DIFFERENT RESERVOIR. USE "APPLICATION FOR PERMIT" (FORM C-101) FOR SUCH PROPOSALS.)	
1. Type of Well: Oil Well ☒ Gas Well ☐ Other	
2. Name of Operator EOG RESOURCES INC	
3. Address of Operator PO BOX 2267 MIDLAND, TX 79702	
4. Well Location Unit Letter D : 309' feet from the NORTH line and 815' feet from the WEST line Section 29 Township 21S Range 33E NMPM County LEA	
11. Elevation (Show whether DR, RKB, RT, GR, etc.) 3752' GR	

12. Check Appropriate Box to Indicate Nature of Notice, Report or Other Data

NOTICE OF INTENTION TO:	SUBSEQUENT REPORT OF:
PERFORM REMEDIAL WORK ☐	REMEDIAL WORK ☐
TEMPORARILY ABANDON ☐	ALTERING CASING ☐
PULL OR ALTER CASING ☐	COMMENCE DRILLING OPNS. ☐
DOWNHOLE COMMINGLE ☐	P AND A ☐
CLOSED-LOOP SYSTEM ☐	CASING/CEMENT JOB ☐
OTHER: ☐	OTHER: Completion ☒

13. Describe proposed or completed operations. (Clearly state all pertinent details, and give pertinent dates, including estimated date of starting any proposed work). SEE RULE 19.15.7.14 NMAC. For Multiple Completions: Attach wellbore diagram of proposed completion or recompletion.

09/20/2019 Rig released
 10/03/2019 Test void to 5000 psi, seals & flanges to 8500 psi
 02/17/2020 Begin perf & frac
 02/23/2020 Finish 16 stages perf & frac, 12,221 - 16,864' 900 3 1/8" shots 11,552,990 lbs proppant + 163,966 bbls load fluid
 02/25/2020 Drilled out plugs and clean out wellbore
 01/18/2021 Opened well to flowback - Date of First Production

Spud Date:

08/31/2019

Rig Release Date:

09/20/2019

I hereby certify that the information above is true and complete to the best of my knowledge and belief.

SIGNATURE KAY MADDOX TITLE Senior Regulatory Specialist DATE 02/25/2021

Type or print name Kay Maddox E-mail address: kay_maddox@eogresources.com PHONE: 432-638-8475

For State Use Only

APPROVED BY: John Garcia TITLE Petroleum Engineer DATE 6/24/2021

Conditions of Approval (if any):

Submit To Appropriate District Office Two Copies <u>District I</u> 1625 N. French Dr., Hobbs, NM 88240 <u>District II</u> 811 S. First St., Artesia, NM 88210 <u>District III</u> 1000 Rio Brazos Rd., Aztec, NM 87410 <u>District IV</u> 1220 S. St. Francis Dr., Santa Fe, NM 87505		State of New Mexico Energy, Minerals and Natural Resources Oil Conservation Division 1220 South St. Francis Dr. Santa Fe, NM 87505			Form C-105 Revised August 1, 2011					
WELL COMPLETION OR RECOMPLETION REPORT AND LOG										
4. Reason for filing: ☒ COMPLETION REPORT (Fill in boxes #1 through #31 for State and Fee wells only) ☐ C-144 CLOSURE ATTACHMENT (Fill in boxes #1 through #9, #15 Date Rig Released and #32 and/or #33; attach this and the plat to the C-144 closure report in accordance with 19.15.17.13.K NMAC)								5. Lease Name or Unit Agreement Name		
								FRUIT LOOP 29 STATE		
								6. Well Number:		
								602H		
7. Type of Completion:										
☒ NEW WELL ☐ WORKOVER ☐ DEEPENING ☐ PLUGBACK ☐ DIFFERENT RESERVOIR ☐ OTHER _____										
8. Name of Operator							9. OGRID			
EOG RESOURCES INC							7377			
10. Address of Operator							11. Pool name or Wildcat			
PO BOX 2267 MIDLAND, TEXAS 79702							WC025 G07 S213330F;BONE SPRING			
12. Location	Unit Ltr	Section	Township	Range	Lot	Feet from the	N/S Line	Feet from the	E/W Line	County
Surface:	D	29	21S	33E		309'	NORTH	815'	WEST	LEA
BH:	N	29	21S	33E		109'	SOUTH	1551'	WEST	LEA
13. Date Spudded	14. Date T.D. Reached		15. Date Rig Released			16. Date Completed (Ready to Produce)		17. Elevations (DF and RKB, RT, GR, etc.)		
08/31/2019	09/19/2019		09/20/2019			01/18/2021		3752 GL		
18. Total Measured Depth of Well			19. Plug Back Measured Depth			20. Was Directional Survey Made?		21. Type Electric and Other Logs Run		
MD 16,864' TVD 12,003'			MD 16,864' TVD 12,003'			YES		None		
22. Producing Interval(s), of this completion - Top, Bottom, Name										
BONE SPRING 12,221-16,864'										
CASING RECORD (Report all strings set in well)										
CASING SIZE		WEIGHT LB./FT.		DEPTH SET		HOLE SIZE		CEMENTING RECORD		AMOUNT PULLED
13 3/8"		54.5# J-55		1746'		17 1/2"		1745 CL C/CIRC		
9 5/8"		40# J-55		5204'		12 1/4"		1992 CL C/CIRC		
5 1/2"		20# HCP 110		16,844'		8 1/2"		3515 CL H/CIRC		
24. LINER RECORD						25. TUBING RECORD				
SIZE	TOP	BOTTOM	SACKS CEMENT	SCREEN		SIZE	DEPTH SET	PACKER SET		
26. Perforation record (interval, size, and number)						27. ACID, SHOT, FRACTURE, CEMENT, SQUEEZE, ETC.				
12,221 - 16,864' 3 1/8", 900 holes						DEPTH INTERVAL		AMOUNT AND KIND MATERIAL USED		
						12,221 - 16,864'		FRAC W/11,552,990 lbs proppant, 163,966 bbls load fld		
PRODUCTION										
Date First Production		Production Method (Flowing, gas lift, pumping - Size and type pump)				Well Status (Prod. or Shut-in)				
01/18/2021		Flowing				Producing				
Date of Test	Hours Tested	Choke Size	Prod'n For Test Period	Oil - Bbl	Gas - MCF	Water - Bbl.	Gas - Oil Ratio			
01/22/2021	24	64		2070	4215	6264	2036			
Flow Tubing Press.	Casing Pressure	Calculated 24-Hour Rate	Oil - Bbl.	Gas - MCF	Water - Bbl.	Oil Gravity - API - (Corr.)				
	559					45				
29. Disposition of Gas (Sold, used for fuel, vented, etc.)								30. Test Witnessed By		
SOLD										
31. List Attachments										
C-102, C-104, C-103, Directional Survey, H spacing, Gas capture										
32. If a temporary pit was used at the well, attach a plat with the location of the temporary pit.										
33. If an on-site burial was used at the well, report the exact location of the on-site burial:										
Latitude _____ Longitude _____ NAD 1927 1983										
I hereby certify that the information shown on both sides of this form is true and complete to the best of my knowledge and belief										
Signature Kay Maddox			Name Kay Maddox			Title Senior Regulatory Specialist			Date 02/25/2021	
E-mail Address kay_maddox@eogresources.com										

This form is to be filed with the appropriate District Office of the Division not later than 20 days after the completion of any newly-drilled or deepened well and not later than 60 days after completion of closure. When submitted as a completion report, this shall be accompanied by one copy of all electrical and radio-activity logs run on the well and a summary of all special tests conducted, including drill stem tests. All depths reported shall be measured depths. In the case of directionally drilled wells, true vertical depths shall also be reported. For multiple completions, items 11, 12 and 26-31 shall be reported for each zone.

Southeastern New Mexico			Northwestern New Mexico				
T. Anhy	Rustler	1605'	T. Canyon	Brushy	6925'	T. Ojo Alamo	T. Penn A"
T. Salt		2012'	T. Strawn			T. Kirtland	T. Penn. "B"
B. Salt		4557'	T. Atoka			T. Fruitland	T. Penn. "C"
T. Yates			T. Miss			T. Pictured Cliffs	T. Penn. "D"
T. 7 Rivers			T. Devonian			T. Cliff House	T. Leadville
T. Queen			T. Silurian			T. Menefee	T. Madison
T. Grayburg			T. Montoya			T. Point Lookout	T. Elbert
T. San Andres			T. Simpson			T. Mancos	T. McCracken
T. Glorieta			T. McKee			T. Gallup	T. Ignacio Otzte
T. Paddock			T. Ellenburger			Base Greenhorn	T. Granite
T. Blinebry			T. Gr. Wash			T. Dakota	
T. Tubb			T. Delaware Sand			T. Morrison	
T. Drinkard			T. Bone Springs			T. Todilto	
T. Abo			T. 1st BS Sand	9946'		T. Entrada	
T. Wolfcamp			T. 2nd BS Sand	10,553'		T. Wingate	
T. Penn			T.			T. Chinle	
T. Cisco (Bough C)			T.			T. Permian	

No. 1, from.....to.....
No. 2, from.....to.....
No. 3, from.....to.....
No. 4, from.....to.....

Include data on rate of water inflow and elevation to which water rose in hole.

No. 1, from.....to.....feet.....
 No. 2, from.....to.....feet.....
 No. 3, from.....to.....feet.....

From	To	Thickness In Feet	Lithology

From	To	Thickness In Feet	Lithology

District I

1625 N. French Dr., Hobbs, NM 88240
Phone:(575) 393-6161 Fax:(575) 393-0720

District II

811 S. First St., Artesia, NM 88210
Phone:(575) 748-1283 Fax:(575) 748-9720

District III

1000 Rio Brazos Rd., Aztec, NM 87410
Phone:(505) 334-6178 Fax:(505) 334-6170

District IV

1220 S. St Francis Dr., Santa Fe, NM 87505
Phone:(505) 476-3470 Fax:(505) 476-3462

State of New Mexico
Energy, Minerals and Natural Resources
Oil Conservation Division
1220 S. St Francis Dr.
Santa Fe, NM 87505

ACKNOWLEDGMENTS

Action 19005

ACKNOWLEDGMENTS

Operator: EOG RESOURCES INC P.O. Box 2267 Midland, TX 79702	OGRID: 7377
	Action Number: 19005
	Action Type: [C-104] Completion Packet (C-104C)

ACKNOWLEDGMENTS

☐	I hereby certify that the required Water Use Report has been, or will be, submitted for this wells completion.
☐	I hereby certify that the required FracFocus disclosure has been, or will be, submitted for this wells completion.

District I
1625 N. French Dr., Hobbs, NM 88240
Phone:(575) 393-6161 Fax:(575) 393-0720
District II
811 S. First St., Artesia, NM 88210
Phone:(575) 748-1283 Fax:(575) 748-9720
District III
1000 Rio Brazos Rd., Aztec, NM 87410
Phone:(505) 334-6178 Fax:(505) 334-6170
District IV
1220 S. St Francis Dr., Santa Fe, NM 87505
Phone:(505) 476-3470 Fax:(505) 476-3462

State of New Mexico
Energy, Minerals and Natural Resources
Oil Conservation Division
1220 S. St Francis Dr.
Santa Fe, NM 87505

CONDITIONS

Action 19005

CONDITIONS

Operator: EOG RESOURCES INC P.O. Box 2267 Midland, TX 79702	OGRID: 7377
	Action Number: 19005
	Action Type: [C-104] Completion Packet (C-104C)

CONDITIONS

Created By	Condition	Condition Date
plmartinez	None	6/24/2021