

District I
1625 N. French Dr., Hobbs, NM 88240
District II
811 S. First St., Artesia, NM 88210
District III
1000 Rio Brazos Rd., Aztec, NM 87410
District IV
1220 S. St. Francis Dr., Santa Fe, NM 87505

State of New Mexico
Energy, Minerals & Natural
Resources

Form C-104
Revised August 1, 2011

Submit one copy to appropriate District Office

Oil Conservation Division
1220 South St. Francis Dr.

☐ AMENDED REPORT

I. REQUEST FOR ALLOWABLE MINERAL AUTHORIZATION TO TRANSPORT

¹ Operator name and Address EOG RESOURCES INC PO BOX 2267 MIDLAND, TEXAS 79702		² OGRID Number 7377	
		³ Reason for Filing Code/ Effective Date NW 03/18/2021	
⁴ API Number 30 - 025-47410	⁵ Pool Name SANDERS TANK; UPPER WOLFCAMP		⁶ Pool Code 98097
⁷ Property Code 327331	⁸ Property Name DOGWOOD 26 FEDERAL COM		⁹ Well Number 745H

II. ¹⁰ Surface Location

Ul or lot no.	Section	Township	Range	Lot Idn	Feet from the	North/South Line	Feet from the	East/West line	County
B	26	26S	33E		396'	NORTH	2634'	EAST	LEA

¹¹ Bottom Hole Location

UL or lot no.	Section	Township	Range	Lot Idn	Feet from the	North/South line	Feet from the	East/West line	County
C	14	26S	33E		110'	NORTH	1841'	WEST	LEA
¹² Lse Code	¹³ Producing Method Code FLOWING	¹⁴ Gas Connection Date	¹⁵ C-129 Permit Number	¹⁶ C-129 Effective Date	¹⁷ C-129 Expiration Date				

III. Oil and Gas Transporters

¹⁸ Transporter OGRID	¹⁹ Transporter Name and Address	²⁰ O/G/W
372812	EOGRM	OIL
151618	ENTERPRISE FIELD SERVICES	GAS
298751	REGENCY FIELD SERVICES	GAS
36785	DCP MIDSTREAM	GAS

IV. Well Completion Data

²¹ Spud Date 09/01/2020	²² Ready Date 03/18/2021	²³ TD 23,729'	²⁴ PBTD 23,697'	²⁵ Perforations 13,384 - 23,697'	²⁶ DHC, MC
²⁷ Hole Size	²⁸ Casing & Tubing Size	²⁹ Depth Set	³⁰ Sacks Cement		
12 1/4	9 5/8"	954'	455 SXS CL C/CIRC		
8 3/4"	7 5/8"	12,834'	1545 SXS CL C&H/CIRC TOC 28' ECHO		
6 3/4"	5 1/2"	23,705'	1170 SXS CL H TOC 5244' CBL		

V. Well Test Data

³¹ Date New Oil 03/18/2021	³² Gas Delivery Date 03/18/2021	³³ Test Date 03/25/2021	³⁴ Test Length 24 HRS	³⁵ Tbg. Pressure	³⁶ Csg. Pressure 1216
³⁷ Choke Size 72	³⁸ Oil 2055	³⁹ Water 12,056	⁴⁰ Gas 5149		⁴¹ Test Method

⁴² I hereby certify that the rules of the Oil Conservation Division have been complied with and that the information given above is true and complete to the best of my knowledge and belief. Signature: Kay Maddox Printed name: Kay Maddox Title: SENIOR REGULATORY SPECIALIST E-mail Address: kay_maddox@eogresources.com Date: 04/13/2021	Phone: 432-638-8475	OIL CONSERVATION DIVISION
		Approved by: PATRICIA MARTINEZ
		Title: PETROLEUM SPECIALIST
		Approval Date: 7/28/2021

District I
1625 N. French Dr., Hobbs, NM 88240
Phone: (575) 393-6161 Fax: (575) 393-0720

District II
811 S. First St., Artesia, NM 88210
Phone: (575) 748-1283 Fax: (575) 748-9720

District III
1000 Rio Brazos Road, Aztec, NM 87410
Phone: (505) 334-6178 Fax: (505) 334-6170

District IV
1220 S. St. Francis Dr., Santa Fe, NM 87505
Phone: (505) 476-3460 Fax: (505) 476-3462

State of New Mexico
Energy, Minerals & Natural Resources
Department
OIL CONSERVATION DIVISION
1220 South St. Francis Dr.
Santa Fe, NM 87505

FORM C-102

Revised August 1, 2011

Submit one copy to appropriate

District Office

☐ AMENDED REPORT

WELL LOCATION AND ACREAGE DEDICATION PLAT

¹ API Number 30-025-47410	² Pool Code 98097	³ Pool Name SANDERS TANK; UPPER WOLFCAMP
⁴ Property Code 327331	⁵ Property Name DOGWOOD 26 FED COM	⁶ Well Number 745H
⁷ GRID No. 7377	⁸ Operator Name EOG RESOURCES, INC.	⁹ Elevation 3310'


¹⁰Surface Location



UL or lot no.	Section	Township	Range	Lot Idn	Feet from the	North/South line	Feet from the	East/West line	County
B	26	26-S	33-E	-	396'	NORTH	2634'	EAST	LEA

¹¹Bottom Hole Location If Different From Surface

UL or lot no.	Section	Township	Range	Lot Idn	Feet from the	North/South line	Feet from the	East/West line	County
C	14	26-S	33-E	-	110'	NORTH	1841'	WEST	LEA

¹² Dedicated Acres 1280.00	¹³ Joint or Infill	¹⁴ Consolidation Code	¹⁵ Order No.
--	-------------------------------	----------------------------------	-------------------------

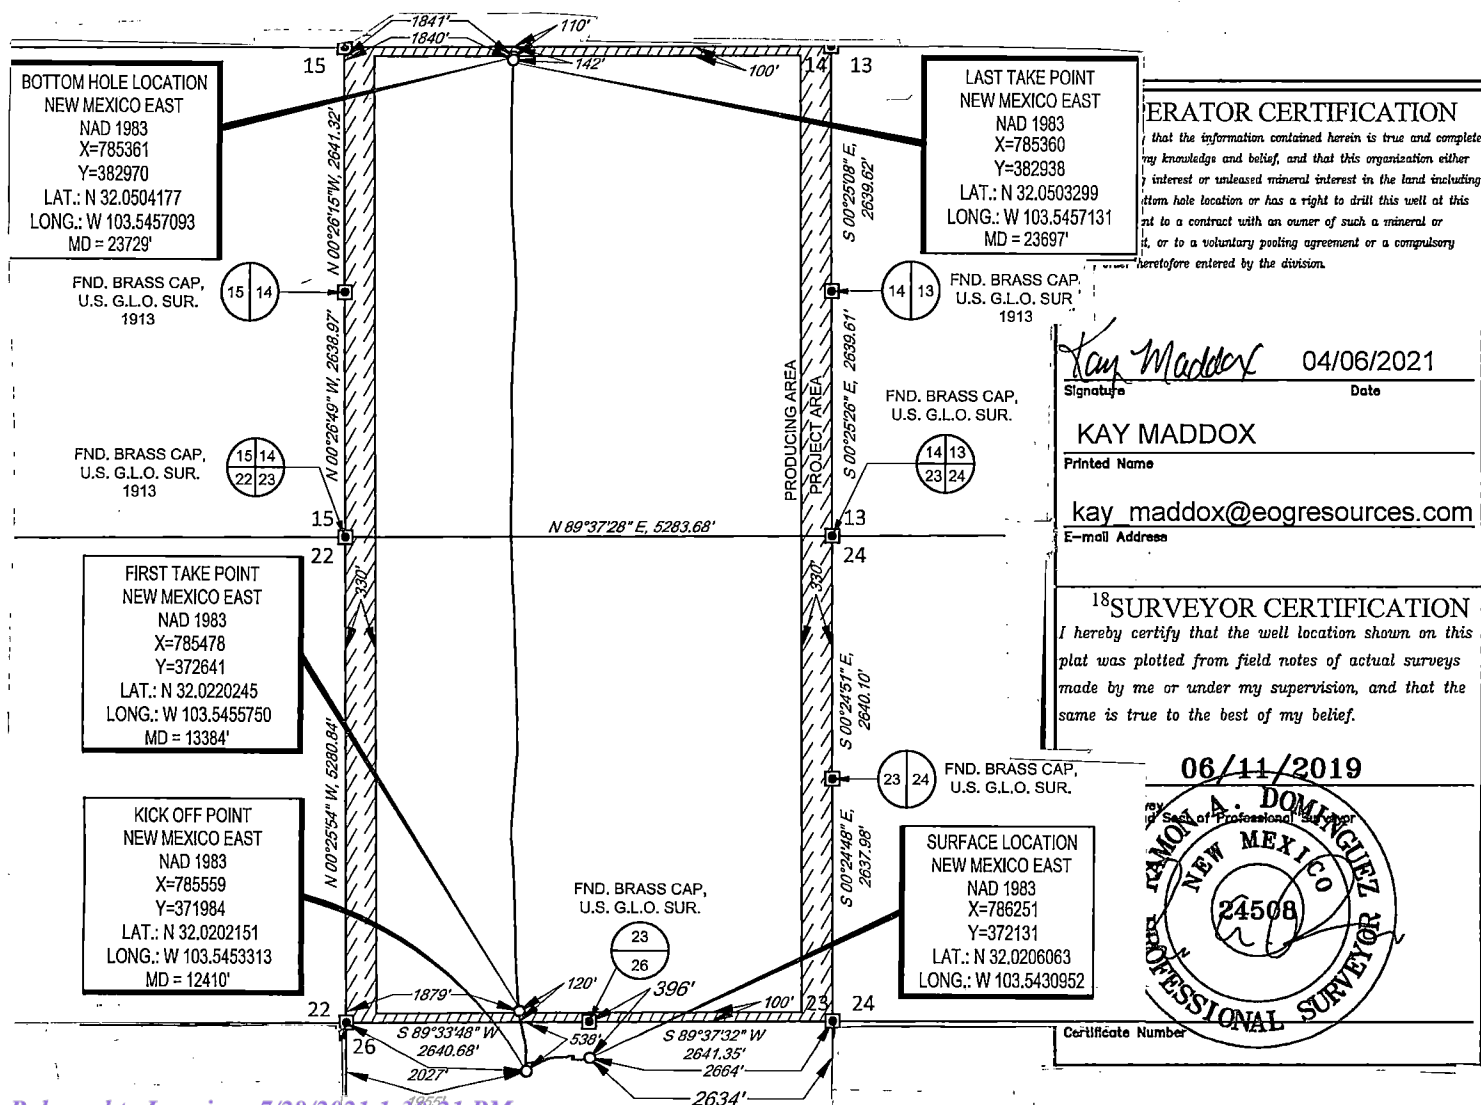

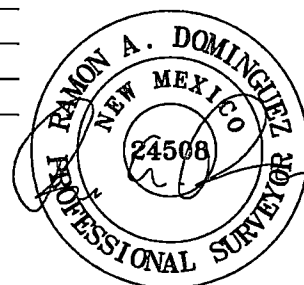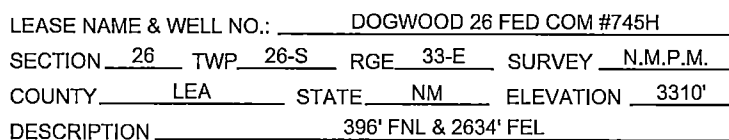

Ramon A. Dominguez, P.S. No. 24508
February 11, 2021



 **TOPOGRAPHIC**
LOYALTY INNOVATION LEGACY

1400 EVERMAN PARKWAY, Ste. 146 • FT. WORTH, TEXAS 76140
TELEPHONE: (817) 744-7512 • FAX (817) 744-7554
2903 NORTH BIG SPRING • MIDLAND, TEXAS 79705
TELEPHONE: (432) 682-1653 OR (800) 767-1653 • FAX (432) 682-1743
WWW.TOPOGRAPHIC.COM

DOGWOOD 26 FED COM #745H AS-COMPLETE	REVISION:		NOTES: 1. ORIGINAL DOCUMENT SIZE: 8.5" X 11" 2. ALL BEARINGS, DISTANCES, AND COORDINATE VALUES CONTAINED HEREIN ARE GRID BASED UPON THE NEW MEXICO COORDINATE SYSTEM OF 1983, EAST ZONE, U.S. SURVEY FEET. 3. THIS WELL LOCATION SHOWN HEREON HAS BEEN SURVEYED ON THE GROUND UNDER MY SUPERVISION AND PREPARED ACCORDING TO THE EVIDENCE FOUND AT THE TIME OF SURVEY, AND DATA PROVIDED BY EOG RESOURCES, INC. THIS CERTIFICATION IS MADE AND LIMITED TO THOSE PERSONS OR ENTITIES SHOWN ON THE FACE OF THIS PLAT AND IS NON-TRANSFERABLE. THIS SURVEY IS CERTIFIED FOR THIS TRANSACTION ONLY.
DATE: 02/11/2021			
FILE:AD_DOGWOOD_26_FED_COM_745H			
DRAWN BY: IMU			
SHEET: 1 OF 1			

Z:\SURVEY\EOG MIDLAND\DOGWOOD 26 FED COM\FINAL PRODUCTS\AD DOGWOOD 26 FED COM 745H.DWG 4/8/2021 11:46:04 AM echoa



EOG Resources - Midland

Lea County, NM (NAD 83 NME)

Dogwood 26 Fed Com

#745H

OH

Design: OH

Midland PVA

02 November, 2020



EOG Resources

Midland PVA

Company:	EOG Resources - Midland	Local Co-ordinate Reference:	Well #745H
Project:	Lea County, NM (NAD 83 NME)	TVD Reference:	KB = 22' @ 3332.0usft
Site:	Dogwood 26 Fed Com	MD Reference:	KB = 22' @ 3332.0usft
Well:	#745H	North Reference:	Grid
Wellbore:	OH	Survey Calculation Method:	Minimum Curvature
Design:	OH	Database:	EDM

Project	Lea County, NM (NAD 83 NME)		
Map System:	US State Plane 1983	System Datum:	Mean Sea Level
Geo Datum:	North American Datum 1983		
Map Zone:	New Mexico Eastern Zone		

Site	Dogwood 26 Fed Com		
Site Position:		Northing:	372,288.00 usft
From:	Map	Easting:	787,910.00 usft
Position Uncertainty:	0.0 usft	Slot Radius:	13-3/16 "
		Latitude:	32° 1' 15.616 N
		Longitude:	103° 32' 15.855 W
		Grid Convergence:	0.42 °

Well		#745H				
Well Position	+N/-S	0.0 usft	Northing:	372,131.00 usft	Latitude:	32° 1' 14.182 N
	+E/-W	0.0 usft	Easting:	786,251.00 usft	Longitude:	103° 32' 35.137 W
Position Uncertainty		0.0 usft	Wellhead Elevation:	usft	Ground Level:	3,310.0 usft

Wellbore	OH				
Magnetics	Model Name	Sample Date	Declination (°)	Dip Angle (°)	Field Strength (nT)
	IGRF2020	11/7/2020	6.59	59.74	47,439.70584417

Design	OH			
Audit Notes:				
Version:	1.0	Phase:	ACTUAL	Tie On Depth: 0.0
Vertical Section:	Depth From (TVD) (usft)	+N/-S (usft)	+E/-W (usft)	Direction (°)
	0.0	0.0	0.0	355.25

Survey Program	Date	11/2/2020		
From (usft)	To (usft)	Survey (Wellbore)	Tool Name	Description
124.0	23,729.0	Driltech MWD (OH)	EOG MWD+IFR1	MWD + IFR1



EOG Resources

Midland PVA

Company:	EOG Resources - Midland	Local Co-ordinate Reference:	Well #745H
Project:	Lea County, NM (NAD 83 NME)	TVD Reference:	KB = 22' @ 3332.0usft
Site:	Dogwood 26 Fed Com	MD Reference:	KB = 22' @ 3332.0usft
Well:	#745H	North Reference:	Grid
Wellbore:	OH	Survey Calculation Method:	Minimum Curvature
Design:	OH	Database:	EDM

Survey											
MD (usft)	Inc (°)	Azi (azimuth) (°)	TVD (usft)	N/S (usft)	E/W (usft)	DLeg (°/100usft)	Build (°/100usft)	Turn (°/100usft)	High to Plan (usft)	Right to Plan (usft)	
0.0	0.00	0.00	0.0	0.0	0.0	0.00	0.00	0.00	0.0	0.0	
124.0	0.17	127.91	124.0	-0.1	0.1	0.14	0.14	0.00	-0.2	0.0	
216.0	0.44	214.18	216.0	-0.5	0.1	0.50	0.29	93.77	-0.4	0.3	
306.0	0.53	206.62	306.0	-1.1	-0.3	0.12	0.10	-8.40	-1.2	0.2	
495.0	0.53	208.73	495.0	-2.7	-1.1	0.01	0.00	1.12	-2.9	0.3	
685.0	0.88	268.14	685.0	-3.5	-3.0	0.40	0.18	31.27	-3.1	3.4	
876.0	0.88	268.76	876.0	-3.6	-6.0	0.00	0.00	0.32	-6.0	3.5	
900.0	0.88	254.34	899.9	-3.6	-6.3	0.92	0.00	-60.08	-7.1	1.8	
971.0	1.14	254.96	970.9	-4.0	-7.5	0.37	0.37	0.87	-8.3	1.9	
1,161.0	4.48	262.25	1,160.7	-5.5	-16.7	1.76	1.76	3.84	-16.6	3.2	
1,352.0	4.57	259.70	1,351.1	-7.8	-31.6	0.12	0.05	-1.34	-21.5	3.5	
1,542.0	5.10	259.35	1,540.4	-10.7	-47.3	0.28	0.28	-0.18	-17.0	6.1	
1,733.0	5.63	264.19	1,730.6	-13.3	-65.0	0.36	0.28	2.53	-12.5	9.3	
1,923.0	5.10	262.69	1,919.7	-15.3	-82.6	0.29	-0.28	-0.79	-9.0	10.4	
2,113.0	5.01	262.43	2,109.0	-17.5	-99.2	0.05	-0.05	-0.14	-4.3	12.1	
2,303.0	5.01	266.12	2,298.3	-19.1	-115.7	0.17	0.00	1.94	1.6	13.3	
2,494.0	5.54	268.14	2,488.5	-20.0	-133.3	0.29	0.28	1.06	6.2	13.1	
2,684.0	5.72	271.48	2,677.6	-20.0	-151.9	0.20	0.09	1.76	9.8	11.6	
2,875.0	4.57	280.36	2,867.8	-18.4	-168.9	0.73	-0.60	4.65	15.6	6.4	
3,065.0	3.43	286.86	3,057.3	-15.4	-181.8	0.64	-0.60	3.42	23.4	-1.8	
3,256.0	1.93	314.64	3,248.1	-11.5	-189.6	1.02	-0.79	14.54	26.3	-25.8	
3,446.0	1.76	334.85	3,438.0	-6.6	-193.1	0.35	-0.09	10.64	18.1	-52.2	
3,637.0	1.67	36.73	3,628.9	-1.7	-192.7	0.92	-0.05	32.40	-55.5	-54.7	
3,827.0	5.01	64.50	3,818.6	4.1	-183.5	1.90	1.76	14.62	-105.2	-29.6	
3,922.0	5.54	63.97	3,913.2	7.9	-175.6	0.56	0.56	-0.56	-123.4	-35.0	
4,113.0	2.73	329.23	4,103.8	15.8	-169.7	3.34	-1.47	-49.60	51.5	-148.4	
4,303.0	5.89	271.48	4,293.4	20.0	-181.7	2.63	1.66	-30.39	162.2	-41.6	



EOG Resources

Midland PVA

Company:	EOG Resources - Midland	Local Co-ordinate Reference:	Well #745H
Project:	Lea County, NM (NAD 83 NME)	TVD Reference:	KB = 22' @ 3332.0usft
Site:	Dogwood 26 Fed Com	MD Reference:	KB = 22' @ 3332.0usft
Well:	#745H	North Reference:	Grid
Wellbore:	OH	Survey Calculation Method:	Minimum Curvature
Design:	OH	Database:	EDM

Survey										
MD (usft)	Inc (°)	Azi (azimuth) (°)	TVD (usft)	N/S (usft)	E/W (usft)	DLeg (°/100usft)	Build (°/100usft)	Turn (°/100usft)	High to Plan (usft)	Right to Plan (usft)
4,398.0	7.74	270.60	4,387.7	20.2	-193.0	1.95	1.95	-0.93	162.3	-39.9
4,494.0	7.91	269.90	4,482.8	20.2	-206.1	0.20	0.18	-0.73	160.6	-38.5
4,589.0	6.60	271.31	4,577.0	20.4	-218.1	1.39	-1.38	1.48	158.4	-43.0
4,684.0	4.75	261.55	4,671.6	19.9	-227.4	2.19	-1.95	-10.27	164.8	-15.6
4,779.0	3.34	235.80	4,766.3	17.8	-233.6	2.39	-1.48	-27.11	158.3	61.1
4,970.0	3.34	234.13	4,957.0	11.4	-242.7	0.05	0.00	-0.87	163.6	77.3
5,065.0	5.80	261.81	5,051.7	9.1	-249.7	3.41	2.59	29.14	184.3	-4.8
5,160.0	4.75	263.04	5,146.3	7.9	-258.4	1.11	-1.11	1.29	186.2	-7.9
5,351.0	10.64	269.55	5,335.5	6.8	-283.9	3.11	3.08	3.41	180.2	-28.9
5,446.0	11.34	268.58	5,428.8	6.5	-302.0	0.76	0.74	-1.02	173.3	-26.3
5,636.0	11.26	267.88	5,615.1	5.4	-339.2	0.08	-0.04	-0.37	157.8	-24.8
5,827.0	11.34	264.01	5,802.4	2.7	-376.5	0.40	0.04	-2.03	143.2	-14.2
6,017.0	11.61	262.17	5,988.6	-1.8	-414.0	0.24	0.14	-0.97	127.1	-8.3
6,208.0	10.38	258.65	6,176.1	-7.8	-449.9	0.73	-0.64	-1.84	112.3	1.5
6,398.0	9.58	257.77	6,363.2	-14.6	-482.2	0.43	-0.42	-0.46	100.5	6.4
6,589.0	8.79	256.80	6,551.7	-21.3	-511.9	0.42	-0.41	-0.51	91.2	11.7
6,780.0	8.97	254.52	6,740.4	-28.6	-540.5	0.21	0.09	-1.19	82.3	19.4
6,970.0	8.88	253.82	6,928.1	-36.6	-568.8	0.07	-0.05	-0.37	73.5	25.2
7,160.0	8.27	250.74	7,116.0	-45.2	-595.8	0.40	-0.32	-1.62	64.4	34.4
7,351.0	7.47	251.09	7,305.2	-53.8	-620.5	0.42	-0.42	0.18	59.3	40.0
7,541.0	5.01	270.34	7,494.1	-57.7	-640.5	1.68	-1.29	10.13	69.6	21.3
7,731.0	4.40	268.67	7,683.5	-57.8	-656.1	0.33	-0.32	-0.88	63.0	22.9
7,782.7	4.19	266.03	7,735.0	-58.0	-660.0	0.55	-0.40	-5.11	58.4	25.7
Brushy Top(Dogwood 26 Fed Com #745H)										
7,922.0	3.69	257.51	7,874.0	-59.3	-669.4	0.55	-0.36	-6.11	44.4	33.3
8,113.0	2.99	253.46	8,064.7	-62.1	-680.2	0.39	-0.37	-2.12	30.9	35.9
8,303.0	2.73	242.83	8,254.4	-65.6	-689.0	0.31	-0.14	-5.59	14.3	40.0



EOG Resources

Midland PVA

Company:	EOG Resources - Midland	Local Co-ordinate Reference:	Well #745H
Project:	Lea County, NM (NAD 83 NME)	TVD Reference:	KB = 22' @ 3332.0usft
Site:	Dogwood 26 Fed Com	MD Reference:	KB = 22' @ 3332.0usft
Well:	#745H	North Reference:	Grid
Wellbore:	OH	Survey Calculation Method:	Minimum Curvature
Design:	OH	Database:	EDM

Survey										
MD (usft)	Inc (°)	Azi (azimuth) (°)	TVD (usft)	N/S (usft)	E/W (usft)	DLeg (°/100usft)	Build (°/100usft)	Turn (°/100usft)	High to Plan (usft)	Right to Plan (usft)
8,494.0	2.55	233.07	8,445.2	-70.2	-696.4	0.25	-0.09	-5.11	-1.4	41.1
8,684.0	2.37	216.46	8,635.1	-75.9	-702.1	0.39	-0.09	-8.74	-21.0	37.8
8,874.0	2.02	210.40	8,824.9	-81.9	-706.2	0.22	-0.18	-3.19	-32.2	34.9
9,064.0	1.58	202.22	9,014.8	-87.2	-708.8	0.27	-0.23	-4.31	-42.8	29.5
9,255.0	1.23	202.75	9,205.8	-91.6	-710.6	0.18	-0.18	0.28	-47.2	29.9
9,445.0	0.18	219.01	9,395.7	-93.7	-711.6	0.56	-0.55	8.56	-39.2	42.5
9,635.0	0.88	145.27	9,585.7	-95.1	-711.0	0.45	0.37	-38.81	-53.3	-26.0
9,826.0	1.49	99.92	9,776.7	-96.8	-707.7	0.56	0.32	-23.74	-22.5	-57.2
10,016.0	1.93	176.91	9,966.6	-100.4	-705.1	1.13	0.23	40.52	-64.6	11.5
10,207.0	2.37	145.53	10,157.5	-106.8	-702.7	0.65	0.23	-16.43	-67.8	-25.5
10,397.0	3.08	132.35	10,347.3	-113.5	-696.7	0.50	0.37	-6.94	-69.1	-41.2
10,492.0	3.96	105.63	10,442.1	-116.1	-691.6	1.93	0.93	-28.13	-48.7	-69.1
10,682.0	2.90	100.80	10,631.8	-118.8	-680.6	0.58	-0.56	-2.54	-54.1	-73.5
10,777.0	0.53	91.31	10,726.7	-119.2	-677.8	2.50	-2.49	-9.99	-44.1	-81.8
10,967.0	2.64	119.26	10,916.6	-121.4	-673.1	1.15	1.11	14.71	-82.4	-51.2
11,158.0	1.58	158.54	11,107.5	-126.0	-668.3	0.91	-0.55	20.57	-102.2	15.4
11,348.0	2.02	241.16	11,297.5	-130.1	-670.3	1.26	0.23	43.48	-1.6	105.9
11,539.0	2.46	248.28	11,488.3	-133.2	-677.0	0.27	0.23	3.73	4.1	105.7
11,730.0	1.76	228.33	11,679.2	-136.7	-683.0	0.53	-0.37	-10.45	-39.0	99.4
11,788.0	1.32	230.96	11,737.2	-137.7	-684.2	0.77	-0.76	4.53	-35.9	101.1
11,940.0	1.14	261.20	11,889.1	-139.0	-687.1	0.44	-0.12	19.89	16.9	106.4
12,130.0	1.41	194.67	12,079.1	-141.6	-689.5	0.75	0.14	-35.02	-93.9	56.1
12,321.0	1.41	194.14	12,270.0	-146.1	-690.7	0.01	0.00	-0.28	-99.1	55.2
12,410.0	1.35	260.41	12,359.0	-147.4	-692.0	1.69	-0.07	74.46	9.2	114.0
KOP, MD:12410.0', TVD:12359.0', N/S:-147.4', E/W:-692.0', INC:1.35										
12,417.0	1.41	264.54	12,366.0	-147.4	-692.2	1.69	0.93	58.99	17.2	113.0
12,512.0	20.58	346.72	12,459.0	-131.1	-697.2	21.51	20.18	86.51	97.3	-0.5



EOG Resources

Midland PVA

Company:	EOG Resources - Midland	Local Co-ordinate Reference:	Well #745H
Project:	Lea County, NM (NAD 83 NME)	TVD Reference:	KB = 22' @ 3332.0usft
Site:	Dogwood 26 Fed Com	MD Reference:	KB = 22' @ 3332.0usft
Well:	#745H	North Reference:	Grid
Wellbore:	OH	Survey Calculation Method:	Minimum Curvature
Design:	OH	Database:	EDM

Survey										
MD (usft)	Inc (°)	Azi (azimuth) (°)	TVD (usft)	N/S (usft)	E/W (usft)	DLeg (°/100usft)	Build (°/100usft)	Turn (°/100usft)	High to Plan (usft)	Right to Plan (usft)
12,607.0	34.38	3.85	12,543.2	-87.8	-699.3	16.61	14.53	18.03	48.9	-27.4
12,702.0	33.50	2.70	12,622.0	-34.8	-696.2	1.15	-0.93	-1.21	9.0	-26.2
12,797.0	47.22	359.89	12,694.2	26.5	-695.0	14.57	14.44	-2.96	-23.9	-33.0
12,893.0	42.82	1.65	12,762.0	94.4	-694.2	4.76	-4.58	1.83	-52.8	-39.4
12,988.0	50.03	346.18	12,827.7	162.3	-702.0	13.99	7.59	-16.28	-51.3	-53.0
13,083.0	57.60	346.53	12,883.7	236.8	-720.0	7.97	7.97	0.37	-51.4	-46.6
13,178.0	61.64	347.23	12,931.8	316.6	-738.6	4.30	4.25	0.74	-39.5	-40.8
13,261.4	67.60	348.24	12,967.5	390.2	-754.6	7.23	7.15	1.21	-19.8	-36.4
HL Crossing, MD:13261.4', TVD:12967.5', N/S:390.2', E/W:-754.6', INC:67.60										
13,274.0	68.50	348.38	12,972.2	401.6	-757.0	7.23	7.15	1.14	-16.3	-35.8
13,366.1	87.17	353.92	12,991.5	490.2	-770.6	21.10	20.27	6.02	0.1	-35.6
FTP Crossing, MD:13366.1', TVD:12991.5', N/S:490.2', E/W:-770.6', INC:87.17										
13,369.0	87.76	354.09	12,991.7	493.1	-770.9	21.10	20.32	5.71	0.2	-35.7
13,370.0	87.74	354.12	12,991.7	494.1	-771.0	3.10	-1.86	2.49	0.3	-35.8
FTP(Dogwood 26 Fed Com #745H)										
13,464.0	86.00	356.46	12,996.8	587.6	-778.7	3.10	-1.85	2.49	4.9	-38.3
13,559.0	90.75	354.35	12,999.5	682.2	-786.3	5.47	5.00	-2.22	7.3	-36.3
13,654.0	91.89	355.93	12,997.3	776.8	-794.4	2.05	1.20	1.66	4.6	-29.6
13,749.0	92.24	357.69	12,993.9	871.6	-799.7	1.89	0.37	1.85	0.8	-25.1
13,845.0	91.89	358.57	12,990.5	967.5	-802.8	0.99	-0.36	0.92	-3.0	-22.7
13,940.0	89.25	353.47	12,989.5	1,062.2	-809.4	6.04	-2.78	-5.37	-4.4	-16.9
13,967.2	89.71	354.81	12,989.8	1,089.3	-812.2	5.18	1.67	4.91	-4.2	-14.3
TGT#1(Dogwood 26 Fed Com #745H)										
14,035.0	90.84	358.13	12,989.4	1,157.0	-816.3	5.18	1.67	4.91	-5.0	-10.7
14,130.0	89.60	359.98	12,989.1	1,251.9	-817.9	2.34	-1.31	1.95	-6.0	-9.8
14,225.0	92.24	359.98	12,987.6	1,346.9	-817.9	2.78	2.78	0.00	-8.2	-10.5
14,320.0	93.30	359.27	12,983.0	1,441.8	-818.6	1.34	1.12	-0.75	-13.4	-10.6



EOG Resources

Midland PVA

Company:	EOG Resources - Midland	Local Co-ordinate Reference:	Well #745H
Project:	Lea County, NM (NAD 83 NME)	TVD Reference:	KB = 22' @ 3332.0usft
Site:	Dogwood 26 Fed Com	MD Reference:	KB = 22' @ 3332.0usft
Well:	#745H	North Reference:	Grid
Wellbore:	OH	Survey Calculation Method:	Minimum Curvature
Design:	OH	Database:	EDM

Survey										
MD (usft)	Inc (°)	Azi (azimuth) (°)	TVD (usft)	N/S (usft)	E/W (usft)	DLeg (°/100usft)	Build (°/100usft)	Turn (°/100usft)	High to Plan (usft)	Right to Plan (usft)
14,415.0	91.01	359.01	12,979.4	1,536.7	-820.0	2.43	-2.41	-0.27	-17.7	-9.9
14,510.0	88.29	357.69	12,980.0	1,631.7	-822.7	3.18	-2.86	-1.39	-17.7	-7.9
14,605.0	86.88	357.87	12,984.0	1,726.5	-826.4	1.50	-1.48	0.19	-14.4	-5.0
14,700.0	88.11	358.04	12,988.1	1,821.4	-829.8	1.31	1.29	0.18	-10.9	-2.3
14,795.0	89.16	355.76	12,990.4	1,916.2	-834.9	2.64	1.11	-2.40	-9.3	2.1
14,847.4	89.69	357.20	12,990.9	1,968.5	-838.1	2.93	1.01	2.75	-9.1	4.9
TGT#2(Dogwood 26 Fed Com #745H)										
14,891.0	90.13	358.40	12,991.0	2,012.0	-839.8	2.93	1.01	2.75	-9.0	6.3
14,986.0	89.43	355.76	12,991.4	2,106.9	-844.6	2.87	-0.74	-2.78	-8.4	10.4
15,081.0	89.69	356.02	12,992.1	2,201.7	-851.5	0.39	0.27	0.27	-7.4	16.5
15,176.0	88.72	355.41	12,993.4	2,296.4	-858.6	1.21	-1.02	-0.64	-5.9	22.8
15,271.0	88.29	355.50	12,995.9	2,391.1	-866.1	0.46	-0.45	0.09	-3.1	29.6
15,365.0	91.45	3.76	12,996.1	2,485.0	-866.7	9.41	3.36	8.79	-2.7	29.5
15,460.0	91.54	2.53	12,993.6	2,579.8	-861.5	1.30	0.09	-1.29	-4.9	23.6
15,556.0	92.42	4.90	12,990.3	2,675.5	-855.3	2.63	0.92	2.47	-7.9	16.6
15,651.0	93.30	4.28	12,985.6	2,770.1	-847.7	1.13	0.93	-0.65	-12.4	8.3
15,746.0	93.56	4.37	12,979.9	2,864.7	-840.5	0.29	0.27	0.09	-17.8	0.4
15,841.0	91.01	2.79	12,976.1	2,959.4	-834.6	3.16	-2.68	-1.66	-21.3	-6.2
15,936.0	90.13	4.28	12,975.1	3,054.2	-828.7	1.82	-0.93	1.57	-22.0	-12.8
16,032.0	92.07	6.31	12,973.3	3,149.8	-819.9	2.92	2.02	2.11	-23.6	-22.3
16,127.0	89.60	4.90	12,971.9	3,244.3	-810.6	2.99	-2.60	-1.48	-24.7	-32.3
16,222.0	88.11	1.82	12,973.8	3,339.1	-805.0	3.60	-1.57	-3.24	-22.5	-38.6
16,317.0	87.58	359.63	12,977.4	3,434.0	-803.8	2.37	-0.56	-2.31	-18.7	-40.6
16,412.0	87.93	357.96	12,981.1	3,528.9	-805.8	1.79	0.37	-1.76	-14.6	-39.3
16,508.0	87.76	358.22	12,984.7	3,624.8	-809.0	0.32	-0.18	0.27	-10.8	-36.9
16,603.0	89.34	0.33	12,987.1	3,719.7	-810.2	2.77	1.66	2.22	-8.1	-36.4
16,698.0	88.20	357.08	12,989.2	3,814.7	-812.4	3.62	-1.20	-3.42	-5.8	-35.0



EOG Resources

Midland PVA

Company:	EOG Resources - Midland	Local Co-ordinate Reference:	Well #745H
Project:	Lea County, NM (NAD 83 NME)	TVD Reference:	KB = 22' @ 3332.0usft
Site:	Dogwood 26 Fed Com	MD Reference:	KB = 22' @ 3332.0usft
Well:	#745H	North Reference:	Grid
Wellbore:	OH	Survey Calculation Method:	Minimum Curvature
Design:	OH	Database:	EDM

Survey										
MD (usft)	Inc (°)	Azi (azimuth) (°)	TVD (usft)	N/S (usft)	E/W (usft)	DLeg (°/100usft)	Build (°/100usft)	Turn (°/100usft)	High to Plan (usft)	Right to Plan (usft)
16,794.0	89.25	359.19	12,991.3	3,910.6	-815.5	2.45	1.09	2.20	-3.4	-32.6
16,889.0	88.55	359.19	12,993.1	4,005.6	-816.8	0.74	-0.74	0.00	-1.3	-31.9
16,984.0	87.76	357.69	12,996.2	4,100.5	-819.4	1.78	-0.83	-1.58	2.0	-30.1
17,079.0	87.93	358.22	12,999.7	4,195.4	-822.8	0.59	0.18	0.56	5.8	-27.4
17,174.0	90.48	357.25	13,001.1	4,290.3	-826.6	2.87	2.68	-1.02	7.4	-24.4
17,270.0	90.84	356.99	13,000.0	4,386.1	-831.4	0.46	0.37	-0.27	6.6	-20.3
17,365.0	91.19	359.01	12,998.3	4,481.1	-834.7	2.16	0.37	2.13	5.1	-17.7
17,460.0	91.80	359.36	12,995.8	4,576.0	-836.1	0.74	0.64	0.37	2.9	-17.1
17,555.0	91.89	358.22	12,992.7	4,670.9	-838.1	1.20	0.09	-1.20	0.1	-15.8
17,650.0	89.08	357.96	12,991.9	4,765.9	-841.2	2.97	-2.96	-0.27	-0.4	-13.4
17,746.0	88.37	357.25	12,994.1	4,861.8	-845.2	1.05	-0.74	-0.74	2.0	-10.1
17,841.0	87.05	356.37	12,997.9	4,956.5	-850.5	1.67	-1.39	-0.93	6.1	-5.5
17,936.0	88.99	356.02	13,001.2	5,051.3	-856.8	2.08	2.04	-0.37	9.6	0.0
18,031.0	90.92	356.55	13,001.2	5,146.1	-863.0	2.11	2.03	0.56	9.9	5.5
18,127.0	91.80	357.08	12,998.9	5,241.9	-868.3	1.07	0.92	0.55	7.9	10.1
18,222.0	92.59	356.90	12,995.3	5,336.7	-873.3	0.85	0.83	-0.19	4.6	14.3
18,317.0	92.68	357.25	12,990.9	5,431.5	-878.1	0.38	0.09	0.37	0.5	18.5
18,412.0	91.89	358.04	12,987.2	5,526.3	-882.0	1.18	-0.83	0.83	-3.1	21.6
18,507.0	92.68	358.40	12,983.4	5,621.2	-885.0	0.91	0.83	0.38	-6.6	23.9
18,602.0	93.21	356.81	12,978.5	5,716.0	-888.9	1.76	0.56	-1.67	-11.2	27.1
18,697.0	90.40	359.63	12,975.5	5,810.9	-891.9	4.19	-2.96	2.97	-13.9	29.3
18,792.0	90.75	1.03	12,974.5	5,905.9	-891.3	1.52	0.37	1.47	-14.6	28.0
18,887.0	90.48	2.44	12,973.5	6,000.8	-888.5	1.51	-0.28	1.48	-15.4	24.4
18,982.0	87.67	2.17	12,975.1	6,095.7	-884.6	2.97	-2.96	-0.28	-13.6	19.9
19,077.0	86.97	0.94	12,979.5	6,190.6	-882.1	1.49	-0.74	-1.29	-8.9	16.6
19,172.0	87.14	1.47	12,984.4	6,285.4	-880.1	0.59	0.18	0.56	-3.7	13.9
19,267.0	85.74	0.24	12,990.3	6,380.2	-878.7	1.96	-1.47	-1.29	2.4	11.7



EOG Resources

Midland PVA

Company:	EOG Resources - Midland	Local Co-ordinate Reference:	Well #745H
Project:	Lea County, NM (NAD 83 NME)	TVD Reference:	KB = 22' @ 3332.0usft
Site:	Dogwood 26 Fed Com	MD Reference:	KB = 22' @ 3332.0usft
Well:	#745H	North Reference:	Grid
Wellbore:	OH	Survey Calculation Method:	Minimum Curvature
Design:	OH	Database:	EDM

Survey										
MD (usft)	Inc (°)	Azi (azimuth) (°)	TVD (usft)	N/S (usft)	E/W (usft)	DLeg (°/100usft)	Build (°/100usft)	Turn (°/100usft)	High to Plan (usft)	Right to Plan (usft)
19,363.0	88.64	0.59	12,995.0	6,476.1	-878.0	3.04	3.02	0.36	7.4	10.3
19,458.0	88.55	0.15	12,997.3	6,571.1	-877.4	0.47	-0.09	-0.46	10.0	9.0
19,553.0	89.87	0.24	12,998.6	6,666.0	-877.0	1.39	1.39	0.09	11.6	7.9
19,648.0	91.63	358.66	12,997.4	6,761.0	-877.9	2.49	1.85	-1.66	10.6	8.1
19,743.0	92.68	359.10	12,993.8	6,855.9	-879.8	1.20	1.11	0.46	7.3	9.2
19,838.0	93.30	359.01	12,988.8	6,950.8	-881.4	0.66	0.65	-0.09	2.6	10.1
19,933.0	93.12	357.52	12,983.5	7,045.6	-884.2	1.58	-0.19	-1.57	-2.4	12.2
20,029.0	90.75	359.36	12,980.3	7,141.5	-886.8	3.12	-2.47	1.92	-5.4	14.1
20,124.0	91.19	0.68	12,978.7	7,236.5	-886.8	1.46	0.46	1.39	-6.8	13.3
20,219.0	90.13	2.44	12,977.6	7,331.4	-884.2	2.16	-1.12	1.85	-7.6	10.0
20,314.0	88.81	1.91	12,978.5	7,426.4	-880.6	1.50	-1.39	-0.56	-6.5	5.7
20,410.0	88.64	1.74	12,980.6	7,522.3	-877.6	0.25	-0.18	-0.18	-4.1	1.9
20,505.0	90.57	3.76	12,981.3	7,617.2	-873.0	2.94	2.03	2.13	-3.2	-3.4
20,600.0	90.04	2.88	12,980.7	7,712.0	-867.5	1.08	-0.56	-0.93	-3.4	-9.6
20,651.4	90.52	2.78	12,980.5	7,763.4	-865.0	0.95	0.93	-0.19	-3.5	-12.5
TGT#3(Dogwood 26 Fed Com #745H)										
20,695.0	90.92	2.70	12,980.0	7,806.9	-862.9	0.95	0.93	-0.19	-3.7	-15.0
20,790.0	91.98	2.70	12,977.5	7,901.8	-858.4	1.12	1.12	0.00	-5.1	-20.2
20,885.0	92.24	2.97	12,974.0	7,996.6	-853.7	0.39	0.27	0.28	-7.6	-25.6
20,980.0	90.57	2.97	12,971.7	8,091.4	-848.8	1.76	-1.76	0.00	-9.0	-31.2
21,075.0	86.97	359.71	12,973.8	8,186.3	-846.6	5.11	-3.79	-3.43	-6.0	-34.2
21,170.0	88.37	0.59	12,977.6	8,281.3	-846.3	1.74	1.47	0.93	-1.1	-35.1
21,265.0	88.11	0.68	12,980.5	8,376.2	-845.3	0.29	-0.27	0.09	2.7	-36.9
21,360.0	88.20	357.25	12,983.6	8,471.1	-847.0	3.61	0.09	-3.61	6.9	-35.9
21,455.0	86.44	356.90	12,988.0	8,565.9	-851.8	1.89	-1.85	-0.37	12.3	-31.8
21,550.0	87.58	356.02	12,993.0	8,660.6	-857.7	1.52	1.20	-0.93	18.2	-26.6



EOG Resources

Midland PVA

Company:	EOG Resources - Midland	Local Co-ordinate Reference:	Well #745H
Project:	Lea County, NM (NAD 83 NME)	TVD Reference:	KB = 22' @ 3332.0usft
Site:	Dogwood 26 Fed Com	MD Reference:	KB = 22' @ 3332.0usft
Well:	#745H	North Reference:	Grid
Wellbore:	OH	Survey Calculation Method:	Minimum Curvature
Design:	OH	Database:	EDM

Survey											
MD (usft)	Inc (°)	Azi (azimuth) (°)	TVD (usft)	N/S (usft)	E/W (usft)	DLeg (°/100usft)	Build (°/100usft)	Turn (°/100usft)	High to Plan (usft)	Right to Plan (usft)	
21,631.0	88.03	356.17	12,996.1	8,741.3	-863.2	0.59	0.56	0.19	22.1	-21.8	
TGT#4(Dogwood 26 Fed Com #745H)											
21,645.0	88.11	356.20	12,996.6	8,755.3	-864.1	0.59	0.56	0.19	22.7	-20.9	
21,741.0	92.42	356.64	12,996.1	8,851.1	-870.1	4.51	4.49	0.46	22.4	-15.7	
21,836.0	92.77	356.29	12,991.8	8,945.8	-876.0	0.52	0.37	-0.37	18.2	-10.6	
21,931.0	92.24	355.76	12,987.7	9,040.5	-882.5	0.79	-0.56	-0.56	14.2	-4.7	
22,026.0	92.07	356.11	12,984.1	9,135.2	-889.3	0.41	-0.18	0.37	10.8	1.3	
22,121.0	92.51	356.11	12,980.3	9,229.9	-895.7	0.46	0.46	0.00	7.1	7.0	
22,216.0	91.28	358.66	12,977.2	9,324.7	-900.0	2.98	-1.29	2.68	4.1	10.6	
22,311.0	90.66	359.54	12,975.6	9,419.7	-901.5	1.13	-0.65	0.93	2.6	11.4	
22,407.0	89.25	0.51	12,975.6	9,515.7	-901.5	1.78	-1.47	1.01	2.8	10.6	
22,502.0	88.99	0.15	12,977.1	9,610.7	-900.9	0.47	-0.27	-0.38	4.4	9.3	
22,597.0	88.20	359.89	12,979.4	9,705.7	-900.9	0.88	-0.83	-0.27	6.9	8.6	
22,692.0	87.67	359.36	12,982.8	9,800.6	-901.5	0.79	-0.56	-0.56	10.4	8.5	
22,787.0	87.32	359.01	12,987.0	9,895.5	-902.9	0.52	-0.37	-0.37	14.7	9.1	
22,883.0	85.30	359.01	12,993.2	9,991.3	-904.5	2.10	-2.10	0.00	21.0	10.1	
22,978.0	85.56	358.31	13,000.7	10,085.9	-906.8	0.78	0.27	-0.74	28.7	11.5	
23,081.0	87.67	0.94	13,006.8	10,188.7	-907.4	3.27	2.05	2.55	34.9	11.4	
23,176.0	90.57	1.38	13,008.3	10,283.7	-905.5	3.09	3.05	0.46	36.5	8.7	
23,271.0	88.90	0.51	13,008.7	10,378.7	-903.9	1.98	-1.76	-0.92	37.1	6.5	
23,366.0	91.71	2.35	13,008.2	10,473.6	-901.6	3.54	2.96	1.94	36.7	3.4	
23,465.0	92.77	2.09	13,004.3	10,572.5	-897.7	1.10	1.07	-0.26	33.0	-1.2	
23,665.0	92.77	1.65	12,994.7	10,772.1	-891.2	0.22	0.00	-0.22	23.6	-9.3	
Last MWD Survey (MD=23665.0')											
23,729.0	92.77	1.65	12,991.6	10,836.0	-889.4	0.00	0.00	0.00	20.6	-11.6	
Projection to Bit (MD=23729.0') - PBHL(Dogwood 26 Fed Com #745H)											



EOG Resources

Midland PVA

Company:	EOG Resources - Midland	Local Co-ordinate Reference:	Well #745H
Project:	Lea County, NM (NAD 83 NME)	TVD Reference:	KB = 22' @ 3332.0usft
Site:	Dogwood 26 Fed Com	MD Reference:	KB = 22' @ 3332.0usft
Well:	#745H	North Reference:	Grid
Wellbore:	OH	Survey Calculation Method:	Minimum Curvature
Design:	OH	Database:	EDM


Design Annotations

Measured Depth (usft)	Vertical Depth (usft)	Local Coordinates		Comment
		+N/-S (usft)	+E/-W (usft)	
12,410.0	12,359.0	-147.4	-692.0	KOP, MD:12410.0', TVD:12359.0', N/S:-147.4', E/W:-692.0', INC:1.35
13,261.4	12,967.5	390.2	-754.6	HL Crossing, MD:13261.4', TVD:12967.5', N/S:390.2', E/W:-754.6', INC:67.60
13,366.1	12,991.5	490.2	-770.6	FTP Crossing, MD:13366.1', TVD:12991.5', N/S:490.2', E/W:-770.6', INC:87.17
23,665.0	12,994.7	10,772.1	-891.2	Last MWD Survey (MD=23665.0')
23,729.0	12,991.6	10,836.0	-889.4	Projection to Bit (MD=23729.0')

Checked By: _____ Approved By: _____ Date: _____

I certify this survey to be true and correct to the best of my belief and knowledge.

Kay Maddox 04/06/2021

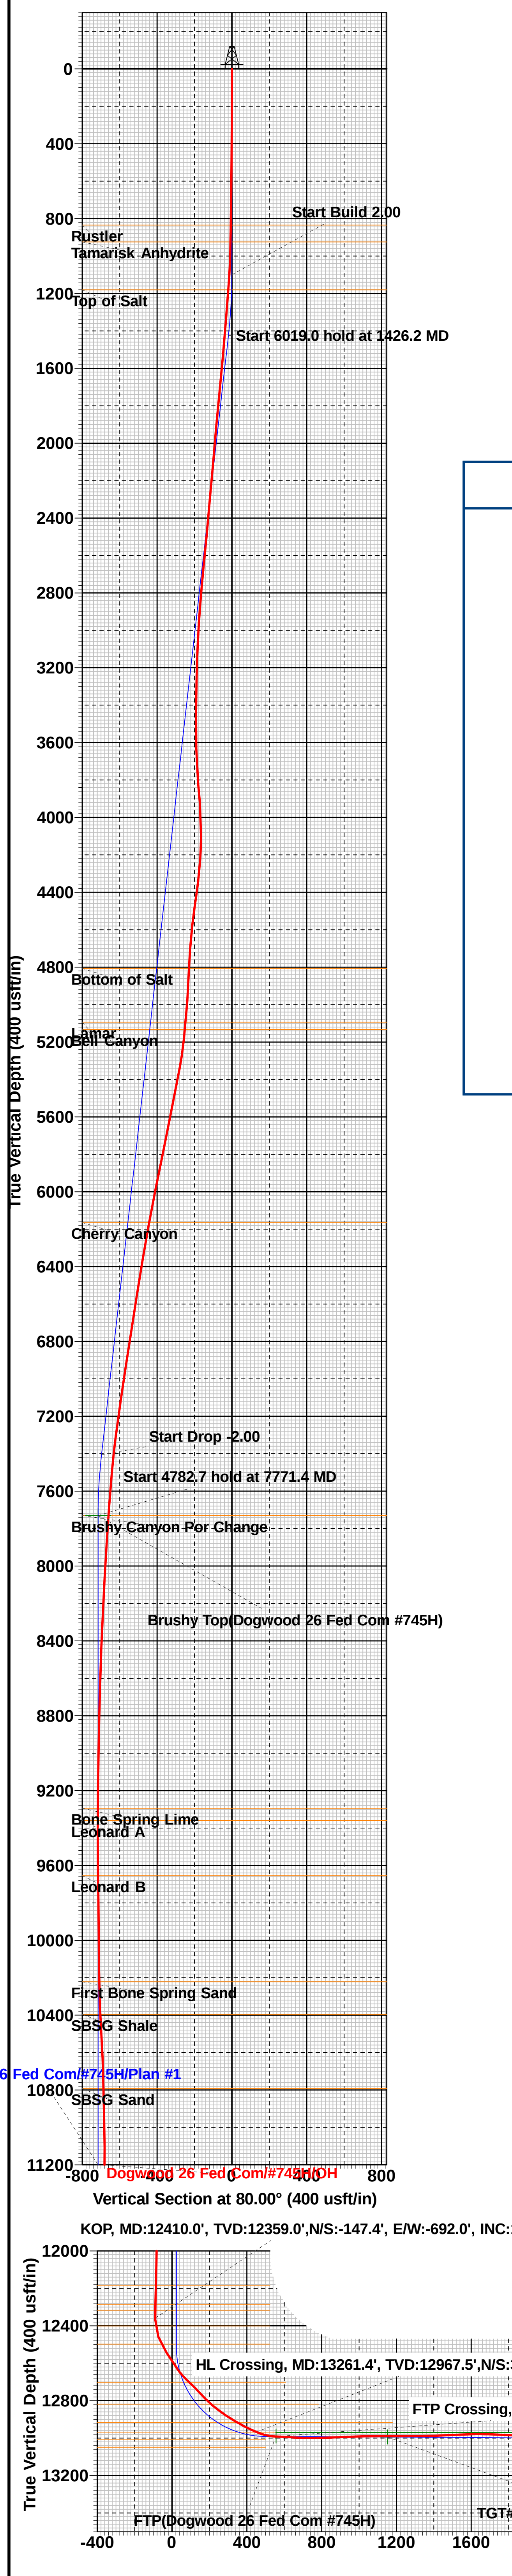

Plan #1






WELL DETAILS: #745H

KB = 22' @ 3332.0usft			3310.0
Northing	Easting	Latitude	Longitude
372131.00	786251.00	32° 1' 14.182 N	103° 32' 35.137 W

SECTION DETAILS									
MD	Inc	Azi	TVD	+N/-S	+E/-W	Dleg	TFace	VSect	Target
0.0	0.00	0.00	0.0	0.0	0.0	0.00	0.00	0.0	
1100.0	0.00	0.00	1100.0	0.0	0.0	0.00	0.00	0.0	
1426.2	6.52	267.10	1425.5	-0.9	-18.5	2.00	267.10	0.6	
7445.2	6.52	267.10	7405.5	-35.6	-701.5	0.00	0.00	22.7	
7771.4	0.00	0.00	7731.0	-36.5	-720.0	2.00	180.00	23.3	
12554.1	0.00	0.00	12513.7	-36.5	-720.0	0.00	0.00	23.3	
13302.0	89.75	350.57	12991.2	432.5	-797.9	12.00	350.57	497.1	
13601.1	89.75	359.54	12992.5	730.2	-823.6	3.00	90.00	795.9	
13959.3	89.75	359.54	12994.0	1088.3	-826.5	0.00	0.00	1153.0	TGT#1(Dogwood 26 Fed Com #745H)
13966.6	89.61	359.56	12994.0	1095.6	-826.5	2.00	172.69	1160.3	
14839.7	89.61	359.56	13000.0	1968.7	-833.2	0.00	0.00	2031.0	TGT#2(Dogwood 26 Fed Com #745H)
14867.2	90.16	359.56	13000.1	1996.2	-833.4	2.00	-0.01	2058.4	
20635.2	90.16	359.56	12984.0	7764.0	-877.5	0.00	0.00	7810.0	TGT#3(Dogwood 26 Fed Com #745H)
20656.8	90.59	359.56	12983.9	7785.6	-877.7	2.00	0.00	7831.5	
21612.0	90.59	359.56	12974.0	8740.7	-885.0	0.00	0.00	8784.0	TGT#4(Dogwood 26 Fed Com #745H)
21637.6	90.08	359.56	12973.9	8766.3	-885.2	2.00	-180.00	8809.5	
23710.4	90.08	359.56	12971.0	10839.0	-901.0	0.00	0.00	10876.4	PBHL(Dogwood 26 Fed Com #745H)

No casing data is available

Name	TVD	+N/-S	+E/-W	Northing	Easting
Brushy Top(Dogwood 26 Fed Com #745H)	7731.0	-36.5	-72.00	372094.50	785531.00
PBHL(Dogwood 26 Fed Com #745H)	12971.0	10839.0	-901.0	382970.00	785350.00
TG1#4(Dogwood 26 Fed Com #745H)	12974.0	8740.7	-885.0	380871.70	785366.03
TG1#3(Dogwood 26 Fed Com #745H)	12984.0	7764.0	-877.5	379895.00	785373.50
FTP(Dogwood 26 Fed Com #745H)	12989.0	490.0	-822.0	372621.00	785429.00
TG1#1(Dogwood 26 Fed Com #745H)	12994.0	1088.3	-826.5	373219.30	785424.51
TG1#2(Dogwood 26 Fed Com #745H)	13000.0	1968.7	-833.2	374099.70	785417.78

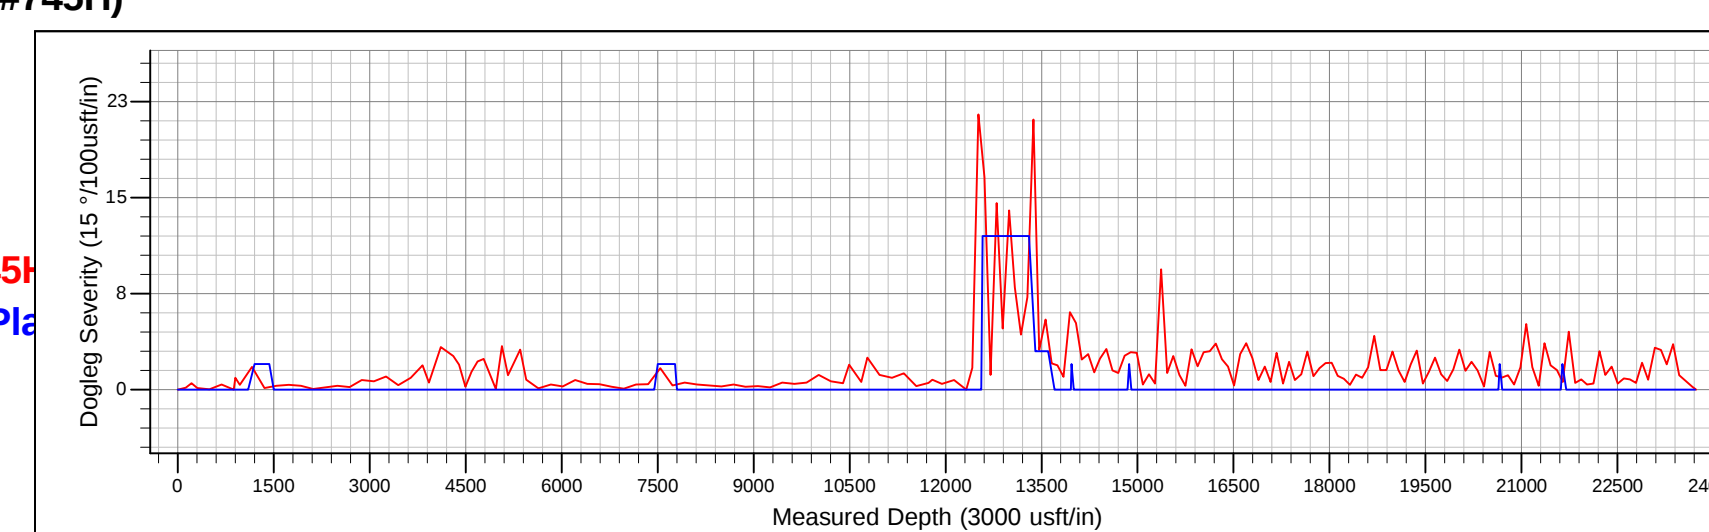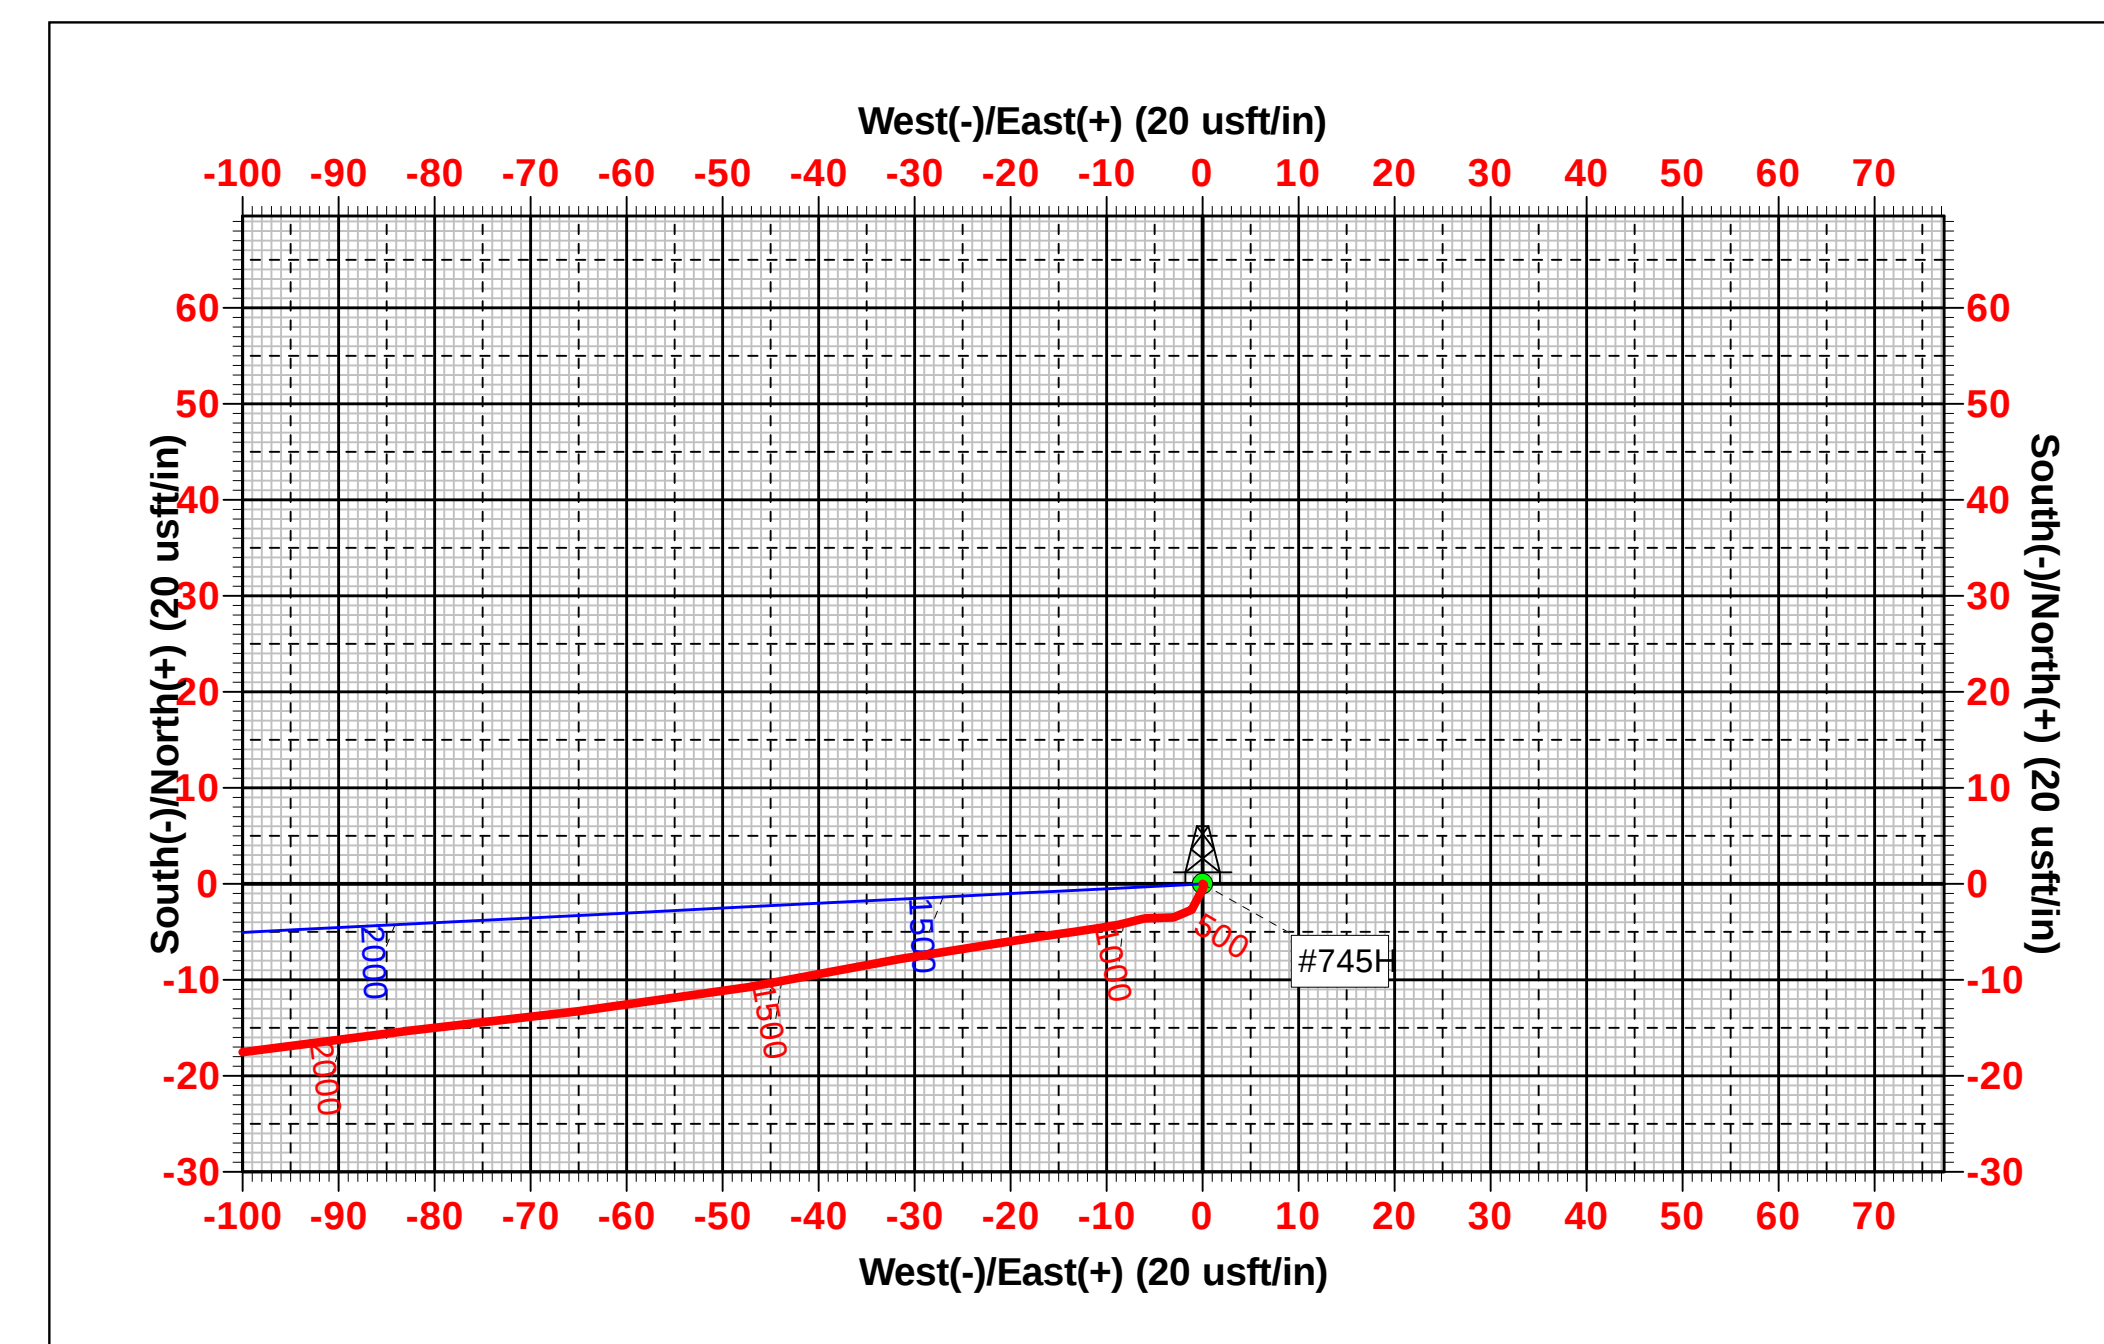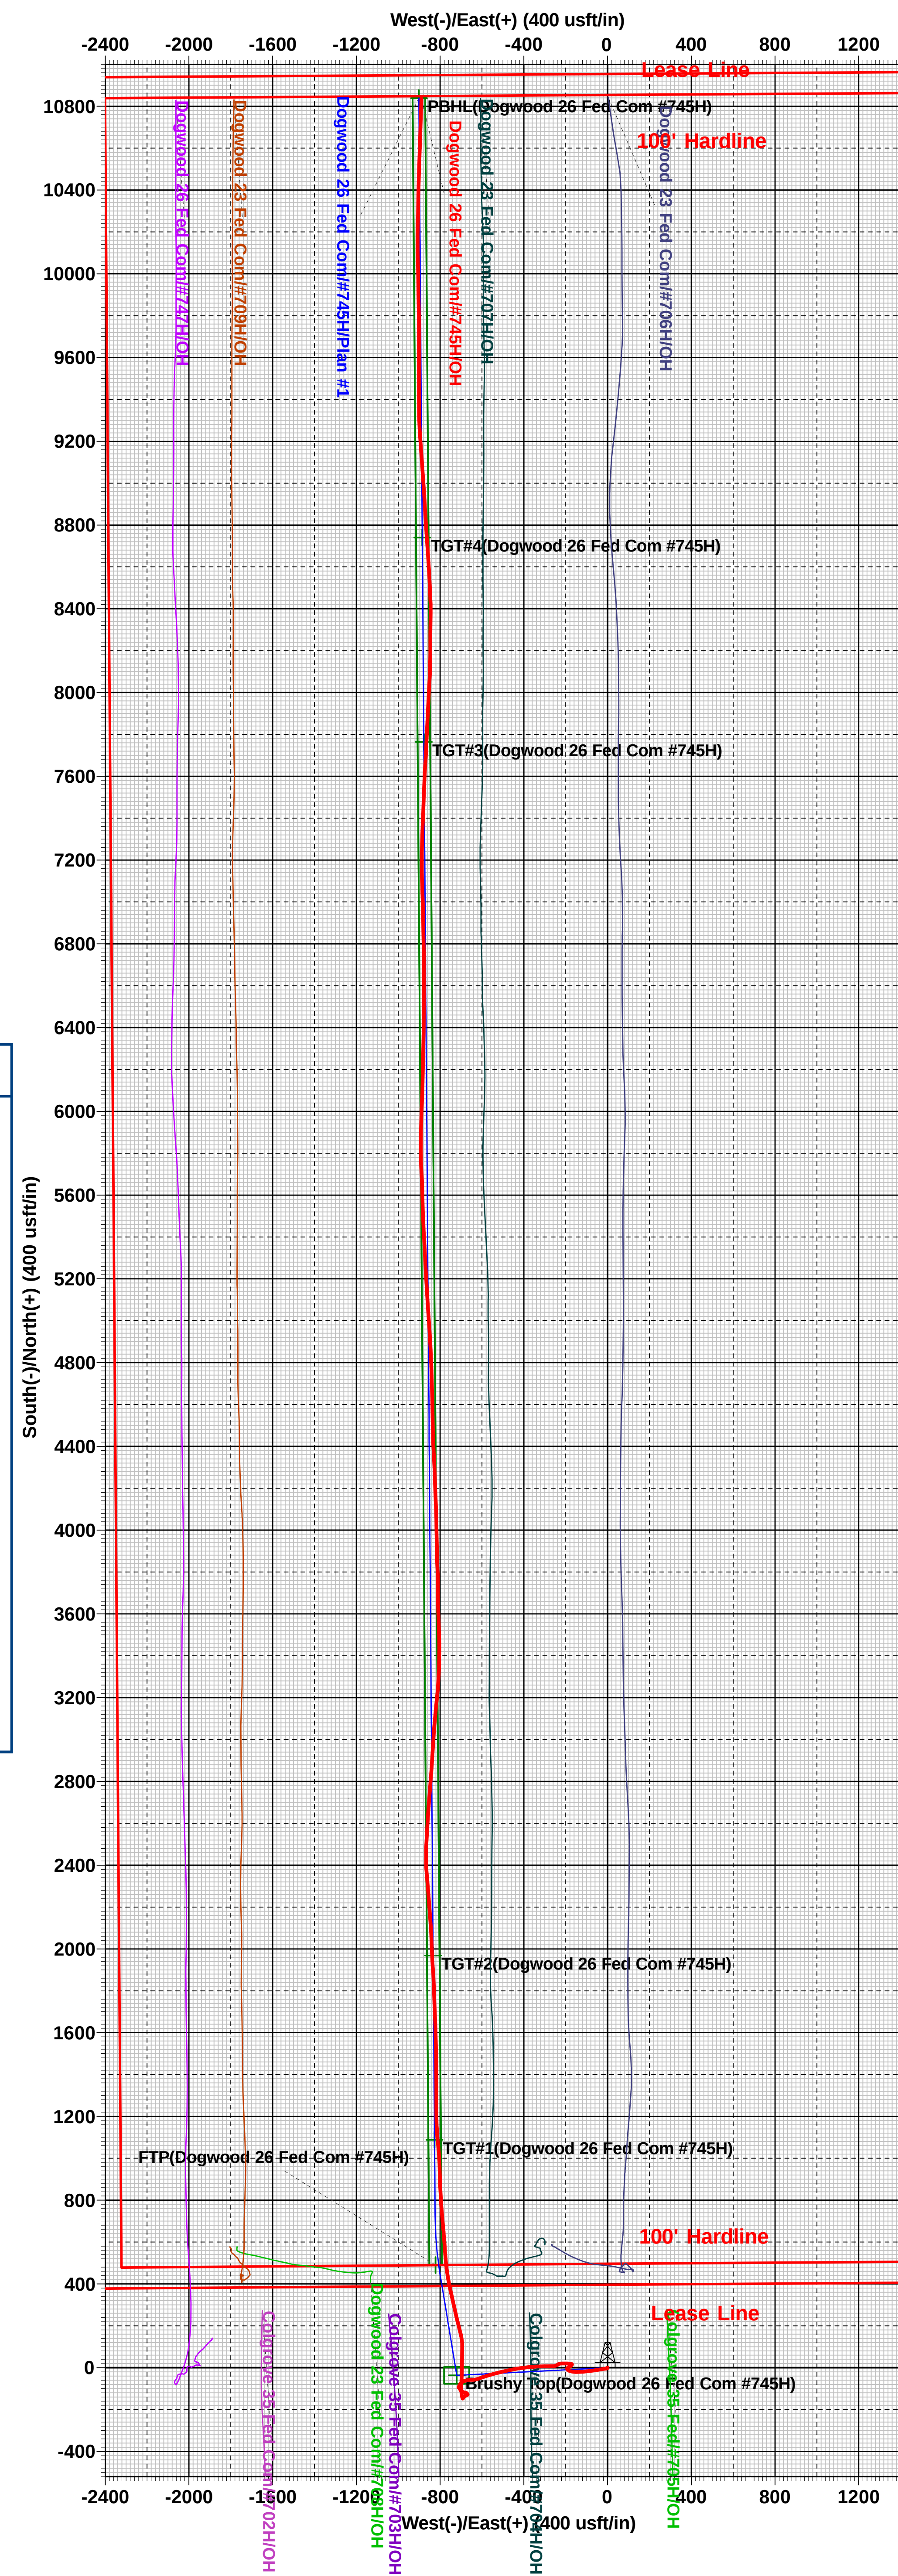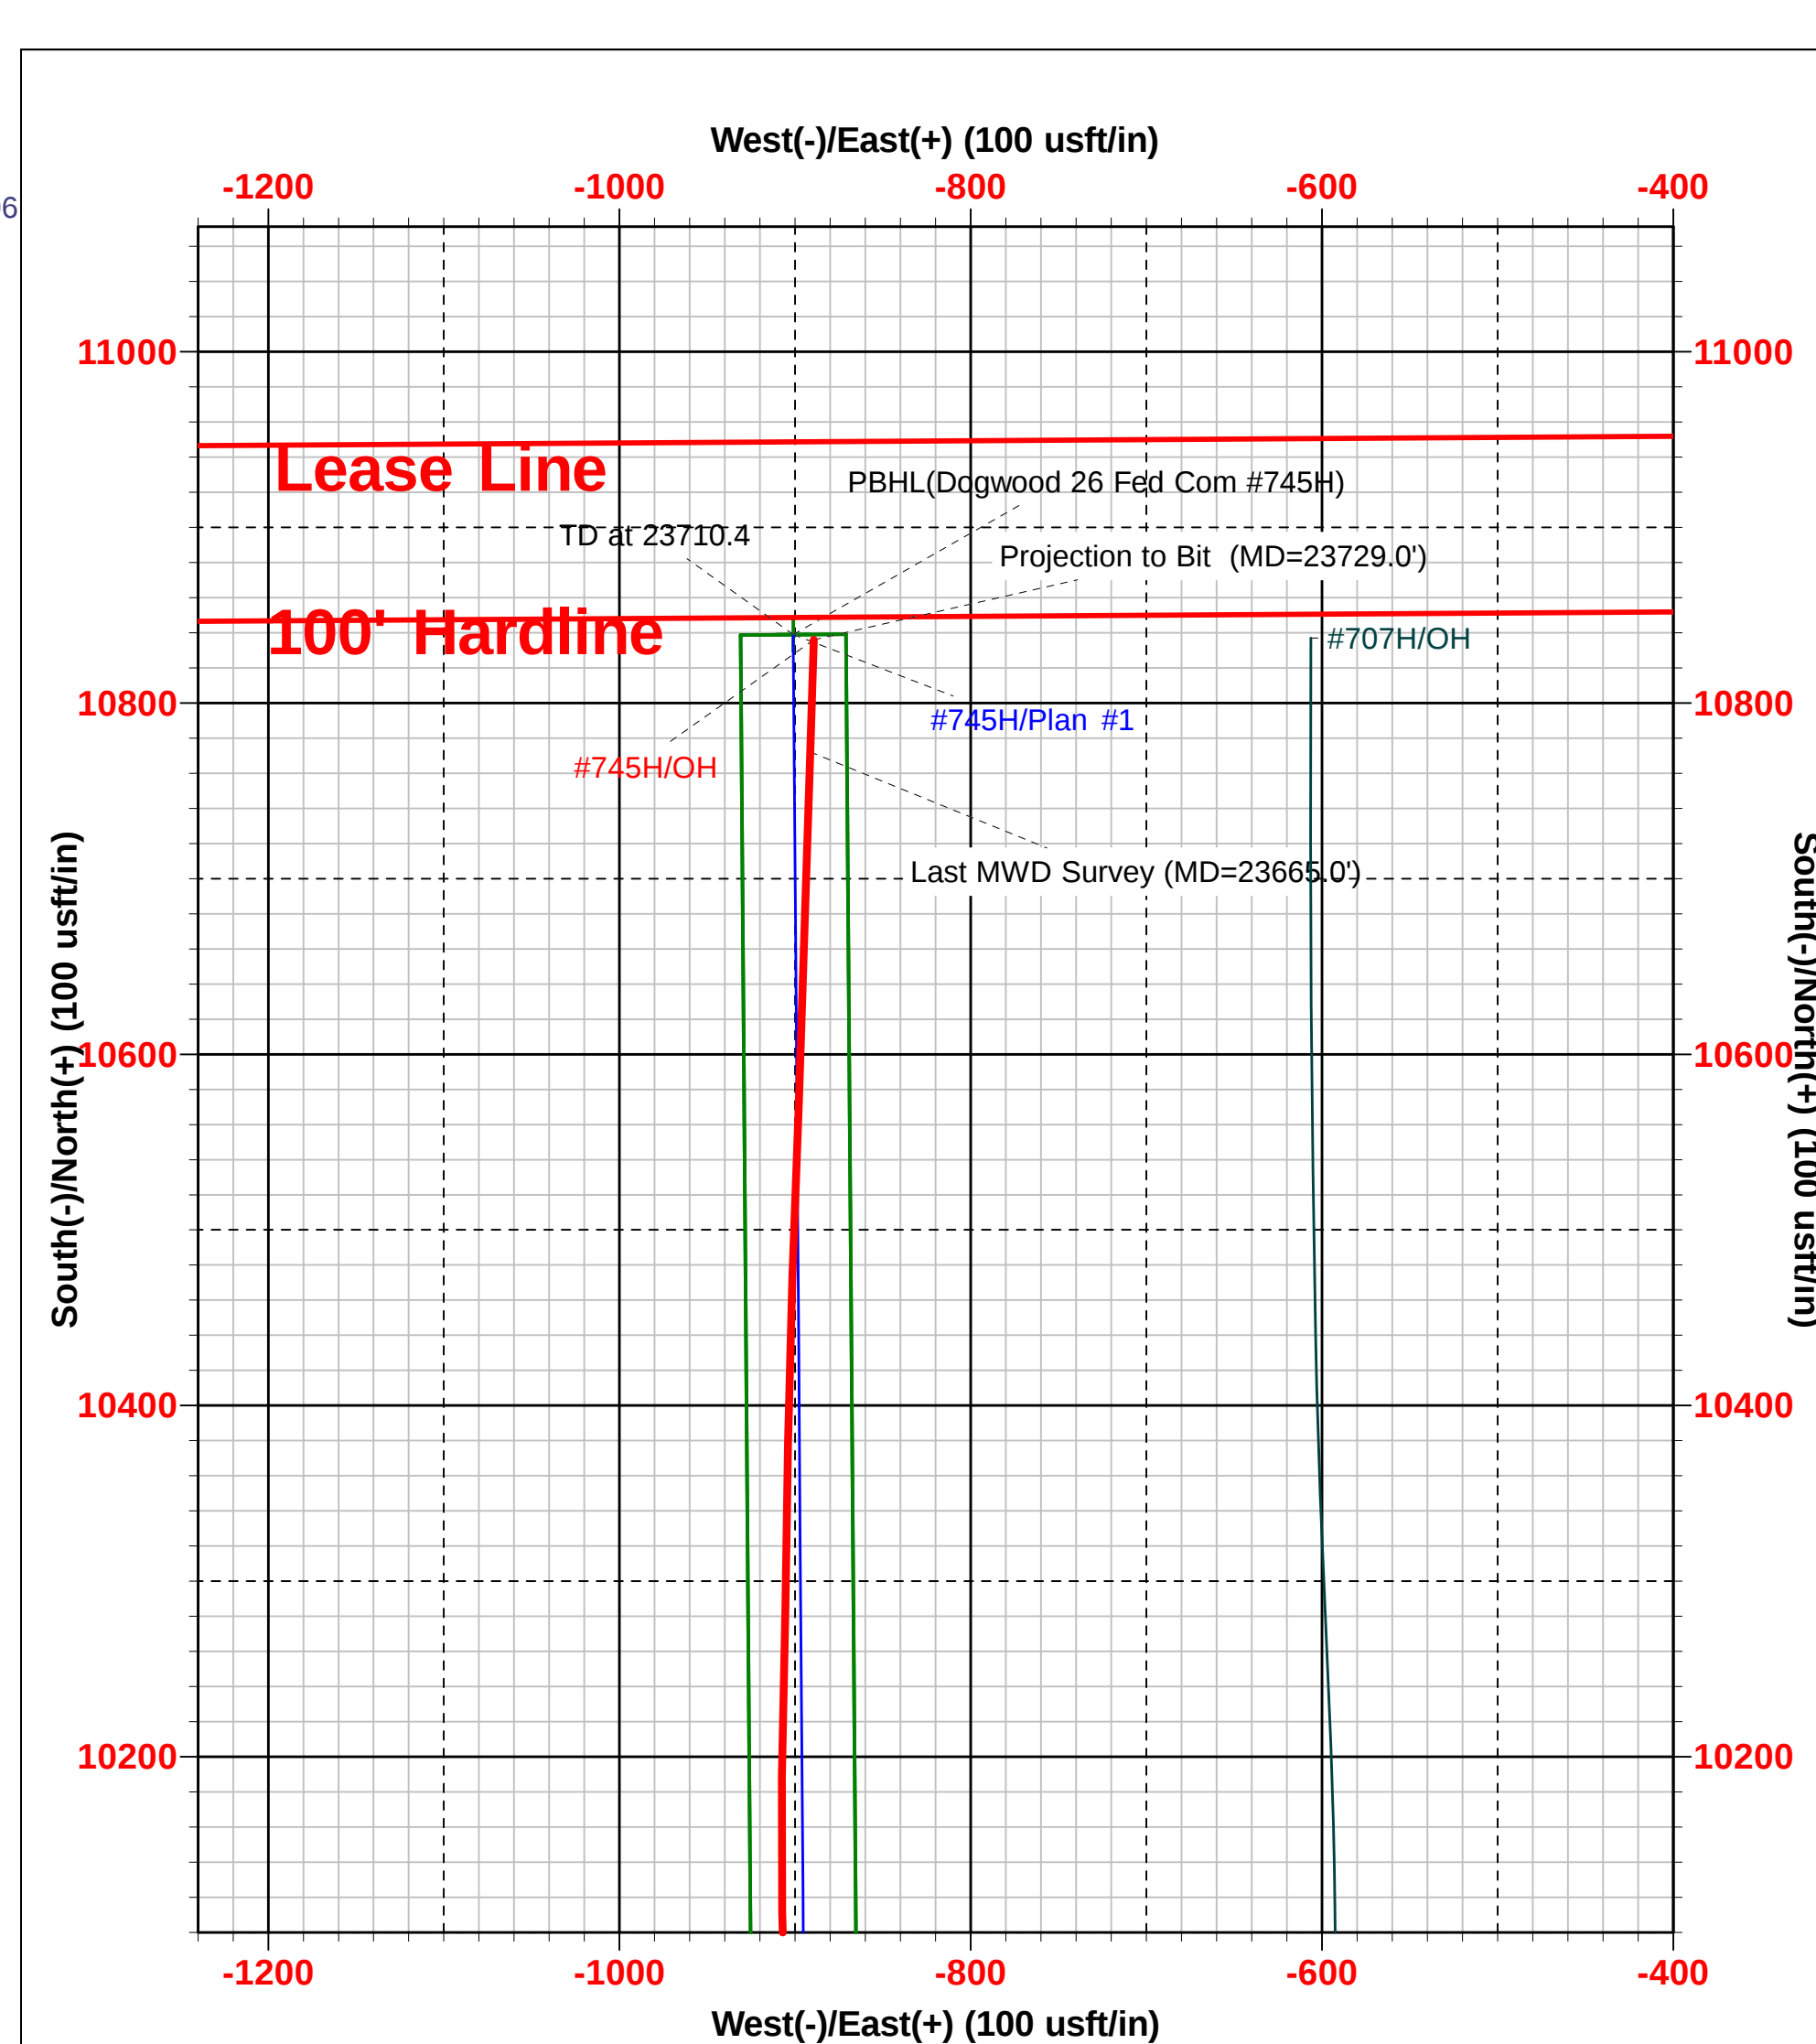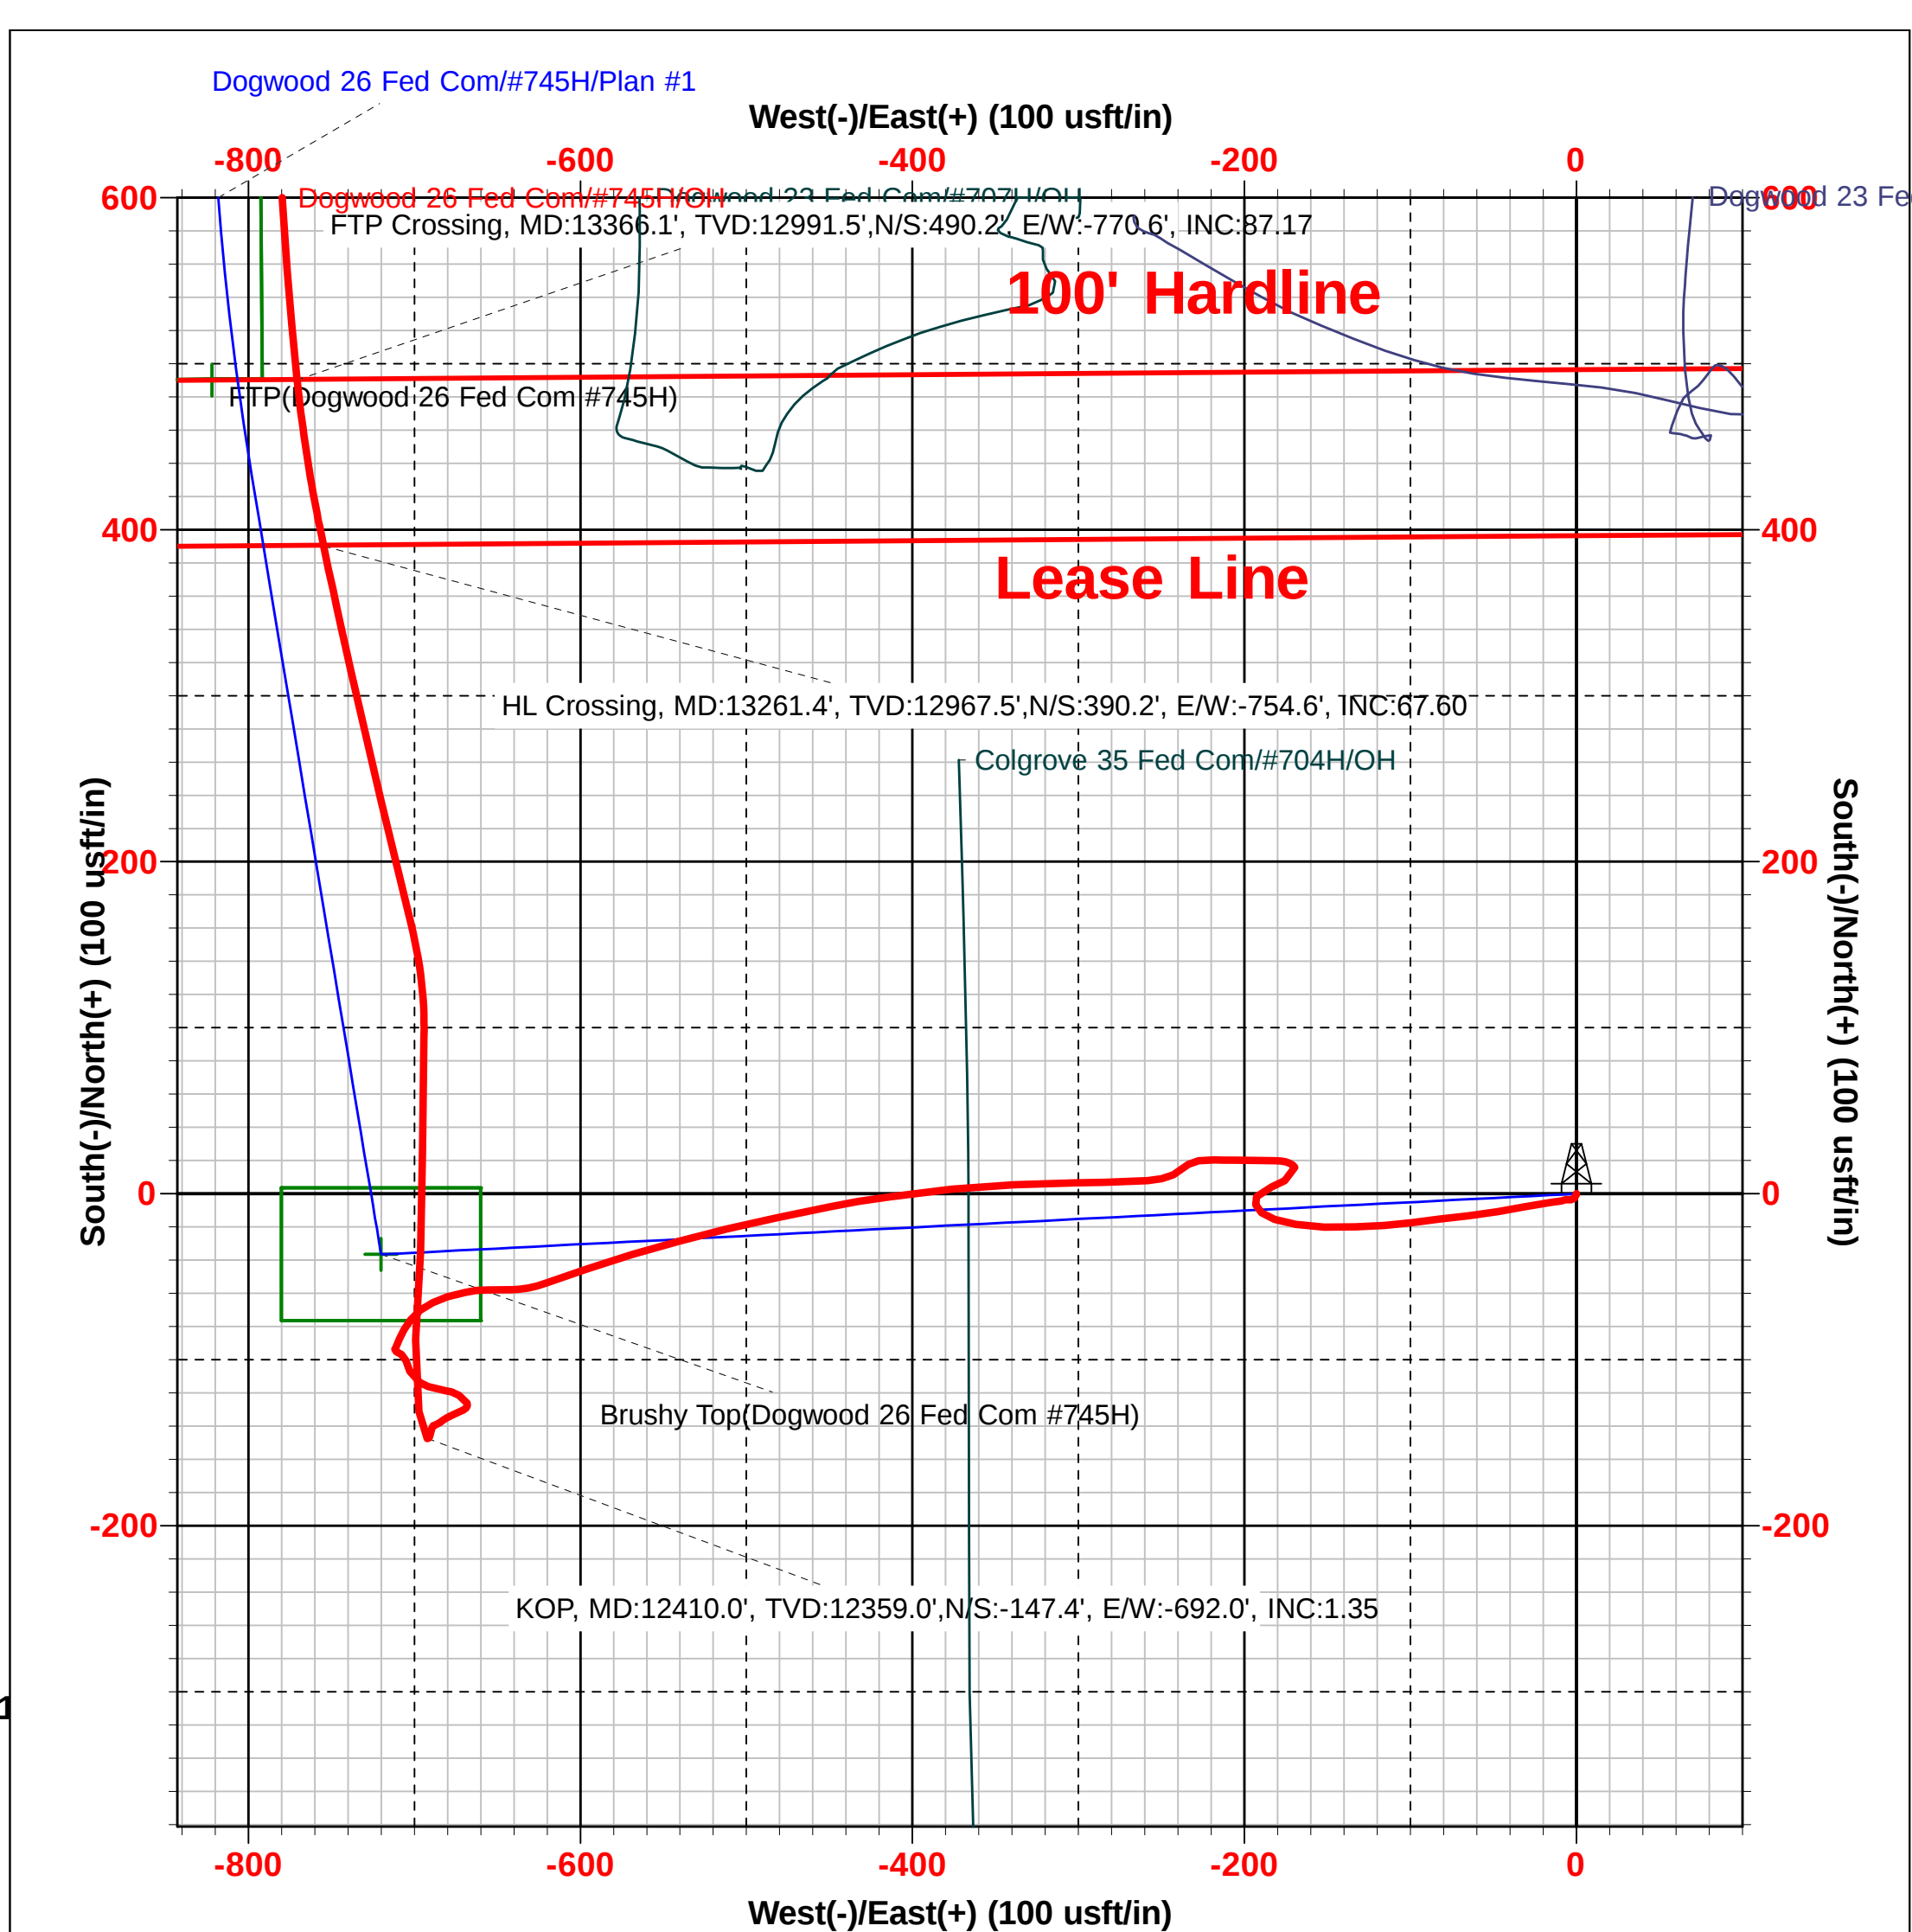

Intent ☐ As Drilled ☐

API #		
Operator Name:	Property Name:	Well Number

Kick Off Point (KOP)

UL	Section	Township	Range	Lot	Feet	From N/S	Feet	From E/W	County
Latitude					Longitude				NAD

First Take Point (FTP)

UL	Section	Township	Range	Lot	Feet	From N/S	Feet	From E/W	County
Latitude					Longitude				NAD

Last Take Point (LTP)

UL	Section	Township	Range	Lot	Feet	From N/S	Feet	From E/W	County
Latitude					Longitude				NAD

Is this well the defining well for the Horizontal Spacing Unit? ☐Is this well an infill well? ☐

If infill is yes please provide API if available, Operator Name and well number for Defining well for Horizontal Spacing Unit.

API #		
Operator Name:	Property Name:	Well Number

KZ 06/29/2018

Submit To Appropriate District Office Two Copies <u>District I</u> 1625 N. French Dr., Hobbs, NM 88240 <u>District II</u> 811 S. First St., Artesia, NM 88210 <u>District III</u> 1000 Rio Brazos Rd., Aztec, NM 87410 <u>District IV</u> 1220 S. St. Francis Dr., Santa Fe, NM 87505		State of New Mexico Energy, Minerals and Natural Resources Oil Conservation Division 1220 South St. Francis Dr. Santa Fe, NM 87505			Form C-105 Revised August 1, 2011					
WELL COMPLETION OR RECOMPLETION REPORT AND LOG										
4. Reason for filing: ☒ COMPLETION REPORT (Fill in boxes #1 through #31 for State and Fee wells only) ☐ C-144 CLOSURE ATTACHMENT (Fill in boxes #1 through #9, #15 Date Rig Released and #32 and/or #33; attach this and the plat to the C-144 closure report in accordance with 19.15.17.13.K NMAC)								5. Lease Name or Unit Agreement Name DOGWOOD 26 FEDERAL COM		
								6. Well Number: 745H		
7. Type of Completion: ☒ NEW WELL ☐ WORKOVER ☐ DEEPENING ☐ PLUGBACK ☐ DIFFERENT RESERVOIR ☐ OTHER _____										
8. Name of Operator EOG RESOURCES INC							9. OGRID 7377			
10. Address of Operator PO BOX 2267 MIDLAND, TEXAS 79702							11. Pool name or Wildcat SANDERS TANK; UPPER WOLFCAMP			
12. Location	Unit Ltr	Section	Township	Range	Lot	Feet from the	N/S Line	Feet from the	E/W Line	County
Surface:	B	26	26S	33E		396	NORTH	2634	EAST	LEA
BH:	C	14	26S	33E		110	NORTH	1841	WEST	LEA
13. Date Spudded 09/01/2020	14. Date T.D. Reached 11/02/2020		15. Date Rig Released 11/03/2020			16. Date Completed (Ready to Produce) 03/18/2021		17. Elevations (DF and RKB, RT, GR, etc.) 3310' GR		
18. Total Measured Depth of Well MD 23,729' TVD 12,991'			19. Plug Back Measured Depth MD 23,697' TVD 12,991'			20. Was Directional Survey Made? YES		21. Type Electric and Other Logs Run None		
22. Producing Interval(s), of this completion - Top, Bottom, Name WOLFCAMP 13,384- 23,697										
23. CASING RECORD (Report all strings set in well)										
CASING SIZE		WEIGHT LB./FT.		DEPTH SET		HOLE SIZE		CEMENTING RECORD		AMOUNT PULLED
9 5/8"		40# J-55		954'		12 1/4"		445 CL C/CIRC		
7 5/8"		29.7# ECP 110		12,834'		8 3/4"		1545 CL C & H/ TOC		28' ECHO
5 1/2"		20# HCP 110		23,705'		6 3/4"		1170 CL H TOC 5244'		CBL
24. LINER RECORD						25. TUBING RECORD				
SIZE	TOP	BOTTOM	SACKS CEMENT	SCREEN		SIZE	DEPTH SET		PACKER SET	
26. Perforation record (interval, size, and number) 13,384-23,697 3 1/8", 2220 holes						27. ACID, SHOT, FRACTURE, CEMENT, SQUEEZE, ETC.				
						DEPTH INTERVAL		AMOUNT AND KIND MATERIAL USED		
						13,384 - 23,697'		FRAC W/26,256,790 lbs proppant, 484,865 bbls load fld		
28. PRODUCTION										
Date First Production 03/18/2021		Production Method (<i>Flowing, gas lift, pumping - Size and type pump</i>) Flowing				Well Status (<i>Prod. or Shut-in</i>) Producing				
Date of Test 03/25/2021	Hours Tested 24	Choke Size 72	Prod'n For Test Period	Oil - Bbl 2055	Gas - MCF 5149	Water - Bbl. 12,056	Gas - Oil Ratio 2505			
Flow Tubing Press.	Casing Pressure 1216	Calculated 24-Hour Rate	Oil - Bbl.	Gas - MCF	Water - Bbl.	Oil Gravity - API - (<i>Corr.</i>) 47				
29. Disposition of Gas (<i>Sold, used for fuel, vented, etc.</i>) SOLD								30. Test Witnessed By		
31. List Attachments C-102, C-104, C-103, Directional Survey, H spacing, Gas capture										
32. If a temporary pit was used at the well, attach a plat with the location of the temporary pit.										
33. If an on-site burial was used at the well, report the exact location of the on-site burial:										
Latitude _____ Longitude _____ NAD 1927 1983										
I hereby certify that the information shown on both sides of this form is true and complete to the best of my knowledge and belief Printed Signature Kay Maddox Name Kay Maddox Title Senior Regulatory Specialist Date 004/13/2021 E-mail Address kay_maddox@eogresources.com										

This form is to be filed with the appropriate District Office of the Division not later than 20 days after the completion of any newly-drilled or deepened well and not later than 60 days after completion of closure. When submitted as a completion report, this shall be accompanied by one copy of all electrical and radio-activity logs run on the well and a summary of all special tests conducted, including drill stem tests. All depths reported shall be measured depths. In the case of directionally drilled wells, true vertical depths shall also be reported. For multiple completions, items 11, 12 and 26-31 shall be reported for each zone.

Southeastern New Mexico			Northwestern New Mexico				
T. Anhy	Rustler	835'	T. Canyon	Brushy	7731'	T. Ojo Alamo	T. Penn A "
T. Salt		1188'	T. Strawn			T. Kirtland	T. Penn. "B"
B. Salt		4807'	T. Atoka			T. Fruitland	T. Penn. "C"
T. Yates			T. Miss			T. Pictured Cliffs	T. Penn. "D"
T. 7 Rivers			T. Devonian			T. Cliff House	T. Leadville
T. Queen			T. Silurian			T. Menefee	T. Madison
T. Grayburg			T. Montoya			T. Point Lookout	T. Elbert
T. San Andres			T. Simpson			T. Mancos	T. McCracken
T. Glorieta			T. McKee			T. Gallup	T. Ignacio Otzte
T. Paddock			T. Ellenburger			Base Greenhorn	T. Granite
T. Blinebry			T. Gr. Wash			T. Dakota	
T. Tubb			T. Delaware Sand			T. Morrison	
T. Drinkard			T. Bone Springs			T. Todilto	
T. Abo			T. 1st BS Sand	10,222'		T. Entrada	
T. Wolfcamp	12,285'		T. 2nd BS Sand	10,792'		T. Wingate	
T. Penn			T. 3rd BS Sand	11,868'		T. Chinle	
T. Cisco (Bough C)			T.			T. Permian	

No. 1, from.....to.....

No. 2, from.....to.....

No. 3, from.....to.....

No. 4, from.....to.....

Include data on rate of water inflow and elevation to which water rose in hole.

No. 1, from.....to.....feet.....
 No. 2, from.....to.....feet.....
 No. 3, from.....to.....feet.....

LITHOLOGY RECORD (Attach additional sheet if necessary)

From	To	Thickness In Feet	Lithology

District I

1625 N. French Dr., Hobbs, NM 88240
Phone:(575) 393-6161 Fax:(575) 393-0720

District II

811 S. First St., Artesia, NM 88210
Phone:(575) 748-1283 Fax:(575) 748-9720

District III

1000 Rio Brazos Rd., Aztec, NM 87410
Phone:(505) 334-6178 Fax:(505) 334-6170

District IV

1220 S. St Francis Dr., Santa Fe, NM 87505
Phone:(505) 476-3470 Fax:(505) 476-3462

State of New Mexico
Energy, Minerals and Natural Resources
Oil Conservation Division
1220 S. St Francis Dr.
Santa Fe, NM 87505

ACKNOWLEDGMENTS

Action 23881

ACKNOWLEDGMENTS

Operator: EOG RESOURCES INC P.O. Box 2267 Midland, TX 79702	OGRID: 7377
	Action Number: 23881
	Action Type: [C-104] Completion Packet (C-104C)

ACKNOWLEDGMENTS

☐	I hereby certify that the required Water Use Report has been, or will be, submitted for this wells completion.
☐	I hereby certify that the required FracFocus disclosure has been, or will be, submitted for this wells completion.

District I
1625 N. French Dr., Hobbs, NM 88240
Phone:(575) 393-6161 Fax:(575) 393-0720
District II
811 S. First St., Artesia, NM 88210
Phone:(575) 748-1283 Fax:(575) 748-9720
District III
1000 Rio Brazos Rd., Aztec, NM 87410
Phone:(505) 334-6178 Fax:(505) 334-6170
District IV
1220 S. St Francis Dr., Santa Fe, NM 87505
Phone:(505) 476-3470 Fax:(505) 476-3462

State of New Mexico
Energy, Minerals and Natural Resources
Oil Conservation Division
1220 S. St Francis Dr.
Santa Fe, NM 87505

CONDITIONS

Action 23881

CONDITIONS

Operator: EOG RESOURCES INC P.O. Box 2267 Midland, TX 79702	OGRID: 7377
	Action Number: 23881
	Action Type: [C-104] Completion Packet (C-104C)

CONDITIONS

Created By	Condition	Condition Date
plmartinez	File 3160-4 within 10 days to NMOCD after BLM approval.	7/28/2021