

District I
1625 N. French Dr., Hobbs, NM 88240
District II
811 S. First St., Artesia, NM 88210
District III
1000 Rio Brazos Rd., Aztec, NM 87410
District IV
1220 S. St. Francis Dr., Santa Fe, NM 87505

State of New Mexico
Energy, Minerals & Natural
Resources

Form C-104
Revised August 1, 2011

Submit one copy to appropriate District Office

Oil Conservation Division
1220 South St. Francis Dr.

☐ AMENDED REPORT

I. REQUEST FOR ALLOWABLE MINERAL AUTHORIZATION TO TRANSPORT

¹ Operator name and Address EOG RESOURCES INC PO BOX 2267 MIDLAND, TEXAS 79702		² OGRID Number 7377	
		³ Reason for Filing Code/ Effective Date NW 7/6/2022	
⁴ API Number 30 - 025-49774	⁵ Pool Name Jennings; Upper Bone Spring Shale		⁶ Pool Code 97838
⁷ Property Code 325727	⁸ Property Name QUIJOTE 2 STATE COM		⁹ Well Number 581H

II. ¹⁰ Surface Location

Ul or lot no.	Section	Township	Range	Lot Idn	Feet from the	North/South Line	Feet from the	East/West line	County
A	2	26S	32E		365'	NORTH	796'	EAST	LEA

¹¹ Bottom Hole Location

UL or lot no.	Section	Township	Range	Lot Idn	Feet from the	North/South line	Feet from the	East/West line	County
P	2	26S	32E		111'	SOUTH	558'	EAST	LEA
¹² Lse Code	¹³ Producing Method Code FLOWING	¹⁴ Gas Connection Date	¹⁵ C-129 Permit Number	¹⁶ C-129 Effective Date	¹⁷ C-129 Expiration Date				

III. Oil and Gas Transporters

¹⁸ Transporter OGRID	¹⁹ Transporter Name and Address	²⁰ O/G/W
372812	EOGRM	OIL
151618	ENTERPRISE FIELD SERVICES	GAS
298751	REGENCY FIELD SERVICES	GAS
36785	DCP MIDSTREAM	GAS

IV. Well Completion Data

²¹ Spud Date 02/23/2022	²² Ready Date 07/6/2022	²³ TD 16,089'	²⁴ PBTD 16,064'	²⁵ Perforations 11,200'-16,064'	²⁶ DHC, MC
²⁷ Hole Size	²⁸ Casing & Tubing Size	²⁹ Depth Set	³⁰ Sacks Cement		
16"	12 1/4"	920'	950 SXS CL C/CIRC		
12 1/4"	9 5/8"	4,653'	1590 SXS CL C/CIRC		
7 7/8"	5 1/2"	16,074'	1625 SXS CL H/CIRC TOC @ 4828'	PRESSURE TEST ATTACHED	

V. Well Test Data

³¹ Date New Oil 7/6/2022	³² Gas Delivery Date 7/6/2022	³³ Test Date 7/15/2022	³⁴ Test Length 24 HRS	³⁵ Tbg. Pressure	³⁶ Csg. Pressure 332
³⁷ Choke Size 128	³⁸ Oil 1285	³⁹ Water 1348	⁴⁰ Gas 2943		⁴¹ Test Method

⁴² I hereby certify that the rules of the Oil Conservation Division have been complied with and that the information given above is true and complete to the best of my knowledge and belief. Signature: <i>Kristina Agee</i> Printed name: Kristina Agee Title: REGULATORY SPECIALIST E-mail Address: kristina_agee@eogresources.com Date: 11/14/2023	OIL CONSERVATION DIVISION	
	Approved by: <i>PATRICIA MARTINEZ</i>	
	Title: <i>PETROLEUM SPECIALIST</i>	
	Approval Date: <i>11/14/2023</i>	
	Phone: 432-686-6996	

District I
1625 N. French Dr., Hobbs, NM 88240
Phone: (575) 393-6161 Fax: (575) 393-0720
District II
811 S. First St., Artesia, NM 88210
Phone: (575) 748-1283 Fax: (575) 748-9720
District III
1000 Rio Brazos Road, Aztec, NM 87410
Phone: (505) 334-6178 Fax: (505) 334-6170
District IV
1220 S. St. Francis Dr., Santa Fe, NM 87505
Phone: (505) 476-3460 Fax: (505) 476-3462

State of New Mexico
Energy, Minerals & Natural Resources
Department
OIL CONSERVATION DIVISION
1220 South St. Francis Dr.
Santa Fe, NM 87505

FORM C-102

Revised August 1, 2011

Submit one copy to appropriate

District Office

☐ AMENDED REPORT

WELL LOCATION AND ACREAGE DEDICATION PLAT AS COMPLETE PLAT

¹ API Number 30-025-49774		² Pool Code 97838		³ Pool Name Jennings; Upper Bone Spring Shale	
⁴ Property Code 325727		⁵ Property Name QUIJOTE 2 STATE COM			⁶ Well Number 581H
⁷ OGRID No. 7377		⁸ Operator Name EOG RESOURCES, INC.			⁹ Elevation 3340'


¹⁰Surface Location



UL or lot no.	Section	Township	Range	Lot Idn	Feet from the	North/South line	Feet from the	East/West line	County
A	2	26-S	32-E	-	365'	NORTH	796'	EAST	LEA

¹¹Bottom Hole Location If Different From Surface

UL or lot no.	Section	Township	Range	Lot Idn	Feet from the	North/South line	Feet from the	East/West line	County
P	2	26-S	32-E	-	111'	SOUTH	558'	EAST	LEA

¹² Dedicated Acres 320.00	¹³ Joint or Infill	¹⁴ Consolidation Code	¹⁵ Order No.
--	-------------------------------	----------------------------------	-------------------------

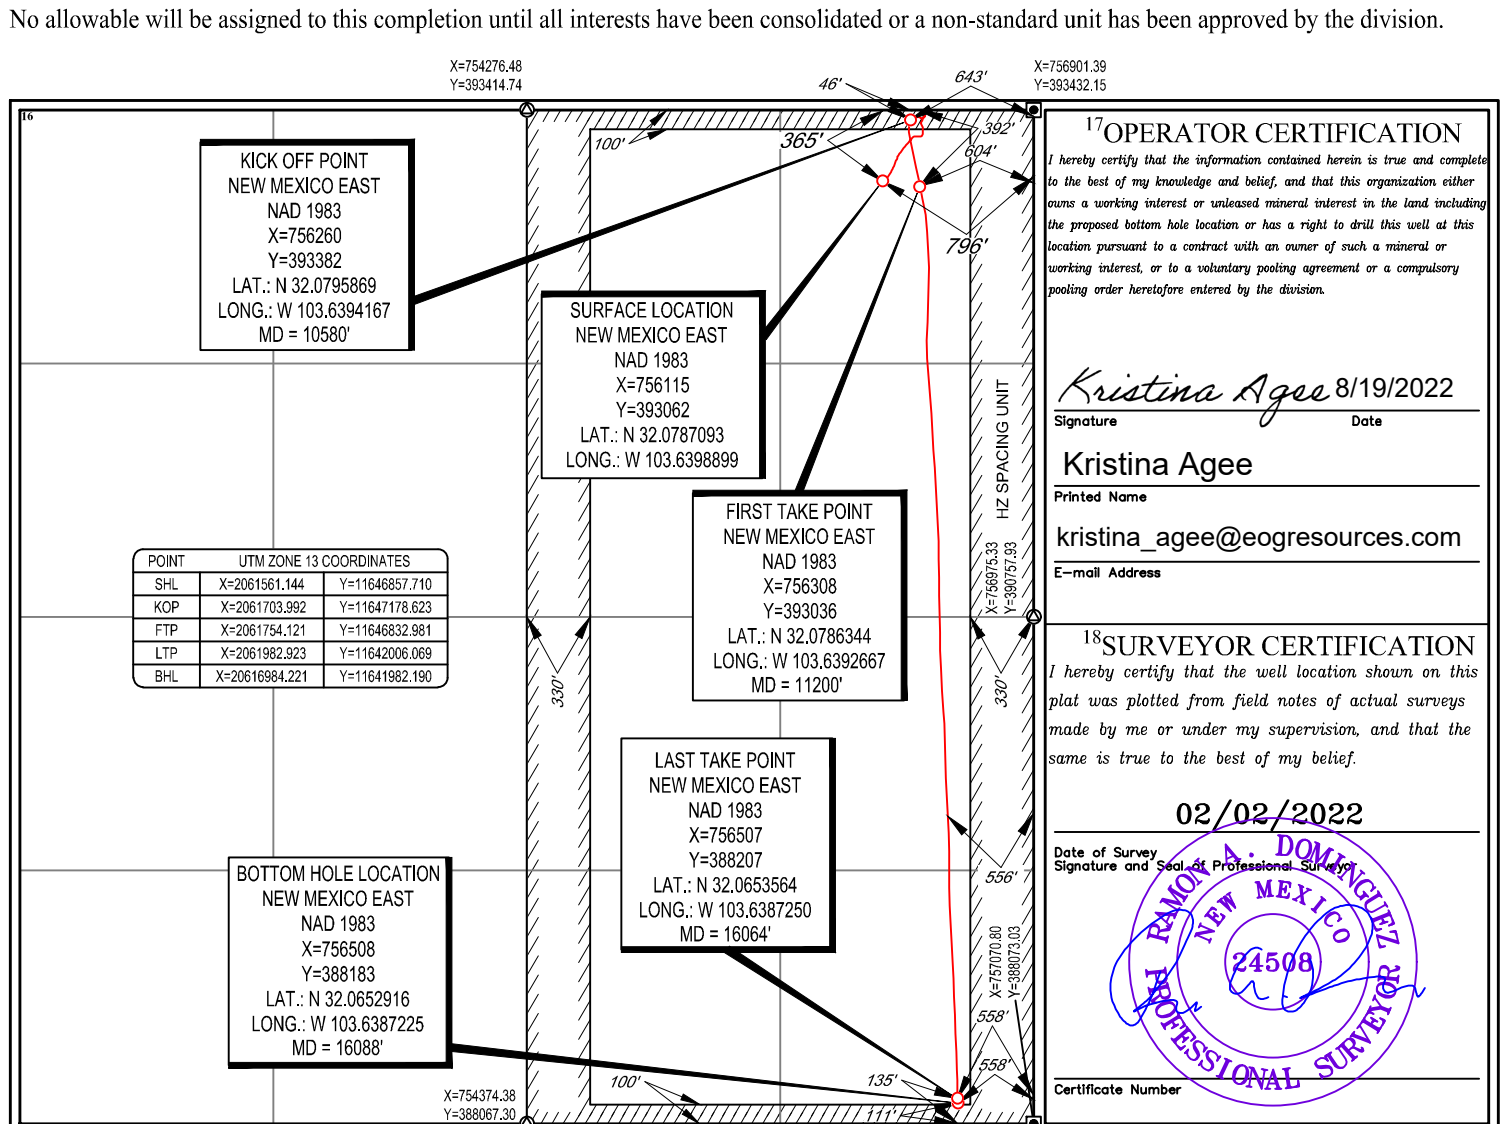

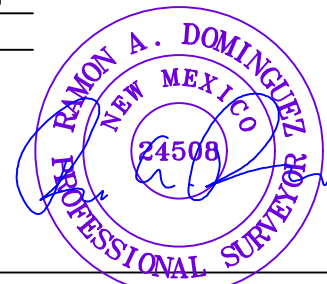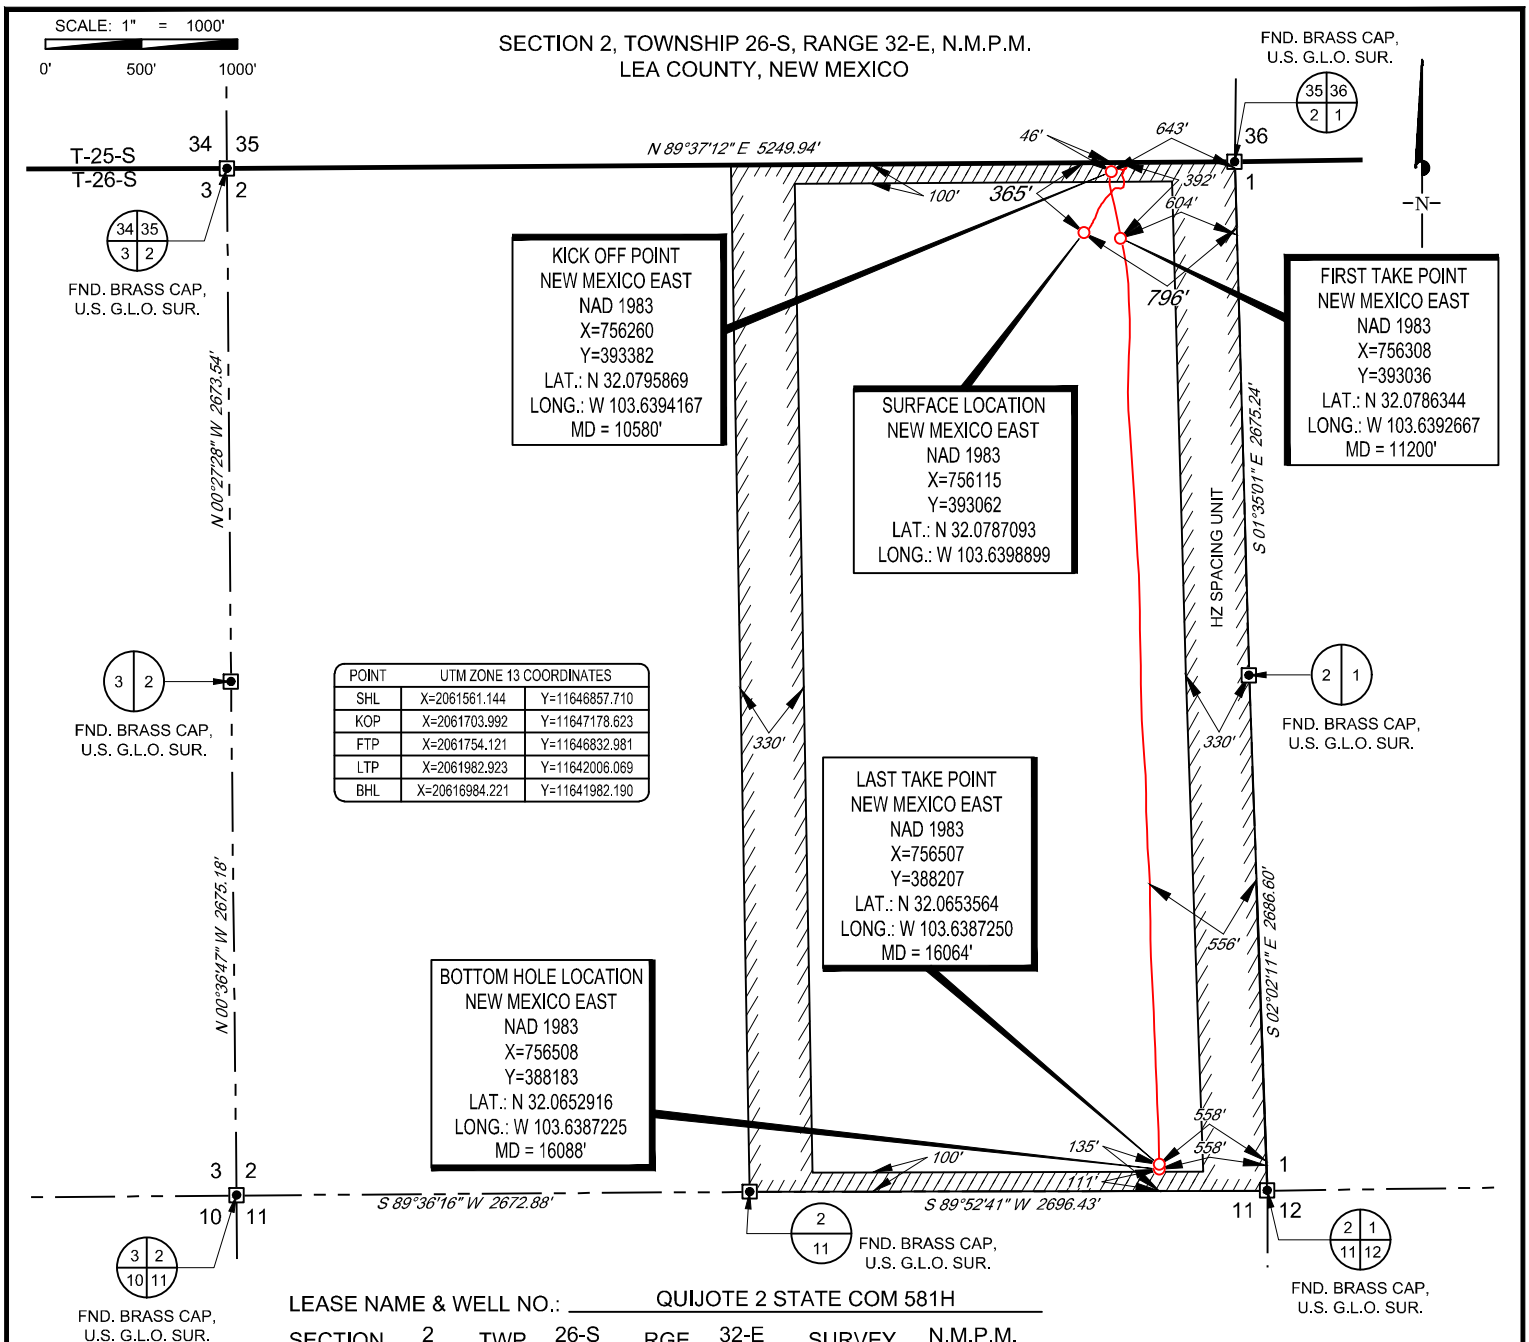

Ramon A. Dominguez, P.S. No. 24508
June 20, 2022

QUIJOTE 2 STATE COM
581H
AS-DRILLED

REVISION:

DATE: 06/17/22

FILE: AD QUIJOTE_2_STATE_COM_581H

DRAWN BY: SAR

SHEET: 2 OF 2

NOTES:

1. ORIGINAL DOCUMENT SIZE: 8.5" X 11"
2. ALL BEARINGS, DISTANCES, AND COORDINATE VALUES CONTAINED HEREIN ARE GRID BASED UPON THE NEW MEXICO COORDINATE SYSTEM OF 1983, EAST ZONE, U.S. SURVEY FEET.
3. THIS WELL LOCATION SHOWN HEREON HAS BEEN SURVEYED ON THE GROUND UNDER MY SUPERVISION AND PREPARED ACCORDING TO THE EVIDENCE FOUND AT THE TIME OF SURVEY, AND DATA PROVIDED BY EOG RESOURCES, INC. THIS CERTIFICATION IS MADE AND LIMITED TO THOSE PERSONS OR ENTITIES SHOWN ON THE FACE OF THIS PLAT AND IS NON-TRANSFERABLE. THIS SURVEY IS CERTIFIED FOR THIS TRANSACTION ONLY.



Midland

Lea County, NM (NAD 83 NME)

Quijote 2 State Com

#581H

OH

Design: OH

Final PVA

12 May, 2022





Final PVA



Company:	Midland	Local Co-ordinate Reference:	Well #581H
Project:	Lea County, NM (NAD 83 NME)	TVD Reference:	KB = 26' @ 3366.0usft
Site:	Quijote 2 State Com	MD Reference:	KB = 26' @ 3366.0usft
Well:	#581H	North Reference:	Grid
Wellbore:	OH	Survey Calculation Method:	Minimum Curvature
Design:	OH	Database:	PEDM

Project	Lea County, NM (NAD 83 NME)		
Map System:	US State Plane 1983	System Datum:	Mean Sea Level
Geo Datum:	North American Datum 1983		
Map Zone:	New Mexico Eastern Zone		

Site	Quijote 2 State Com		
Site Position:		Northing:	393,066.99 usft
From:	Map	Easting:	756,153.00 usft
Position Uncertainty:	0.0 usft	Slot Radius:	13-3/16 "
		Latitude:	32° 4' 43.401 N
		Longitude:	103° 38' 23.163 W
		Grid Convergence:	0.37 °

Well		#581H				
Well Position	+N-S	0.0 usft	Northing:	393,062.00 usft	Latitude:	32° 4' 43.354 N
	+E-W	0.0 usft	Easting:	756,115.00 usft	Longitude:	103° 38' 23.605 W
Position Uncertainty		0.0 usft	Wellhead Elevation:	usft	Ground Level:	3,340.0 usft

Wellbore	OH				
Magnetics	Model Name	Sample Date	Declination (°)	Dip Angle (°)	Field Strength (nT)
	IGRF2020	4/22/2022	6.47	59.73	47,312.88558691

Design	OH			
Audit Notes:				
Version:	1.0	Phase:	ACTUAL	Tie On Depth: 0.0
Vertical Section:	Depth From (TVD) (usft)	+N/-S (usft)	+E/-W (usft)	Direction (°)
	0.0	0.0	0.0	175.58

Survey Program	Date	5/12/2022		
From (usft)	To (usft)	Survey (Wellbore)	Tool Name	Description
121.0	16,089.0	Altitude MWD (OH)	EOG MWD+IFR1	MWD + IFR1

Company:	Midland	Local Co-ordinate Reference:	Well #581H
Project:	Lea County, NM (NAD 83 NME)	TVD Reference:	KB = 26' @ 3366.0usft
Site:	Quijote 2 State Com	MD Reference:	KB = 26' @ 3366.0usft
Well:	#581H	North Reference:	Grid
Wellbore:	OH	Survey Calculation Method:	Minimum Curvature
Design:	OH	Database:	PEDM

Survey											
MD (usft)	Inc (°)	Azi (azimuth) (°)	TVD (usft)	N/S (usft)	E/W (usft)	DLeg (°/100usft)	Build (°/100usft)	Turn (°/100usft)	High to Plan (usft)	Right to Plan (usft)	
0.0	0.00	0.00	0.0	0.0	0.0	0.00	0.00	0.00	0.0	0.0	
121.0	0.52	164.57	121.0	-0.5	0.1	0.43	0.43	0.00	-0.5	0.0	
303.0	0.80	86.99	303.0	-1.3	1.6	0.47	0.15	-42.63	-1.6	-1.3	
394.0	0.83	71.80	394.0	-1.0	2.9	0.24	0.03	-16.69	-2.4	-1.9	
575.0	0.98	48.11	575.0	0.4	5.3	0.22	0.08	-13.09	-4.2	-3.2	
673.0	1.09	43.21	672.9	1.7	6.6	0.14	0.11	-5.00	-5.7	-3.6	
769.0	0.83	43.14	768.9	2.8	7.7	0.27	-0.27	-0.07	-7.3	-3.6	
864.0	1.22	54.17	863.9	3.9	8.9	0.46	0.41	11.61	-9.6	-2.1	
960.0	1.62	61.62	959.9	5.2	11.0	0.46	0.42	7.76	-12.1	-0.7	
1,055.0	3.44	42.08	1,054.8	7.9	14.1	2.09	1.92	-20.57	-14.8	-5.2	
1,150.0	3.49	44.60	1,149.6	12.1	18.0	0.17	0.05	2.65	-17.4	-5.0	
1,246.0	5.12	37.23	1,245.3	17.6	22.6	1.79	1.70	-7.68	-17.1	-8.0	
1,341.0	6.03	37.24	1,339.9	24.9	28.2	0.96	0.96	0.01	-16.9	-8.5	
1,436.0	5.35	31.58	1,434.4	32.7	33.6	0.93	-0.72	-5.96	-15.5	-10.2	
1,531.0	4.71	31.94	1,529.1	39.8	38.0	0.67	-0.67	0.38	-13.9	-9.7	
1,626.0	4.46	32.09	1,623.8	46.2	42.0	0.26	-0.26	0.16	-11.6	-9.3	
1,721.0	5.37	26.01	1,718.4	53.3	45.9	1.10	0.96	-6.40	-8.9	-9.4	
1,817.0	5.52	26.16	1,814.0	61.5	49.9	0.16	0.16	0.16	-8.1	-8.0	
1,912.0	5.34	26.71	1,908.5	69.6	53.9	0.20	-0.19	0.58	-7.3	-6.6	
2,007.0	4.86	24.88	2,003.2	77.2	57.6	0.53	-0.51	-1.93	-5.7	-5.4	
2,197.0	4.55	22.29	2,192.5	91.4	63.8	0.20	-0.16	-1.36	-1.6	-1.9	
2,292.0	4.72	18.60	2,287.2	98.6	66.5	0.36	0.18	-3.88	0.5	0.4	
2,387.0	4.25	21.66	2,381.9	105.6	69.0	0.55	-0.49	3.22	2.8	2.7	
2,482.0	4.27	21.15	2,476.7	112.2	71.6	0.05	0.02	-0.54	5.4	4.9	
2,577.0	4.73	18.96	2,571.4	119.2	74.2	0.52	0.48	-2.31	7.4	7.6	
2,672.0	3.90	20.29	2,666.1	125.9	76.6	0.88	-0.87	1.40	10.0	9.9	
2,767.0	5.46	35.26	2,760.8	132.6	80.3	2.07	1.64	15.76	14.5	7.6	

Company:	Midland	Local Co-ordinate Reference:	Well #581H
Project:	Lea County, NM (NAD 83 NME)	TVD Reference:	KB = 26' @ 3366.0usft
Site:	Quijote 2 State Com	MD Reference:	KB = 26' @ 3366.0usft
Well:	#581H	North Reference:	Grid
Wellbore:	OH	Survey Calculation Method:	Minimum Curvature
Design:	OH	Database:	PEDM

Survey											
MD (usft)	Inc (°)	Azi (azimuth) (°)	TVD (usft)	N/S (usft)	E/W (usft)	DLeg (°/100usft)	Build (°/100usft)	Turn (°/100usft)	High to Plan (usft)	Right to Plan (usft)	
2,858.0	6.44	33.36	2,851.3	140.4	85.6	1.10	1.08	-2.09	14.4	8.1	
2,958.0	6.27	36.09	2,950.7	149.5	91.9	0.35	-0.17	2.73	14.1	7.3	
3,053.0	5.65	34.93	3,045.2	157.6	97.6	0.66	-0.65	-1.22	14.0	7.3	
3,148.0	5.78	35.64	3,139.7	165.3	103.1	0.16	0.14	0.75	14.6	6.9	
3,243.0	5.44	36.95	3,234.2	172.8	108.6	0.38	-0.36	1.38	15.4	6.2	
3,338.0	5.47	41.67	3,328.8	179.7	114.3	0.47	0.03	4.97	16.7	4.0	
3,433.0	5.51	43.67	3,423.4	186.4	120.5	0.21	0.04	2.11	17.5	1.9	
3,623.0	5.10	43.47	3,612.6	199.2	132.6	0.22	-0.22	-0.11	19.5	-1.3	
3,718.0	4.97	40.72	3,707.2	205.3	138.2	0.29	-0.14	-2.89	21.1	-1.7	
3,814.0	4.57	38.43	3,802.9	211.5	143.3	0.46	-0.42	-2.39	23.2	-1.8	
3,909.0	3.93	33.96	3,897.6	217.1	147.4	0.76	-0.67	-4.71	26.2	-0.2	
4,004.0	2.85	34.73	3,992.4	221.8	150.6	1.14	-1.14	0.81	30.5	-0.7	
4,099.0	3.33	54.06	4,087.3	225.4	154.2	1.20	0.51	20.35	33.0	-13.3	
4,194.0	3.24	52.95	4,182.1	228.6	158.5	0.12	-0.09	-1.17	37.2	-15.9	
4,289.0	3.28	64.90	4,277.0	231.4	163.1	0.72	0.04	12.58	36.3	-27.8	
4,479.0	3.78	98.63	4,466.6	232.7	174.3	1.11	0.26	17.75	12.7	-58.1	
4,574.0	3.79	103.04	4,561.4	231.5	180.4	0.31	0.01	4.64	5.6	-68.0	
4,601.0	3.61	97.54	4,588.4	231.2	182.1	1.47	-0.67	-20.37	11.6	-69.7	
4,773.0	3.07	89.89	4,760.1	230.5	192.1	0.41	-0.31	-4.45	19.3	-81.0	
4,868.0	3.18	73.93	4,854.9	231.3	197.2	0.92	0.12	-16.80	38.9	-76.1	
4,963.0	3.35	51.91	4,949.8	233.7	201.9	1.32	0.18	-23.18	60.2	-57.4	
5,059.0	3.94	25.15	5,045.6	238.4	205.5	1.86	0.61	-27.87	73.8	-25.3	
5,154.0	4.07	7.67	5,140.4	244.7	207.3	1.29	0.14	-18.40	71.5	-2.9	
5,249.0	3.46	6.29	5,235.2	250.9	208.1	0.65	-0.64	-1.45	65.3	-1.3	
5,439.0	3.45	1.56	5,424.8	262.3	208.9	0.15	-0.01	-2.49	53.8	3.7	
5,629.0	3.28	348.66	5,614.5	273.4	208.0	0.41	-0.09	-6.79	40.6	14.3	
5,725.0	3.27	342.12	5,710.4	278.7	206.6	0.39	-0.01	-6.81	33.2	18.5	

Company:	Midland	Local Co-ordinate Reference:	Well #581H
Project:	Lea County, NM (NAD 83 NME)	TVD Reference:	KB = 26' @ 3366.0usft
Site:	Quijote 2 State Com	MD Reference:	KB = 26' @ 3366.0usft
Well:	#581H	North Reference:	Grid
Wellbore:	OH	Survey Calculation Method:	Minimum Curvature
Design:	OH	Database:	PEDM

Survey										
MD (usft)	Inc (°)	Azi (azimuth) (°)	TVD (usft)	N/S (usft)	E/W (usft)	DLeg (°/100usft)	Build (°/100usft)	Turn (°/100usft)	High to Plan (usft)	Right to Plan (usft)
5,820.0	3.09	340.08	5,805.2	283.7	204.9	0.22	-0.19	-2.15	27.3	19.6
5,915.0	3.05	339.56	5,900.1	288.4	203.1	0.05	-0.04	-0.55	22.0	19.8
6,011.0	2.84	329.46	5,995.9	292.9	201.0	0.58	-0.22	-10.52	13.3	22.9
6,106.0	2.22	341.69	6,090.8	296.6	199.3	0.86	-0.65	12.87	13.7	20.1
6,201.0	2.18	349.25	6,185.8	300.2	198.3	0.31	-0.04	7.96	12.6	18.3
6,297.0	2.30	27.33	6,281.7	303.7	198.9	1.53	0.12	39.67	17.9	7.8
6,392.0	2.44	27.48	6,376.6	307.2	200.7	0.15	0.15	0.16	14.0	7.7
6,487.0	2.58	29.43	6,471.5	310.8	202.7	0.17	0.15	2.05	10.1	7.3
6,583.0	2.37	21.79	6,567.4	314.5	204.5	0.41	-0.22	-7.96	4.9	8.3
6,678.0	2.17	20.41	6,662.4	318.0	205.8	0.22	-0.21	-1.45	0.9	8.4
6,773.0	1.91	18.68	6,757.3	321.2	207.0	0.28	-0.27	-1.82	-2.7	8.3
6,868.0	1.74	16.11	6,852.3	324.1	207.9	0.20	-0.18	-2.71	-6.1	8.1
6,963.0	1.50	11.18	6,947.2	326.7	208.5	0.29	-0.25	-5.19	-9.5	7.5
7,058.0	1.69	29.56	7,042.2	329.2	209.5	0.57	0.20	19.35	-9.2	10.4
7,153.0	2.01	38.31	7,137.1	331.7	211.2	0.45	0.34	9.21	-10.6	11.9
7,248.0	1.73	35.28	7,232.1	334.2	213.0	0.31	-0.29	-3.19	-14.3	11.3
7,342.0	1.74	28.10	7,326.0	336.6	214.5	0.23	0.01	-7.64	-18.4	9.2
7,438.0	1.46	45.66	7,422.0	338.7	216.1	0.58	-0.29	18.29	-17.4	14.8
7,533.0	1.29	66.82	7,517.0	340.0	217.9	0.56	-0.18	22.27	-13.1	20.5
7,628.0	1.00	88.87	7,612.0	340.4	219.8	0.55	-0.31	23.21	-6.2	24.3
7,722.0	0.35	92.73	7,706.0	340.4	220.9	0.69	-0.69	4.11	-5.7	24.7
7,818.0	0.19	21.69	7,802.0	340.6	221.2	0.35	-0.17	-74.00	-25.5	2.4
7,913.0	0.10	63.86	7,897.0	340.7	221.3	0.14	-0.09	44.39	-17.5	19.0
8,008.0	0.36	223.19	7,992.0	340.6	221.2	0.48	0.27	167.72	22.9	-11.6
8,198.0	0.56	218.31	8,182.0	339.4	220.2	0.11	0.11	-2.57	22.2	-9.6
8,294.0	0.78	218.74	8,277.9	338.5	219.5	0.23	0.23	0.45	21.0	-9.8
8,389.0	0.89	214.09	8,372.9	337.4	218.7	0.14	0.12	-4.89	20.4	-8.1

Company:	Midland	Local Co-ordinate Reference:	Well #581H
Project:	Lea County, NM (NAD 83 NME)	TVD Reference:	KB = 26' @ 3366.0usft
Site:	Quijote 2 State Com	MD Reference:	KB = 26' @ 3366.0usft
Well:	#581H	North Reference:	Grid
Wellbore:	OH	Survey Calculation Method:	Minimum Curvature
Design:	OH	Database:	PEDM

Survey											
MD (usft)	Inc (°)	Azi (azimuth) (°)	TVD (usft)	N/S (usft)	E/W (usft)	DLeg (°/100usft)	Build (°/100usft)	Turn (°/100usft)	High to Plan (usft)	Right to Plan (usft)	
8,579.0	0.64	192.22	8,562.9	335.2	217.7	0.20	-0.13	-11.51	19.5	-0.5	
8,769.0	1.31	226.97	8,752.9	332.6	215.8	0.46	0.35	18.29	12.7	-10.9	
8,960.0	1.80	231.13	8,943.8	329.3	211.9	0.26	0.26	2.18	6.7	-11.6	
9,055.0	2.28	252.86	9,038.8	327.8	208.9	0.95	0.51	22.87	-1.4	-12.7	
9,150.0	2.45	268.68	9,133.7	327.2	205.1	0.71	0.18	16.65	-8.6	-11.4	
9,245.0	1.85	275.35	9,228.6	327.3	201.6	0.68	-0.63	7.02	-13.4	-10.1	
9,340.0	2.34	277.70	9,323.6	327.7	198.1	0.52	0.52	2.47	-17.3	-9.4	
9,436.0	2.26	288.36	9,419.5	328.5	194.4	0.45	-0.08	11.10	-22.6	-5.7	
9,531.0	2.32	307.72	9,514.4	330.3	191.1	0.81	0.06	20.38	-26.9	2.7	
9,626.0	1.37	316.25	9,609.3	332.3	188.8	1.04	-1.00	8.98	-29.2	7.0	
9,721.0	1.47	279.18	9,704.3	333.3	186.8	0.96	0.11	-39.02	-29.6	-12.7	
9,817.0	2.49	261.85	9,800.3	333.2	183.5	1.22	1.06	-18.05	-27.7	-21.4	
9,912.0	3.26	255.71	9,895.1	332.2	178.8	0.87	0.81	-6.46	-30.0	-24.4	
10,007.0	2.96	249.99	9,990.0	330.7	173.9	0.45	-0.32	-6.02	-32.6	-27.6	
10,102.0	3.08	261.15	10,084.9	329.5	169.1	0.63	0.13	11.75	-42.3	-20.3	
10,197.0	3.05	263.86	10,179.7	328.8	164.1	0.16	-0.03	2.85	-48.3	-18.1	
10,292.0	3.08	250.92	10,274.6	327.7	159.1	0.73	0.03	-13.62	-48.0	-29.1	
10,387.0	3.04	254.14	10,369.5	326.2	154.3	0.19	-0.04	3.39	-54.6	-26.2	
10,515.0	3.29	241.73	10,497.3	323.5	147.8	0.57	0.20	-9.70	-54.7	-38.0	
10,580.0	5.19	213.88	10,562.1	320.2	144.5	4.23	2.92	-42.85	-35.1	-60.1	
KOP, MD:10580.0', TVD:10562.1', N/S:320.2', E/W:144.5', INC:5.19											
10,610.0	6.28	207.38	10,591.9	317.6	143.0	4.23	3.64	-21.66	-31.0	-63.9	
10,705.0	21.68	193.02	10,683.9	295.8	136.6	16.49	16.21	-15.12	-29.2	-73.2	
10,775.0	29.68	178.25	10,747.0	265.8	134.2	14.56	11.43	-21.11	-26.1	-81.5	
FTP Crossing, MD:10775.0', TVD:10747.0', N/S:265.8', E/W:134.2', INC:29.68											
10,800.0	32.81	174.67	10,768.4	252.9	135.0	14.56	12.53	-14.31	-27.5	-82.8	
10,895.0	34.62	165.19	10,847.4	201.1	144.3	5.85	1.91	-9.98	-34.2	-81.1	

Company:	Midland	Local Co-ordinate Reference:	Well #581H
Project:	Lea County, NM (NAD 83 NME)	TVD Reference:	KB = 26' @ 3366.0usft
Site:	Quijote 2 State Com	MD Reference:	KB = 26' @ 3366.0usft
Well:	#581H	North Reference:	Grid
Wellbore:	OH	Survey Calculation Method:	Minimum Curvature
Design:	OH	Database:	PEDM

Survey										
MD (usft)	Inc (°)	Azi (azimuth) (°)	TVD (usft)	N/S (usft)	E/W (usft)	DLeg (°/100usft)	Build (°/100usft)	Turn (°/100usft)	High to Plan (usft)	Right to Plan (usft)
10,990.0	46.33	167.55	10,919.6	141.3	158.7	12.43	12.33	2.48	-50.3	-68.2
11,085.0	54.48	168.68	10,980.1	69.7	173.7	8.63	8.58	1.19	-63.4	-54.7
11,180.0	59.08	168.19	11,032.1	-8.2	189.7	4.86	4.84	-0.52	-68.2	-40.3
11,275.0	63.28	169.22	11,077.9	-89.8	205.9	4.52	4.42	1.08	-62.5	-24.2
11,370.0	69.42	170.13	11,116.0	-175.3	221.5	6.52	6.46	0.96	-47.4	-9.1
11,465.0	73.65	178.50	11,146.1	-264.9	230.3	9.47	4.45	8.81	-23.8	-2.0
11,560.0	77.73	175.68	11,169.6	-356.8	235.0	5.17	4.29	-2.97	-0.4	-0.1
11,655.0	86.54	179.32	11,182.6	-450.7	239.1	10.02	9.27	3.83	12.6	1.1
11,750.0	88.56	182.10	11,186.6	-545.6	237.9	3.61	2.13	2.93	16.7	-3.1
11,845.0	88.33	181.53	11,189.2	-640.5	234.9	0.65	-0.24	-0.60	19.3	-9.1
11,940.0	89.65	182.50	11,190.9	-735.4	231.6	1.72	1.39	1.02	20.9	-15.4
12,035.0	88.27	181.00	11,192.6	-830.4	228.7	2.15	-1.45	-1.58	22.6	-21.3
12,130.0	86.40	176.20	11,197.0	-925.2	231.0	5.42	-1.97	-5.05	27.1	-21.9
12,225.0	88.86	174.97	11,201.0	-1,019.8	238.3	2.89	2.59	-1.29	31.0	-17.6
12,415.0	90.15	176.55	11,202.6	-1,209.3	252.4	1.07	0.68	0.83	32.6	-9.5
12,605.0	91.41	176.61	11,200.0	-1,399.0	263.7	0.66	0.66	0.03	30.1	-4.1
12,700.0	91.75	176.69	11,197.4	-1,493.8	269.2	0.37	0.36	0.08	27.4	-1.5
12,795.0	91.13	177.12	11,195.0	-1,588.6	274.4	0.79	-0.65	0.45	25.0	0.6
12,890.0	89.99	176.78	11,194.1	-1,683.4	279.4	1.25	-1.20	-0.36	24.1	2.7
12,986.0	88.25	175.85	11,195.6	-1,779.2	285.6	2.06	-1.81	-0.97	25.6	5.9
13,081.0	90.38	179.71	11,196.7	-1,874.1	289.3	4.64	2.24	4.06	26.7	6.6
13,176.0	89.73	179.00	11,196.6	-1,969.1	290.3	1.01	-0.68	-0.75	26.6	4.6
13,271.0	89.26	179.24	11,197.4	-2,064.1	291.8	0.56	-0.49	0.25	27.5	3.1
13,366.0	88.02	178.69	11,199.7	-2,159.1	293.5	1.43	-1.31	-0.58	29.7	1.9
13,461.0	90.15	178.85	11,201.2	-2,254.0	295.5	2.25	2.24	0.17	31.2	0.9
13,556.0	90.57	179.54	11,200.6	-2,349.0	296.9	0.85	0.44	0.73	30.6	-0.7
13,651.0	86.09	178.12	11,203.4	-2,443.9	298.8	4.95	-4.72	-1.49	33.4	-1.8

Company:	Midland	Local Co-ordinate Reference:	Well #581H
Project:	Lea County, NM (NAD 83 NME)	TVD Reference:	KB = 26' @ 3366.0usft
Site:	Quijote 2 State Com	MD Reference:	KB = 26' @ 3366.0usft
Well:	#581H	North Reference:	Grid
Wellbore:	OH	Survey Calculation Method:	Minimum Curvature
Design:	OH	Database:	PEDM

Survey										
MD (usft)	Inc (°)	Azi (azimuth) (°)	TVD (usft)	N/S (usft)	E/W (usft)	DLeg (°/100usft)	Build (°/100usft)	Turn (°/100usft)	High to Plan (usft)	Right to Plan (usft)
13,747.0	87.41	177.54	11,208.8	-2,539.7	302.4	1.50	1.37	-0.60	38.8	-1.1
13,862.0	91.22	176.93	11,210.2	-2,654.5	308.0	3.36	3.31	-0.53	40.2	0.8
13,972.0	90.35	174.80	11,208.7	-2,764.2	315.9	2.09	-0.79	-1.94	38.7	5.3
14,032.0	92.37	176.41	11,207.3	-2,824.0	320.5	4.30	3.37	2.68	37.3	8.0
14,127.0	92.28	179.93	11,203.4	-2,918.9	323.6	3.70	-0.09	3.71	33.4	8.1
14,222.0	91.81	178.60	11,200.0	-3,013.8	324.8	1.48	-0.49	-1.40	30.0	6.3
14,317.0	90.77	177.65	11,197.9	-3,108.7	327.9	1.48	-1.09	-1.00	27.9	6.4
14,412.0	90.18	176.86	11,197.1	-3,203.6	332.4	1.04	-0.62	-0.83	27.1	8.0
14,507.0	88.95	175.82	11,197.8	-3,298.4	338.5	1.70	-1.29	-1.09	27.8	11.1
14,602.0	90.21	178.94	11,198.5	-3,393.3	342.8	3.54	1.33	3.28	28.5	12.5
14,697.0	92.20	179.38	11,196.5	-3,488.3	344.2	2.15	2.09	0.46	26.5	10.9
14,792.0	90.35	179.47	11,194.4	-3,583.2	345.2	1.95	-1.95	0.09	24.4	8.9
14,887.0	90.27	179.54	11,193.9	-3,678.2	346.0	0.11	-0.08	0.07	23.9	6.7
14,982.0	84.99	177.26	11,197.8	-3,773.1	348.6	6.05	-5.56	-2.40	27.8	6.4
15,077.0	89.37	177.13	11,202.5	-3,867.8	353.3	4.61	4.61	-0.14	32.5	8.0
15,172.0	89.40	176.26	11,203.5	-3,962.7	358.8	0.92	0.03	-0.92	33.5	10.5
15,268.0	91.44	178.00	11,202.8	-4,058.5	363.6	2.79	2.12	1.81	32.8	12.3
15,362.0	92.34	177.90	11,199.7	-4,152.4	366.9	0.96	0.96	-0.11	29.7	12.8
15,457.0	90.97	178.12	11,197.0	-4,247.3	370.2	1.46	-1.44	0.23	27.0	13.1
15,552.0	89.87	177.33	11,196.3	-4,342.2	374.0	1.43	-1.16	-0.83	26.3	13.9
15,648.0	89.62	177.76	11,196.7	-4,438.2	378.1	0.52	-0.26	0.45	26.7	15.0
15,743.0	89.85	177.54	11,197.1	-4,533.1	382.0	0.34	0.24	-0.23	27.1	15.9
15,838.0	89.03	177.17	11,198.1	-4,628.0	386.4	0.95	-0.86	-0.39	28.1	17.3
15,890.0	91.58	179.75	11,197.8	-4,679.9	387.8	6.98	4.90	4.96	27.8	17.1
16,035.0	90.99	177.78	11,194.5	-4,824.9	390.9	1.42	-0.41	-1.36	24.5	15.6
Last MWD Survey (MD=16035.0')										



Final PVA



Company:	Midland	Local Co-ordinate Reference:	Well #581H
Project:	Lea County, NM (NAD 83 NME)	TVD Reference:	KB = 26' @ 3366.0usft
Site:	Quijote 2 State Com	MD Reference:	KB = 26' @ 3366.0usft
Well:	#581H	North Reference:	Grid
Wellbore:	OH	Survey Calculation Method:	Minimum Curvature
Design:	OH	Database:	PEDM

Survey										
MD (usft)	Inc (°)	Azi (azimuth) (°)	TVD (usft)	N/S (usft)	E/W (usft)	DLeg (°/100usft)	Build (°/100usft)	Turn (°/100usft)	High to Plan (usft)	Right to Plan (usft)
16,089.0	90.99	177.78	11,193.6	-4,878.8	393.0	0.00	0.00	0.00	23.6	16.0
Projection to Bit (MD=16089.0')										

Design Annotations				
Measured Depth (usft)	Vertical Depth (usft)	Local Coordinates		Comment
		+N/-S (usft)	+E/-W (usft)	
10,580.0	10,562.1	320.2	144.5	KOP, MD:10580.0', TVD:10562.1',N/S:320.2', E/W:144.5', INC:5.19
10,775.0	10,747.0	265.8	134.2	FTP Crossing, MD:10775.0', TVD:10747.0',N/S:265.8', E/W:134.2', INC:29.68
16,035.0	11,194.5	-4,824.9	390.9	Last MWD Survey (MD=16035.0')
16,089.0	11,193.6	-4,878.8	393.0	Projection to Bit (MD=16089.0')

Checked By: _____ Approved By: _____ Date: _____



Lea County, NM (NAD 83 NME)

Quijote 2 State Com #581H

Plan #1

PROJECT DETAILS: Lea County, NM (NAD 83 NME)


Geodetic System: US State Plane 1983
Datum: North American Datum 1983
Ellipsoid: GRS 1980
Zone: New Mexico Eastern Zone
System Datum: Mean Sea Level

WELL DETAILS: #581H

KB = 26' @ 3366.0usft 3340.0
Northing 393062.00 Easting 756115.00 Latitude 32° 4' 43.354 N Longitude 103° 38' 23.605 W

Azimuths to Grid North
True North: -0.37°
Magnetic North: 6.10°

Magnetic Field
Strength: 47312.9nT
Dip Angle: 59.73°
Date: 4/22/2022
Model: IGRF2020

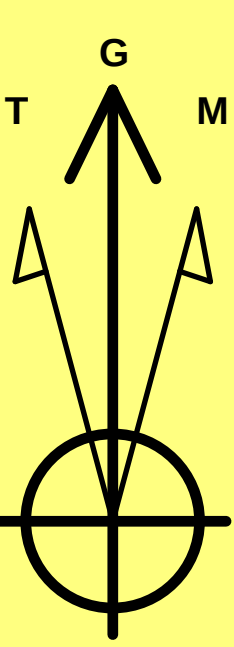

To convert a Magnetic Direction to a Grid Direction, Add 6.10°
To convert a Magnetic Direction to a True Direction, Add 6.47° East
To convert a True Direction to a Grid Direction, Subtract 0.37°

PLANNING DETAILS







Sec	MD	Inc	Azi	TVD	+N/-S	+E/-W	Dleg	TFace	Vsect	Target
1	0.0	0.00	0.00	0.0	0.0	0.0	0.00	0.00	0.0	
2	1000.0	0.00	0.00	1000.0	0.0	0.0	0.00	0.00	0.0	
3	1300.0	6.00	34.11	1299.5	13.0	8.8	2.00	34.11	-12.3	
4	4650.4	6.00	34.11	4631.5	303.0	205.2	0.00	0.00	-286.3	
5	4950.5	0.00	0.00	4931.0	316.0	214.0	2.00	180.00	-298.6	
6	10616.5	0.00	0.00	10597.0	316.0	214.0	0.00	0.00	-298.6	
7	11516.4	90.00	178.20	11170.0	-256.7	232.0	10.00	178.20	273.8	
8	16142.1	90.00	178.20	11170.0	-4880.0	377.0	0.00	0.00	4894.5	PBHL(Quijote 2 State Com #581H)

CASING DETAILS

No casing data is available

WELLBORE TARGET DETAILS (MAP CO-ORDINATES)

Name	TVD	+N/-S	+E/-W	Northing	Easting
PBHL(Quijote 2 State Com #581H)	11170.0	-4880.0	377.0	388182.00	756492.00
Brushy Top(Quijote 2 State Com #581H)	7291.0	316.0	214.0	393378.00	756329.00
FTP(Quijote 2 State Com #581H)	11170.0	266.0	214.0	393328.00	756329.00

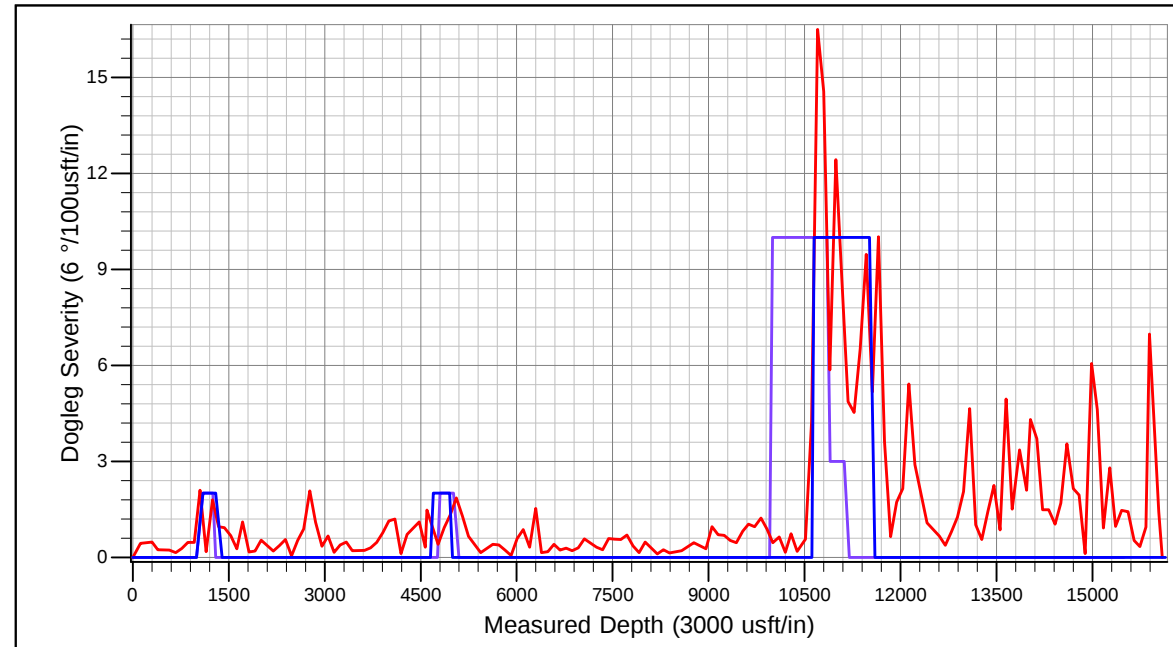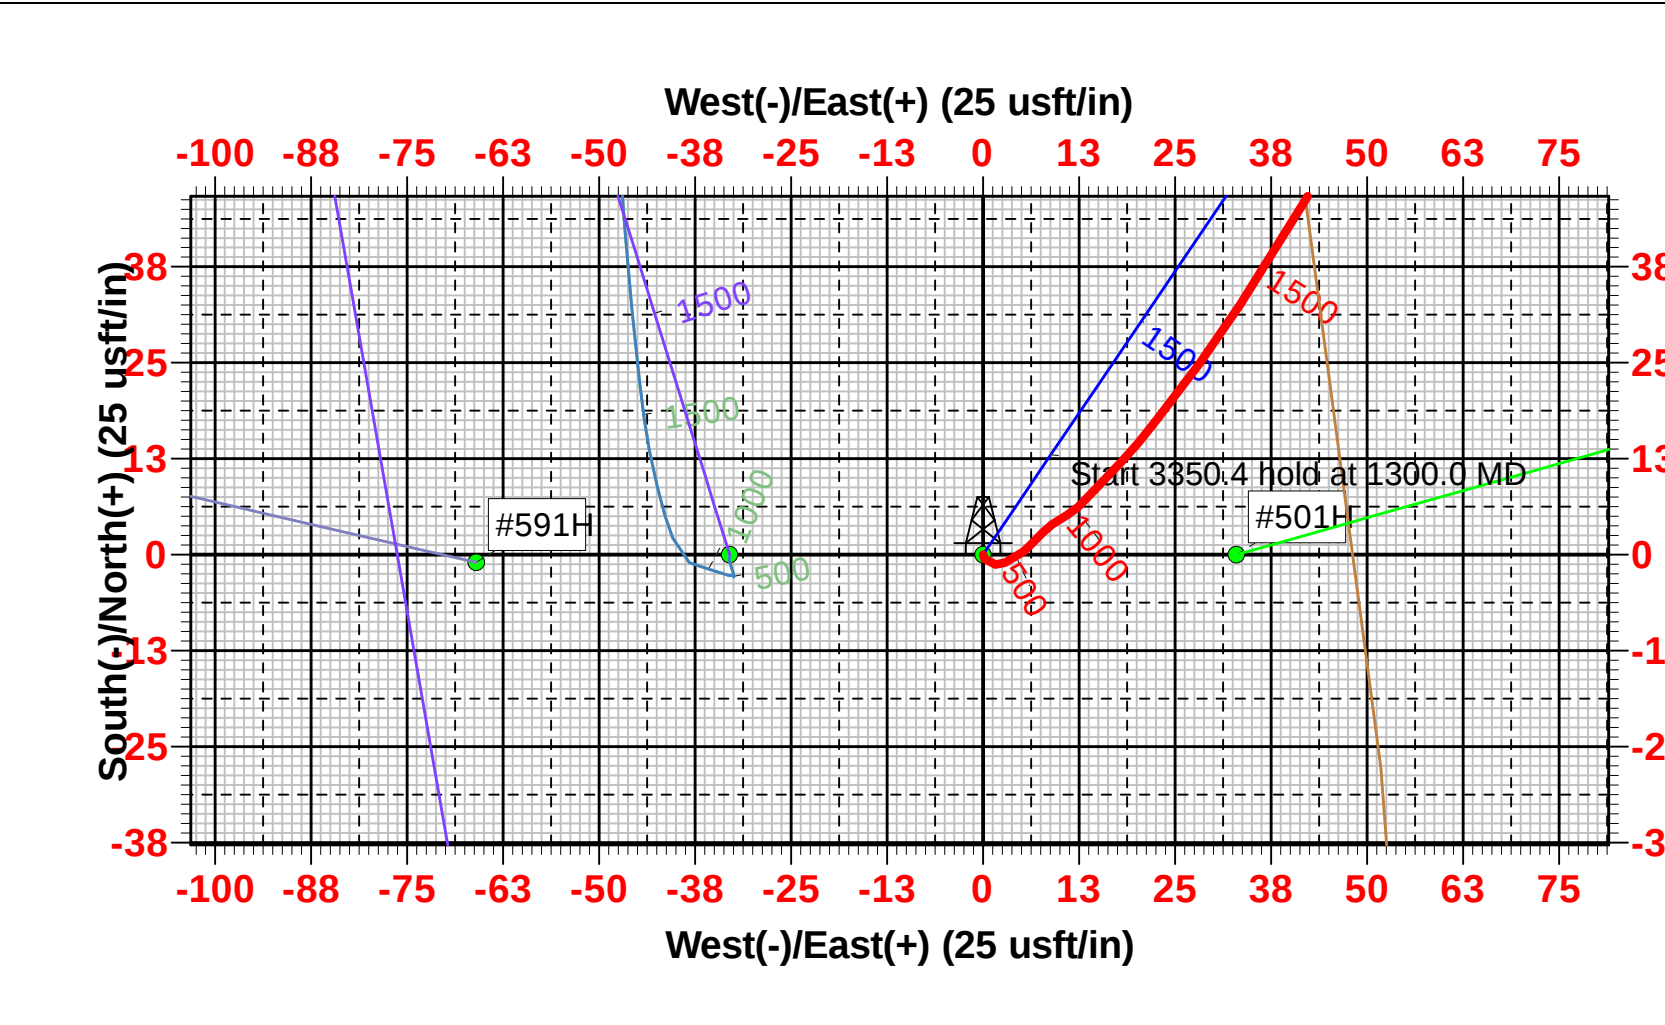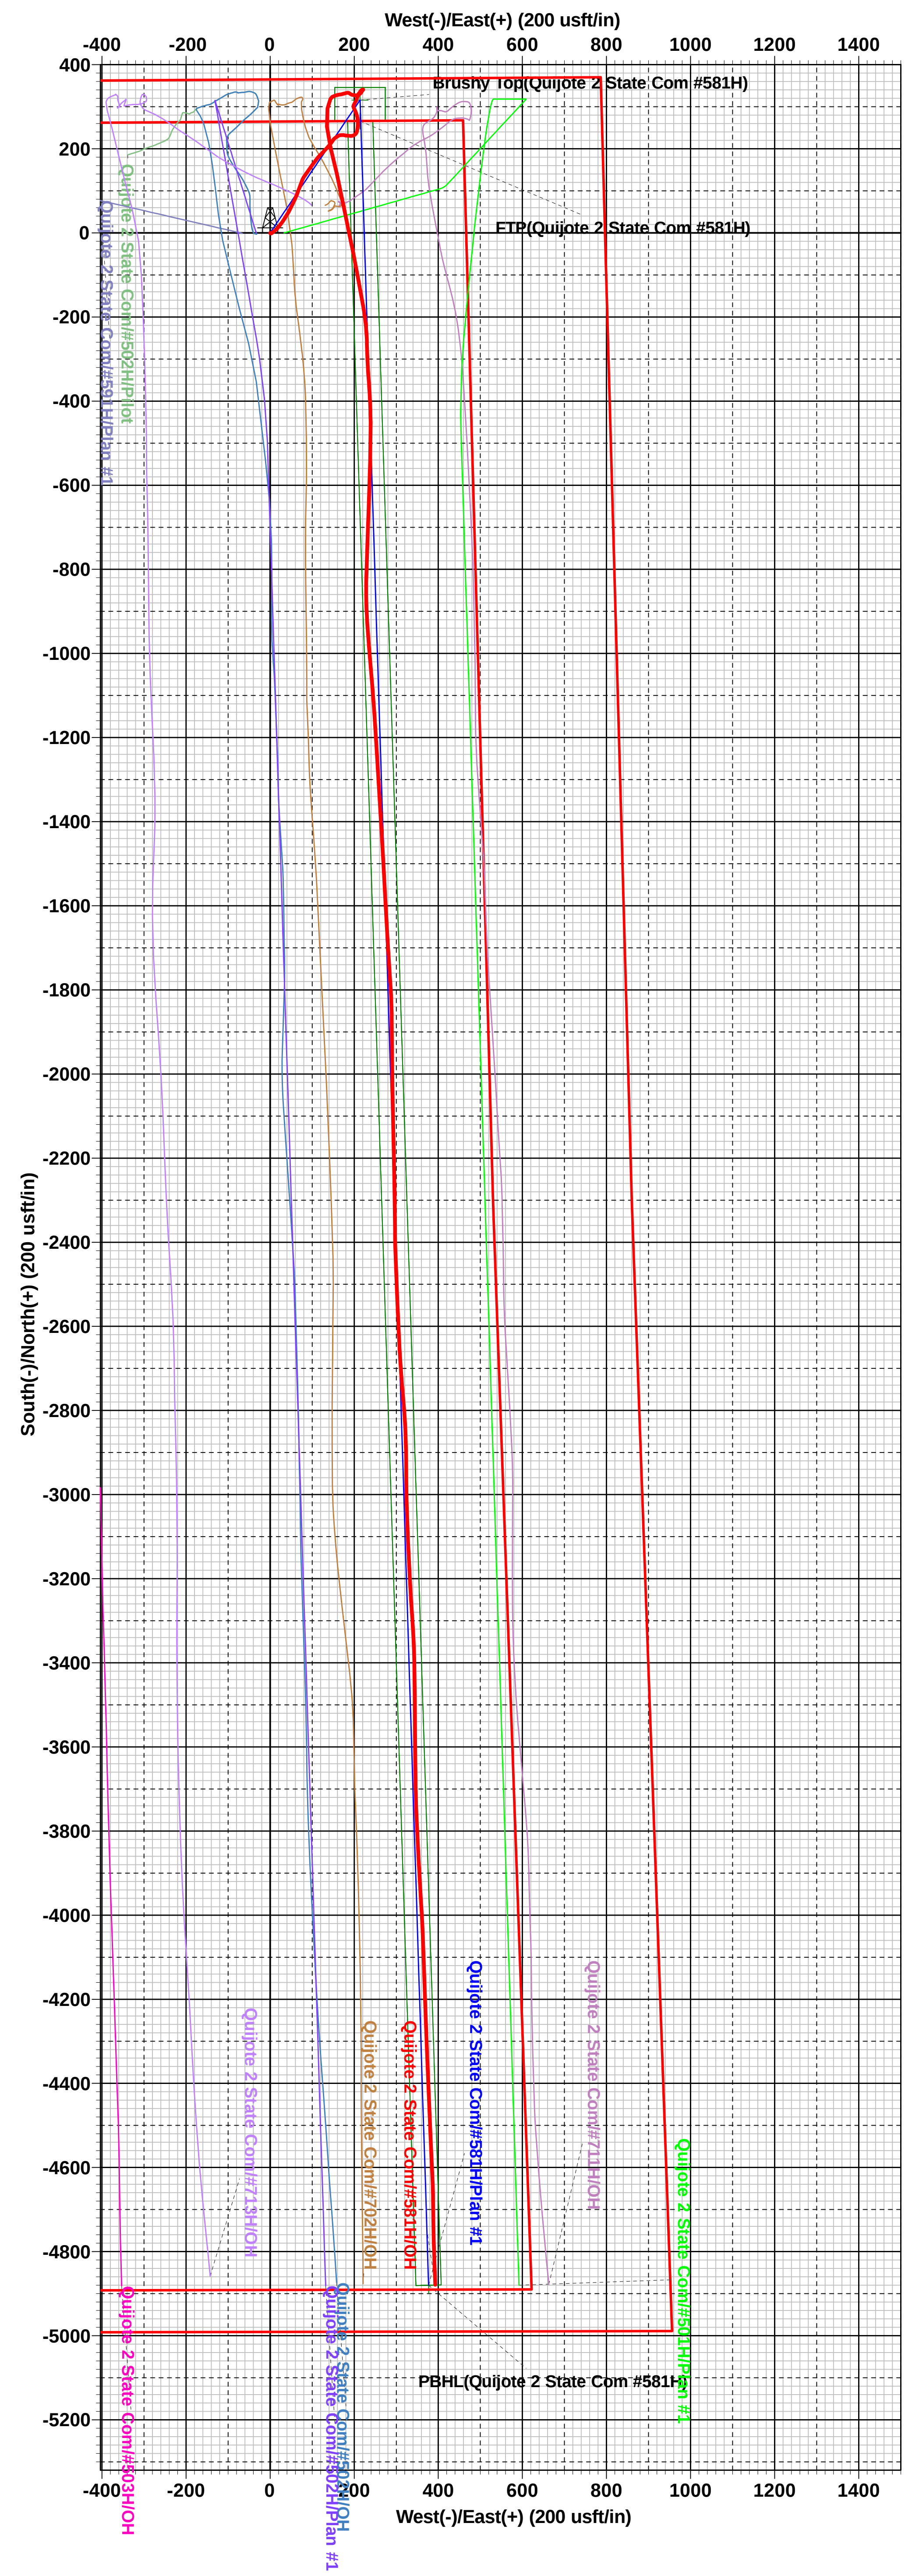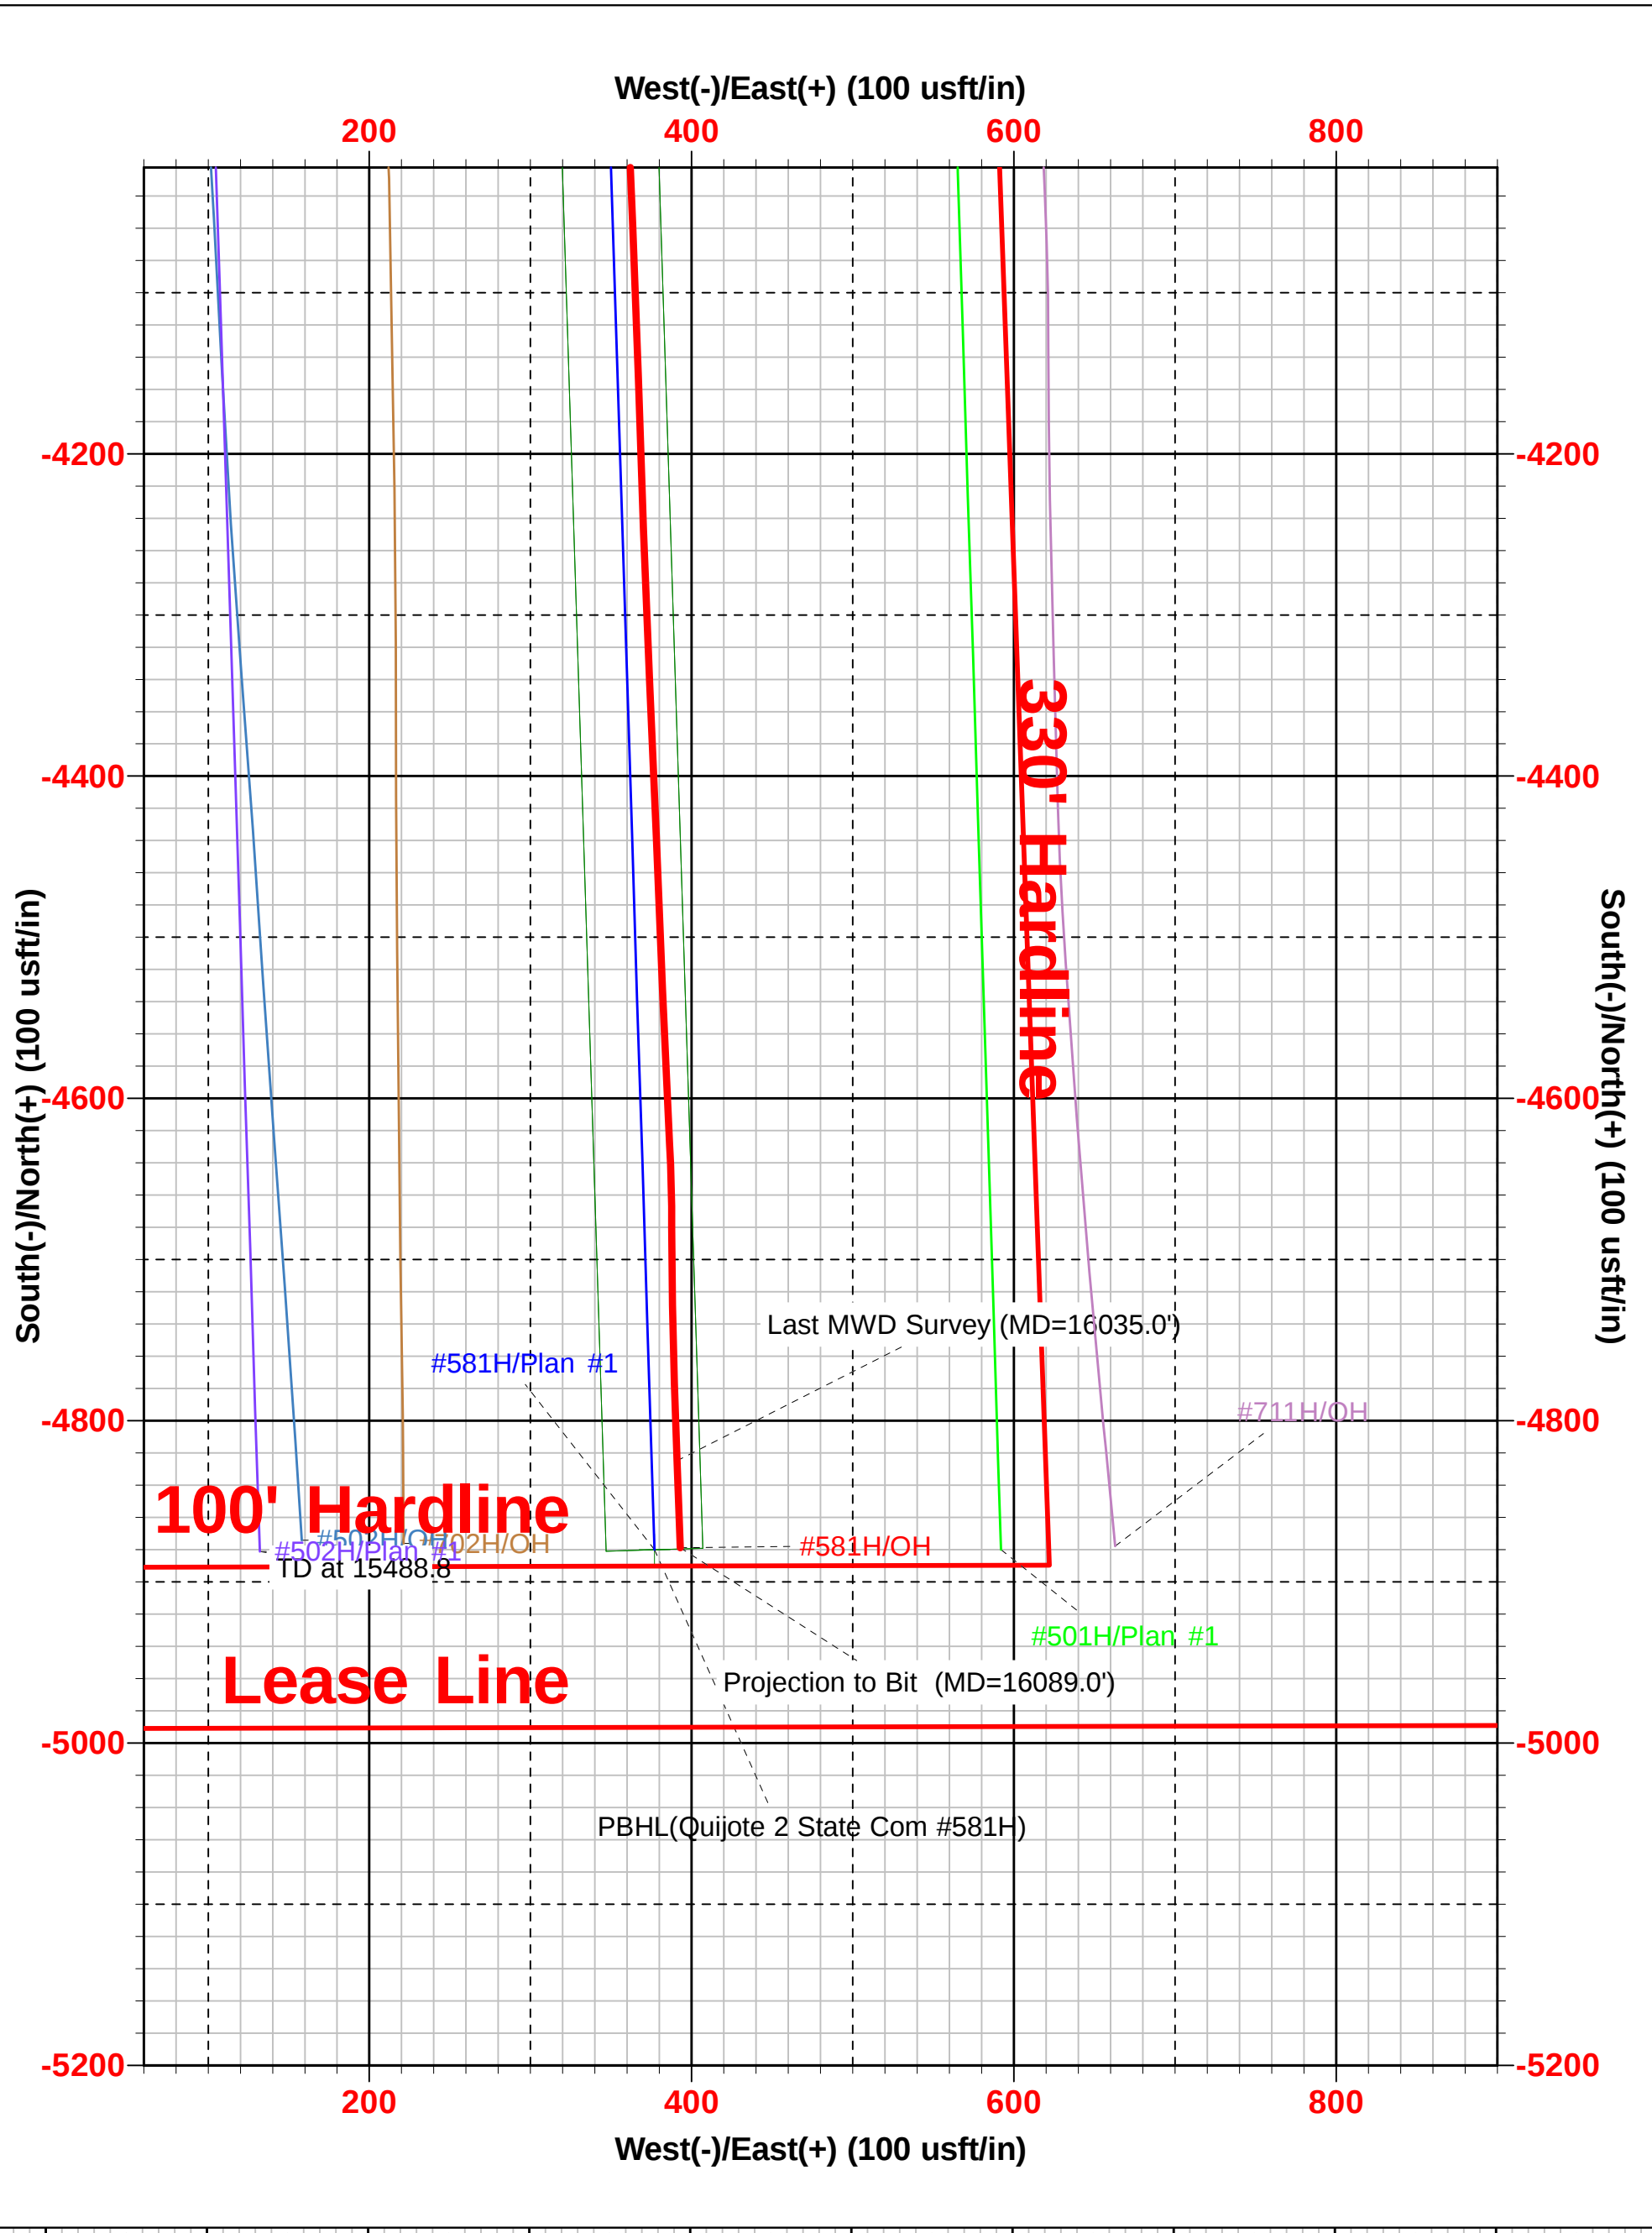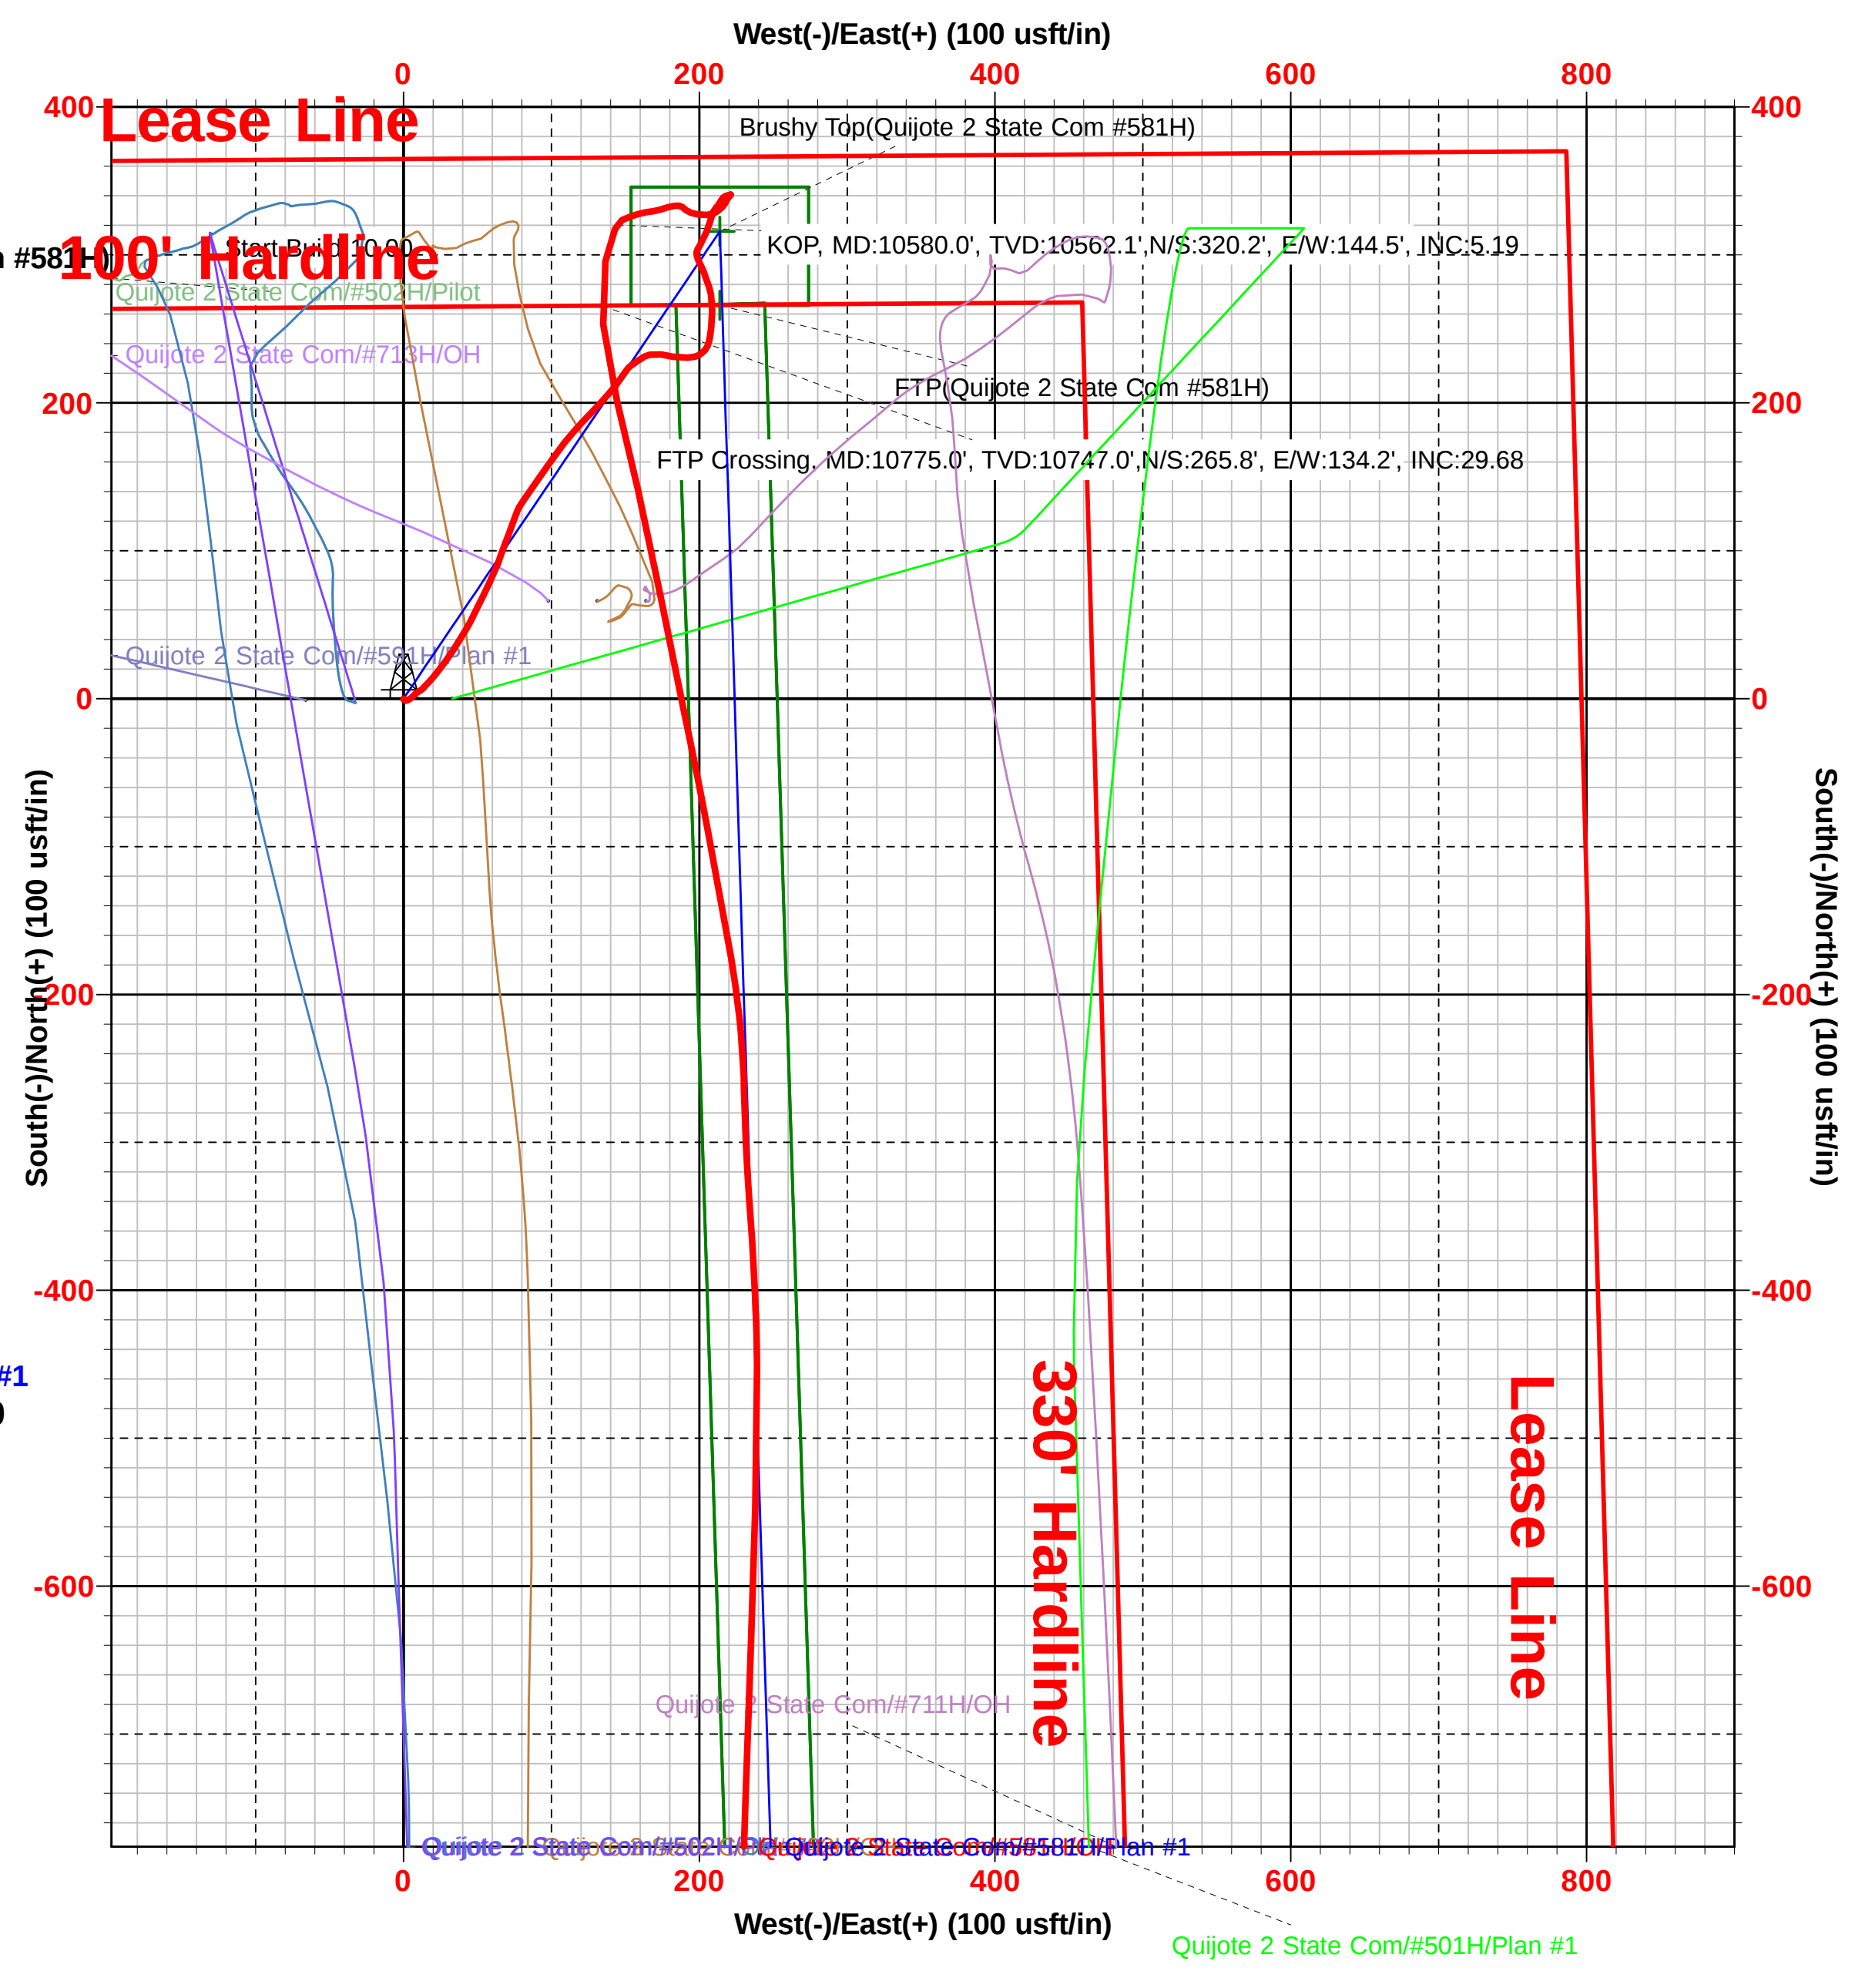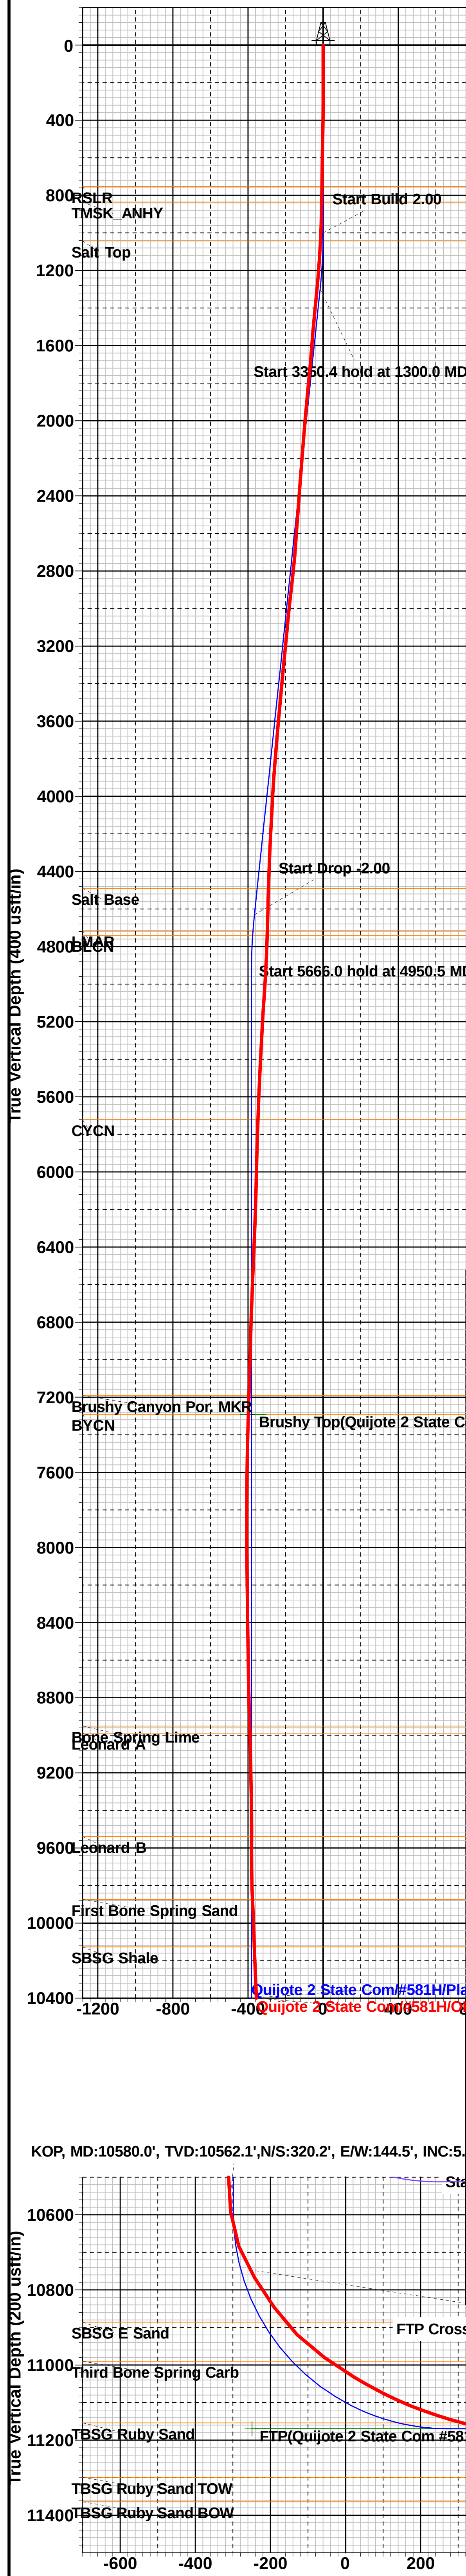

Intent ☐ As Drilled ☐

API #		
Operator Name:	Property Name:	Well Number

Kick Off Point (KOP)

UL	Section	Township	Range	Lot	Feet	From N/S	Feet	From E/W	County
Latitude					Longitude				NAD

First Take Point (FTP)

UL	Section	Township	Range	Lot	Feet	From N/S	Feet	From E/W	County
Latitude					Longitude				NAD

Last Take Point (LTP)

UL	Section	Township	Range	Lot	Feet	From N/S	Feet	From E/W	County
Latitude					Longitude				NAD

Is this well the defining well for the Horizontal Spacing Unit? ☐Is this well an infill well? ☐

If infill is yes please provide API if available, Operator Name and well number for Defining well for Horizontal Spacing Unit.

API #		
Operator Name:	Property Name:	Well Number

KZ 06/29/2018

Submit a Copy To Appropriate District Office
 District I – (575) 393-6161
 1625 N. French Dr., Hobbs, NM 88240
 District II – (575) 748-1283
 811 S. First St., Artesia, NM 88210
 District III – (505) 334-6178
 1000 Rio Brazos Rd., Aztec, NM 87410
 District IV – (505) 476-3460
 1220 S. St. Francis Dr., Santa Fe, NM 87505

State of New Mexico
 Energy, Minerals and Natural Resources

Form C-103
 Revised July 18, 2013

OIL CONSERVATION DIVISION
 1220 South St. Francis Dr.
 Santa Fe, NM 87505

SUNDRY NOTICES AND REPORTS ON WELLS (DO NOT USE THIS FORM FOR PROPOSALS TO DRILL OR TO DEEPEN OR PLUG BACK TO A DIFFERENT RESERVOIR. USE "APPLICATION FOR PERMIT" (FORM C-101) FOR SUCH PROPOSALS.)		WELL API NO. 30-025-49774
1. Type of Well: Oil Well ☐ Gas Well ☐ Other ☐		5. Indicate Type of Lease STATE ☒ FEE ☐
2. Name of Operator		6. State Oil & Gas Lease No. 325727
3. Address of Operator		7. Lease Name or Unit Agreement Name QUIJOTE 2 STATE COM
4. Well Location Unit Letter <u>A</u> : <u>365</u> feet from the <u>NORTH</u> line and <u>796</u> feet from the <u>EAST</u> line Section <u>2</u> Township <u>26S</u> Range <u>32E</u> NMPM <u>LEA</u> County		8. Well Number <u>581H</u>
11. Elevation (Show whether DR, RKB, RT, GR, etc.) 3340' GR		9. OGRID Number 7377
10. Pool name or Wildcat Jennings; Upper Bone Spring Shale-97838		

12. Check Appropriate Box to Indicate Nature of Notice, Report or Other Data

NOTICE OF INTENTION TO:	SUBSEQUENT REPORT OF:
PERFORM REMEDIAL WORK ☐	REMEDIAL WORK ☐
TEMPORARILY ABANDON ☐	ALTERING CASING ☐
PULL OR ALTER CASING ☐	COMMENCE DRILLING OPNS. ☐
DOWNHOLE COMMINGLE ☐	P AND A ☐
CLOSED-LOOP SYSTEM ☐	CASING/CEMENT JOB ☐
OTHER: ☐	OTHER: ☒

13. Describe proposed or completed operations. (Clearly state all pertinent details, and give pertinent dates, including estimated date of starting any proposed work). SEE RULE 19.15.7.14 NMAC. For Multiple Completions: Attach wellbore diagram of proposed completion or recompletion.

5/2/2022 RIG RELEASED
 5/17/2022 MIRU TEST VOID TO 5000 PSI, SEALS AND FLANGES TO 8500 PSI
 6/6/2022 BEGIN PERF AND FRAC
 6/12/2022 FINISH 25 STAGES PERF & FRAC, 11,200' - 16,064' W/ 3 1/8" 1050 SHOTS, FRAC 12,683,463 LBS PROPPANT + 218,119 BBLS LOAD FLUID
 6/16/2022 DRILLED OUT PLUGS AND CLEAN OUT WELLBORE
 7/6/2022 OPENED WELL TO FLOWBACK – DATE OF FIRST PRODUCTION

Spud Date:

2/23/2022

Rig Release Date:

5/2/2022

I hereby certify that the information above is true and complete to the best of my knowledge and belief.

SIGNATURE Kristina Agee TITLE REGULATORY SPECIALIST DATE 11/14/2023

Type or print name Kristina Agee E-mail address: kristina.agee@eogresources.com PHONE: 432-686-6996

For State Use Only

APPROVED BY: _____ TITLE _____ DATE _____

Conditions of Approval (if any):

Submit To Appropriate District Office Two Copies <u>District I</u> 1625 N. French Dr., Hobbs, NM 88240 <u>District II</u> 811 S. First St., Artesia, NM 88210 <u>District III</u> 1000 Rio Brazos Rd., Aztec, NM 87410 <u>District IV</u> 1220 S. St. Francis Dr., Santa Fe, NM 87505		State of New Mexico Energy, Minerals and Natural Resources Oil Conservation Division 1220 South St. Francis Dr. Santa Fe, NM 87505			Form C-105 Revised August 1, 2011					
WELL COMPLETION OR RECOMPLETION REPORT AND LOG										
4. Reason for filing: ☒ COMPLETION REPORT (Fill in boxes #1 through #31 for State and Fee wells only) ☐ C-144 CLOSURE ATTACHMENT (Fill in boxes #1 through #9, #15 Date Rig Released and #32 and/or #33; attach this and the plat to the C-144 closure report in accordance with 19.15.17.13.K NMAC)								5. Lease Name or Unit Agreement Name QUIJOTE 2 STATE COM		
								6. Well Number: 581H		
7. Type of Completion: ☒ NEW WELL ☐ WORKOVER ☐ DEEPENING ☐ PLUGBACK ☐ DIFFERENT RESERVOIR ☐ OTHER _____										
8. Name of Operator EOG RESOURCES INC							9. OGRID 7377			
10. Address of Operator PO BOX 2267 MIDLAND, TEXAS 79702							11. Pool name or Wildcat Jennings; Upper Bone Spring Shale			
12. Location	Unit Ltr	Section	Township	Range	Lot	Feet from the	N/S Line	Feet from the	E/W Line	County
Surface:	A	2	26S	32E		365'	NORTH	796'	EAST	LEA
BH:	P	2	26S	32E		111'	SOUTH	558'	EAST	LEA
13. Date Spudded 03/23/2022	14. Date T.D. Reached 04/30/2022		15. Date Rig Released 5/2/2022			16. Date Completed (Ready to Produce) 7/6/2022		17. Elevations (DF and RKB, RT, GR, etc.) 3340GL		
18. Total Measured Depth of Well MD 16,089' TVD 11,193'			19. Plug Back Measured Depth MD 16,064' TVD 11,193'			20. Was Directional Survey Made? YES		21. Type Electric and Other Logs Run None		
22. Producing Interval(s), of this completion - Top, Bottom, Name 3ND BONE SPRINGS 11,200'-16,064'										
23. CASING RECORD (Report all strings set in well)										
CASING SIZE		WEIGHT LB./FT.		DEPTH SET		HOLE SIZE		CEMENTING RECORD		AMOUNT PULLED
13 3/8"		54.5# J-55		920'		16"		950 CL C/CIRC		
9 5/8"		40# J55		4,653'		12 1/4"		1590 C/CIRC		
5 1/2"		20# HCP 110		16,074'		7 7/8"		1625 CL H/CIRC TOC @4828'		PRESSURE TEST ATTACHED
24. LINER RECORD						25. TUBING RECORD				
SIZE	TOP	BOTTOM	SACKS CEMENT	SCREEN		SIZE	DEPTH SET		PACKER SET	
26. Perforation record (interval, size, and number) 11,200'-16,064' 3 1/8", 1050 holes						27. ACID, SHOT, FRACTURE, CEMENT, SQUEEZE, ETC.				
						DEPTH INTERVAL		AMOUNT AND KIND MATERIAL USED		
						11,200'-16,064'		FRAC W/12,683,463 lbs proppant, 218,119 bbls load fld		
28. PRODUCTION										
Date First Production 7/6/2022		Production Method (Flowing, gas lift, pumping - Size and type pump) Flowing				Well Status (Prod. or Shut-in) Producing				
Date of Test 7/15/2022	Hours Tested 24	Choke Size 128	Prod'n For Test Period	Oil - Bbl 1285	Gas - MCF 2943	Water - Bbl. 1348	Gas - Oil Ratio 2290			
Flow Tubing Press.	Casing Pressure 332	Calculated 24-Hour Rate	Oil - Bbl.	Gas - MCF	Water - Bbl.	Oil Gravity - API - (Corr.) 46				
29. Disposition of Gas (Sold, used for fuel, vented, etc.) SOLD									30. Test Witnessed By	
31. List Attachments C-102, C-104, C-103, Directional Survey, H spacing,										
32. If a temporary pit was used at the well, attach a plat with the location of the temporary pit.										
33. If an on-site burial was used at the well, report the exact location of the on-site burial:										
Latitude _____ Longitude _____ NAD 1927 1983										
I hereby certify that the information shown on both sides of this form is true and complete to the best of my knowledge and belief										
Signature <i>Kristina Agee</i>			Printed Name Kristina Agee		Title REGULATORY SPECIALIST			Date 11/14/2023		
E-mail Address kristina_agee@eogresources.com										

This form is to be filed with the appropriate District Office of the Division not later than 20 days after the completion of any newly-drilled or deepened well and not later than 60 days after completion of closure. When submitted as a completion report, this shall be accompanied by one copy of all electrical and radio-activity logs run on the well and a summary of all special tests conducted, including drill stem tests. All depths reported shall be measured depths. In the case of directionally drilled wells, true vertical depths shall also be reported. For multiple completions, items 11, 12 and 26-31 shall be reported for each zone.

Southeastern New Mexico				Northwestern New Mexico			
T. Anhy	Rustler	753'	T. Canyon Brushy 7291'	T. Ojo Alamo	T. Penn A"		
T. Salt		1,043'	T. Strawn	T. Kirtland	T. Penn. "B"		
B. Salt		4,490'	T. Atoka	T. Fruitland	T. Penn. "C"		
T. Yates			T. Miss	T. Pictured Cliffs	T. Penn. "D"		
T. 7 Rivers			T. Devonian	T. Cliff House	T. Leadville		
T. Queen			T. Silurian	T. Menefee	T. Madison		
T. Grayburg			T. Montoya	T. Point Lookout	T. Elbert		
T. San Andres			T. Simpson	T. Mancos	T. McCracken		
T. Glorieta			T. McKee	T. Gallup	T. Ignacio Otzte		
T. Paddock			T. Ellenburger	Base Greenhorn	T. Granite		
T. Blinebry			T. Gr. Wash	T. Dakota			
T. Tubb			T. Delaware Sand	T. Morrison			
T. Drinkard			T. Bone Springs	T. Todilto			
T. Abo			T. 1st BS Sand 9,874'	T. Entrada			
T. Wolfcamp			T. 2nd BS Sand 11,154'	T. Wingate			
T. Penn			T.	T. Chinle			
T. Cisco (Bough C)			T.	T. Permian			

No. 1, from.....to.....

No. 2, from.....to.....

No. 3, from.....to.....

No. 4, from.....to.....

Include data on rate of water inflow and elevation to which water rose in hole.

No. 1, from.....to.....feet.....
 No. 2, from.....to.....feet.....
 No. 3, from.....to.....feet.....

From	To	Thickness In Feet	Lithology

District I
1625 N. French Dr., Hobbs, NM 88240
Phone:(575) 393-6161 Fax:(575) 393-0720
District II
811 S. First St., Artesia, NM 88210
Phone:(575) 748-1283 Fax:(575) 748-9720
District III
1000 Rio Brazos Rd., Aztec, NM 87410
Phone:(505) 334-6178 Fax:(505) 334-6170
District IV
1220 S. St Francis Dr., Santa Fe, NM 87505
Phone:(505) 476-3470 Fax:(505) 476-3462

State of New Mexico
Energy, Minerals and Natural Resources
Oil Conservation Division
1220 S. St Francis Dr.
Santa Fe, NM 87505

ACKNOWLEDGMENTS

Action 285452

ACKNOWLEDGMENTS

Operator: EOG RESOURCES INC P.O. Box 2267 Midland, TX 79702	OGRID: 7377
	Action Number: 285452
	Action Type: [C-104] Completion Packet (C-104C)

ACKNOWLEDGMENTS

☒	I hereby certify that the required Water Use Report has been, or will be, submitted for this wells completion.
☒	I hereby certify that the required FracFocus disclosure has been, or will be, submitted for this wells completion.

District I
1625 N. French Dr., Hobbs, NM 88240
Phone:(575) 393-6161 Fax:(575) 393-0720
District II
811 S. First St., Artesia, NM 88210
Phone:(575) 748-1283 Fax:(575) 748-9720
District III
1000 Rio Brazos Rd., Aztec, NM 87410
Phone:(505) 334-6178 Fax:(505) 334-6170
District IV
1220 S. St Francis Dr., Santa Fe, NM 87505
Phone:(505) 476-3470 Fax:(505) 476-3462

State of New Mexico
Energy, Minerals and Natural Resources
Oil Conservation Division
1220 S. St Francis Dr.
Santa Fe, NM 87505

CONDITIONS

Action 285452

CONDITIONS

Operator: EOG RESOURCES INC P.O. Box 2267 Midland, TX 79702	OGRID: 7377
	Action Number: 285452
	Action Type: [C-104] Completion Packet (C-104C)

CONDITIONS

Created By	Condition	Condition Date
plmartinez	None	11/14/2023