

Santa Fe Main Office Phone: (505) 476-3441 General Information Phone: (505) 629-6116 Online Phone Directory Visit: https://www.emnrd.nm.gov/ocd/contact-us/	State of New Mexico Energy, Minerals & Natural Resources Department OIL CONSERVATION DIVISION	C-104 Revised July 9, 2024 Submit Electronically Via OCD Permitting
---	--	---

REQUEST FOR ALLOWABLE AND AUTHORIZATION TO TRANSPORT

Section 1 - Operator and Well Information

Submittal Type: ☐ Test Allowable (C-104RT) ☒ New Well (C-104NW) ☐ Recomplete (C-104RC) ☐ Pay Add (C-104RC) ☐ Amended	
Operator Name: Tap Rock Operating, LLC	OGRID: 372043
Property Name and Well Number: High Life Fed Com 202H	Property Code: 335064
Mineral Owner: ☐ State ☐ Fee ☐ Tribal ☒ Federal	API Number: 30-0 15-54526
Pool Name: Purple Sage; Wolfcamp (Gas)	Pool Code: 98220

Section 2 – Surface Location

UL	Section	Township	Range	Lot	Ft. from N/S	Ft. from E/W	Latitude	Longitude	County
H	10	25-S	25-E	-	1829' FNL	355' FEL	32.1465816	-104.3763823	EDDY

Section 3 – Completion Information

Producing Method	Ready Date	Perforations MD	Perforations TVD
Flowing	4/11/2025	8,343' - 23,470'	8,166' - 8,570'

Section 4 – Action IDs for Submissions and Order Numbers

List Action IDs for Drilling Sundries	Was an Order required / needed (Y/N), if yes list Order number:
C-104 RT Action ID (if C-104NW): 458017	Communitization Agreement ☐ Yes ☒ No, Order No.
Surface Casing Action ID: 414672	Unit: ☐ Yes ☒ No, Order No.
Intermediate 1 Casing Action ID: 418806	Compulsory Pooling: ☒ Yes ☐ No, Order No. R-23396
Intermediate 2 Casing Action ID: N/A	Down Hole Commingling: ☐ Yes ☒ No, Order No.
Production Casing Action ID: 418808	Surface Commingling: ☐ Yes ☒ No, Order No.
All casing was pressure tested in accordance with NMAC ☒ Yes ☐ No	Non-standard Location: ☐ Yes ☒ No ☐ Common ownership Order No.
Liner 1 Action ID: N/A	Non-standard Proration: ☐ Yes ☒ No, Order No.
Casing was installed prior to OCD's Action ID system (Y/N): N	Simultaneous Dedication: ☐ Yes ☒ No, Order No.

Section 5 - Operator Signature and Certification

☒ I hereby certify that the required Water Use Report has been, or will be, submitted for this well's completion.	
☒ I hereby certify that the required Fracfocus disclosure has been, or will be, submitted for this well's completion.	
☒ I hereby certify that the rules of the Oil Conservation Division have been complied with and that the information given above is true and complete to the best of my knowledge and belief.	
Name Bill Ramsey	
Title Sr. Environmental and Regulatory Specialist	Date 10/23/2025

C-102 Submit Electronically Via OCD Permitting	State of New Mexico Energy, Minerals & Natural Resources Department OIL CONSERVATION DIVISION	Revised July 9, 2024	
		Submittal Type:	☐ Initial Submittal
			☐ Amended Report
		☒ As Drilled	

WELL LOCATION AND ACREAGE DEDICATION PLAT

API Number 30-015-54526	Pool Code 98220	Pool Name Purple Sage; Wolfcamp (Gas)
Property Code 335064	Property Name HIGH LIFE FED COM	Well Number 202H
OGRID No. 372043	Operator Name TAP ROCK OPERATING, LLC.	Ground Level Elevation 3511'
Surface Owner: ☐ State ☒ Fee ☐ Tribal ☐ Federal		Mineral Owner: ☐ State ☐ Fee ☐ Tribal ☒ Federal

Surface Location

UL or lot no.	Section	Township	Range	Lot Idn	Feet from the N/S	Feet from the E/W	Latitude	Longitude	County
H	10	25-S	25-E	-	1829' N	355' E	N 32.1465816	W 104.3763823	EDDY

Bottom Hole Location

UL or lot no.	Section	Township	Range	Lot Idn	Feet from the N/S	Feet from the E/W	Latitude	Longitude	County
H	7	25-S	26-E	-	1608' N	237' E	N 32.1467795	W 104.3248459	EDDY

Dedicated Acres	Infill or Defining Well	Defining Well API	Overlapping Spacing Unit (Y/N)	Consolidated Code
1919.96	Infill	30-015-54531	N	C
Order Numbers			Well Setbacks are under Common Ownership: ☒ Yes ☐ No	

Kick Off Point (KOP)

UL or lot no.	Section	Township	Range	Lot Idn	Feet from the N/S	Feet from the E/W	Latitude	Longitude	County
-	-	-	-	-	- -	- -	-	-	-


First Take Point (FTP)

UL or lot no.	Section	Township	Range	Lot Idn	Feet from the N/S	Feet from the E/W	Latitude	Longitude	County
E	11	25-S	26-E	-	1622' N	330' W	N 32.1471354	W 104.3741752	EDDY

Last Take Point (LTP)

UL or lot no.	Section	Township	Range	Lot Idn	Feet from the N/S	Feet from the E/W	Latitude	Longitude	County
H	7	25-S	26-E	-	1606' N	330' E	N 32.1467982	W 104.3251465	EDDY

Unitized Area or Area of Uniform Interest	Spacing Unity Type ☒ Horizontal ☐ Vertical	Ground Floor Elevation -
---	--	-----------------------------

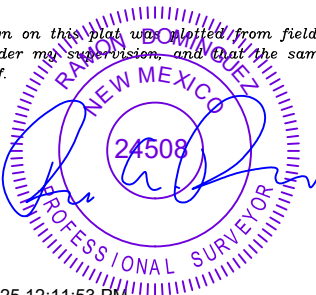OPERATOR CERTIFICATION I hereby certify that the information contained herein is true and complete to the best of my knowledge and belief; and, if the well is a vertical or directional well, that this organization either owns a working interest or unleased mineral interest in the land including the proposed bottom hole location or has a right to drill this well at this location pursuant to a contract with an owner of a working interest or unleased mineral interest, or to a voluntary pooling agreement or a compulsory pooling order heretofore entered by the division. If this well is a horizontal well, I further certify that this organization has received the consent of at least one lessee or owner of a working interest or unleased mineral interest in each tract (in the target pool or formation) in which any part of the well's completed interval will be located or obtained a compulsory pooling order from the division. <i>William Ramsey</i> 5/2/2025		SURVEYORS CERTIFICATION I hereby certify that the well location shown on this plat was plotted from field notes of actual surveys made by me or under my supervision, and that the same is true and correct to the best of my belief.  4/30/2025 12:11:53 PM	
Signature _____ Date _____ Bill Ramsey		Signature and Seal of Professional Surveyor _____ Date _____	
Print Name _____ bramsey@taprk.com E-mail Address _____		Certificate Number _____ Date of Survey _____ 11/18/2024	

C-102

Submit Electronically
Via OCD PermittingState of New Mexico
Energy, Minerals & Natural Resources Department
OIL CONSERVATION DIVISION

Revised July 9, 2024

Submittal
Type:

- ☐ Initial Submittal
- ☐ Amended Report
- ☐ As Drilled

Property Name and Well Number

HIGH LIFE FED COM 202H

SURFACE LOCATION (SHL)

NEW MEXICO EAST
NAD 1983
X=528014 Y=417065
LAT.: N 32.1465816
LONG.: W 104.3763823
NAD 1927
X=486832 Y=417008
LAT.: N 32.1464643
LONG.: W 104.3758804
1829' FNL 355' FEL

FIRST TAKE POINT (FTP)


NEW MEXICO EAST
NAD 1983
X=528697 Y=417266
LAT.: N 32.1471354
LONG.: W 104.3741752
NAD 1927
X=487515 Y=417209
LAT.: N 32.1470181
LONG.: W 104.3736734
1622' FNL 330' FWL
MD=8333' TVD=8159'

BLM PERF. POINT (BPP1)

NEW MEXICO EAST
NAD 1983
X=532363 Y=417344
LAT.: N 32.1473552
LONG.: W 104.3623304
NAD 1927
X=491181 Y=417288
LAT.: N 32.1472377
LONG.: W 104.3618290
1528' FNL 1331' FEL
MD=12008' TVD=8270'


BLM PERF. POINT (BPP2)

NEW MEXICO EAST
NAD 1983
X=533694 Y=417365
LAT.: N 32.1474129
LONG.: W 104.3580302
NAD 1927
X=492512 Y=417308
LAT.: N 32.1472952
LONG.: W 104.3575289
1517' FNL 0' FEL
MD=13340' TVD=8305'

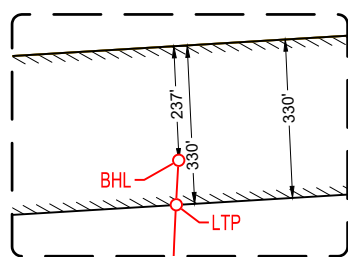

DETAIL VIEW

SCALE: 1" = 400'

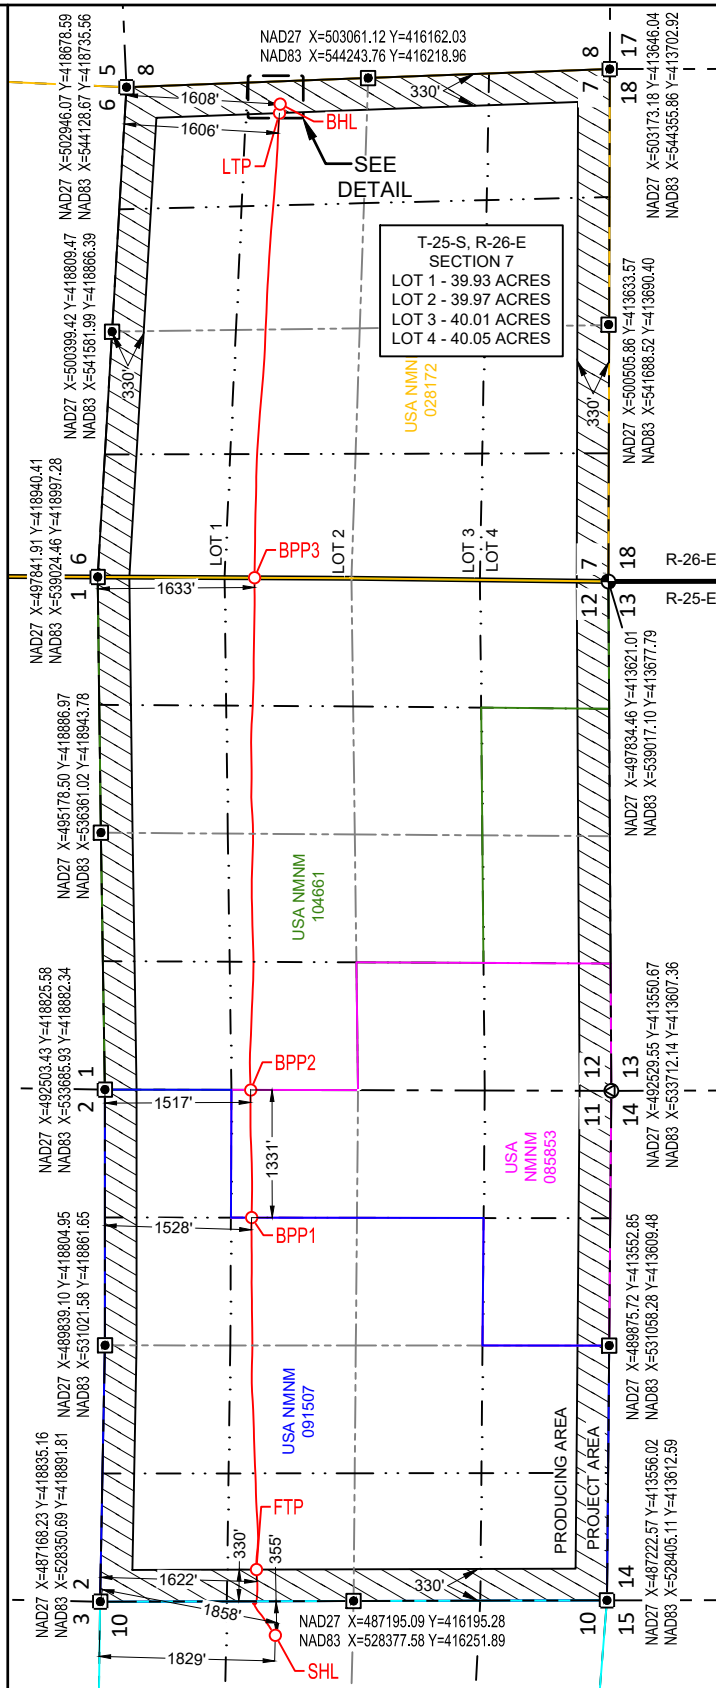

BLM PERF. POINT (BPP3)


NEW MEXICO EAST
NAD 1983
X=539029 Y=417364
LAT.: N 32.1474122
LONG.: W 104.3407937
NAD 1927
X=497846 Y=417307
LAT.: N 32.1472941
LONG.: W 104.3402930
1633' FNL 0' FEL
MD=18683' TVD=8448'

LAST TAKE POINT (LTP)

NEW MEXICO EAST
NAD 1983
X=543871 Y=417141
LAT.: N 32.1467982
LONG.: W 104.3251465
NAD 1927
X=502689 Y=417084
LAT.: N 32.1466799
LONG.: W 104.3246463
1606' FNL 330' FEL
MD=23535' TVD=8571'

BOTTOM HOLE LOCATION (BHL)

NEW MEXICO EAST
NAD 1983
X=543964 Y=417134
LAT.: N 32.1467795
LONG.: W 104.3248459
NAD 1927
X=502782 Y=417077
LAT.: N 32.1466611
LONG.: W 104.3243457
1608' FNL 237' FEL
MD=23630' TVD=8570'

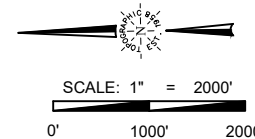


SURVEYORS CERTIFICATION

I hereby certify that the well location shown on this plat was plotted from field notes of actual surveys made by me or under my supervision, and that the same is true and correct to the best of my belief.
11/18/2024


Date of Survey

Signature and Seal of Professional Surveyor:

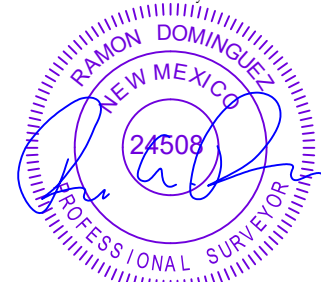

4/30/2025 12:11:54 PM

SECTION 10, TOWNSHIP 25-S, RANGE 25-E, N.M.P.M.
EDDY COUNTY, NEW MEXICO

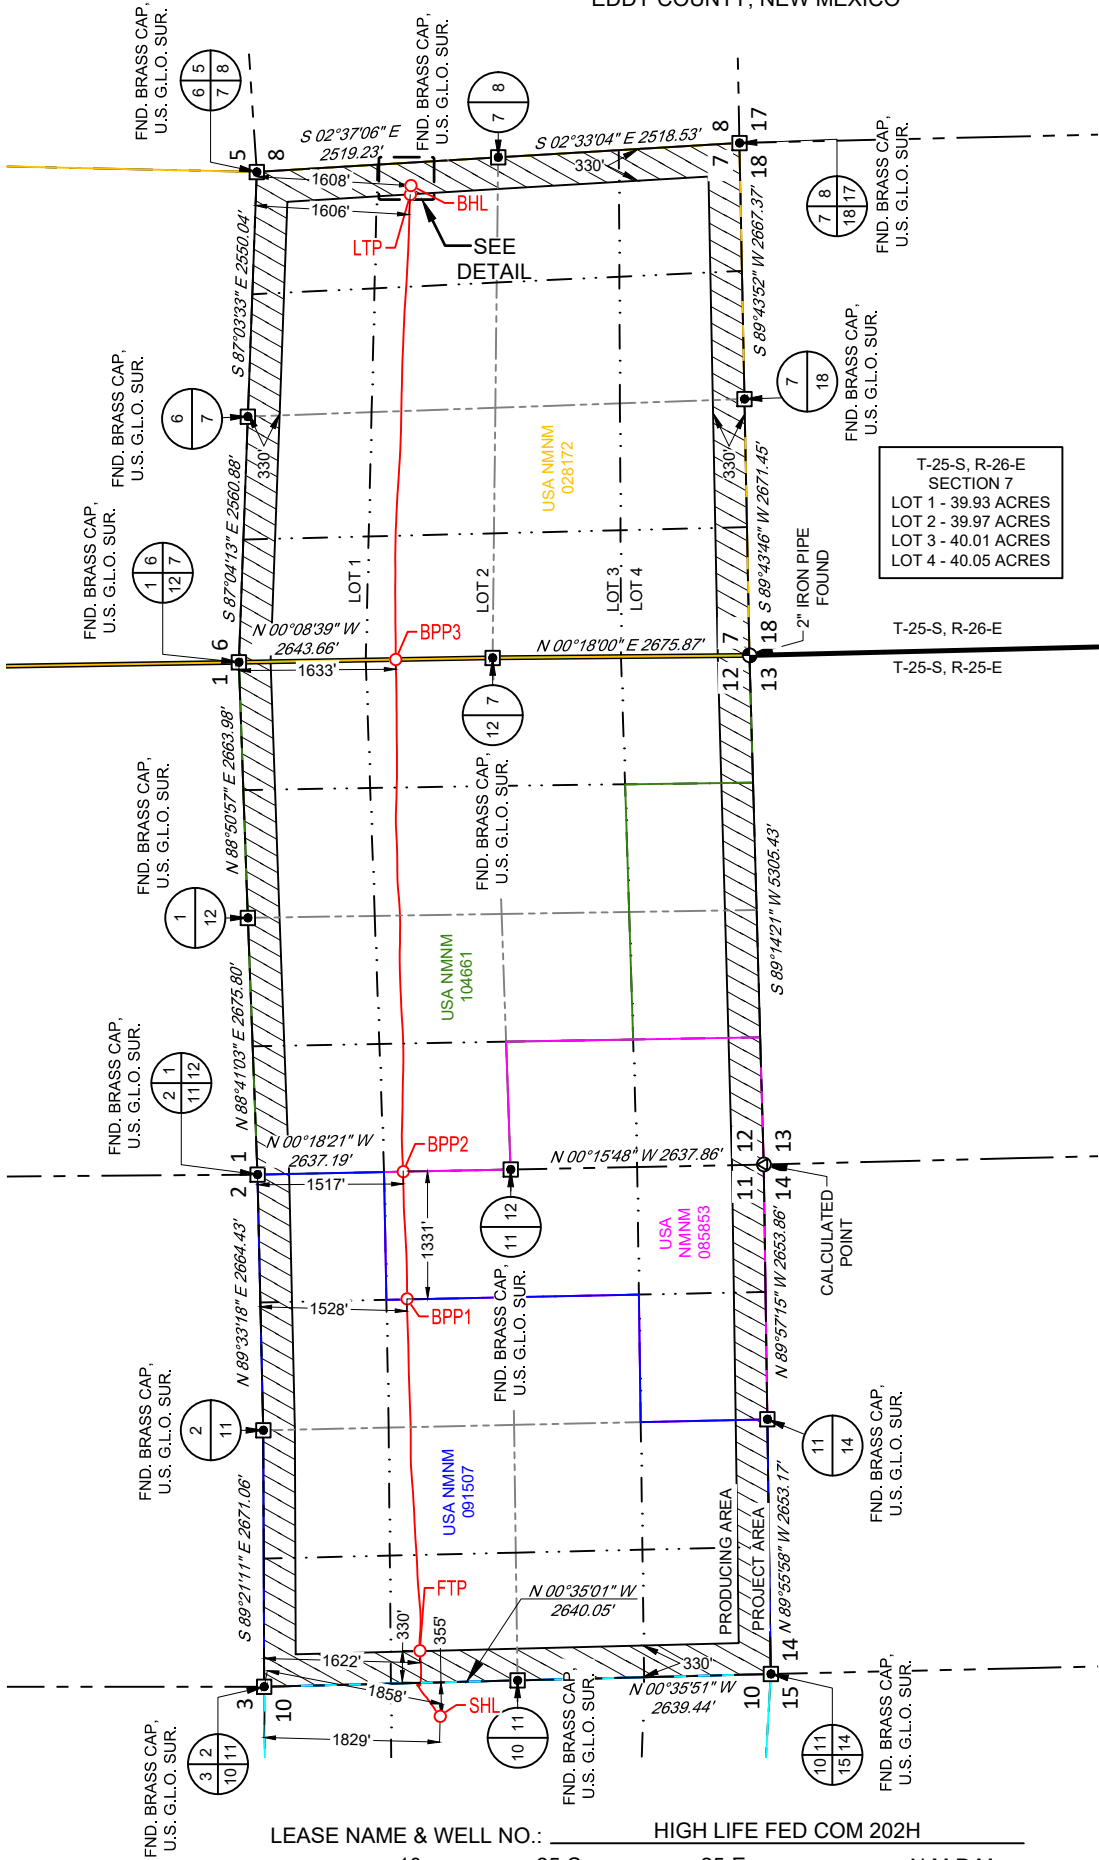

SURFACE LOCATION (SHL)

NEW MEXICO EAST
NAD 1983
X=528014 Y=417065
LAT.: N 32.1465816
LONG.: W 104.3763823
1829' FNL 355' FEL

FIRST TAKE POINT (FTP)

NEW MEXICO EAST
NAD 1983
X=528697 Y=417266
LAT.: N 32.1471354
LONG.: W 104.3741752
1622' FNL 330' FWL
MD=8333' TVD=8159'

BLM PERF. POINT (BPP1)

NEW MEXICO EAST
NAD 1983
X=532363 Y=417344
LAT.: N 32.1473552
LONG.: W 104.3623304
1528' FNL 1331' FEL
MD=12008' TVD=8270'

BLM PERF. POINT (BPP2)

NEW MEXICO EAST
NAD 1983
X=533694 Y=417365
LAT.: N 32.1474129
LONG.: W 104.3580302
1517' FNL 0' FEL
MD=13340' TVD=8305'

BLM PERF. POINT (BPP3)


NEW MEXICO EAST
NAD 1983
X=539029 Y=417364
LAT.: N 32.1474122
LONG.: W 104.3407937
1633' FNL 0' FEL
MD=18683' TVD=8448'

LAST TAKE POINT (LTP)

NEW MEXICO EAST
NAD 1983
X=543871 Y=417141
LAT.: N 32.1467982
LONG.: W 104.3251465
1606' FNL 330' FEL
MD=23535' TVD=8571'


BOTTOM HOLE LOCATION (BHL)

NEW MEXICO EAST
NAD 1983
X=543964 Y=417134
LAT.: N 32.1467795
LONG.: W 104.3248459
1608' FNL 237' FEL
MD=23630' TVD=8570'

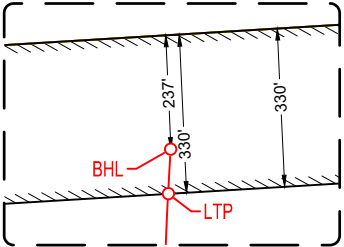


DETAIL VIEW
SCALE: 1" = 400'

LEASE NAME & WELL NO.: HIGH LIFE FED COM 202H
SECTION 10 TWP 25-S RGE 25-E SURVEY N.M.P.M.
COUNTY EDDY STATE NM ELEVATION 3511'
DESCRIPTION 1829' FNL & 355' FEL

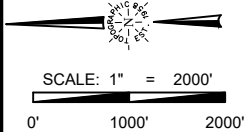

481 WINSOTT ROAD, Ste. 200 • BENBROOK, TEXAS 76126
TELEPHONE: (817) 744-7512 • FAX (817) 744-7554
2903 NORTH BIG SPRING • MIDLAND, TEXAS 79705
TELEPHONE: (432) 682-1653 OR (800) 767-1653 • FAX (432) 682-1743
WWW.TOPOGRAPHIC.COM

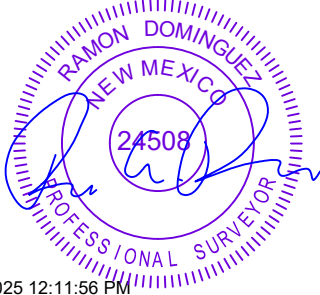

4/30/2025 12:11:56 PM

Ramon A. Dominguez , P.S. No. 24508

HIGH LIFE FED COM 202H AS-DRILLED	REVISION:	
DATE:	04/23/25	
FILE:	AD_HIGH_LIFE_FED_COM_202H	
DRAWN BY:	AMD	
SHEET :	3 OF 3	

- NOTES:
1. ORIGINAL DOCUMENT SIZE: 8.5" X 14"
 2. ALL BEARINGS, DISTANCES, AND COORDINATE VALUES CONTAINED HEREIN ARE GRID BASED UPON THE NEW MEXICO COORDINATE SYSTEM OF 1983, EAST ZONE, U.S. SURVEY FEET.
 3. THIS WELL LOCATION SHOWN HEREON HAS BEEN SURVEYED ON THE GROUND UNDER MY SUPERVISION AND PREPARED ACCORDING TO THE EVIDENCE FOUND AT THE TIME OF SURVEY, AND DATA PROVIDED BY TAP ROCK OPERATING, LLC. THIS CERTIFICATION IS MADE AND LIMITED TO THOSE PERSONS OR ENTITIES SHOWN ON THE FACE OF THIS PLAT AND IS NON-TRANSFERABLE. THIS SURVEY IS CERTIFIED FOR THIS TRANSACTION ONLY.



3335 Pollok Drive
Conroe, Texas 77303
936.442.2500 (office)
www.msdir.com

MS Directional LLC Survey Data Certification

MS Directional LLC Job Number: MSMO-129503
Survey Type: MWD
Operating Company: Tap Rock Operating
Well Name and Number: High Life Fed Com 202H
Drainhole Number: Original Wellbore
Location: Eddy, New Mexico
API Number: 30-015-54526
Tie In Depth: 0.00
Surveyed Depths: 153.00' - 23552.00'
Projected TD Survey: 23630.00'
Dates Performed: 11/30/2024 - 12/21/2024

To the best of my knowledge, I certify the following:

1. The data is true, correct and complete and within the limitations of the tool set forth by MS Directional LLC or if applicable, contain corrected surveys by a third party named Superior QC LLC;
2. I am authorized and qualified to make this report; and
3. I have reviewed this report and find it conforms to the principles and procedures as set forth by MS Directional LLC

MWD Surveyor Name: Mark Gibson

MWD Operations Manager: Charles Davis

Signature:

A handwritten signature in black ink, appearing to read "CWD" followed by a stylized flourish.

Date: 01/14/2025

Email: charles.davis@msdir.com



**Tap Rock Operating
Eddy County, New Mexico (NAD 83)
30-015-54526
High Life Fed Com 202H
Wellbore 1**

**MS MWD + FDIR
Certified Survey Report
14 January 2025**

Field	Eddy County, New Mexico (NAD 83) - Tap Rock Operating		
CRS	US-SPC83 / New Mexico Eastern Zone	North Reference	GRID
Apply Scale Factor	NO	Scale Factor	1.000
System Datum	Mean Sea Level	Depth Datum->MSL	3537.00Usft

Well	High Life Fed Com 202H		
Local North	-0.000Usft	Local East	0.000Usft
Map Northing	417064.550Usft	Map Easting	528014.110Usft
Latitude	32° 8' 47.694" N	Longitude	104° 22' 34.976" W
Depth Datum / Rig	Well-H&P 466 / H&P 466	Datum Elevation	3537.00Usft
GL Elevation	3511.00Usft	Grid Convergence	-0.023

Wellbore	High Life Fed Com 202H - Wellbore 1		
Magnetic Model	User defined	Date	09/12/2024
Total Field (nT)	47168.40	Dip Angle (deg)	59.612
Declination	6.812		
VS Origin	Well	VS Azimuth	90.58
VS Origin NS	0.00Usft	VS Origin EW	0.00Usft

Survey Program	High Life Fed Com 202H - Wellbore 1		
Depth From Usft	Depth To Usft	Survey	Survey Tool
0.00	23630.00	MS MWD + FDIR	MWD+IFR1+SAG+FDIR

MD	INC	AZI	TVD	NS	EW	VS	DLS	BR	TR
Usft	deg	deg	Usft	Usft	Usft	Usft	deg/100Usft	deg/100Usft	deg/100Usft
0.00	0.00	0.00	0.00	0.00	0.00	0.00	0.00	0.00	0.00
153.00	0.42	70.74	153.00	0.18	0.53	0.27	0.27	0.27	0.00
211.00	1.05	46.46	210.99	0.62	1.12	1.11	1.19	1.09	-41.86
309.00	1.54	72.82	308.97	1.63	3.02	3.01	0.77	0.50	26.90
403.00	3.40	86.38	402.88	2.18	7.01	6.99	2.06	1.98	14.43
498.00	5.02	89.35	497.62	2.40	13.98	13.96	1.72	1.71	3.13
593.00	3.94	83.88	592.33	2.80	21.38	21.35	1.22	-1.14	-5.76
679.00	1.66	39.79	678.23	4.07	25.12	25.08	3.47	-2.65	-51.27
774.00	3.45	292.00	773.17	6.20	23.35	23.28	4.49	1.88	-113.46
869.00	4.10	298.47	867.96	8.89	17.71	17.62	0.82	0.68	6.81
963.00	1.91	283.48	961.83	10.86	13.23	13.12	2.46	-2.33	-15.95
1058.00	1.40	212.85	1056.79	10.25	11.07	10.96	2.06	-0.54	-74.35
1153.00	2.00	191.14	1151.75	7.65	10.12	10.04	0.92	0.63	-22.85
1248.00	1.98	191.63	1246.70	4.42	9.46	9.42	0.03	-0.02	0.52
1343.00	0.75	112.67	1341.67	2.57	9.71	9.68	2.08	-1.29	-83.12
1439.00	0.92	87.25	1437.66	2.36	11.06	11.03	0.42	0.18	-26.48
1524.00	0.68	85.72	1522.65	2.43	12.24	12.22	0.28	-0.28	-1.80
1663.00	2.20	41.51	1661.61	4.49	14.83	14.79	1.28	1.09	-31.81
1759.00	2.83	24.65	1757.52	8.03	17.04	16.96	1.01	0.66	-17.56
1854.00	3.68	36.26	1852.36	12.62	19.82	19.69	1.13	0.89	12.22
1950.00	4.72	51.10	1948.11	17.58	24.72	24.54	1.56	1.08	15.46
2045.00	5.93	56.07	2042.70	22.78	31.83	31.60	1.36	1.27	5.23
2141.00	5.59	51.81	2138.21	28.43	39.62	39.33	0.57	-0.35	-4.44
2236.00	6.74	53.78	2232.66	34.59	47.76	47.40	1.23	1.21	2.07
2332.00	7.45	55.83	2327.93	41.41	57.45	57.03	0.79	0.74	2.14
2427.00	8.89	58.17	2421.96	48.74	68.78	68.29	1.56	1.52	2.46
2522.00	9.17	58.15	2515.78	56.61	81.45	80.87	0.29	0.29	-0.02
2618.00	8.75	56.43	2610.61	64.68	94.03	93.37	0.52	-0.44	-1.79
2713.00	7.31	53.78	2704.68	72.25	104.93	104.19	1.56	-1.52	-2.79
2808.00	8.56	55.29	2798.77	79.85	115.62	114.80	1.33	1.32	1.59
2903.00	7.13	53.29	2892.87	87.40	126.16	125.27	1.53	-1.51	-2.11
2999.00	8.34	56.55	2988.00	94.80	136.74	135.78	1.34	1.26	3.40
3094.00	9.93	56.47	3081.79	103.12	149.32	148.27	1.67	1.67	-0.08
3190.00	9.14	54.64	3176.46	112.11	162.44	161.30	0.88	-0.82	-1.91
3285.00	7.98	55.83	3270.41	120.18	172.82	171.05	1.24	-1.22	1.25
3381.00	7.94	55.25	3365.48	127.70	185.01	183.71	0.09	-0.04	-0.60
3477.00	7.85	57.90	3460.57	134.96	196.01	194.64	0.39	-0.09	2.76
3572.00	7.66	50.00	3554.70	142.48	206.36	204.91	1.14	-0.20	-8.32
3668.00	9.29	46.57	3649.65	151.92	216.89	215.34	1.78	1.70	-3.57
3763.00	8.60	48.96	3743.50	161.86	227.81	226.16	0.82	-0.73	2.52
3858.00	6.87	50.55	3837.63	170.13	237.56	235.82	1.83	-1.82	1.67
3954.00	7.07	49.50	3932.92	177.62	246.49	244.67	0.25	0.21	-1.09
4049.00	9.30	56.11	4026.95	185.69	257.30	255.41	2.54	2.35	6.96
4145.00	9.03	58.65	4121.72	193.94	270.18	268.20	0.51	-0.28	2.65
4240.00	7.54	59.89	4215.73	200.94	281.94	279.89	1.58	-1.57	1.31
4335.00	6.03	60.07	4310.06	206.56	291.65	289.55	1.59	-1.59	0.19

Certified Survey Report



MD	INC	AZI	TVD	NS	EW	VS	DLS	BR	TR
Usft	deg	deg	Usft	Usft	Usft	Usft	deg/100Usft	deg/100Usft	deg/100Usft
4431.00	5.88	60.90	4405.54	211.47	300.32	298.16	0.18	-0.16	0.86
4526.00	4.92	61.43	4500.12	215.78	308.15	305.95	1.01	-1.01	0.56
4621.00	4.18	65.05	4594.82	219.19	314.87	312.63	0.84	-0.78	3.81
4717.00	3.83	63.50	4690.59	222.10	320.91	318.64	0.38	-0.36	-1.61
4812.00	2.99	62.05	4785.42	224.68	325.94	323.65	0.89	-0.88	-1.53
4908.00	2.54	57.34	4881.31	227.00	329.94	327.62	0.52	-0.47	-4.91
5003.00	1.24	42.58	4976.25	228.89	332.41	330.07	1.45	-1.37	-15.54
5099.00	0.70	34.97	5072.24	230.14	333.45	331.10	0.58	-0.56	-7.93
5194.00	0.85	198.24	5167.24	229.94	333.56	331.21	1.61	0.16	171.86
5290.00	2.19	215.19	5263.20	227.77	332.28	329.96	1.46	1.40	17.66
5385.00	2.78	158.01	5358.12	224.15	332.09	329.81	2.56	0.62	-60.19
5481.00	0.99	133.04	5454.07	221.42	333.57	331.31	2.01	-1.86	-26.01
5576.00	1.84	348.26	5549.05	222.35	333.86	331.59	2.85	0.89	-152.40
5672.00	1.19	312.13	5645.02	224.53	332.81	330.52	1.17	-0.68	-37.64
5767.00	0.80	310.88	5740.01	225.63	331.58	329.28	0.41	-0.41	-1.32
5862.00	0.80	267.83	5835.00	226.04	330.41	328.11	0.62	0.00	-45.32
5957.00	1.09	291.03	5929.99	226.34	328.91	326.60	0.50	0.31	24.42
6053.00	1.05	14.35	6025.98	227.52	328.27	325.95	1.48	-0.04	86.79
6148.00	1.05	322.57	6120.96	229.05	327.96	325.62	0.97	0.00	-54.51
6244.00	1.40	301.41	6216.94	230.36	326.42	324.07	0.59	0.36	-22.04
6339.00	1.14	208.27	6311.92	230.13	324.98	322.64	1.95	-0.27	-98.04
6435.00	1.14	220.51	6407.91	228.57	323.91	321.58	0.25	0.00	12.75
6530.00	1.65	202.44	6502.88	226.58	322.78	320.47	0.70	0.54	-19.02
6625.00	0.84	137.52	6597.86	224.81	322.72	320.43	1.58	-0.85	-68.34
6721.00	2.34	178.90	6693.82	222.33	323.24	320.97	1.87	1.56	43.10
6817.00	1.60	163.80	6789.76	219.08	323.65	321.41	0.94	-0.77	-15.73
6912.00	0.75	167.73	6884.74	217.20	324.15	321.94	0.90	-0.89	4.14
7007.00	1.94	178.99	6979.72	214.98	324.31	322.12	1.28	1.25	11.85
7103.00	1.79	159.30	7075.67	211.96	324.87	322.71	0.68	-0.16	-20.51
7198.00	2.15	57.09	7170.63	211.54	326.89	324.73	3.24	0.38	-107.59
7293.00	0.79	50.64	7265.60	212.92	328.89	326.72	1.44	-1.43	-6.79
7388.00	0.65	178.77	7360.59	212.80	329.41	327.24	1.36	-0.15	134.87
7484.00	2.09	192.30	7456.56	210.54	329.05	326.90	1.53	1.50	14.09
7579.00	2.45	189.82	7551.49	206.85	328.34	326.22	0.39	0.38	-2.61
7617.00	2.40	183.63	7589.46	205.25	328.15	326.05	0.70	-0.13	-16.29
7686.00	3.25	138.85	7658.38	202.34	329.34	327.28	3.32	1.23	-64.90
7782.00	11.12	97.55	7753.59	199.07	340.33	338.30	9.31	8.20	-43.02
7877.00	25.05	94.13	7843.68	196.40	369.62	367.61	14.70	14.66	-3.60
7973.00	29.69	94.89	7928.91	192.91	413.60	411.63	4.85	4.83	0.79
8068.00	40.31	91.78	8006.63	189.94	467.92	465.97	11.33	11.18	-3.27
8163.00	51.74	88.16	8072.49	190.18	536.15	534.19	12.34	12.03	-3.81
8259.00	60.32	84.23	8126.10	195.60	615.48	613.47	9.56	8.94	-4.09
8355.00	70.44	86.70	8166.04	202.41	702.36	700.28	10.80	10.54	2.57
8417.00	78.49	91.67	8182.64	203.21	762.02	759.93	15.10	12.98	8.02
8475.00	86.69	95.42	8190.12	199.64	819.37	817.30	15.52	14.14	6.47
8570.00	88.44	95.20	8194.16	190.86	913.87	911.89	1.86	1.84	-0.23
8665.00	89.44	89.76	8195.91	186.75	1008.73	1006.79	5.82	1.05	-5.73
8760.00	90.99	87.06	8195.56	189.39	1103.68	1101.70	3.28	1.63	-2.84
8856.00	89.75	85.99	8194.94	195.20	1199.50	1197.46	1.71	-1.29	-1.11
8951.00	90.57	85.14	8194.67	202.55	1294.21	1292.09	1.24	0.86	-0.89
9046.00	90.99	86.70	8193.38	209.31	1388.96	1386.77	1.70	0.44	1.64
9141.00	91.71	89.13	8191.14	212.76	1483.86	1481.63	2.67	0.76	2.56
9237.00	90.39	88.18	8189.38	215.02	1579.81	1577.56	1.69	-1.38	-0.99
9332.00	89.59	86.74	8189.40	219.23	1674.72	1672.41	1.73	-0.84	-1.52
9428.00	88.44	86.47	8191.05	224.91	1770.53	1768.17	1.23	-1.20	-0.28
9523.00	86.94	87.64	8194.88	229.79	1865.33	1862.91	2.00	-1.58	1.23
9619.00	86.54	88.05	8200.34	233.39	1961.10	1958.64	0.60	-0.42	0.43
9714.00	88.44	88.32	8204.50	236.40	2055.96	2053.46	2.02	2.00	0.28
9810.00	87.95	88.14	8207.52	239.36	2151.87	2149.33	0.54	-0.51	-0.19
9905.00	87.44	87.20	8211.34	243.22	2246.71	2244.13	1.13	-0.54	-0.99
10001.00	87.74	86.95	8215.38	248.12	2342.50	2339.87	0.41	0.31	-0.26
10096.00	87.85	86.29	8219.03	253.71	2437.26	2434.57	0.70	0.12	-0.69
10192.00	87.09	86.15	8223.27	260.04	2532.96	2530.20	0.80	-0.79	-0.15
10287.00	86.54	88.34	8228.55	264.59	2627.70	2624.89	2.37	-0.58	2.31
10382.00	87.24	90.70	8233.71	265.39	2722.55	2719.72	2.59	0.74	2.48
10478.00	88.64	90.91	8237.16	264.04	2818.47	2815.66	1.47	1.46	0.22
10573.00	90.24	90.97	8238.08	262.48	2913.45	2910.65	1.69	1.68	0.06
10668.00	91.24	90.48	8236.86	261.28	3008.44	3005.64	1.17	1.05	-0.52
10860.00	89.29	87.70	8235.97	264.33	3200.38	3197.54	1.77	-1.02	-1.45
10955.00	90.14	88.97	8236.44	267.09	3295.34	3292.47	1.61	0.89	1.34
11050.00	87.49	89.11	8238.41	268.68	3390.30	3387.40	2.79	-2.79	0.15
11145.00	86.89	89.15	8243.06	270.12	3485.17	3482.26	0.63	-0.63	0.04
11241.00	87.39	88.39	8247.85	272.18	3581.03	3578.09	0.95	0.52	-0.79
11336.00	87.44	90.03	8252.14	273.49	3675.92	3672.96	1.73	0.05	1.73
11431.00	87.75	90.33	8256.13	273.19	3770.83	3767.88	0.45	0.33	0.32
11527.00	88.90	89.54	8258.93	273.30	3866.79	3863.83	1.45	1.20	-0.82
11622.00	89.90	88.80	8259.93	274.67	3961.77	3958.79	1.31	1.05	-0.78
11717.00	89.42	88.98	8260.49	276.52	4056.75	4053.75	0.54	-0.51	0.19

MD	INC	AZI	TVD	NS	EW	VS	DLS	BR	TR
Usft	deg	deg	Usft	Usft	Usft	Usft	deg/100Usft	deg/100Usft	deg/100Usft
11813.00	88.67	88.52	8262.09	278.61	4152.72	4149.68	0.92	-0.78	-0.48
11908.00	87.07	89.09	8265.62	280.59	4247.63	4244.57	1.79	-1.68	0.60
12004.00	87.89	91.49	8269.84	280.10	4343.52	4340.47	2.64	0.85	2.50
12099.00	89.40	90.89	8272.09	278.13	4438.47	4435.43	1.71	1.59	-0.63
12194.00	87.56	90.37	8274.61	277.09	4533.43	4530.39	2.01	-1.94	-0.55
12290.00	87.40	90.28	8278.83	276.54	4629.34	4626.30	0.19	-0.17	-0.09
12385.00	88.39	89.17	8282.32	277.00	4724.27	4721.22	1.57	1.04	-1.17
12481.00	89.19	88.34	8284.35	279.08	4820.22	4817.15	1.20	0.83	-0.86
12576.00	90.79	87.85	8284.36	282.24	4915.17	4912.06	1.76	1.68	-0.52
12672.00	88.69	87.84	8284.80	285.85	5011.09	5007.94	2.19	-2.19	-0.01
12767.00	86.77	86.98	8288.56	290.14	5105.92	5102.72	2.21	-2.02	-0.91
12863.00	86.66	86.48	8294.06	295.61	5201.60	5198.34	0.53	-0.11	-0.52
12958.00	88.69	89.64	8297.92	298.82	5296.45	5293.16	3.95	2.14	3.33
13054.00	90.19	90.24	8298.85	298.92	5392.44	5389.14	1.68	1.56	0.63
13149.00	89.39	88.80	8299.20	299.71	5487.44	5484.12	1.73	-0.84	-1.52
13245.00	88.74	90.31	8300.77	300.46	5583.42	5580.09	1.71	-0.68	1.57
13340.00	86.49	89.54	8304.72	300.58	5678.33	5675.00	2.50	-2.37	-0.81
13436.00	87.33	88.02	8309.90	302.63	5774.16	5770.80	1.81	0.88	-1.58
13531.00	87.50	87.20	8314.18	306.58	5868.98	5865.58	0.88	0.18	-0.86
13626.00	88.59	89.32	8317.42	309.46	5963.88	5960.44	2.51	1.15	2.23
13722.00	88.54	91.70	8319.83	308.61	6059.84	6056.40	2.48	-0.05	2.48
13817.00	88.52	92.97	8322.27	304.74	6154.73	6151.33	1.34	-0.02	1.34
13913.00	90.19	92.10	8323.35	300.50	6250.62	6247.26	1.96	1.74	-0.91
14008.00	90.44	91.84	8322.82	297.23	6345.56	6342.23	0.38	0.26	-0.27
14104.00	85.95	90.67	8325.85	295.13	6441.47	6438.15	4.83	-4.68	-1.22
14199.00	85.95	92.18	8332.56	292.77	6536.20	6532.90	1.59	0.00	1.59
14294.00	85.44	92.84	8339.69	288.62	6630.84	6627.58	0.88	-0.54	0.69
14390.00	87.64	91.96	8345.48	284.61	6726.57	6723.35	2.47	2.29	-0.92
14485.00	90.43	91.55	8347.08	281.70	6821.50	6818.30	2.97	2.94	-0.43
14580.00	90.69	90.86	8346.15	279.71	6916.48	6913.29	0.78	0.27	-0.73
14676.00	90.04	89.07	8345.54	279.76	7012.47	7009.28	1.98	-0.68	-1.86
14772.00	88.03	87.94	8347.16	282.27	7108.42	7105.20	2.40	-2.09	-1.18
14867.00	87.39	87.32	8350.95	286.19	7203.26	7199.99	0.94	-0.67	-0.65
14962.00	87.53	87.54	8355.16	290.45	7298.07	7294.76	0.27	0.15	0.23
15058.00	87.84	88.85	8359.04	293.47	7393.94	7390.59	1.40	0.32	1.36
15153.00	88.29	88.15	8362.25	295.96	7488.86	7485.48	0.88	0.47	-0.74
15249.00	87.74	88.11	8365.58	299.09	7584.75	7581.33	0.57	-0.57	-0.04
15344.00	86.74	88.27	8370.15	302.08	7679.59	7676.14	1.07	-1.05	0.17
15439.00	86.00	89.69	8376.16	303.77	7774.38	7770.91	1.68	-0.78	1.49
15535.00	87.99	90.30	8381.20	303.78	7870.24	7866.76	2.17	2.07	0.64
15630.00	89.49	92.12	8383.29	301.77	7965.19	7961.73	2.48	1.58	1.92
15726.00	90.53	91.89	8383.27	298.41	8061.13	8057.70	1.11	1.08	-0.24
15821.00	91.89	91.59	8381.26	295.53	8156.06	8152.65	1.47	1.43	-0.32
15917.00	92.07	90.51	8377.95	293.77	8251.99	8248.59	1.14	0.19	-1.13
16012.00	85.69	89.12	8379.80	294.08	8346.92	8343.51	6.87	-6.72	-1.46
16108.00	85.39	87.35	8387.27	297.03	8442.58	8439.14	1.86	-0.31	-1.84
16203.00	84.79	85.49	8395.40	302.93	8537.04	8533.54	2.05	-0.63	-1.96
16299.00	86.74	85.65	8402.49	310.33	8632.49	8628.90	2.04	2.03	0.17
16394.00	91.98	88.86	8403.55	314.87	8727.33	8723.69	6.47	5.52	3.38
16490.00	90.44	90.83	8401.52	315.13	8823.30	8819.66	2.60	-1.60	2.05
16585.00	89.97	90.40	8401.18	314.11	8918.29	8914.66	0.67	-0.49	-0.45
16681.00	91.07	89.55	8400.31	314.16	9014.29	9010.64	1.45	1.15	-0.89
16776.00	90.39	88.26	8399.10	315.97	9109.26	9105.59	1.53	-0.72	-1.36
16871.00	85.65	87.29	8402.38	319.66	9204.10	9200.39	5.09	-4.99	-1.02
16967.00	84.58	89.82	8410.56	322.07	9299.71	9295.98	2.85	-1.11	2.64
17062.00	85.24	91.74	8418.99	320.78	9394.32	9390.60	2.13	0.69	2.02
17158.00	88.45	92.80	8424.27	316.98	9490.09	9486.39	3.52	3.34	1.10
17253.00	91.54	92.75	8424.28	312.38	9584.97	9581.31	3.25	3.25	-0.05
17349.00	93.12	92.45	8420.38	308.03	9680.79	9677.17	1.68	1.65	-0.31
17444.00	92.39	91.76	8415.81	304.55	9775.61	9772.03	1.06	-0.77	-0.73
17539.00	90.98	91.39	8413.02	301.94	9870.53	9866.97	1.53	-1.48	-0.39
17635.00	91.69	90.39	8410.78	300.45	9966.49	9962.94	1.28	0.74	-1.04
17730.00	92.94	89.85	8406.94	300.25	10061.41	10057.86	1.43	1.32	-0.57
17826.00	89.79	89.68	8404.66	300.64	10157.37	10153.81	3.29	-3.28	-0.18
17921.00	88.24	90.89	8406.29	300.17	10252.35	10248.79	2.07	-1.63	1.27
18017.00	88.25	90.78	8409.23	298.77	10348.30	10344.74	0.12	0.01	-0.11
18112.00	86.65	90.03	8413.46	298.10	10443.20	10439.64	1.86	-1.68	-0.79
18208.00	84.96	90.08	8420.48	298.01	10538.94	10535.38	1.76	-1.76	0.05
18303.00	87.89	91.25	8426.40	296.91	10633.73	10630.18	3.32	3.08	1.23
18399.00	86.24	90.14	8431.32	295.74	10729.59	10726.05	2.07	-1.72	-1.16
18494.00	85.59	88.55	8438.09	296.82	10824.34	10820.78	1.80	-0.68	-1.67
18590.00	86.95	88.81	8444.33	299.03	10920.11	10916.53	1.44	1.42	0.27
18685.00	88.09	90.54	8448.44	299.57	11015.02	11011.42	2.18	1.20	1.82
18781.00	89.69	90.94	8450.30	298.33	11110.99	11107.40	1.72	1.67	0.42
18876.00	88.87	91.10	8451.49	296.64	11205.96	11202.39	0.88	-0.86	0.17
18972.00	87.49	89.81	8454.54	295.88	11301.91	11298.33	1.97	-1.44	-1.34
19067.00	89.40	90.20	8457.12	295.87	11396.87	11393.29	2.05	2.01	0.41

MD	INC	AZI	TVD	NS	EW	VS	DLS	BR	TR
Usft	deg	deg	Usft	Usft	Usft	Usft	deg/100Usft	deg/100Usft	deg/100Usft
19163.00	90.53	90.41	8457.18	295.36	11492.87	11489.29	1.20	1.18	0.22
19258.00	89.54	90.63	8457.12	294.49	11587.86	11584.29	1.07	-1.04	0.23
19354.00	90.50	90.50	8457.09	293.55	11683.85	11680.28	1.01	1.00	-0.14
19449.00	90.59	91.49	8456.18	291.90	11778.83	11775.28	1.05	0.09	1.04
19545.00	90.05	91.18	8455.65	289.66	11874.81	11871.27	0.65	-0.56	-0.32
19640.00	89.79	89.91	8455.78	288.76	11969.80	11966.26	1.36	-0.27	-1.34
19735.00	88.65	90.99	8457.07	288.01	12064.79	12061.25	1.65	-1.20	1.14
19831.00	88.21	91.47	8459.70	285.95	12160.73	12157.21	0.68	-0.46	0.50
19926.00	87.89	92.20	8462.94	282.91	12255.62	12252.13	0.84	-0.34	0.77
20022.00	89.02	92.98	8465.53	278.58	12351.49	12348.03	1.43	1.18	0.81
20117.00	87.94	93.19	8468.05	273.46	12446.31	12442.91	1.16	-1.14	0.22
20212.00	86.09	93.22	8472.99	268.16	12541.03	12537.68	1.95	-1.95	0.03
20307.00	85.59	94.04	8479.88	262.16	12635.59	12632.29	1.01	-0.53	0.86
20403.00	85.94	94.22	8486.97	255.27	12731.08	12727.84	0.41	0.36	0.19
20498.00	86.99	95.02	8492.83	247.63	12825.59	12822.43	1.39	1.11	0.84
20593.00	87.83	94.62	8497.12	239.66	12920.16	12917.07	0.98	0.88	-0.42
20689.00	88.62	94.34	8500.10	232.16	13015.82	13012.80	0.87	0.82	-0.29
20784.00	89.99	94.01	8501.25	225.25	13110.55	13107.60	1.48	1.44	-0.35
20880.00	88.19	93.96	8502.77	218.57	13206.31	13203.42	1.88	-1.88	-0.05
20975.00	89.89	93.18	8504.37	212.66	13301.10	13298.27	1.97	1.79	-0.82
21071.00	86.94	92.20	8507.02	208.16	13396.95	13394.16	3.24	-3.07	-1.02
21166.00	86.74	91.02	8512.26	205.49	13491.77	13489.00	1.26	-0.21	-1.24
21262.00	86.94	91.79	8517.55	203.14	13587.59	13584.84	0.83	0.21	0.80
21357.00	88.34	92.40	8521.46	199.67	13682.44	13679.72	1.61	1.47	0.64
21453.00	89.44	92.29	8523.32	195.74	13778.34	13775.66	1.15	1.15	-0.11
21548.00	89.64	91.98	8524.08	192.20	13873.28	13870.62	0.39	0.21	-0.33
21644.00	89.90	91.88	8524.47	188.97	13969.22	13966.59	0.29	0.27	-0.10
21739.00	91.54	92.83	8523.28	185.07	14064.13	14061.53	1.99	1.73	1.00
21834.00	91.94	93.24	8520.39	180.04	14158.95	14156.40	0.60	0.42	0.43
21930.00	88.69	92.80	8519.86	174.98	14254.80	14252.30	3.42	-3.39	-0.46
22025.00	88.47	93.06	8522.22	170.13	14349.65	14347.19	0.36	-0.23	0.27
22120.00	88.94	93.67	8524.37	164.56	14444.46	14442.05	0.81	0.49	0.64
22216.00	86.29	93.37	8528.36	158.67	14540.19	14537.84	2.78	-2.76	-0.31
22311.00	85.77	93.58	8534.94	152.92	14634.79	14632.49	0.59	-0.55	0.22
22406.00	86.34	94.51	8541.47	146.24	14729.32	14727.09	1.15	0.60	0.98
22502.00	87.31	95.49	8546.79	137.88	14824.81	14822.65	1.44	1.01	1.02
22597.00	87.79	94.24	8550.85	129.83	14919.38	14917.30	1.41	0.51	-1.32
22693.00	88.34	94.04	8554.09	122.91	15015.07	15013.06	0.61	0.57	-0.21
22789.00	88.74	93.80	8556.54	116.35	15110.82	15108.86	0.49	0.42	-0.25
22884.00	90.29	93.91	8557.34	109.96	15205.59	15203.70	1.64	1.63	0.12
22980.00	90.18	93.71	8556.95	103.58	15301.38	15299.55	0.24	-0.11	-0.21
23075.00	89.49	92.81	8557.22	98.18	15396.23	15394.44	1.19	-0.73	-0.95
23171.00	88.34	92.73	8559.04	93.54	15492.09	15490.35	1.20	-1.20	-0.08
23266.00	86.92	91.89	8562.97	89.71	15586.93	15585.23	1.74	-1.49	-0.88
23361.00	87.69	92.62	8567.44	85.98	15681.75	15680.08	1.12	0.81	0.77
23457.00	88.98	93.09	8570.23	81.20	15777.59	15775.96	1.43	1.34	0.49
23552.00	90.70	94.20	8570.49	75.16	15872.39	15870.82	2.15	1.81	1.17
23630.00	90.70	94.20	8569.54	69.45	15950.18	15948.66	0.00	0.00	0.00 PTB

Santa Fe Main Office Phone: (505) 476-3441 General Information Phone: (505) 629-6116 Online Phone Directory Visit: https://www.emnrd.nm.gov/ocd/contact-us/	State of New Mexico Energy, Minerals & Natural Resources Department OIL CONSERVATION DIVISION	C-105 Revised July 9, 2024 Submit Electronically Via OCD Permitting
--	--	---

WELL COMPLETION OR RECOMPLETION REPORT AND LOG

Section 1 - Operator and Well Information

Submittal Type: ☒ New Well ☐ Workover ☐ Deepening ☐ Plugback ☐ Different Reservoir ☐ C-144 Closure Attachment ☐ Other	
Operator Name: Tap Rock Operating, LLC	OGRID: 372043
Property Name and Well Number: High Life Federal Com #202H	Property Code: 335064
Mineral Owner: ☐ State ☐ Fee ☐ Tribal ☒ Federal	API Number: 30-015-54526
Pool Name: Purple Sage; Wolfcamp (Gas)	Pool Code: 98220

Section 2 – Well Location

	Ul or lot no.	Section	Township	Range	Lot Id	Feet from	N/S Line	Feet from	E/W Line	County
SHL:	H	10	25-S	25-E	-	1829’	FNL	355’	FEL	EDDY
BHL	H	7	25-S	26-E	-	1608’	FNL	237’	FEL	EDDY

Section 3 – Completion Information

Date T.D. Reached 12/19/2024	Total Measured Depth of Well 23,630’	Acid Volume (bbls)	☒ Directional Survey Submitted ☐ Deviation Survey Submitted
Date Rig Released 12/21/2024	Plug-Back Measured Depth 23,544’	Completion Fluid Used (bbls) 836,721 bbls Slickwater	Were Logs Ran (Y/N) Yes
Completion Date 3/15/2025 – 3/31/2025	Perforations (MD and TVD) 8,343’ - 23,470’	Completion Proppant Used (lbs) 38,056,650 lbs of 40/140 mesh sand	List Type of Logs Ran if applicable: Mud Log

Section 4 – Action IDs for Submissions and Order Numbers

Surface Casing Action ID: 477130	UIC Permit/Order (UIC wells only) ☐ Yes ☒ No, Order No.
Intermediate 1 Casing Action ID: 418806	NOI Recomplete Action ID (if applicable): N/A
Intermediate 2 Casing Action ID: N/A	NOI Plugback Action ID (if applicable): N/A
Production Casing Action ID: 418808	Cement Squeeze Action ID (if applicable): N/A
Tubing Action ID: 479536	All casing was pressure tested in accordance with NMAC ☒ Yes ☐ No
Liner 1 Action ID:	Casing was installed prior to Action ID system (Y/N):

Section 5 – Test Data

Date First Production 4/22/2025	Production Method Flows from well	Well Status Flowing	Gas – Oil Ratio 2583
Date of Test 5/10/2025	Choke Size 56/64	Flowing Tubing Pressure 0	Casing Pressure 924
24 hr Oil (bbls) 684	24 hr Gas (MCF) 1767	24 hr Water (bbls) 8556	Oil Gravity – API 47
Disposition of Gas: Captured			

Section 6 – Pits

☐ A temporary pit was used at the well. If so, attach a plat with the location of the temporary pit.

☒ A Closed Loop System was used.

☐ If an on-site burial was used at the well, report the exact location of the on-site burial:

LAT: _____ LONG: _____

Section 7 - Operator Signature and Certification

☒ I hereby certify that the required Water Use Report has been, or will be, submitted for this well’s completion.	
☒ I hereby certify that the required Fracfocus disclosure has been, or will be, submitted for this well’s completion.	
☒ I hereby certify that the rules of the Oil Conservation Division have been complied with and that the information given above is true and complete to the best of my knowledge and belief.	
Name: Bill Ramsey	
Title: Sr. Environmental and Regulatory Specialist	Date: 7/8/2025

South Formations				North Formations			
Formation/Zone	MD	TVD	W/O/G	Formation/Zone	MD	TVD	W/O/G
T. Anhy	21’	21’		T. San Jose			
T. Salt	456’	456’		T. Nacimiento			
B. Salt	1259’	1259’		T. Ojo Alamo			
T. Yates				T. Kirtland			
T. 7 Rivers				T. Fruitland			
T. Queen				T. Pictured Cliffs			
T. Grayburg				T. Lewis Shale			
T. San Andres				T. Chacra			
T. Glorieta				T. Cliff House			
T. Yeso				T. Menefee			
T. Paddock				T. Point Lookout			
T. Blinebry				T. Mancos			
T.Tubb				T. Gallup			
T. Drinkard				T. Greenhorn			
T. Abo				T. Graneros			
T. Wolfcamp				T. Dakota			
T. Penn				T. Morrison			
T. Cisco				T. Bluff			
T. Canyon				T.Todilto			
T. Strawn				T. Entrada			
T. Atoka				T. Wingate			
T. Morrow				T. Chinle			
T. Barnett Shale				T. Permian			
T. Miss				T. Penn A"			
T. Woodford Shale				T. Penn. "B"			
T. Devonian				T. Penn. "C"			
T. Silurian				T. Penn. "D"			
T. Fusselman				T. Leadville			
T. Montoya				T. Madison			
T. Simpson				T. Elbert			
T. McKee				T. McCracken			
T. Waddell				T. Ignacio Otzte			
T. Connel				T. Granite			
T. Ellenburger				T. Hermosa			
T. Gr. Wash				T. De Chelly			
T. Delaware Sand				T. Pinkerton			
T. Lamar Lime	1491’	1491’					
T. Bell Canyon	1524’	1524’					
T. Cherry Canyon	2453’	2447’					
T. Brushy Canyon	3347’	3332’					
T. Bone Springs	5078’	5051’					
T. 1st BS Sand	5906’	5879’					
T. 2nd BS Sand	6477’	6450’					
T. 3rd BS Sand	7732’	7704’					
Wolfcamp	8176’	8144’					




Downhole Well Profile

Well Name: HIGH LIFE FEDERAL COM #202H

API/UWI 30-015-54526	Surface Legal Location T25S R25E SEC 11	Field Name	License #	State/Province New Mexico	Well Configuration Type
Original KB Elevation (ft) 3,537.00	KB-Tubing Head Distance (ft)	Spud Date 12/4/2024 23:15	Rig Release Date 12/21/2024 22:00	PBTD (All) (ftKB)	Total Depth All (TVD) (ftKB) Original Hole - 8,541.6

Type	Make	Working Pressure (psi)	Max Pres (psi)	Start Date	End Date
------	------	------------------------	----------------	------------	----------

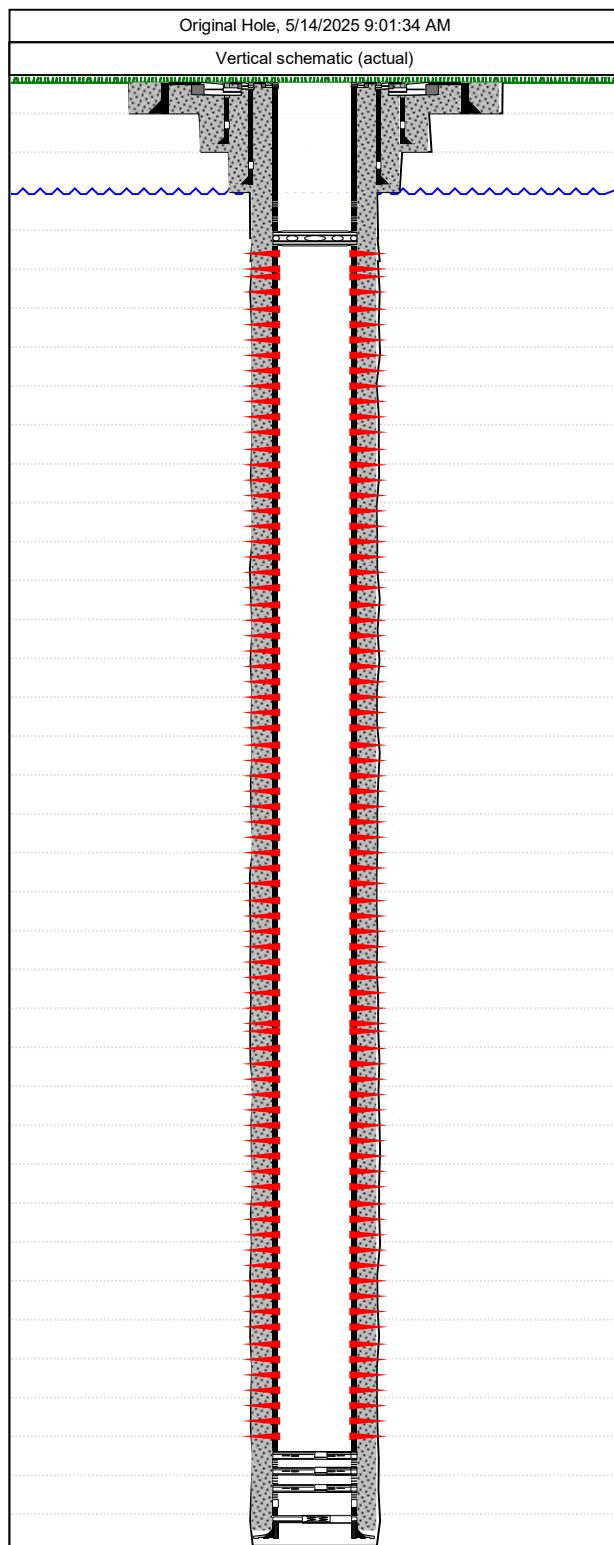

Casing Strings					
Csg Des	OD (in)	Wt/Len (lb/ft)	Grade	Top Thread	Set Depth (ftKB)
Conductor	20	106.50	J-55	WELDED	145.0
Surface	11 3/4	42.00	J-55	Buttress Thread	352.8
Intermediate	8 5/8	32.00	J-55	Buttress Thread	1,561.5
Production	5 1/2	20.00	P-110ICY	TXP BTC	23,596.7


Perforations			
Date	Top (ftKB)	Btm (ftKB)	Linked Zone
3/31/2025	8,343	8,510	
3/31/2025	8,530	8,710	
3/31/2025	8,730	8,910	
3/30/2025	8,930	9,110	
3/30/2025	9,130	9,310	
3/30/2025	9,330	9,510	
3/30/2025	9,530	9,710	
3/30/2025	9,730	9,910	
3/30/2025	9,930	10,110	
3/29/2025	10,130	10,310	
3/29/2025	10,330	10,510	
3/29/2025	10,530	10,710	
3/29/2025	10,730	10,910	
3/29/2025	10,930	11,110	
3/28/2025	11,130	11,310	
3/28/2025	11,330	11,510	
3/28/2025	11,530	11,710	
3/28/2025	11,730	11,910	
3/28/2025	11,930	12,110	
3/28/2025	12,130	12,310	
3/27/2025	12,330	12,510	
3/27/2025	12,530	12,710	
3/27/2025	12,730	12,910	
3/27/2025	12,930	13,110	
3/27/2025	13,130	13,310	
3/26/2025	13,330	13,510	
3/26/2025	13,530	13,710	
3/26/2025	13,730	13,910	
3/26/2025	13,930	14,110	
3/26/2025	14,130	14,310	
3/26/2025	14,330	14,510	
3/25/2025	14,530	14,710	
3/25/2025	14,730	14,910	
3/25/2025	14,930	15,110	
3/25/2025	15,130	15,310	
3/25/2025	15,330	15,510	
3/25/2025	15,530	15,710	
3/24/2025	15,730	15,910	
3/24/2025	15,930	16,110	
3/24/2025	16,130	16,310	
3/24/2025	16,330	16,510	
3/24/2025	16,530	16,710	
3/24/2025	16,730	16,910	
3/23/2025	16,930	17,110	



Downhole Well Profile

Well Name: HIGH LIFE FEDERAL COM #202H

API/UWI 30-015-54526	Surface Legal Location T25S R25E SEC 11	Field Name	License #	State/Province New Mexico	Well Configuration Type
Original KB Elevation (ft) 3,537.00	KB-Tubing Head Distance (ft)	Spud Date 12/4/2024 23:15	Rig Release Date 12/21/2024 22:00	PBTD (All) (ftKB)	Total Depth All (TVD) (ftKB) Original Hole - 8,541.6

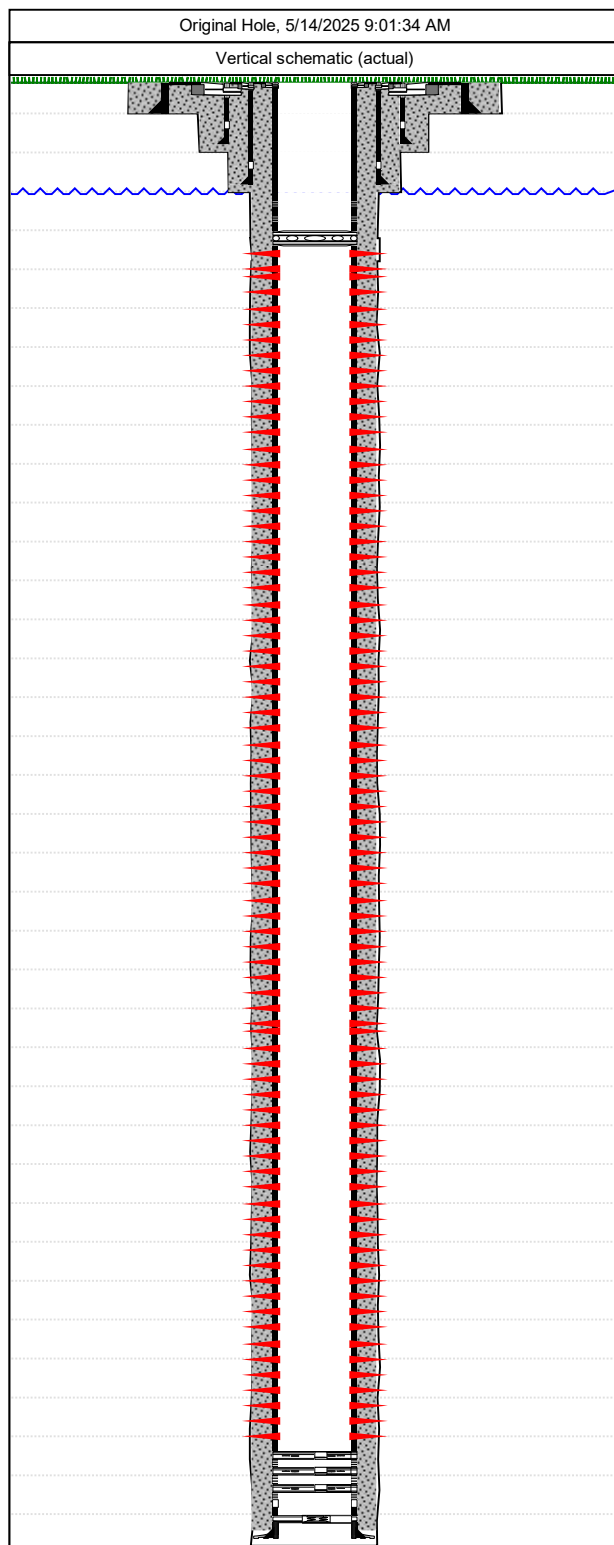

Perforations			
Date	Top (ftKB)	Btm (ftKB)	Linked Zone
3/23/2025	17,130	17,310	
3/23/2025	17,330	17,510	
3/23/2025	17,530	17,710	
3/23/2025	17,730	17,910	
3/22/2025	17,930	18,110	
3/22/2025	18,130	18,310	
3/22/2025	18,310	18,510	
3/22/2025	18,530	18,710	
3/22/2025	18,730	18,910	
3/22/2025	18,930	19,110	
3/21/2025	19,130	19,310	
3/21/2025	19,330	19,510	
3/21/2025	19,530	19,710	
3/21/2025	19,730	19,910	
3/21/2025	19,930	20,110	
3/20/2025	20,130	20,310	
3/20/2025	20,330	20,510	
3/20/2025	20,530	20,710	
3/20/2025	20,730	20,910	
3/20/2025	20,930	21,110	
3/19/2025	21,130	21,310	
3/19/2025	21,330	21,490	
3/19/2025	21,510	21,670	
3/19/2025	21,690	21,850	
3/19/2025	21,870	22,030	
3/19/2025	22,050	22,210	
3/18/2025	22,230	22,390	
3/18/2025	22,410	22,570	
3/18/2025	22,590	22,750	
3/17/2025	22,770	22,930	
3/17/2025	22,950	23,110	
3/16/2025	23,130	23,290	
3/15/2025	23,310	23,470	

Tubing Strings

Tubing Description		Run Date		String Length (ft)		Set Depth (ftKB)		
Item Des	Jts	Make	Model	OD (in)	Wt (lb/ft)	Grade	Len (ft)	

Rod Strings

Rod Description	Run Date		String Length (ft)	Set Depth (ftKB)			
Item Des	Jts	Make	Model	OD (in)	Wt (lb/ft)	Grade	Len (ft)

Sante Fe Main Office
Phone: (505) 476-3441

General Information
Phone: (505) 629-6116

Online Phone Directory
<https://www.emnrd.nm.gov/ocd/contact-us>

State of New Mexico
Energy, Minerals and Natural Resources
Oil Conservation Division
1220 S. St Francis Dr.
Santa Fe, NM 87505

ACKNOWLEDGMENTS

Action 519156

ACKNOWLEDGMENTS

Operator: TAP ROCK OPERATING, LLC 1700 Lincoln St Denver, CO 80203	OGRID: 372043
	Action Number: 519156
	Action Type: [C-104] Completion Packet - New Well (C-104NW)

ACKNOWLEDGMENTS

☒	I hereby certify that the required Water Use Report has been, or will be, submitted for this wells completion.
☒	I hereby certify that the required FracFocus disclosure has been, or will be, submitted for this wells completion.
☒	I hereby certify that the rules of the Oil Conservation Division have been complied with and that the information given above is true and complete to the best of my knowledge and belief.

Sante Fe Main Office
Phone: (505) 476-3441

General Information
Phone: (505) 629-6116

Online Phone Directory
<https://www.emnrd.nm.gov/oed/contact-us>

State of New Mexico
Energy, Minerals and Natural Resources
Oil Conservation Division
1220 S. St Francis Dr.
Santa Fe, NM 87505

CONDITIONS

Action 519156

CONDITIONS

Operator: TAP ROCK OPERATING, LLC 1700 Lincoln St Denver, CO 80203	OGRID: 372043
	Action Number: 519156
	Action Type: [C-104] Completion Packet - New Well (C-104NW)

CONDITIONS

Created By	Condition	Condition Date
plmartinez	File 3160-4 within 10 days of BLM Approval.	12/17/2025