

## APPLICATION FOR AUTHORIZATION TO INJECT

I. Purpose:  Secondary Recovery  Pressure Maintenance  Disposal  Storage  
Application qualifies for administrative approval?  yes  no

II. Operator: BTA OIL PRODUCERS  
Address: 104 South Pecos Midland, Texas 79701  
Contact party: DOROTHY HOUGHTON Phone: 915/682-3753

III. Well data: Complete the data required on the reverse side of this form for each well proposed for injection. Additional sheets may be attached if necessary.

IV. Is this an expansion of an existing project?  yes  no  
If yes, give the Division order number authorizing the project \_\_\_\_\_.

V. Attach a map that identifies all wells and leases within two miles of any proposed injection well with a one-half mile radius circle drawn around each proposed injection well. This circle identifies the well's area of review.

\* VI. Attach a tabulation of data on all wells of public record within the area of review which penetrate the proposed injection zone. Such data shall include a description of each well's type, construction, date drilled, location, depth, record of completion, and a schematic of any plugged well illustrating all plugging detail.

VII. Attach data on the proposed operation, including:

1. Proposed average and maximum daily rate and volume of fluids to be injected;
2. Whether the system is open or closed;
3. Proposed average and maximum injection pressure;
4. Sources and an appropriate analysis of injection fluid and compatibility with the receiving formation if other than reinjected produced water; and
5. If injection is for disposal purposes into a zone not productive of oil or gas at or within one mile of the proposed well, attach a chemical analysis of the disposal zone formation water (may be measured or inferred from existing literature, studies, nearby wells, etc.).

\* VIII. Attach appropriate geological data on the injection zone including appropriate lithologic detail, geological name, thickness, and depth. Give the geologic name, and depth to bottom of all underground sources of drinking water (aquifers containing waters with total dissolved solids concentrations of 10,000 mg/l or less) overlying the proposed injection zone as well as any such source known to be immediately underlying the injection interval.

IX. Describe the proposed stimulation program, if any.

\* X. Attach appropriate logging and test data on the well. (If well logs have been filed with the Division they need not be resubmitted.)

\* XI. Attach a chemical analysis of fresh water from two or more fresh water wells (if available and producing) within one mile of any injection or disposal well showing location of wells and dates samples were taken.

XII. Applicants for disposal wells must make an affirmative statement that they have examined available geologic and engineering data and find no evidence of open faults or any other hydrologic connection between the disposal zone and any underground source of drinking water.

XIII. Applicants must complete the "Proof of Notice" section on the reverse side of this form.

XIV. Certification

I hereby certify that the information submitted with this application is true and correct to the best of my knowledge and belief.

Name: DOROTHY HOUGHTON Title Regulatory Supervisor

Signature: Dorothy Houghton Date: 6-4-86

\* If the information required under Sections VI, VIII, X, and XI above has been previously submitted, it need not be duplicated and resubmitted. Please show the date and circumstance of the earlier submittal.

RECORDED EXAMINER STONER  
ON Conservation Division  
SFA Exhibit No. 1  
Case No. 8942

BTA OIL PRODUCERS  
Buckeye, 8601 JV-P  
Well No. 1-SWD  
Form C-108 Attachment Data Sheet  
-E-, Sec. 29, T-17-S, R-36-E  
Lea County, New Mexico

- V. The attached map identifies all wells and leases within two miles of our proposed injection well. See Exhibit -A-.
- VI. Exhibit -B- is a tabulation on all wells of public record within the area of review (1/2 mile). Also attached are Exhibits -C- 1 through 6, a schematic of each of the six plugged wells within the area of review.
- VII. 1. Estimated average maximum daily rate will be 1,000 barrels per day.  
2. The system will be closed.  
3. The proposed average maximum injection pressure will be 750 psi. *Request 1016 psi.*  
4. The source of produced water will be the Abo and San Andres formations.  
5. Exhibit -D- 1 through 3 are water analyses of produced water from wells in the area.
- VIII. Attached Exhibit -E- is a stratigraphic section of the "Permian San Andres" formation which we estimate to be a thickness of +1,657' from the top of the San Andres to the base of the San Andres.
- The source of drinking water in this area is the Ogallala Aquifer located from 50 feet to 250 feet.
- IX. We propose to use 1,500 gal. of 15% HCl acid for a stimulation program.
- X. Logs were previously furnished by Calatex Exploration on this well.
- XI. We were not able to obtain chemical analysis of fresh water in this area.
- XII. After examining available geologic and engineering data, I find no evidence of open faults in the "Permian San Andres" formation or any other hydrologic connection between the disposal zone and any underground source of drinking water.

  
MARVIN ZOLLER  
Chief Geologist  
For BTA Oil Producers

XIII. We are having a legal notice published in the Lovington Daily Leader and will forward a copy of proof of publication as soon as available. A copy of our application has been furnished by certified mail to the surface leasee, State of New Mexico, Commission of Public Lands, and to each leasehold operator within one-half mile of the well location. See Exhibit -F-.

BTA OIL PRODUCERS

Buckeye, 8601 JV-P  
Sec. 29, T-17-S, R-36-E  
Lea County, New Mexico

Log properties indicate the San Andres interval  
(5,082' - 5,120') to be consistent, a dolomite  
zone having approximately 13% porosity and  
indicated permeability.

O. V. SIVAGE  
O. V. SIVAGE  
Production Engineer  
For BTA Oil Producers

**Exhibit -A-** BTA OIL PRODUCERS - buckeye, 8601 JV

Buckeye, 8601 JV-B No. 1, SWB

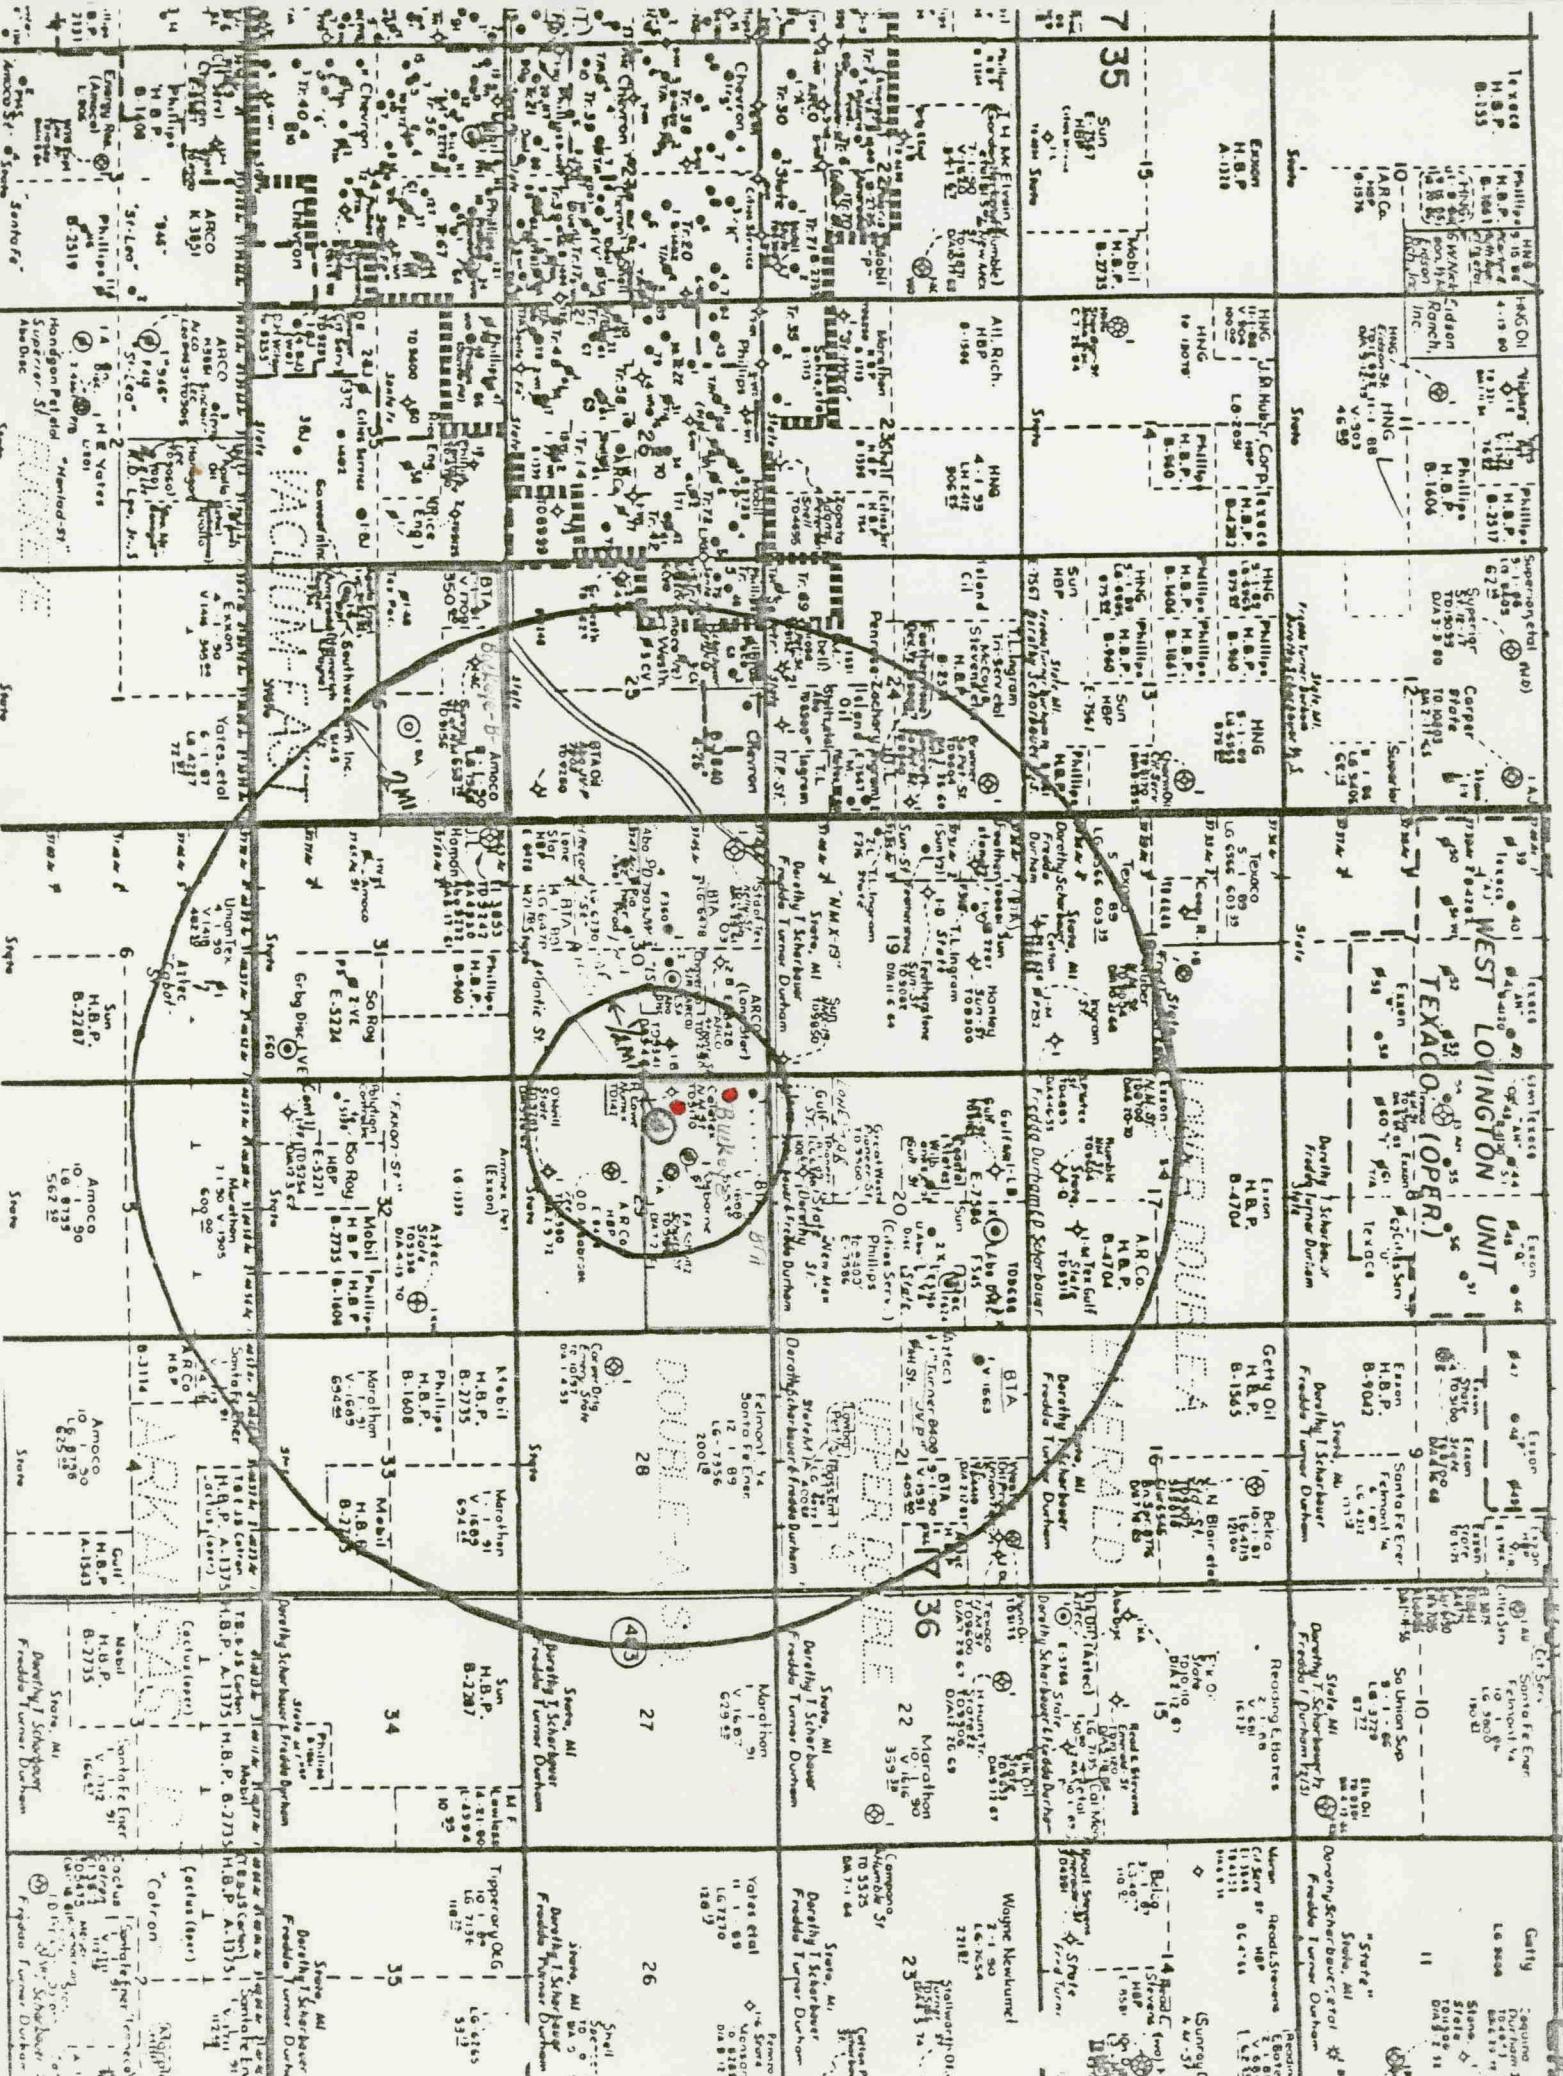


EXHIBIT -F-

List of Offset Operators  
and Surface Owners

---

BTA Oil Producers  
Buckeye, 8601 JV-P  
Lea County, New Mexico

---

Chevron U.S.A., Inc.  
P. O. Box 1150  
Midland, Texas 79702

*Chevron*

Pioneer Production Corp.  
P. O. Box 2542  
Amarillo, Texas 79189

Arco Oil and Gas Company  
P. O. Box 1610  
Midland, Texas 79702

Sun Exploration and Production Co.  
P. O. Box 1861  
Midland, Texas 79702

Surface Owner:  
Giles M. Lee  
West Star Route, Box 478  
Lovington, New Mexico 88260

I hereby certify the above were mailed copies of our application  
on June 4, 1986.

*Dorothy Houghton*  
DOROTHY HOUGHTON

List of Offset Operators  
and Surface Owners

---

BTA Oil Producers  
Buckeye, 8601 JV-P  
Lea County, New Mexico

---

Chevron U.S.A., Inc.  
P. O. Box 1150  
Midland, Texas 79702

Pioneer Production Corp.  
P. O. Box 2542  
Amarillo, Texas 79189

Arco Oil and Gas Company  
P. O. Box 1610  
Midland, Texas 79702

Sun Exploration and Production Co.  
P. O. Box 1861  
Midland, Texas 79702

Surface Owner:  
Giles M. Lee  
West Star Route, Box 478  
Lovington, New Mexico 88260

I hereby certify the above were mailed copies of our application  
on June 4, 1986.

  
DOROTHY HOUGHTON

Chaverroo Operating Co., Inc.  
P. O. Box 763  
Hobbs, New Mexico 88241

I hereby certify the above was mailed a copy of our application  
on July 7, 1986.

  
DOROTHY HOUGHTON

srs

P 477 957 339

RECEIPT FOR CERTIFIED MAIL


7-8-1994

Chaverro Operating Co., Inc.

P. O. Box 763

Hobbs, NM 88241

1984-4301-794

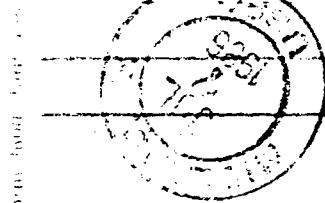

P.O. Box 763  
Hobbs, NM 88241

## INJECTION WELL DATA SHEET

BTA OIL PRODUCERS OPERATOR	Buckeye, 8601 JV-P LEASE			
1-SWD WELL NO.	2310' FNL & 990' FWL FOOTAGE LOCATION	29 SECTION	17-S TOWNSHIP	36-E RANGE

SchematicTabular DataSurface Casing

See Attached

Size 8-5/8" @ 437' " Cemented with 300 sx.TOC Circ feet determined by \_\_\_\_\_Hole size 11"Intermediate Casing

Size \_\_\_\_\_ " Cemented with \_\_\_\_\_ sx.

TOC \_\_\_\_\_ feet determined by \_\_\_\_\_

Hole size \_\_\_\_\_

Long stringSize 4-1/2" @ 5159' " Cemented with 1175 sx.TOC Circ. to surface feet determined by \_\_\_\_\_Hole size 7-7/8"Total depth 5168'

Injection interval      Perf @

5082      feet to      5120      feet  
(perforated or open hole, indicate which)Tubing size 2-3/8" OD lined with Fiberglass (material) set in aBaker Loc-Set packer at 5000 feet  
(brand and model)

(or describe any other casing-tubing seal).

Other Data

1. Name of the injection formation San Andres
2. Name of Field or Pool (if applicable) Vacuum, Grayburg
3. Is this a new well drilled for injection?  Yes  No  
If no, for what purpose was the well originally drilled? Production - Drld by Calatex  
as New Mexico State #1 - Spud: 11-26-83 P&A 2-22-84
4. Has the well ever been perforated in any other zone(s)? List all such perforated intervals and give plugging detail (sacks of cement or bridge plug(s) used) No- See Above Perf's  
1. 10 sx plug from 4910' - 5019' 2. 20 sx plug from 3000' - 3200' 3. 20 sx plug from 1850' - 2050' 4. 10 sx @ Surface
5. Give the depth to and name of any overlying and/or underlying oil or gas zones (pools) in this area. Abo Detrital 8800'- 9200'

## EXHIBIT -B-


BTA Oil Producers  
Buckeye, 8601 JV-P  
Well No. 1, SWD

Company Name Lease Name, Well #	Well Type	Construction	Spud Date Completion	Location	Depth	Record of Completion
Homer C. Osborne State #1 (Exhibit C-1)	0i1	8-5/8 @ 1995 4-1/2 @ 5067	4-29-80 2-16-81	Unt. Ltr. F, Sec. 29 T-17-S, R-36-E	5,152'	OH-5067-5152 IPP-15 B0 + 6 BW; P&A 3-23-84
Frank A. Schultz Schultz State #1 (Exhibit C-2)	Dry	8-5/8 @ 380 4-1/2 @ 5160	5-30-76 7-9-76	Unt. Ltr. F, Sec. 29 T-17-S, R-36-E	5,160'	Perf. 5082-5138 Swb. 19 BO P&A 7-9-76
O. D. Alsabrook Alsabrook #1 (Exhibit C-3)	Dry	4-1/2 @ 5297	11-26-71 2-9-72	Unt. Ltr. K, Sec. 29 T-17-S, R-36-E	5,300'	Perf. 5136-5203 Swb. 100% wtr. P&A 2-9-72
BTA Buckeye #1	0i1	13-3/8 @ 402 8-5/8 @ 4395 5-1/2 @ 9900	3-15-86 <del>11-17-86 / 17c-17</del>	Unt. Ltr. D, Sec. 29 T-17-S, R-36-E	PB 5240 9,900' <del>5-11-86 / 17c-17</del>	Perf. 5050-5163 IPP- (testing) <del>5-11-86 / 17c-17</del>
Joseph I. O'Neill State -K- #1 (Exhibit C-4)	Dry	13-3/8 @ 358 8-5/8 @ 3470	4-13-62 5-26-62	Unt. Ltr. N, Sec. 29 T-17-S, R-36-E	9,283'	2 DST's P&A 5-26-62
Lone Star Prod. Co. Atlantic State #1-B (Exhibit C-5)	Dry	10-3/4 @ 406 7-5/8 @ 3618	7-9-64 9-9-64	Unt. Ltr. H, Sec. 30 T-17-S, R-36-E	9,341'	Perf. 8705-9178 P&A 9-9-64
Lone Star Prod. Co. Gulf State #1 (Exhibit C-6)	0i1	10-3/4 @ 395 7-5/8 @ 3600 4-1/2 @ 9293	3-28-64 5-25-64	Unt. Ltr. M, Sec. 20 T-17-S, R-36-E	9,258' 9,322'	Perf. 9171-78; Flwd 123 BO; Perf. 8705-9083 P&A 7-25-68

BTA OIL PRODUCERS


Buckeye, 8601 JV-P

Well No. 1, SWD

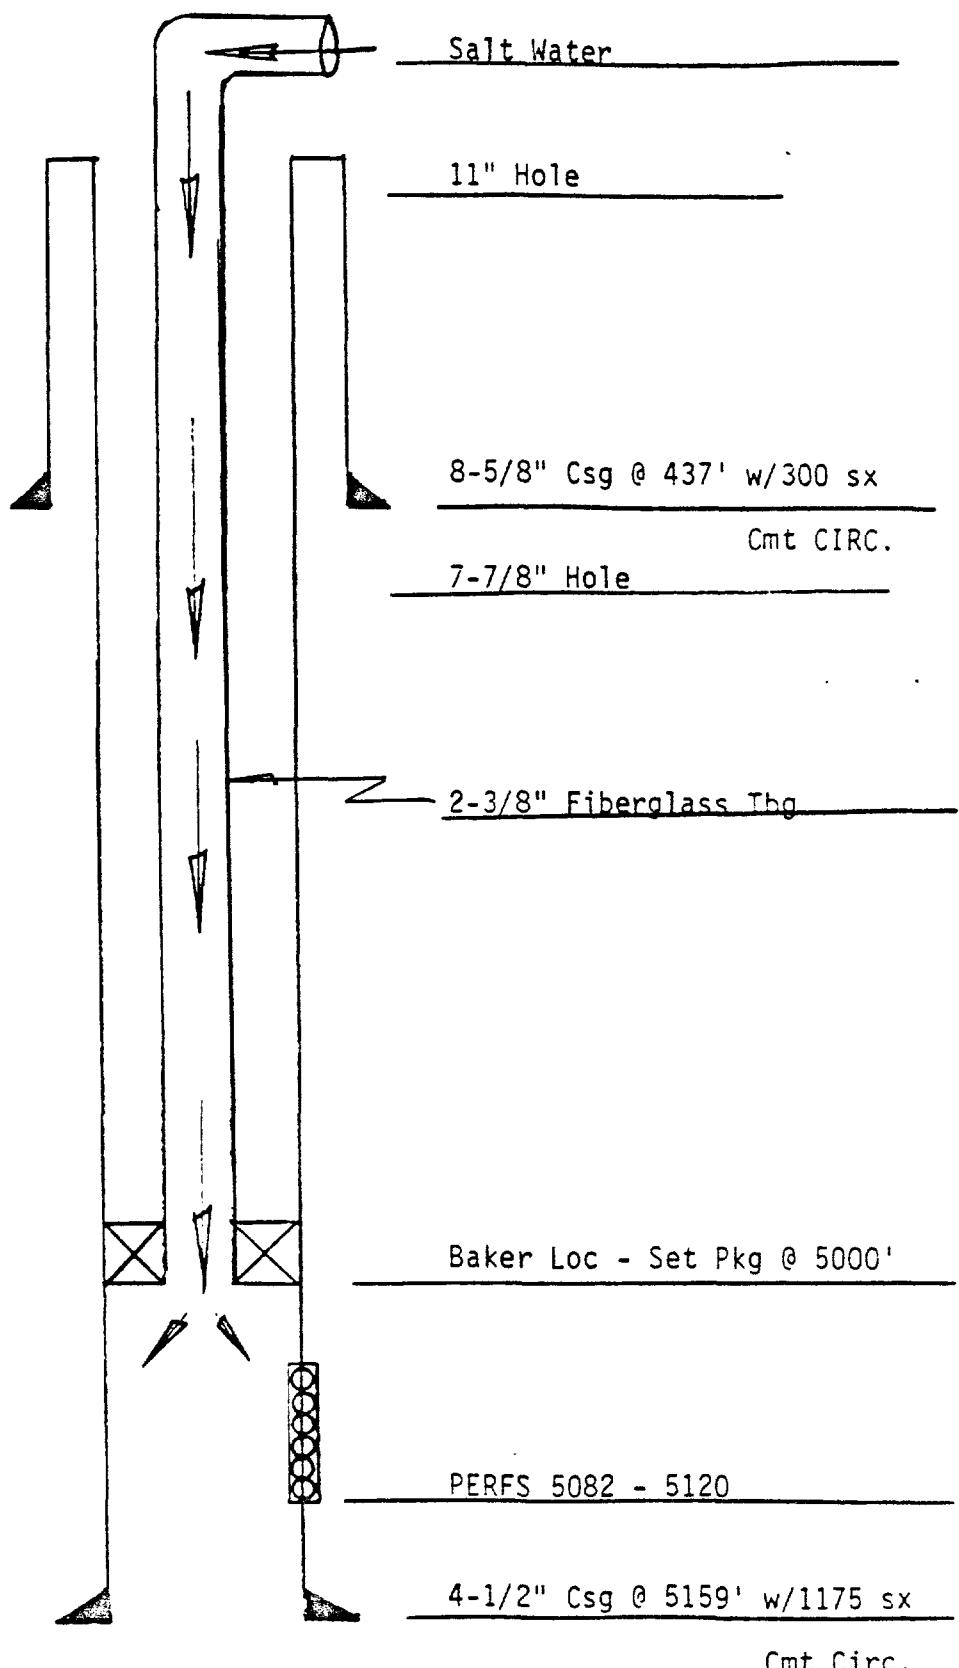


Cmt Circ.

BTA OIL PRODUCERS  
Buckeye, 8601 JV-P  
330' FN & WL Sec 29, T-17-S, R-36-E  
Lea County, New Mexico

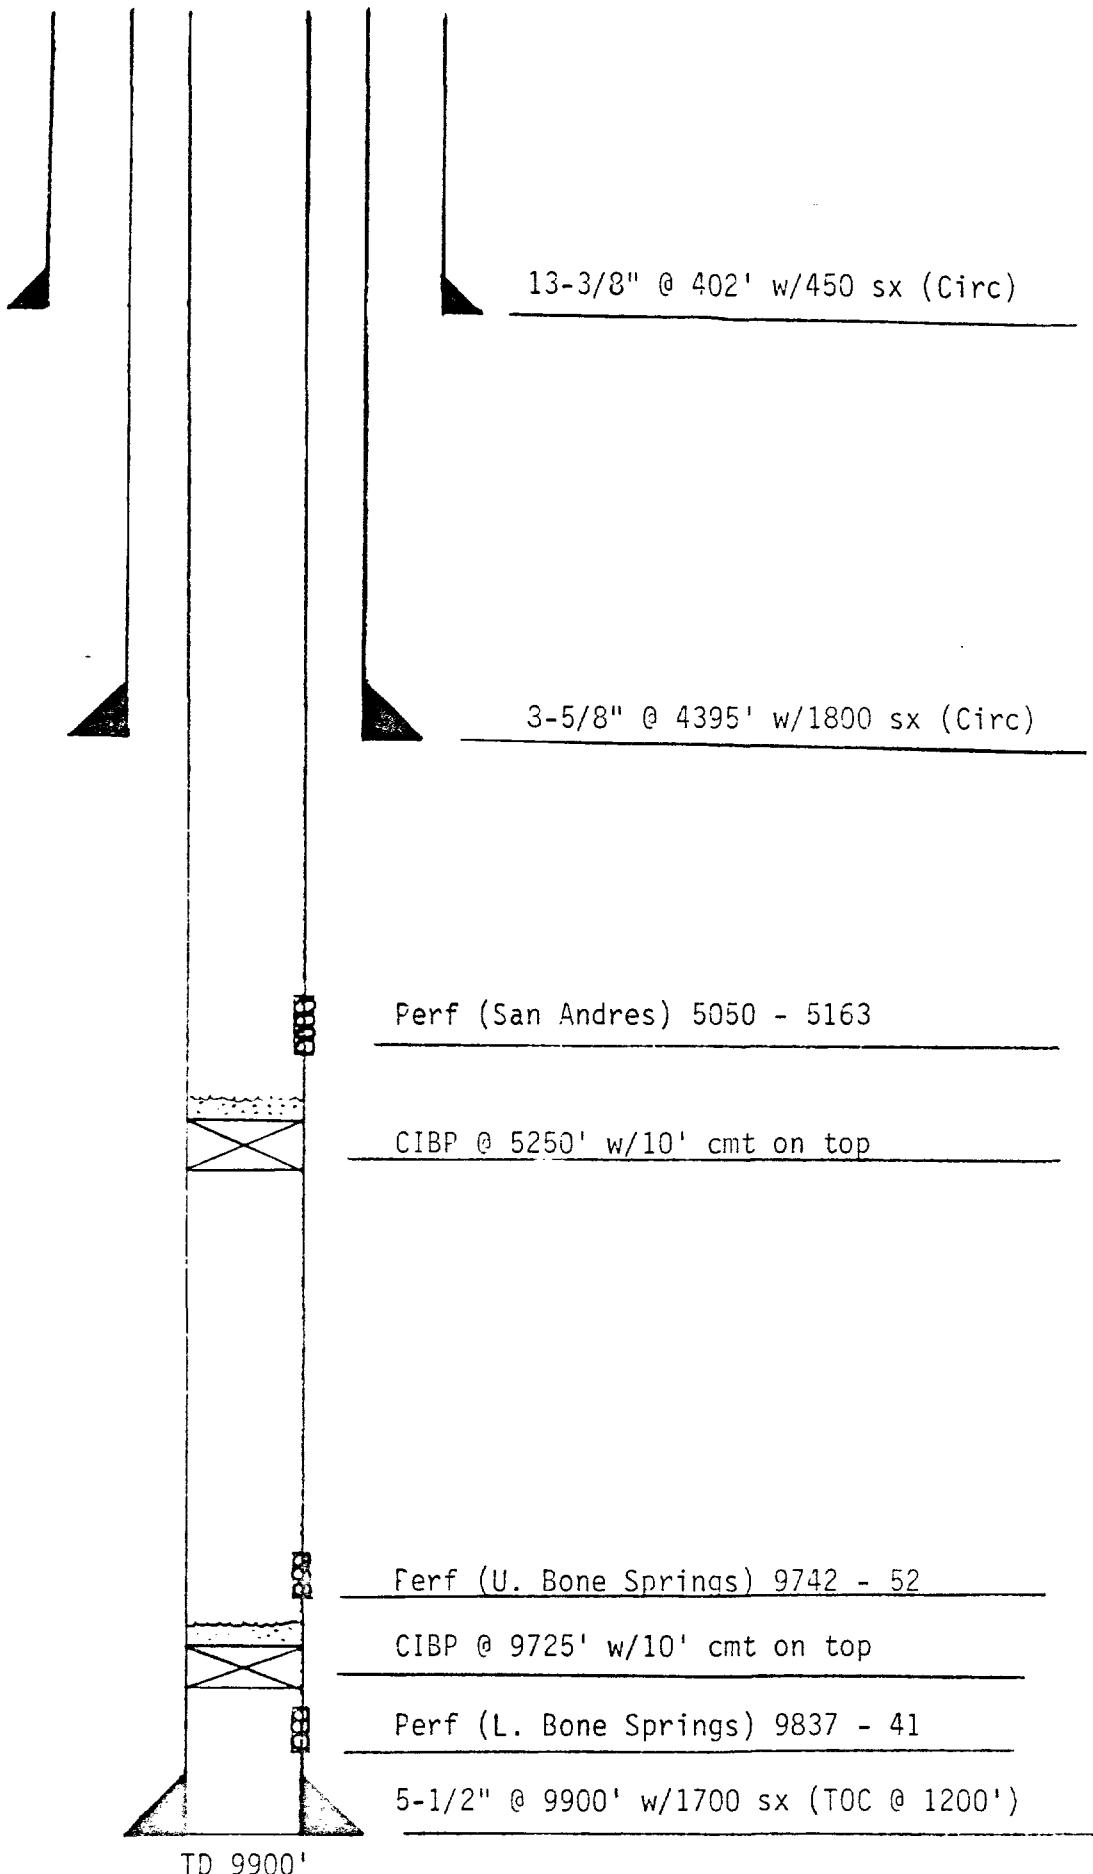

E X H I B I T C-1

Homer C. Osborne  
State #1  
-F-, Sec. 29, T-17-S, R-36-E

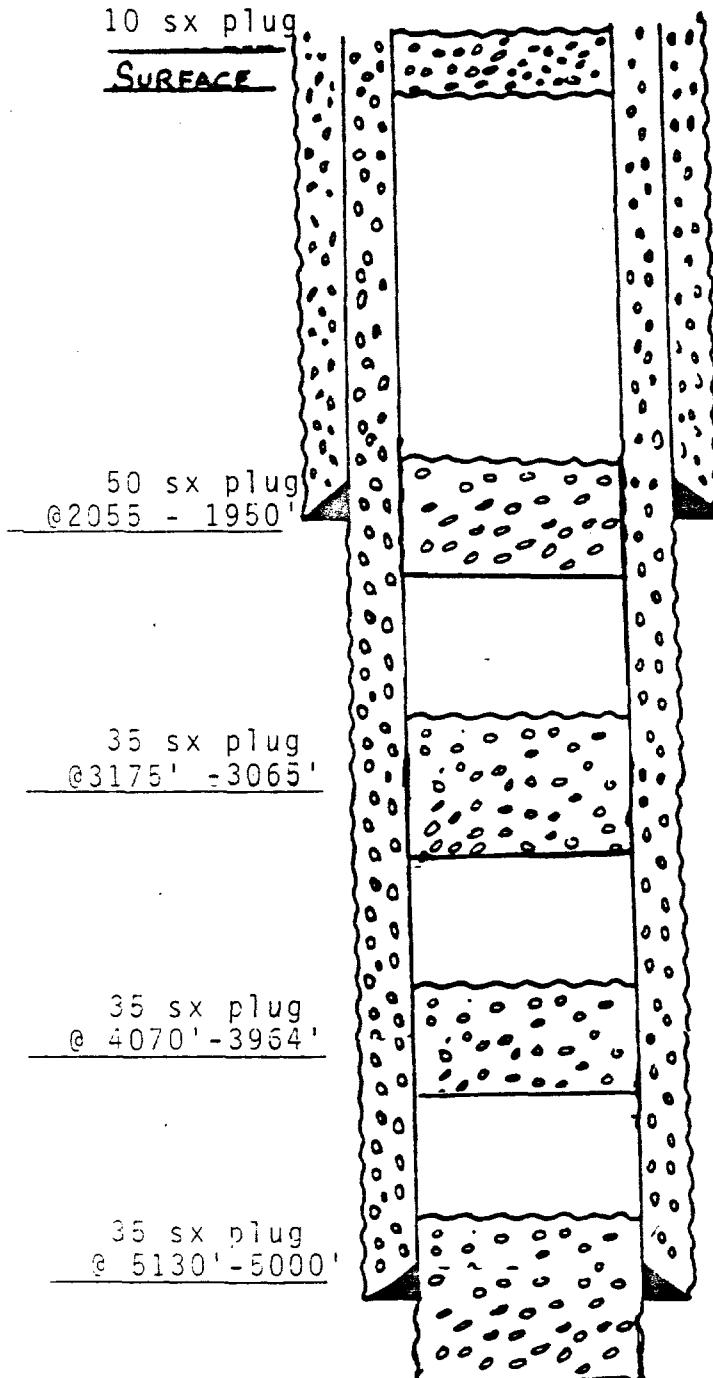

12 1/4" hole

3-5/8" @ 1995 w/ 1190 sx

Cement circulated

Shot 4-1/2" @ 4020'

7 7/8" hole

4-1/2" @ 5067' w/ 150 sx

Estimated top cement 4100'

TD 5152'

Exhibit C-2

Frank A. Schultz

Schultz State #1

-F-, Sec. 29, T-17-S, R-36-E

*12 1/4" hole*

8-5/8" @ 380 w/250 sx

*Estimated cement circulated*


3 sx plug

1964' - 2064'

35 sx plug

3379' - 3344'

CIBP @ 3370'

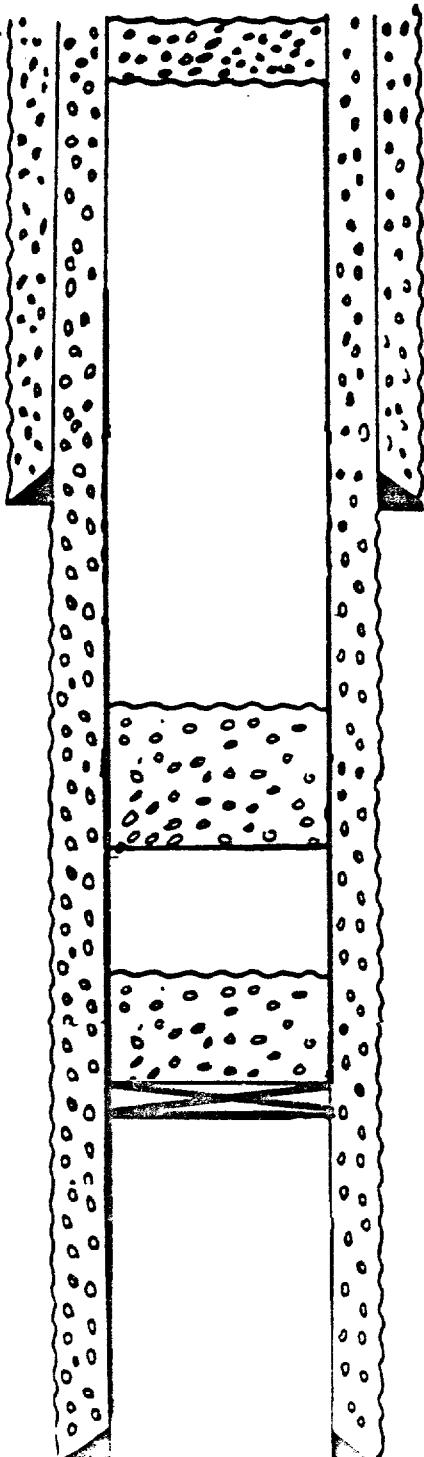

*7 7/8" hole*

*TD 5160'*

4-1/2" @ 5160' w/300 sx


*TD 5160'*

*~~Estimated cement circulated~~*

**ILLEGIBLE**

E X H I B I T C-3

O. D. ALSABROOK  
Alsabrook #1  
-K-, Sec. 29, 6-17-S, R-36-E

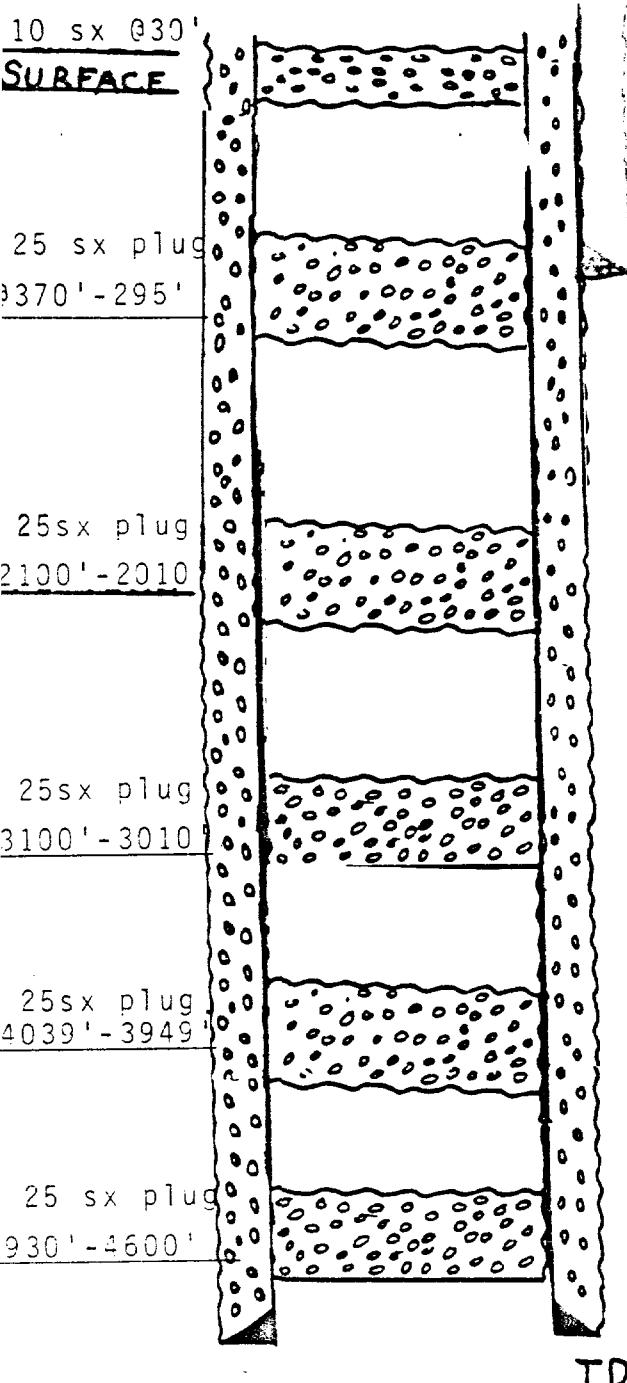

12  $\frac{1}{4}$ " hole.

8  $\frac{1}{8}$ " @ 369 w 324 cu ft cement  
cement circulated

Left 1273' of 4-1/2" csg in hole.

Cut 4-1/2" csg @ 4024'

7  $\frac{1}{8}$ " hole

4-1/2" @ 5297' w/200 sx. Top cement

Estimated @ 8000'

E X H I B I T C-4


JOSEPH I. O'NEILL, JR.

State -K- #1

-N-, Sec. 29, T-17-S, R-36-E

0 sx plug

SURFACE

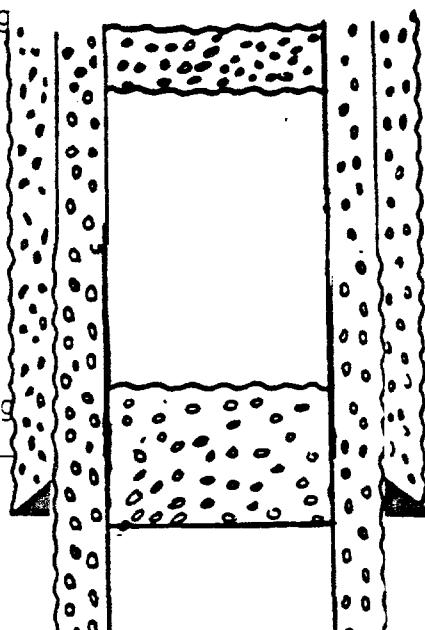

17 1/4" hole

13-3/8" @ 358 w/400 sx Cement cushioned

Pulled 1587' of 8-5/8" csg - Left 1901' in hole.

11" hole

8-5/8" @ 3470' w/300 sx

Estimated top cement 2000'

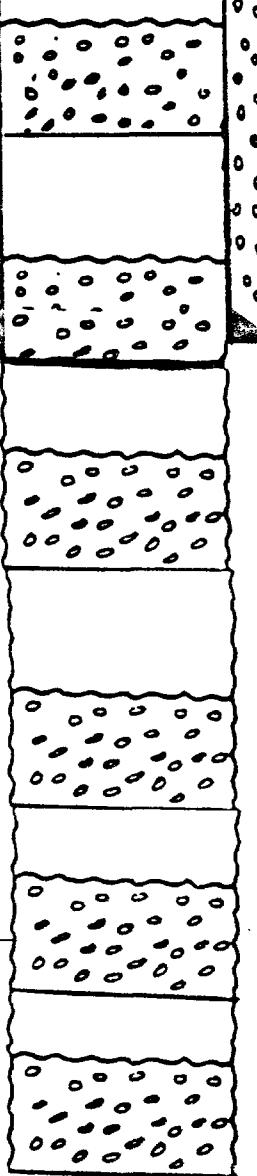


Exhibit -C- 5

Lone Star Producing Company

Atlantic State -B- #1

-H-, Sec. 30, T-17-S, R-36-E


15" hole

10-3/4" @ 406' w/350 sx Cement circulated

9 7/8" hole.

Cut 7-5/8" csg @ 1600' Pulled 50 jts

*Top cement by topo  
Survey @ 2500'*

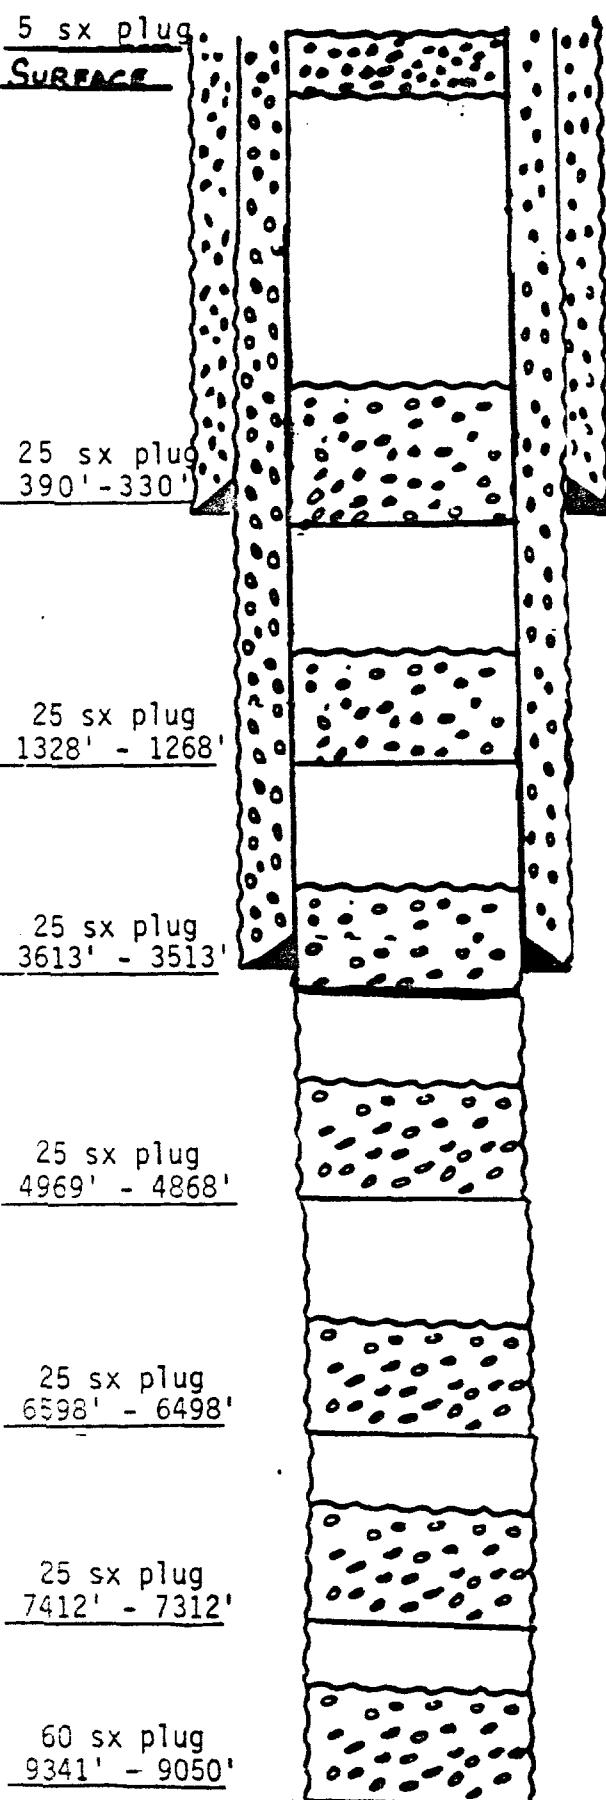


TD 9341'

Exhibit C-6

Lone Star Prod. Company

Gulf State #1

-M-, Sec. 20, T-17-S, R-36-E

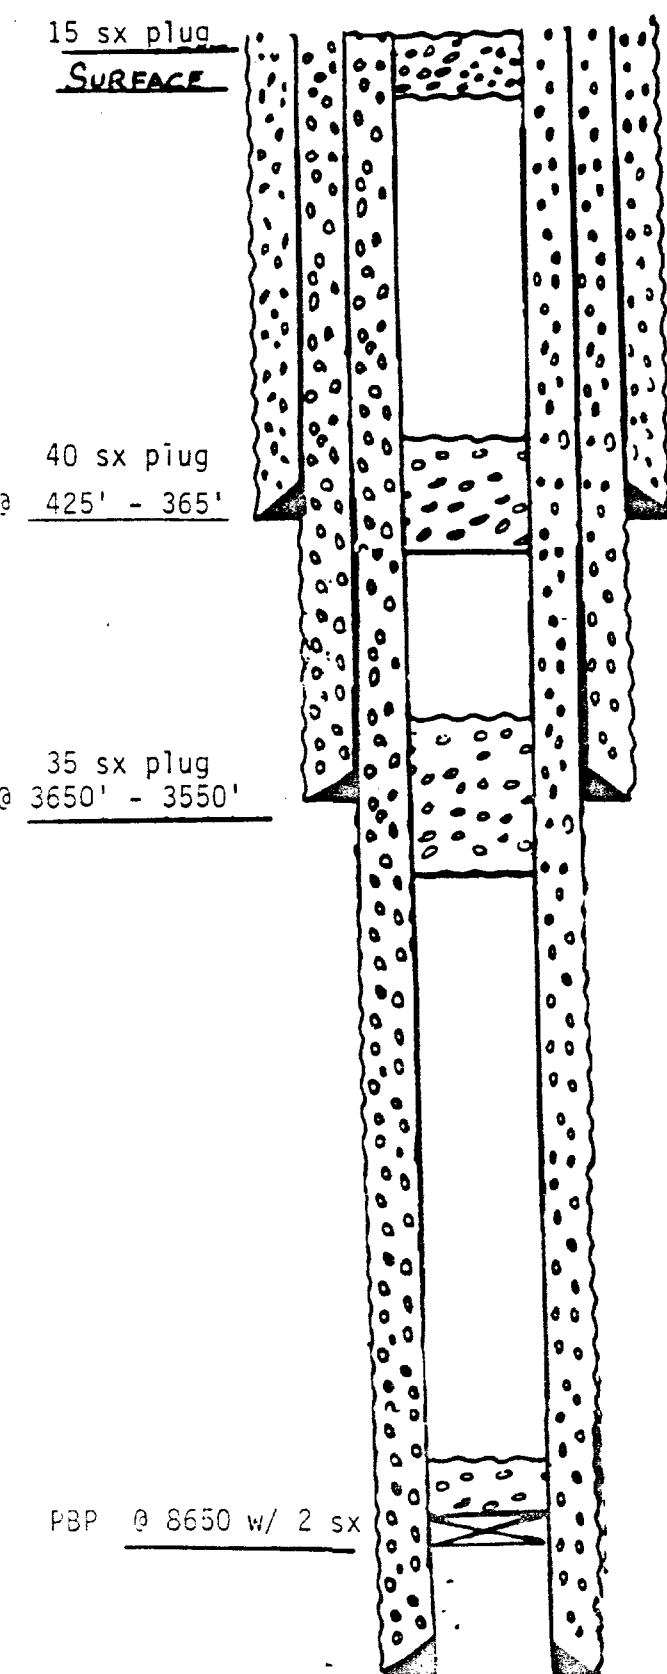

10-3/4" @ 395 w/325 sx

(Left in well.)

7-5/8" @ 3600' w/1112 sx

(7-5/8" 2500' - Left in well.)

Cut 4-1/2" @ 5050'

Left:

4243' of 4-1/2" csg in well

4-1/2" @ 9293 w/200 sx

TD 9322'

*Not applicable  
over 1/2 mile  
from injection well*

P O BOX 1468  
MONAHANS TEXAS 79556  
PH 943-3234 OR 563-1040

Martin Water Laboratories, Inc.

709 W INDIANA  
MIDLAND TEXAS 79701  
PHONE 683-4521

## RESULT OF WATER ANALYSES

To: Mr. Royce Boyce  
104 South Pecos, Midland, Texas

LABORATORY NO. 78665  
SAMPLE RECEIVED 7-8-86  
RESULTS REPORTED 7-10-86

COMPANY BTA Oil Producers LEASE Giles Lee  
FIRM VACUUM UNIT 1

FIELD SHEET NO. 29 BLOCK T17S SURVEY R36E COUNTY Lea STATE NM

SOURCE OF SAMPLE AND DATE TAKEN:

Raw water - taken from Giles Lee water well. 7-7-86

Permit No. L-8266(5)

REMARKS

CHEMICAL AND PHYSICAL PROPERTIES				
	NO. 1	NO. 2	NO. 3	NO. 4
Specific Gravity at 60° F.	1.0013			
pH After Sampled				
pH After Received	8.46			
B carbonat as $\text{HCO}_3$	117			
Supersaturation as $\text{CaCO}_3$				
Undersaturation as $\text{CaCO}_3$	- -			
Total hardness as $\text{CaCO}_3$	18			
Calcium as Ca	6			
Magnesium as Mg	0			
Sodium and/or Potassium	73			
Sulfate as $\text{SO}_4$	42			
Chloride as Cl	18			
Iron as Fe	3.7			
Barium as Ba				
Turbidity Electric				
Color as Pt				
Total Salts, Calculated	265			
Temperature °F.				
Carbon Dioxide, Calculated				
Dissolved Oxygen, Winkler				
Hydrogen Sulfide	0.0			
P-H at 60° F. mm/m at 77° F.	32.00			
Suspended Solids				
Filtrable Susp. as mg/l				
Volume F. Filtered, ml				

**Results Reported As Milligrams Per Liter**

*[Signature]* **Declarant's Name** **Date** **Declarant's Address** **Declarant's Relationship to Deceased**  
I, the undersigned, do solemnly declare and affirm that the above information is true and correct to the best of my knowledge and belief.

62 - 2001 - 3

WY 11-18 7-20-68

Waylan C. Martin, M. A.

P O BOX 1468  
AHANS TEXAS 79756  
43-3234 OR 563-1040

Martin Water Laboratories, Inc.

709 W INDIANA  
MIDLAND TEXAS 79701  
PHONE 683-4521

RESULT OF WATER ANALYSES

Ms. Dorothy Haughton  
South Pecos, Midland, Texas

LABORATORY NO. 78687  
SAMPLE RECEIVED 7-10-86  
RESULTS REPORTED 7-11-86

PANY BTA Oil Producers LEASE 8601 JV-P Buckeye  
LD OR POOL Vacuum Unit Ltr -D

TION 29 BLOCK T17S SURVEY R36E COUNTY Lea STATE NM

SOURCE OF SAMPLE AND DATE TAKEN:

D. 1 Raw water - taken from Nolan Brunson irrigation well. 7-7-86

D. 2

D. 3

D. 4

ARKS:

CHEMICAL AND PHYSICAL PROPERTIES

	NO. 1	NO. 2	NO. 3	NO. 4
Specific Gravity at 60° F.	1.0019			
When Sampled				
When Received	6.92			
Carbonate as HCO <sub>3</sub>	224			
Supersaturation as CaCO <sub>3</sub>				
Undersaturation as CaCO <sub>3</sub>				
Total Hardness as CaCO <sub>3</sub>	192			
Calcium as Ca	72			
Magnesium as Mg	3			
Chlorum and/or Potassium	38			
Sulfate as SO <sub>4</sub>	53			
Chloride as Cl	26			
Iron as Fe	0.08			
Boron as Ba				
Conductivity, Electric				
Gold as Pt				
Total Solids, Calculated	417			
Temperature °F.				
Carbon Dioxide, Calculated				
Dissolved Oxygen, Winkler				
Hydrogen Sulfide	0.0			
Electrolytic Conductivity ohms/m at 77° F.	22.50			
Dissolved O <sub>2</sub>				
Dissolved Solids as mg/l				
Volume = liter = ml				

Results Reported As Milligrams Per Liter

Additional Observations And Remarks The undersigned certifies the above to be true and correct  
the best of his knowledge and belief.

Exhibit D-1  
Martin Water Laboratories, Inc.

P O BOX 1468  
MONAHANS TEXAS 79756  
PH 943-3234 OR 563-1040

709 W INDIANA  
MIDLAND, TEXAS 79701  
PHONE 683-4521

**RESULT OF WATER ANALYSES**

TO: Mr. Steve Salmon  
104 South Pecos, Midland, Texas

LABORATORY NO. 1085221  
SAMPLE RECEIVED 10-15-85  
RESULTS REPORTED 10-18-85

COMPANY BTA Oil Producers

LEASE 8408 JV-P Turner #1

FIELD OR POOL Wildcat

Lower Kiamble - A- (Abo)

SECTION 21 BLOCK T-17-S SURVEY R-36-E

COUNTY Lea

STATE NM

SOURCE OF SAMPLE AND DATE TAKEN:

NO. 1 Pit sample. 10-13-85

NO. 2 Recovered water - middle. 10-13-85

NO. 3 Recovered water - bottom. 10-13-85

NO. 4 Recovered water - sampler. 10-13-85

REMARKS: DST #1 - Lower Abo - 9,220' - 9,240'

**CHEMICAL AND PHYSICAL PROPERTIES**

	NO. 1	NO. 2	NO. 3	NO. 4
Specific Gravity at 60° F.	1.0734	1.0736	1.0745	1.0739
pH When Sampled				
pH When Received	8.83	8.17	7.86	7.84
Bicarbonate as HCO <sub>3</sub>	-	183	415	451
Supersaturation as CaCO <sub>3</sub>				
Undersaturation as CaCO <sub>3</sub>				
Total Hardness as CaCO <sub>3</sub>	5,250	5,350	6,400	6,350
Calcium as Ca	1,780	1,760	2,060	2,020
Magnesium as Mg	194	231	304	316
Sodium and/or Potassium	36,996	36,101	36,008	35,929
Sulfate as SO <sub>4</sub>	6,114	6,063	5,962	5,760
Chloride as Cl	56,105	54,685	55,395	55,395
Iron as Fe	2.5	2.5	9.3	12.7
Barium as Ba				
Turbidity, Electric				
Color as Pt				
Total Solids, Calculated	101.408	99.303	100.180	99.859
Temperature °F.				
Carbon Dioxide, Calculated				
Dissolved Oxygen Winkler				
Hydrogen Sulfide	0.0	0.0	0.0	0.0
Resistivity, ohms/m at 77° F.	0.095	0.097	0.095	0.096
Suspended Oil				
Filtrable Solids as mg/l				
Volume Filtered, ml				
Carbonate, as CO <sub>3</sub>	36	48	0	0

Results Reported As Milligrams Per Liter

Additional Determinations And Remarks Sample from "top" - No water.

The above recovered waters appear to be pit water with no evidence of any influence from Abo formation water.

**Exhibit D-2**

## Martin Water Laboratories, Inc.

P O BOX 1468  
MONAHANS, TEXAS 79756  
PH 943-3234 OR 563-1040

709 W INDIANA  
MIDLAND, TEXAS 79701  
PHONE 683-4521

## RESULT OF WATER ANALYSES

To: Mr. Steve Salmon  
104 South Pecos, Midland, Texas 79701

LABORATORY NO. 386346

SAMPLE RECEIVED 3-31-86

RESULTS REPORTED 4-3-86

COMPANY BTA Oil Producers

LEASE Turner #2

EIELDORP 8001

## South Louisiana (Abo)

~~FIELD BOUNDARY~~ SECTION 21 BLOCK T-17-S SURVEY R-36-E

COUNTY \_\_\_\_\_ Le

— STATE — NM

SOURCE OF SAMPLE AND DATE TAKEN:

NO. 1 Pit sample, 3-29-86

NO. 2 Recovered water - top, 3-29-86

No. 1 Recovered water-bottom, 3-29-86

204

DST #1 - Abo #2 (Lower) = 9,260' - 9,360'

**REMARKS:**

## CHEMICAL AND PHYSICAL PROPERTIES

	NO. 1	NO. 2	NO. 3	NO. 4
Specific Gravity at 60° F.	1.0099	1.0091	1.0202	
pH When Sampled				
pH When Received	7.98	7.64	6.82	
Bicarbonate as $\text{HCO}_3$	1.976	1.147	1.147	
Supersaturation as $\text{CaCO}_3$				
Undersaturation as $\text{CaCO}_3$				
Total Hardness as $\text{CaCO}_3$	2,300	2,000	7,200	
Calcium as Ca	1,060	700	2,200	
Magnesium as Mg	61	61	413	
Sodium and/or Potassium	1,530	1,882	6,211	
Sulfate as $\text{SO}_4$	2,551	2,304	2,441	
Chloride as Cl	1,385	1,953	12,215	
Iron as Fe	12.7	2..	0.04	
Barium as Ba				
Turbidity, Electric				
Color as Pt				
Total Solids, Calculated	8,563	8,046	24,628	
Temperature °F.				
Carbon Dioxide, Calculated				
Dissolved Oxygen, Winkler				
Hydrogen Sulfide				
Resistivity, ohms/m at 77° F.	0.0	0.0	0.0	
Suspended Oil	0.940	0.900	0.320	
Filtrable Solids as mg/l				
Volume Filtered, ml				

**Results Reported As Milligrams Per Liter**

Additional Determinations And Remarks When we compare the above with our records in the area, we find the possibility that the bottom sample could involve as much as one half Abo water. However, this is assuming that there is no other source of higher salts from waters that might have been lost in this interval. Also, we would expect the Abo to carry a substantial amount of hydrogen sulfide, therefore placing additional doubt on the probability of a significant amount of Abo being involved in the bottom sample.

## Exhibit D-3

Martin Water Laboratories, Inc.

P O BOX 1468  
MONAHANS, TEXAS 79756  
PH 943-3234 OR 563-1040

708 W INDIANA  
MIDLAND, TEXAS 79701  
PHONE 683-4521

## RESULT OF WATER ANALYSES

TO: Mr. Steve Salmon  
104 South Pecos, Midland, Texas

LABORATORY NO. 386276  
SAMPLE RECEIVED 3-25-86  
RESULTS REPORTED 3-27-86

COMPANY BTA Oil Producers LEASE 8601-JVP Buckeye #1  
FIELD OR POOL Vacuum Grayburg-SA UNIT LETTER -D-  
SECTION 29 TOWNSHIP 17-S SURVEY R-36-E COUNTY Lea STATE NM

## SOURCE OF SAMPLE AND DATE TAKEN:

- NO. 1 Pit sample. 3-24-86  
NO. 2 Recovered water - middle. 3-24-86  
NO. 3 Recovered water - bottom. 3-24-86  
NO. 4 Recovered water - sampler. 3-24-86

REMARKS: DST #1 - San Andres - 5,050' - 5,090'

## CHEMICAL AND PHYSICAL PROPERTIES

	NO. 1	NO. 2	NO. 3	NO. 4
Specific Gravity at 60° F.	1.0088	1.0072	1.0091	1.0105
pH When Sampled				
pH When Received	10.34	6.98	6.77	6.96
Bicarbonate as $\text{HCO}_3^-$	49	927	1,159	927
Supersaturation as $\text{CaCO}_3$				
Supersaturation as $\text{CaCO}_3$				
Hardness as $\text{CaCO}_3$	1,115	1,830	2,350	2,550
Calcium as Ca	440	656	850	870
Magnesium as Mg	4	46	55	91
Sodium and/or Potassium	2,313	1,099	2,193	3,139
Sulfate as $\text{SO}_4^{2-}$	1,027	1,280	1,453	1,493
Chloride as Cl	3,444	1,509	3,302	5,007
Iron as Fe	3.4	1	1.7	1.7
Barium as Ba				
Turbidity, Electric				
Color as Pt				
Total Solids, Calculated	7,345	5,518	9,013	11,527
Temperature °F.				
Carbon Dioxide, Calculated				
Dissolved Oxygen, Winkler				
Hydrogen Sulfide	0.5	1,125	1,950	1,050
Resistivity, ohms/m at 77° F.	0.510	1.13	0.750	0.570
Suspended Oil				
Filtrable Solids as mg/l				
Volume Filtered, ml				
Carbonate, as $\text{CO}_3^{2-}$	103	0	0	0

Results Reported As Milligrams Per Liter

Additional Determinations And Remarks Sample from "top" - no water.

In comparing the above with our records in the immediate area, we find some concern in identifying the origin of the waters recovered in that there is only a relatively mild difference between the pit water and our San Andres water. Also, pit water can readily pick up hydrogen sulfide; therefore, we cannot rely on the high sulfide content. However, we do find some weak indicators herein that indicate the probability that the last water recovered is predominantly San Andres.