

UNITED STATES
DEPARTMENT OF THE INTERIOR
BUREAU OF LAND MANAGEMENTFORM APPROVED
OMB NO. 1004-0135
Expires: July 31, 2010**SUNDRY NOTICES AND REPORTS ON WELLS**
Do not use this form for proposals to drill or to re-enter an abandoned well. Use form 3160-3 (APD) for such proposals.

HOBBS OCD

5. Lease Serial No.
NMLC060329

6. If Indian, Allottee or Tribe Name

7. If Unit or CA/Agreement, Name and/or No.

SUBMIT IN TRIPLICATE - Other instructions on reverse side.

1. Type of Well

☒ Oil Well ☐ Gas Well ☐ Other

RECEIVED

8. Well Name and No.
HT 18 FEDERAL 005

2. Name of Operator

CIMAREX ENERGY CO. OF COLORADO

Contact: MICHELLE CHAPPELL

Email: mchappell@cimarex.com

9. API Well No.
30-025-39975

3a. Address

600 N. MARIENFELD STREET, SUITE 600
MIDLAND, TX 79701

3b. Phone No. (include area code)

Ph: 432-620-1959
Fx: 432-620-194010. Field and Pool, or Exploratory
MALJAMAR; YESO, WEST

4. Location of Well (Footage, Sec., T., R., M., or Survey Description)

Sec 18 T17S R32E SWNW 2310FNL 990FWL
32.835594 N Lat, 103.811281 W Lon

11. County or Parish, and State

LEA COUNTY, NM

12. CHECK APPROPRIATE BOX(ES) TO INDICATE NATURE OF NOTICE, REPORT, OR OTHER DATA

TYPE OF SUBMISSION	TYPE OF ACTION			
<input checked="" type="checkbox"/> Notice of Intent	<input type="checkbox"/> Acidize	<input type="checkbox"/> Deepen	<input type="checkbox"/> Production (Start/Resume)	<input type="checkbox"/> Water Shut-Off
<input type="checkbox"/> Subsequent Report	<input type="checkbox"/> Alter Casing	<input type="checkbox"/> Fracture Treat	<input checked="" type="checkbox"/> Reclamation	<input type="checkbox"/> Well Integrity
<input type="checkbox"/> Final Abandonment Notice	<input type="checkbox"/> Casing Repair	<input type="checkbox"/> New Construction	<input type="checkbox"/> Recomplete	<input type="checkbox"/> Other
	<input type="checkbox"/> Change Plans	<input type="checkbox"/> Plug and Abandon	<input type="checkbox"/> Temporarily Abandon	
	<input type="checkbox"/> Convert to Injection	<input type="checkbox"/> Plug Back	<input type="checkbox"/> Water Disposal	

13. Describe Proposed or Completed Operation (clearly state all pertinent details, including estimated starting date of any proposed work and approximate duration thereof. If the proposal is to deepen directionally or recomplete horizontally, give subsurface locations and measured and true vertical depths of all pertinent markers and zones. Attach the Bond under which the work will be performed or provide the Bond No. on file with BLM/BIA. Required subsequent reports shall be filed within 30 days following completion of the involved operations. If the operation results in a multiple completion or recompletion in a new interval, a Form 3160-4 shall be filed once testing has been completed. Final Abandonment Notices shall be filed only after all requirements, including reclamation, have been completed, and the operator has determined that the site is ready for final inspection.)

Cimarex Energy Co. of Colorado respectfully requests the approval for the attached "As Built" Battery Diagram for the HT 18 Federal 5. We also request your approval to change the interim reclamation plan. We intend to begin interim reclamation as soon as approval has been received.

Please find attached the following diagrams:

Approved rig diagram

Approved original interim reclamation plan

Proposed "As Built" Battery/ proposed interim reclamation plan

14. I hereby certify that the foregoing is true and correct.

**Electronic Submission #200709 verified by the BLM Well Information System
For CIMAREX ENERGY CO. OF COLORADO, sent to the Hobbs**

Name (Printed/Typed) MICHELLE CHAPPELL

Title REGULATORY TECHNICIAN

Signature (Electronic Submission)

Date 03/05/2013

THIS SPACE FOR FEDERAL OR STATE OFFICE USE

Approved By

Title

Date

Conditions of approval, if any, are attached. Approval of this notice does not warrant or certify that the applicant holds legal or equitable title to those rights in the subject lease which would entitle the applicant to conduct operations thereon.


Office

Title 18 U.S.C. Section 1001 and Title 43 U.S.C. Section 1212, make it a crime for any person knowingly and willfully to make to any department or agency of the United States any false, fictitious or fraudulent statements or representations as to any matter within its jurisdiction.

**** OPERATOR-SUBMITTED ** OPERATOR-SUBMITTED ** OPERATOR-SUBMITTED ****

MAR 19 2013

Silver Oak #3

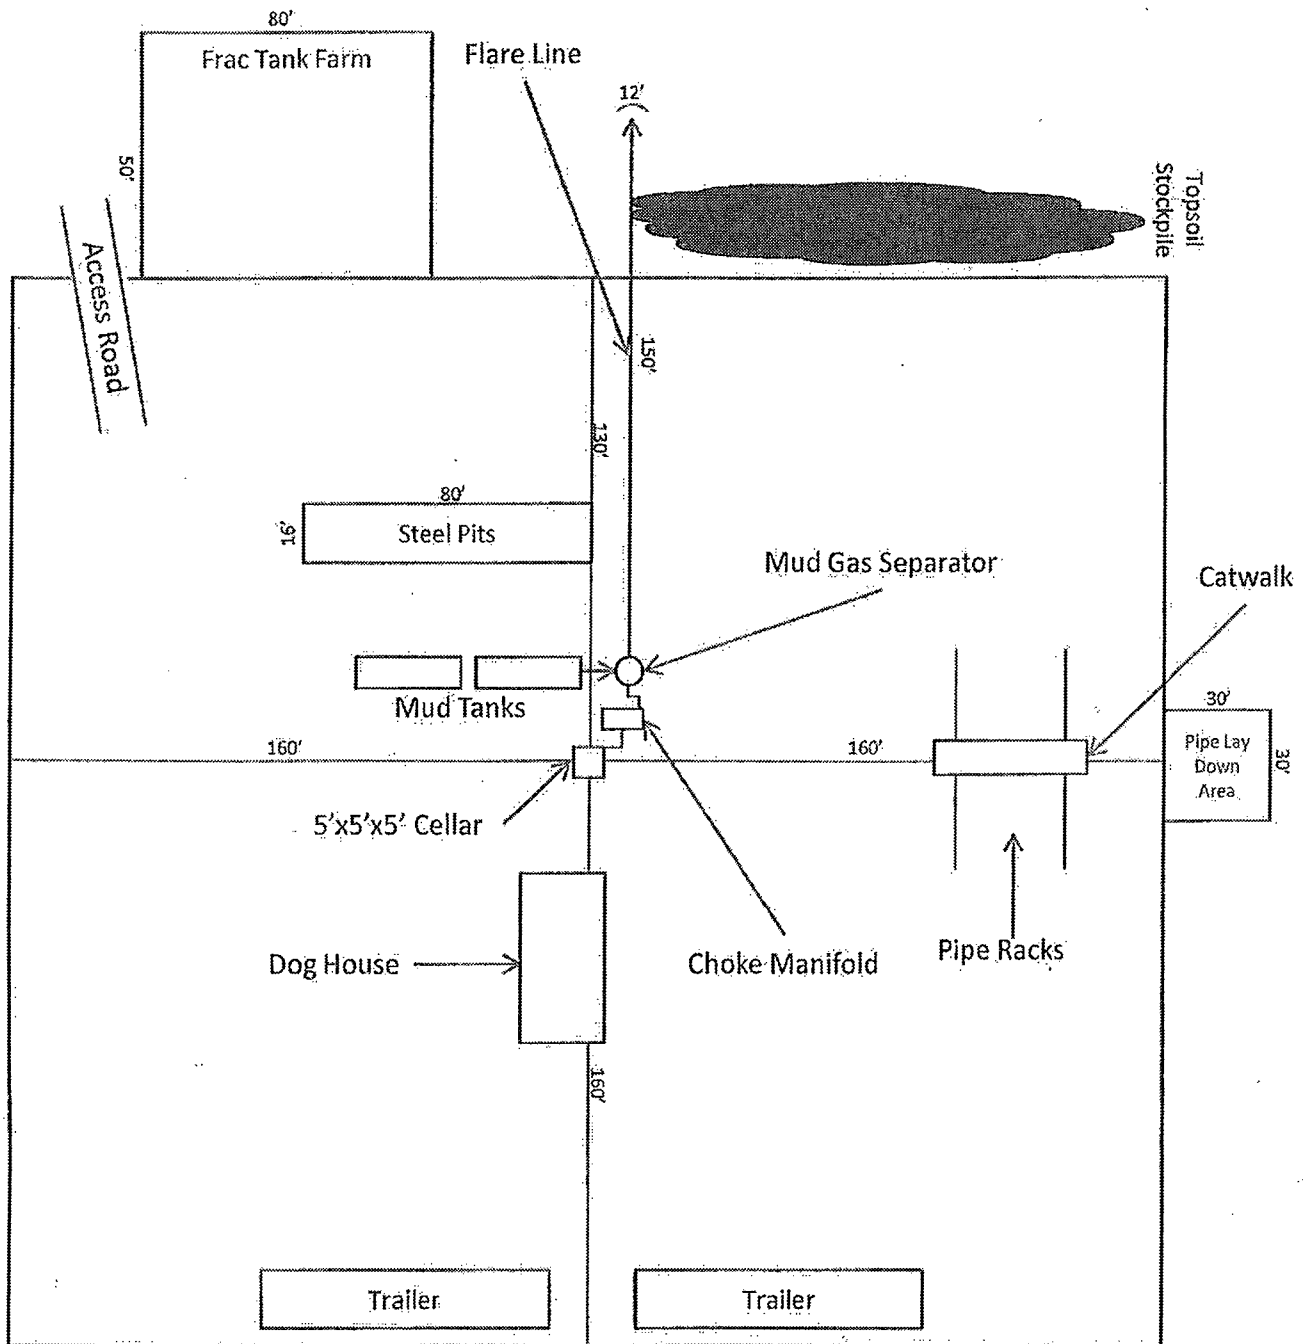

1"=50'

Exhibit D – Rig Diagram
HT Federal No. 5
 Cimarex Energy Co. of Colorado
 18-17S-32E
 2310 FNL & 990 FWL
 Lea County, NM




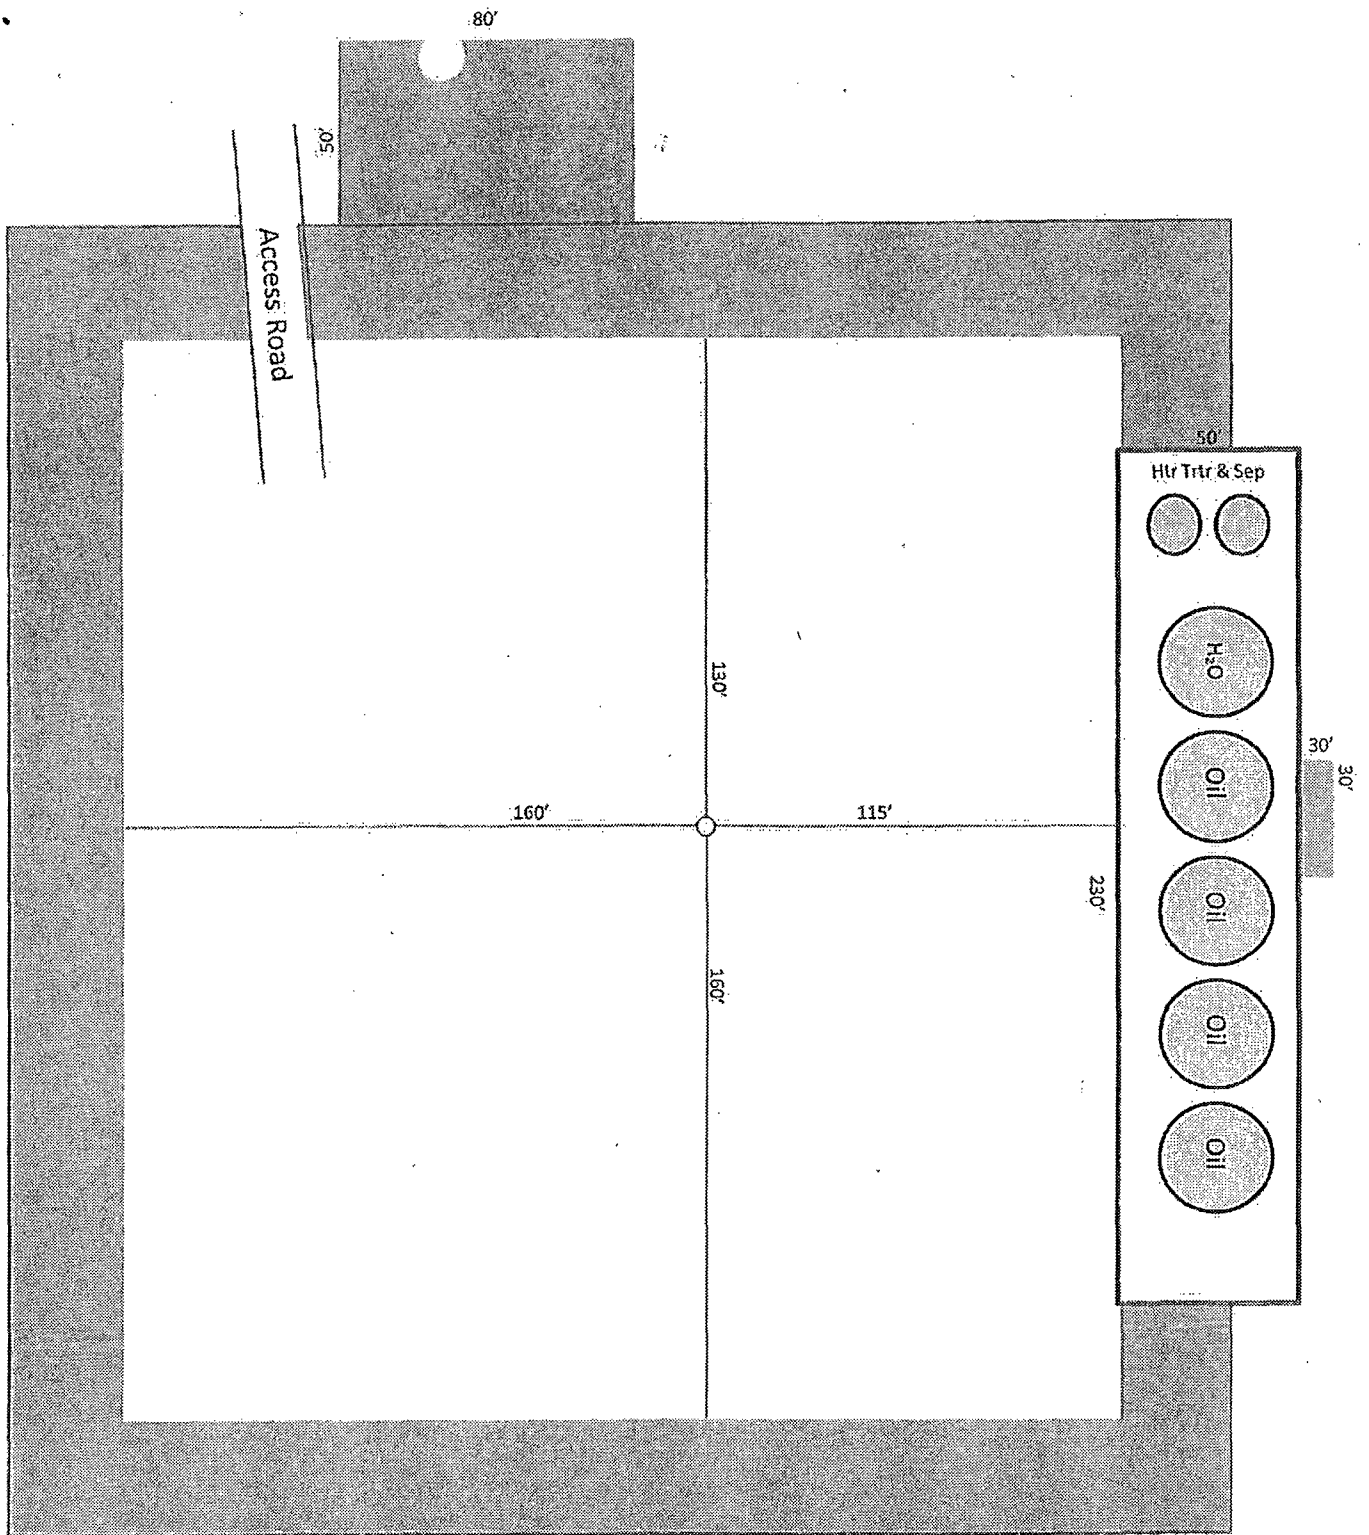


Exhibit D-1
HT Federal No. 5
 Cimarex Energy Co. of Colorado
 18-17S-32E
 2310 FNL & 990 FWL
 Lea County, NM

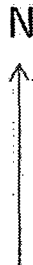

1"=50'

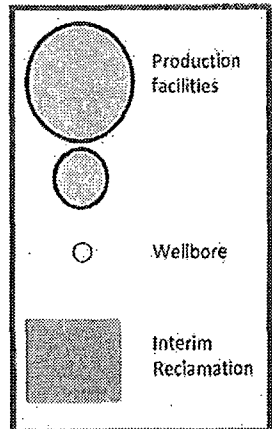

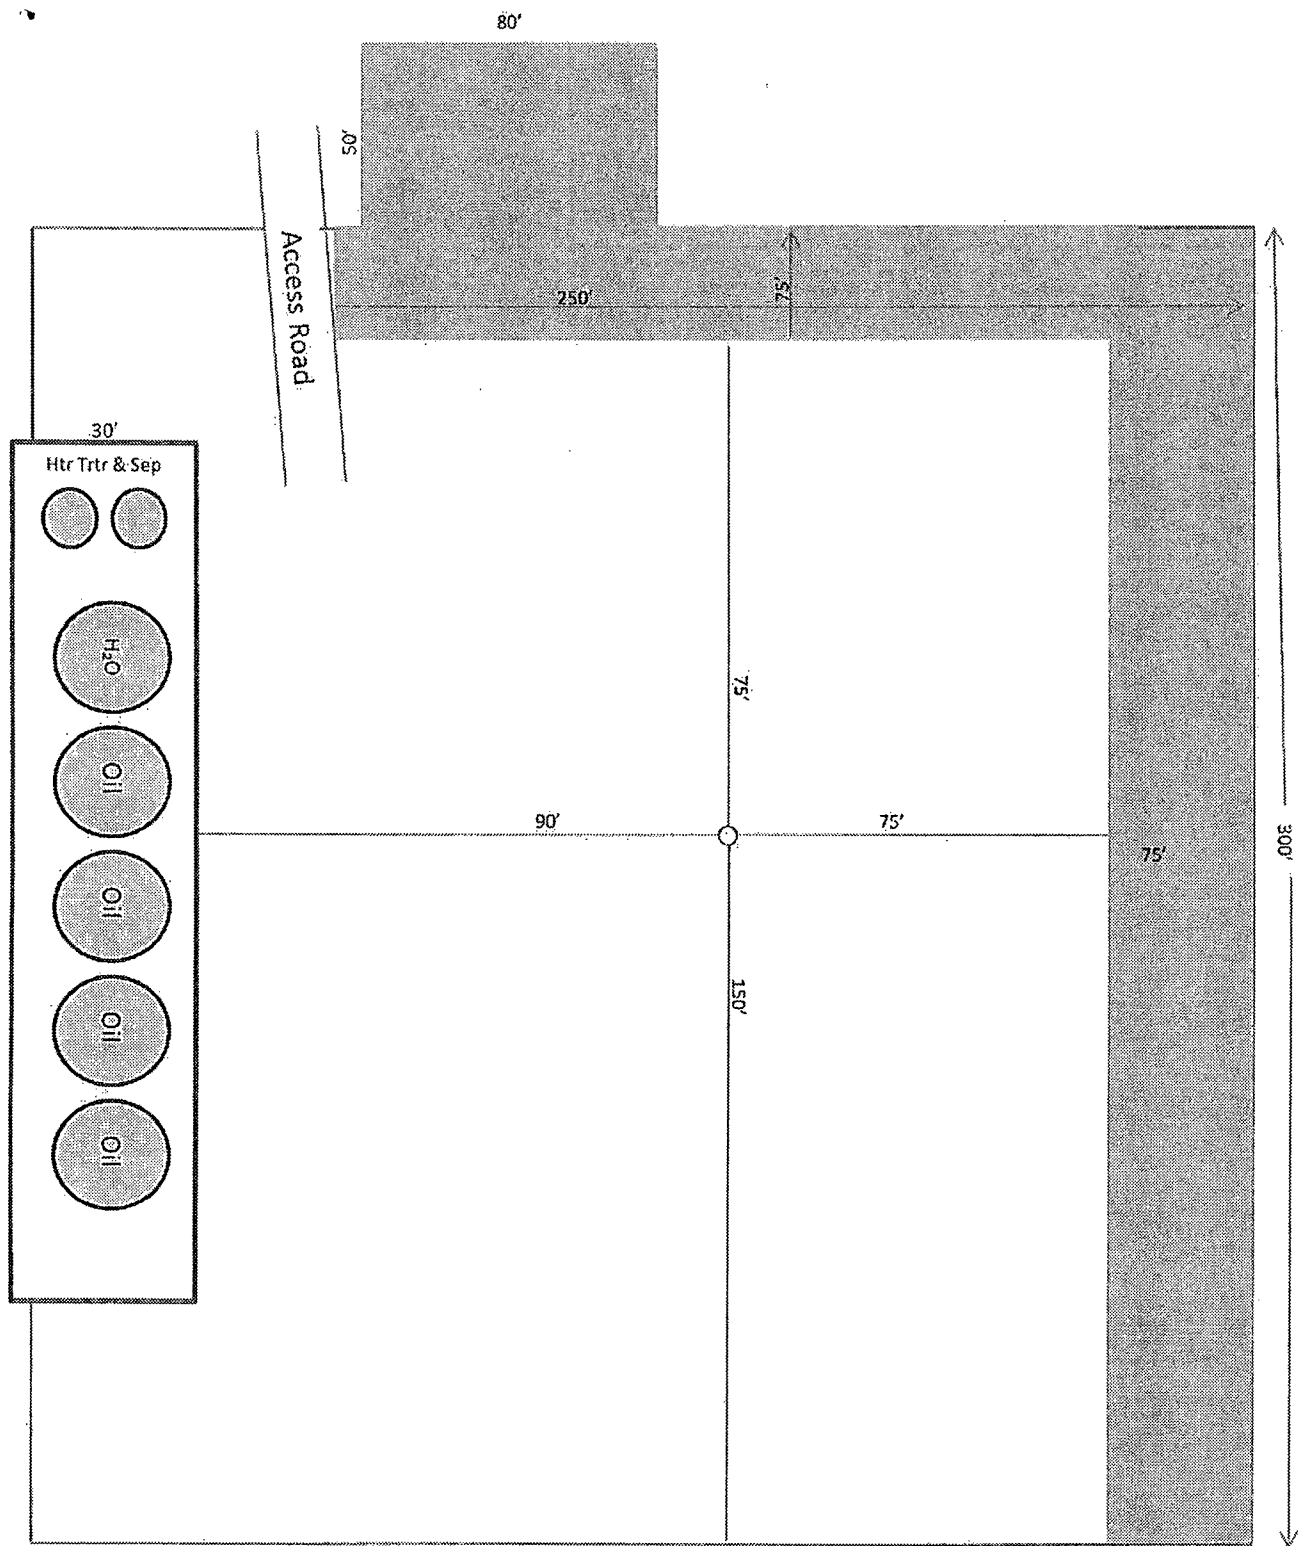

As Built Battery Diagram and
Proposed Interim Reclaim
HT 18 Federal No. 5
Cimarex Energy Co. of Colorado
18-17S-32E
2310 FNL & 990 FWL
Lea County, NM



1"=50'

