

UNITED STATES
DEPARTMENT OF THE INTERIOR
BUREAU OF LAND MANAGEMENT

FORM APPROVED
OMB NO. 1004-0135
Expires: July 31, 2010

SUNDRY NOTICES AND REPORTS ON WELLS
Do not use this form for proposals to drill or to re-enter an abandoned well. Use form 3160-3 (APD) for such proposals.

OCD
HOBBS
APR 17 2017
RECEIVED

5. Lease Serial No.
NMNM0359292

6. If Indian, Allottee or Tribe Name

7. If Unit or CA/Agreement, Name and/or No.

SUBMIT IN TRIPLICATE - Other instructions on reverse side.

1. Type of Well

☒ Oil Well ☐ Gas Well ☐ Other

8. Well Name and No.
GOEDEKE 2

2. Name of Operator
RKI EXP & PROD, LLC

Contact: JESSICA M DEMARCE
E-Mail: jessica.demarce@wpenergy.com

9. API Well No.
30-025-08407

3a. Address
3500 ONE WILLIAMS CENTER MD35
TULSA, OK 74172

3b. Phone No. (include area code)
Ph: 539-573-3521

10. Field and Pool, or Exploratory
SALADO DRAW; DELAWARE

4. Location of Well (Footage, Sec., T., R., M., or Survey Description)
Sec 10 T26S R33E 1980FNL 1980FEL

11. County or Parish, and State
LEA COUNTY COUNTY, NM

12. CHECK APPROPRIATE BOX(ES) TO INDICATE NATURE OF NOTICE, REPORT, OR OTHER DATA

TYPE OF SUBMISSION	TYPE OF ACTION			
<input type="checkbox"/> Notice of Intent	<input type="checkbox"/> Acidize	<input type="checkbox"/> Deepen	<input type="checkbox"/> Production (Start/Resume)	<input type="checkbox"/> Water Shut-Off
<input checked="" type="checkbox"/> Subsequent Report	<input type="checkbox"/> Alter Casing	<input type="checkbox"/> Fracture Treat	<input type="checkbox"/> Reclamation	<input type="checkbox"/> Well Integrity
<input type="checkbox"/> Final Abandonment Notice	<input type="checkbox"/> Casing Repair	<input type="checkbox"/> New Construction	<input type="checkbox"/> Recomplete	<input checked="" type="checkbox"/> Other
	<input type="checkbox"/> Change Plans	<input type="checkbox"/> Plug and Abandon	<input type="checkbox"/> Temporarily Abandon	Site Facility Diagram/Security Plan
	<input type="checkbox"/> Convert to Injection	<input type="checkbox"/> Plug Back	<input type="checkbox"/> Water Disposal	

13. Describe Proposed or Completed Operation (clearly state all pertinent details, including estimated starting date of any proposed work and approximate duration thereof. If the proposal is to deepen directionally or recompleat horizontally, give subsurface locations and measured and true vertical depths of all pertinent markers and zones. Attach the Bond under which the work will be performed or provide the Bond No. on file with BLM/BIA. Required subsequent reports shall be filed within 30 days following completion of the involved operations. If the operation results in a multiple completion or recompleat in a new interval, a Form 3160-4 shall be filed once testing has been completed. Final Abandonment Notices shall be filed only after all requirements, including reclamation, have been completed, and the operator has determined that the site is ready for final inspection.)

SFD DATED 8/10/2016 ABSM DATED 8/10/2016 ATTACHED

ENTERED 2/5/17
INTO AFMSS

Accepted for Record Purposes.
Approval Subject to Onsite Inspection.
Date: 2/5/17

14. I hereby certify that the foregoing is true and correct.

Electronic Submission #349041 verified by the BLM Well Information System
For RKI EXP & PROD, LLC, sent to the Hobbs
Committed to AFMSS for processing by DEBORAH MCKINNEY on 09/01/2016 ()

Name (Printed/Typed) JESSICA M DEMARCE

Title REGULATORY TECH

Signature (Electronic Submission)

Date 08/25/2016

THIS SPACE FOR FEDERAL OR STATE OFFICE USE

Approved By

[Signature]

Title

EPS LUE

Date

2/5/17

Conditions of approval, if any, are attached. Approval of this notice does not warrant or certify that the applicant holds legal or equitable title to those rights in the subject lease which would entitle the applicant to conduct operations thereon.

Office


CFO

Title 18 U.S.C. Section 1001 and Title 43 U.S.C. Section 1212, make it a crime for any person knowingly and willfully to make to any department or agency of the United States any false, fictitious or fraudulent statements or representations as to any matter within its jurisdiction.

**** OPERATOR-SUBMITTED ** OPERATOR-SUBMITTED ** OPERATOR-SUBMITTED ****

Ko


Accepted for Record Purposes.
Approved Subject to Onsite Inspection.

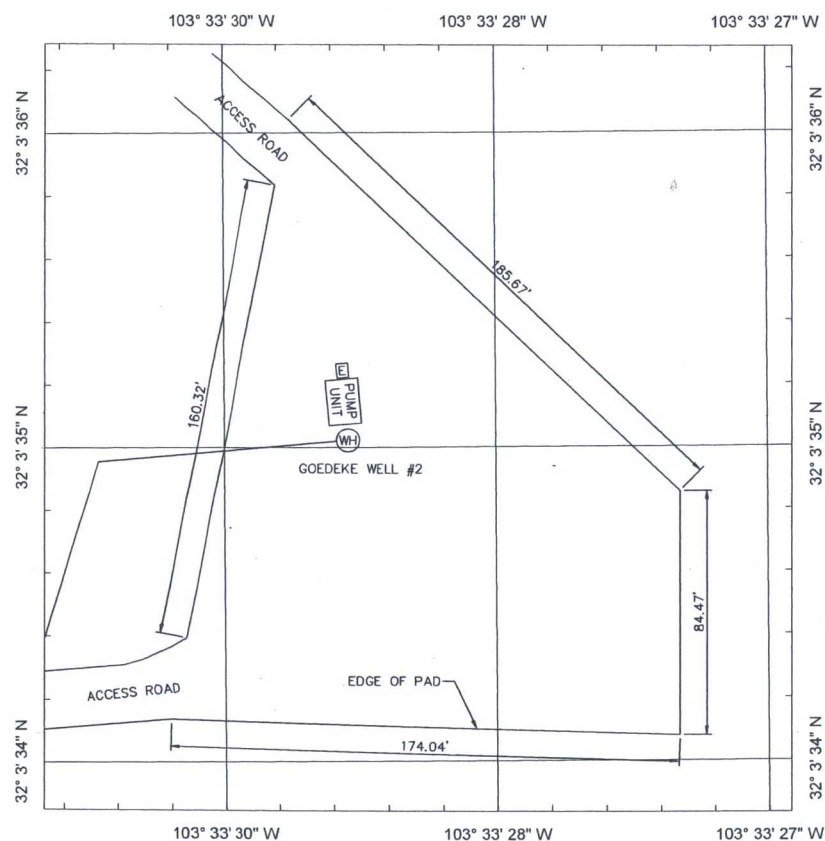

GOEDEKE WELL #2
1"=40'

LEGEND	
UG	UNDERGROUND
AG	ABOVE GROUND
UP	UTILITY POLE
E	ELECTRICAL PANEL/BOX
SP	SOLAR PANEL
GEN	GENERATOR
	OVERHEAD POWER LINE
	ELECTRIC LINE (UG)
	ELECTRIC LINE (AG)
----	OIL FLOWLINE (UG)
----	OIL FLOWLINE (AG)
----	RECYCLE FLOWLINE (UG)
----	RECYCLE FLOWLINE (AG)
----	WATER FLOWLINE (UG)
----	WATER FLOWLINE (AG)
----	GAS FLOWLINE (UG)
----	GAS FLOWLINE (AG)
----	UNKNOWN FLOWLINE (UG)
----	UNKNOWN FLOWLINE (AG)
	EDGE OF PAD
○	FENCE
(FWKO)	FREE WATER KNOCKOUT
(O)	LOAD OUT VALVE (OIL)
(W)	LOAD OUT VALVE (WATER)
MTR	METER
PU	PUMPING UNIT
RP	RECYCLE PUMP
SP	SEPARATOR
(O)	TANK (OIL)
(W)	TANK (WATER)
BLDG	BUILDING
(C)	COMBUSTOR
(H)	HEATER TREATER
F	FLARE
FS	FLARE SEPARATOR
WH	WELLHEAD
SC	SURVEY CONTROL POINT
Δ	WELD
R(*)	RISER (SIZE)
	STAIRS
TP	TRANSFER PUMP

[illegible]

	SHED NO.	GOEDEKE WELL #2
	SHED LID	—
	PANEL TYPE	WELL SITE
	SHED LID	—
CONSTRUCTION	BOULE	1" = 40'
SPECIAL CO. WPX ENERGY		SPICE NO.
TYPE AS-BUILT SITE MAP		
STATE ICA COUNTY NEW MEXICO	CLASS —	FILE NO. AB5M-01

