

DISTRICT I  
1625 N. FRENCH DR., HOBBS, NM 88240  
Phone: (575) 393-6161 Fax: (575) 393-0720

DISTRICT II  
811 S. FIRST ST., ARTESIA, NM 88210  
Phone: (575) 748-1283 Fax: (575) 748-9720

DISTRICT III  
1000 RIO BRAZOS RD., AZTEC, NM 87410  
Phone: (505) 334-6178 Fax: (505) 334-6170

DISTRICT IV  
1220 S. ST. FRANCIS DR., SANTA FE, NM 87505  
Phone: (505) 476-3460 Fax: (505) 476-3462

State of New Mexico  
Energy, Minerals & Natural Resources Department  
**OIL CONSERVATION DIVISION**  
1220 SOUTH ST. FRANCIS DR.  
Santa Fe, New Mexico 87505

Form C-102  
Revised August 1, 2011  
Submit one copy to appropriate  
District Office

☒ AMENDED REPORT

**WELL LOCATION AND ACREAGE DEDICATION PLAT**

API Number 30-025-45274	Pool Code 98098	Pool Name WC-025 G-09 S243532M; WOLFBONE
Property Code 322742	Property Name FEZ FEDERAL COM	Well Number 601H
OGRID No. 229137	Operator Name COG OPERATING, LLC	Elevation 3243.9'

**Surface Location**

UL or lot No.	Section	Township	Range	Lot Idn	Feet from the	North/South line	Feet from the	East/West line	County
N	9	25-S	35-E		280	SOUTH	1750	WEST	LEA

**Bottom Hole Location If Different From Surface**


UL or lot No.	Section	Township	Range	Lot Idn	Feet from the	North/South line	Feet from the	East/West line	County
3	4	25-S	35-E		205	NORTH	2225	WEST	LEA

Dedicated Acres 641.72	Joint or Infill	Consolidation Code	Order No.
---------------------------	-----------------	--------------------	-----------


NO ALLOWABLE WILL BE ASSIGNED TO THIS COMPLETION UNTIL ALL INTERESTS HAVE BEEN CONSOLIDATED  
OR A NON-STANDARD UNIT HAS BEEN APPROVED BY THE DIVISION

SEE PAGE 2

Property Code 322742	Property Name FEZ FEDERAL COM	Well Number 601H
OGRID No. 229137	Operator Name COG OPERATING, LLC	Elevation 3243.9'

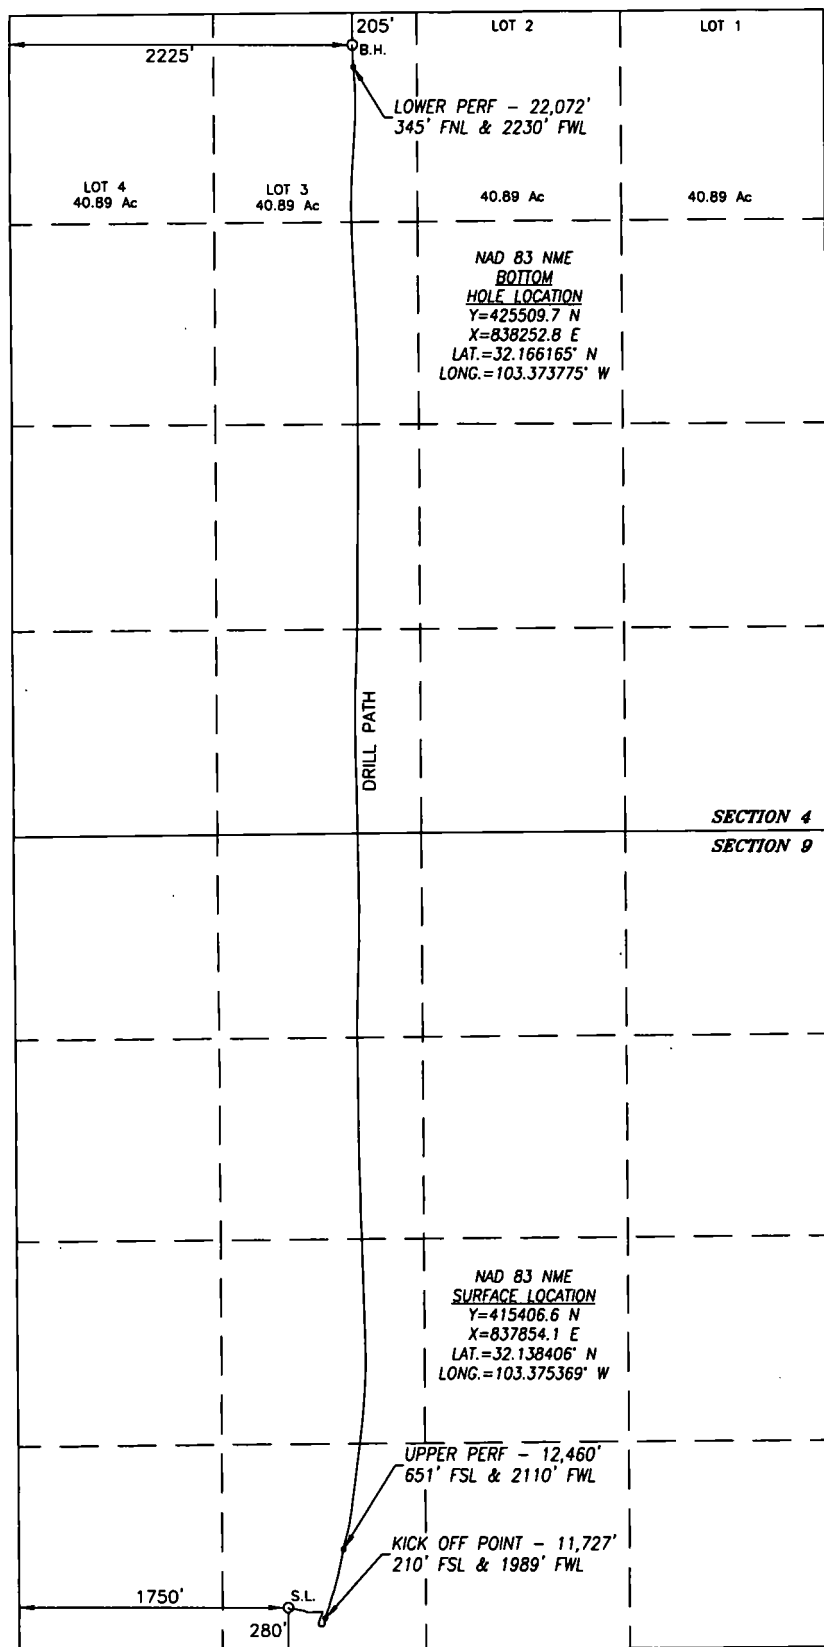

SURFACE INFO AND BOREPATH SHOWN HEREON  
IS BASED ON DIRECTIONAL SURVEY REPORT  
PROVIDED BY COG OPERATING, LLC FOR THE  
FEZ FEDERAL COM #601H SUPPLIED TO  
HARCROW SURVEYING, LLC ON NOVEMBER 15,  
2019

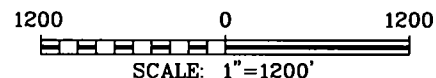

#### OPERATOR CERTIFICATION

I hereby certify that the information  
herein is true and complete to the best of  
my knowledge and belief, and that this  
organization either owns a working interest  
or unleased mineral interest in the land  
including the proposed bottom hole location  
or has a right to drill this well at this  
location pursuant to a contract with an  
owner of such mineral or working interest,  
or to a voluntary pooling agreement or a  
compulsory pooling order heretofore entered  
by the division.

*Amanda Avery* 12/2/19  
Signature Date

Amanda Avery

Printed Name

aavery@concho.com

E-mail Address

#### SURVEYOR CERTIFICATION

I hereby certify that the well location  
shown on this plat was plotted from field  
notes of actual surveys made by me or  
under my supervision, and that the same is  
true and correct to the best of my belief.

DEC. 4, 2017/MAR. 1, 2019

Date of Survey/Date of Geographic Survey

Signature & Seal of Professional Surveyor



*Chad Harcrow* 11/25/19  
Signature Date

Certificate No. CHAD HARCROW 17777

PAGE 2 OF 2 W.O. #19-2170 DRAWN BY: WN

Intent ☐ As Drilled ☒

API #  
30-025-45274

Operator Name: COG OPERATING, LLC	Property Name: FEZ FEDERAL COM	Well Number 601H
--------------------------------------	-----------------------------------	---------------------

Kick Off Point (KOP)

UL N	Section 9	Township 25S	Range 35E	Lot	Feet 210	From N/S SOUTH	Feet 1989	From E/W WEST	County LEA
Latitude 32.138214					Longitude -103.374598			NAD 83	

First Take Point (FTP)

UL N	Section 9	Township 25S	Range 35E	Lot	Feet 651	From N/S SOUTH	Feet 2110	From E/W WEST	County LEA
Latitude 32.139424					Longitude -103.374205			NAD 83	

Last Take Point (LTP)

UL 3	Section 4	Township 25S	Range 35E	Lot	Feet 345	From N/S NORTH	Feet 2230	From E/W WEST	County LEA
Latitude 32.165778					Longitude -103.373775			NAD 83	

Is this well the defining well for the Horizontal Spacing Unit? ☐ No

Is this well an infill well? ☐ Yes

If infill is yes please provide API if available, Operator Name and well number for Defining well for Horizontal Spacing Unit.

API #  
30-025-45275

Operator Name: COG Operating LLC	Property Name: Fez Federal Com	Well Number 602H
-------------------------------------	-----------------------------------	---------------------

KZ 06/29/2018