DISTRICT II 811 S. FIRST ST., ARTESIA, NM 88210 Phone: (575) 748-1283 Fax: (575) 748-9720

State of New Mexico DISTRICT I
1625 N. PRENCH DR., HOBBS, NM 88240
Phone: (675) 893-6161 Pax: (676) 893-0720

Energy, Minerals & Natural Resources Department OIL CONSERVATION DIVISION

1220 SOUTH ST. FRANCIS DR. Santa Fe, New Mexico 87505

Form C-102 Revised August 1, 2011 Submit one copy to appropriate District Office

AMENDED REPORT

DISTRICT III 1000 RIO BRAZOS RD., AZTEC, NM 87410 Phone: (505) 334-6178 Fax: (505) 334-6170

DISTRICT IV 1220 S. ST. FRANCIS DR., SANTA FE, NM 67505 Phone: (505) 476-3460 Fax: (505) 476-3462

WELL LOCATION AND ACREAGE DEDICATION PLAT

API Number	Pool Code Pool Name			
30-025-45331	98098	WC-025 G-09 S243532M;	WOLFBONE	
Property Code	Prop	erty Name	Well Number	
322742	FEZ FE	DERAL COM	604H	
OGRID No.	Oper	ator Name	Elevation	
229137	COG OPE	RATING, LLC	3262.9'	

Surface Location

UL or lo	t No.	Section	Township	Range	Lot Idn	Feet from the	North/South line	Feet from the	East/West line	County
M		9	25-S	35-E		280	SOUTH	450	WEST	LEA

Bottom Hole Location If Different From Surface


UL or lot No.	Section	Township	Range	Lot Idn	Feet from the	North/South line	Feet from the	East/West line	County
4	4	25-S	3.5-E		201	NORTH	342	WEST	LEA
Dedicated Acre	s Joint o	r Infill C	onsolidation (Code Or	der No.				
641.72									

NO ALLOWABLE WILL BE ASSIGNED TO THIS COMPLETION UNTIL ALL INTERESTS HAVE BEEN CONSOLIDATED OR A NON-STANDARD UNIT HAS BEEN APPROVED BY THE DIVISION

HOBBS OCD RECEIVED

SEE PAGE 2

PAGE 1 OF 2 W.O. #19-2173 DRAWN BY: WN

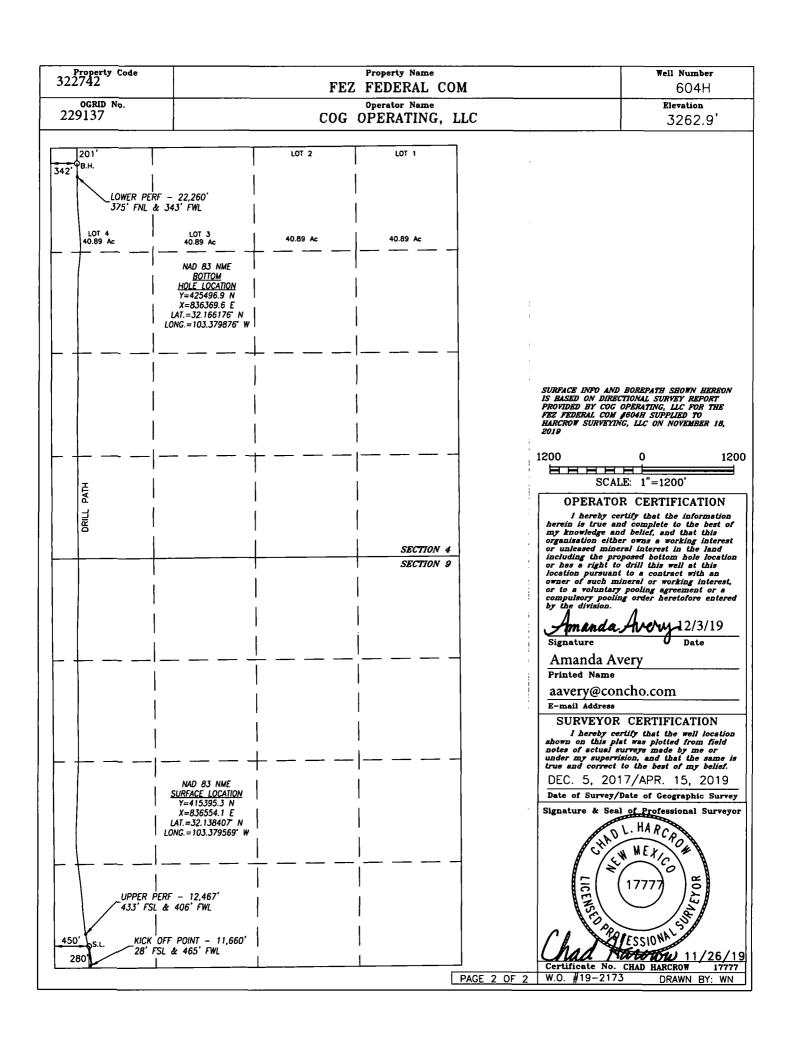

Intent As Drilled X									
API # 30-025-45331									
Operator Name: COG OPERATING, LLC	Property Name: FEZ FEDERAL COM	Well Number 604H							
Kick Off Point (KOP)									
	Feet From N/S Feet From E/W Cour 28 SOUTH 465 WEST LEA								
12.137714	Longitude -103.379521 NAD 83								
First Take Point (FTP)	First Take Point (FTP)								
	Feet From N/S Feet From E/W Cour 433 SOUTH 406 WEST LEA	•							
Latitude 32.138828	Longitude NAD -103.379712 83								
Last Take Point (LTP)									
1 1 1 1 1	Feet From N/S Feet From E/W County NORTH 343 WEST LEA								
132.165698	Longitude -103.379872 83								
Is this well the defining well for the Horizontal Spacing Unit? No									
Is this well an infill well? Yes									
If infill is yes please provide API if available, Operator Name and well number for Defining well for Horizontal Spacing Unit. API #									
30-025-45275									
Operator Name: COG Operating LLC	Property Name: Fez Federal Com	Well Number 604H							

KZ 06/29/2018