

DISTRICT I
1625 N. FRENCH DR., HOBBS, NM 88240
Phone: (505) 393-8181 Fax: (505) 393-0720

DISTRICT II
811 S. FIRST ST., ARTESIA, NM 88210
Phone: (505) 748-1283 Fax: (505) 748-9720

DISTRICT III
1000 RIO BRAZOS RD., AZTEC, NM 87410
Phone: (505) 334-8178 Fax: (505) 334-8170

DISTRICT IV
1220 S. ST. FRANCIS DR., SANTA FE, NM 87505
Phone: (505) 476-3460 Fax: (505) 476-3462

HOBBS OGD

OIL CONSERVATION DIVISION

JAN 15 2020
1220 SOUTH ST. FRANCIS DR.
Santa Fe, New Mexico 87505

RECEIVED

State of New Mexico

Minerals & Natural Resources Department

Form C-102

Revised August 1, 2011

Submit one copy to appropriate

District Office

☒ AMENDED REPORT

As Drilled

WELL LOCATION AND ACREAGE DEDICATION PLAT

API Number 30-025-45280 ✓	Pool Code 98098	Pool Name WC-025 G-09 S243532M; WOLFBONE ✓
Property Code 322742	Property Name FEZ FEDERAL COM ✓	Well Number 704H ✓
OGRID No. 229137 ✓	Operator Name COG OPERATING, LLC ✓	Elevation 3260.3'

Surface Location

UL or lot No.	Section	Township	Range	Lot Idn	Feet from the	North/South line	Feet from the	East/West line	County
M	9	25-S	35-E		280	SOUTH	480	WEST	LEA ✓

Bottom Hole Location If Different From Surface

UL or lot No.	Section	Township	Range	Lot Idn	Feet from the	North/South line	Feet from the	East/West line	County
4	4	25-S	35-E		206	NORTH	959	WEST	LEA

Dedicated Acres 641.72	Joint or Infill	Consolidation Code	Order No.
---------------------------	-----------------	--------------------	-----------

NO ALLOWABLE WILL BE ASSIGNED TO THIS COMPLETION UNTIL ALL INTERESTS HAVE BEEN CONSOLIDATED
OR A NON-STANDARD UNIT HAS BEEN APPROVED BY THE DIVISION


SEE PAGE 2

PAGE 1 OF 2


W.O. #19-2176

DRAWN BY: WN

Property Code 322742	Property Name FEZ FEDERAL COM	Well Number 704H
OGRID No. 229137	Operator Name COG OPERATING, LLC	Elevation 3260.3'

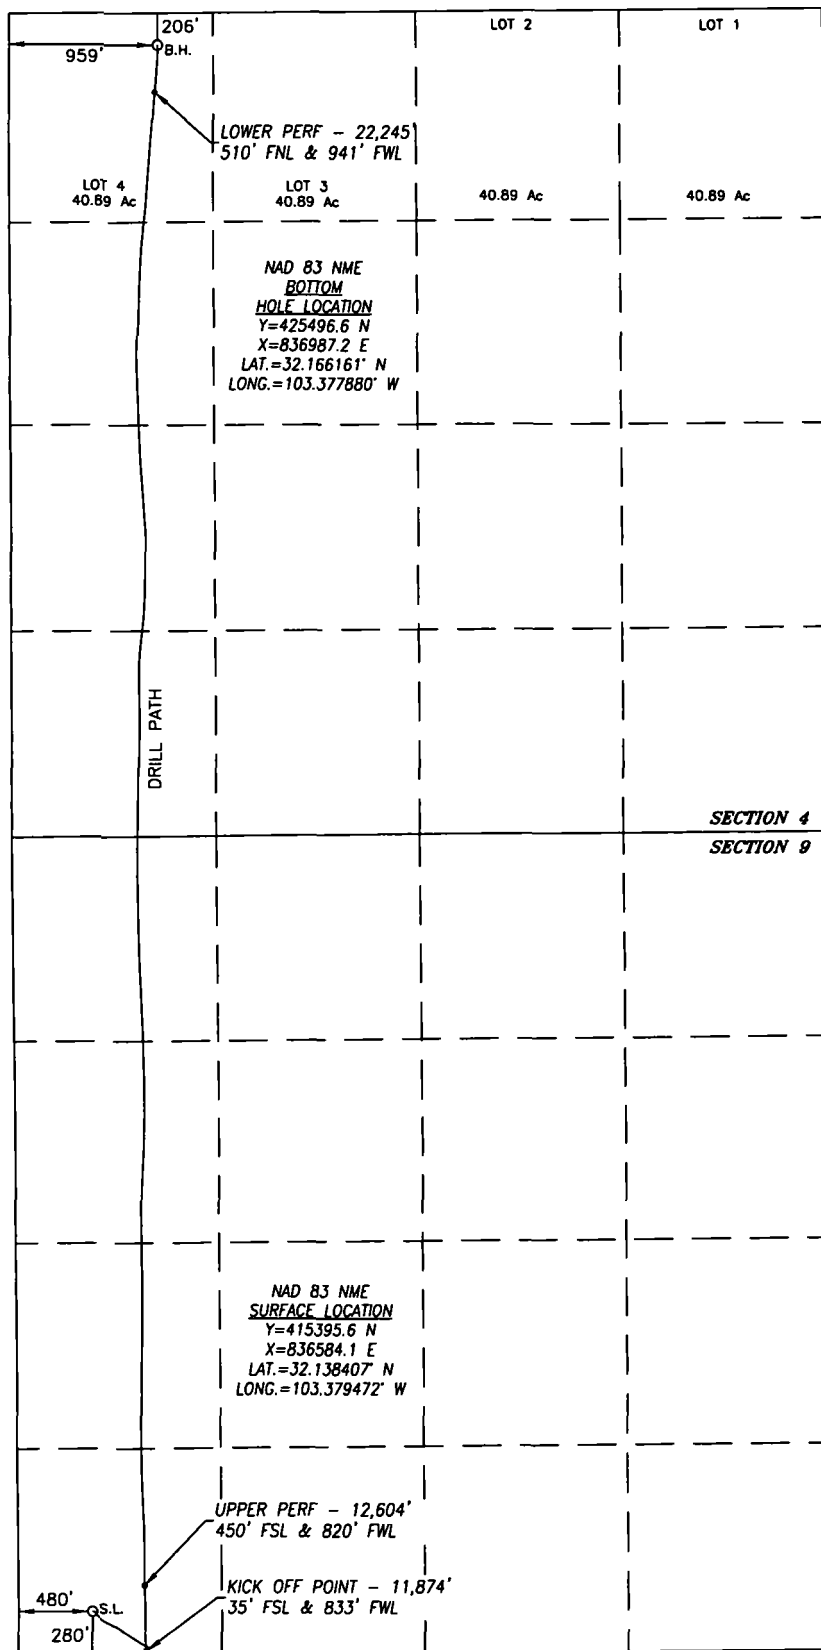

SURFACE INFO AND BOREPATH SHOWN HEREON IS BASED ON DIRECTIONAL SURVEY REPORT PROVIDED BY COG OPERATING, LLC FOR THE FEZ FEDERAL COM #704H SUPPLIED TO HARCROW SURVEYING, LLC ON NOVEMBER 18, 2019

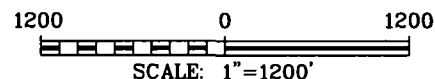

OPERATOR CERTIFICATION

I hereby certify that the information herein is true and complete to the best of my knowledge and belief, and that this organization either owns a working interest or unleased mineral interest in the land including the proposed bottom hole location or has a right to drill this well at this location pursuant to a contract with an owner of such mineral or working interest, or to a voluntary pooling agreement or a compulsory pooling order heretofore entered by the division.

Amanda Avery 12/4/19
Signature Date

Amanda Avery

Printed Name

aavery@concho.com

E-mail Address

SURVEYOR CERTIFICATION

I hereby certify that the well location shown on this plat was plotted from field notes of actual surveys made by me or under my supervision, and that the same is true and correct to the best of my belief.

DEC. 5, 2017/MAY 8, 2019

Date of Survey/Date of Geographic Survey

Signature & Seal of Professional Surveyor



Chad Harcrow 11/26/19
Certificate No. CHAD HARCROW 17777

HOBBS OCD

Intent ☐ As Drilled ☒

JAN 15 2020

API #
30-025-45280**RECEIVED**Operator Name:
COG OPERATING, LLCProperty Name:
FEZ FEDERAL COMWell Number
704H**Kick Off Point (KOP)**

UL M	Section 9	Township 25S	Range 35E	Lot	Feet 35	From N/S SOUTH	Feet 833	From E/W WEST	County LEA
Latitude 32.137733					Longitude -103.378331			NAD 83	

First Take Point (FTP)

UL M	Section 9	Township 25S	Range 35E	Lot	Feet 450	From N/S SOUTH	Feet 820	From E/W WEST	County LEA
Latitude 32.138875					Longitude -103.378375			NAD 83	

Last Take Point (LTP)

UL 4	Section 4	Township 25S	Range 35E	Lot	Feet 510	From N/S NORTH	Feet 941	From E/W WEST	County LEA
Latitude 32.165325					Longitude -103.377942			NAD 83	

Is this well the defining well for the Horizontal Spacing Unit?

☐ No

Is this well an infill well?

☐ Yes

If infill is yes please provide API if available, Operator Name and well number for Defining well for Horizontal Spacing Unit.

API #
30-025-45275Operator Name:
COG Operating LLCProperty Name:
Fez Federal ComWell Number
704H

KZ 06/29/2018