

DISTRICT I

1625 N. FRENCH DR., HOBBS, NM 88240
Phone: (505) 393-8101 Fax: (505) 393-0720

DISTRICT II

811 S. FIRST ST., ARTESIA, NM 88203
Phone: (505) 748-1283 Fax: (505) 748-0720

DISTRICT III

1000 RIO BRAZOS RD., AZTEC, NM 87410
Phone: (505) 334-8178 Fax: (505) 334-8170

DISTRICT IV

1220 S. ST. FRANCIS DR., SANTA FE, NM 87505
Phone: (505) 476-3460 Fax: (505) 476-3460

State of New Mexico

Energy, Minerals & Natural Resources Department

HOBBS OGD

CONSERVATION DIVISION

1220 SOUTH ST. FRANCIS DR.

JAN 15 2026 Santa Fe, New Mexico 87505

Form C-102

Revised August 1, 2011

Submit one copy to appropriate

District Office

☒ AMENDED REPORT

As Drilled

WELL LOCATION AND ACREAGE DEDICATION PLAT

API Number 30-025-45337	Pool Code 98098	Pool Name WC-025 G-09 S243532M; WOLFBONE
Property Code 322742	Property Name FEZ FEDERAL COM	Well Number 705H
OGRID No. 229137	Operator Name COG OPERATING, LLC	Elevation 3262.4'

Surface Location

UL or lot No.	Section	Township	Range	Lot Idn	Feet from the	North/South line	Feet from the	East/West line	County
M	9	25-S	35-E		280	SOUTH	420	WEST	LEA

Bottom Hole Location If Different From Surface

UL or lot No.	Section	Township	Range	Lot Idn	Feet from the	North/South line	Feet from the	East/West line	County
4	4	25-S	35-E		201	NORTH	350	WEST	LEA
Dedicated Acres 641.72	Joint or Infill	Consolidation Code	Order No.						

NO ALLOWABLE WILL BE ASSIGNED TO THIS COMPLETION UNTIL ALL INTERESTS HAVE BEEN CONSOLIDATED
OR A NON-STANDARD UNIT HAS BEEN APPROVED BY THE DIVISION


SEE PAGE 2

PAGE 1 OF 2


W.O. #19-2190

DRAWN BY: WN

Property Code 322742	Property Name FEZ FEDERAL COM	Well Number 705H
OGRID No. 229137	Operator Name COG OPERATING, LLC	Elevation 3262.4'

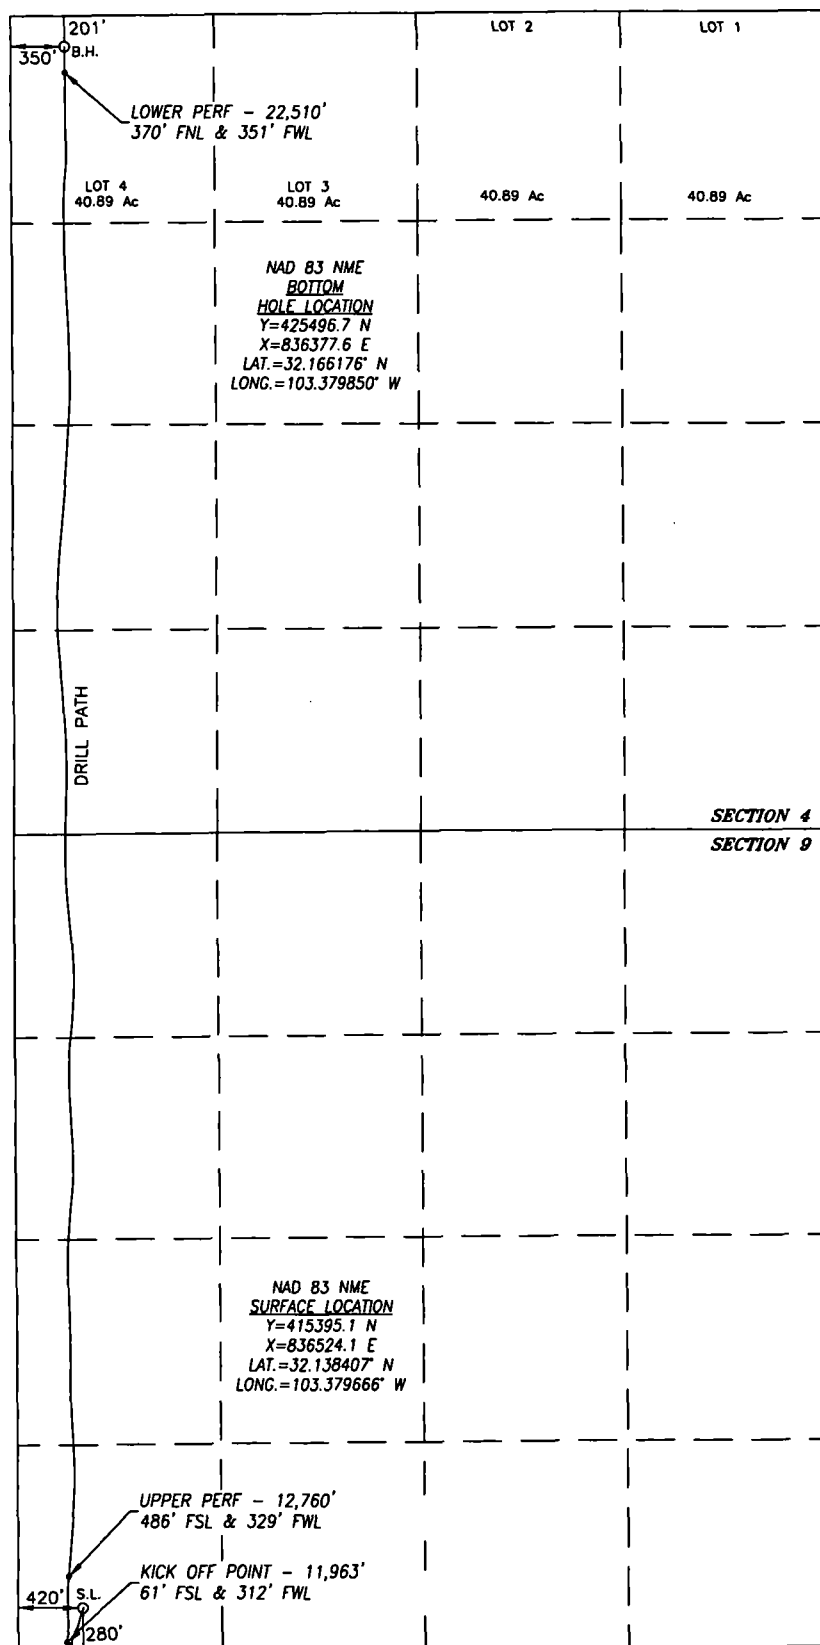

SURFACE INFO AND BOREPATH SHOWN HEREON IS BASED ON DIRECTIONAL SURVEY REPORT PROVIDED BY COG OPERATING, LLC FOR THE FEZ FEDERAL COM #705H SUPPLIED TO HARCROW SURVEYING, LLC ON NOVEMBER 18, 2019

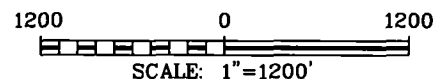

OPERATOR CERTIFICATION

I hereby certify that the information herein is true and complete to the best of my knowledge and belief, and that this organization either owns a working interest or unless mineral interest in the land including the proposed bottom hole location or has a right to drill this well at this location pursuant to a contract with an owner of such mineral or working interest, or to a voluntary pooling agreement or a compulsory pooling order heretofore entered by the division.

Amanda Avery 12/4/19
Signature Date

Amanda Avery

Printed Name

aaavery@concho.com

E-mail Address

SURVEYOR CERTIFICATION

I hereby certify that the well location shown on this plat was plotted from field notes of actual surveys made by me or under my supervision, and that the same is true and correct to the best of my belief.

DEC. 5, 2017/MAY 6, 2019

Date of Survey/Date of Geographic Survey

Signature & Seal of Professional Surveyor



Chad Harcrow 11/26/19
Certificate No. CHAD HARCROW 17777

HOBBS OCD

Intent ☐ As Drilled ☒

JAN 15 2020

API #
30-025-45337**RECEIVED**

Operator Name: COG OPERATING, LLC	Property Name: FEZ FEDERAL COM	Well Number 705H
--------------------------------------	-----------------------------------	---------------------

Kick Off Point (KOP)

UL M	Section 9	Township 25S	Range 35E	Lot	Feet 61	From N/S SOUTH	Feet 312	From E/W WEST	County LEA
Latitude 32.137806					Longitude -103.380014				NAD 83

First Take Point (FTP)

UL M	Section 9	Township 25S	Range 35E	Lot	Feet 486	From N/S SOUTH	Feet 329	From E/W WEST	County LEA
Latitude 32.138974					Longitude -103.379961				NAD 83

Last Take Point (LTP)

UL 4	Section 4	Township 25S	Range 35E	Lot	Feet 370	From N/S NORTH	Feet 351	From E/W WEST	County LEA
Latitude 32.165711					Longitude -103.379846				NAD 83

Is this well the defining well for the Horizontal Spacing Unit? ☐ NoIs this well an infill well? ☐ Yes

If infill is yes please provide API if available, Operator Name and well number for Defining well for Horizontal Spacing Unit.

API #
30-025-45275

Operator Name: COG Operating LLC	Property Name: Fez Federal Com	Well Number 705H
-------------------------------------	-----------------------------------	---------------------

KZ 06/29/2018