


OPERATOR LANG & UNGER
LEASE FEDERAL-WILLS
LOCATION NO. 1
COUNTY LEA STATE NEW MEXICO

DATE 7-31-56
SCALE 1" = 1000'

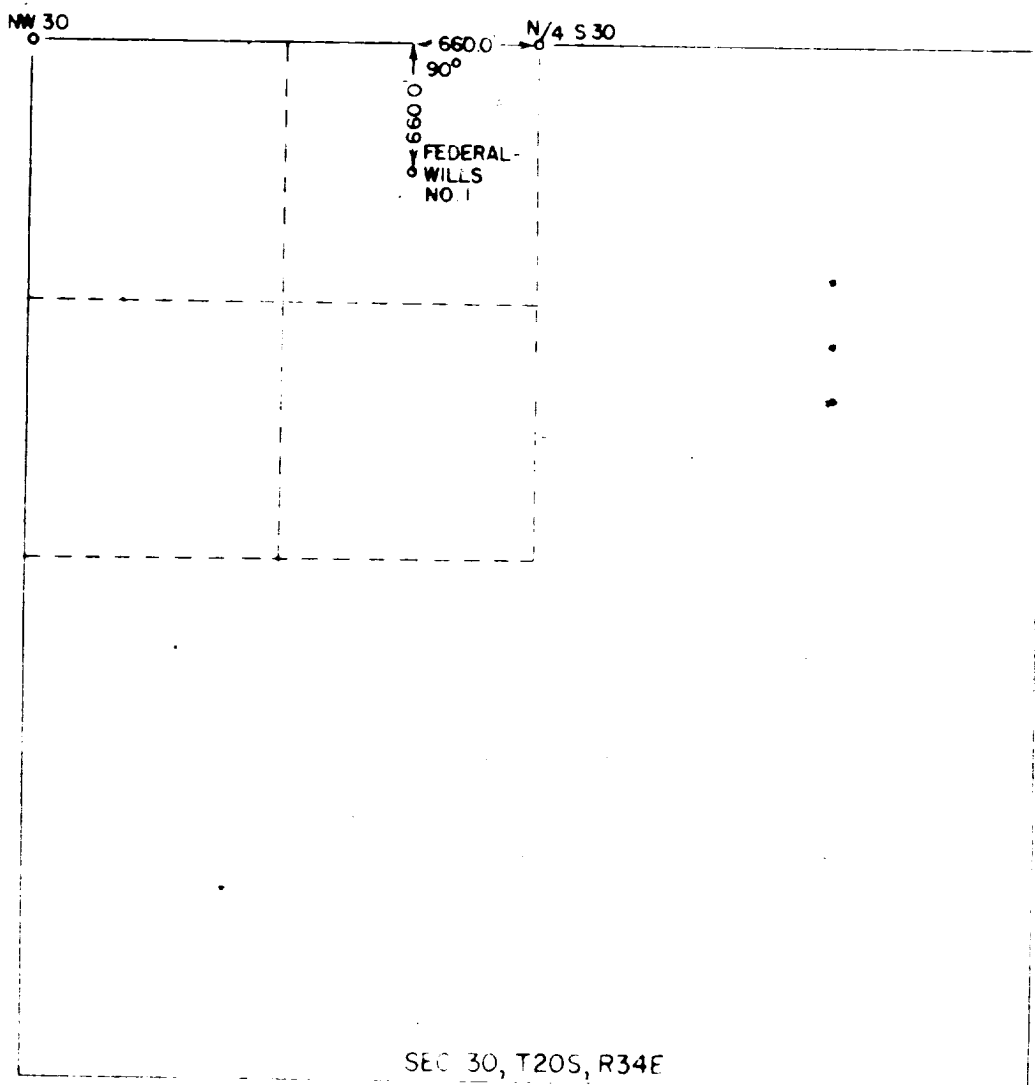

I certify that the above plat was constructed from a plan prepared by me or under my supervision and is true and correct to the best of my knowledge and belief.

Ben T. Phillips Jr. C.S.

Ben T. Phillips Jr.