

UNITED STATES  
DEPARTMENT OF THE INTERIOR  
BUREAU OF LAND MANAGEMENT

OCD Hobbs

FORM APPROVED  
OMB NO. 1004-0135  
Expires: July 31, 2010

**SUNDRY NOTICES AND REPORTS ON WELLS**  
*Do not use this form for proposals to drill or to re-enter an abandoned well. Use form 3160-3 (APD) for such proposals.*

HOBBS OCD

**SUBMIT IN TRIPLICATE - Other instructions on reverse side.**

MAR 15 2013

1. Type of Well <input checked="" type="checkbox"/> Oil Well <input type="checkbox"/> Gas Well <input type="checkbox"/> Other		5. Lease Serial No. NMLC060329
2. Name of Operator CIMAREX ENERGY CO OF COLORADO		6. If Indian, Allottee or Tribe Name
3a. Address 600 N. MARIENFELD STREET, SUITE 600 MIDLAND, TX 79701		7. If Unit or CA/Agreement, Name and/or No.
3b. Phone No. (include area code) Ph: 432-620-1959 Fax: 432-620-1940		8. Well Name and No. HT 18 FEDERAL 008
4. Location of Well (Footage, Sec., T., R., M., or Survey Description) Sec 18 T17S R32E NWNW 530FNL 330FWL 32.840489 N Lat, 103.813433 W Lon		9. API Well No. 30-025-39976
		10. Field and Pool, or Exploratory MALJAMAR, YESO, WEST
		11. County or Parish, and State LEA COUNTY, NM

**12. CHECK APPROPRIATE BOX(ES) TO INDICATE NATURE OF NOTICE, REPORT, OR OTHER DATA**

TYPE OF SUBMISSION	TYPE OF ACTION			
<input checked="" type="checkbox"/> Notice of Intent	<input type="checkbox"/> Acidize	<input type="checkbox"/> Deepen	<input type="checkbox"/> Production (Start/Resume)	<input type="checkbox"/> Water Shut-Off
<input type="checkbox"/> Subsequent Report	<input type="checkbox"/> Alter Casing	<input type="checkbox"/> Fracture Treat	<input checked="" type="checkbox"/> Reclamation	<input type="checkbox"/> Well Integrity
<input type="checkbox"/> Final Abandonment Notice	<input type="checkbox"/> Casing Repair	<input type="checkbox"/> New Construction	<input type="checkbox"/> Recomplete	<input type="checkbox"/> Other
	<input type="checkbox"/> Change Plans	<input type="checkbox"/> Plug and Abandon	<input type="checkbox"/> Temporarily Abandon	
	<input type="checkbox"/> Convert to Injection	<input type="checkbox"/> Plug Back	<input type="checkbox"/> Water Disposal	

13. Describe Proposed or Completed Operation (clearly state all pertinent details, including estimated starting date of any proposed work and approximate duration thereof. If the proposal is to deepen directionally or recompleat horizontally, give subsurface locations and measured and true vertical depths of all pertinent markers and zones. Attach the Bond under which the work will be performed or provide the Bond No. on file with BLM/BIA. Required subsequent reports shall be filed within 30 days following completion of the involved operations. If the operation results in a multiple completion or recompleat in a new interval, a Form 3160-4 shall be filed once testing has been completed. Final Abandonment Notices shall be filed only after all requirements, including reclamation, have been completed, and the operator has determined that the site is ready for final inspection.)

Cimarex Energy Co. of Colorado respectfully requests approval for the attached "As Built" Battery Diagram for the HT 18 Federal 8. We also request your approval to change the interim reclamation plan. We intend to begin interim reclamation as soon as approval has been received.

Please find attached the following diagrams:  
Approved rig diagram  
Approved original interim reclamation plan  
Proposed "As Built" Battery/ proposed reclamation plan

14. I hereby certify that the foregoing is true and correct. <b>Electronic Submission #200812 verified by the BLM Well Information System For CIMAREX ENERGY CO OF COLORADO, sent to the Hobbs</b>	
Name (Printed/Typed) MICHELLE CHAPPELL	Title REGULATORY TECHNICIAN
Signature (Electronic Submission)	Date 03/06/2013

**THIS SPACE FOR FEDERAL OR STATE OFFICE USE**

Approved By <u>James R. Pons</u>	Title <u>SEPS</u>	Date <u>3-13-13</u>
Conditions of approval, if any, are attached. Approval of this notice does not warrant or certify that the applicant holds legal or equitable title to those rights in the subject lease which would entitle the applicant to conduct operations thereon.		Office <u>CFO</u>

Title 18 U.S.C. Section 1001 and Title 43 U.S.C. Section 1212, make it a crime for any person knowingly and willfully to make to any department or agency of the United States any false, fictitious or fraudulent statements or representations as to any matter within its jurisdiction.

**\*\* OPERATOR-SUBMITTED \*\* OPERATOR-SUBMITTED \*\* OPERATOR-SUBMITTED \*\***

# Silver Oak #3

Exhibit D – Rig Diagram

HT Federal No. 8

Cimarex Energy Co. of Colorado

18-17S-32E

530 FNL & 330 FWL

Lea County, NM



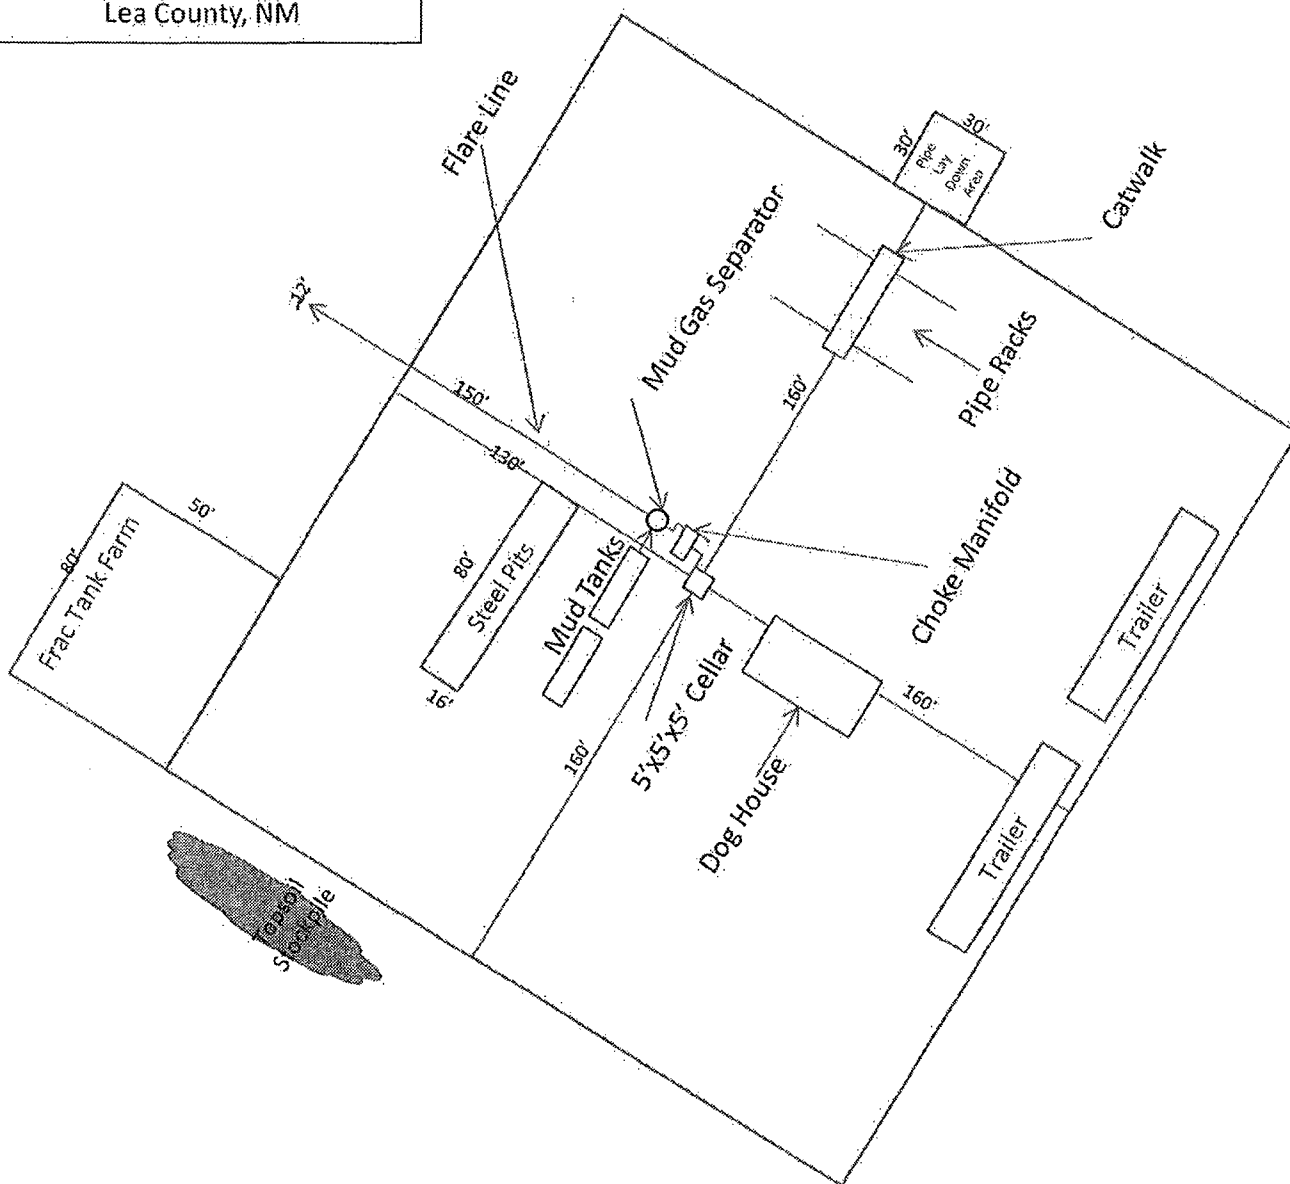


Exhibit D-1  
HT Federal No. 8  
Cimarex Energy Co. of Colorado  
18-17S-32E  
530 FNL & 330 FWL  
Lea County, NM

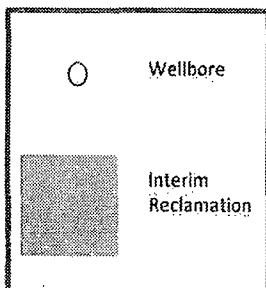

As Built Battery Diagram and  
Proposed Interim Reclaim  
**HT 18 Federal No. 8**  
Cimarex Energy Co. of Colorado  
18-17S-32E  
530 FNL & 330 FWL  
Lea County, NM

30'

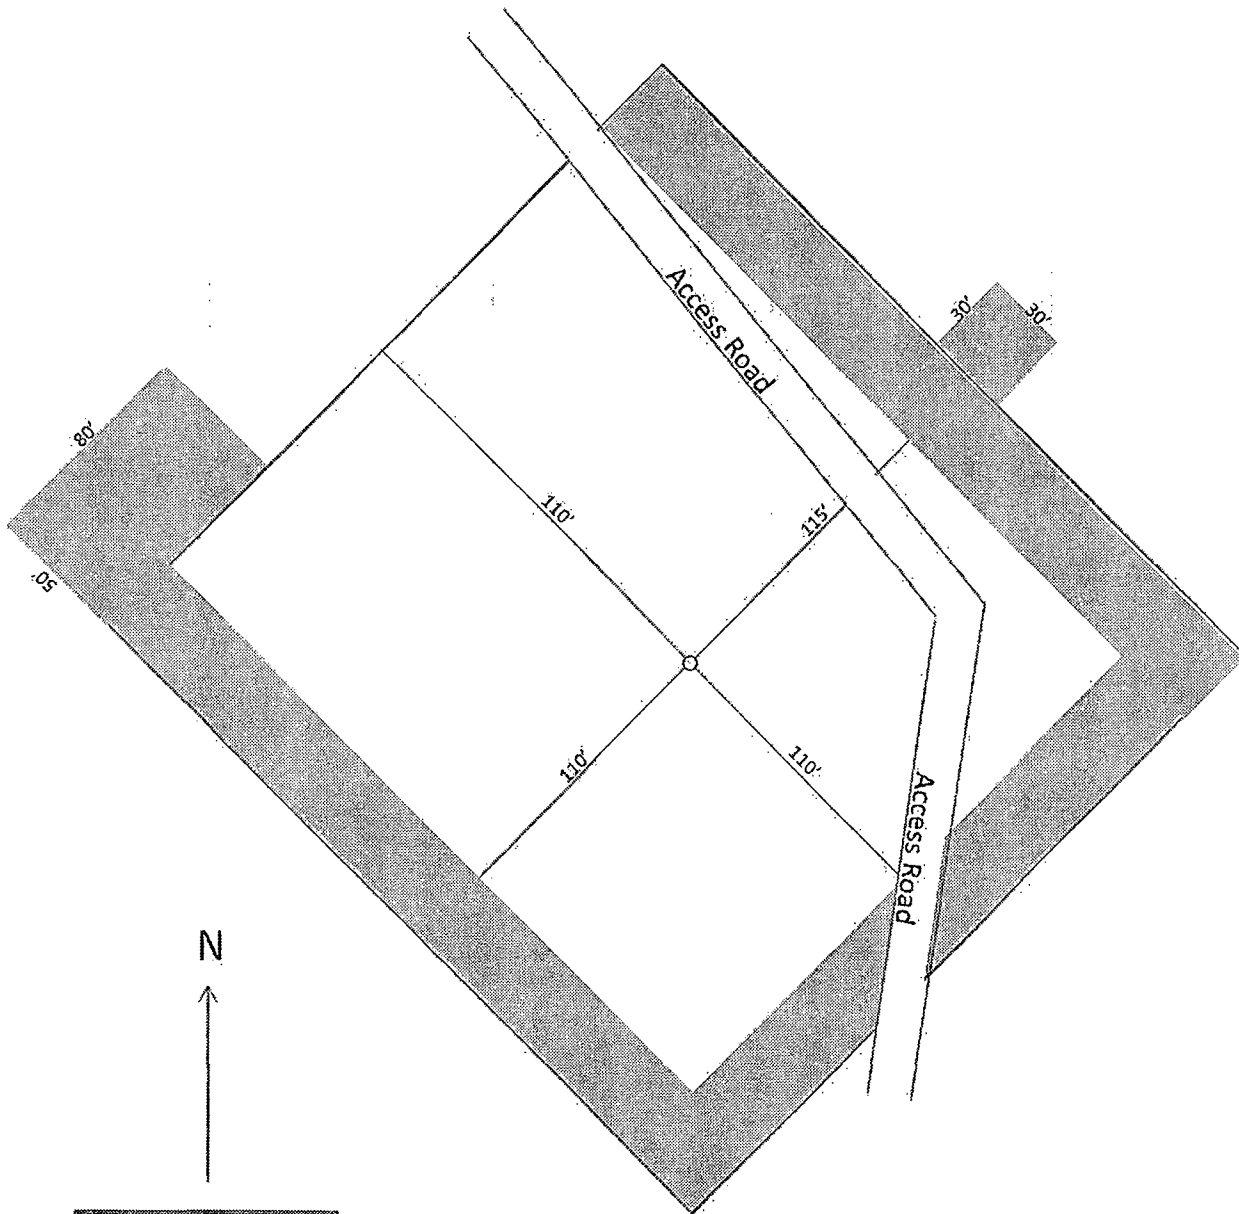