

EC

UNITED STATES  
DEPARTMENT OF THE INTERIOR  
BUREAU OF LAND MANAGEMENT

New Mexico Oil Conservation Division

1625 N. French Drive  
Hobbs, NM 88240FORM APPROVED  
OMB NO. 1004-0135  
Expires: July 31, 2010

## SUNDRY NOTICES AND REPORTS ON WELLS

Do not use this form for proposals to drill or to re-enter an  
abandoned well. Use form 3160-3 (APD) for such proposals.

SUBMIT IN TRIPLICATE - Other instructions on reverse side.

1. Type of Well <input checked="" type="checkbox"/> Oil Well <input type="checkbox"/> Gas Well <input type="checkbox"/> Other		5. Lease Serial No. NMLC060850
2. Name of Operator CIMAREX ENERGY CO OF COLORADO		6. If Indian, Allottee or Tribe Name
3a. Address 600 N. MARIENFELD STREET, SUITE 600 MIDLAND, TX 79701		7. If Unit or CA/Agreement, Name and/or No. NMM128142
3b. Phone No. (include area code) Ph: 432-620-1959 Fax: 432-620-1940		8. Well Name and No. BOXER 3 FEDERAL COM 001
4. Location of Well (Footage, Sec., T., R., M., or Survey Description) Sec 3 T15S R31E SENE 2135FNL 170FEL 33.046433 N Lat, 103.801500 W Lon		9. API Well No. 30-005-29195
		10. Field and Pool, or Exploratory ABO/WOLFCAMP WILDCAT
		11. County or Parish, and State CHAVES COUNTY, NM

## 12. CHECK APPROPRIATE BOX(ES) TO INDICATE NATURE OF NOTICE, REPORT, OR OTHER DATA

TYPE OF SUBMISSION	TYPE OF ACTION			
<input checked="" type="checkbox"/> Notice of Intent	<input type="checkbox"/> Acidize	<input type="checkbox"/> Deepen	<input type="checkbox"/> Production (Start/Resume)	<input type="checkbox"/> Water Shut-Off
<input type="checkbox"/> Subsequent Report	<input type="checkbox"/> Alter Casing	<input type="checkbox"/> Fracture Treat	<input checked="" type="checkbox"/> Reclamation	<input type="checkbox"/> Well Integrity
<input type="checkbox"/> Final Abandonment Notice	<input type="checkbox"/> Casing Repair	<input type="checkbox"/> New Construction	<input type="checkbox"/> Recomplete	<input type="checkbox"/> Other
	<input type="checkbox"/> Change Plans	<input type="checkbox"/> Plug and Abandon	<input type="checkbox"/> Temporarily Abandon	
	<input type="checkbox"/> Convert to Injection	<input type="checkbox"/> Plug Back	<input type="checkbox"/> Water Disposal	

13. Describe Proposed or Completed Operation (clearly state all pertinent details, including estimated starting date of any proposed work and approximate duration thereof. If the proposal is to deepen directionally or recompleat horizontally, give subsurface locations and measured and true vertical depths of all pertinent markers and zones. Attach the Bond under which the work will be performed or provide the Bond No. on file with BLM/BIA. Required subsequent reports shall be filed within 30 days following completion of the involved operations. If the operation results in a multiple completion or recompleat in a new interval, a Form 3160-4 shall be filed once testing has been completed. Final Abandonment Notices shall be filed only after all requirements, including reclamation, have been completed, and the operator has determined that the site is ready for final inspection.)

Cimarex Energy Co. of Colorado respectfully requests approval for the attached "As Built" Battery Diagram for the Boxer 3 Federal Com 1. We also request your approval to change the interim reclamation plan. We intend to begin interim reclamation as soon as approval has been received.

Please find attached the following diagrams:

Approved rig diagram

Approved original interim reclamation plan

Proposed "As Built" Battery/proposed reclamation plan.

ACCEPTED FOR  
RECORD

JUL 02 2014

NAME /st Angel Mayes

14. I hereby certify that the foregoing is true and correct. Electronic Submission #201189 verified by the BLM Well Information System For CIMAREX ENERGY CO OF COLORADO, sent to the Roswell		Assistant Field Manager, Lands And Minerals
Name (Printed/Typed) MICHELLE CHAPPELL	Title REGULATORY TECHNICIAN	
Signature (Electronic Submission)	Date 03/11/2013	

## THIS SPACE FOR FEDERAL OR STATE OFFICE USE

Approved By _____	Title _____	Date _____
Conditions of approval, if any, are attached. Approval of this notice does not warrant or certify that the applicant holds legal or equitable title to those rights in the subject lease which would entitle the applicant to conduct operations thereon.		Office _____

Title 18 U.S.C. Section 1001 and Title 43 U.S.C. Section 1212, make it a crime for any person knowingly and willfully to make to any department or agency of the United States any false, fictitious or fraudulent statements or representations as to any matter within its jurisdiction.


\*\* OPERATOR-SUBMITTED \*\* OPERATOR-SUBMITTED \*\* OPERATOR-SUBMITTED \*\*

MBS/OCD 7/9/2014

JUL 10 2014

fw

# Precision Drilling Rig 77

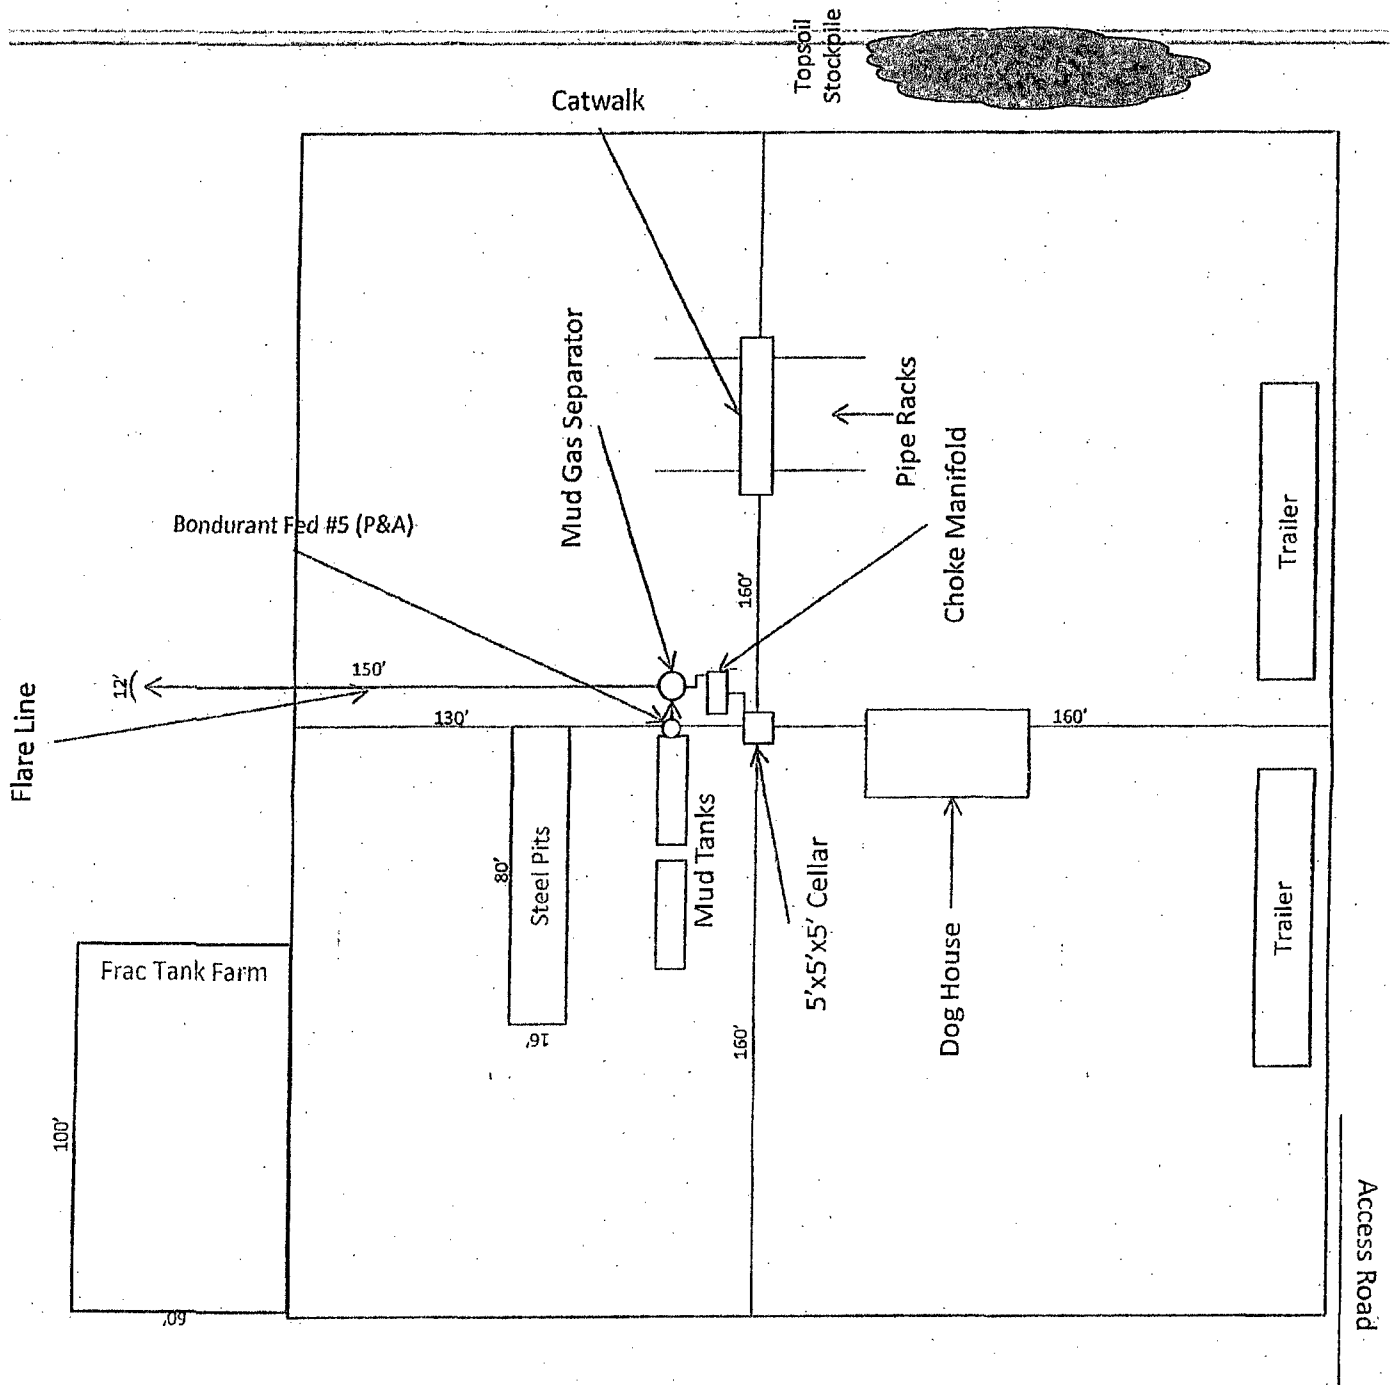

1"=50'

N

Rig Diagram  
 Boxer 3 Fee No. 1  
 Cimarex Energy Co. of Colorado  
 3-15S-31E  
 SHL 2135 FNL & 170 FEL  
 BHL 2265 FNL & 330 FWL  
 Chaves County, NM




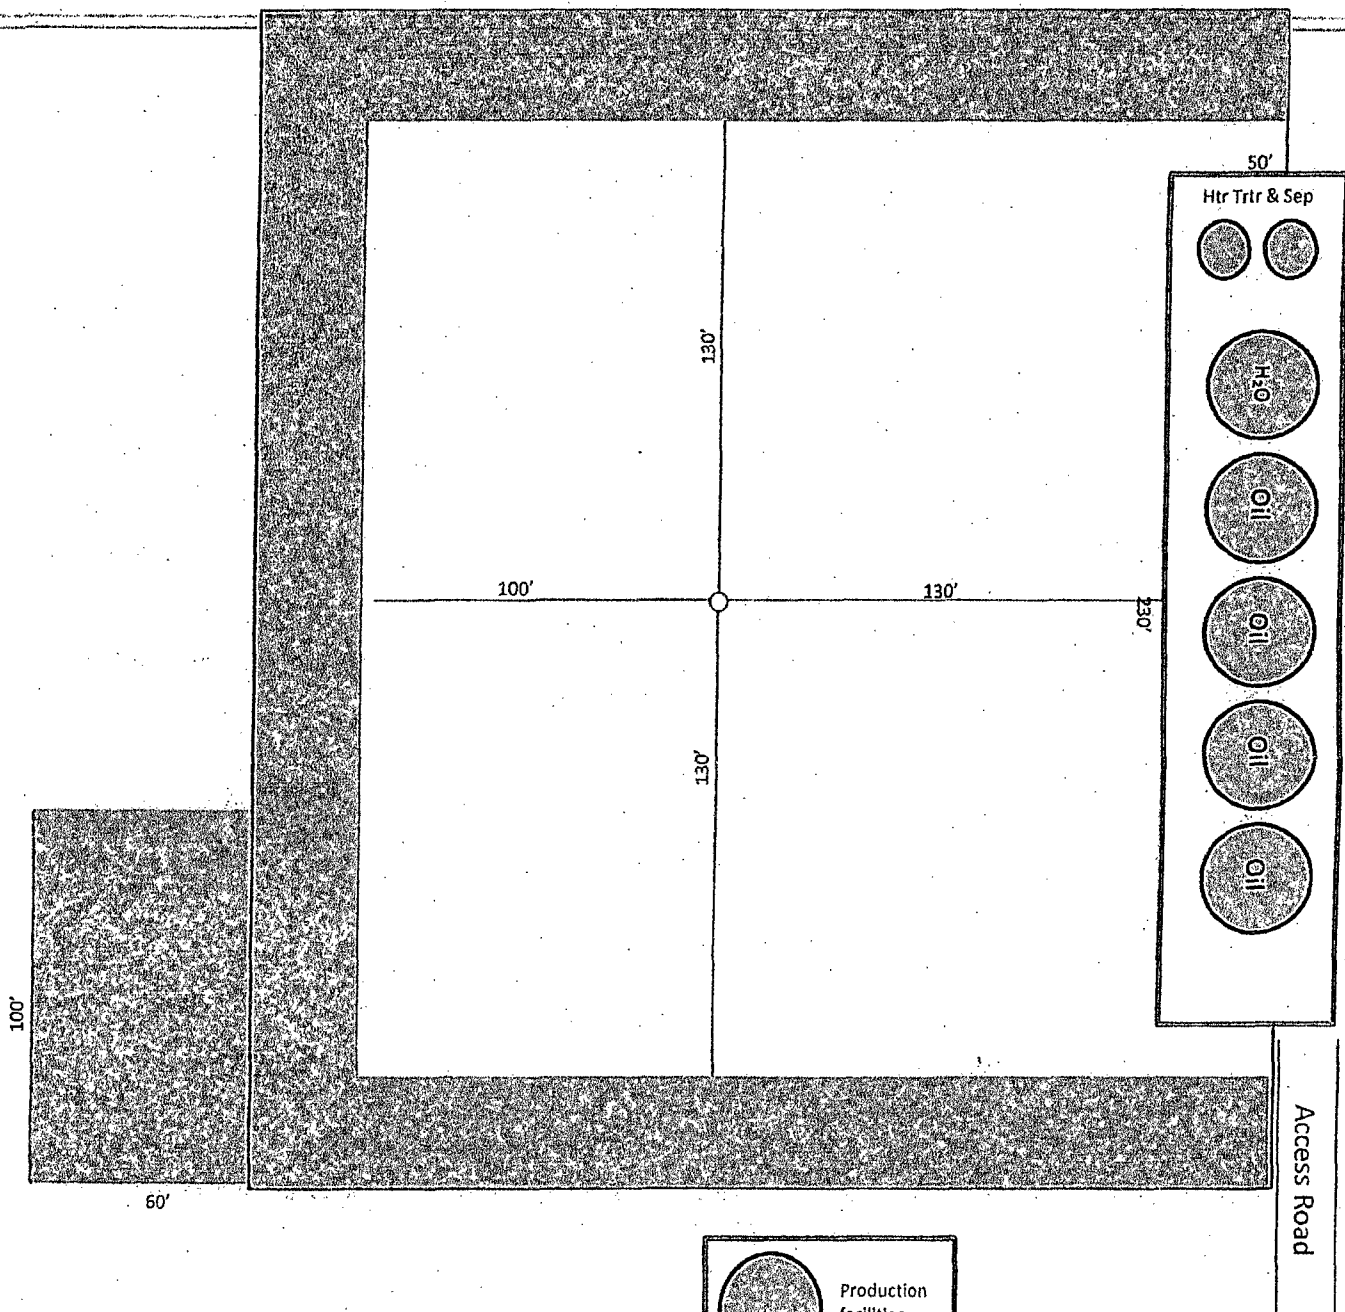


Exhibit D-1  
 Production Facilities Layout Diagram  
**Boxer 3 Fee No. 1**  
 Cimarex Energy Co. of Colorado  
 3-15S-31E  
 SHL 2135 FNL & 170 FEL  
 BHL 2265 FNL & 330 FWL  
 Chaves County, NM

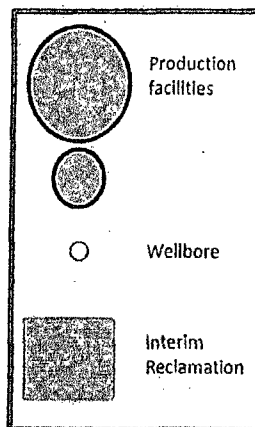

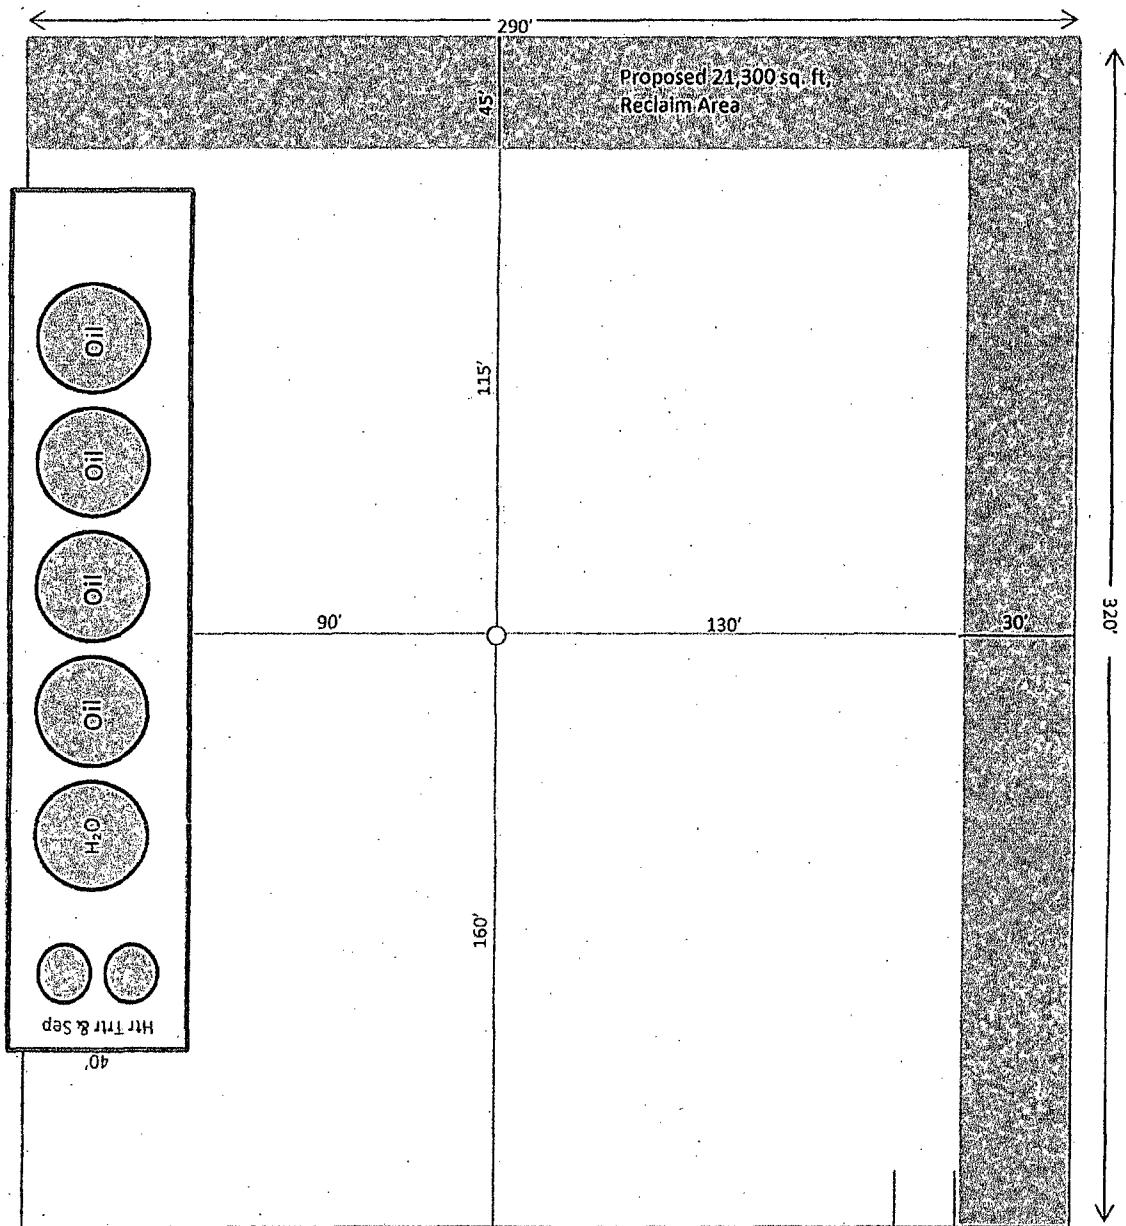

As Built Battery Diagram and  
Proposed Interim Reclaim  
**Boxer 3 Federal Com No. 1**  
Cimarex Energy Co. of Colorado  
3-155-31E  
SHL 2135 FNL & 170 FEL  
BHL 2274 FNL & 332 FWL  
Chaves County, NM

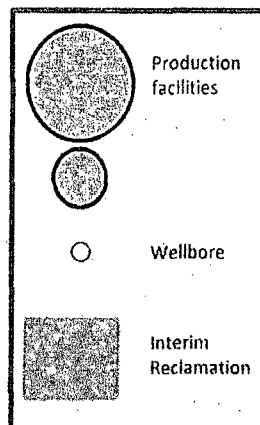

1"=50'