

JUL 11 2018

RECEIVED

'As Drilled'

Operator Name: EOG RESOURCES, INC	Property Name: PAPAYA 10 STATE 30-025-44032	Well Number 201H
--------------------------------------	---	---------------------

## Kick Off Point (KOP)

UL D	Section 10	Township 21S	Range 34E	Lot	Feet 80	From N/S NORTH	Feet 455	From E/W WEST	County LEA
Latitude 32.5004810					Longitude 103.4648638			NAD 1983	

## First Take Point (FTP)

UL D	Section 10	Township 21S	Range 34E	Lot	Feet 573	From N/S NORTH	Feet 405	From E/W WEST	County LEA
Latitude 32.4991265					Longitude 103.4650238			NAD 1983	

## Last Take Point (LTP)

UL M	Section 10	Township 21S	Range 34E	Lot	Feet 367	From N/S SOUTH	Feet 372	From E/W WEST	County LEA
Latitude 32.4871942					Longitude 103.4651358			NAD 1983	

Is this well the defining well for the Horizontal Spacing Unit?


YES

Is this well an infill well?

NO

If infill is yes please provide API if available, Operator Name and well number for Defining well for Horizontal Spacing Unit.

API #		
Operator Name:	Property Name:	Well Number

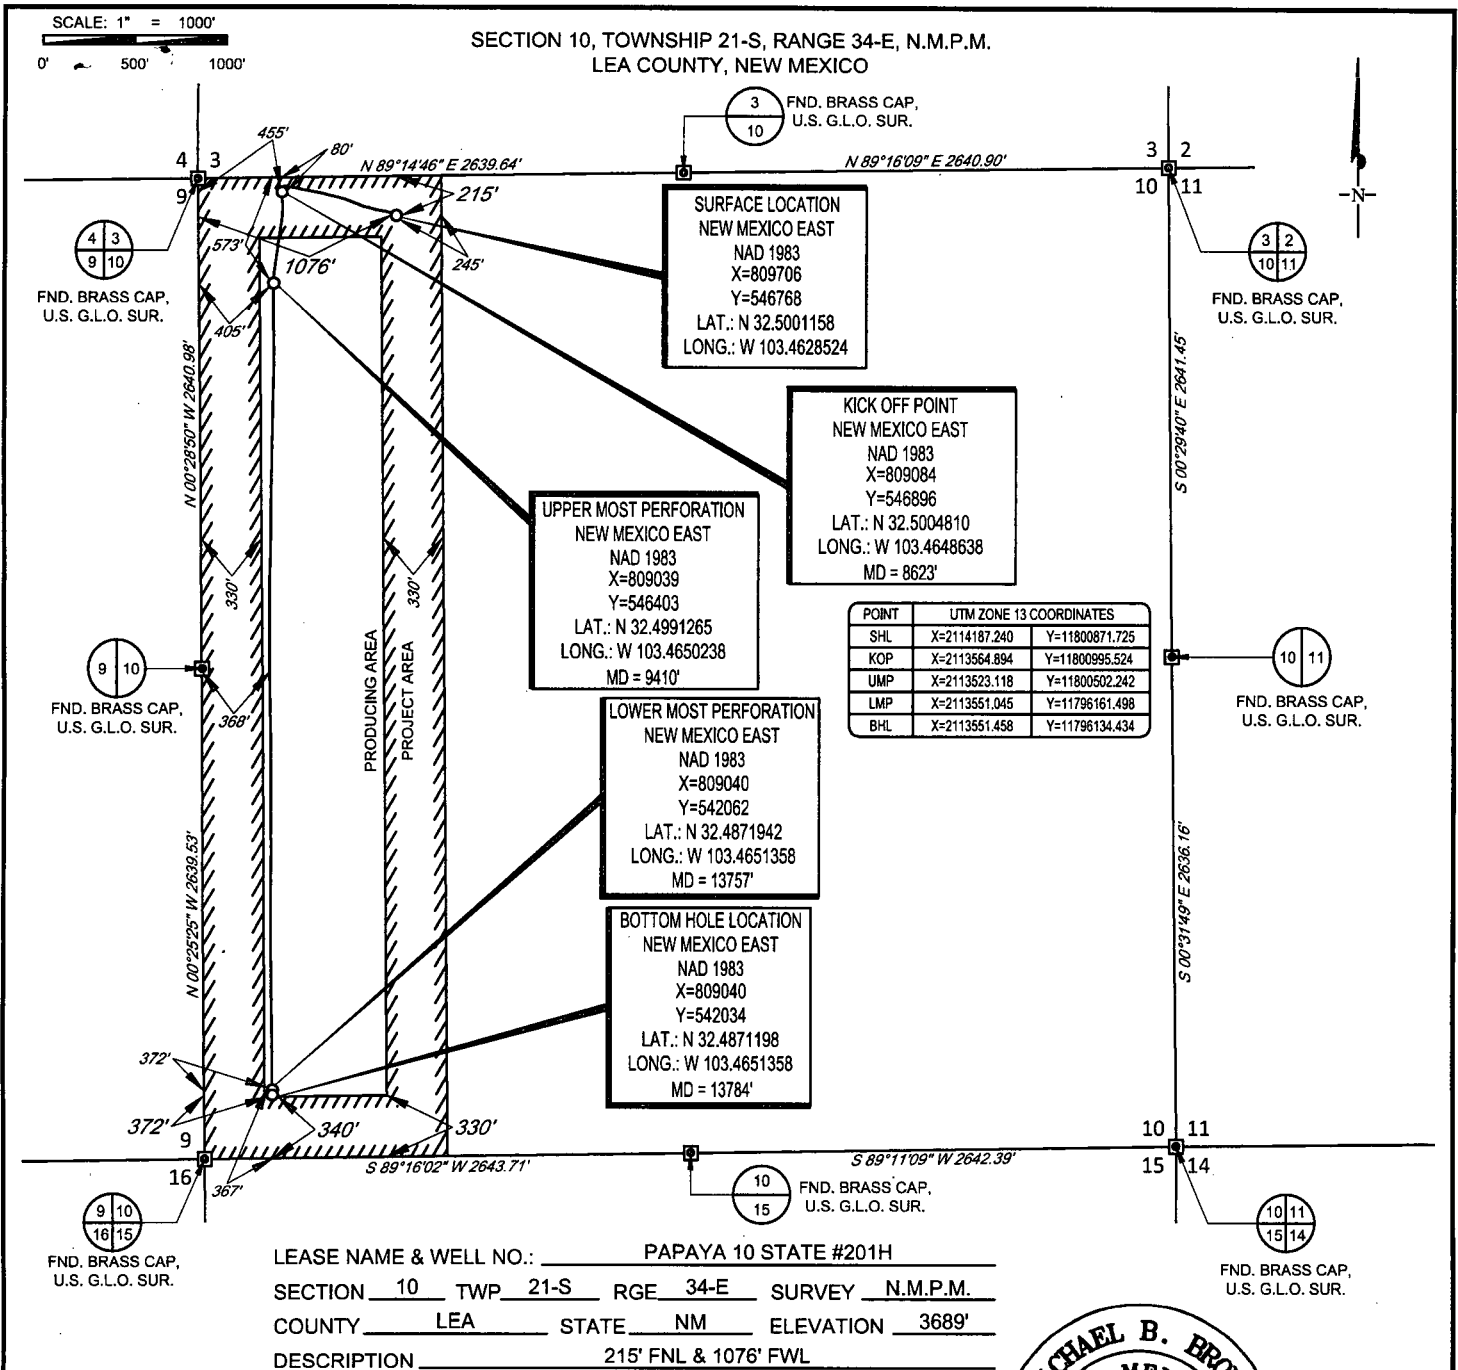


**egog resources, Inc.**



**TOPOGRAPHIC**  
LOYALTY INNOVATION LEGACY

1400 EVERMAN PARKWAY, Ste. 146 • FT. WORTH, TEXAS 76140  
TELEPHONE: (817) 744-7512 • FAX (817) 744-7554  
2903 NORTH BIG SPRING • MIDLAND, TEXAS 79705  
TELEPHONE: (432) 682-1653 OR (800) 767-1653 • FAX (432) 682-1743  
WWW.TOPOGRAPHIC.COM

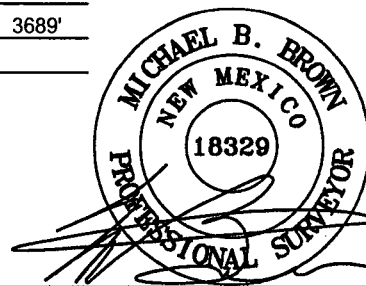

Michael Blake Brown, P.S. No. 18329  
JUNE 12, 2018

PAPAYA 10 STATE #201H AS-COMPLETED		REVISION:	NOTES:
DATE: 06/12/2018			1. ORIGINAL DOCUMENT SIZE: 8.5" X 11"
FILE: AD_PAPAYA_10_STATE_201H_REV1			2. ALL BEARINGS, DISTANCES, AND COORDINATE VALUES CONTAINED HEREIN ARE GRID BASED UPON THE NEW MEXICO COORDINATE SYSTEM OF 1983, EAST ZONE, U.S. SURVEY FEET.
DRAWN BY: H.B.			3. THIS WELL LOCATION SHOWN HEREON HAS BEEN SURVEYED ON THE GROUND UNDER MY SUPERVISION AND PREPARED ACCORDING TO THE EVIDENCE FOUND AT THE TIME OF SURVEY, AND DATA PROVIDED BY EOG RESOURCES, INC. THIS CERTIFICATION IS MADE AND LIMITED TO THOSE PERSONS OR ENTITIES SHOWN ON THE FACE OF THIS PLAT AND IS NON-TRANSFERABLE. THIS SURVEY IS CERTIFIED FOR THIS TRANSACTION ONLY.
SHEET: 1 OF 1			