UNITED STATES DEPARTMENT OF THE INTERIOR

FORM APPROVED OMB NO. 1004-0137 Expires: January 31, 2018

BUREAU OF LAND MANAGEMENT 5. Lease Serial No. NMNM0160973 SUNDRY NOTICES AND REPORTS ON WELLS OCD Hobbs

Do not use this form for proposals to drill or to re-enter an abandoned well. Use form 3160-3 (APD) for such proposals.										
					6. If Indian, Allottee or Tribe Name					
SUBMIT IN TRIPLICATE - Other instructions on page 2						7. If Unit or CA/Agreement, Name and/or No. NMNM138998				
1. Type of Well ☑ Oil Well ☐ Gas Well ☐ Other						Well Name and No. TIGERCAT FEDERAL COM 1H				
Name of Operator Contact: BOBBIE GOODLOE COG OPERATING LLC E-Mail: bgoodloe@concho.com						9. API Well No. 30-025-44302-00-X1				
3a. Address ONE CONCHO CENTER 600 W ILLINOIS AVENUE Ph: 575-748-695 MIDLAND, TX 79701-4287					10. Field and Pool or Exploratory Area WILDCAT BONE SPRING					
4. Location of Well (Footage, Sec., T., R., M., or Survey Description)					11.	11. County or Parish, State				
Sec 8 T26S R33E NWNE 355FNL 1620FEL 32.064315 N Lat, 103.591003 W Lon				·	LEA COUNTY, NM					
12. CHECK THE AF	PPROPRIATE BOX(ES)	TO INDICA	TE NATURE O	F NOTICE	E, REI	PORT, OR OTH	ER DATA			
TYPE OF SUBMISSION TYPE OF ACTION							-		.	
☐ Notice of Intent	☐ Acidize	☐ Deep	oen	☐ Production (Start/Resume)		Start/Resume)	☐ Water Shut-Off			
	☐ Alter Casing	☐ Hyd	raulic Fracturing	Reclai	☐ Reclamation		■ Well Integrity			
Subsequent Report	☐ Casing Repair	□ New	☐ New Construction ☐ R		Recomplete		Other	e. Dia a		
☐ Final Abandonment Notice	□ Change Plans	□ Plug and Abandon		☐ Tempe	□ Temporarily Abandon		Site Facility m/Security	iy Diag Plan	,ra	
	☐ Convert to Injection	Plug	☐ Plug Back ☐ Water Dis		Dispo	sal	·			
If the proposal is to deepen directions Attach the Bond under which the wor following completion of the involved testing has been completed. Final Abdetermined that the site is ready for fit COG OPERATING LLC RESPITIGERCAT FEDERAL COM 8 GAS SALES METER #57559 ALL FEDERAL REQUIREMENTSEE ATTACHED FACILITY DIFFERENT TIGERCAT FEDERAL COM #TIGERCAT FEDERAL *TIGERCAT FI	ck will be performed or provide to operations. If the operation rest operations. If the operation rest operation rest operation. PECTFULLY REQUESTS IS A CTB. MEETS API AND AGA ST NTS AND REGULATIONS IN AGRAM 11H 30-025-44302 12H 30-025-44303 13H 30-025-44534	he Bond No. on alts in a multiple d only after all a DESIGNATIO	file with BLM/BIA e completion or reco requirements, included	Required sompletion in a ing reclamate	subsequ a new in ion, hav	ent reports must be a nterval, a Form 3160 re been completed as	filed within 30 0-4 must be file and the operator	days ed once r has		
	Electronic Submission #4	PERATING L	LC. sent to the h	lobbs	•					
Name (Printed/Typed) BOBBIE G	Title REGULATORY ANALYST									
Signature (Electronic Submission) Date 01/2					ACC	SEPTED FO	R RECO)RN	1	
	THIS SPACE FO	R FEDERA	L OR STATE	OFFICE	USE					
Approved By			Title			FEB 1 4	2019 _{ate}			
Conditions of approval, if any, are attached. Approval of this notice does not warrant or sertify that the applicant holds legal or equitable title to those rights in the subject lease which would entitle the applicant to conduct operations thereon.			Office		Bi	JREAU OF CAND	MANAGEME	NT		

Title 18 U.S.C. Section 1001 and Title 43 U.S.C. Section 1212, make it a crime for any person knowingly and willfully to make to any department or agency of the Us States any false, fictitious or fraudulent statements or representations as to any matter within its jurisdiction.



TIGERCAT FED COM 8A CTB

SECTION 08, T26S, R33E, UNIT A COORDS: 32.063199, -103.587178 LEA COUNTY, NM

WELLS:

TIGERCAT FEDERAL COM #001H: 30-025-44302 TIGERCAT FEDERAL COM #002H: 30-025-44303 TIGERCAT FEDERAL COM #003H: 30-025-44534 TIGERCAT FEDERAL COM #004H: 30-025-44535

GAS FMP METER Gas Sales Line Meter (GS): #57559

#1H Gas Lift Meter (Currently on ESP) #2H Gas Lift Meter. (Currently on ESP) #3H Gas Lift Meter (L3): #39022503 #4H Gas Lift Meter: (Currently on ESP)

VRU Gas Meter: (GV): #39022436 Flare Gas Meter (GF): #V-24787-01.1 oster Comp. Gas Meter (BG): #39022435

(BB): #12559

GAS METERS

GAS (G1): #39022437 #2H Meters GAS (G2): #39022438 GAS (G4): #39022440 Buy Back Gas Meter

#1H Meters: #3H Meters: OIL (O1): #N7031016000 OIL (O3): #N703A616000 GAS (G3): #39022439 #4H Meters: OIL (O2): #N303876000 OIL (O4): #N7031916000


ALLOCATION MTRS


Production Phase - Oil Tank #1

- Valve 1 open
- Valves 2, 3, and 4 closed
- Valves 5, 6, 7, and 8 open
- Valves 9, 10, 11, and 12 closed
- Valve 13 open
- Valves 14, 15, and 16 closed

Sales Phase - Oil Tank #1

- Valve 1 closed
- Valves 2, 3, or 4 open
- Valve 5 closed
- Valves 6, 7, and 8 open
- Valve 9 open
- Valves 10, 11, and 12 closed
- Valve 13 closed
- Valves 14, 15, or 16 open

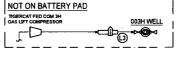

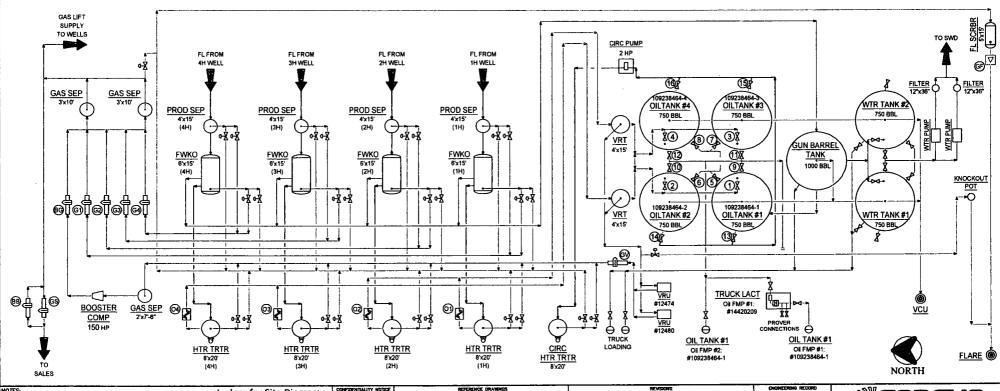

Type of Lease: Federal & Fee Federal Lease #: NMNM016040A & NMNM1060973 Property Code: 320525 OGRID #: 229137 CA NMNM138998

Ledger for Site Diagram Produced Fluid: Produced Oil: **Produced Gas:** Produced Water: ----Flare/Vent:

THIS DRAWING IS PROPERTY OF COD OPPORTING LLC AND IS LENT TO PHE BORROWER FOR COMPDENTIAL USE ORLY AND IS SHAREST TO RETURN UPON REQUEST AND SHALL HOT BE REPRODUCED. OCPRED, LENT OR OTHERWISE DEPOSED OF DRECTLY OR ROBRECTLY, NOR USED FOR ANY PURPOSE OTHER THAN DATE NO. DATE BY CHK. APP A 09/05/18 ISSUED FOR REMEW ./S C9 09/19/18 REVISED PER AS-BUILT as DP 09/20/18 RE-ISSUED FOR REVIEW AS CB AFE NO COG OPERATING LLC ONE CONCHO CENTER FACIL DIGIT SITE SECURITY PLANS LOCATED AT: 600 WEST ILLINOIS AVENUE MIDLAND, TEXAS 79701 OPER ENGR SCALE:

NORTHERN DELAWARE BASIN ASSET PRODUCTION FACELITIES SITE FACILITY DIAGRAM TIGERCAT FED COM 8A CTB

LEA COUNTY D-1700-81-005

MALTIPLE