

UNITED STATES  
DEPARTMENT OF THE INTERIOR  
BUREAU OF LAND MANAGEMENT

OCD Hobbs

FORM APPROVED  
OMB NO. 1004-0137  
Expires: January 31, 2018**SUNDRY NOTICES AND REPORTS ON WELLS**  
*Do not use this form for proposals to drill or to re-enter an abandoned well. Use form 3160-3 (APD) for such proposals.*

SUBMIT IN TRIPLICATE - Other instructions on page 2

HOBBS OCD

NOV 18 2019

RECEIVED

1. Type of Well <input checked="" type="checkbox"/> Oil Well <input type="checkbox"/> Gas Well <input type="checkbox"/> Other		5. Lease Serial No. NMLC032104
2. Name of Operator CHEVRON USA INCORPORATED		6. If Indian, Allottee or Tribe Name
Contact: CINDY H MURILLO E-Mail: CHERRERAMURILLO@CHEVRON.COM		7. If Unit or CA/Agreement, Name and/or No.
3a. Address 6301 DEAUVILLE BLVD MIDLAND, TX 79706	3b. Phone No. (include area code) Ph: 575-263-0431 Fx: 575-263-0445	8. Well Name and No. AH BLINEBRY FEDERAL NCT-1 B3 25
4. Location of Well (Footage, Sec., T., R., M., or Survey Description) Sec 28 T22S R38E SESW 660FSL 1650FWL		9. API Well No. 30-025-21403-00-C1
		10. Field and Pool or Exploratory Area BRUNSON TUBB OIL & GAS
		11. County or Parish, State LEA COUNTY, NM


## 12. CHECK THE APPROPRIATE BOX(ES) TO INDICATE NATURE OF NOTICE, REPORT, OR OTHER DATA

TYPE OF SUBMISSION	TYPE OF ACTION			
<input type="checkbox"/> Notice of Intent	<input type="checkbox"/> Acidize	<input type="checkbox"/> Deepen	<input type="checkbox"/> Production (Start/Resume)	<input type="checkbox"/> Water Shut-Off
<input checked="" type="checkbox"/> Subsequent Report	<input type="checkbox"/> Alter Casing	<input type="checkbox"/> Hydraulic Fracturing	<input type="checkbox"/> Reclamation	<input type="checkbox"/> Well Integrity
<input type="checkbox"/> Final Abandonment Notice	<input type="checkbox"/> Casing Repair	<input type="checkbox"/> New Construction	<input type="checkbox"/> Recomplete	<input checked="" type="checkbox"/> Other
	<input type="checkbox"/> Change Plans	<input type="checkbox"/> Plug and Abandon	<input type="checkbox"/> Temporarily Abandon	Site Facility Diagram/Security Plan
	<input type="checkbox"/> Convert to Injection	<input type="checkbox"/> Plug Back	<input type="checkbox"/> Water Disposal	

13. Describe Proposed or Completed Operation: Clearly state all pertinent details, including estimated starting date of any proposed work and approximate duration thereof. If the proposal is to deepen directionally or recompleat horizontally, give subsurface locations and measured and true vertical depths of all pertinent markers and zones. Attach the Bond under which the work will be performed or provide the Bond No. on file with BLM/BIA. Required subsequent reports must be filed within 30 days following completion of the involved operations. If the operation results in a multiple completion or recompleat in a new interval, a Form 3160-4 must be filed once testing has been completed. Final Abandonment Notices must be filed only after all requirements, including reclamation, have been completed and the operator has determined that the site is ready for final inspection.

CHEVRON USA INC IS SUBMITTING A SITE SECURITY DIAGRAM ON THE ABOVE WELL.  
THE WELLS BELOW ARE INCLUDED IN THE SITE SECURITY DIAGRAM.  
A H BLINEBRY FEDERAL NCT 1 BTY 3 #25 30-025-21403  
A H BLINEBRY FEDERAL NCT 1 #43 30-025-29353  
A H BLINEBRY FEDERAL NCT 1 #47 30-025-32675  
A H BLINEBRY FEDERAL NCT 1 #42 30-025-28823

PLEASE FIND ATTACHED SITE SECURITY DIAGRAM

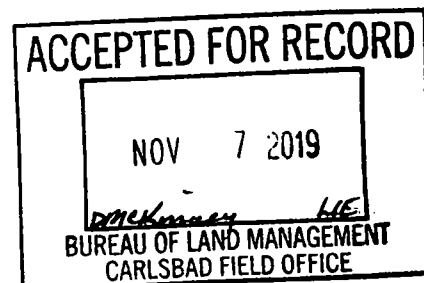

14. I hereby certify that the foregoing is true and correct. Electronic Submission #490604 verified by the BLM Well Information System For CHEVRON USA INCORPORATED, sent to the Hobbs Committed to AFMSS for processing by DEBORAH MCKINNEY on 10/31/2019 (20DLM0047SE)	
Name (Printed/Typed) CINDY H MURILLO	Title PERMITTING SPECIALIST
Signature (Electronic Submission)	Date 10/31/2019


## THIS SPACE FOR FEDERAL OR STATE OFFICE USE

Approved By _____	Title _____	Date _____
Conditions of approval, if any, are attached. Approval of this notice does not warrant or certify that the applicant holds legal or equitable title to those rights in the subject lease which would entitle the applicant to conduct operations thereon.		Office _____

Title 18 U.S.C. Section 1001 and Title 43 U.S.C. Section 1212, make it a crime for any person knowingly and willfully to make to any department or agency of the United States any false, fictitious or fraudulent statements or representations as to any matter within its jurisdiction.

(Instructions on page 2)

\*\* BLM REVISED \*\* BLM REVISED \*\* BLM REVISED \*\* BLM REVISED \*\* BLM REVISED \*\* K3

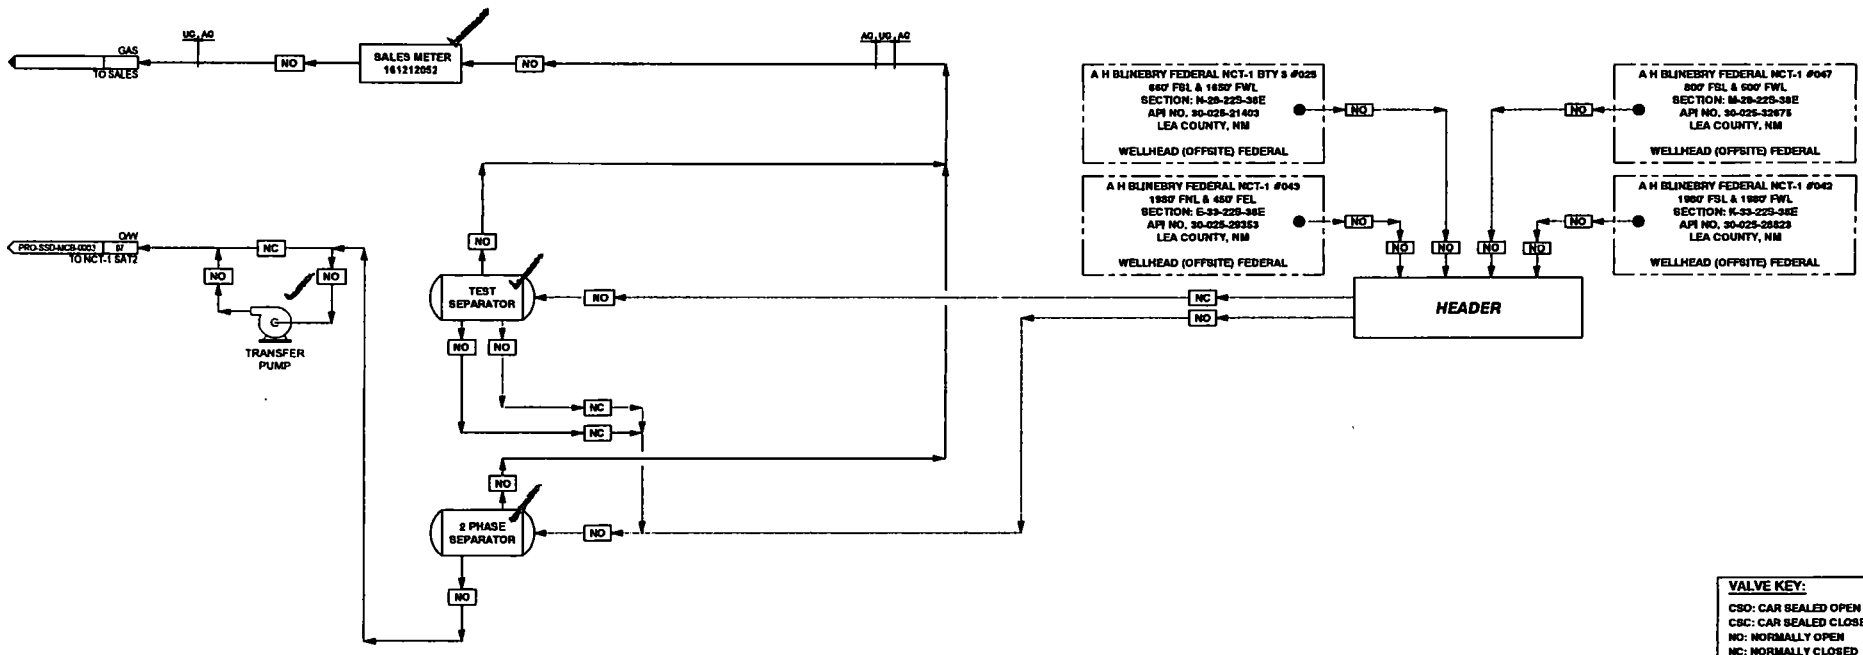

REVISIONS				
△	ISSUED AS-BUILT			△
△	BASIN DESIGN, ORF #18321	MMN 10/29/19	△	△
△			△	△
△			△	△

AS-BUILT

**Chevron U.S.A. Inc.**

EUNICE FOT - DELAWARE BASIN  
BLINEBRY OIL & GAS - LEA COUNTY, NM

BLINEBRY NCT-1 SAT 3 - SITE SECURITY DIAGRAM

**BLYOG-BLOGN1S1-PRO-SSD-MCB-0004**

DR. JCK

ENG. TZDZ

ALTERNATE DWG NUMBER API NUMBER

PLOT DATE: 10/29/2019, FILE NAME: BLYOG-BLOGN1S1-PRO-SSD-MCB-0004

LEASE NUMBER

ALTERNATE DWG NUMBER API NUMBER