

UNITED STATES  
DEPARTMENT OF THE INTERIOR  
BUREAU OF LAND MANAGEMENT

OCD Hobbs

FORM APPROVED  
OMB NO. 1004-0137  
Expires: January 31, 2018**SUNDRY NOTICES AND REPORTS ON WELLS**  
**Do not use this form for proposals to drill or to re-enter an abandoned well. Use form 3160-3 (APD) for such proposals.**5. Lease Serial No.  
NMNM97164

6. If Indian, Allottee or Tribe Name

7. If Unit or CA/Agreement, Name and/or No.

8. Well Name and No.  
FEDERAL 24 039. API Well No.  
30-025-34103-00-S110. Field and Pool or Exploratory Area  
D-K11. County or Parish, State  
LEA COUNTY, NM**SUBMIT IN TRIPLICATE - Other instructions on page 2**

1. Type of Well

☒ Oil Well ☐ Gas Well ☐ Other

2. Name of Operator

CHEVRON USA INCORPORATED

Contact: CINDY H MURILLO

E-Mail: CHERRAMURILLO@CHEVRON.COM

3a. Address

6301 DEAUVILLE BLVD  
MIDLAND, TX 79706

3b. Phone No. (include area code)

Ph: 575-263-0431

Fx: 575-263-0445

4. Location of Well (Footage, Sec., T., R., M., or Survey Description)

Sec 24 T20S R38E SWSE 467FSL 1980FEL

**12. CHECK THE APPROPRIATE BOX(ES) TO INDICATE NATURE OF NOTICE, REPORT, OR OTHER DATA**

## TYPE OF SUBMISSION


- ☐
- Notice of Intent
- 
- ☒
- Subsequent Report
- 
- ☐
- Final Abandonment Notice

## TYPE OF ACTION

- |   |   |  |   |
|---|---|--|---|
| <input type="checkbox"/> Acidize              | <input type="checkbox"/> Deepen               | <input type="checkbox"/> Production (Start/Resume) | <input type="checkbox"/> Water Shut-Off   |
| <input type="checkbox"/> Alter Casing         | <input type="checkbox"/> Hydraulic Fracturing | <input type="checkbox"/> Reclamation               | <input type="checkbox"/> Well Integrity   |
| <input type="checkbox"/> Casing Repair        | <input type="checkbox"/> New Construction     | <input type="checkbox"/> Recomplete                | <input checked="" type="checkbox"/> Other |
| <input type="checkbox"/> Change Plans         | <input type="checkbox"/> Plug and Abandon     | <input type="checkbox"/> Temporarily Abandon       | Site Facility Diagram/Security Plan       |
| <input type="checkbox"/> Convert to Injection | <input type="checkbox"/> Plug Back            | <input type="checkbox"/> Water Disposal            |   |

13. Describe Proposed or Completed Operation: Clearly state all pertinent details, including estimated starting date of any proposed work and approximate duration thereof. If the proposal is to deepen directionally or recomple horizontally, give subsurface locations and measured and true vertical depths of all pertinent markers and zones. Attach the Bond under which the work will be performed or provide the Bond No. on file with BLM/BIA. Required subsequent reports must be filed within 30 days following completion of the involved operations. If the operation results in a multiple completion or recompletion in a new interval, a Form 3160-4 must be filed once testing has been completed. Final Abandonment Notices must be filed only after all requirements, including reclamation, have been completed and the operator has determined that the site is ready for final inspection.

CHEVRON USA INC IS SUBMITTING A SITE SECURITY DIAGRAM ON THE ABOVE WELL.  
PLEASE FIND ATTACHED SITE SECURITY DIAGRAM.

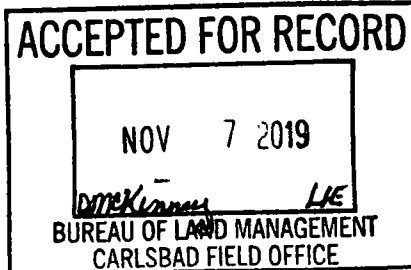

14. I hereby certify that the foregoing is true and correct.

Electronic Submission #490489 verified by the BLM Well Information System  
For CHEVRON USA INCORPORATED, sent to the Hobbs  
Committed to AFMSS for processing by DEBORAH MCKINNEY on 10/31/2019 (20DLM0045SE)

Name (Printed/Typed) CINDY H MURILLO

Title PERMITTING SPECIALIST

Signature (Electronic Submission)

Date 10/30/2019

**THIS SPACE FOR FEDERAL OR STATE OFFICE USE**

Approved By \_\_\_\_\_

Title \_\_\_\_\_

Date \_\_\_\_\_


Conditions of approval, if any, are attached. Approval of this notice does not warrant or certify that the applicant holds legal or equitable title to those rights in the subject lease which would entitle the applicant to conduct operations thereon.

Office \_\_\_\_\_

Title 18 U.S.C. Section 1001 and Title 43 U.S.C. Section 1212, make it a crime for any person knowingly and willfully to make to any department or agency of the United States any false, fictitious or fraudulent statements or representations as to any matter within its jurisdiction.

(Instructions on page 2)

**\*\* BLM REVISED \*\* BLM REVISED \*\* BLM REVISED \*\* BLM REVISED \*\* BLM REVISED \*\***

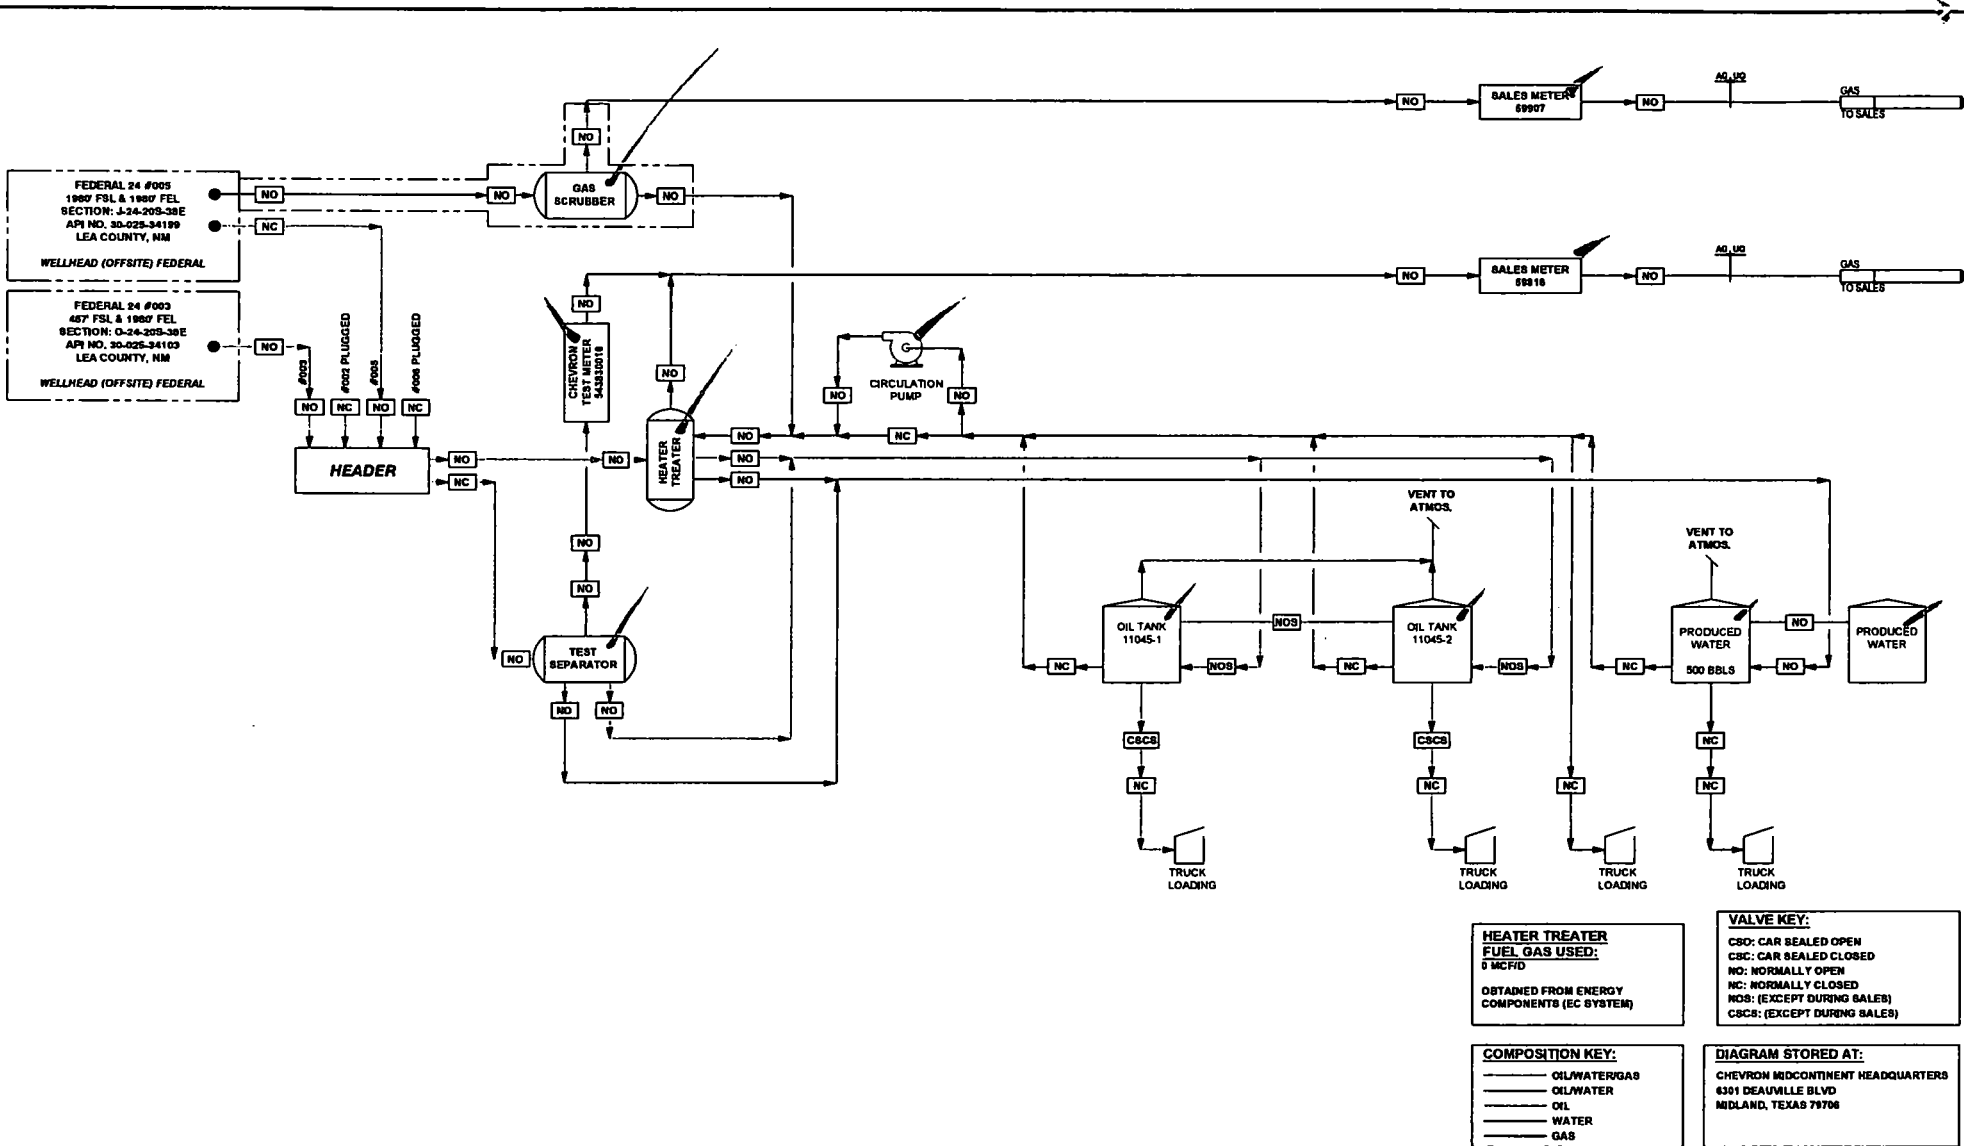

REVISIONS				AS-BUILT		Chevron U.S.A. Inc.		DELAWARE BASIN - EUNICE FOT FEDERAL 24 - LEA COUNTY, NM	
ISSUED AS-BUILT	BAZIN DESIGN, DR #19419	WTH 10/30/19	WTH	AS-BUILT	AS-BUILT	DR. MWH	ENG. TZZZ	FEDERAL 24 ALL - SITE SECURITY DIAGRAM	FEDRL-ALL-PRO-SSD-MCB-0001

PLOT DATE: 10/30/2019, FILE NAME: FEDRL-ALL-PRO-SSD-MCB-0001 LEASE NUMBER ALTERNATE DWG NUMBER API NUMBER