District 1 1625 N. French Dr., Hobbs, NM 88240 Phone: (575) 393-6161 Fax: (575) 393-0720 District 11 811 S. First St., Artesia, NM 88210 Phone: (575) 748-1283 Fax: (575) 748-9720 District III 1000 Rio Brazos Road, Aztec, NM 87410 Phone: (505) 334-6178 Fax: (505) 334-6170 District IV 1220 S. St. Francis Dr., Santa Fe, NM 87505 Phone: (505) 476-3460 Fax: (505) 476-3462 State of New Mexico
Energy, Minerals & Natural Resources And 2 3 2020


Department
OIL CONSERVATION DIVISION ECEIVED
1220 South St. Francis Dr.
Santa Fe, NM 87505


FORM C-102
Revised August 1, 2011
Submit one copy to appropriate
District Office

WELL LOCATION AND ACREAGE DEDICATION PLAT

¹ API Number				² Pool Code		³ Pool Name						
30-	-025-45	856		98092	; UPPER WC	ER WOLFCAMP						
Property Code					6	⁶ Well Number						
3253			I		702H							
OGRID No.				-		⁹ Elevation						
7377				EO		3477'						
¹⁰ Surface Location												
UL or lot no.	Section	Township	Range	Lot Idn	Feet from the			East/West line	County			
D	2	25-S	33-E	-	291'	NORTH	299'	WEST	LEA			
¹¹ Bottom Hole Location If Different From Surface												
UL or lot no.	Section	Township	Range Lot Idn		Feet from the	North/South line	Feet from the	East/West line	County			
M	2	25-S	33-E	-	107'	SOUTH	1011,	WEST	LEA			
¹² Dedicated Acres	13 Joint or	Infill 14Co	nsolidation Cod	le 15Orde	r No.				•			
319.79												

No allowable will be assigned to this completion until all interests have been consolidated or a non-standard unit has been approved by

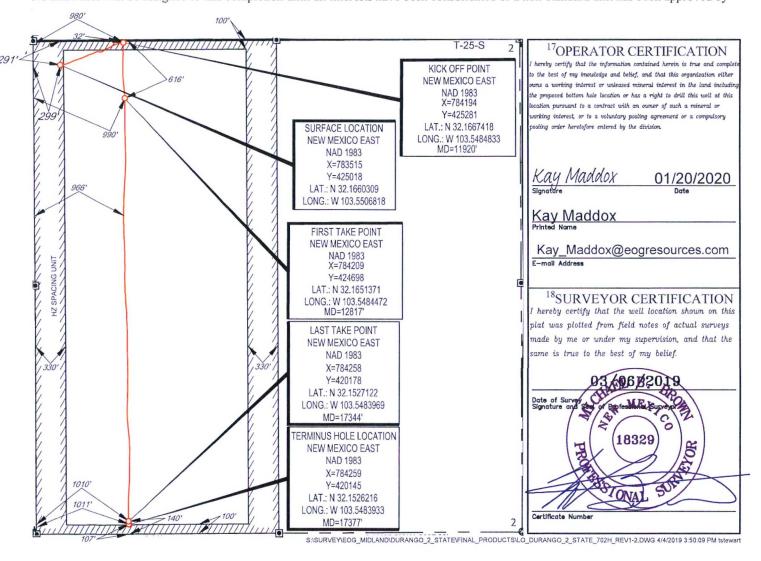

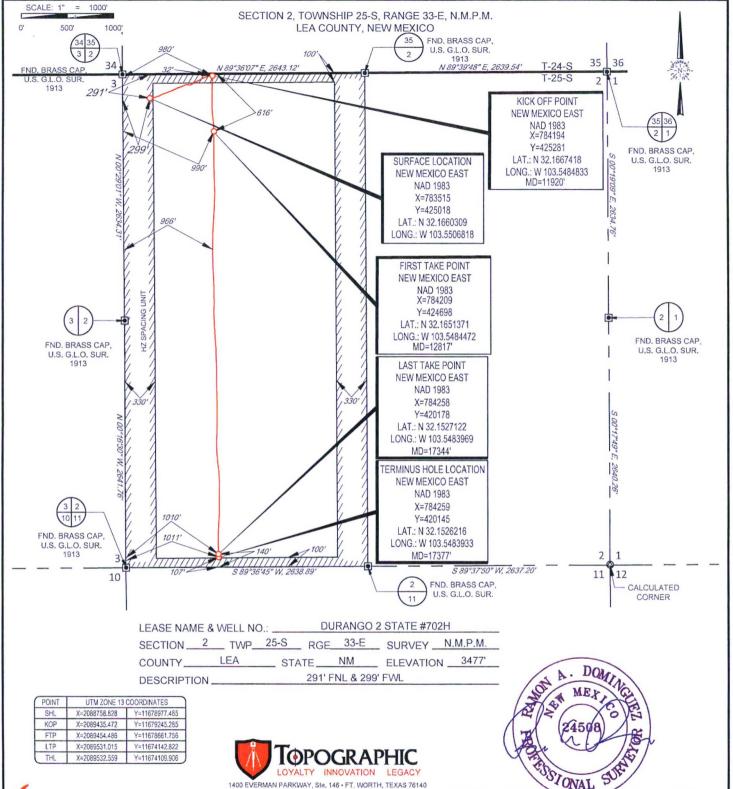



TELEPHONE: (817) 744-7512 - FAX (817) 744-7554
2903 NORTH BIG SPRING - MIDLAND, TEXAS 79705
TELEPHONE: (432) 682-1653 OR (800) 767-1653 - FAX (432) 682-1743
WWW.TOPOGRAPHIC.COM



Ramon A. Dominguez, P.S. No. 24508 **DECEMBER 23, 2019**

	REVISION:				
DURANGO 2 STATE #702H AS-COMPLETE					
710 OOMI EETE					
DATE: 12/23/2019					
FILE:AD_DURANGO_2_STATE_702H					
DRAWN BY: JLS					
SHEET: 1 OF 1					

NOTES

ORIGINAL DOCUMENT SIZE: 8.5" X 11"

ALL BEARINGS, DISTANCES, AND COORDINATE VALUES CONTAINED HEREIN ARE GRID BASED UPON THE NEW MEXICO COORDINATE SYSTEM OF 1983, EAST ZONE, U.S. SURVEY FEET.

THIS WELL LOCATION SHOWN HEREON HAS BEEN SURVEYED ON THE GROUND UNDER MY SUPERVISION AND PREPARED ACCORDING TO THE EVIDENCE FOUND AT THE TIME OF SURVEY, AND DATA PROVIDED BY EOG RESOURCES, INC. THIS CERTIFICATION IS MADE AND LIMITED TO THOSE PERSONS OR ENTITIES SHOWN ON THE FACE OF THIS PLAT AND IS NON-TRANSFERABLE. THIS SURVEY IS CERTIFIED FOR THIS TRANSACTION ONLY.

Intent [As Drill	ed xx	<										
API#	-45856													
30-025-45856 Operator Name: EOG RESOURCES, INC						Property Name: DURANGO 2 STATE						Well Number 702H		
Kick Off P	oint (KOf	P)												
UL Sec D 2	tion Tov	wnship S	Range 33E	Lot	Feet 32		From N		Feet 980		m E/W EST	County LEA		
Latitude 32.1667418						Longitude 103.5484833						NAD 1983		
					<u> </u>							1		
First Take Point (FTP)														
UL Sec	tion Tov	wnship	Range 33E	Lot	Feet 616		From N	-	Feet 990		m E/W EST	County		
Latitude 32.165		<u>-</u>			Longitu	Longitude 103.5484472						NAD 1983		
02.100					1.00.							1.000		
Last Take Point (LTP)														
UL Sec M 2	tion Tov	wnship S	Range 33E	Lot	Feet 140									
Latitude	7422			·	1 -	Longitude NAD						22		
32.1527122					103.	103.5483969 1983						3		
Is this well the defining well for the Horizontal Spacing Unit? NO														
Is this well an infill well? YES														
If infill is yes please provide API if available, Operator Name and well number for Defining well for Horizontal Spacing Unit.														
API # 30-025	- 4 5847													
Operator Name:						Property Name:						Well Number		
EOG RESOURCES, INC						DURANGO 2 STATE						#703H		