PAGE 1 OF 2


DRAWN BY: WN

W.O. #20-96

HOBBS OCD State of New Mexico DISTRICT I

1025 N. FRENCE DR. HOBBS, NM 88240
Frome: (676) S03-6161 Fax: (676) S03-0720

Energy, Minerals & Natural Resources Dana 2ttm 2020 Form C-102 DISTRICT II 811 S. FIRST ST., ARTESIA, NM 88210 Phone: (675) 748-1283 Pag: (675) 748-9720 OIL CONSERVATION DIVISION Revised August 1, 2011 1220 SOUTH ST. FRANCIS DRECEIVED one copy to appropriate Santa Fe, New Mexico 87505RECEIVED District Office DISTRICT III 1000 RIO BRAZOS RD., AZTEC, NM 87410 Phone: (505) 334-6178 Fax: (505) 334-6170 DISTRICT IV 1220 S. ST. FRANCIS DR., SANTA FE, NM 87505 Phone: (505) 476-3460 Fax: (505) 476-3462 **Ø** AMENDED REPORT AS DRILLED WELL LOCATION AND ACREAGE DEDICATION PLAT WC-025 G-09 S263504N; WOLFCAMP API Number Pool Code 98117 30-025-44570 Property Code Property Name Well Number 326333 TATANK FEDERAL COM **4H** OGRID No. Operator Name Elevation 229137 COG OPERATING, LLC 3027.1 Surface Location Section Feet from the East/West line UL or lot No. Township Range Lot Idn Feet from the North/South line County 230 SOUTH 436 **EAST** 11 26-S 35-E LEA Bottom Hole Location If Different From Surface UL or lot No. Section Township Range Lot Idn Feet from the North/South line Feet from the East/West line County 79 **NORTH** 975 Α 26-S 35-E **EAST** LEA Dedicated Acres Joint or Infill Consolidation Code Order No. 320 NO ALLOWABLE WILL BE ASSIGNED TO THIS COMPLETION UNTIL ALL INTERESTS HAVE BEEN CONSOLIDATED OR A NON-STANDARD UNIT HAS BEEN APPROVED BY THE DIVISION SEE PAGE 2

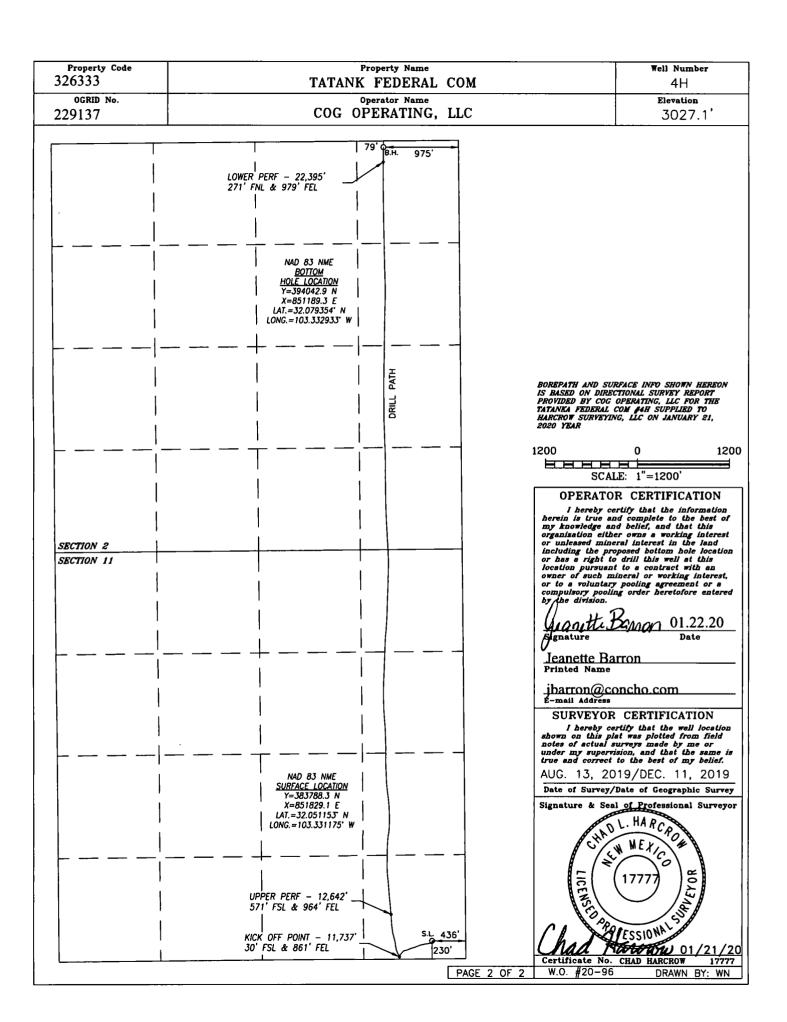

API # 30-025-44570  Operator Name: Property Name: Well Num COG OPERATING, LLC TATANKA FEDERAL COM 4H
Operator Name: Property Name: Well Num
COG OPERATING, LLC TATANKA FEDERAL COM 4H
Kick Off Point (KOP)
UL Section Township Range Lot Feet From N/S Feet From E/W County
P   11   26S   35E     30   SOUTH   861   EAST   LEA   Latitude   Longitude   NAD
32.050603 -103.332546 83
L.,,
First Take Point (FTP)
UL Section Township Range Lot Feet From N/S Feet From E/W County
P 11 26S 35E 571 SOUTH 964 EAST LEA
Latitude
32.032091  -103.332076   03
A via Talla Datisa (LTD)
Last Take Point (LTP)
UL Section Township Range Lot Feet From N/S Feet From E/W County A 2 26S 35E 271 NORTH 979 EAST LEA
Latitude Longitude NAD
32.078827  -103.332946  83
Is this well the defining well for the Horizontal Spacing Unit?
to Abic well are infill well?
Is this well an infill well?
If infill is yes please provide API if available, Operator Name and well number for Defining well for Horizont Spacing Unit.
API#
Operator Name: Property Name: Well Nun

KZ 06/29/2018