

I. REQUEST FOR ALLOWABLE MINERAL AUTHORIZATION TO TRANSPORT

¹ Operator name and Address EOG RESOURCES INC PO BOX 2267 MIDLAND, TEXAS 79702		² OGRID Number 7377
		³ Reason for Filing Code/ Effective Date NW 10/31/2021
⁴ API Number 30 - 025-48874	⁵ Pool Name WC025 G08 S253216D; UPPER WOLFCAMP	⁶ Pool Code 98270
⁷ Property Code 330825	⁸ Property Name ALMOST EDDY 30 FEDERAL COM	⁹ Well Number 722H

II. ¹⁰ Surface Location

Ul or lot no. K	Section 30	Township 25S	Range 32E	Lot Idn	Feet from the 2249	North/South Line SOUTH	Feet from the 1728	East/West line WEST	County LEA
--------------------	---------------	-----------------	--------------	---------	-----------------------	---------------------------	-----------------------	------------------------	---------------

¹¹ Bottom Hole Location

UL or lot no. M	Section 31	Township 25S	Range 32E	Lot Idn	Feet from the 107	North/South line SOUTH	Feet from the 1277	East/West line WEST	County LEA
¹² Lse Code	¹³ Producing Method Code FLOWING	¹⁴ Gas Connection Date	¹⁵ C-129 Permit Number		¹⁶ C-129 Effective Date		¹⁷ C-129 Expiration Date		

III. Oil and Gas Transporters

¹⁸ Transporter OGRID	¹⁹ Transporter Name and Address	²⁰ O/G/W
372812	EOGRM	OIL
151618	ENTERPRISE FIELD SERVICES	GAS
298751	REGENCY FIELD SERVICES	GAS
36785	DCP MIDSTREAM	GAS

IV. Well Completion Data

²¹ Spud Date 06/19/2021	²² Ready Date 10/31/2021	²³ TD 19,670'	²⁴ PBDT 19,647'	²⁵ Perforations 12,400 - 19,647'	²⁶ DHC, MC
²⁷ Hole Size		²⁸ Casing & Tubing Size	²⁹ Depth Set		³⁰ Sacks Cement
12 1/4"		9 5/8"	1240'		660 SXS CL C/CIRC
8 3/4"		7 5/8"	11,233'		1427 SXS CL C & H/CIRC
6 3/4"		5 1/2"	19,654'		830 SXS CL H TOC 10,960' CBL

V. Well Test Data

³¹ Date New Oil 10/31/2021	³² Gas Delivery Date 10/31/2021	³³ Test Date 11/05/2021	³⁴ Test Length 24 HRS	³⁵ Tbg. Pressure	³⁶ Csg. Pressure 2738
³⁷ Choke Size 54	³⁸ Oil 3373	³⁹ Water 5953	⁴⁰ Gas 11894		⁴¹ Test Method
⁴² I hereby certify that the rules of the Oil Conservation Division have been complied with and that the information given above is true and complete to the best of my knowledge and belief. Signature: Kay Maddox			OIL CONSERVATION DIVISION		
Printed name: Kay Maddox			Approved by: Sarah McGrath		
Title: SENIOR REGULATORY SPECIALIST			Title: Petroleum Specialist - A		
E-mail Address: kay_maddox@eogresources.com			Approval Date: 07/27/2022		
Date: 11/18/2021		Phone: 432-638-8475	File 3160-4 Completion Report within 10 days to NMOCD after BLM approval.		

District I
1625 N. French Dr., Hobbs, NM 88240
Phone: (575) 393-6161 Fax: (575) 393-0720
District II
811 S. First St., Artesia, NM 88210
Phone: (575) 748-1283 Fax: (575) 748-9720
District III
1000 Rio Brazos Road, Aztec, NM 87410
Phone: (505) 334-6178 Fax: (505) 334-6170
District IV
1220 S. St. Francis Dr., Santa Fe, NM 87505
Phone: (505) 476-3460 Fax: (505) 476-3462

State of New Mexico
Energy, Minerals & Natural Resources
Department
OIL CONSERVATION DIVISION
1220 South St. Francis Dr.
Santa Fe, NM 87505

FORM C-102

Revised August 1, 2011

Submit one copy to appropriate

District Office

☒ AMENDED REPORT
AS-COMPLETED

WELL LOCATION AND ACREAGE DEDICATION PLAT

¹ API Number 30-025-48874		² Pool Code 98270	³ Pool Name WC025 G08 S253216D; UPPPER WOLFCAMP
⁴ Property Code 330825	⁵ Property Name ALMOST EDDY 30 FED COM		⁶ Well Number 722H
⁷ GRID No. 7377	⁸ Operator Name EOG RESOURCES, INC.		⁹ Elevation 3353'

¹⁰Surface Location


UL or lot no.	Section	Township	Range	Lot Idn	Feet from the	North/South line	Feet from the	East/West line	County
K	30	25-S	32-E	-	2249'	SOUTH	1728'	WEST	LEA

¹¹Bottom Hole Location If Different From Surface


UL or lot no.	Section	Township	Range	Lot Idn	Feet from the	North/South line	Feet from the	East/West line	County
4	31	25-S	32-E	-	107'	SOUTH	1277'	WEST	LEA

¹² Dedicated Acres 480.22	¹³ Joint or Infill	¹⁴ Consolidation Code	¹⁵ Order No.
--	-------------------------------	----------------------------------	-------------------------

No allowable will be assigned to this completion until all interests have been consolidated or a non-standard unit has been approved by the division.

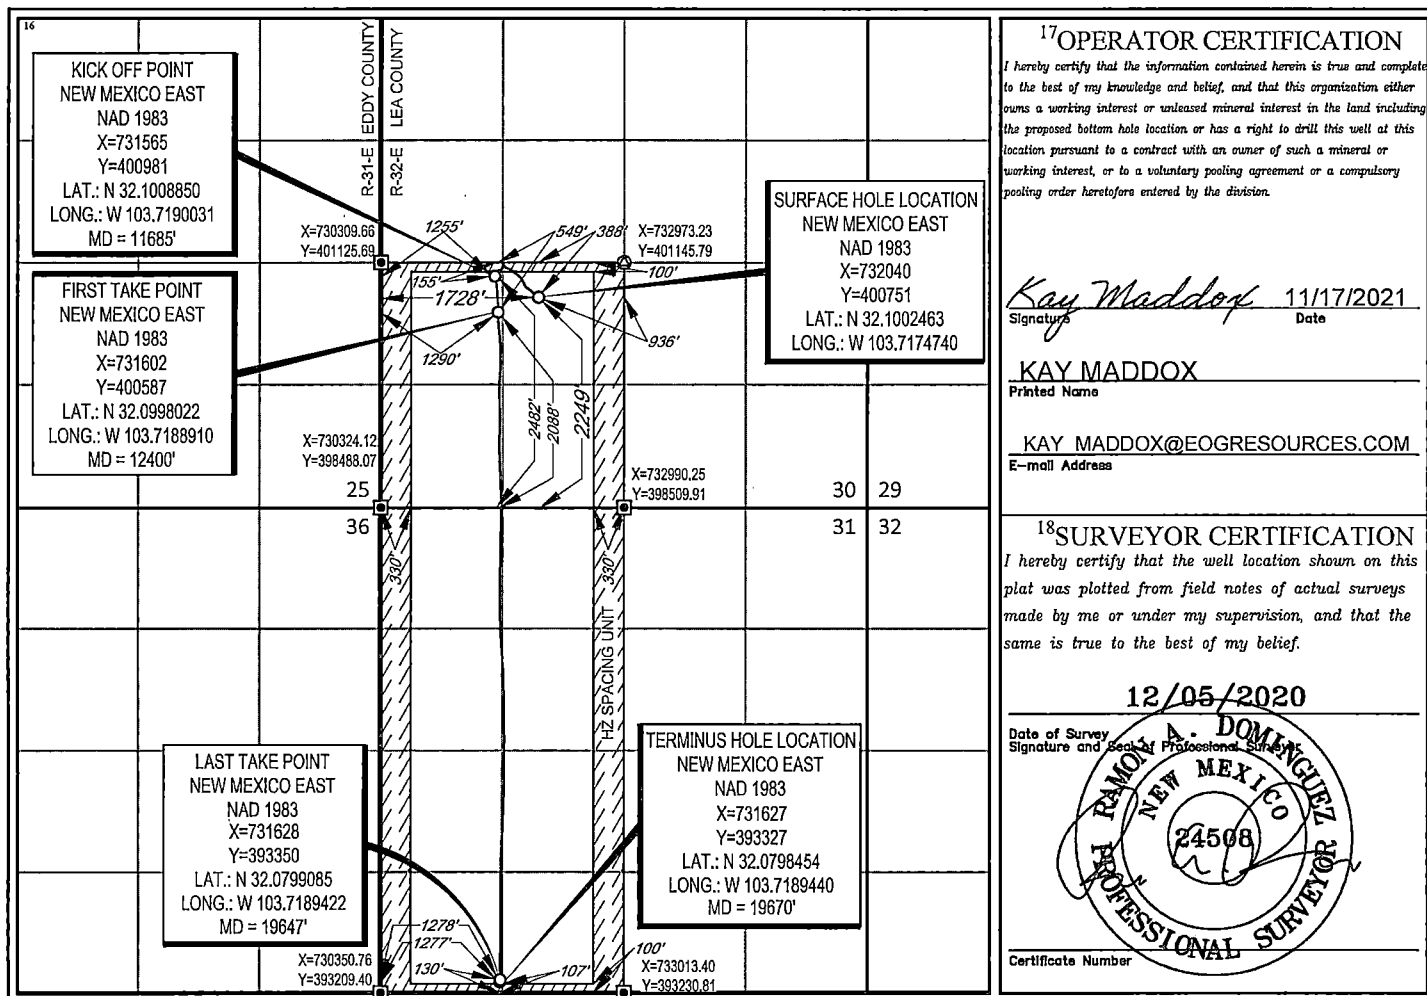


S:\SURVEY\EOG_MIDLAND\ALMOST_EDDY_30_FED_COM\FINAL_PRODUCTS\AD_ALMOST_EDDY_30_FED_COM_722H.DWG 10/22/2021 10:21:16 AM bzollinger

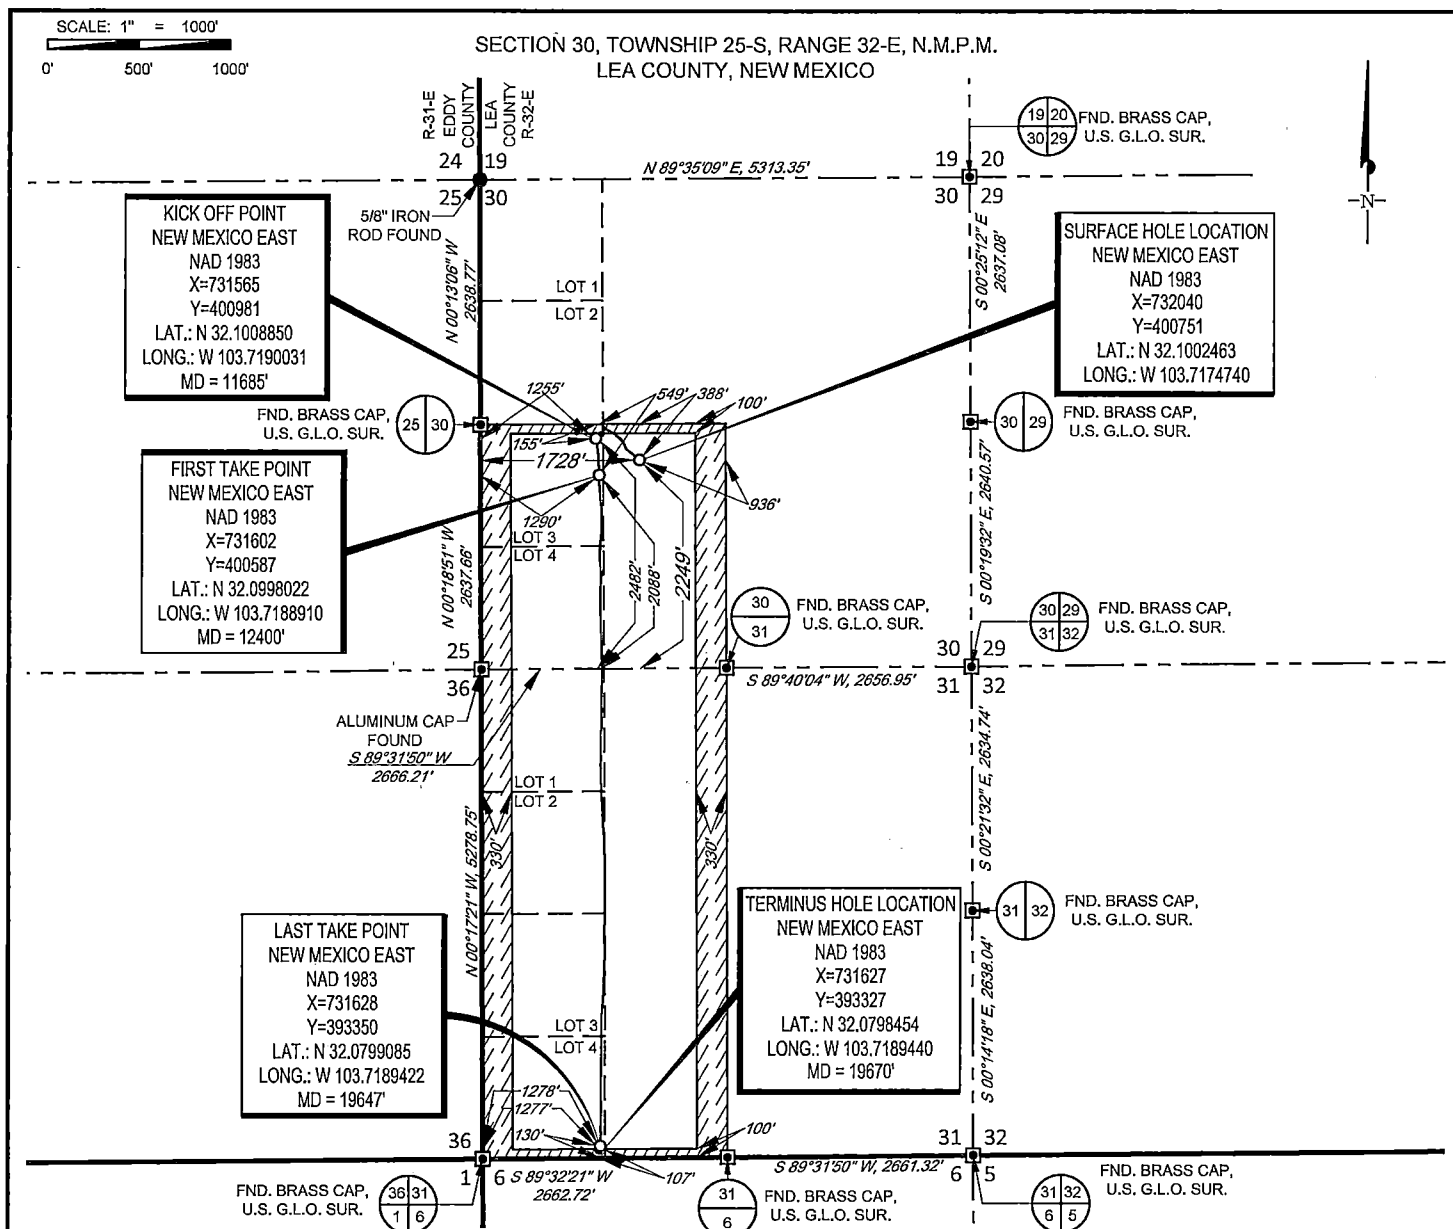

TOPOGRAPHIC
LOYALTY INNOVATION LEGACY

1400 EVERMAN PARKWAY, Ste. 146 • FT. WORTH, TEXAS 76140
TELEPHONE: (817) 744-7512 • FAX (817) 744-7554
2903 NORTH BIG SPRING • MIDLAND, TEXAS 79705
TELEPHONE: (432) 682-1653 OR (800) 767-1653 • FAX (432) 682-1743
WWW.TOPOGRAPHIC.COM

Geog resources, Inc.

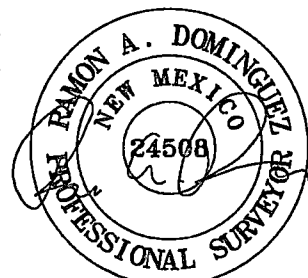

Ramon A. Dominguez, P.S. No. 24508
OCTOBER 21, 2021

ALMOST EDDY 30 FED COM 722H AS-COMplete	REVISION:	NOTES:
DATE: 10/19/2021		1. ORIGINAL DOCUMENT SIZE: 8.5" X 11"
FILE: AD_ALMOST_EDDY_30_FED_COM_722H		2. ALL BEARINGS, DISTANCES, AND COORDINATE VALUES CONTAINED HEREIN ARE GRID BASED UPON THE NEW MEXICO COORDINATE SYSTEM OF 1983, EAST ZONE, U.S. SURVEY FEET.
DRAWN BY: A.V.F.		3. THIS WELL LOCATION SHOWN HEREON HAS BEEN SURVEYED ON THE GROUND UNDER MY SUPERVISION AND PREPARED ACCORDING TO THE EVIDENCE FOUND AT THE TIME OF SURVEY, AND DATA PROVIDED BY EOG RESOURCES, INC. THIS CERTIFICATION IS MADE AND LIMITED TO THOSE PERSONS OR ENTITIES SHOWN ON THE FACE OF THIS PLAT AND IS NON-TRANSFERABLE. THIS SURVEY IS CERTIFIED FOR THIS TRANSACTION ONLY.
SHEET: 1 OF 1		4. ADJOINER INFORMATION SHOWN FOR INFORMATIONAL PURPOSES ONLY.

S:\SURVEY\EOG_MIDLAND\ALMOST_EDDY_30_FED_COM\FINAL_PRODUCTS\AD_ALMOST_EDDY_30_FED_COM_722H.DWG 10/22/2021 10:21:16 AM bzollinger



Lea County, NM (NAD 83 NME)

Almost Eddy 30 Fed Com #722H


OH

PROJECT DETAILS: Lea County, NM (NAD 83 NME)

Geodetic System: US State Plane 1983
Datum: North American Datum 1983
Ellipsoid: GRS 1980
Zone: New Mexico Eastern Zone
System Datum: Mean Sea Level

WELL DETAILS: #722H










3353.0
kb = 25' @ 3378.0usft
Northing 400751.00 Easting 732040.00 Latitude 32° 6' 0.888 N Longitude 103° 43' 2.908 W

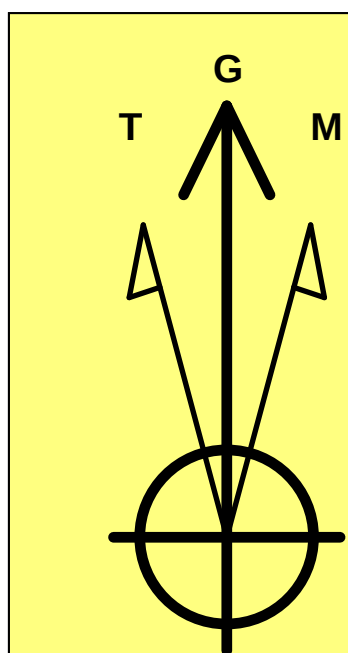

Azimuths to Grid North
True North: -0.33°
Magnetic North: 6.27°

Magnetic Field
Strength: 47398.5nT
Dip Angle: 59.76°
Date: 7/13/2021
Model: IGRF2020

To convert a Magnetic Direction to a Grid Direction, Add 6.27°
To convert a Magnetic Direction to a True Direction, Add 6.59° East
To convert a True Direction to a Grid Direction, Subtract 0.33°

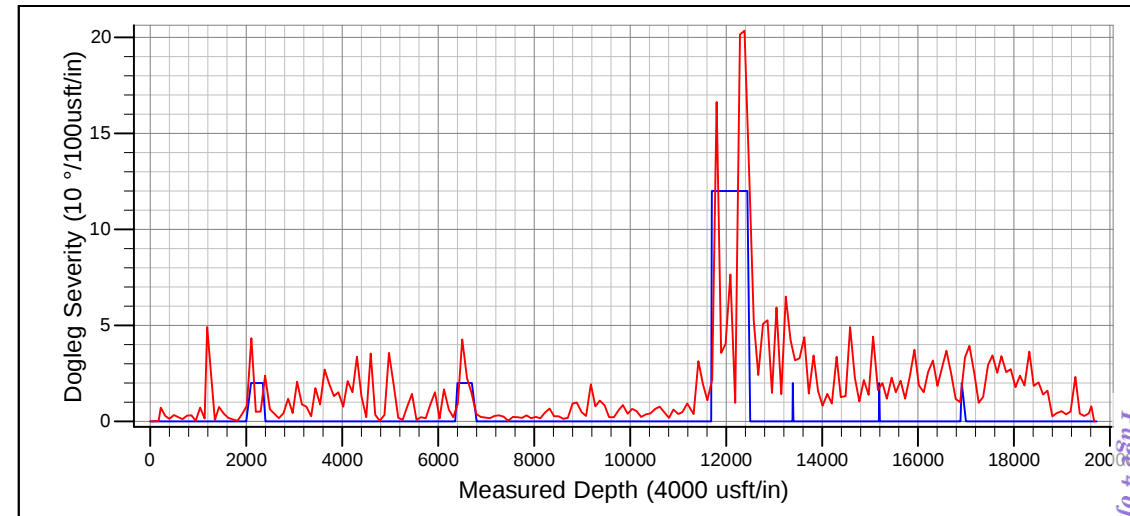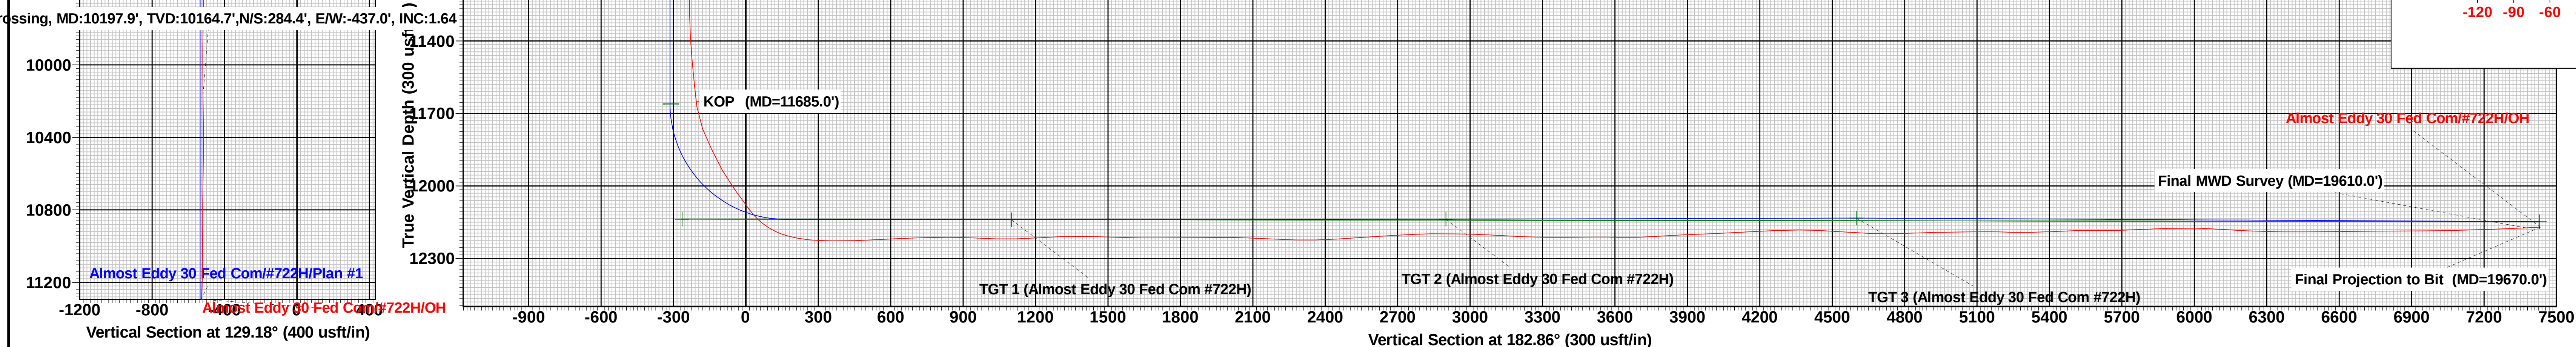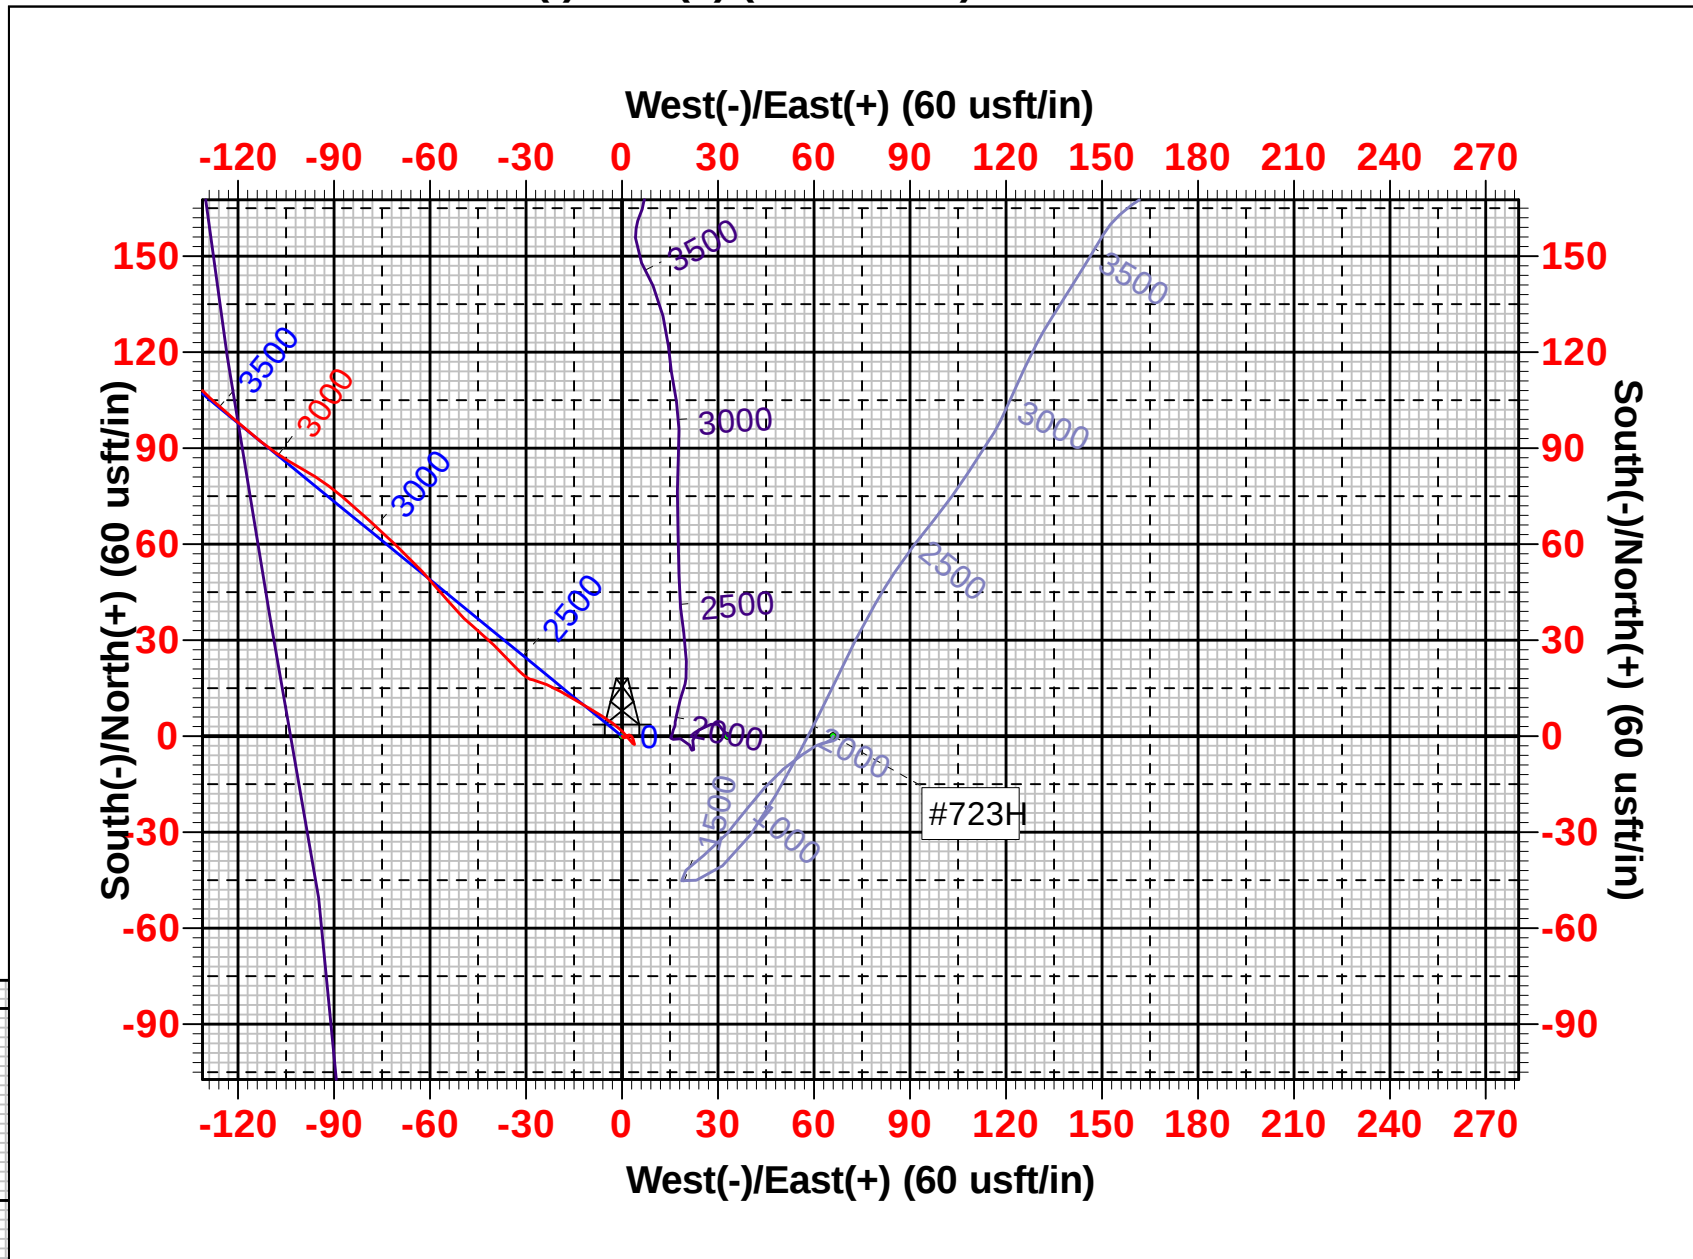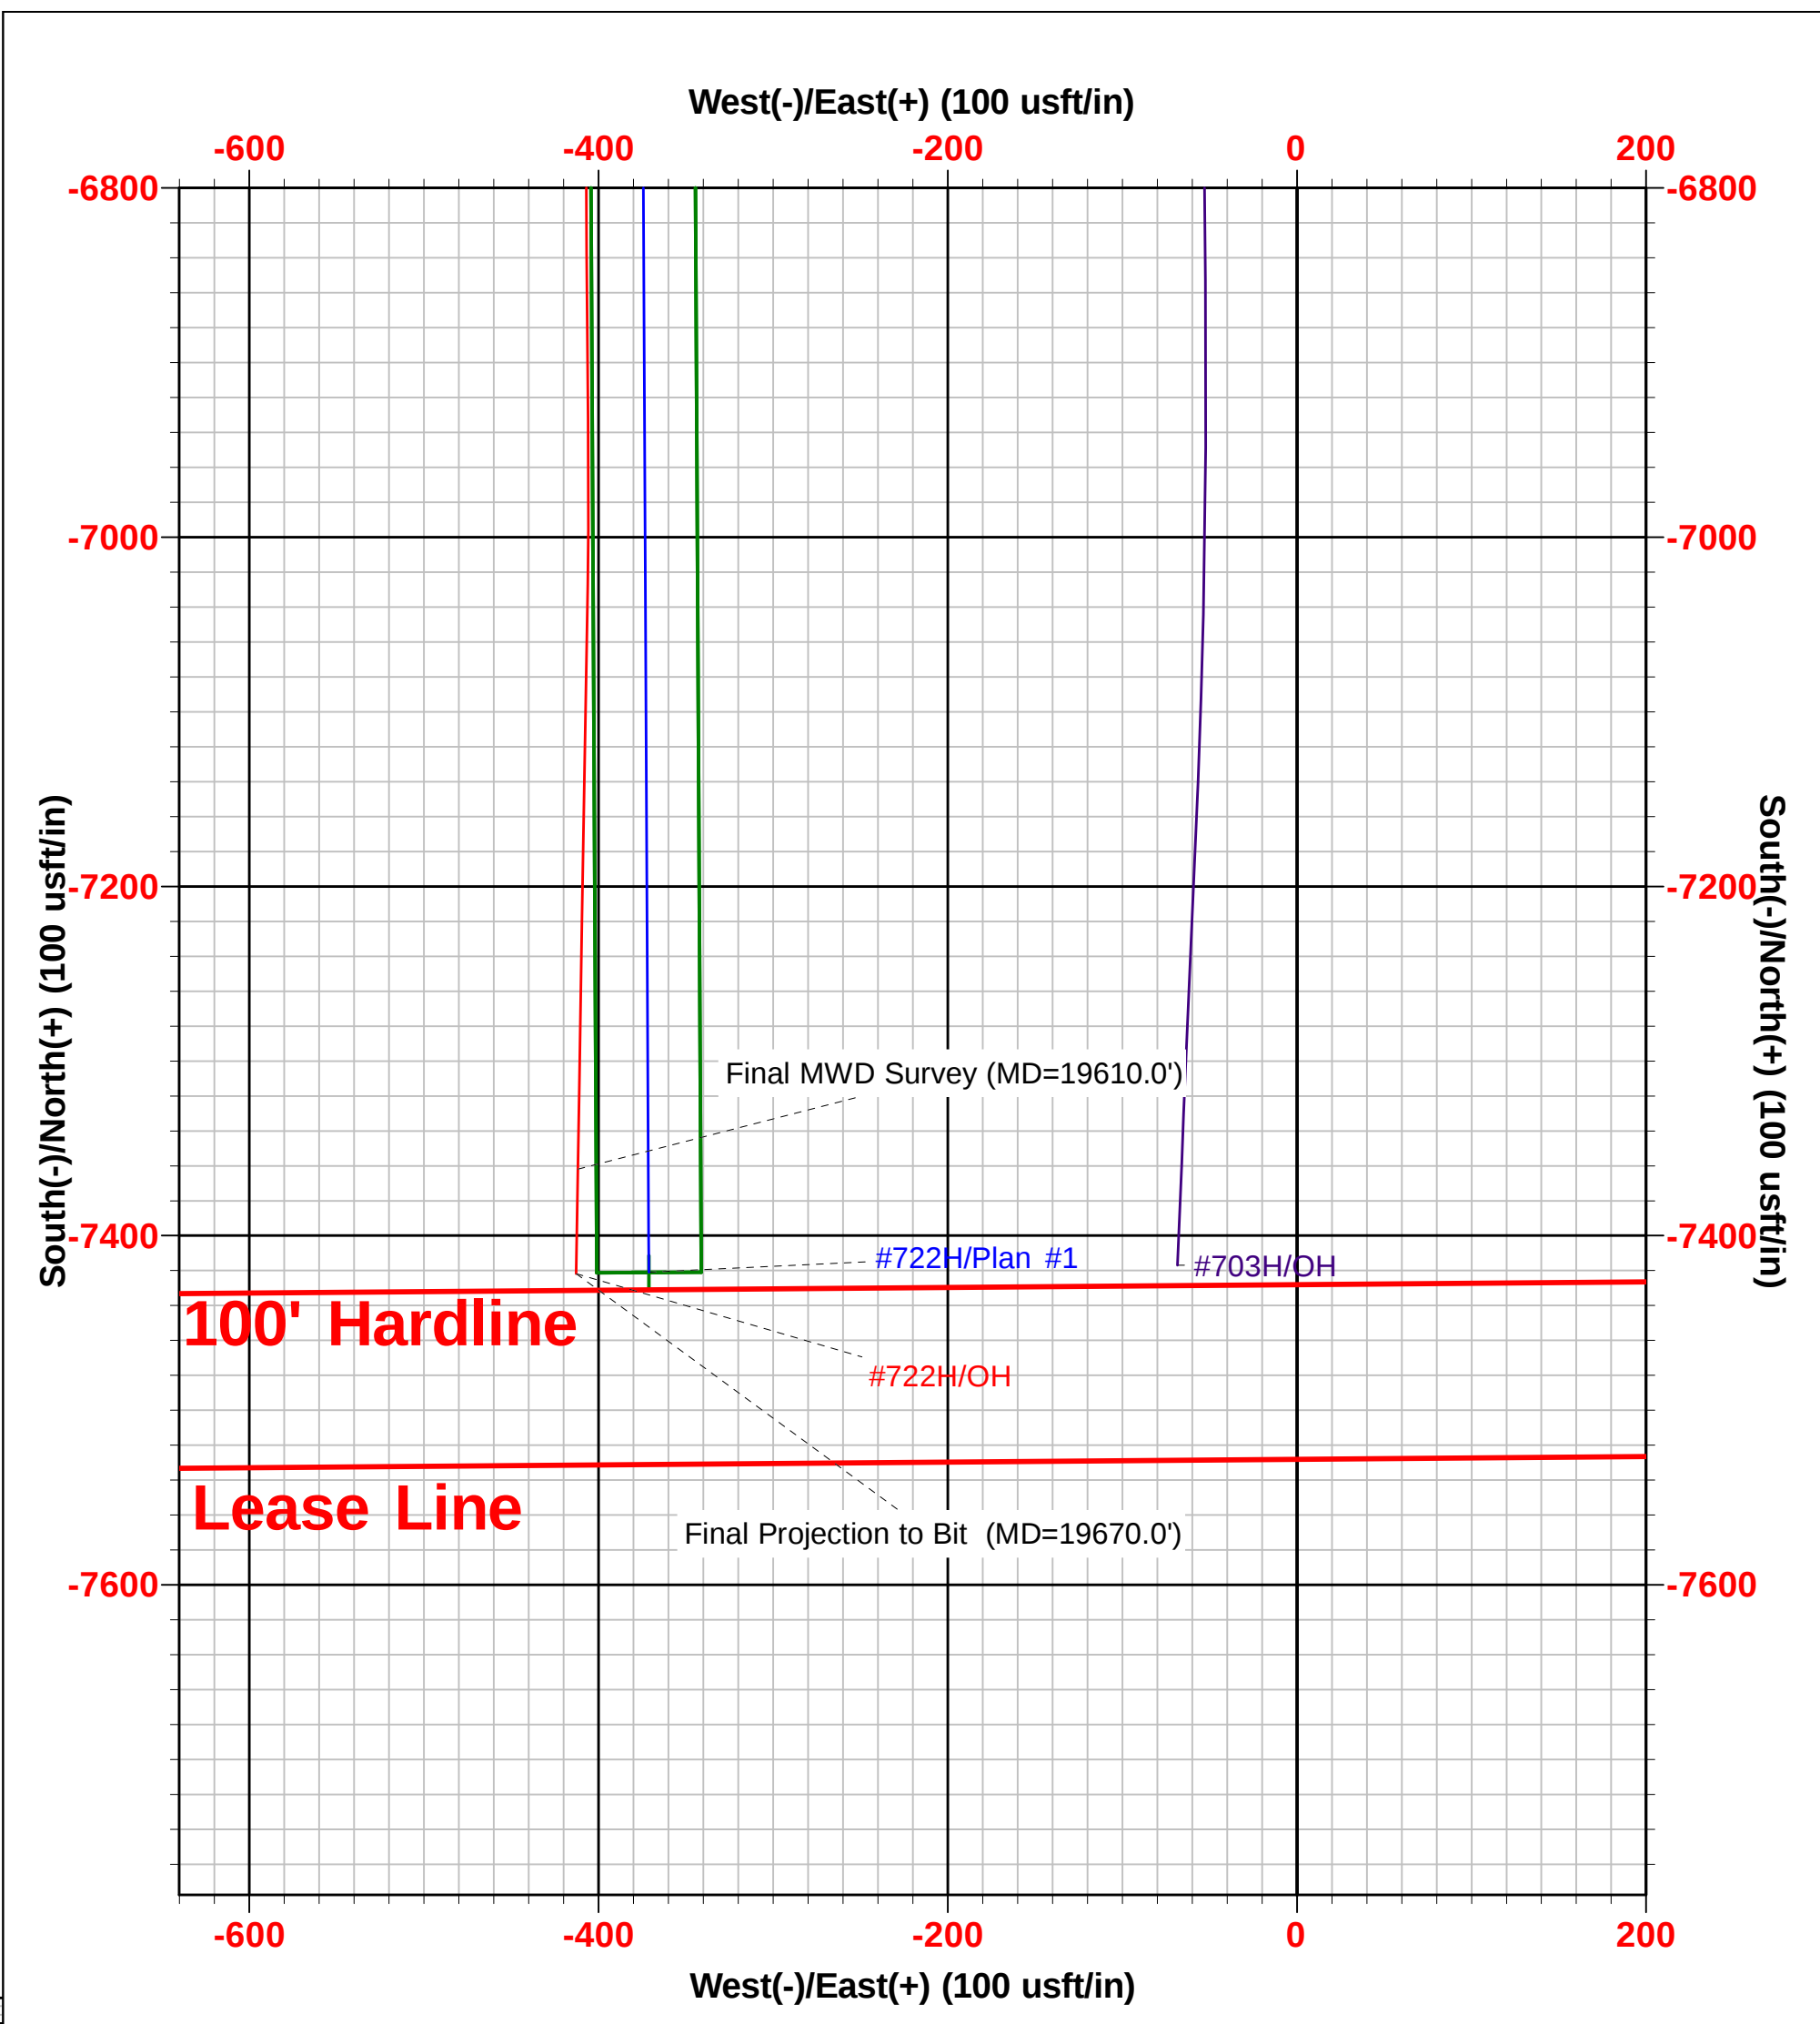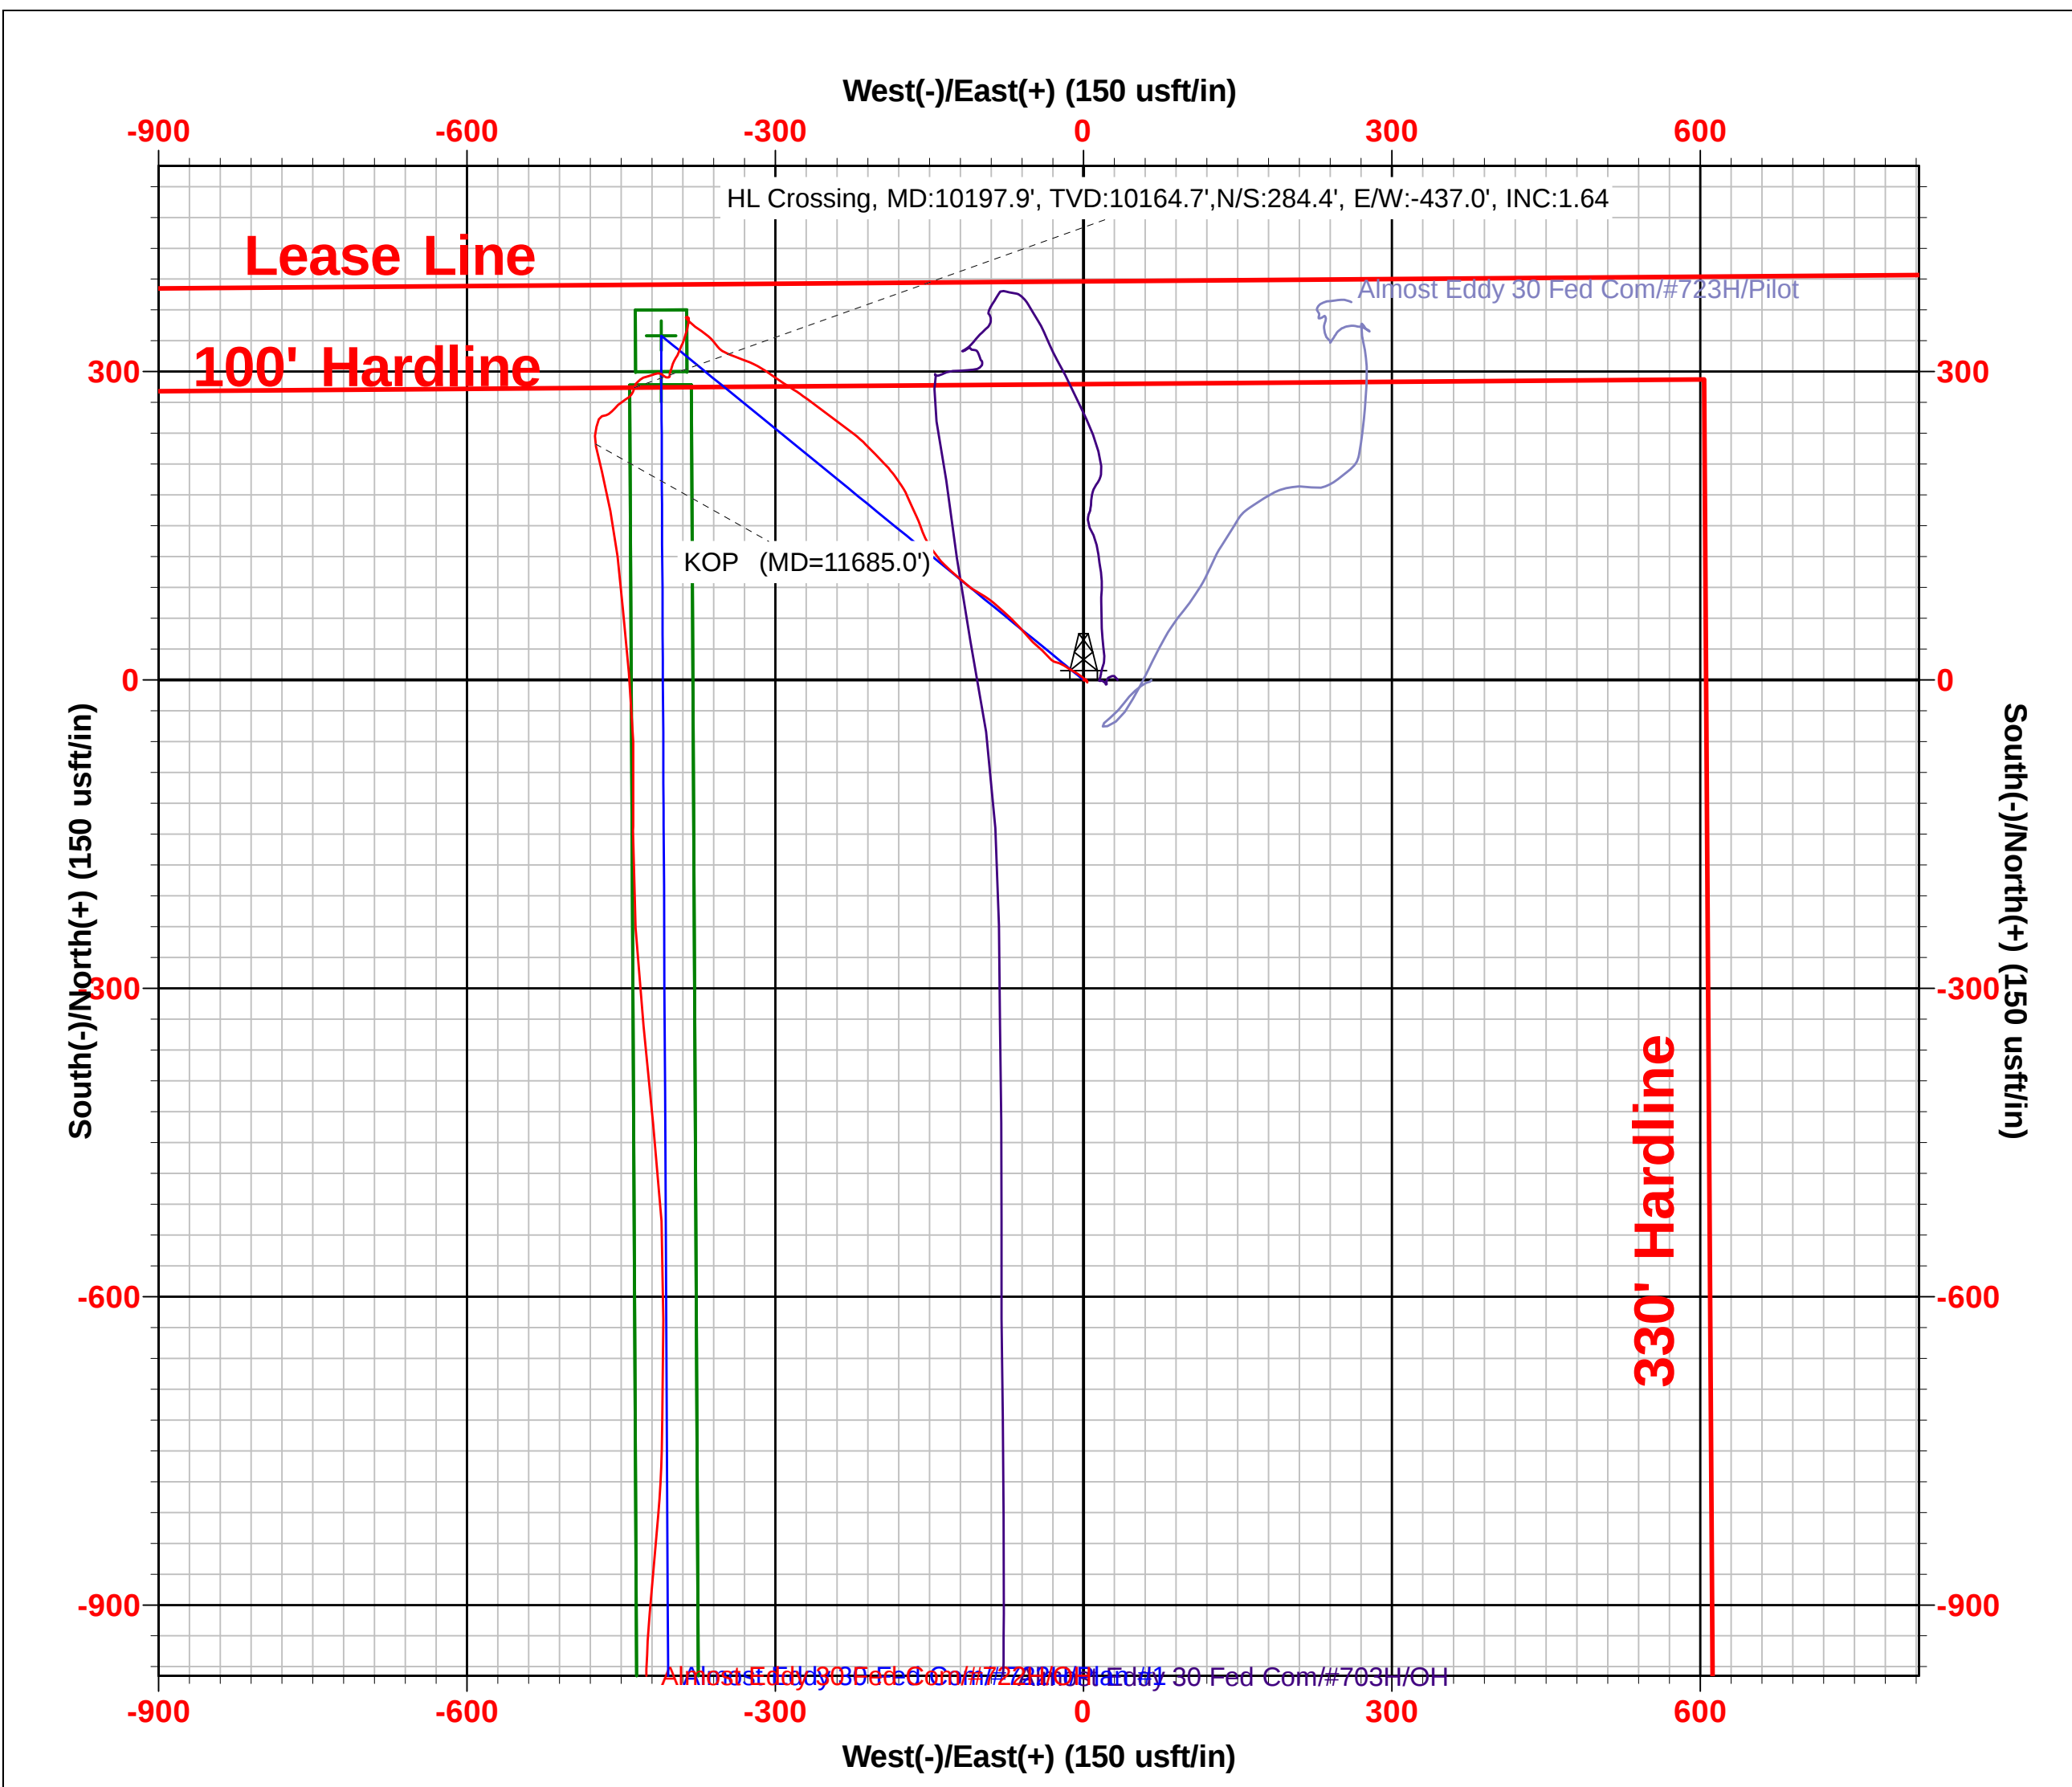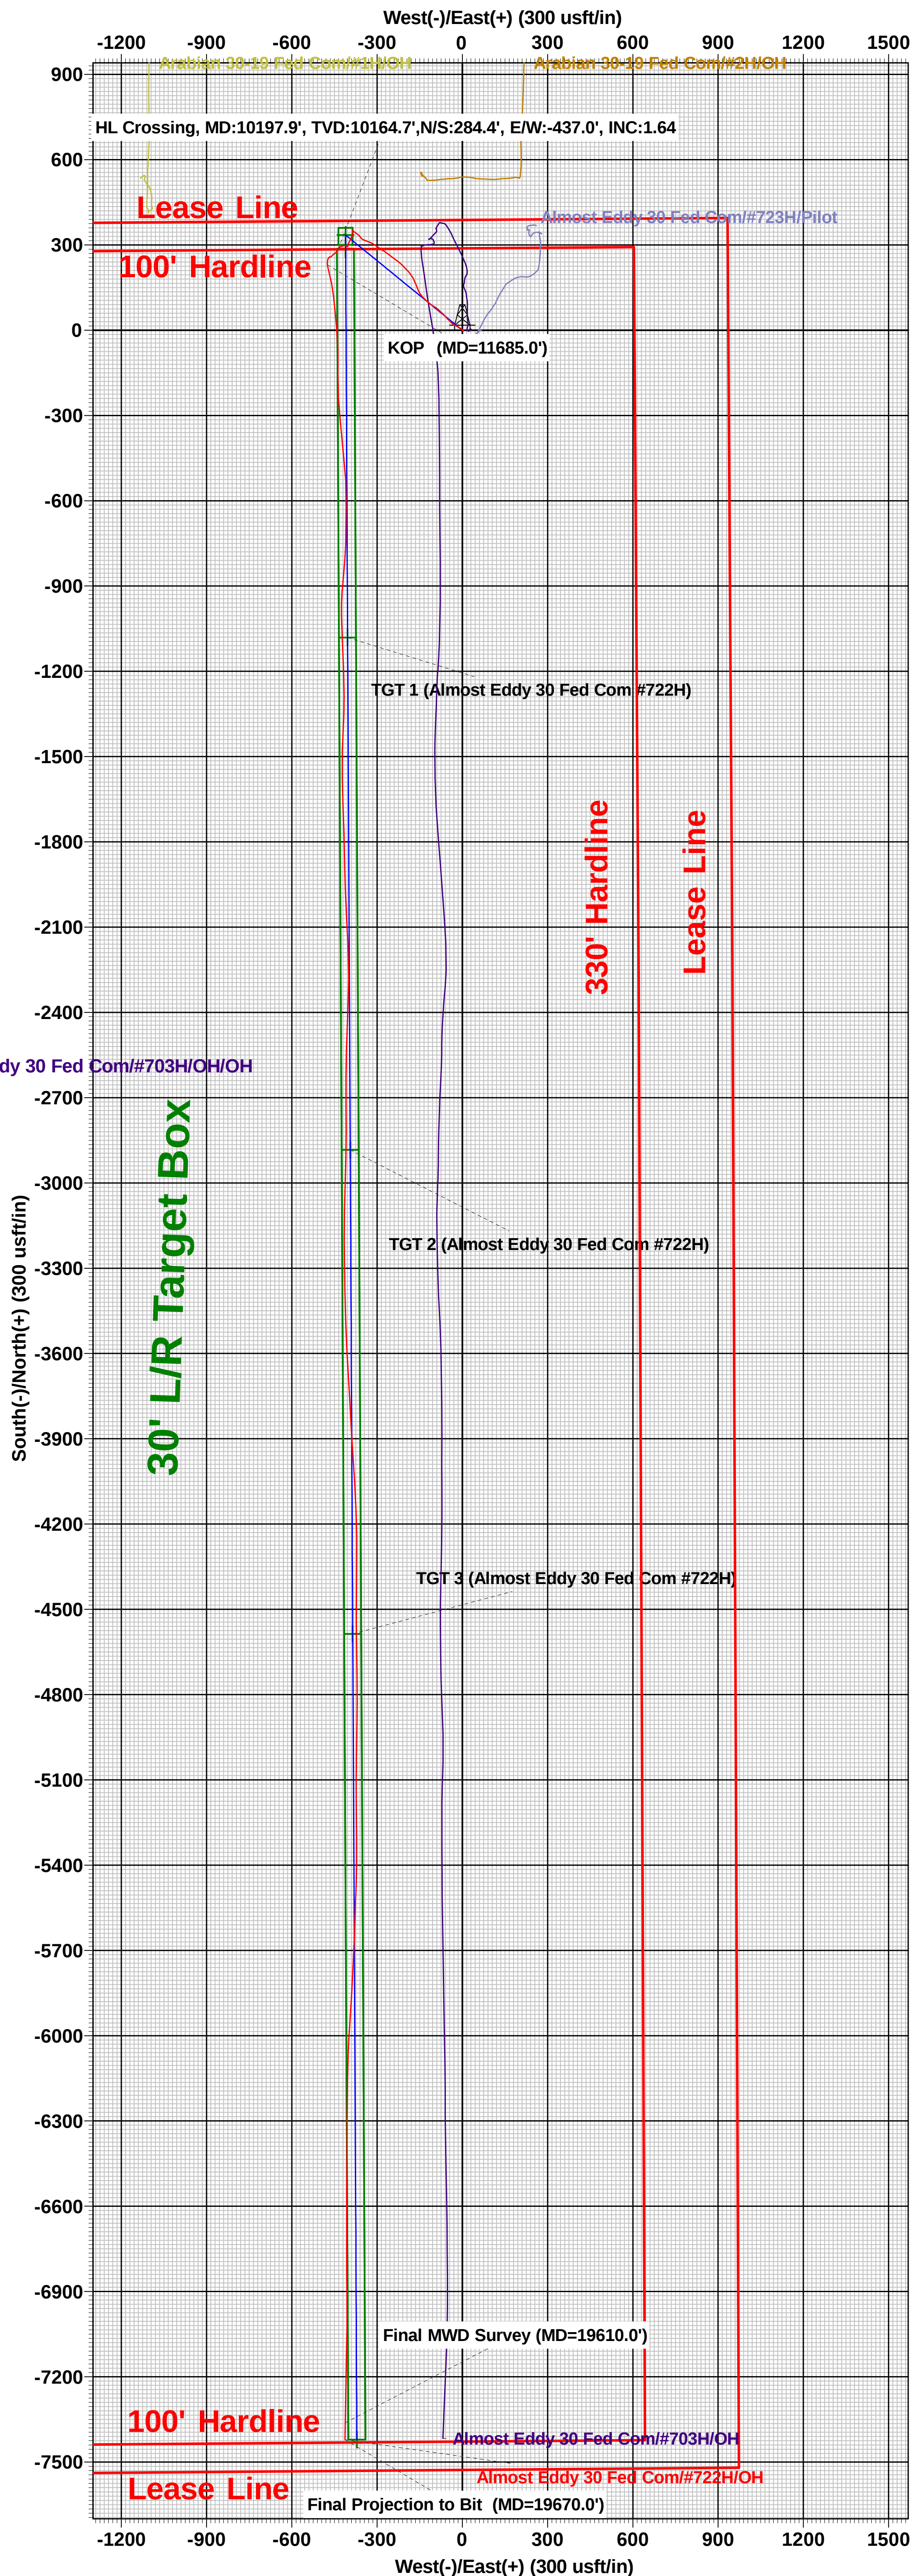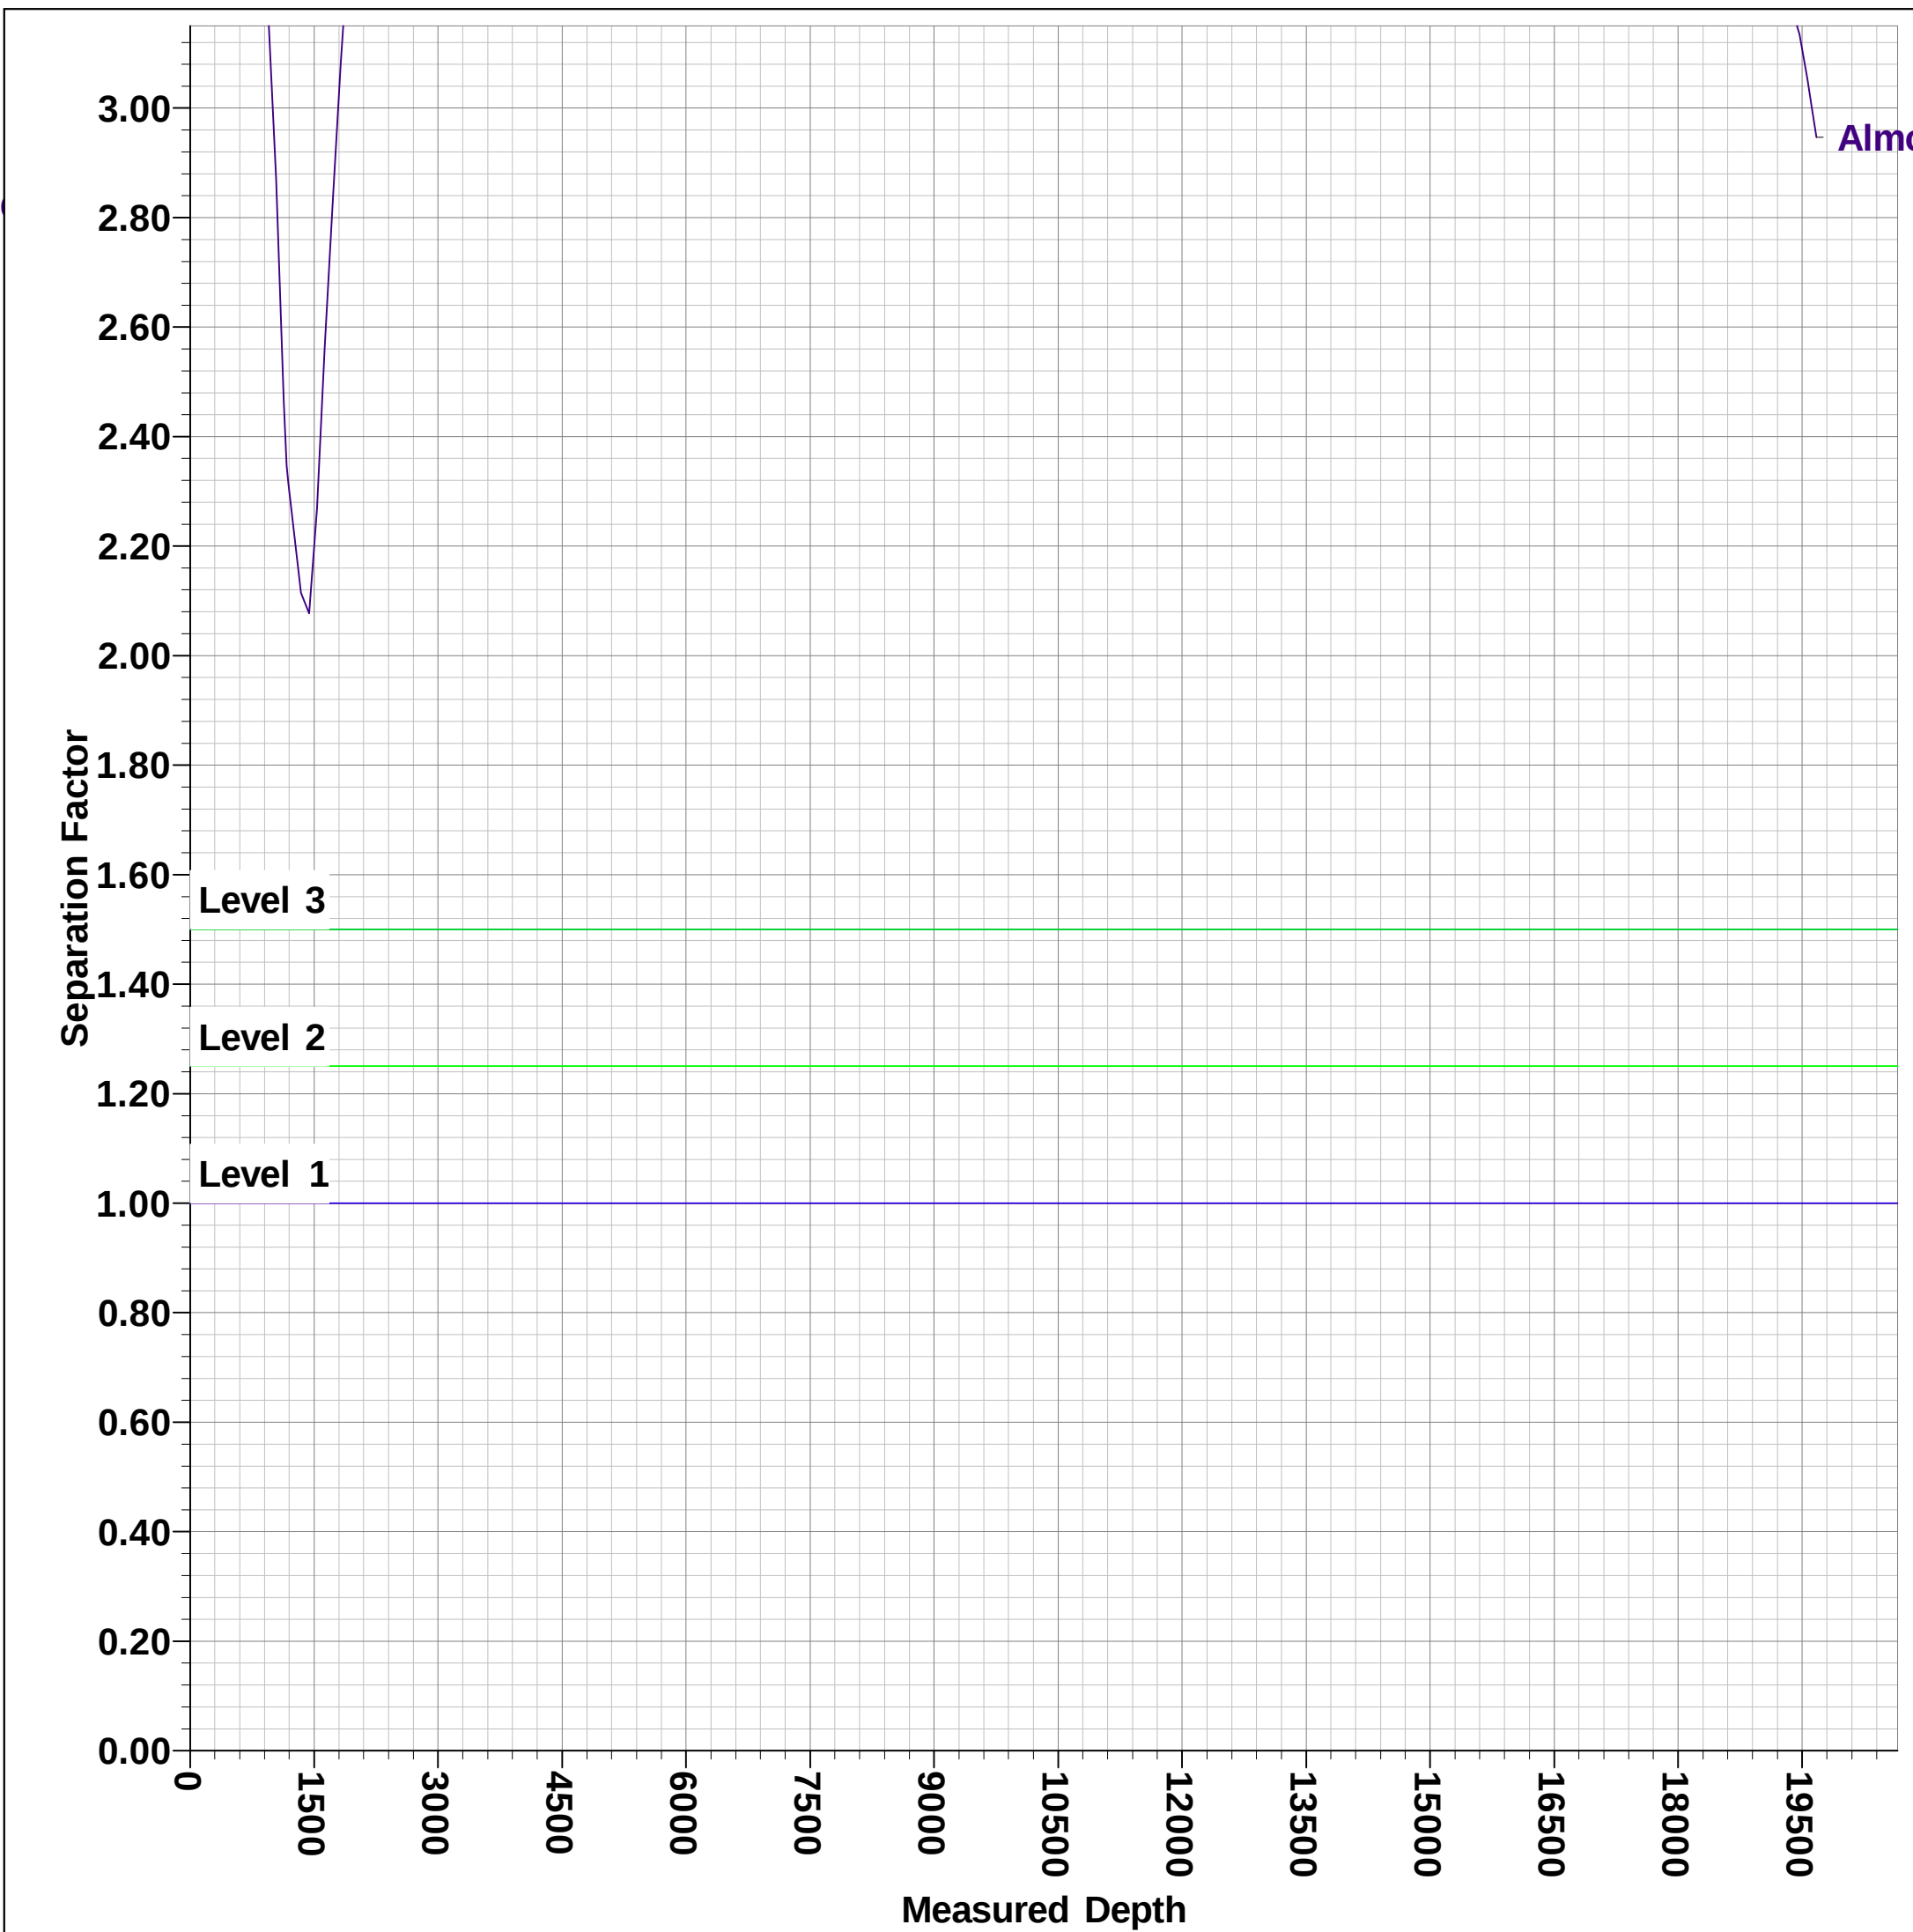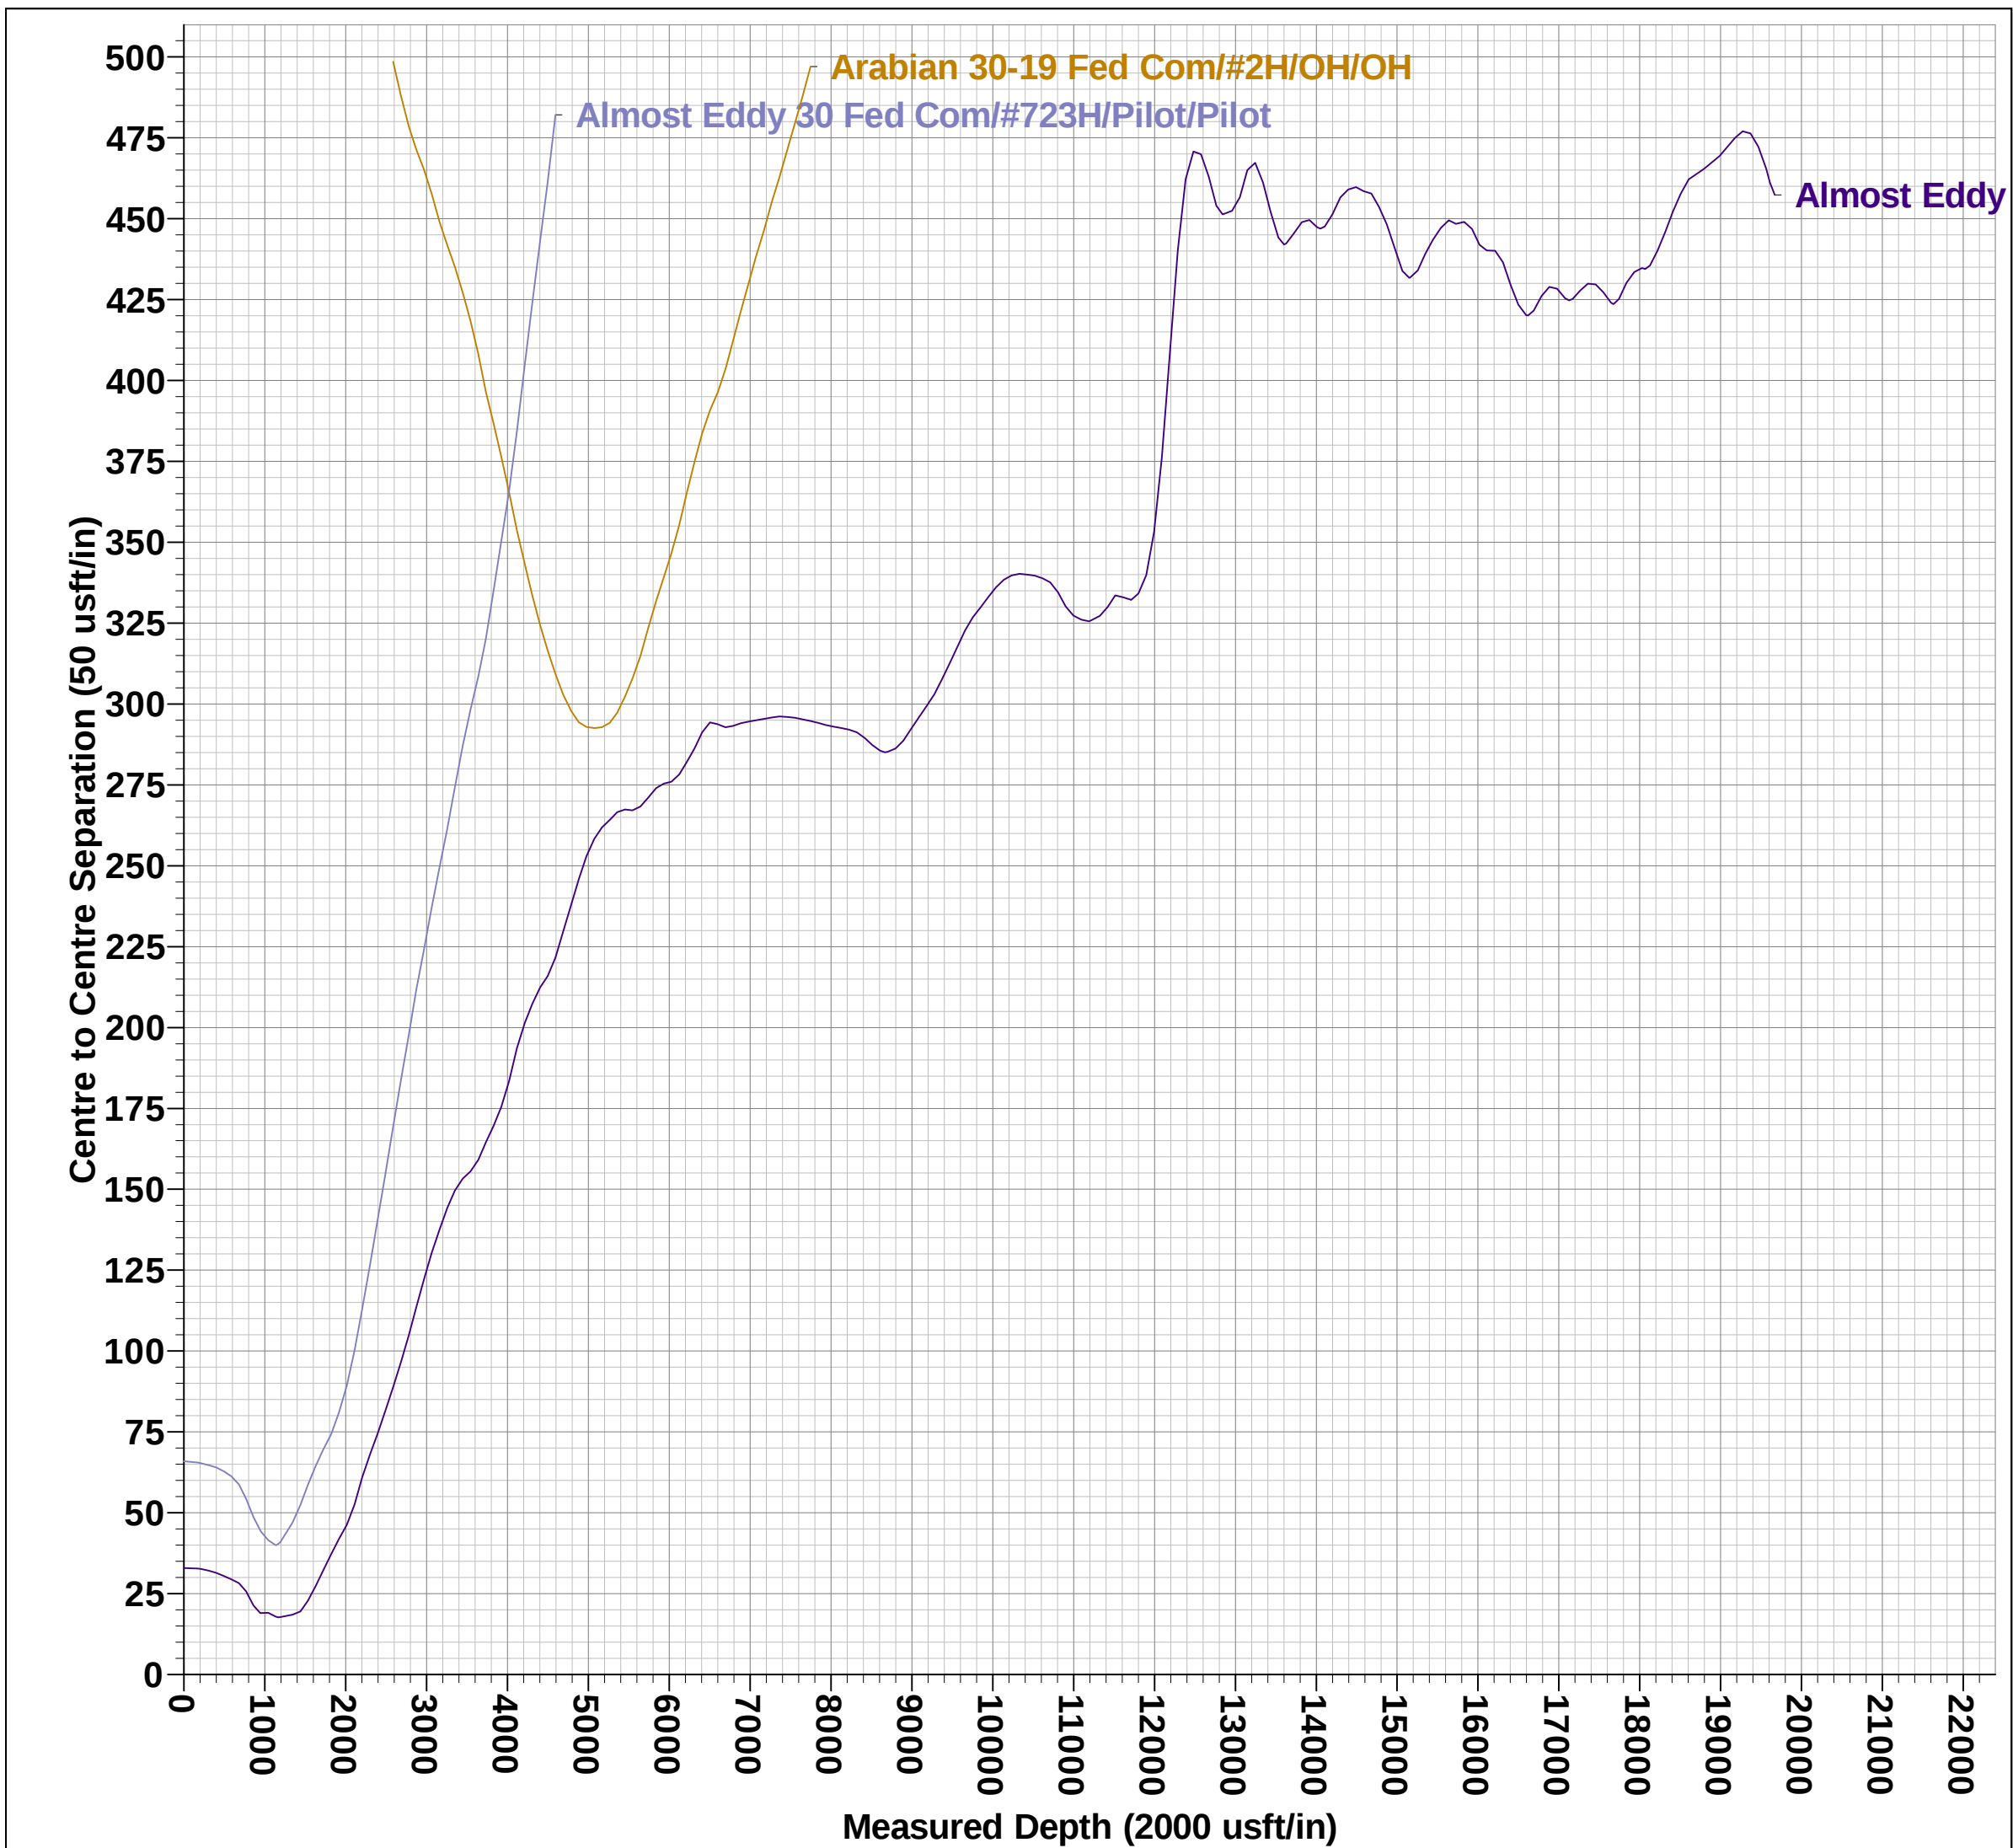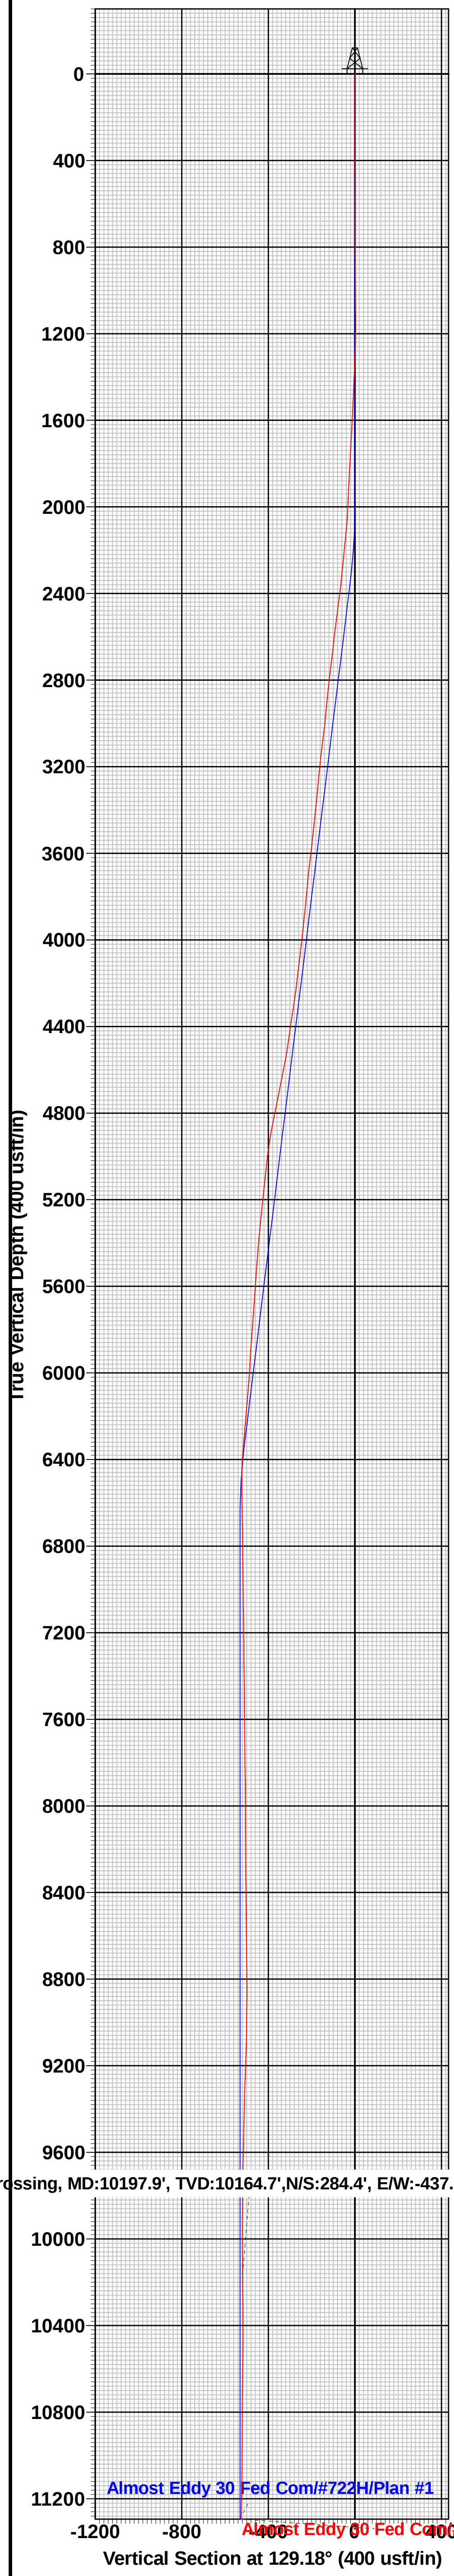



Midland

Lea County, NM (NAD 83 NME)

Almost Eddy 30 Fed Com

#722H

OH

Design: OH

Final PVA

24 August, 2021



Final PVA

Company:	Midland	Local Co-ordinate Reference:	Well #722H
Project:	Lea County, NM (NAD 83 NME)	TVD Reference:	kb = 25' @ 3378.0usft
Site:	Almost Eddy 30 Fed Com	MD Reference:	kb = 25' @ 3378.0usft
Well:	#722H	North Reference:	Grid
Wellbore:	OH	Survey Calculation Method:	Minimum Curvature
Design:	OH	Database:	PEDM

Project	Lea County, NM (NAD 83 NME)		
Map System:	US State Plane 1983	System Datum:	Mean Sea Level
Geo Datum:	North American Datum 1983		
Map Zone:	New Mexico Eastern Zone		

Site	Almost Eddy 30 Fed Com		
Site Position:		Northing:	400,427.00 usft
From:	Map	Easting:	730,701.00 usft
Position Uncertainty:	0.0 usft	Slot Radius:	13-3/16 "
		Latitude:	32° 5' 57.757 N
		Longitude:	103° 43' 18.496 W
		Grid Convergence:	0.32 °

Well		#722H				
Well Position	+N/-S	0.0 usft	Northing:	400,751.00 usft	Latitude:	32° 6' 0.888 N
	+E/-W	0.0 usft	Easting:	732,040.00 usft	Longitude:	103° 43' 2.908 W
Position Uncertainty		0.0 usft	Wellhead Elevation:	usft	Ground Level:	3,353.0 usft

Wellbore	OH				
Magnetics	Model Name	Sample Date	Declination (°)	Dip Angle (°)	Field Strength (nT)
	IGRF2020	7/13/2021	6.59	59.76	47,398.46919858

Design	OH			
Audit Notes:				
Version:	1.0	Phase:	ACTUAL	Tie On Depth: 0.0
Vertical Section:	Depth From (TVD) (usft)	+N/-S (usft)	+E/-W (usft)	Direction (°)
	0.0	0.0	0.0	182.86

Survey Program	Date 8/24/2021			
From (usft)	To (usft)	Survey (Wellbore)	Tool Name	Description
177.0	19,670.0	SDI MWD #1 (OH)	EOG MWD+IFR1	MWD + IFR1



Final PVA

Company:	Midland	Local Co-ordinate Reference:	Well #722H
Project:	Lea County, NM (NAD 83 NME)	TVD Reference:	kb = 25' @ 3378.0usft
Site:	Almost Eddy 30 Fed Com	MD Reference:	kb = 25' @ 3378.0usft
Well:	#722H	North Reference:	Grid
Wellbore:	OH	Survey Calculation Method:	Minimum Curvature
Design:	OH	Database:	PEDM

Survey											
MD (usft)	Inc (°)	Azi (azimuth) (°)	TVD (usft)	N/S (usft)	E/W (usft)	DLeg (°/100usft)	Build (°/100usft)	Turn (°/100usft)	High to Plan (usft)	Right to Plan (usft)	
0.0	0.00	0.00	0.0	0.0	0.0	0.00	0.00	0.00	0.0	0.0	0.0
177.0	0.03	107.86	177.0	0.0	0.0	0.02	0.02	0.00	0.0	0.0	0.0
221.0	0.34	140.09	221.0	-0.1	0.1	0.72	0.70	73.25	-0.2	0.0	0.0
312.0	0.10	171.17	312.0	-0.4	0.3	0.29	-0.26	34.15	-0.4	0.3	0.3
402.0	0.10	95.79	402.0	-0.5	0.4	0.14	0.00	-83.76	-0.5	-0.4	-0.4
494.0	0.40	78.55	494.0	-0.4	0.8	0.33	0.33	-18.74	-0.7	-0.6	-0.6
586.0	0.45	53.29	586.0	-0.2	1.4	0.21	0.05	-27.46	-1.0	-1.0	-1.0
678.0	0.35	48.07	678.0	0.3	1.9	0.12	-0.11	-5.67	-1.6	-1.1	-1.1
769.0	0.17	97.47	769.0	0.4	2.3	0.30	-0.20	54.29	-2.2	0.7	0.7
859.0	0.40	131.64	859.0	0.2	2.6	0.31	0.26	37.97	-1.8	1.9	1.9
950.0	0.41	128.09	950.0	-0.2	3.1	0.03	0.01	-3.90	-2.6	1.7	1.7
1,042.0	0.94	164.07	1,042.0	-1.1	3.6	0.71	0.58	39.11	-2.1	3.1	3.1
1,133.0	0.87	170.87	1,133.0	-2.5	3.9	0.14	-0.08	7.47	-3.1	3.4	3.4
1,189.0	1.96	320.28	1,189.0	-2.2	3.3	4.90	1.95	266.80	3.9	-1.2	-1.2
1,343.0	1.95	317.29	1,342.9	1.7	-0.1	0.07	-0.01	-1.94	-1.3	-1.1	-1.1
1,438.0	2.42	303.45	1,437.8	4.0	-2.9	0.74	0.49	-14.57	-4.6	-1.8	-1.8
1,534.0	2.79	301.81	1,533.7	6.4	-6.6	0.39	0.39	-1.71	-8.9	-2.0	-2.0
1,629.0	2.96	301.97	1,628.6	8.9	-10.6	0.18	0.18	0.17	-13.7	-1.9	-1.9
1,725.0	2.92	300.28	1,724.5	11.4	-14.8	0.10	-0.04	-1.76	-18.6	-2.4	-2.4
1,821.0	2.95	300.63	1,820.3	13.9	-19.1	0.04	0.03	0.36	-23.5	-2.3	-2.3
1,917.0	3.00	293.80	1,916.2	16.2	-23.5	0.37	0.05	-7.11	-28.0	-5.3	-5.3
2,012.0	2.62	280.29	2,011.1	17.6	-27.9	0.80	-0.40	-14.22	-30.6	-12.3	-12.3
2,108.0	5.92	317.78	2,106.8	21.6	-33.4	4.33	3.44	39.05	-36.5	9.9	9.9
2,203.0	5.70	313.71	2,201.3	28.5	-40.1	0.49	-0.23	-4.28	-41.5	6.5	6.5
2,299.0	5.42	309.53	2,296.9	34.7	-47.0	0.51	-0.29	-4.35	-42.7	3.1	3.1
2,395.0	7.35	320.73	2,392.3	42.3	-54.4	2.38	2.01	11.67	-40.8	9.9	9.9
2,491.0	7.14	316.22	2,487.5	51.4	-62.4	0.63	-0.22	-4.70	-41.9	4.7	4.7



Final PVA

Company:	Midland	Local Co-ordinate Reference:	Well #722H
Project:	Lea County, NM (NAD 83 NME)	TVD Reference:	kb = 25' @ 3378.0usft
Site:	Almost Eddy 30 Fed Com	MD Reference:	kb = 25' @ 3378.0usft
Well:	#722H	North Reference:	Grid
Wellbore:	OH	Survey Calculation Method:	Minimum Curvature
Design:	OH	Database:	PEDM

Survey											
MD (usft)	Inc (°)	Azi (azimuth) (°)	TVD (usft)	N/S (usft)	E/W (usft)	DLeg (°/100usft)	Build (°/100usft)	Turn (°/100usft)	High to Plan (usft)	Right to Plan (usft)	
2,586.0	6.89	313.76	2,581.8	59.6	-70.6	0.41	-0.26	-2.59	-42.2	1.8	
2,682.0	6.90	312.45	2,677.1	67.5	-79.0	0.16	0.01	-1.36	-42.0	0.0	
2,778.0	6.64	309.90	2,772.5	74.9	-87.5	0.41	-0.27	-2.66	-41.6	-2.3	
2,873.0	5.88	302.21	2,866.9	81.1	-95.9	1.19	-0.80	-8.09	-39.8	-7.1	
2,969.0	5.61	298.98	2,962.4	86.0	-104.1	0.44	-0.28	-3.36	-37.4	-7.5	
3,065.0	7.17	310.11	3,057.8	92.1	-112.8	2.07	1.62	11.59	-37.0	0.5	
3,160.0	6.33	310.10	3,152.1	99.3	-121.4	0.88	-0.88	-0.01	-36.6	0.3	
3,256.0	5.64	312.59	3,247.6	105.9	-128.9	0.77	-0.72	2.59	-34.9	1.4	
3,351.0	5.41	313.40	3,342.2	112.1	-135.6	0.26	-0.24	0.85	-32.4	1.1	
3,446.0	6.64	323.75	3,436.7	119.6	-142.1	1.72	1.29	10.89	-30.4	4.8	
3,542.0	5.79	324.06	3,532.1	128.0	-148.2	0.89	-0.89	0.32	-29.5	2.0	
3,638.0	8.08	334.23	3,627.4	138.0	-154.0	2.70	2.39	10.59	-29.6	3.0	
3,733.0	6.59	342.47	3,721.6	149.2	-158.5	1.92	-1.57	8.67	-31.2	1.8	
3,828.0	5.68	334.48	3,816.1	158.7	-162.2	1.31	-0.96	-8.41	-30.8	-8.2	
3,924.0	7.13	333.98	3,911.5	168.3	-166.9	1.51	1.51	-0.52	-30.8	-13.4	
4,020.0	6.64	338.51	4,006.8	178.8	-171.5	0.76	-0.51	4.72	-33.0	-16.2	
4,116.0	7.81	325.45	4,102.0	189.4	-177.2	2.09	1.22	-13.60	-29.2	-27.8	
4,212.0	6.37	324.52	4,197.3	199.1	-184.0	1.50	-1.50	-0.97	-29.4	-31.4	
4,307.0	9.38	316.56	4,291.4	209.0	-192.4	3.36	3.17	-8.38	-26.2	-37.4	
4,403.0	8.13	316.05	4,386.3	219.6	-202.5	1.30	-1.30	-0.53	-28.9	-39.1	
4,499.0	8.01	314.92	4,481.3	229.2	-212.0	0.21	-0.12	-1.18	-30.0	-41.0	
4,594.0	11.20	308.46	4,575.0	239.6	-223.9	3.54	3.36	-6.80	-29.5	-44.7	
4,690.0	11.26	306.78	4,669.1	251.0	-238.7	0.35	0.06	-1.75	-35.3	-45.3	
4,786.0	11.24	306.85	4,763.3	262.2	-253.7	0.03	-0.02	0.07	-42.5	-44.8	
4,881.0	11.41	305.53	4,856.4	273.2	-268.7	0.33	0.18	-1.39	-48.6	-45.2	
4,977.0	8.04	302.34	4,951.0	282.3	-282.1	3.55	-3.51	-3.32	-50.7	-46.9	
5,073.0	6.24	304.09	5,046.3	288.9	-292.1	1.89	-1.87	1.82	-52.4	-44.1	



Final PVA

Company:	Midland	Local Co-ordinate Reference:	Well #722H
Project:	Lea County, NM (NAD 83 NME)	TVD Reference:	kb = 25' @ 3378.0usft
Site:	Almost Eddy 30 Fed Com	MD Reference:	kb = 25' @ 3378.0usft
Well:	#722H	North Reference:	Grid
Wellbore:	OH	Survey Calculation Method:	Minimum Curvature
Design:	OH	Database:	PEDM

Survey										
MD (usft)	Inc (°)	Azi (azimuth) (°)	TVD (usft)	N/S (usft)	E/W (usft)	DLeg (°/100usft)	Build (°/100usft)	Turn (°/100usft)	High to Plan (usft)	Right to Plan (usft)
5,168.0	6.07	304.39	5,140.7	294.6	-300.5	0.18	-0.18	0.32	-51.3	-42.9
5,263.0	6.12	303.96	5,235.2	300.3	-308.9	0.07	0.05	-0.45	-49.5	-42.2
5,358.0	5.68	298.38	5,329.7	305.3	-317.2	0.76	-0.46	-5.87	-43.5	-45.1
5,454.0	4.44	291.85	5,425.3	309.0	-324.9	1.42	-1.29	-6.80	-35.4	-46.9
5,549.0	4.51	291.48	5,520.0	311.7	-331.7	0.08	0.07	-0.39	-31.4	-43.6
5,645.0	4.32	290.52	5,615.8	314.3	-338.6	0.21	-0.20	-1.00	-27.0	-40.4
5,741.0	4.20	291.91	5,711.5	316.9	-345.3	0.16	-0.12	1.45	-23.9	-36.2
5,836.0	4.25	302.88	5,806.2	320.1	-351.5	0.85	0.05	11.55	-25.7	-29.1
5,932.0	3.71	322.39	5,902.0	324.5	-356.4	1.51	-0.56	20.32	-29.0	-20.4
6,027.0	3.60	321.07	5,996.8	329.3	-360.1	0.15	-0.12	-1.39	-23.2	-23.5
6,123.0	4.98	310.42	6,092.5	334.3	-365.2	1.65	1.44	-11.09	-13.9	-28.1
6,219.0	4.73	304.16	6,188.2	339.3	-371.6	0.61	-0.26	-6.52	-7.2	-28.9
6,314.0	4.57	305.71	6,282.9	343.7	-377.9	0.21	-0.17	1.63	-4.1	-27.9
6,409.0	4.89	315.55	6,377.6	348.8	-383.8	0.92	0.34	10.36	-5.7	-27.4
6,505.0	1.15	356.36	6,473.4	352.6	-386.8	4.26	-3.90	42.51	-20.7	-20.3
6,600.0	1.47	105.07	6,568.4	353.3	-385.7	2.25	0.34	114.43	-18.1	25.0
6,696.0	1.23	168.30	6,664.4	352.0	-384.3	1.49	-0.25	65.86	11.2	29.6
6,791.0	1.36	183.33	6,759.4	349.8	-384.1	0.38	0.14	15.82	16.4	26.0
6,887.0	1.28	192.62	6,855.3	347.6	-384.4	0.24	-0.08	9.68	18.1	23.2
6,982.0	1.45	189.58	6,950.3	345.4	-384.8	0.19	0.18	-3.20	14.6	24.1
7,078.0	1.61	189.98	7,046.3	342.9	-385.3	0.17	0.17	0.42	12.2	24.0
7,173.0	1.83	194.62	7,141.2	340.1	-385.9	0.27	0.23	4.88	11.3	23.0
7,269.0	1.63	202.27	7,237.2	337.4	-386.8	0.32	-0.21	7.97	11.4	21.5
7,364.0	1.53	194.75	7,332.2	334.9	-387.6	0.24	-0.11	-7.92	5.8	22.6
7,460.0	1.50	195.24	7,428.1	332.4	-388.3	0.03	-0.03	0.51	3.5	22.6
7,556.0	1.58	203.12	7,524.1	330.0	-389.1	0.24	0.08	8.21	4.0	22.1
7,651.0	1.78	201.27	7,619.0	327.4	-390.2	0.22	0.21	-1.95	0.5	22.1



Final PVA

Company:	Midland	Local Co-ordinate Reference:	Well #722H
Project:	Lea County, NM (NAD 83 NME)	TVD Reference:	kb = 25' @ 3378.0usft
Site:	Almost Eddy 30 Fed Com	MD Reference:	kb = 25' @ 3378.0usft
Well:	#722H	North Reference:	Grid
Wellbore:	OH	Survey Calculation Method:	Minimum Curvature
Design:	OH	Database:	PEDM

Survey											
MD (usft)	Inc (°)	Azi (azimuth) (°)	TVD (usft)	N/S (usft)	E/W (usft)	DLeg (°/100usft)	Build (°/100usft)	Turn (°/100usft)	High to Plan (usft)	Right to Plan (usft)	
7,747.0	1.78	207.07	7,715.0	324.7	-391.4	0.19	0.00	6.04	-0.2	22.1	
7,843.0	1.91	198.86	7,810.9	321.9	-392.6	0.31	0.14	-8.55	-6.5	21.6	
7,938.0	1.98	202.96	7,905.9	318.9	-393.8	0.16	0.07	4.32	-8.1	22.2	
8,034.0	1.92	209.00	8,001.8	315.9	-395.2	0.22	-0.06	6.29	-9.0	23.1	
8,129.0	1.88	213.23	8,096.8	313.2	-396.8	0.15	-0.04	4.45	-10.4	23.8	
8,225.0	2.14	203.43	8,192.7	310.3	-398.4	0.45	0.27	-10.21	-17.7	21.4	
8,320.0	1.52	203.46	8,287.7	307.5	-399.6	0.65	-0.65	0.03	-20.7	21.4	
8,416.0	1.56	194.05	8,383.6	305.1	-400.4	0.27	0.04	-9.80	-26.5	17.5	
8,512.0	1.35	199.11	8,479.6	302.7	-401.1	0.26	-0.22	5.27	-27.3	19.9	
8,608.0	1.43	195.28	8,575.6	300.5	-401.8	0.13	0.08	-3.99	-30.9	18.0	
8,703.0	1.59	197.86	8,670.5	298.1	-402.5	0.18	0.17	2.72	-32.5	19.4	
8,799.0	1.01	167.03	8,766.5	296.0	-402.7	0.93	-0.60	-32.11	-39.9	-0.7	
8,894.0	0.65	230.93	8,861.5	294.8	-403.0	0.98	-0.38	67.26	-19.1	36.2	
8,990.0	0.81	265.24	8,957.5	294.4	-404.1	0.48	0.17	35.74	3.6	41.0	
9,086.0	1.08	266.26	9,053.5	294.3	-405.6	0.28	0.28	1.06	2.7	40.9	
9,181.0	2.42	311.30	9,148.5	295.6	-408.0	1.92	1.41	47.41	28.2	27.7	
9,277.0	2.14	293.77	9,244.4	297.7	-411.2	0.78	-0.29	-18.26	14.9	34.3	
9,372.0	1.59	266.28	9,339.3	298.3	-414.1	1.09	-0.58	-28.94	-5.5	36.4	
9,468.0	2.25	252.61	9,435.3	297.6	-417.3	0.83	0.69	-14.24	-17.1	33.8	
9,563.0	2.42	250.30	9,530.2	296.4	-420.9	0.20	0.18	-2.43	-22.3	33.0	
9,659.0	2.47	254.97	9,626.1	295.2	-424.8	0.21	0.05	4.86	-23.7	34.9	
9,755.0	2.00	247.78	9,722.0	294.0	-428.4	0.57	-0.49	-7.49	-31.6	31.4	
9,851.0	1.84	223.84	9,818.0	292.3	-431.0	0.85	-0.17	-24.94	-44.7	15.2	
9,947.0	1.78	235.78	9,913.9	290.3	-433.3	0.40	-0.06	12.44	-43.6	24.4	
10,042.0	1.68	215.78	10,008.9	288.4	-435.3	0.64	-0.11	-21.05	-52.1	7.5	
10,138.0	1.54	198.32	10,104.9	286.0	-436.6	0.53	-0.15	-18.19	-54.6	-8.9	



Final PVA

Company:	Midland	Local Co-ordinate Reference:	Well #722H
Project:	Lea County, NM (NAD 83 NME)	TVD Reference:	kb = 25' @ 3378.0usft
Site:	Almost Eddy 30 Fed Com	MD Reference:	kb = 25' @ 3378.0usft
Well:	#722H	North Reference:	Grid
Wellbore:	OH	Survey Calculation Method:	Minimum Curvature
Design:	OH	Database:	PEDM

Survey											
MD (usft)	Inc (°)	Azi (azimuth) (°)	TVD (usft)	N/S (usft)	E/W (usft)	DLeg (°/100usft)	Build (°/100usft)	Turn (°/100usft)	High to Plan (usft)	Right to Plan (usft)	
10,197.9	1.64	195.05	10,164.7	284.4	-437.0	0.23	0.17	-5.47	-55.6	-12.0	
HL Crossing, MD:10197.9', TVD:10164.7', N/S:284.4', E/W:-437.0', INC:1.64											
10,234.0	1.71	193.27	10,200.8	283.4	-437.3	0.23	0.18	-4.92	-56.3	-13.8	
10,330.0	1.66	204.96	10,296.8	280.7	-438.2	0.36	-0.05	12.18	-60.7	-1.8	
10,425.0	1.98	212.42	10,391.7	278.1	-439.7	0.42	0.34	7.85	-63.4	6.3	
10,520.0	2.31	226.43	10,486.7	275.4	-441.9	0.65	0.35	14.75	-63.5	21.9	
10,616.0	2.67	240.99	10,582.6	273.0	-445.3	0.76	0.37	15.17	-60.1	37.6	
10,712.0	2.88	232.50	10,678.5	270.4	-449.2	0.48	0.22	-8.84	-69.6	28.0	
10,807.0	2.73	231.25	10,773.3	267.5	-452.8	0.17	-0.16	-1.32	-74.8	26.5	
10,903.0	2.55	219.13	10,869.2	264.5	-456.0	0.61	-0.19	-12.62	-83.1	9.7	
10,999.0	2.49	227.12	10,965.2	261.4	-458.8	0.37	-0.06	8.32	-85.1	21.4	
11,094.0	2.09	232.85	11,060.1	258.9	-461.7	0.48	-0.42	6.03	-86.4	30.0	
11,189.0	1.57	255.54	11,155.0	257.6	-464.4	0.93	-0.55	23.88	-71.0	61.7	
11,324.0	2.08	259.24	11,290.0	256.6	-468.6	0.39	0.38	2.74	-71.2	66.3	
11,420.0	3.71	205.20	11,385.9	253.5	-471.6	3.13	1.70	-56.29	-99.5	-20.2	
11,516.0	5.34	193.56	11,481.6	246.3	-474.0	1.94	1.70	-12.12	-100.9	-40.6	
11,611.0	5.51	182.64	11,576.1	237.5	-475.2	1.10	0.18	-11.49	-100.2	-59.9	
11,685.0	6.71	172.46	11,649.7	229.7	-474.8	2.18	1.62	-13.76	-95.8	-77.4	
KOP (MD=11685.0')											
11,707.0	7.10	170.12	11,671.5	227.0	-474.4	2.18	1.77	-10.64	-95.2	-81.2	
11,803.0	23.04	165.64	11,763.9	202.8	-468.7	16.64	16.60	-4.67	-100.0	-83.9	
11,898.0	26.02	169.48	11,850.4	164.3	-460.3	3.56	3.14	4.04	-107.3	-67.5	
11,994.0	29.57	172.75	11,935.3	120.1	-453.4	4.02	3.70	3.41	-92.0	-53.7	
12,090.0	36.79	175.31	12,015.6	67.9	-448.1	7.66	7.52	2.67	-61.2	-43.7	
12,193.0	36.15	174.03	12,098.4	6.9	-442.4	0.97	-0.62	-1.24	-9.8	-34.9	
12,288.0	55.08	178.09	12,164.6	-60.5	-438.2	20.15	19.93	4.27	32.0	-30.5	
12,384.0	74.32	181.81	12,205.4	-146.8	-438.3	20.34	20.04	3.87	67.0	-30.8	



Final PVA

Company:	Midland	Local Co-ordinate Reference:	Well #722H
Project:	Lea County, NM (NAD 83 NME)	TVD Reference:	kb = 25' @ 3378.0usft
Site:	Almost Eddy 30 Fed Com	MD Reference:	kb = 25' @ 3378.0usft
Well:	#722H	North Reference:	Grid
Wellbore:	OH	Survey Calculation Method:	Minimum Curvature
Design:	OH	Database:	PEDM

Survey											
MD (usft)	Inc (°)	Azi (azimuth) (°)	TVD (usft)	N/S (usft)	E/W (usft)	DLeg (°/100usft)	Build (°/100usft)	Turn (°/100usft)	High to Plan (usft)	Right to Plan (usft)	
12,480.0	84.78	175.33	12,222.8	-241.0	-435.9	12.75	10.90	-6.75	84.7	-27.8	
12,576.0	89.83	175.41	12,227.3	-336.6	-428.1	5.26	5.26	0.08	89.0	-20.5	
12,671.0	90.87	173.36	12,226.8	-431.1	-418.8	2.42	1.09	-2.16	88.2	-11.7	
12,767.0	94.33	176.79	12,222.4	-526.6	-410.6	5.07	3.60	3.57	83.6	-4.0	
12,863.0	91.58	181.03	12,217.5	-622.5	-408.8	5.26	-2.86	4.42	78.4	-2.7	
12,958.0	92.72	180.21	12,213.9	-717.4	-409.8	1.48	1.20	-0.86	74.7	-4.2	
13,054.0	89.16	184.66	12,212.3	-813.2	-413.9	5.94	-3.71	4.64	72.9	-8.8	
13,149.0	87.92	185.17	12,214.7	-907.9	-422.0	1.41	-1.31	0.54	75.1	-17.4	
13,245.0	87.72	178.93	12,218.4	-1,003.7	-425.5	6.50	-0.21	-6.50	78.6	-21.4	
13,341.0	91.34	177.08	12,219.2	-1,099.6	-422.1	4.23	3.77	-1.93	79.2	-18.5	
13,437.0	94.26	177.94	12,214.5	-1,195.4	-418.0	3.17	3.04	0.90	74.6	-14.9	
13,533.0	91.81	179.92	12,209.4	-1,291.2	-416.2	3.28	-2.55	2.06	69.6	-13.5	
13,628.0	88.86	182.86	12,208.9	-1,386.2	-418.5	4.38	-3.11	3.09	69.2	-16.3	
13,724.0	88.09	181.70	12,211.4	-1,482.1	-422.3	1.45	-0.80	-1.21	71.8	-20.6	
13,820.0	88.62	178.45	12,214.2	-1,578.0	-422.4	3.43	0.55	-3.39	74.7	-21.3	
13,916.0	90.13	178.52	12,215.2	-1,674.0	-419.9	1.57	1.57	0.07	75.9	-19.2	
14,012.0	90.37	177.77	12,214.8	-1,769.9	-416.8	0.82	0.25	-0.78	75.5	-16.6	
14,107.0	90.74	179.08	12,213.9	-1,864.9	-414.2	1.43	0.39	1.38	74.7	-14.5	
14,203.0	90.07	178.49	12,213.2	-1,960.8	-412.1	0.93	-0.70	-0.61	74.2	-12.9	
14,299.0	87.45	176.60	12,215.3	-2,056.7	-408.0	3.36	-2.73	-1.97	76.3	-9.3	
14,394.0	87.89	177.71	12,219.1	-2,151.5	-403.3	1.26	0.46	1.17	80.3	-5.1	
14,490.0	87.69	178.96	12,222.8	-2,247.4	-400.5	1.32	-0.21	1.30	84.1	-2.8	
14,585.0	91.31	181.90	12,223.7	-2,342.4	-401.2	4.91	3.81	3.09	85.1	-4.0	
14,681.0	93.46	182.21	12,219.7	-2,438.2	-404.7	2.26	2.24	0.32	81.2	-7.9	
14,777.0	94.26	181.62	12,213.2	-2,534.0	-407.9	1.03	0.83	-0.61	74.8	-11.7	
14,872.0	92.82	180.17	12,207.3	-2,628.8	-409.3	2.15	-1.52	-1.53	69.1	-13.6	
14,968.0	94.13	179.99	12,201.5	-2,724.6	-409.5	1.38	1.36	-0.19	63.3	-14.3	



Final PVA

Company:	Midland	Local Co-ordinate Reference:	Well #722H
Project:	Lea County, NM (NAD 83 NME)	TVD Reference:	kb = 25' @ 3378.0usft
Site:	Almost Eddy 30 Fed Com	MD Reference:	kb = 25' @ 3378.0usft
Well:	#722H	North Reference:	Grid
Wellbore:	OH	Survey Calculation Method:	Minimum Curvature
Design:	OH	Database:	PEDM

Survey											
MD (usft)	Inc (°)	Azi (azimuth) (°)	TVD (usft)	N/S (usft)	E/W (usft)	DLeg (°/100usft)	Build (°/100usft)	Turn (°/100usft)	High to Plan (usft)	Right to Plan (usft)	
15,064.0	89.90	179.72	12,198.1	-2,820.5	-409.2	4.42	-4.41	-0.28	60.1	-14.5	
15,159.0	89.63	181.25	12,198.5	-2,915.5	-410.0	1.64	-0.28	1.61	60.6	-15.8	
15,255.0	87.79	181.77	12,200.7	-3,011.4	-412.6	1.99	-1.92	0.54	63.1	-18.8	
15,351.0	86.78	181.27	12,205.2	-3,107.3	-415.1	1.17	-1.05	-0.52	67.9	-21.9	
15,447.0	87.62	179.25	12,209.9	-3,203.2	-415.5	2.28	0.87	-2.10	72.9	-22.8	
15,542.0	89.06	179.27	12,212.7	-3,298.1	-414.3	1.52	1.52	0.02	75.9	-22.0	
15,638.0	91.07	178.99	12,212.6	-3,394.1	-412.9	2.11	2.09	-0.29	76.1	-21.1	
15,733.0	90.23	178.25	12,211.5	-3,489.1	-410.6	1.18	-0.88	-0.78	75.3	-19.3	
15,829.0	88.42	176.88	12,212.6	-3,585.0	-406.5	2.36	-1.89	-1.43	76.7	-15.7	
15,924.0	91.95	176.59	12,212.3	-3,679.8	-401.1	3.73	3.72	-0.31	76.7	-10.8	
16,020.0	93.76	176.69	12,207.5	-3,775.5	-395.5	1.89	1.89	0.10	72.2	-5.7	
16,116.0	92.59	177.55	12,202.2	-3,871.2	-390.7	1.51	-1.22	0.90	67.1	-1.3	
16,212.0	91.61	175.28	12,198.7	-3,967.0	-384.7	2.57	-1.02	-2.36	63.9	4.2	
16,308.0	93.86	177.32	12,194.1	-4,062.7	-378.5	3.16	2.34	2.12	59.6	9.9	
16,403.0	92.11	177.38	12,189.2	-4,157.4	-374.1	1.84	-1.84	0.06	54.9	13.8	
16,499.0	93.12	179.83	12,184.8	-4,253.3	-371.7	2.76	1.05	2.55	50.8	15.6	
16,594.0	89.66	180.36	12,182.5	-4,348.2	-371.9	3.68	-3.64	0.56	48.8	15.0	
16,690.0	87.28	180.41	12,185.1	-4,444.2	-372.5	2.48	-2.48	0.05	51.6	13.9	
16,786.0	86.31	179.86	12,190.4	-4,540.0	-372.8	1.16	-1.01	-0.57	57.3	13.1	
16,882.0	87.08	179.30	12,196.0	-4,635.9	-372.1	0.99	0.80	-0.58	62.8	13.3	
16,978.0	90.20	178.59	12,198.2	-4,731.8	-370.3	3.33	3.25	-0.74	64.6	14.6	
17,074.0	93.22	180.85	12,195.4	-4,827.8	-369.8	3.93	3.15	2.35	61.2	14.6	
17,170.0	90.84	180.38	12,192.0	-4,923.7	-370.9	2.53	-2.48	-0.49	57.3	13.1	
17,265.0	90.84	181.30	12,190.6	-5,018.7	-372.3	0.97	0.00	0.97	55.4	11.2	
17,361.0	90.23	180.23	12,189.7	-5,114.7	-373.5	1.28	-0.64	-1.11	54.0	9.4	
17,456.0	87.82	178.85	12,191.3	-5,209.6	-372.8	2.92	-2.54	-1.45	55.1	9.7	
17,551.0	90.84	180.05	12,192.4	-5,304.6	-371.9	3.42	3.18	1.26	55.7	10.1	



Final PVA

Company:	Midland	Local Co-ordinate Reference:	Well #722H
Project:	Lea County, NM (NAD 83 NME)	TVD Reference:	kb = 25' @ 3378.0usft
Site:	Almost Eddy 30 Fed Com	MD Reference:	kb = 25' @ 3378.0usft
Well:	#722H	North Reference:	Grid
Wellbore:	OH	Survey Calculation Method:	Minimum Curvature
Design:	OH	Database:	PEDM

Survey										
MD (usft)	Inc (°)	Azi (azimuth) (°)	TVD (usft)	N/S (usft)	E/W (usft)	DLeg (°/100usft)	Build (°/100usft)	Turn (°/100usft)	High to Plan (usft)	Right to Plan (usft)
17,647.0	93.26	180.18	12,189.0	-5,400.5	-372.1	2.52	2.52	0.14	51.7	9.4
17,742.0	91.41	182.82	12,185.1	-5,495.4	-374.5	3.39	-1.95	2.78	47.4	6.4
17,837.0	89.43	181.40	12,184.4	-5,590.3	-378.0	2.56	-2.08	-1.49	46.2	2.5
17,933.0	91.61	182.82	12,183.5	-5,686.3	-381.6	2.71	2.27	1.48	44.8	-1.6
18,028.0	93.22	182.31	12,179.5	-5,781.1	-385.8	1.78	1.69	-0.54	40.3	-6.3
18,124.0	91.34	183.61	12,175.7	-5,876.9	-390.8	2.38	-1.96	1.35	35.9	-11.7
18,220.0	89.56	183.81	12,175.0	-5,972.7	-397.0	1.87	-1.85	0.21	34.7	-18.4
18,315.0	86.61	182.01	12,178.1	-6,067.5	-401.8	3.64	-3.11	-1.89	37.3	-23.8
18,411.0	86.71	180.24	12,183.7	-6,163.3	-403.7	1.84	0.10	-1.84	42.4	-26.2
18,507.0	88.46	181.09	12,187.8	-6,259.2	-404.8	2.03	1.82	0.89	46.0	-27.7
18,606.0	89.06	179.85	12,189.9	-6,358.2	-405.6	1.39	0.61	-1.25	47.6	-29.1
18,701.0	90.44	180.48	12,190.3	-6,453.2	-405.9	1.60	1.45	0.66	47.5	-29.8
18,797.0	90.67	180.39	12,189.4	-6,549.2	-406.6	0.26	0.24	-0.09	46.0	-31.0
18,893.0	90.84	180.02	12,188.1	-6,645.1	-407.0	0.42	0.18	-0.39	44.3	-31.9
18,989.0	90.34	180.04	12,187.1	-6,741.1	-407.0	0.52	-0.52	0.02	42.8	-32.4
19,085.0	90.23	179.71	12,186.7	-6,837.1	-406.8	0.36	-0.11	-0.34	41.8	-32.7
19,180.0	90.07	179.26	12,186.4	-6,932.1	-405.9	0.50	-0.17	-0.47	41.0	-32.3
19,275.0	91.41	181.00	12,185.2	-7,027.1	-406.2	2.31	1.41	1.83	39.3	-33.0
19,370.0	91.78	181.06	12,182.6	-7,122.1	-407.9	0.39	0.39	0.06	36.1	-35.2
19,466.0	91.98	180.88	12,179.4	-7,218.0	-409.5	0.28	0.21	-0.19	32.5	-37.3
19,562.0	92.38	180.88	12,175.8	-7,313.9	-411.0	0.42	0.42	0.00	28.3	-39.3
19,610.0	92.72	181.04	12,173.6	-7,361.9	-411.8	0.78	0.71	0.33	25.9	-40.4
Final MWD Survey (MD=19610.0')										
19,670.0	92.72	181.04	12,170.8	-7,421.8	-412.9	0.00	0.00	0.00	22.8	-41.7
Final Projection to Bit (MD=19670.0')										



Final PVA

Company: Midland
Project: Lea County, NM (NAD 83 NME)
Site: Almost Eddy 30 Fed Com
Well: #722H
Wellbore: OH
Design: OH

Local Co-ordinate Reference: Well #722H
TVD Reference: kb = 25' @ 3378.0usft
MD Reference: kb = 25' @ 3378.0usft
North Reference: Grid
Survey Calculation Method: Minimum Curvature
Database: PEDM

Design Annotations

Measured Depth (usft)	Vertical Depth (usft)	Local Coordinates		Comment
		+N/-S (usft)	+E/-W (usft)	
10,197.9	10,164.7	284.4	-437.0	HL Crossing, MD:10197.9', TVD:10164.7', N/S:284.4', E/W:-437.0', INC:1.64
11,685.0	11,649.7	229.7	-474.8	KOP (MD=11685.0')
19,610.0	12,173.6	-7,361.9	-411.8	Final MWD Survey (MD=19610.0')
19,670.0	12,170.8	-7,421.8	-412.9	Final Projection to Bit (MD=19670.0')

Checked By: _____ Approved By: _____ Date: _____

I CERTIFY THIS SURVEY TO BE TRUE AND CORRECT TO THE BEST OF MY BELIEF AND KNOWLEDGE
 KAY MADDOX 11/17/2021

Intent ☐ As Drilled ☐

API #		
Operator Name:	Property Name:	Well Number

Kick Off Point (KOP)

UL	Section	Township	Range	Lot	Feet	From N/S	Feet	From E/W	County
Latitude					Longitude				NAD

First Take Point (FTP)

UL	Section	Township	Range	Lot	Feet	From N/S	Feet	From E/W	County
Latitude					Longitude				NAD

Last Take Point (LTP)

UL	Section	Township	Range	Lot	Feet	From N/S	Feet	From E/W	County
Latitude					Longitude				NAD

Is this well the defining well for the Horizontal Spacing Unit? ☐Is this well an infill well? ☐

If infill is yes please provide API if available, Operator Name and well number for Defining well for Horizontal Spacing Unit.

API #		
Operator Name:	Property Name:	Well Number

KZ 06/29/2018

Submit To Appropriate District Office Two Copies <u>District I</u> 1625 N. French Dr., Hobbs, NM 88240 <u>District II</u> 811 S. First St., Artesia, NM 88210 <u>District III</u> 1000 Rio Brazos Rd., Aztec, NM 87410 <u>District IV</u> 1220 S. St. Francis Dr., Santa Fe, NM 87505		State of New Mexico Energy, Minerals and Natural Resources Oil Conservation Division 1220 South St. Francis Dr. Santa Fe, NM 87505			Form C-105 Revised August 1, 2011 AMENDED													
					1. WELL API NO. 30-025-48874													
					2. Type of Lease ☐ STATE ☐ FEE ☒ FED/INDIAN													
					3. State Oil & Gas Lease No.													
WELL COMPLETION OR RECOMPLETION REPORT AND LOG																		
4. Reason for filing: ☒ COMPLETION REPORT (Fill in boxes #1 through #31 for State and Fee wells only) ☐ C-144 CLOSURE ATTACHMENT (Fill in boxes #1 through #9, #15 Date Rig Released and #32 and/or #33; attach this and the plat to the C-144 closure report in accordance with 19.15.17.13.K NMAC)					5. Lease Name or Unit Agreement Name ALMOST EDDY 30 FEDERAL COM 6. Well Number: 722H													
7. Type of Completion: ☒ NEW WELL ☐ WORKOVER ☐ DEEPENING ☐ PLUGBACK ☐ DIFFERENT RESERVOIR ☐ OTHER _____																		
8. Name of Operator EOG RESOURCES INC					9. OGRID 7377													
10. Address of Operator PO BOX 2267 MIDLAND, TEXAS 79702					11. Pool name or Wildcat WC025 G08 S253216D; UPPER WOLFCAMP (98270)													
12. Location	Unit Ltr	Section	Township	Range	Lot	Feet from the	N/S Line	Feet from the	E/W Line	County								
Surface:	K	30	25S	32E		2249	SOUTH	1728	WEST	LEA								
BH:	M	31	25S	32E		107	SOUTH	1277	WEST	LEA								
13. Date Spudded 06/19/2021	14. Date T.D. Reached 08/24/2021		15. Date Rig Released 08/24/2021			16. Date Completed (Ready to Produce) 10/31/2021		17. Elevations (DF and RKB, RT, GR, etc.) 3353' GR										
18. Total Measured Depth of Well MD 19,670' TVD 12,170'			19. Plug Back Measured Depth MD 19,647' TVD 12,170'			20. Was Directional Survey Made? YES		21. Type Electric and Other Logs Run None										
22. Producing Interval(s), of this completion - Top, Bottom, Name WOLFCAMP 12,400 - 19,647'																		
23. CASING RECORD (Report all strings set in well)																		
CASING SIZE		WEIGHT LB./FT.		DEPTH SET		HOLE SIZE		CEMENTING RECORD		AMOUNT PULLED								
9 5/8"		40# J-55		1,240'		12 1/4"		660 CL C/CIRC										
7 5/8"		29.7# ICYP 110		11,233'		8 3/4"		1427 CL C & H 28' ECHO										
5 1/2"		20# ICYP 110		19,654'		6 3/4"		830 CL H/TOC @ 10,960'		CBL								
24. LINER RECORD						25. TUBING RECORD												
SIZE	TOP	BOTTOM	SACKS CEMENT	SCREEN	SIZE	DEPTH SET	PACKER SET											
26. Perforation record (interval, size, and number) 12,400 -19,647' 3 1/8", 1872 holes						27. ACID, SHOT, FRACTURE, CEMENT, SQUEEZE, ETC. <table border="1" style="width:100%; border-collapse: collapse;"> <tr> <td>DEPTH INTERVAL</td> <td>AMOUNT AND KIND MATERIAL USED</td> </tr> <tr> <td>12,400 - 19,647'</td> <td>FRAC W/17,693,600 lbs proppant, 337,945 bbls load fld</td> </tr> <tr> <td> </td> <td> </td> </tr> <tr> <td> </td> <td> </td> </tr> </table>					DEPTH INTERVAL	AMOUNT AND KIND MATERIAL USED	12,400 - 19,647'	FRAC W/17,693,600 lbs proppant, 337,945 bbls load fld				
DEPTH INTERVAL	AMOUNT AND KIND MATERIAL USED																	
12,400 - 19,647'	FRAC W/17,693,600 lbs proppant, 337,945 bbls load fld																	
28. PRODUCTION																		
Date First Production 10/31/2021		Production Method (<i>Flowing, gas lift, pumping - Size and type pump</i>) Flowing				Well Status (<i>Prod. or Shut-in</i>) Producing												
Date of Test 11/05/2021	Hours Tested 24	Choke Size 54	Prod'n For Test Period	Oil - Bbl 3373	Gas - MCF 11,894	Water - Bbl. 5953	Gas - Oil Ratio 3526											
Flow Tubing Press.	Casing Pressure 2738	Calculated 24-Hour Rate	Oil - Bbl.	Gas - MCF	Water - Bbl.	Oil Gravity - API - (<i>Corr.</i>) 49												
29. Disposition of Gas (<i>Sold, used for fuel, vented, etc.</i>) SOLD							30. Test Witnessed By											
31. List Attachments C-102, C-104, C-103, Directional Survey, H spacing																		
32. If a temporary pit was used at the well, attach a plat with the location of the temporary pit.																		
33. If an on-site burial was used at the well, report the exact location of the on-site burial:																		
Latitude _____ Longitude _____ NAD 1927 1983																		
I hereby certify that the information shown on both sides of this form is true and complete to the best of my knowledge and belief																		
Signature Kay Maddox			Name Kay Maddox			Title Senior Regulatory Specialist			Date 11/18/2021									
E-mail Address kay_maddox@eogresources.com																		

This form is to be filed with the appropriate District Office of the Division not later than 20 days after the completion of any newly-drilled or deepened well and not later than 60 days after completion of closure. When submitted as a completion report, this shall be accompanied by one copy of all electrical and radio-activity logs run on the well and a summary of all special tests conducted, including drill stem tests. All depths reported shall be measured depths. In the case of directionally drilled wells, true vertical depths shall also be reported. For multiple completions, items 11, 12 and 26-31 shall be reported for each zone.

Southeastern New Mexico			Northwestern New Mexico				
T. Anhy	Rustler	1096'	T. Canyon	Brushy	6789'	T. Ojo Alamo	T. Penn A "
T. Salt		1361'	T. Strawn			T. Kirtland	T. Penn. "B"
B. Salt		4237'	T. Atoka			T. Fruitland	T. Penn. "C"
T. Yates			T. Miss			T. Pictured Cliffs	T. Penn. "D"
T. 7 Rivers			T. Devonian			T. Cliff House	T. Leadville
T. Queen			T. Silurian			T. Menefee	T. Madison
T. Grayburg			T. Montoya			T. Point Lookout	T. Elbert
T. San Andres			T. Simpson			T. Mancos	T. McCracken
T. Glorieta			T. McKee			T. Gallup	T. Ignacio Otzte
T. Paddock			T. Ellenburger			Base Greenhorn	T. Granite
T. Blinebry			T. Gr. Wash			T. Dakota	
T. Tubb			T. Delaware Sand			T. Morrison	
T. Drinkard			T. Bone Springs			T. Todilto	
T. Abo			T. 1st BS Sand	9424'		T. Entrada	
T. Wolfcamp	11,727'		T. 2nd BS Sand	10,069'		T. Wingate	
T. Penn			T. 3rd BS Sand	11,300'		T. Chinle	
T. Cisco (Bough C)			T.			T. Permian	

No. 1, from.....to.....
No. 2, from.....to.....
No. 3, from.....to.....
No. 4, from.....to.....

Include data on rate of water inflow and elevation to which water rose in hole.

No. 1, from.....to.....feet.....
 No. 2, from.....to.....feet.....
 No. 3, from.....to.....feet.....

LITHOLOGY RECORD (Attach additional sheet if necessary)

From	To	Thickness In Feet	Lithology

From	To	Thickness In Feet	Lithology

District I

1625 N. French Dr., Hobbs, NM 88240
Phone:(575) 393-6161 Fax:(575) 393-0720

District II

811 S. First St., Artesia, NM 88210
Phone:(575) 748-1283 Fax:(575) 748-9720

District III

1000 Rio Brazos Rd., Aztec, NM 87410
Phone:(505) 334-6178 Fax:(505) 334-6170

District IV

1220 S. St Francis Dr., Santa Fe, NM 87505
Phone:(505) 476-3470 Fax:(505) 476-3462

State of New Mexico
Energy, Minerals and Natural Resources
Oil Conservation Division
1220 S. St Francis Dr.
Santa Fe, NM 87505

ACKNOWLEDGMENTS

Action 124473

ACKNOWLEDGMENTS

Operator: EOG RESOURCES INC P.O. Box 2267 Midland, TX 79702	OGRID: 7377
	Action Number: 124473
	Action Type: [C-104] Completion Packet (C-104C)

ACKNOWLEDGMENTS

☒	I hereby certify that the required Water Use Report has been, or will be, submitted for this wells completion.
☒	I hereby certify that the required FracFocus disclosure has been, or will be, submitted for this wells completion.

District I
1625 N. French Dr., Hobbs, NM 88240
Phone:(575) 393-6161 Fax:(575) 393-0720
District II
811 S. First St., Artesia, NM 88210
Phone:(575) 748-1283 Fax:(575) 748-9720
District III
1000 Rio Brazos Rd., Aztec, NM 87410
Phone:(505) 334-6178 Fax:(505) 334-6170
District IV
1220 S. St Francis Dr., Santa Fe, NM 87505
Phone:(505) 476-3470 Fax:(505) 476-3462

State of New Mexico
Energy, Minerals and Natural Resources
Oil Conservation Division
1220 S. St Francis Dr.
Santa Fe, NM 87505

CONDITIONS

Action 124473

CONDITIONS

Operator: EOG RESOURCES INC P.O. Box 2267 Midland, TX 79702	OGRID: 7377
	Action Number: 124473
	Action Type: [C-104] Completion Packet (C-104C)

CONDITIONS

Created By	Condition	Condition Date
smcgrath	File 3160-4 Completion Report within 10 days to NMOCD after BLM approval.	7/27/2022