

District I
1625 N. French Dr., Hobbs, NM 88240
District II
811 S. First St., Artesia, NM 88210
District III
1000 Rio Brazos Rd., Aztec, NM 87410
District IV
1220 S. St. Francis Dr., Santa Fe, NM 87505

State of New Mexico
Energy, Minerals & Natural
Resources

Form C-104
Revised August 1, 2011

Submit one copy to appropriate District Office

Oil Conservation Division
1220 South St. Francis Dr.

☐ AMENDED REPORT

I. REQUEST FOR ALLOWABLE MINERAL AUTHORIZATION TO TRANSPORT

¹ Operator name and Address EOG RESOURCES INC PO BOX 2267 MIDLAND, TEXAS 79702		² OGRID Number 7377	
		³ Reason for Filing Code/ Effective Date NW 01/24/2023	
⁴ API Number 30 - 025-50134	⁵ Pool Name BOBCAT DRAW; UPPER WOLFCAMP		⁶ Pool Code 98094
⁷ Property Code 330827	⁸ Property Name LACEY SWISS 1 FEDERAL COM		⁹ Well Number 704H

II. ¹⁰ Surface Location

Ul or lot no.	Section	Township	Range	Lot Idn	Feet from the	North/South Line	Feet from the	East/West line	County
C	1	25S	33E		728'	NORTH	2501'	WEST	LEA

¹¹ Bottom Hole Location

UL or lot no.	Section	Township	Range	Lot Idn	Feet from the	North/South line	Feet from the	East/West line	County
O	12	25S	33E		110'	SOUTH	1651'	EAST	LEA
¹² Lse Code	¹³ Producing Method Code FLOWING	¹⁴ Gas Connection Date	¹⁵ C-129 Permit Number	¹⁶ C-129 Effective Date	¹⁷ C-129 Expiration Date				

III. Oil and Gas Transporters

¹⁸ Transporter OGRID	¹⁹ Transporter Name and Address	²⁰ O/G/W
372812	EOGRM	OIL
151618	ENTERPRISE FIELD SERVICES	GAS
298751	REGENCY FIELD SERVICES	GAS
36785	DCP MIDSTREAM	GAS

IV. Well Completion Data

²¹ Spud Date 06/29/2022	²² Ready Date 01/24/2023	²³ TD 22,737'	²⁴ PBTD 22,713'	²⁵ Perforations 12,920 - 22,713'	²⁶ DHC, MC
²⁷ Hole Size	²⁸ Casing & Tubing Size	²⁹ Depth Set	³⁰ Sacks Cement		
12 1/4"	9 5/8"	1341'	669 SXS CL C/CIRC		
8 3/4"	7 5/8"	11,908'	1510 SXS CL C&H/85' ECHO		
6 3/4"	5 1/2"	22,722'	1120 SXS CL H TOC 0' CBL		

V. Well Test Data

³¹ Date New Oil 01/24/2023	³² Gas Delivery Date 01/24/2023	³³ Test Date 02/05/2023	³⁴ Test Length 24 HRS	³⁵ Tbg. Pressure	³⁶ Csg. Pressure 1027
³⁷ Choke Size 36	³⁸ Oil 4292	³⁹ Water 4940	⁴⁰ Gas 7859		⁴¹ Test Method

⁴² I hereby certify that the rules of the Oil Conservation Division have been complied with and that the information given above is true and complete to the best of my knowledge and belief. Signature: Kay Maddox Printed name: Kay Maddox Title: SENIOR REGULATORY SPECIALIST E-mail Address: kay_maddox@eogresources.com Date: 02/13/2023	Phone: 432-638-8475	OIL CONSERVATION DIVISION	
	Approved by: PATRICIA MARTINEZ		
	Title: PETROLEUM SPECIALIST		
	Approval Date: 3/10/2025		

District I
1625 N. French Dr., Hobbs, NM 88240
Phone: (575) 393-6161 Fax: (575) 393-0720
District II
811 S. First St., Artesia, NM 88210
Phone: (575) 748-1283 Fax: (575) 748-9720
District III
1000 Rio Brazos Road, Aztec, NM 87410
Phone: (505) 334-6178 Fax: (505) 334-6170
District IV
1220 S. St. Francis Dr., Santa Fe, NM 87505
Phone: (505) 476-3460 Fax: (505) 476-3462

State of New Mexico
Energy, Minerals & Natural Resources
Department
OIL CONSERVATION DIVISION
1220 South St. Francis Dr.
Santa Fe, NM 87505

FORM C-102

Revised August 1, 2011

Submit one copy to appropriate

District Office

☐ AMENDED REPORT

AS-DRILLED PLAT

¹ API Number 30-025-50134	² Pool Code 98094	³ Pool Name BOBCAT DRAW; UPPER WOLFCAMP
⁴ Property Code 330827	⁵ Property Name LACEY SWISS 1 FED COM	⁶ Well Number 704H
⁷ OGRID No. 7377	⁸ Operator Name EOG RESOURCES, INC.	⁹ Elevation 3466'

¹⁰Surface Location


UL or lot no.	Section	Township	Range	Lot Idn	Feet from the	North/South line	Feet from the	East/West line	County
3	1	25-S	33-E	-	728'	NORTH	2501'	WEST	LEA

¹¹Bottom Hole Location If Different From Surface

UL or lot no.	Section	Township	Range	Lot Idn	Feet from the	North/South line	Feet from the	East/West line	County
0	12	25-S	33-E	-	110'	SOUTH	1651'	EAST	LEA

¹² Dedicated Acres 639.91	¹³ Joint or Infill	¹⁴ Consolidation Code	¹⁵ Order No.
---	-------------------------------	----------------------------------	-------------------------

No allowable will be assigned to this completion until all interests have been consolidated or a non-standard unit has been approved by the division.

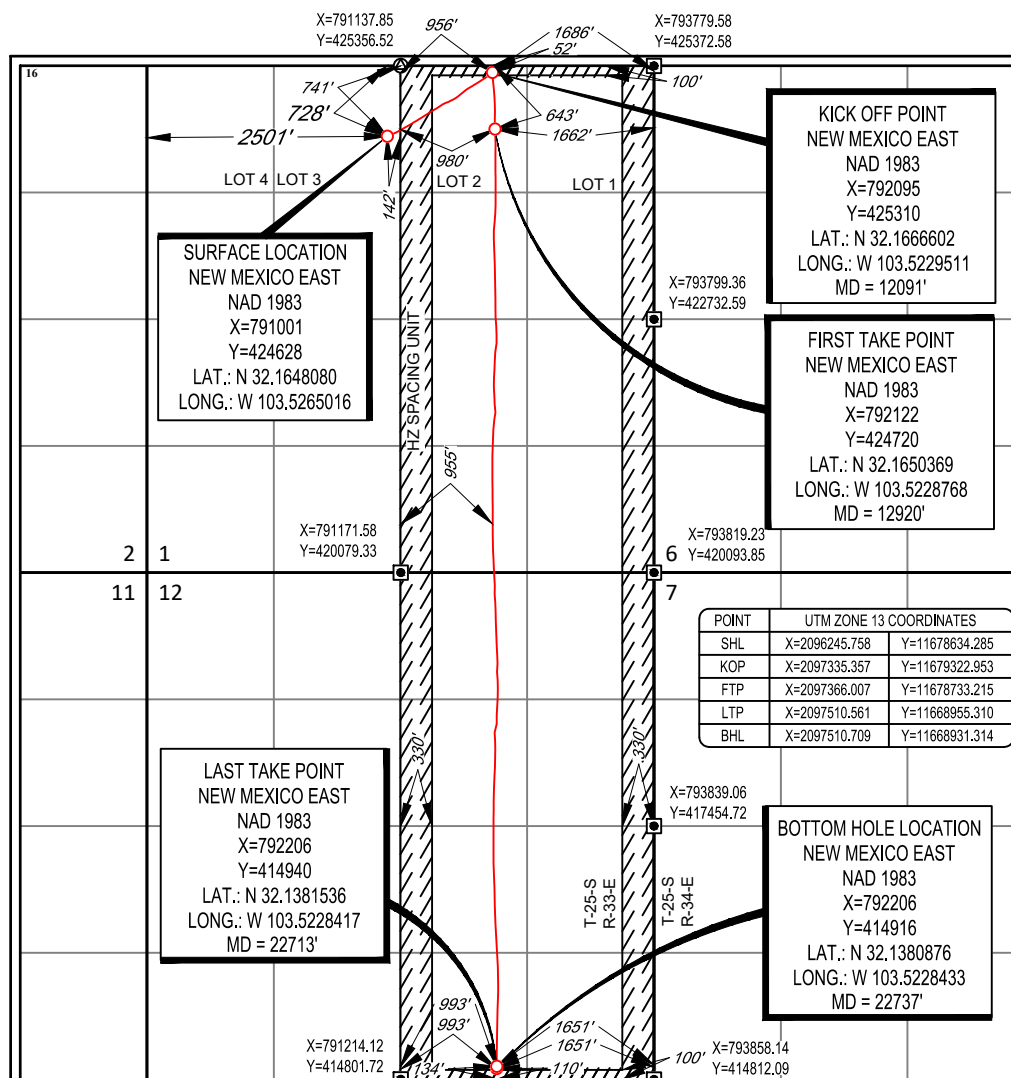¹⁷OPERATOR CERTIFICATION

I hereby certify that the information contained herein is true and complete to the best of my knowledge and belief, and that this organization either owns a working interest or unleased mineral interest in the land including the proposed bottom hole location or has a right to drill this well at this location pursuant to a contract with an owner of such a mineral or working interest, or to a voluntary pooling agreement or a compulsory pooling order heretofore entered by the division.

Kay Maddox 02/07/2023
Signature Date

KAY MADDOX

Printed Name

KAY_MADDOX@EOGRESOURCES.COM


E-mail Address

¹⁸SURVEYOR CERTIFICATION


I hereby certify that the well location shown on this plat was plotted from field notes of actual surveys made by me or under my supervision, and that the same is true to the best of my belief.

06/27/2022

Date of Survey
Signature and Seal of Professional Surveyor

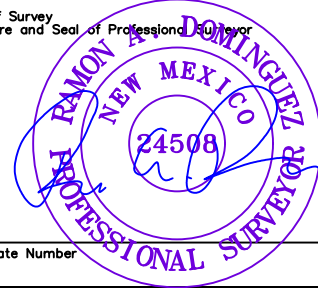

Certificate Number

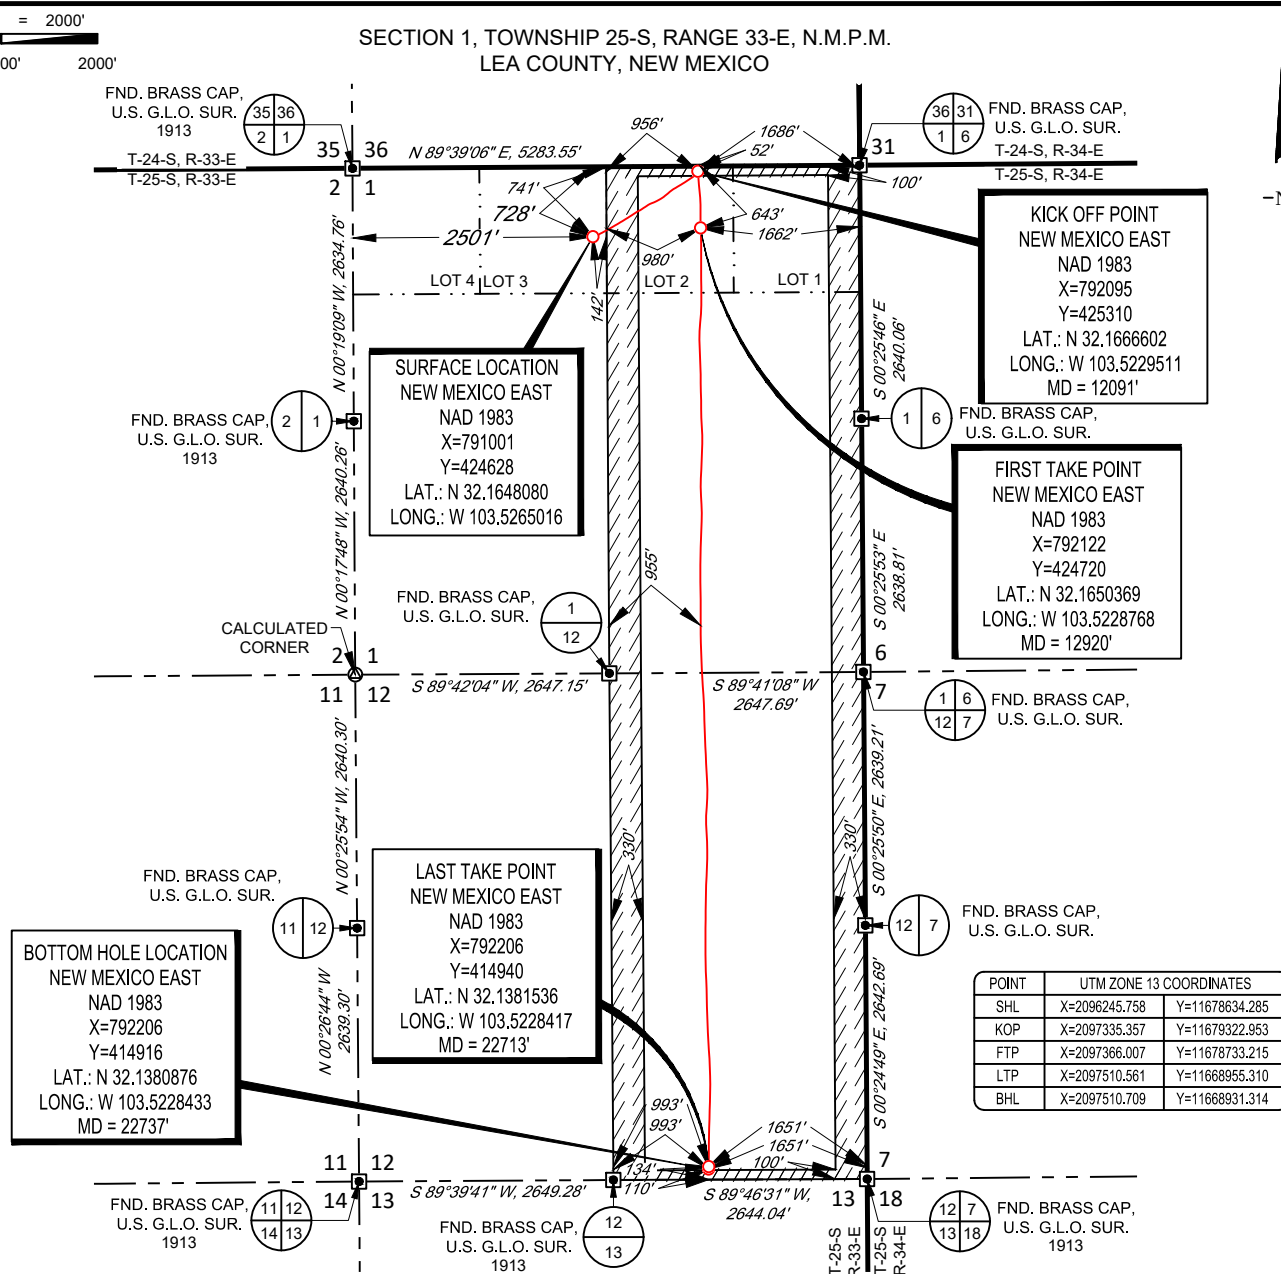






LEASE NAME & WELL NO.: LACEY SWISS 1 FED COM 704H
SECTION 1 TWP. 25-S RGE 33-E SURVEY N.M.P.M.
COUNTY LEA STATE NM ELEVATION 3466'
DESCRIPTION 728' FNL & 2501' FWL



Ramon A. Dominguez, P.S. No. 24508
January 19, 2023



LACEY SWISS 1 FED COM 704H AS-COMPLETED	REVISION:		NOTES: 1. ORIGINAL DOCUMENT SIZE: 8.5" X 11" 2. ALL BEARINGS, DISTANCES, AND COORDINATE VALUES CONTAINED HEREIN ARE GRID BASED UPON THE NEW MEXICO COORDINATE SYSTEM OF 1983, EAST ZONE, U.S. SURVEY FEET. 3. THIS WELL LOCATION SHOWN HEREON HAS BEEN SURVEYED ON THE GROUND UNDER MY SUPERVISION AND PREPARED ACCORDING TO THE EVIDENCE FOUND AT THE TIME OF SURVEY, AND DATA PROVIDED BY EOG RESOURCES, INC. THIS CERTIFICATION IS MADE AND LIMITED TO THOSE PERSONS OR ENTITIES SHOWN ON THE FACE OF THIS PLAT AND IS NON-TRANSFERABLE. THIS SURVEY IS CERTIFIED FOR THIS TRANSACTION ONLY.
DATE: 01/19/23			
FILE:AD_LACEY_SWISS_1_FED_COM_704H			
DRAWN BY: IMU			
SHEET : 2 OF 2			

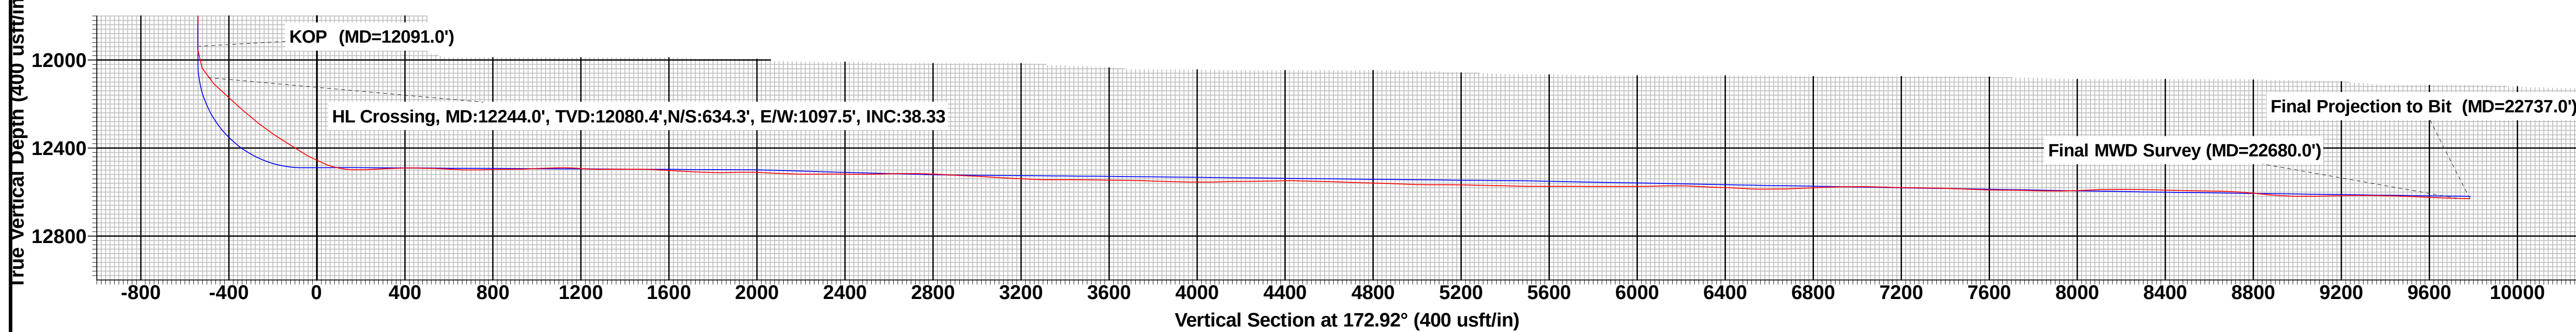
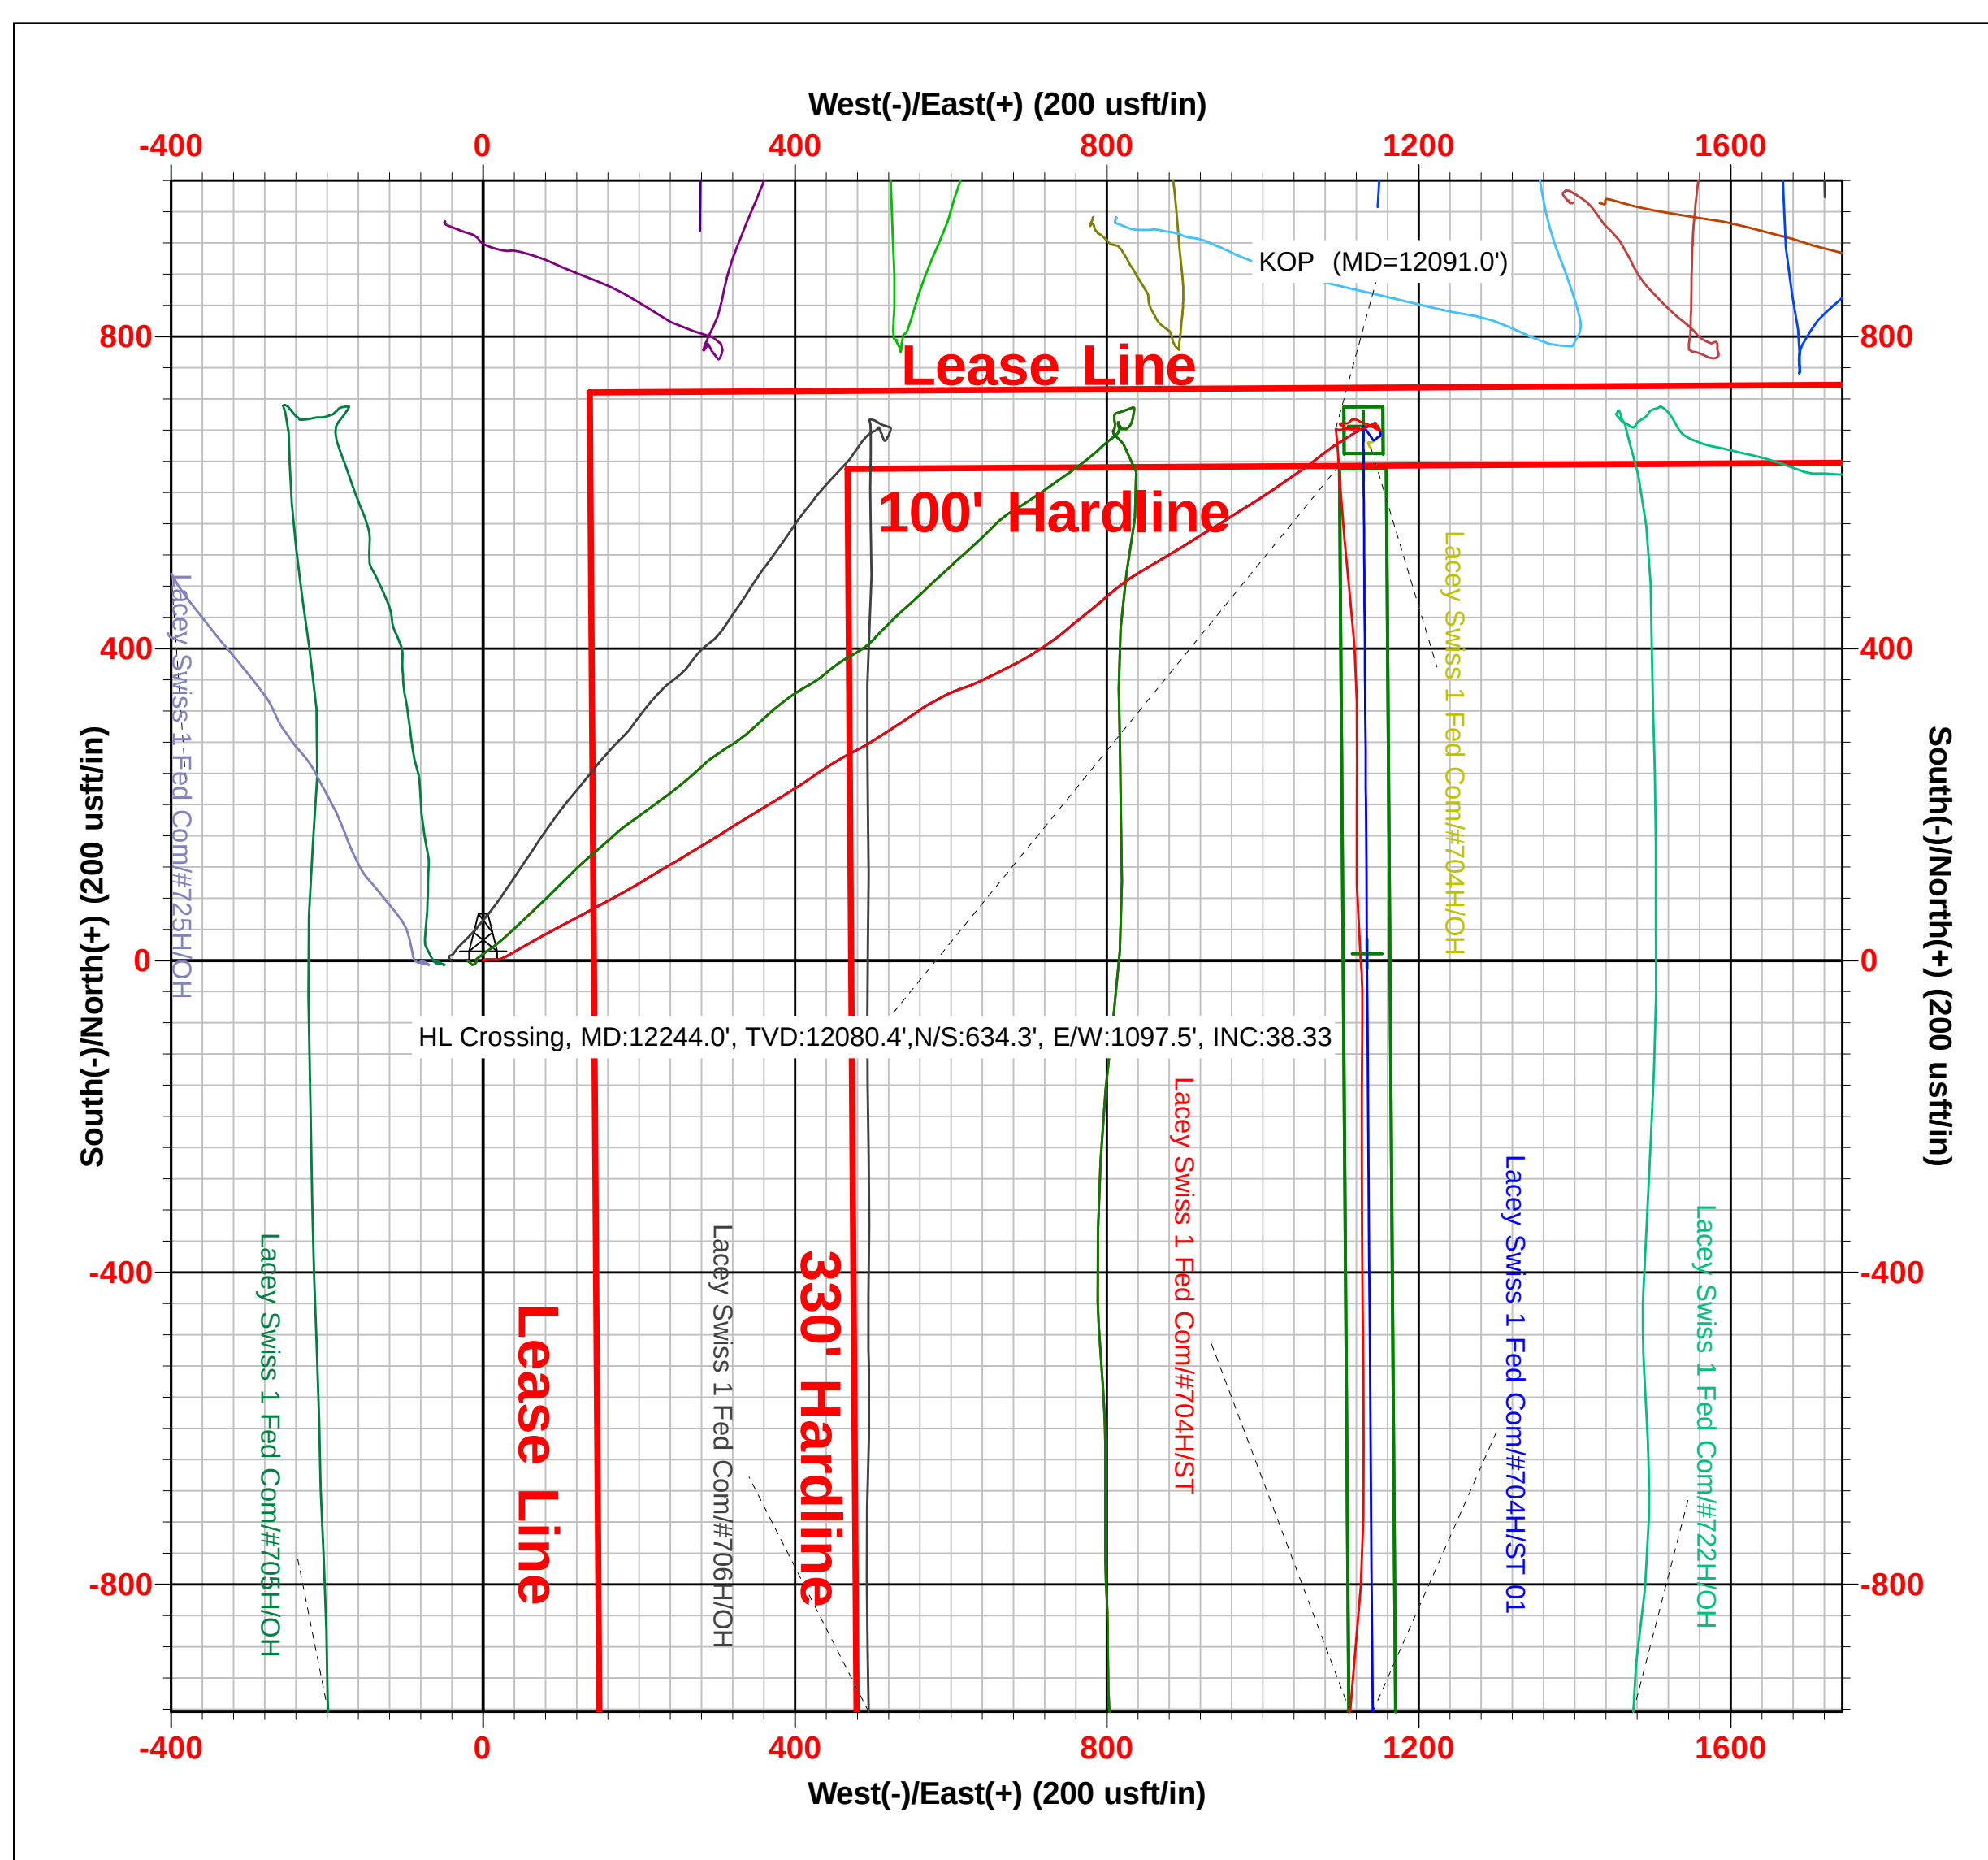
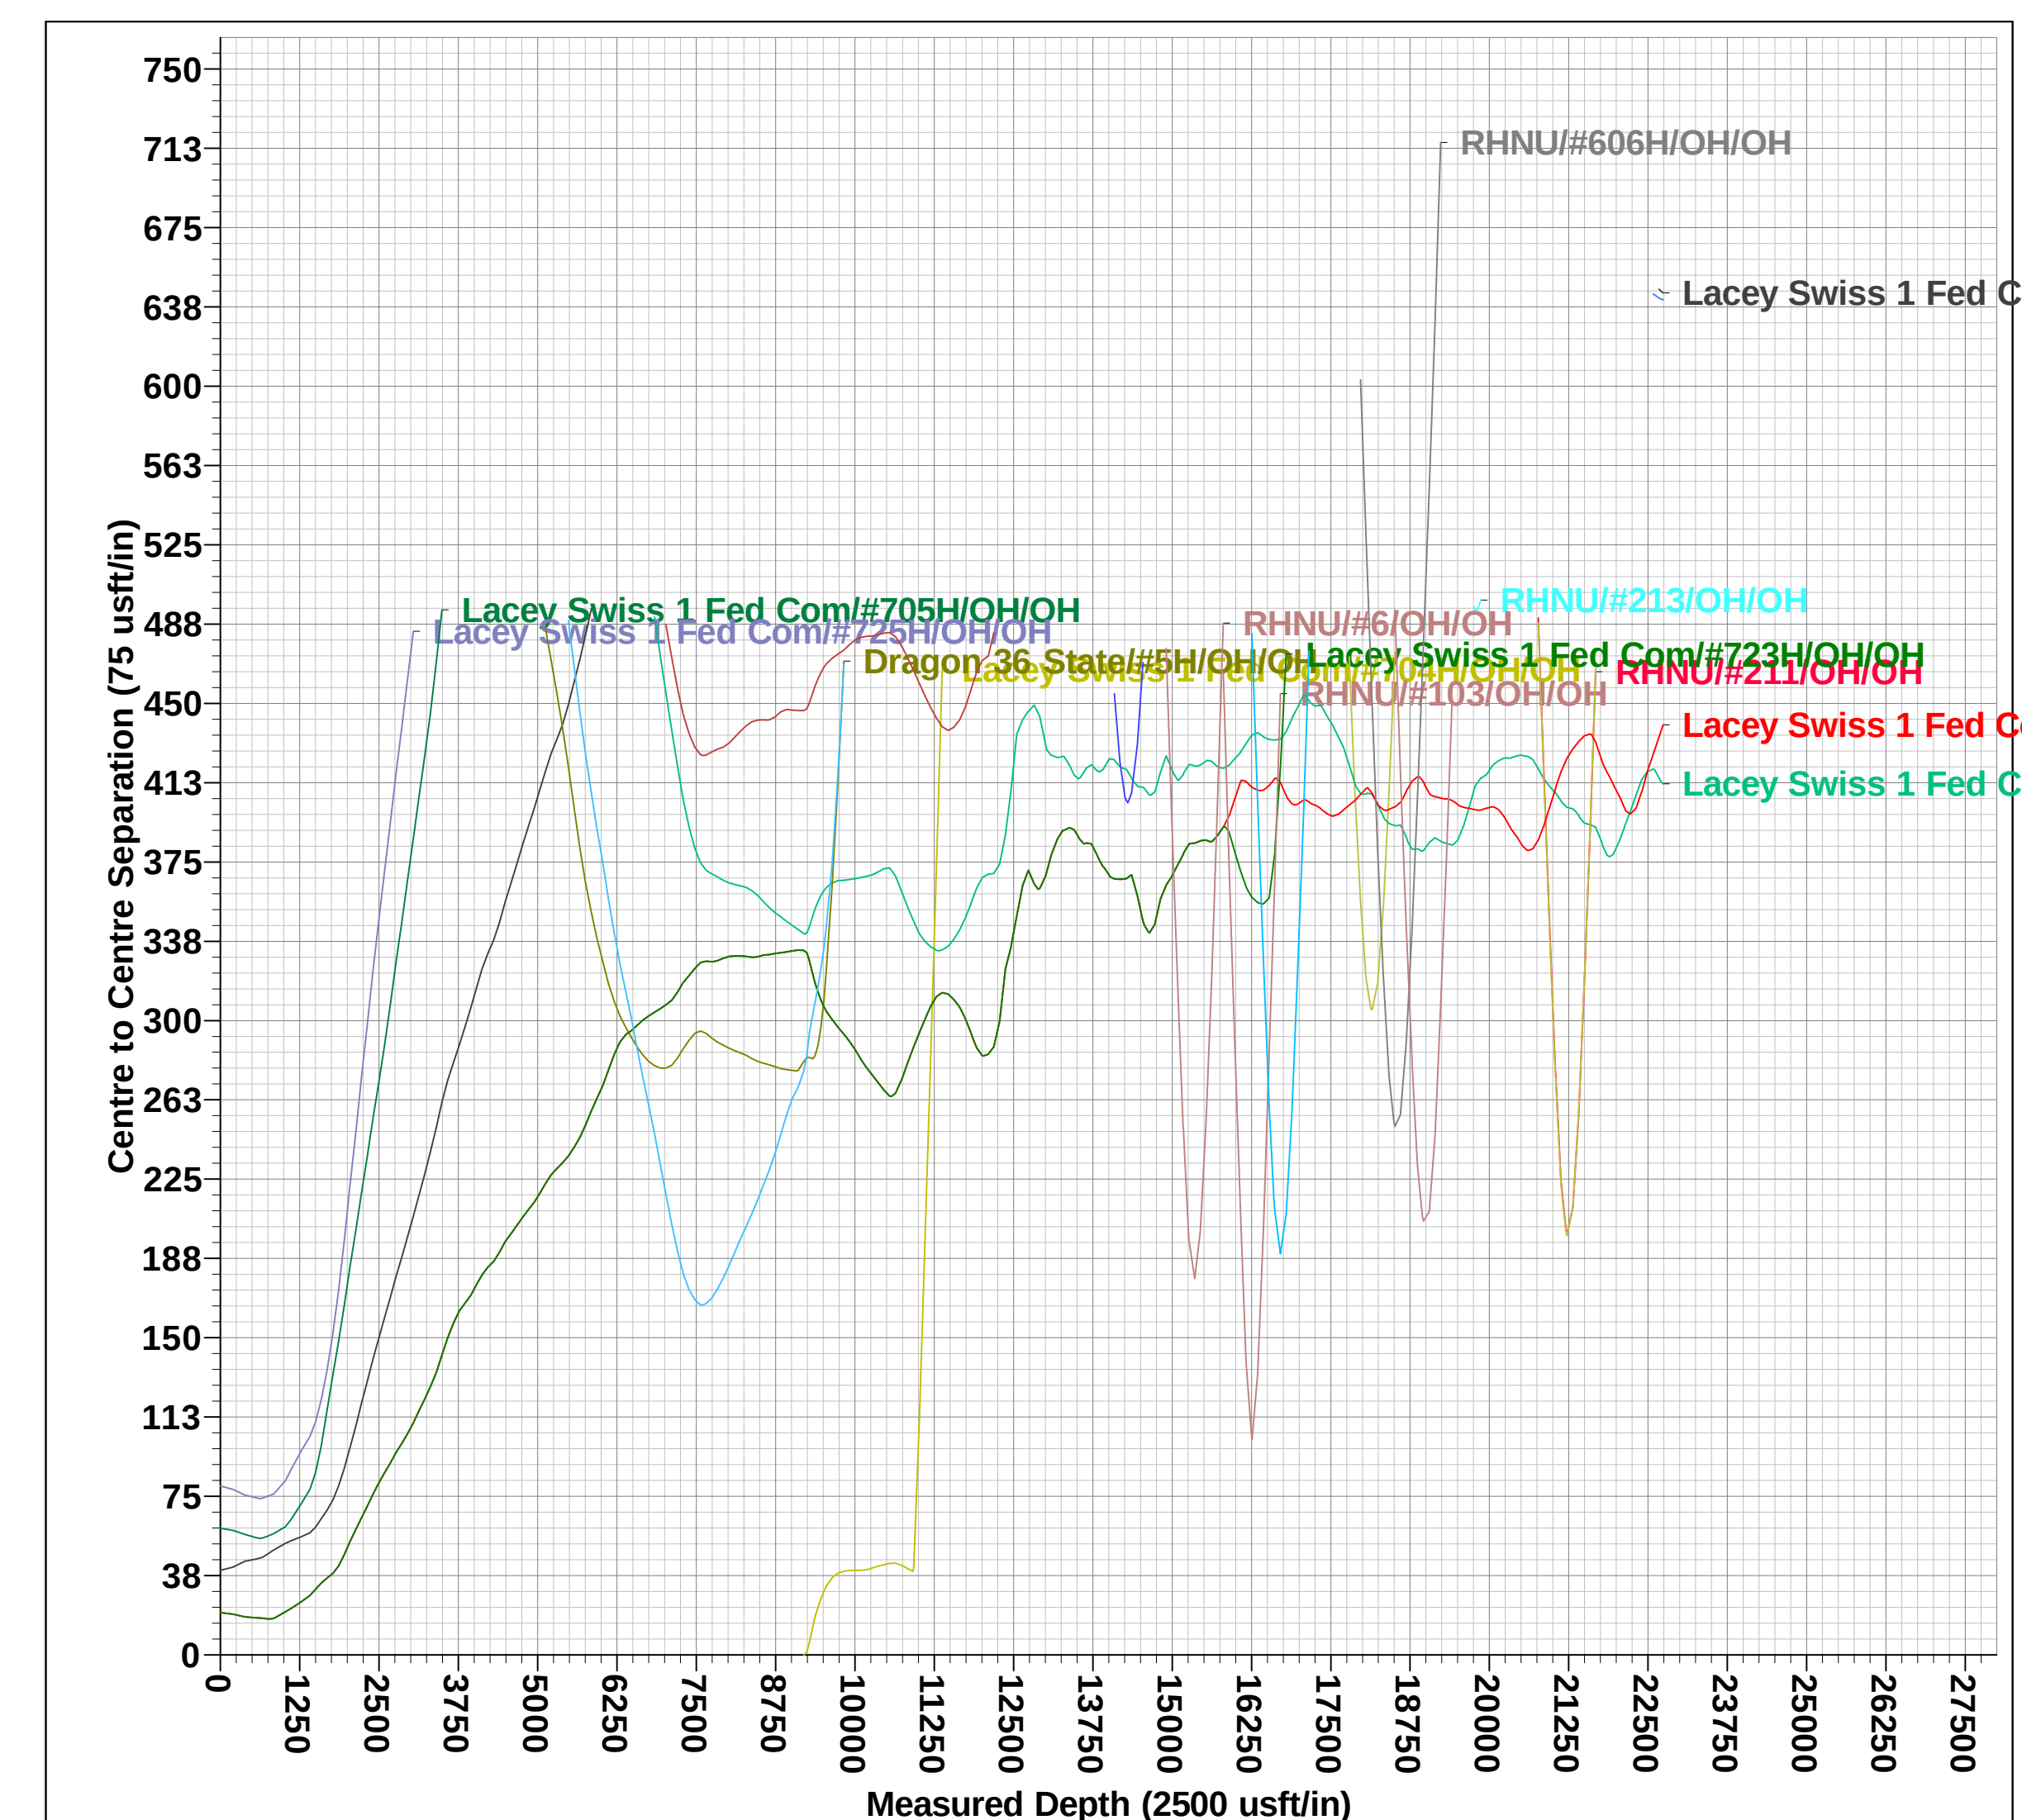
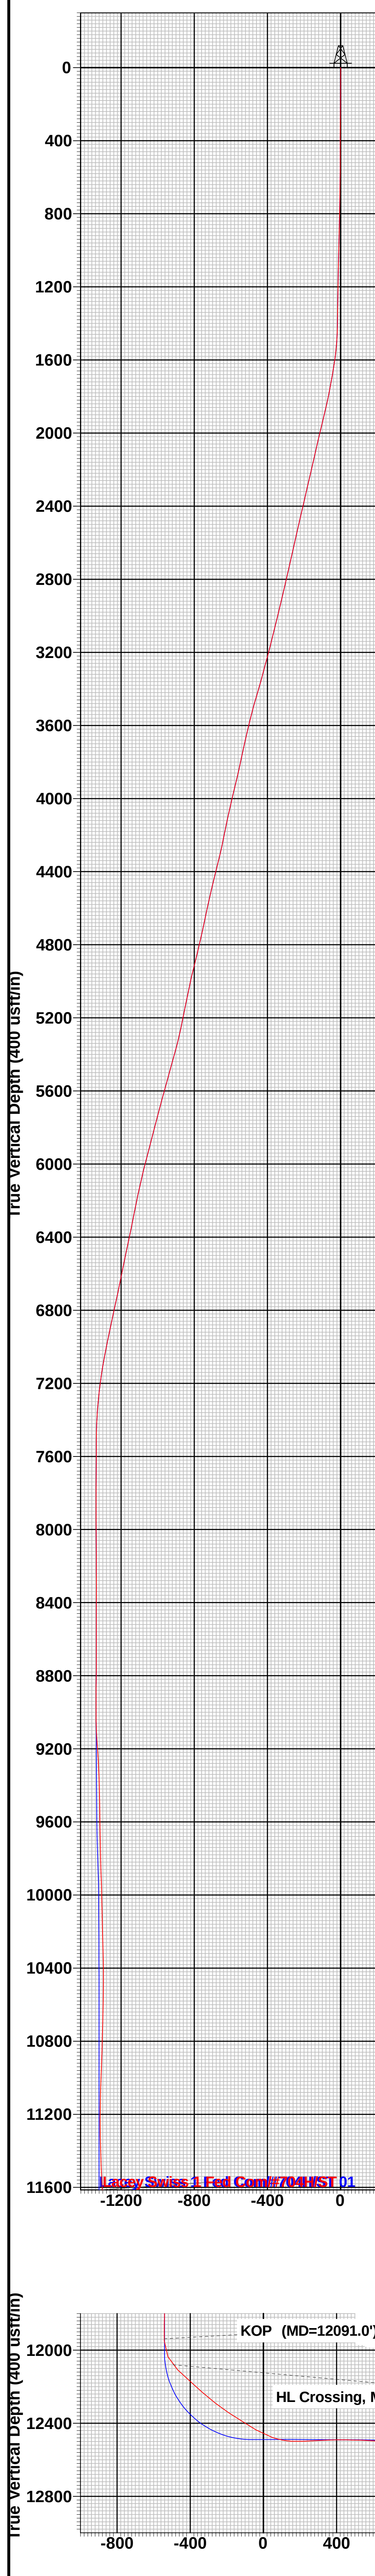
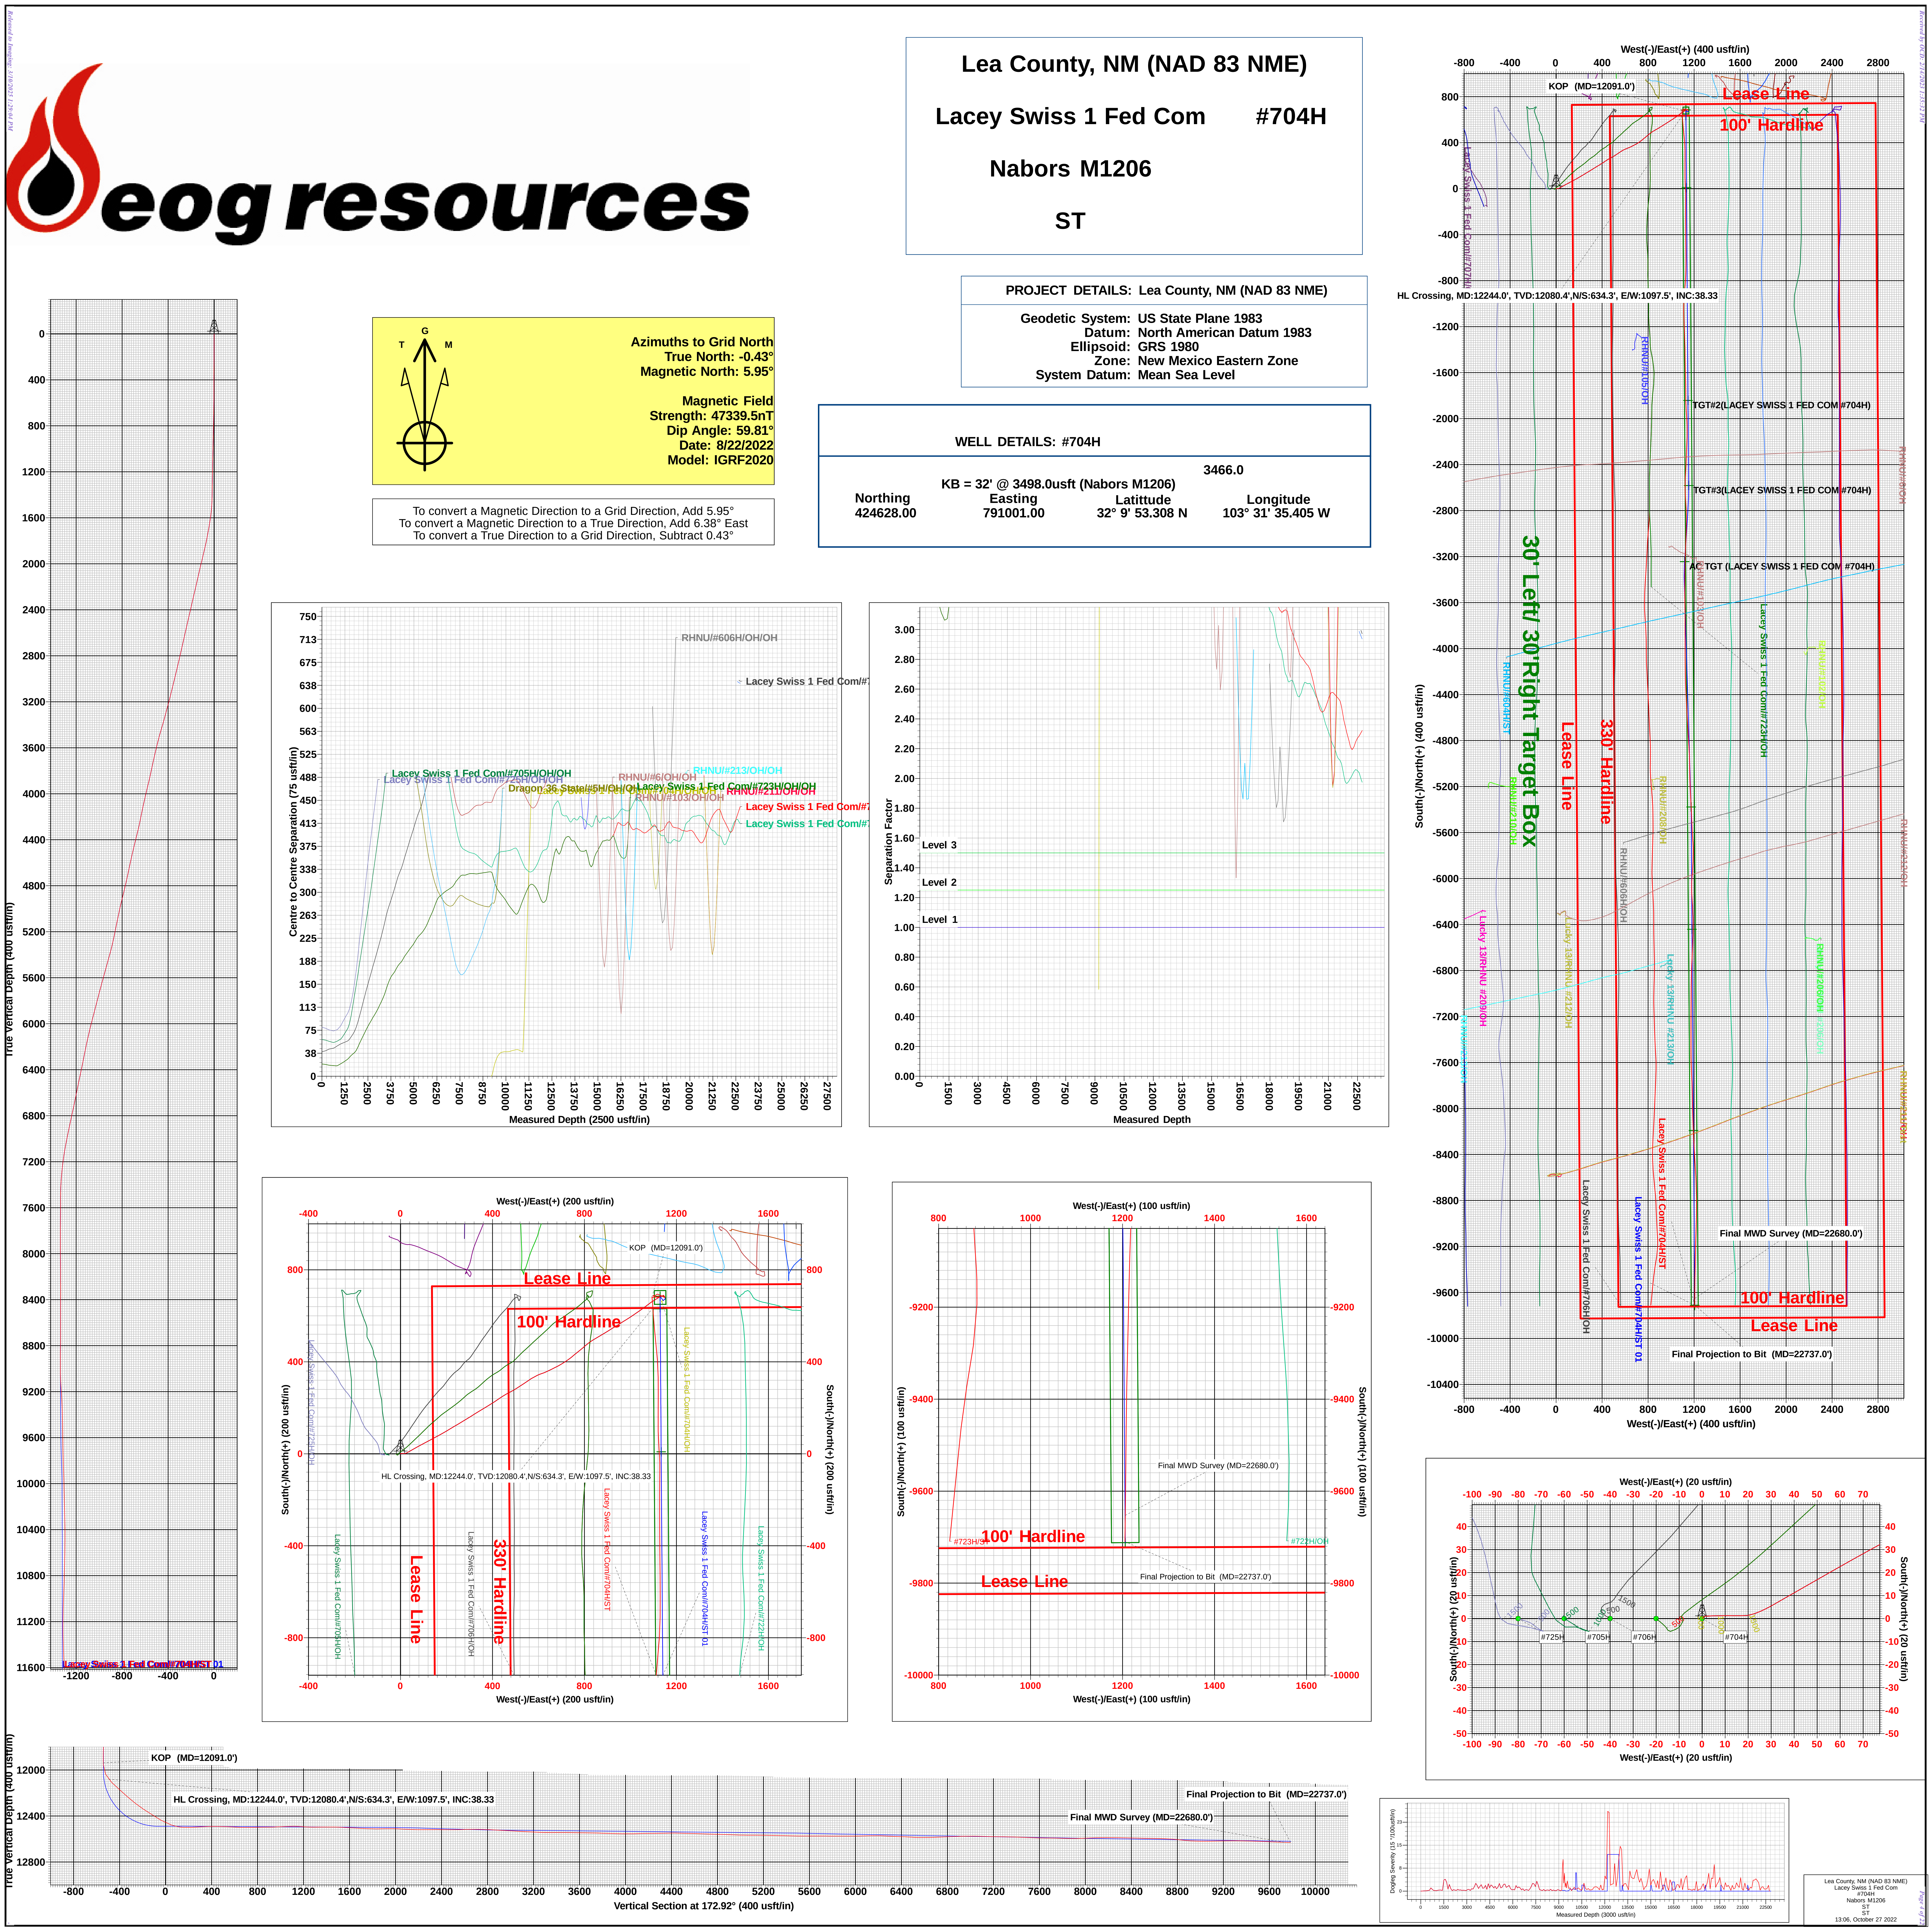


ST

Geodetic System: US State Plane 1983
Datum: North American Datum 1983
Ellipsoid: GRS 1980
Zone: New Mexico Eastern Zone
System Datum: Mean Sea Level

WELL DETAILS: #704H

			3466.0
	KB = 32' @ 3498.0usft (Nabors M1206)		
Northings	Easting	Latitude	Longitude
424628.00	791001.00	32° 9' 53.308 N	103° 31' 35.405 W

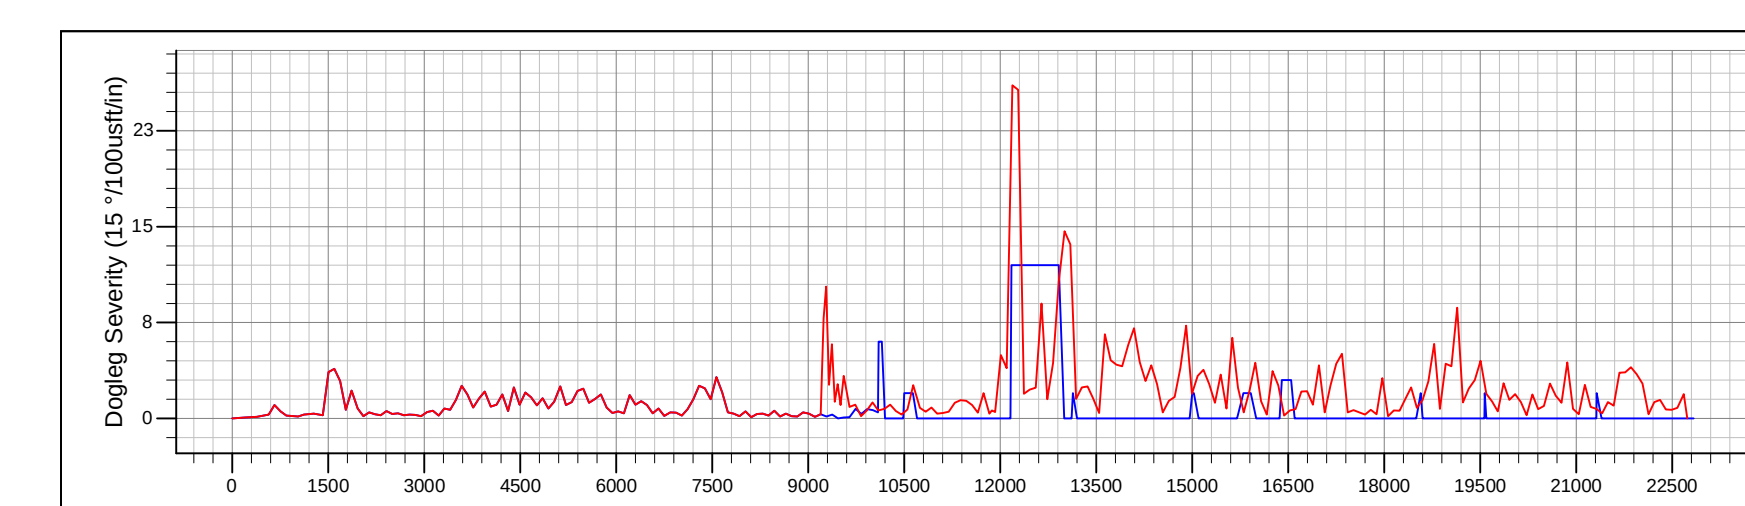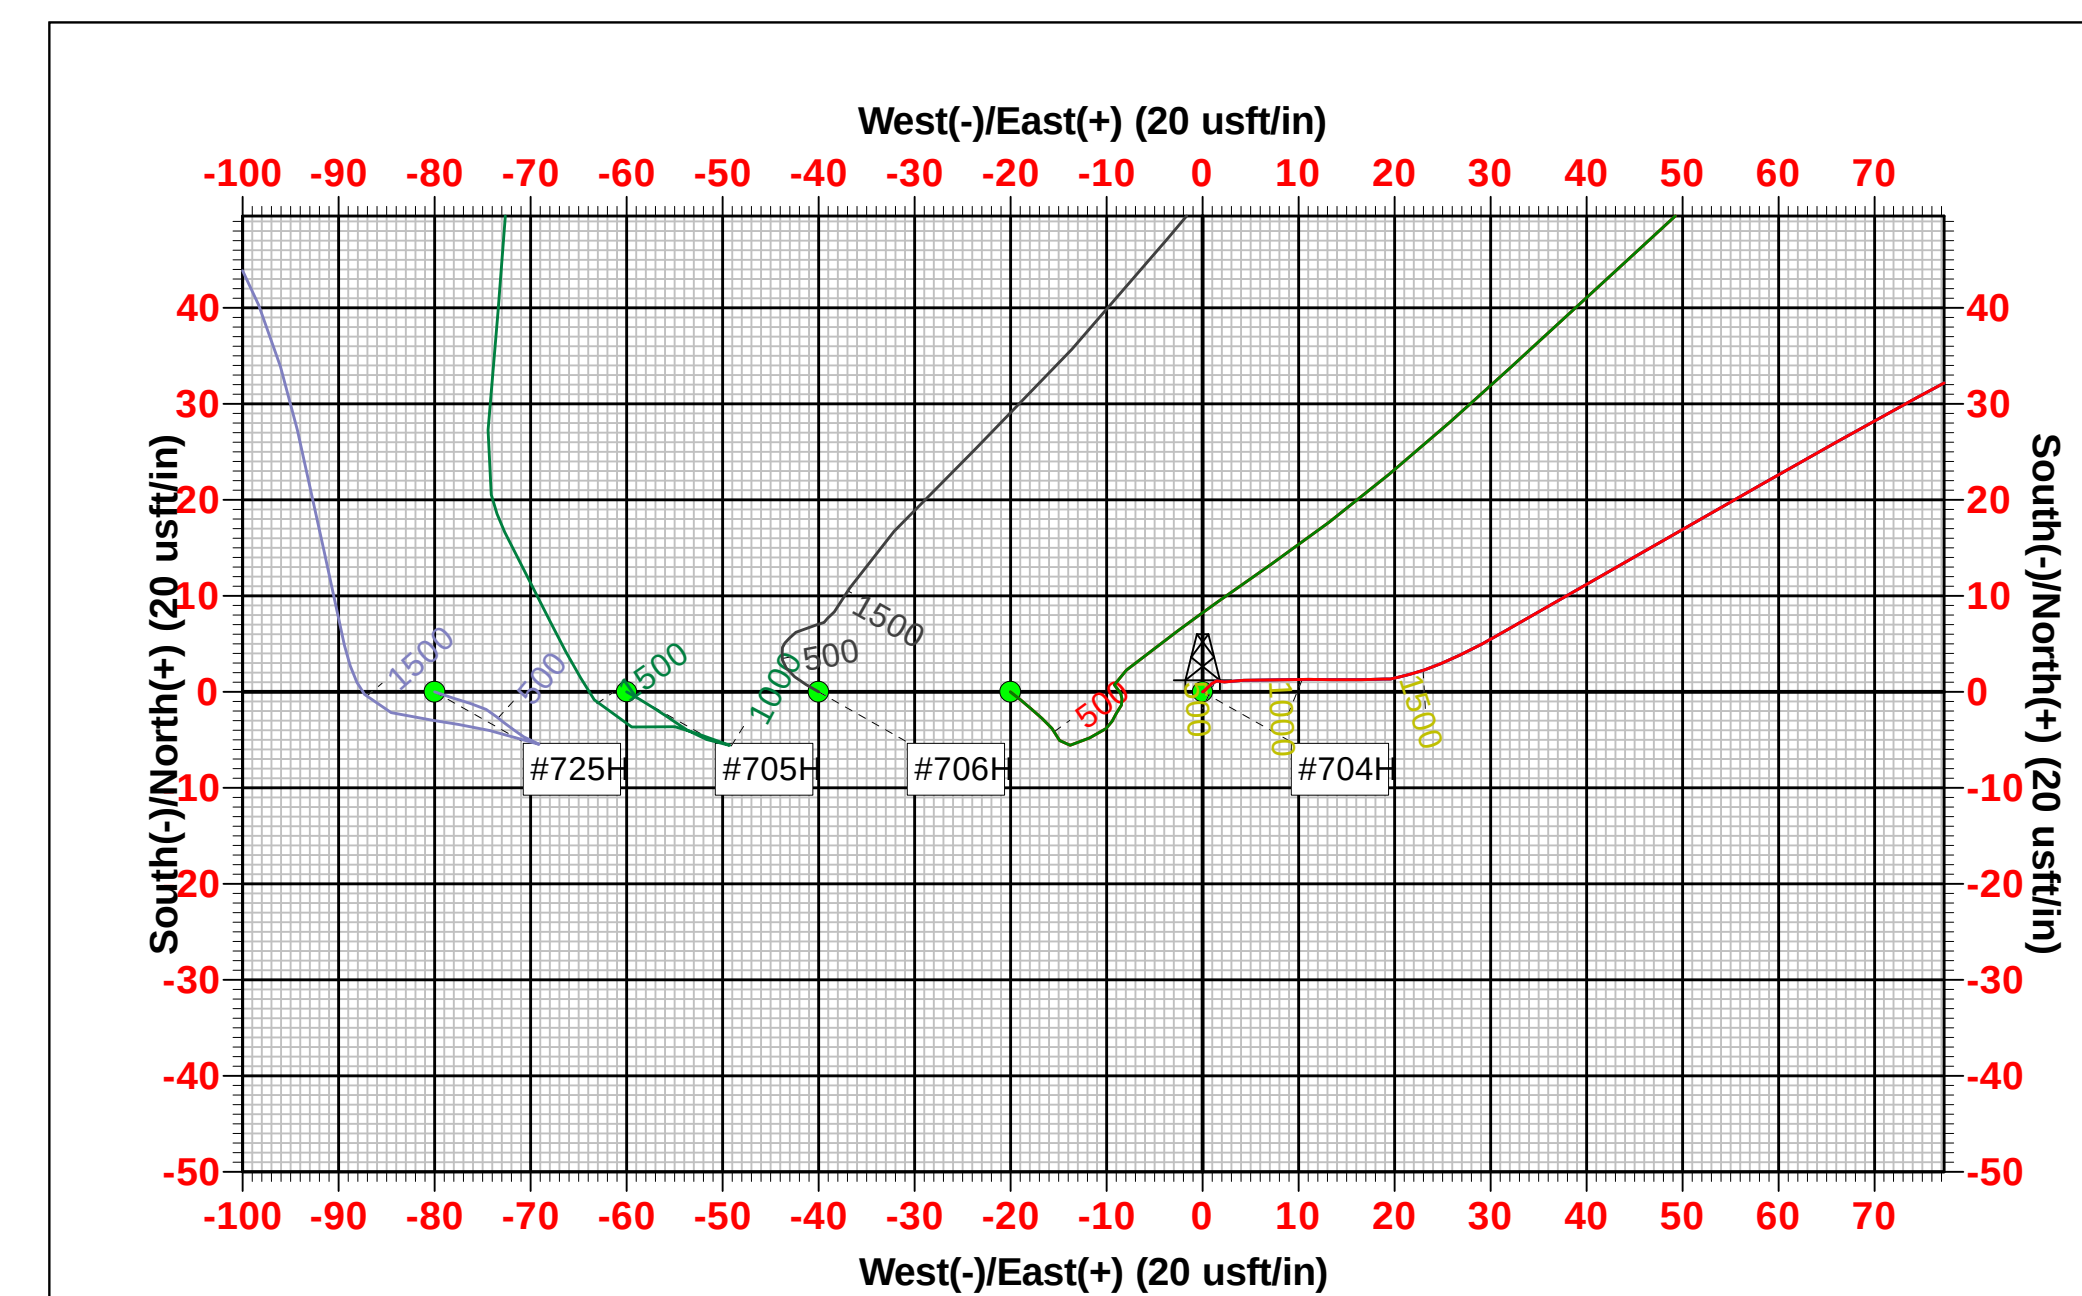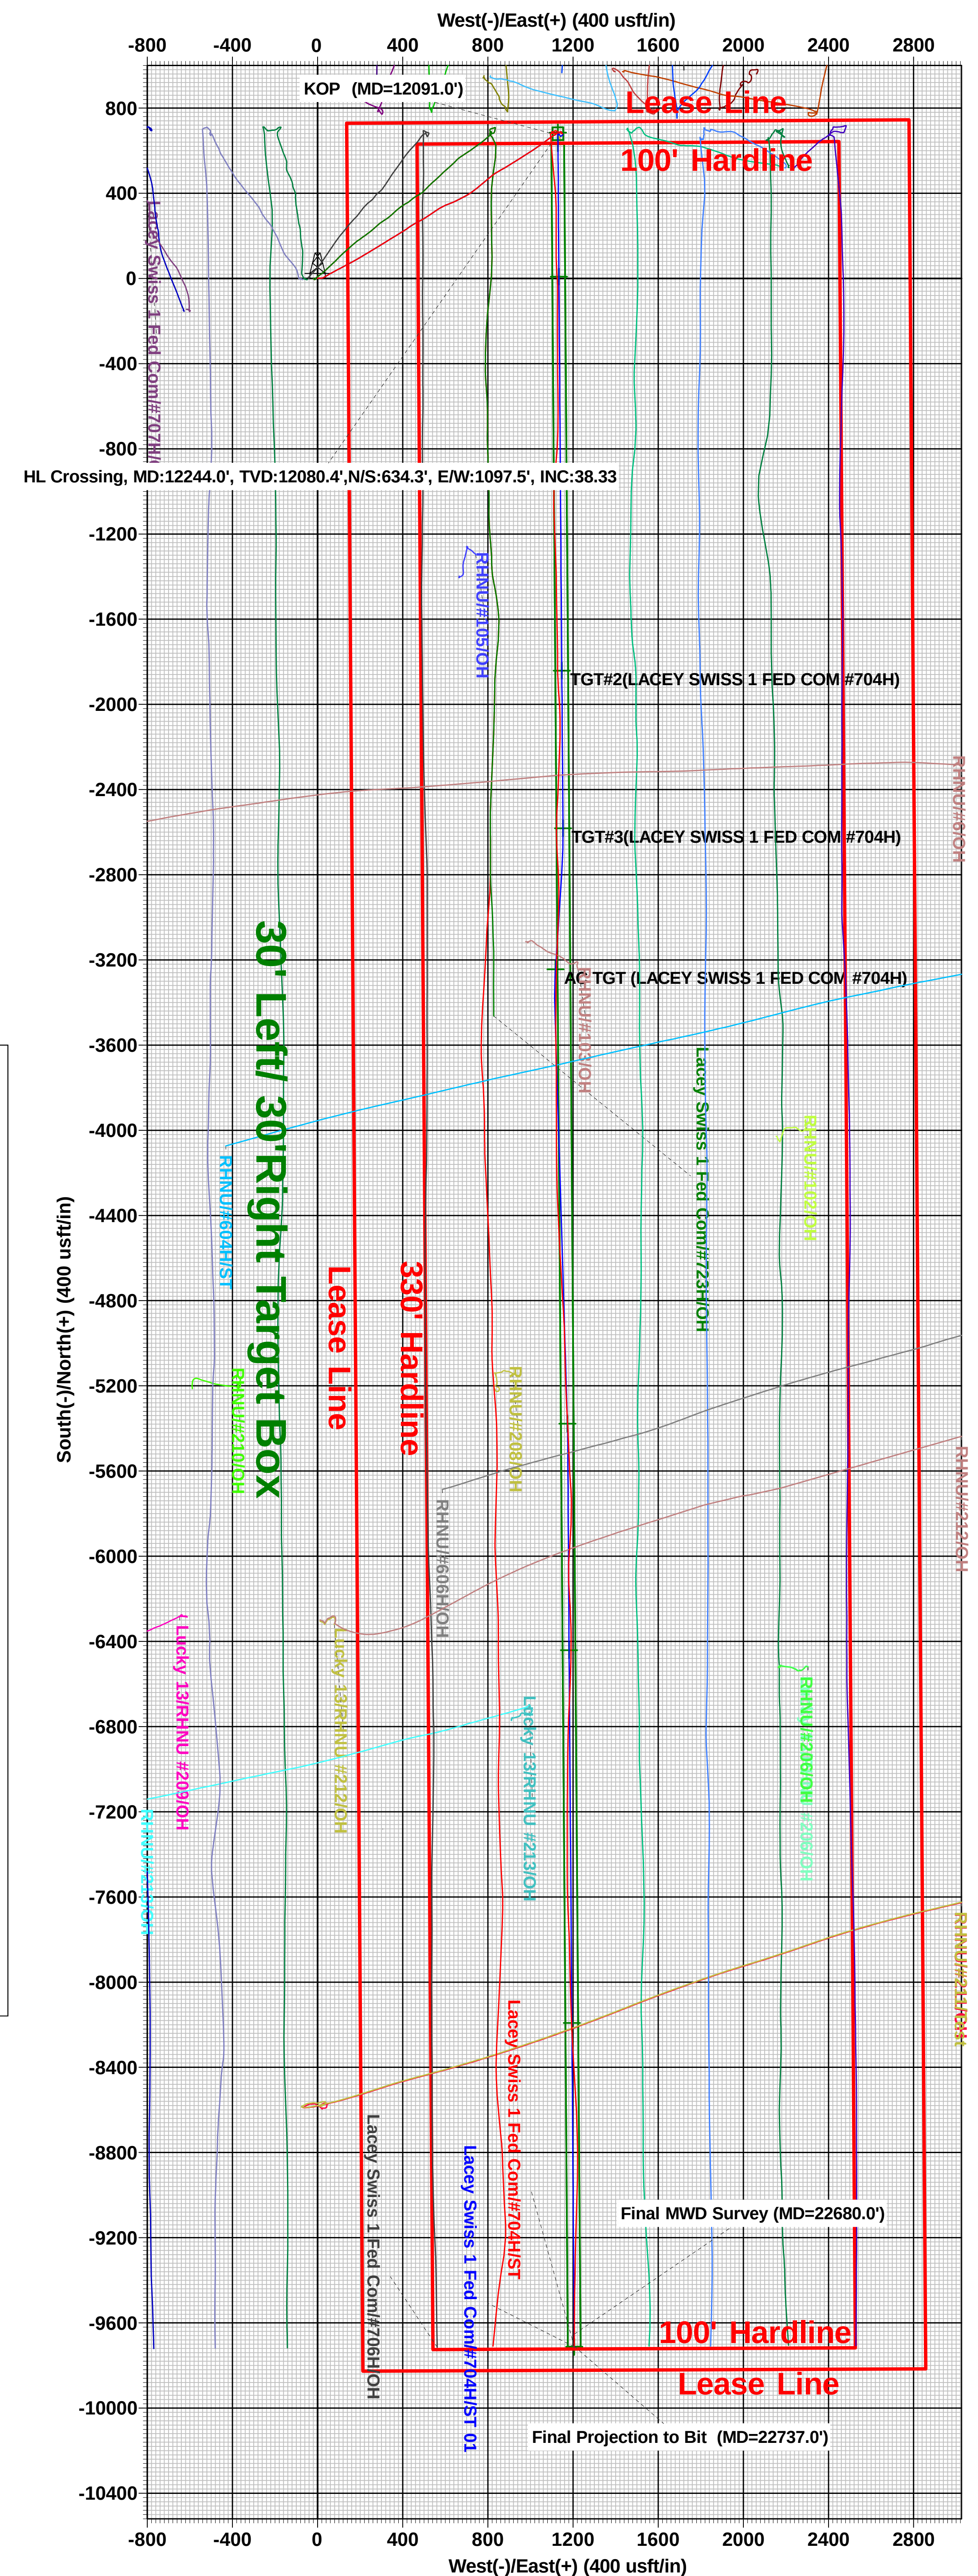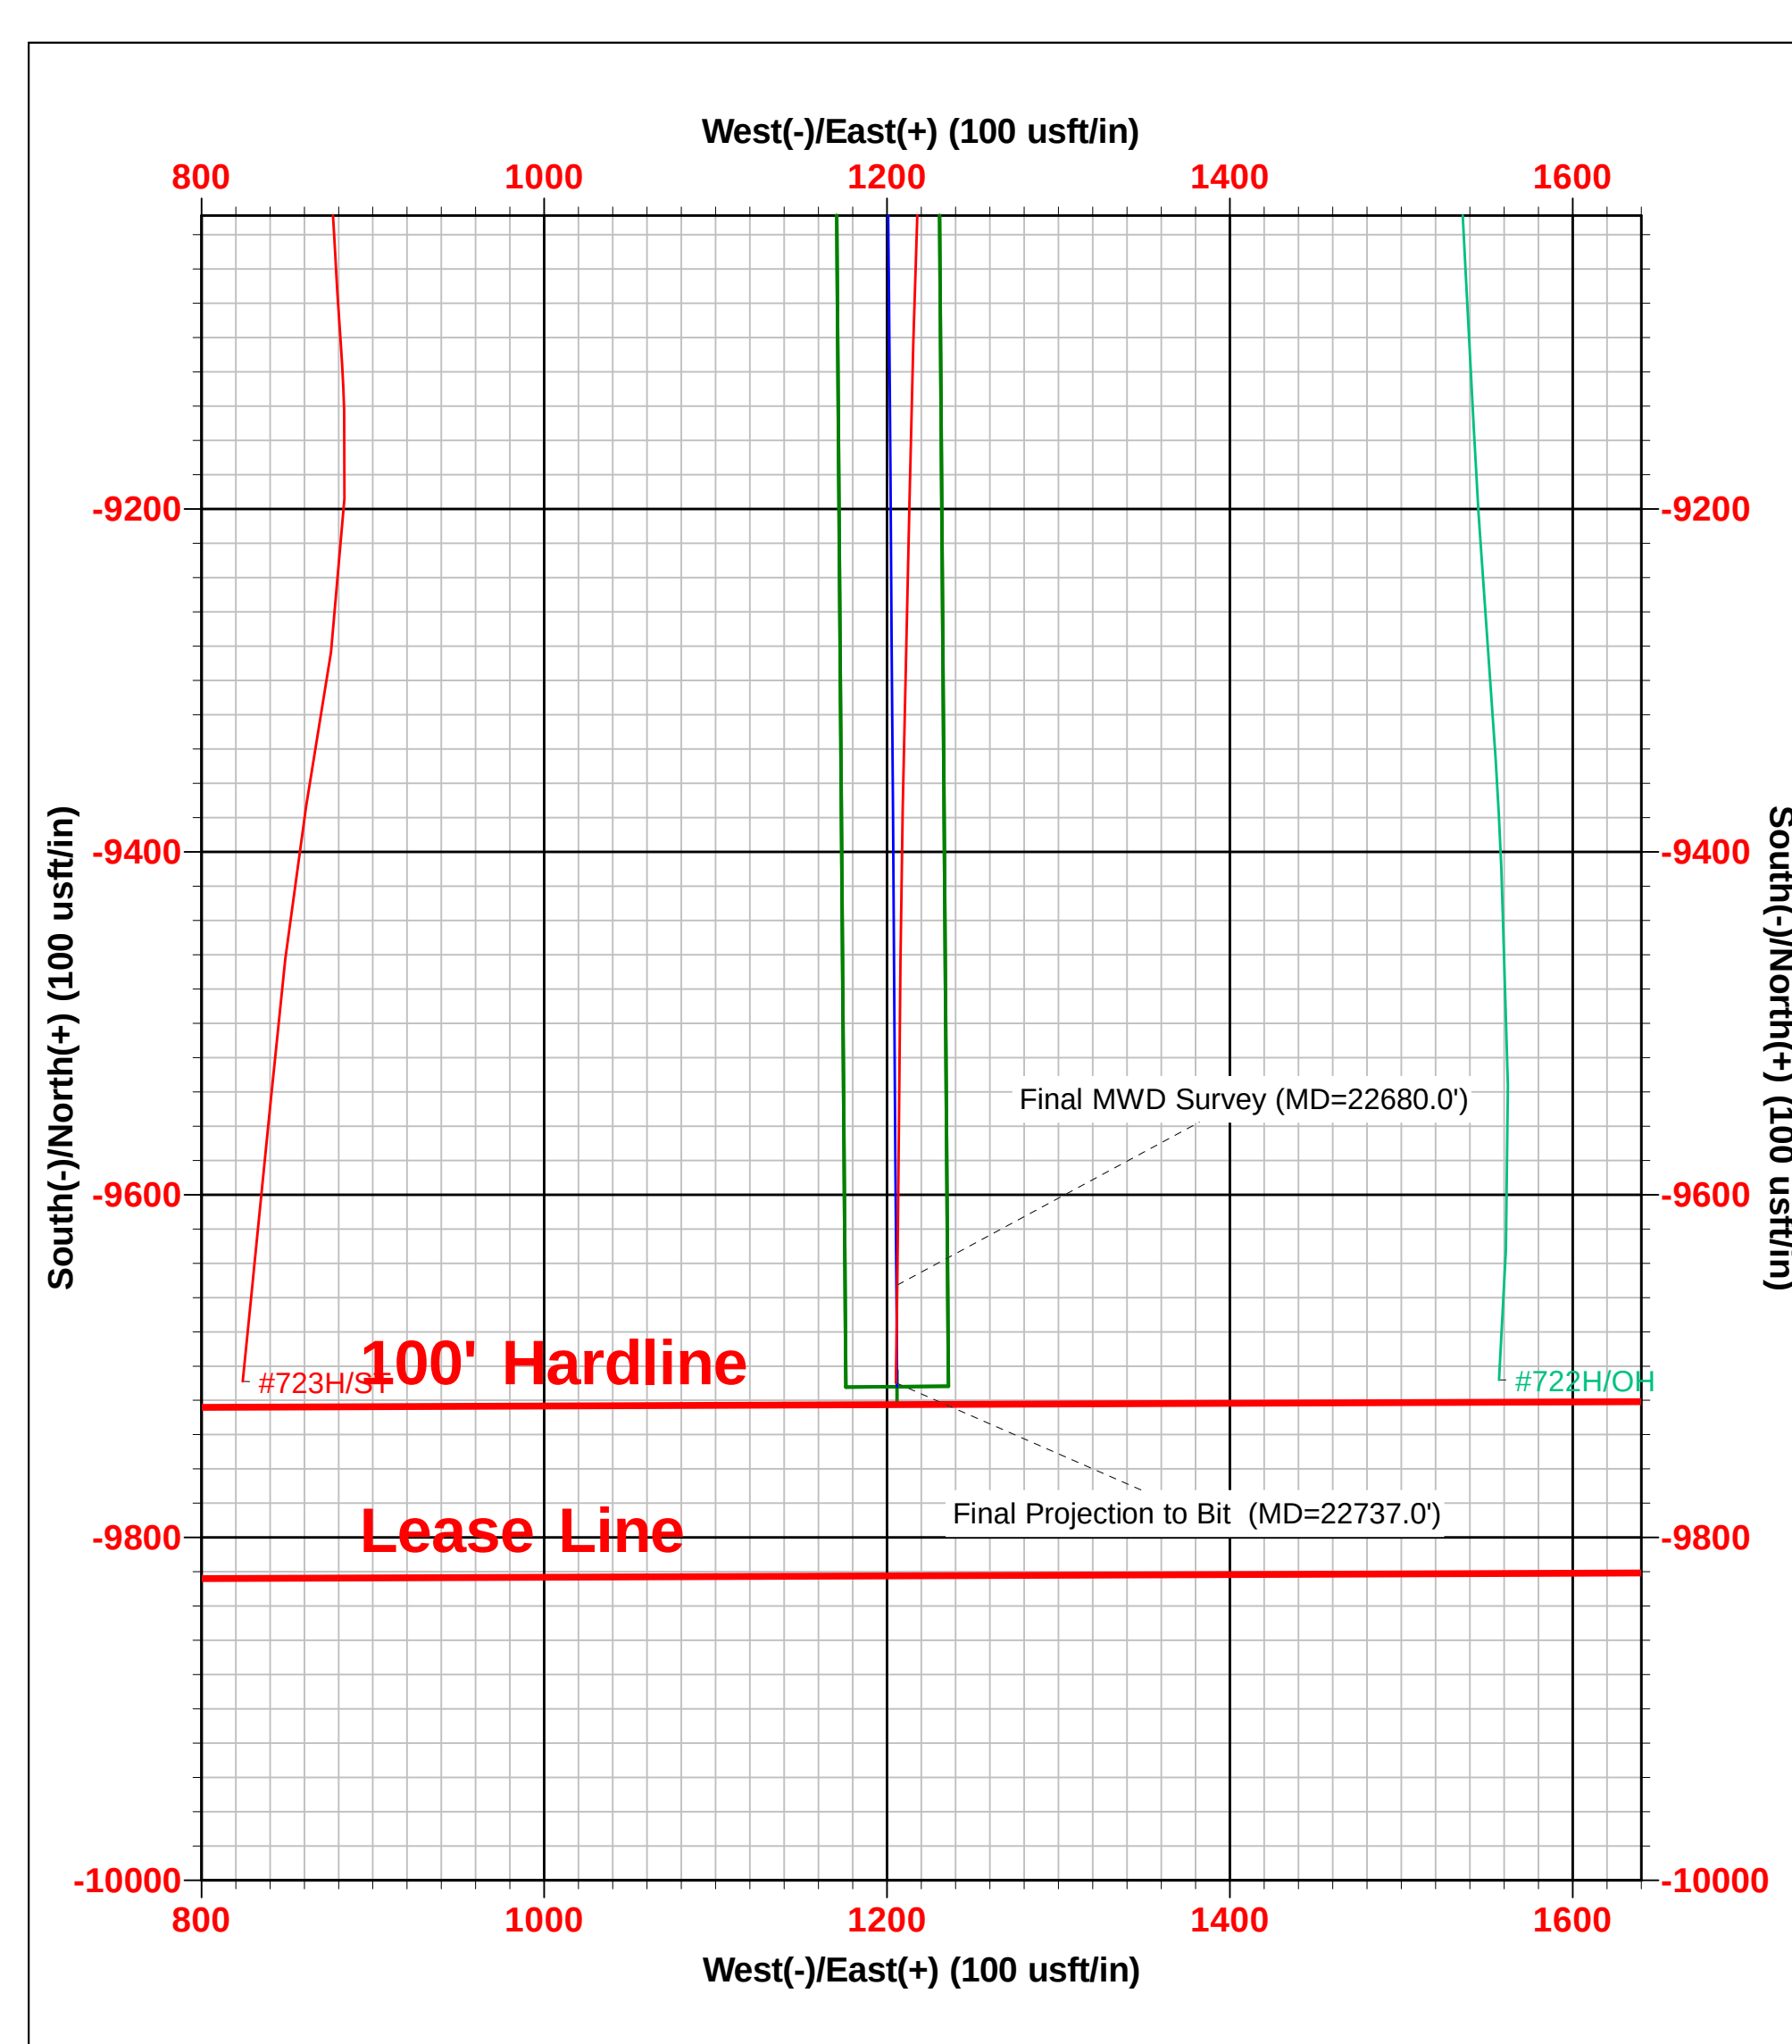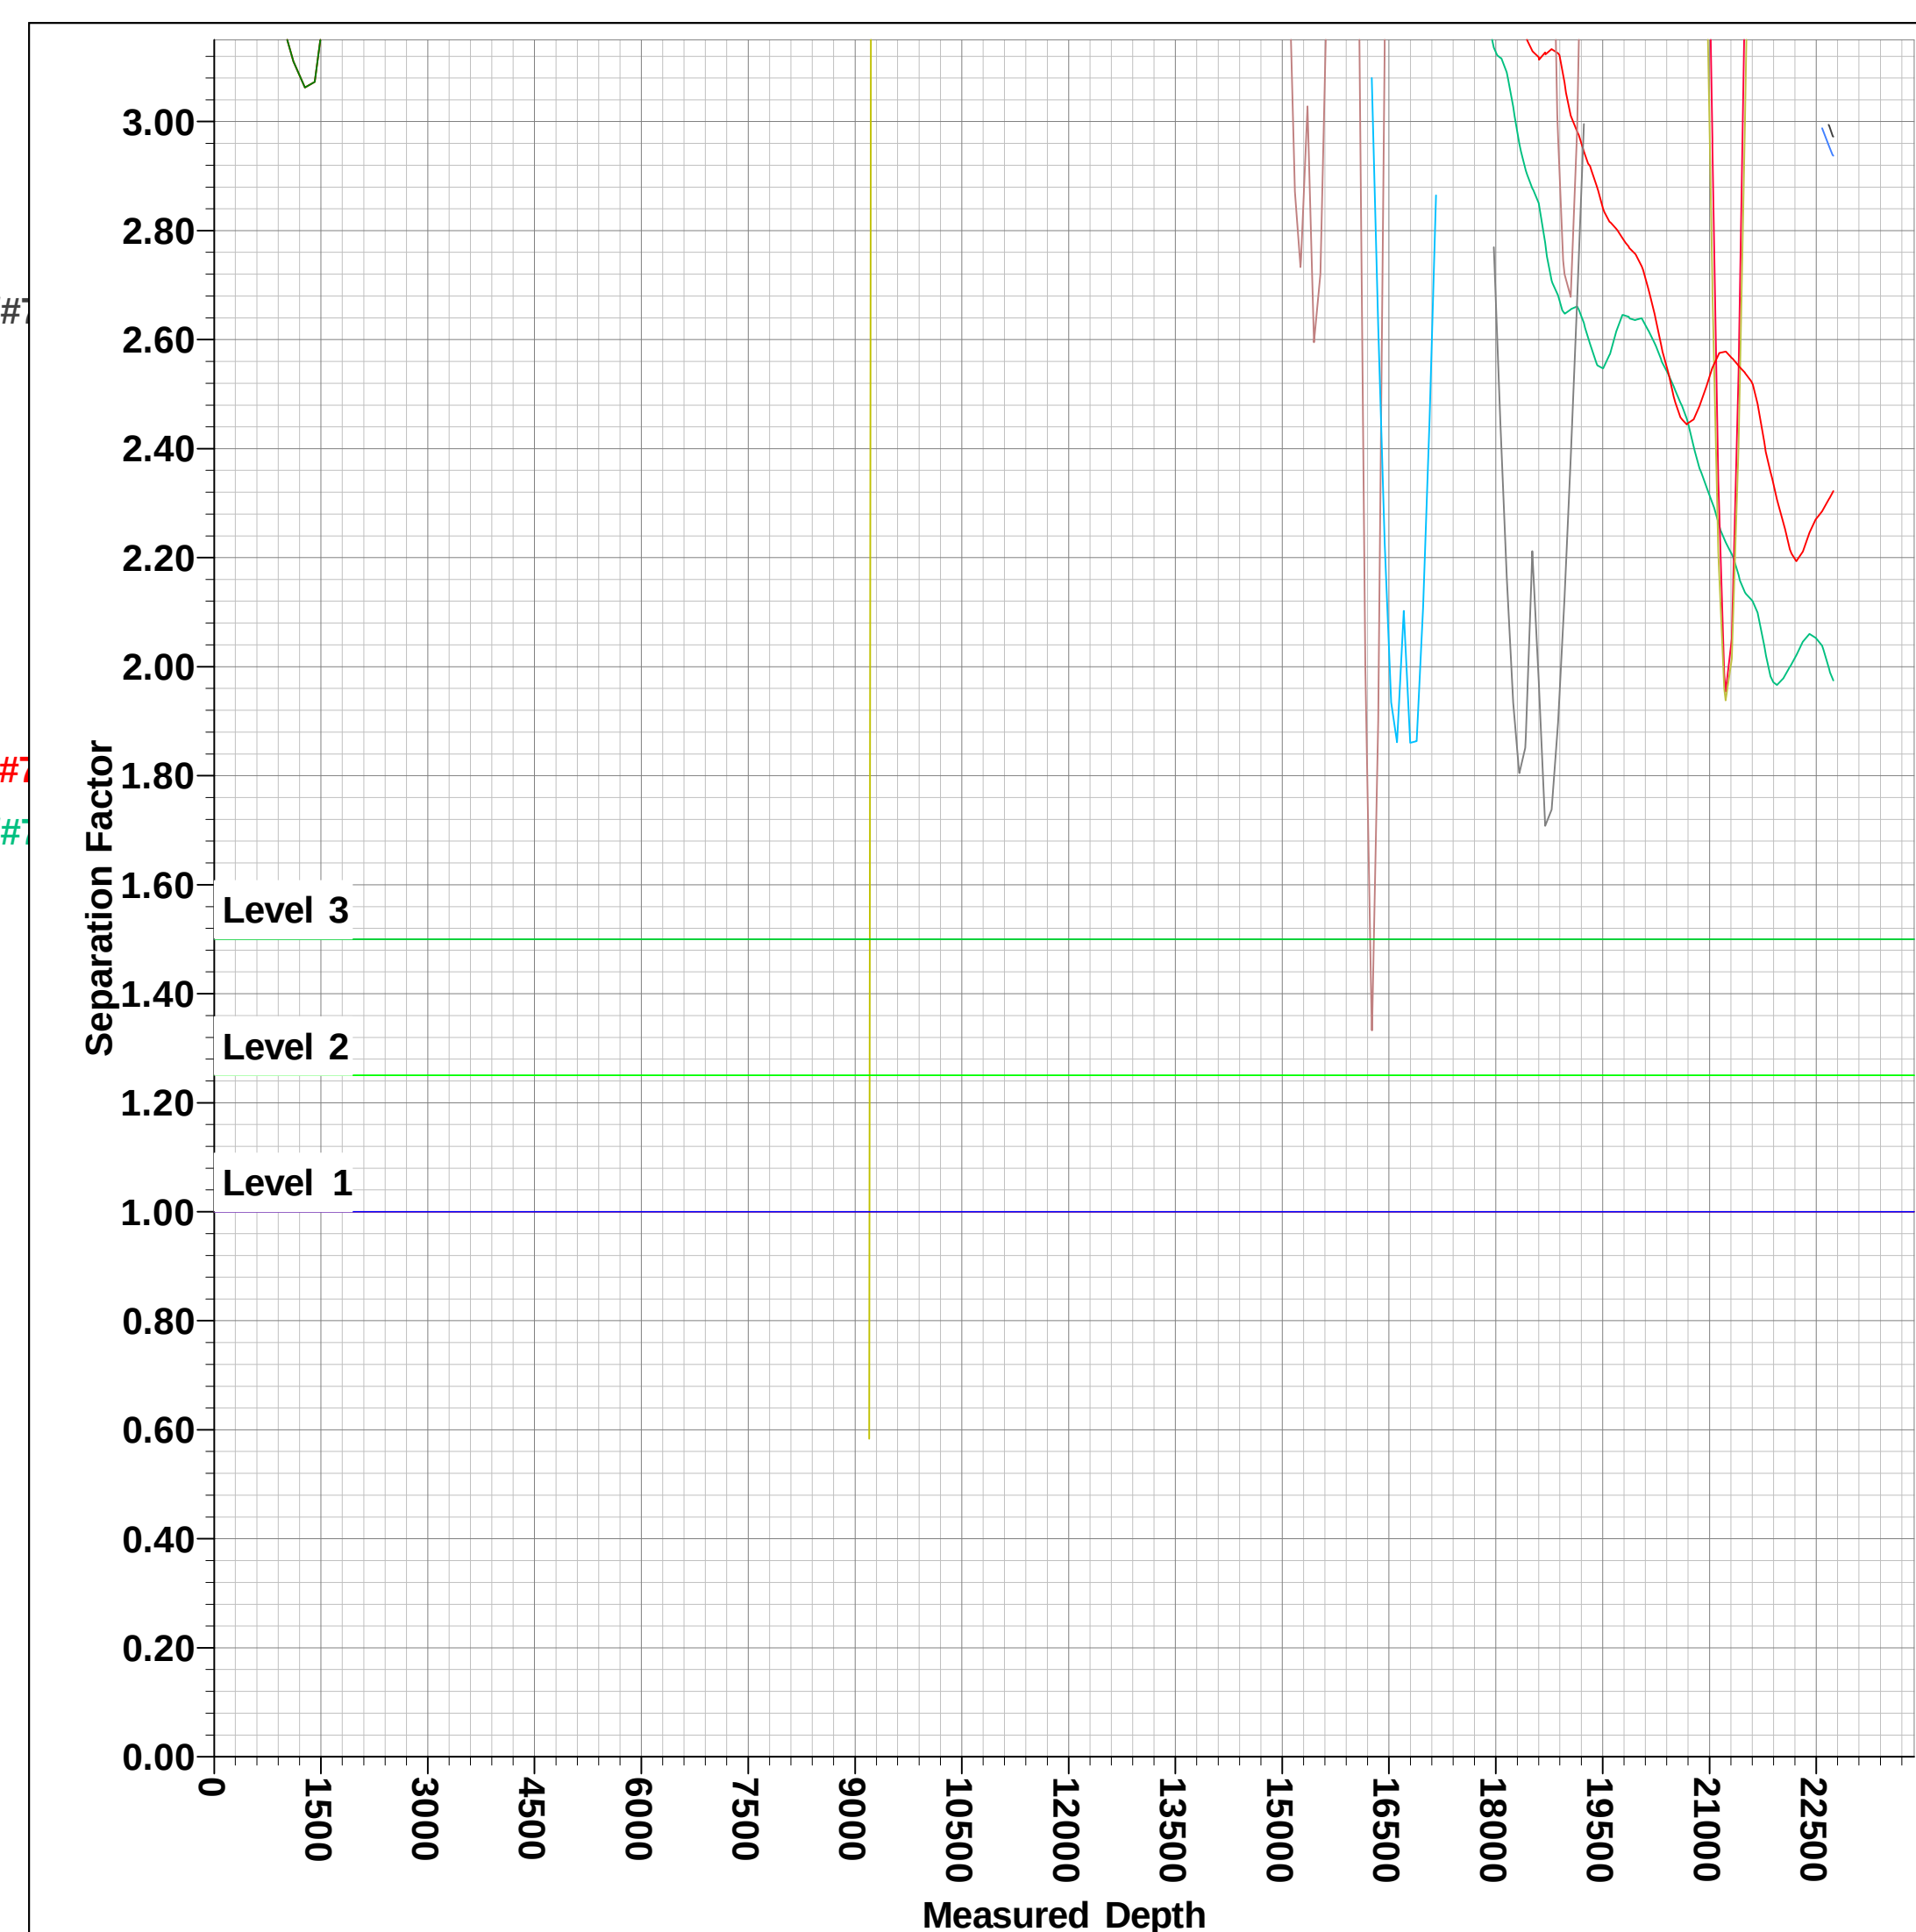

Lea County, NM (NAD 83 NME)
Lacey Swiss 1 Fed Com
#704H
Nabors M1206
ST
OT



Midland

Lea County, NM (NAD 83 NME)

Lacey Swiss 1 Fed Com

#704H

ST

Design: ST

Final PVA

27 October, 2022



Final PVA

Company:	Midland	Local Co-ordinate Reference:	Well #704H
Project:	Lea County, NM (NAD 83 NME)	TVD Reference:	KB = 32' @ 3498.0usft (Nabors M1206)
Site:	Lacey Swiss 1 Fed Com	MD Reference:	KB = 32' @ 3498.0usft (Nabors M1206)
Well:	#704H	North Reference:	Grid
Wellbore:	ST	Survey Calculation Method:	Minimum Curvature
Design:	ST	Database:	PEDM

Project	Lea County, NM (NAD 83 NME)		
Map System:	US State Plane 1983	System Datum:	Mean Sea Level
Geo Datum:	North American Datum 1983		
Map Zone:	New Mexico Eastern Zone		

Site	Lacey Swiss 1 Fed Com		
Site Position:		Northing:	425,128.00 usft
From:	Map	Easting:	793,117.00 usft
Position Uncertainty:	0.0 usft	Slot Radius:	13-3/16 "
		Latitude:	32° 9' 58.098 N
		Longitude:	103° 31' 10.745 W
		Grid Convergence:	0.43 °

Well		#704H				
Well Position	+N/-S	0.0 usft	Northing:	424,628.00 usft	Latitude:	32° 9' 53.308 N
	+E/-W	0.0 usft	Easting:	791,001.00 usft	Longitude:	103° 31' 35.405 W
Position Uncertainty	0.0 usft		Wellhead Elevation:	usft	Ground Level:	3,466.0 usft

Wellbore	ST				
Magnetics	Model Name	Sample Date	Declination (°)	Dip Angle (°)	Field Strength (nT)
	IGRF2020	8/22/2022	6.38	59.81	47,339.48437072

Design	ST				
Audit Notes:					
Version:	1.0	Phase:	ACTUAL	Tie On Depth:	9,194.0
Vertical Section:	Depth From (TVD) (usft)	+N/-S (usft)	+E/-W (usft)	Direction (°)	
	0.0	0.0	0.0	172.92	



Final PVA

Company:	Midland	Local Co-ordinate Reference:	Well #704H
Project:	Lea County, NM (NAD 83 NME)	TVD Reference:	KB = 32' @ 3498.0usft (Nabors M1206)
Site:	Lacey Swiss 1 Fed Com	MD Reference:	KB = 32' @ 3498.0usft (Nabors M1206)
Well:	#704H	North Reference:	Grid
Wellbore:	ST	Survey Calculation Method:	Minimum Curvature
Design:	ST	Database:	PEDM

Survey Program		Date	10/27/2022		
From (usft)	To (usft)	Survey (Wellbore)	Tool Name	Description	
199.0	9,194.0	DriTech MWD #1 (OH)	EOG MWD+IFR1	MWD + IFR1	
9,240.0	22,737.0	DriTech MWD #2 (ST)	EOG MWD+IFR1	MWD + IFR1	

Survey											
MD (usft)	Inc (°)	Azi (azimuth) (°)	TVD (usft)	N/S (usft)	E/W (usft)	DLeg (°/100usft)	Build (°/100usft)	Turn (°/100usft)	High to Plan (usft)	Right to Plan (usft)	
0.0	0.00	0.00	0.0	0.0	0.0	0.00	0.00	0.00	0.0	0.0	
199.0	0.18	53.95	199.0	0.2	0.3	0.09	0.09	0.00	0.0	0.0	
384.0	0.44	41.91	384.0	0.9	1.0	0.14	0.14	-6.51	0.0	0.0	
569.0	0.18	169.18	569.0	1.1	1.5	0.31	-0.14	68.79	0.0	0.0	
661.0	0.97	84.57	661.0	1.1	2.3	1.05	0.86	-91.97	0.0	0.0	
753.0	1.49	86.38	753.0	1.2	4.3	0.57	0.57	1.97	0.0	0.0	
844.0	1.32	92.10	843.9	1.2	6.5	0.24	-0.19	6.29	0.0	0.0	
1,025.0	1.58	86.65	1,024.9	1.3	11.1	0.16	0.14	-3.01	0.0	0.0	
1,115.0	1.41	95.61	1,114.9	1.3	13.4	0.32	-0.19	9.96	0.0	0.0	
1,275.0	0.88	81.02	1,274.8	1.3	16.6	0.38	-0.33	-9.12	0.0	0.0	
1,412.0	1.14	94.98	1,411.8	1.3	19.0	0.26	0.19	10.19	0.0	0.0	
1,502.0	4.31	71.88	1,501.7	2.3	23.1	3.66	3.52	-25.67	0.0	0.0	
1,593.0	7.65	60.02	1,592.2	6.4	31.6	3.89	3.67	-13.03	0.0	0.0	
1,683.0	10.29	60.46	1,681.1	13.3	43.8	2.93	2.93	0.49	0.0	0.0	
1,774.0	10.90	60.11	1,770.5	21.6	58.3	0.67	0.67	-0.38	0.0	0.0	
1,864.0	12.84	61.42	1,858.6	30.7	74.5	2.18	2.16	1.46	0.0	0.0	
1,955.0	13.54	62.22	1,947.2	40.5	92.8	0.79	0.77	0.88	0.0	0.0	
2,045.0	13.37	62.13	2,034.7	50.2	111.3	0.19	-0.19	-0.10	0.0	0.0	
2,136.0	12.93	62.13	2,123.3	59.9	129.6	0.48	-0.48	0.00	0.0	0.0	
2,226.0	12.93	60.81	2,211.1	69.5	147.3	0.33	0.00	-1.47	0.0	0.0	
2,316.0	12.84	61.86	2,298.8	79.2	164.9	0.28	-0.10	1.17	0.0	0.0	



Final PVA

Company:	Midland	Local Co-ordinate Reference:	Well #704H
Project:	Lea County, NM (NAD 83 NME)	TVD Reference:	KB = 32' @ 3498.0usft (Nabors M1206)
Site:	Lacey Swiss 1 Fed Com	MD Reference:	KB = 32' @ 3498.0usft (Nabors M1206)
Well:	#704H	North Reference:	Grid
Wellbore:	ST	Survey Calculation Method:	Minimum Curvature
Design:	ST	Database:	PEDM

Survey										
MD (usft)	Inc (°)	Azi (azimuth) (°)	TVD (usft)	N/S (usft)	E/W (usft)	DLeg (°/100usft)	Build (°/100usft)	Turn (°/100usft)	High to Plan (usft)	Right to Plan (usft)
2,407.0	13.01	59.58	2,387.5	89.1	182.6	0.59	0.19	-2.51	0.0	0.0
2,497.0	12.75	60.46	2,475.2	99.1	200.0	0.36	-0.29	0.98	0.0	0.0
2,588.0	12.75	58.70	2,564.0	109.3	217.3	0.43	0.00	-1.93	0.0	0.0
2,679.0	12.66	59.67	2,652.7	119.6	234.5	0.25	-0.10	1.07	0.0	0.0
2,769.0	12.93	59.14	2,740.5	129.7	251.7	0.33	0.30	-0.59	0.0	0.0
2,860.0	13.10	58.26	2,829.2	140.4	269.2	0.29	0.19	-0.97	0.0	0.0
2,950.0	13.28	58.44	2,916.8	151.1	286.7	0.21	0.20	0.20	0.0	0.0
3,041.0	13.72	59.14	3,005.3	162.1	304.8	0.52	0.48	0.77	0.0	0.0
3,131.0	14.16	57.73	3,092.6	173.5	323.3	0.62	0.49	-1.57	0.0	0.0
3,222.0	14.16	58.61	3,180.9	185.2	342.2	0.24	0.00	0.97	0.0	0.0
3,312.0	14.86	58.96	3,268.0	196.9	361.5	0.78	0.78	0.39	0.0	0.0
3,403.0	15.48	58.44	3,355.8	209.3	381.8	0.70	0.68	-0.57	0.0	0.0
3,494.0	16.80	57.73	3,443.2	222.7	403.3	1.47	1.45	-0.78	0.0	0.0
3,584.0	14.68	54.30	3,529.9	236.3	423.6	2.57	-2.36	-3.81	0.0	0.0
3,675.0	13.28	58.52	3,618.2	248.5	441.9	1.90	-1.54	4.64	0.0	0.0
3,765.0	12.49	58.79	3,705.9	258.9	459.0	0.88	-0.88	0.30	0.0	0.0
3,856.0	11.52	63.80	3,794.9	268.0	475.6	1.56	-1.07	5.51	0.0	0.0
3,946.0	13.19	59.49	3,882.8	277.2	492.5	2.12	1.86	-4.79	0.0	0.0
4,037.0	13.81	57.03	3,971.3	288.4	510.5	0.93	0.68	-2.70	0.0	0.0
4,127.0	12.84	57.21	4,058.9	299.6	528.0	1.08	-1.08	0.20	0.0	0.0
4,218.0	11.17	55.45	4,147.9	310.1	543.7	1.88	-1.84	-1.93	0.0	0.0
4,308.0	11.70	55.71	4,236.1	320.2	558.4	0.59	0.59	0.29	0.0	0.0
4,399.0	13.72	60.02	4,324.9	330.8	575.4	2.45	2.22	4.74	0.0	0.0
4,489.0	13.98	63.97	4,412.3	340.9	594.4	1.09	0.29	4.39	0.0	0.0
4,580.0	13.37	71.44	4,500.7	349.1	614.3	2.05	-0.67	8.21	0.0	0.0
4,670.0	12.49	65.99	4,588.4	356.3	633.0	1.67	-0.98	-6.06	0.0	0.0
4,761.0	11.61	64.24	4,677.4	364.3	650.3	1.05	-0.97	-1.92	0.0	0.0



Final PVA

Company: Midland
Project: Lea County, NM (NAD 83 NME)
Site: Lacey Swiss 1 Fed Com
Well: #704H
Wellbore: ST
Design: ST

Local Co-ordinate Reference: Well #704H
TVD Reference: KB = 32' @ 3498.0usft (Nabors M1206)
MD Reference: KB = 32' @ 3498.0usft (Nabors M1206)
North Reference: Grid
Survey Calculation Method: Minimum Curvature
Database: PEDM

Survey										
MD (usft)	Inc (°)	Azi (azimuth) (°)	TVD (usft)	N/S (usft)	E/W (usft)	DLeg (°/100usft)	Build (°/100usft)	Turn (°/100usft)	High to Plan (usft)	Right to Plan (usft)
4,851.0	13.01	62.92	4,765.3	372.9	667.4	1.59	1.56	-1.47	0.0	0.0
4,942.0	13.72	62.65	4,853.9	382.5	686.1	0.78	0.78	-0.30	0.0	0.0
5,032.0	13.81	57.64	4,941.3	393.1	704.7	1.33	0.10	-5.57	0.0	0.0
5,123.0	11.52	56.94	5,030.1	403.9	721.5	2.52	-2.52	-0.77	0.0	0.0
5,214.0	12.05	52.90	5,119.1	414.6	736.7	1.08	0.58	-4.44	0.0	0.0
5,304.0	11.17	49.21	5,207.3	426.0	750.8	1.28	-0.98	-4.10	0.0	0.0
5,394.0	13.10	50.70	5,295.3	438.1	765.3	2.17	2.14	1.66	0.0	0.0
5,485.0	15.21	51.49	5,383.5	452.1	782.6	2.33	2.32	0.87	0.0	0.0
5,575.0	16.00	48.59	5,470.2	467.6	801.1	1.23	0.88	-3.22	0.0	0.0
5,666.0	15.12	52.63	5,557.9	483.1	820.0	1.53	-0.97	4.44	0.0	0.0
5,756.0	15.48	58.96	5,644.7	496.5	839.6	1.90	0.40	7.03	0.0	0.0
5,847.0	14.77	60.28	5,732.5	508.5	860.1	0.87	-0.78	1.45	0.0	0.0
5,937.0	14.42	59.49	5,819.6	519.9	879.7	0.45	-0.39	-0.88	0.0	0.0
6,028.0	14.42	57.38	5,907.8	531.7	899.0	0.58	0.00	-2.32	0.0	0.0
6,118.0	14.68	58.52	5,994.9	543.7	918.2	0.43	0.29	1.27	0.0	0.0
6,209.0	13.01	58.26	6,083.2	555.1	936.7	1.84	-1.84	-0.29	0.0	0.0
6,299.0	12.05	57.38	6,171.1	565.5	953.2	1.09	-1.07	-0.98	0.0	0.0
6,389.0	10.82	58.08	6,259.3	575.0	968.3	1.38	-1.37	0.78	0.0	0.0
6,480.0	11.78	58.08	6,348.5	584.5	983.5	1.05	1.05	0.00	0.0	0.0
6,570.0	12.13	57.29	6,436.6	594.4	999.2	0.43	0.39	-0.88	0.0	0.0
6,661.0	11.52	55.45	6,525.7	604.8	1,014.7	0.79	-0.67	-2.02	0.0	0.0
6,751.0	11.52	56.41	6,613.8	614.8	1,029.6	0.21	0.00	1.07	0.0	0.0
6,842.0	11.78	54.57	6,703.0	625.2	1,044.8	0.50	0.29	-2.02	0.0	0.0
6,932.0	12.13	53.51	6,791.0	636.2	1,059.9	0.46	0.39	-1.18	0.0	0.0
7,023.0	12.22	52.63	6,880.0	647.7	1,075.2	0.23	0.10	-0.97	0.0	0.0
7,113.0	11.61	53.87	6,968.0	658.8	1,090.1	0.74	-0.68	1.38	0.0	0.0
7,204.0	10.73	59.31	7,057.3	668.6	1,104.8	1.51	-0.97	5.98	0.0	0.0



Final PVA

Company:	Midland	Local Co-ordinate Reference:	Well #704H
Project:	Lea County, NM (NAD 83 NME)	TVD Reference:	KB = 32' @ 3498.0usft (Nabors M1206)
Site:	Lacey Swiss 1 Fed Com	MD Reference:	KB = 32' @ 3498.0usft (Nabors M1206)
Well:	#704H	North Reference:	Grid
Wellbore:	ST	Survey Calculation Method:	Minimum Curvature
Design:	ST	Database:	PEDM

Survey										
MD (usft)	Inc (°)	Azi (azimuth) (°)	TVD (usft)	N/S (usft)	E/W (usft)	DLeg (°/100usft)	Build (°/100usft)	Turn (°/100usft)	High to Plan (usft)	Right to Plan (usft)
7,294.0	8.44	57.91	7,146.0	676.4	1,117.6	2.56	-2.54	-1.56	0.0	0.0
7,385.0	6.51	65.47	7,236.3	682.0	1,127.9	2.38	-2.12	8.31	0.0	0.0
7,475.0	5.19	68.72	7,325.8	685.6	1,136.4	1.51	-1.47	3.61	0.0	0.0
7,566.0	2.29	60.35	7,416.6	688.0	1,141.8	3.23	-3.19	-9.20	0.0	0.0
7,656.0	0.44	74.94	7,506.6	689.0	1,143.7	2.07	-2.06	16.21	0.0	0.0
7,747.0	0.00	192.45	7,597.6	689.1	1,144.0	0.48	-0.48	0.00	0.0	0.0
7,837.0	0.35	107.82	7,687.6	689.0	1,144.3	0.39	0.39	0.00	0.0	0.0
7,927.0	0.44	85.93	7,777.6	689.0	1,144.9	0.19	0.10	-24.32	0.0	0.0
8,018.0	0.18	193.77	7,868.6	688.8	1,145.2	0.58	-0.29	118.51	0.0	0.0
8,108.0	0.26	209.86	7,958.6	688.5	1,145.0	0.11	0.09	17.88	0.0	0.0
8,199.0	0.53	179.45	8,049.6	687.9	1,144.9	0.37	0.30	-33.42	0.0	0.0
8,289.0	0.35	221.46	8,139.6	687.3	1,144.8	0.40	-0.20	46.68	0.0	0.0
8,380.0	0.18	250.46	8,230.6	687.1	1,144.5	0.23	-0.19	31.87	0.0	0.0
8,470.0	0.44	131.11	8,320.6	686.8	1,144.6	0.61	0.29	-132.61	0.0	0.0
8,561.0	0.44	111.24	8,411.5	686.4	1,145.2	0.17	0.00	-21.84	0.0	0.0
8,651.0	0.62	145.35	8,501.5	685.9	1,145.8	0.39	0.20	37.90	0.0	0.0
8,742.0	0.70	158.35	8,592.5	685.0	1,146.3	0.19	0.09	14.29	0.0	0.0
8,832.0	0.62	147.19	8,682.5	684.1	1,146.7	0.17	-0.09	-12.40	0.0	0.0
8,923.0	0.88	119.59	8,773.5	683.3	1,147.6	0.48	0.29	-30.33	0.0	0.0
9,013.0	0.97	139.98	8,863.5	682.4	1,148.7	0.38	0.10	22.66	0.0	0.0
9,104.0	0.88	145.87	8,954.5	681.2	1,149.6	0.14	-0.10	6.47	0.0	0.0
9,194.0	1.06	160.55	9,044.5	679.8	1,150.2	0.34	0.20	16.31	0.0	0.0
9,240.0	2.81	293.18	9,090.5	679.9	1,149.3	7.85	3.80	288.33	-1.4	-0.3
9,282.0	7.12	299.33	9,132.3	681.6	1,146.1	10.33	10.26	14.64	-5.6	-0.6
9,326.0	8.27	298.01	9,175.9	684.4	1,141.0	2.64	2.61	-3.00	-11.9	-1.4
9,373.0	5.63	292.21	9,222.6	686.8	1,135.8	5.81	-5.62	-12.34	-17.7	-3.6
9,417.0	5.28	287.38	9,266.4	688.3	1,131.9	1.31	-0.80	-10.98	-21.7	-5.8



Final PVA

Company:	Midland	Local Co-ordinate Reference:	Well #704H
Project:	Lea County, NM (NAD 83 NME)	TVD Reference:	KB = 32' @ 3498.0usft (Nabors M1206)
Site:	Lacey Swiss 1 Fed Com	MD Reference:	KB = 32' @ 3498.0usft (Nabors M1206)
Well:	#704H	North Reference:	Grid
Wellbore:	ST	Survey Calculation Method:	Minimum Curvature
Design:	ST	Database:	PEDM

Survey											
MD (usft)	Inc (°)	Azi (azimuth) (°)	TVD (usft)	N/S (usft)	E/W (usft)	DLeg (°/100usft)	Build (°/100usft)	Turn (°/100usft)	High to Plan (usft)	Right to Plan (usft)	
9,463.0	4.13	293.00	9,312.2	689.5	1,128.4	2.69	-2.50	12.22	-26.2	-4.0	
9,508.0	3.69	290.19	9,357.1	690.7	1,125.5	1.07	-0.98	-6.24	-29.3	-5.9	
9,554.0	2.37	305.48	9,403.0	691.7	1,123.3	3.34	-2.87	33.24	-32.6	2.0	
9,644.0	1.93	286.50	9,493.0	693.3	1,120.4	0.92	-0.49	-21.09	-35.1	-10.4	
9,735.0	0.97	277.97	9,583.9	693.8	1,118.1	1.08	-1.05	-9.37	-35.0	-16.7	
9,825.0	1.14	274.28	9,673.9	694.0	1,116.5	0.20	0.19	-4.10	-34.3	-19.7	
9,916.0	1.41	250.20	9,764.9	693.7	1,114.5	0.65	0.30	-26.46	-23.2	-32.7	
10,006.0	2.11	219.79	9,854.9	692.0	1,112.4	1.27	0.78	-33.79	-3.2	-39.9	
10,096.0	1.67	230.69	9,944.8	689.9	1,110.4	0.63	-0.49	12.11	-10.6	-38.6	
10,187.0	1.14	248.70	10,035.8	688.7	1,108.5	0.75	-0.58	19.79	-22.7	-29.9	
10,277.0	1.58	286.41	10,125.8	688.8	1,106.5	1.08	0.49	41.90	-34.4	-6.4	
10,368.0	1.76	268.83	10,216.7	689.1	1,103.9	0.59	0.20	-19.32	-30.8	-12.9	
10,458.0	1.76	259.51	10,306.7	688.8	1,101.1	0.32	0.00	-10.36	-29.0	-13.7	
10,549.0	1.14	250.81	10,397.7	688.3	1,098.9	0.72	-0.68	-9.56	-27.7	-14.3	
10,639.0	1.49	124.69	10,487.6	687.3	1,099.0	2.61	0.39	-140.13	26.0	-15.2	
10,745.0	2.37	122.05	10,593.6	685.3	1,102.0	0.83	0.83	-2.49	23.1	-14.0	
10,835.0	2.81	117.92	10,683.5	683.3	1,105.5	0.53	0.49	-4.59	19.9	-12.5	
10,926.0	2.29	104.39	10,774.4	681.8	1,109.3	0.87	-0.57	-14.87	18.3	-8.0	
11,016.0	2.37	96.04	10,864.3	681.2	1,112.9	0.39	0.09	-9.28	15.7	-5.5	
11,107.0	2.11	88.30	10,955.3	681.0	1,116.4	0.44	-0.29	-8.51	12.7	-3.6	
11,197.0	2.20	75.74	11,045.2	681.5	1,119.7	0.53	0.10	-13.96	9.8	-1.1	
11,288.0	1.06	78.72	11,136.2	682.1	1,122.3	1.26	-1.25	3.27	7.2	-1.5	
11,378.0	0.79	351.27	11,226.1	682.9	1,123.0	1.44	-0.30	-97.17	1.2	6.3	
11,469.0	1.23	277.71	11,317.1	683.6	1,121.9	1.38	0.48	-80.84	-6.8	2.3	
11,559.0	2.11	264.70	11,407.1	683.6	1,119.3	1.06	0.98	-14.46	-9.8	0.5	
11,650.0	2.29	254.42	11,498.0	683.0	1,115.9	0.48	0.20	-11.30	-13.2	-1.6	
11,740.0	4.04	262.68	11,587.9	682.1	1,111.0	2.00	1.94	9.18	-18.2	0.6	



Final PVA

Company:	Midland	Local Co-ordinate Reference:	Well #704H
Project:	Lea County, NM (NAD 83 NME)	TVD Reference:	KB = 32' @ 3498.0usft (Nabors M1206)
Site:	Lacey Swiss 1 Fed Com	MD Reference:	KB = 32' @ 3498.0usft (Nabors M1206)
Well:	#704H	North Reference:	Grid
Wellbore:	ST	Survey Calculation Method:	Minimum Curvature
Design:	ST	Database:	PEDM

Survey										
MD (usft)	Inc (°)	Azi (azimuth) (°)	TVD (usft)	N/S (usft)	E/W (usft)	DLeg (°/100usft)	Build (°/100usft)	Turn (°/100usft)	High to Plan (usft)	Right to Plan (usft)
11,831.0	4.40	263.56	11,678.6	681.3	1,104.4	0.40	0.40	0.97	-24.9	0.9
11,867.0	4.57	261.62	11,714.5	680.9	1,101.6	0.63	0.47	-5.39	-27.7	0.0
11,921.0	4.40	264.44	11,768.4	680.4	1,097.4	0.52	-0.31	5.22	-31.9	1.5
12,011.0	1.93	344.24	11,858.3	681.5	1,093.5	4.98	-2.74	88.67	-6.3	35.1
12,091.0	1.24	150.47	11,938.2	682.1	1,093.6	3.94	-0.86	207.79	14.9	-32.3
KOP (MD=12091.0')										
12,102.0	1.67	152.64	11,949.2	681.8	1,093.7	3.94	3.90	19.71	13.4	-32.8
12,192.0	24.97	176.02	12,036.2	661.4	1,095.7	26.05	25.89	25.98	-19.5	-35.5
12,244.0	38.33	176.08	12,080.4	634.3	1,097.5	25.70	25.70	0.12	-40.8	-37.2
HL Crossing, MD:12244.0', TVD:12080.4', N/S:634.3', E/W:1097.5', INC:38.33										
12,282.0	48.10	176.11	12,108.1	608.3	1,099.3	25.70	25.70	0.07	-60.3	-39.2
12,373.0	46.78	174.52	12,169.6	541.5	1,104.8	1.94	-1.45	-1.75	-105.1	-35.9
12,463.0	48.80	174.70	12,230.1	475.2	1,111.0	2.25	2.24	0.20	-130.8	-28.5
12,554.0	51.00	174.88	12,288.7	405.9	1,117.4	2.42	2.42	0.20	-136.6	-20.2
12,644.0	58.04	179.80	12,340.9	332.7	1,120.6	9.00	7.82	5.47	-126.0	-10.8
12,734.0	56.72	179.45	12,389.4	256.9	1,121.1	1.50	-1.47	-0.39	-97.2	-12.0
12,825.0	60.41	181.12	12,436.9	179.3	1,120.7	4.35	4.05	1.84	-52.6	-13.4
12,915.0	69.82	178.92	12,474.7	97.8	1,120.7	10.69	10.46	-2.44	-14.6	-12.8
13,005.0	82.57	175.49	12,496.1	10.7	1,125.1	14.64	14.17	-3.81	6.7	-8.5
13,096.0	93.65	181.03	12,499.1	-80.1	1,127.8	13.61	12.18	6.09	9.2	-6.5
13,186.0	92.86	179.89	12,494.0	-169.9	1,127.1	1.54	-0.88	-1.27	3.6	-7.8
13,276.0	90.66	179.97	12,491.3	-259.9	1,127.2	2.45	-2.44	0.09	0.4	-8.4
13,367.0	88.37	179.97	12,492.0	-350.9	1,127.2	2.52	-2.52	0.00	0.7	-9.0
13,457.0	87.23	179.18	12,495.5	-440.8	1,127.9	1.54	-1.27	-0.88	3.6	-9.0
13,547.0	87.41	179.53	12,499.7	-530.7	1,128.9	0.44	0.20	0.39	7.3	-8.7
13,638.0	93.39	180.06	12,499.1	-621.6	1,129.2	6.60	6.57	0.58	6.2	-9.1
13,729.0	89.25	180.41	12,497.0	-712.6	1,128.9	4.57	-4.55	0.38	3.6	-10.1



Final PVA

Company: Midland
Project: Lea County, NM (NAD 83 NME)
Site: Lacey Swiss 1 Fed Com
Well: #704H
Wellbore: ST
Design: ST

Local Co-ordinate Reference: Well #704H
TVD Reference: KB = 32' @ 3498.0usft (Nabors M1206)
MD Reference: KB = 32' @ 3498.0usft (Nabors M1206)
North Reference: Grid
Survey Calculation Method: Minimum Curvature
Database: PEDM

Survey										
MD (usft)	Inc (°)	Azi (azimuth) (°)	TVD (usft)	N/S (usft)	E/W (usft)	DLeg (°/100usft)	Build (°/100usft)	Turn (°/100usft)	High to Plan (usft)	Right to Plan (usft)
13,819.0	91.19	183.66	12,496.6	-802.5	1,125.7	4.21	2.16	3.61	2.8	-14.0
13,909.0	93.91	186.13	12,492.6	-892.1	1,118.0	4.08	3.02	2.74	-1.5	-22.3
14,000.0	89.60	183.14	12,489.8	-982.7	1,110.7	5.76	-4.74	-3.29	-5.0	-30.3
14,090.0	85.56	178.22	12,493.6	-1,072.6	1,109.6	7.07	-4.49	-5.47	-1.6	-32.1
14,181.0	89.52	177.51	12,497.5	-1,163.4	1,113.0	4.42	4.35	-0.78	1.8	-29.4
14,271.0	92.07	178.22	12,496.3	-1,253.3	1,116.3	2.94	2.83	0.79	0.0	-26.7
14,362.0	88.29	177.78	12,496.0	-1,344.3	1,119.5	4.18	-4.15	-0.48	-0.8	-24.2
14,452.0	86.61	179.53	12,500.0	-1,434.2	1,121.6	2.69	-1.87	1.94	2.7	-22.8
14,542.0	86.70	179.09	12,505.3	-1,524.0	1,122.7	0.50	0.10	-0.49	7.5	-22.3
14,633.0	87.76	178.39	12,509.7	-1,614.9	1,124.7	1.40	1.16	-0.77	11.4	-21.0
14,724.0	89.16	179.01	12,512.1	-1,705.8	1,126.8	1.68	1.54	0.68	13.4	-19.6
14,814.0	92.51	180.24	12,510.8	-1,795.8	1,127.3	3.97	3.72	1.37	11.5	-19.7
14,905.0	86.61	177.25	12,511.5	-1,886.7	1,129.3	7.27	-6.48	-3.29	11.4	-18.4
14,995.0	87.76	175.93	12,515.9	-1,976.4	1,134.7	1.94	1.28	-1.47	13.4	-13.7
15,085.0	88.55	178.83	12,518.8	-2,066.3	1,138.8	3.34	0.88	3.22	13.7	-10.3
15,175.0	91.19	181.03	12,519.0	-2,156.3	1,138.9	3.82	2.93	2.44	11.4	-10.8
15,265.0	89.52	182.79	12,518.5	-2,246.2	1,135.9	2.70	-1.86	1.96	8.4	-14.5
15,356.0	88.81	181.91	12,519.8	-2,337.1	1,132.2	1.24	-0.78	-0.97	7.1	-18.9
15,446.0	91.80	182.70	12,519.3	-2,427.0	1,128.6	3.44	3.32	0.88	4.2	-23.2
15,536.0	91.71	183.40	12,516.6	-2,516.9	1,123.8	0.78	-0.10	0.78	-1.1	-28.7
15,626.0	88.72	178.57	12,516.2	-2,606.8	1,122.2	6.31	-3.32	-5.37	-3.9	-30.8
15,716.0	87.23	176.99	12,519.4	-2,696.7	1,125.7	2.41	-1.66	-1.76	-2.6	-25.8
15,807.0	86.79	177.07	12,524.1	-2,787.4	1,130.4	0.49	-0.48	0.09	1.0	-16.8
15,897.0	87.49	178.92	12,528.6	-2,877.3	1,133.6	2.20	0.78	2.06	4.7	-7.9
15,987.0	86.17	182.61	12,533.6	-2,967.1	1,132.4	4.35	-1.47	4.10	8.9	-3.3
16,077.0	87.32	182.17	12,538.7	-3,056.9	1,128.6	1.37	1.28	-0.49	13.3	-1.3
16,167.0	87.41	181.91	12,542.9	-3,146.7	1,125.4	0.31	0.10	-0.29	16.7	1.3



Final PVA

Company: Midland
Project: Lea County, NM (NAD 83 NME)
Site: Lacey Swiss 1 Fed Com
Well: #704H
Wellbore: ST
Design: ST

Local Co-ordinate Reference: Well #704H
TVD Reference: KB = 32' @ 3498.0usft (Nabors M1206)
MD Reference: KB = 32' @ 3498.0usft (Nabors M1206)
North Reference: Grid
Survey Calculation Method: Minimum Curvature
Database: PEDM

Survey											
MD (usft)	Inc (°)	Azi (azimuth) (°)	TVD (usft)	N/S (usft)	E/W (usft)	DLeg (°/100usft)	Build (°/100usft)	Turn (°/100usft)	High to Plan (usft)	Right to Plan (usft)	
16,257.0	90.75	182.26	12,544.3	-3,236.6	1,122.1	3.73	3.71	0.39	17.4	3.9	
16,348.0	89.43	180.32	12,544.2	-3,327.6	1,120.1	2.58	-1.45	-2.13	16.5	5.9	
16,438.0	89.34	180.50	12,545.1	-3,417.6	1,119.4	0.22	-0.10	0.20	16.6	4.9	
16,528.0	89.08	179.97	12,546.4	-3,507.6	1,119.1	0.66	-0.29	-0.59	16.9	1.9	
16,618.0	89.34	179.36	12,547.6	-3,597.6	1,119.6	0.74	0.29	-0.68	17.1	-0.3	
16,708.0	87.49	178.92	12,550.1	-3,687.5	1,121.0	2.11	-2.06	-0.49	18.7	-1.7	
16,798.0	88.99	180.15	12,552.9	-3,777.5	1,121.7	2.15	1.67	1.37	20.5	-3.7	
16,888.0	88.11	179.71	12,555.1	-3,867.5	1,121.8	1.09	-0.98	-0.49	21.8	-6.3	
16,979.0	91.89	179.97	12,555.1	-3,958.4	1,122.0	4.16	4.15	0.29	20.8	-8.8	
17,069.0	91.45	179.89	12,552.5	-4,048.4	1,122.2	0.50	-0.49	-0.09	17.2	-11.4	
17,159.0	89.25	179.09	12,552.0	-4,138.4	1,123.0	2.60	-2.44	-0.89	15.7	-13.3	
17,249.0	93.12	179.09	12,550.1	-4,228.3	1,124.4	4.30	4.30	0.00	12.9	-14.6	
17,339.0	88.72	177.86	12,548.7	-4,318.3	1,126.8	5.08	-4.89	-1.37	10.5	-14.9	
17,430.0	88.55	177.43	12,550.8	-4,409.2	1,130.5	0.51	-0.19	-0.47	11.7	-13.9	
17,520.0	88.02	177.16	12,553.5	-4,499.0	1,134.8	0.66	-0.59	-0.30	13.4	-12.4	
17,610.0	88.37	176.90	12,556.4	-4,588.9	1,139.4	0.48	0.39	-0.29	15.3	-10.4	
17,700.0	88.37	176.63	12,558.9	-4,678.7	1,144.5	0.30	0.00	-0.30	16.9	-8.1	
17,790.0	87.76	176.55	12,562.0	-4,768.5	1,149.9	0.68	-0.68	-0.09	19.0	-5.4	
17,880.0	88.02	176.37	12,565.3	-4,858.2	1,155.4	0.35	0.29	-0.20	21.3	-2.6	
17,971.0	89.78	178.66	12,567.0	-4,949.1	1,159.3	3.17	1.93	2.52	22.1	-1.4	
18,061.0	89.60	178.66	12,567.5	-5,039.1	1,161.5	0.20	-0.20	0.00	21.6	-2.0	
18,151.0	89.16	178.30	12,568.5	-5,129.1	1,163.8	0.63	-0.49	-0.40	21.6	-2.4	
18,241.0	88.81	177.86	12,570.1	-5,219.0	1,166.9	0.62	-0.39	-0.49	22.3	-2.1	
18,331.0	88.02	176.72	12,572.6	-5,308.9	1,171.1	1.54	-0.88	-1.27	23.8	-0.5	
18,421.0	89.96	177.78	12,574.1	-5,398.7	1,175.4	2.46	2.16	1.18	24.4	1.2	
18,512.0	89.43	177.25	12,574.6	-5,489.7	1,179.4	0.82	-0.58	-0.58	23.3	4.1	
18,602.0	90.75	177.34	12,574.5	-5,579.6	1,183.6	1.47	1.47	0.10	21.4	7.7	



Final PVA

Company:	Midland	Local Co-ordinate Reference:	Well #704H
Project:	Lea County, NM (NAD 83 NME)	TVD Reference:	KB = 32' @ 3498.0usft (Nabors M1206)
Site:	Lacey Swiss 1 Fed Com	MD Reference:	KB = 32' @ 3498.0usft (Nabors M1206)
Well:	#704H	North Reference:	Grid
Wellbore:	ST	Survey Calculation Method:	Minimum Curvature
Design:	ST	Database:	PEDM

Survey										
MD (usft)	Inc (°)	Azi (azimuth) (°)	TVD (usft)	N/S (usft)	E/W (usft)	DLeg (°/100usft)	Build (°/100usft)	Turn (°/100usft)	High to Plan (usft)	Right to Plan (usft)
18,692.0	88.81	175.58	12,574.8	-5,669.4	1,189.2	2.91	-2.16	-1.96	20.1	12.7
18,782.0	90.40	180.59	12,575.5	-5,759.3	1,192.2	5.84	1.77	5.57	19.0	15.1
18,872.0	90.40	181.29	12,574.8	-5,849.3	1,190.7	0.78	0.00	0.78	16.6	13.0
18,963.0	89.87	185.16	12,574.6	-5,940.1	1,185.6	4.29	-0.58	4.25	14.7	7.3
19,053.0	92.77	182.87	12,572.5	-6,029.9	1,179.3	4.11	3.22	-2.54	10.9	0.4
19,143.0	87.76	176.90	12,572.1	-6,119.8	1,179.5	8.66	-5.57	-6.63	8.8	0.0
19,234.0	86.70	176.46	12,576.5	-6,210.5	1,184.7	1.26	-1.16	-0.48	11.4	4.7
19,324.0	88.29	177.86	12,580.5	-6,300.3	1,189.2	2.35	1.77	1.56	13.6	8.5
19,415.0	86.35	179.80	12,584.7	-6,391.2	1,191.0	3.01	-2.13	2.13	16.2	9.8
19,505.0	90.04	181.47	12,587.5	-6,481.1	1,190.0	4.50	4.10	1.86	17.4	8.1
19,596.0	91.80	181.64	12,586.1	-6,572.1	1,187.6	1.94	1.93	0.19	14.3	5.0
19,686.0	92.15	182.79	12,583.0	-6,662.0	1,184.1	1.33	0.39	1.28	9.7	0.9
19,777.0	92.68	182.79	12,579.1	-6,752.8	1,179.7	0.58	0.58	0.00	4.3	-4.2
19,867.0	90.92	181.03	12,576.3	-6,842.7	1,176.7	2.76	-1.96	-1.96	-0.1	-7.9
19,958.0	89.60	180.94	12,575.9	-6,933.6	1,175.1	1.45	-1.45	-0.10	-2.0	-10.1
20,048.0	88.02	180.24	12,577.8	-7,023.6	1,174.2	1.92	-1.76	-0.78	-1.7	-11.7
20,139.0	89.16	180.50	12,580.0	-7,114.6	1,173.6	1.28	1.25	0.29	-1.0	-13.0
20,229.0	89.34	180.32	12,581.2	-7,204.6	1,173.0	0.28	0.20	-0.20	-1.4	-14.3
20,319.0	87.67	179.97	12,583.5	-7,294.5	1,172.7	1.90	-1.86	-0.39	-0.6	-15.2
20,410.0	88.29	180.24	12,586.7	-7,385.5	1,172.6	0.74	0.68	0.30	1.1	-16.1
20,500.0	87.67	179.62	12,589.9	-7,475.4	1,172.7	0.97	-0.69	-0.69	2.7	-16.6
20,591.0	90.04	178.83	12,591.7	-7,566.4	1,173.9	2.75	2.60	-0.87	3.0	-16.1
20,681.0	88.64	178.04	12,592.8	-7,656.4	1,176.4	1.79	-1.56	-0.88	2.5	-14.3
20,772.0	87.93	177.16	12,595.5	-7,747.2	1,180.2	1.24	-0.78	-0.97	3.6	-11.1
20,862.0	91.54	178.74	12,595.9	-7,837.2	1,183.4	4.38	4.01	1.76	2.5	-8.6
20,953.0	92.24	178.83	12,592.9	-7,928.1	1,185.3	0.78	0.77	0.10	-2.1	-7.3
21,043.0	92.07	178.57	12,589.5	-8,018.0	1,187.4	0.34	-0.19	-0.29	-7.0	-6.0



Final PVA

Company: Midland
Project: Lea County, NM (NAD 83 NME)
Site: Lacey Swiss 1 Fed Com
Well: #704H
Wellbore: ST
Design: ST

Local Co-ordinate Reference: Well #704H
TVD Reference: KB = 32' @ 3498.0usft (Nabors M1206)
MD Reference: KB = 32' @ 3498.0usft (Nabors M1206)
North Reference: Grid
Survey Calculation Method: Minimum Curvature
Database: PEDM

Survey										
MD (usft)	Inc (°)	Azi (azimuth) (°)	TVD (usft)	N/S (usft)	E/W (usft)	DLeg (°/100usft)	Build (°/100usft)	Turn (°/100usft)	High to Plan (usft)	Right to Plan (usft)
21,134.0	89.78	177.87	12,588.1	-8,108.9	1,190.2	2.63	-2.52	-0.77	-10.0	-3.8
21,225.0	88.99	177.60	12,589.0	-8,199.9	1,193.8	0.92	-0.87	-0.30	-10.6	-0.9
21,315.0	88.55	177.07	12,591.0	-8,289.7	1,198.0	0.77	-0.49	-0.59	-9.9	2.6
21,406.0	88.37	176.72	12,593.4	-8,380.6	1,202.9	0.43	-0.20	-0.38	-8.7	6.9
21,496.0	89.52	176.72	12,595.1	-8,470.4	1,208.0	1.28	1.28	0.00	-8.2	11.4
21,587.0	88.72	176.28	12,596.5	-8,561.2	1,213.6	1.00	-0.88	-0.48	-8.1	16.2
21,677.0	86.53	178.65	12,600.2	-8,651.0	1,217.6	3.58	-2.43	2.63	-5.5	19.5
21,768.0	83.27	178.13	12,608.3	-8,741.6	1,220.1	3.63	-3.58	-0.57	1.3	21.4
21,858.0	86.53	179.71	12,616.3	-8,831.3	1,221.8	4.02	3.62	1.76	8.1	22.4
21,949.0	89.08	181.56	12,619.8	-8,922.2	1,220.8	3.46	2.80	2.03	10.4	20.8
22,039.0	91.54	181.82	12,619.3	-9,012.1	1,218.1	2.75	2.73	0.29	8.7	17.4
22,130.0	91.28	181.64	12,617.0	-9,103.1	1,215.4	0.35	-0.29	-0.20	5.2	14.0
22,220.0	90.22	181.20	12,615.9	-9,193.0	1,213.2	1.28	-1.18	-0.49	2.9	11.1
22,311.0	88.90	181.29	12,616.6	-9,284.0	1,211.2	1.45	-1.45	0.10	2.3	8.5
22,401.0	88.29	181.12	12,618.8	-9,373.9	1,209.3	0.70	-0.68	-0.19	3.3	5.9
22,492.0	87.85	180.68	12,621.8	-9,464.9	1,207.9	0.68	-0.48	-0.48	5.2	3.8
22,582.0	87.14	180.41	12,625.8	-9,554.8	1,207.0	0.84	-0.79	-0.30	7.9	2.3
22,680.0	88.99	180.76	12,629.1	-9,652.7	1,206.0	1.92	1.89	0.36	9.9	0.5
Final MWD Survey (MD=22680.0')										
22,737.0	88.99	180.76	12,630.1	-9,709.7	1,205.3	0.00	0.00	0.00	10.1	-0.6
Final Projection to Bit (MD=22737.0')										



Final PVA

Company:	Midland	Local Co-ordinate Reference:	Well #704H
Project:	Lea County, NM (NAD 83 NME)	TVD Reference:	KB = 32' @ 3498.0usft (Nabors M1206)
Site:	Lacey Swiss 1 Fed Com	MD Reference:	KB = 32' @ 3498.0usft (Nabors M1206)
Well:	#704H	North Reference:	Grid
Wellbore:	ST	Survey Calculation Method:	Minimum Curvature
Design:	ST	Database:	PEDM

Design Annotations					
Measured Depth (usft)	Vertical Depth (usft)	Local Coordinates			
		+N/-S (usft)	+E/-W (usft)	Comment	
12,091.0	11,938.2	682.1	1,093.6	KOP (MD=12091.0')	
12,244.0	12,080.4	634.3	1,097.5	HL Crossing, MD:12244.0', TVD:12080.4', N/S:634.3', E/W:1097.5', INC:38.33	
22,680.0	12,629.1	-9,652.7	1,206.0	Final MWD Survey (MD=22680.0')	
22,737.0	12,630.1	-9,709.7	1,205.3	Final Projection to Bit (MD=22737.0')	

Checked By: _____	Approved By: _____	Date: _____
-------------------	--------------------	-------------

I CERTIFY THIS SURVEY TO BE TRUE AND CORRECT TO THE BEST OF MY BELIEF AND KNOWLEDGE
KAY MADDOX 02/14/2023

Intent ☐ As Drilled ☐

API #		
Operator Name:	Property Name:	Well Number

Kick Off Point (KOP)

UL	Section	Township	Range	Lot	Feet	From N/S	Feet	From E/W	County
Latitude					Longitude				NAD

First Take Point (FTP)

UL	Section	Township	Range	Lot	Feet	From N/S	Feet	From E/W	County
Latitude					Longitude				NAD

Last Take Point (LTP)

UL	Section	Township	Range	Lot	Feet	From N/S	Feet	From E/W	County
Latitude					Longitude				NAD

Is this well the defining well for the Horizontal Spacing Unit? ☐Is this well an infill well? ☐

If infill is yes please provide API if available, Operator Name and well number for Defining well for Horizontal Spacing Unit.

API #		
Operator Name:	Property Name:	Well Number

KZ 06/29/2018

Submit To Appropriate District Office Two Copies <u>District I</u> 1625 N. French Dr., Hobbs, NM 88240 <u>District II</u> 811 S. First St., Artesia, NM 88210 <u>District III</u> 1000 Rio Brazos Rd., Aztec, NM 87410 <u>District IV</u> 1220 S. St. Francis Dr., Santa Fe, NM 87505		State of New Mexico Energy, Minerals and Natural Resources Oil Conservation Division 1220 South St. Francis Dr. Santa Fe, NM 87505			Form C-105 Revised August 1, 2011					
WELL COMPLETION OR RECOMPLETION REPORT AND LOG										
4. Reason for filing: ☒ COMPLETION REPORT (Fill in boxes #1 through #31 for State and Fee wells only) ☐ C-144 CLOSURE ATTACHMENT (Fill in boxes #1 through #9, #15 Date Rig Released and #32 and/or #33; attach this and the plat to the C-144 closure report in accordance with 19.15.17.13.K NMAC)								5. Lease Name or Unit Agreement Name LACEY SWISS 1 FEDERAL COM		
								6. Well Number: 704H		
7. Type of Completion: ☒ NEW WELL ☐ WORKOVER ☐ DEEPENING ☐ PLUGBACK ☐ DIFFERENT RESERVOIR ☐ OTHER _____										
8. Name of Operator EOG RESOURCES INC						9. OGRID 7377				
10. Address of Operator PO BOX 2267 MIDLAND, TEXAS 79702						11. Pool name or Wildcat BOBCAT DRAW; UPPER WOLFCAMP				
12. Location	Unit Ltr	Section	Township	Range	Lot	Feet from the	N/S Line	Feet from the	E/W Line	County
Surface:	C	1	25S	33E		728	NORTH	2501	WEST	LEA
BH:	O	12	25S	33E		110	SOUTH	1651	EAST	LEA
13. Date Spudded 06/29/2022	14. Date T.D. Reached 10/29/2022		15. Date Rig Released 10/31/2022			16. Date Completed (Ready to Produce) 01/24/2023		17. Elevations (DF and RKB, RT, GR, etc.) 3467'		
18. Total Measured Depth of Well MD 22,737' TVD 12,630'			19. Plug Back Measured Depth MD 22,713' TVD 12,630'			20. Was Directional Survey Made? YES		21. Type Electric and Other Logs Run GAMMA RAY/CBL		
22. Producing Interval(s), of this completion - Top, Bottom, Name WOLFCAMP 12,920 - 22,713'										
23. CASING RECORD (Report all strings set in well)										
CASING SIZE		WEIGHT LB./FT.		DEPTH SET		HOLE SIZE		CEMENTING RECORD		AMOUNT PULLED
9 5/8"		36# J-55		1341'		12 1/4"		669 SXS CL C/CIRC		
7 5/8"		29.7# P110 EC		11,908'		8 3/4"		1510 SXS CL C&H/85' ECHO		
5 1/2"		20# HCP 110		22,722'		6 3/4"		1120 CL H/TOC 0 CBL		
24. LINER RECORD						25. TUBING RECORD				
SIZE	TOP	BOTTOM	SACKS CEMENT	SCREEN	SIZE	DEPTH SET	PACKER SET			
26. Perforation record (interval, size, and number) 12,920 - 22,713' 3 1/8", 2058 HOLES						27. ACID, SHOT, FRACTURE, CEMENT, SQUEEZE, ETC.				
						DEPTH INTERVAL		AMOUNT AND KIND MATERIAL USED		
						12,920 - 22,713'		FRAC W/ 382,386 BBLs LOAD FLD, W/24,153,209 LBS PROPPANT		
28. PRODUCTION										
Date First Production 01/24/2023		Production Method (<i>Flowing, gas lift, pumping - Size and type pump</i>) FLOWING				Well Status (<i>Prod. or Shut-in</i>) PRODUCING				
Date of Test 02/05/2023	Hours Tested 24 HRS	Choke Size 36	Prod'n For Test Period	Oil - Bbl 4292	Gas - MCF 7859	Water - Bbl. 4940	Gas - Oil Ratio 1831			
Flow Tubing Press.	Casing Pressure 1027	Calculated 24-Hour Rate	Oil - Bbl.	Gas - MCF	Water - Bbl.	Oil Gravity - API - (<i>Corr.</i>) 45				
29. Disposition of Gas (<i>Sold, used for fuel, vented, etc.</i>)								30. Test Witnessed By		
31. List Attachments C-102, C-104, DIRECTIONAL SURVEY, H SPACING (POINTS),										
32. If a temporary pit was used at the well, attach a plat with the location of the temporary pit.										
33. If an on-site burial was used at the well, report the exact location of the on-site burial:										
Latitude _____				Longitude _____				NAD 1927 1983		
I hereby certify that the information shown on both sides of this form is true and complete to the best of my knowledge and belief										
Signature Kay Maddox			Name Kay Maddox			Title Senior Regulatory Specialist			Date 02/13/2023	
E-mail Address kay_maddox@eogresources.com										

This form is to be filed with the appropriate District Office of the Division not later than 20 days after the completion of any newly-drilled or deepened well and not later than 60 days after completion of closure. When submitted as a completion report, this shall be accompanied by one copy of all electrical and radio-activity logs run on the well and a summary of all special tests conducted, including drill stem tests. All depths reported shall be measured depths. In the case of directionally drilled wells, true vertical depths shall also be reported. For multiple completions, items 11, 12 and 26-31 shall be reported for each zone.

Southeastern New Mexico		Northwestern New Mexico	
T. Anhy <u>RUSTLER 1194'</u>	T. Canyon <u>BRUSHY 8162'</u>	T. Ojo Alamo	T. Penn A "
T. Salt <u>T/SALT 1677'</u>	T. Strawn	T. Kirtland	T. Penn. "B"
B. Salt <u>B/SALT 5009'</u>	T. Atoka	T. Fruitland	T. Penn. "C"
T. Yates	T. Miss	T. Pictured Cliffs	T. Penn. "D"
T. 7 Rivers	T. Devonian	T. Cliff House	T. Leadville
T. Queen	T. Silurian	T. Menefee	T. Madison
T. Grayburg	T. Montoya	T. Point Lookout	T. Elbert
T. San Andres	T. Simpson	T. Mancos	T. McCracken
T. Glorieta	T. McKee	T. Gallup	T. Ignacio Otzte
T. Paddock	T. Ellenburger	Base Greenhorn	T.Granite
T. Blinebry	T. Gr. Wash	T. Dakota	
T.Tubb	T. Delaware Sand	T. Morrison	
T. Drinkard	T. Bone Springs	T.Todilto	
T. Abo	T. <u>1ST BONE SPRING SAND 10,264'</u>	T. Entrada	
T. Wolfcamp <u>12,370'</u>	T. <u>2ND BONE SPRING SAND 10,956'</u>	T. Wingate	
T. Penn	T. <u>3RD BONE SPRING SAND 11,948'</u>	T. Chinle	
T. Cisco (Bough C)	T.	T. Permian	

No. 1, from.....to.....
No. 2, from.....to.....
No. 3, from.....to.....
No. 4, from.....to.....

Include data on rate of water inflow and elevation to which water rose in hole.

No. 1, from.....to.....feet.....
 No. 2, from.....to.....feet.....
 No. 3, from.....to.....feet.....

From	To	Thickness In Feet	Lithology

From	To	Thickness In Feet	Lithology

Sante Fe Main Office
Phone: (505) 476-3441

General Information
Phone: (505) 629-6116

Online Phone Directory
<https://www.emnrd.nm.gov/ocd/contact-us>

State of New Mexico
Energy, Minerals and Natural Resources
Oil Conservation Division
1220 S. St Francis Dr.
Santa Fe, NM 87505

ACKNOWLEDGMENTS

Action 186136

ACKNOWLEDGMENTS

Operator: EOG RESOURCES INC 5509 Champions Drive Midland, TX 79706	OGRID: 7377
	Action Number: 186136
	Action Type: [C-104] Completion Packet (C-104C)

ACKNOWLEDGMENTS

☒	I hereby certify that the required Water Use Report has been, or will be, submitted for this wells completion.
☒	I hereby certify that the required FracFocus disclosure has been, or will be, submitted for this wells completion.

Sante Fe Main Office
Phone: (505) 476-3441

General Information
Phone: (505) 629-6116

Online Phone Directory
<https://www.emnrd.nm.gov/ocd/contact-us>

State of New Mexico
Energy, Minerals and Natural Resources
Oil Conservation Division
1220 S. St Francis Dr.
Santa Fe, NM 87505

CONDITIONS

Action 186136

CONDITIONS

Operator: EOG RESOURCES INC 5509 Champions Drive Midland, TX 79706	OGRID: 7377
	Action Number: 186136
	Action Type: [C-104] Completion Packet (C-104C)

CONDITIONS

Created By	Condition	Condition Date
plmartinez	File 3160-4 Completion Report within 10 days of BLM approval.	3/10/2025