

District I
1625 N. French Dr., Hobbs, NM 88240
District II
811 S. First St., Artesia, NM 88210
District III
1000 Rio Brazos Rd., Aztec, NM 87410
District IV
1220 S. St. Francis Dr., Santa Fe, NM 87505

State of New Mexico
Energy, Minerals & Natural
Resources

Form C-104
Revised August 1, 2011

Submit one copy to appropriate District Office

Oil Conservation Division
1220 South St. Francis Dr.

☐ AMENDED REPORT

I. REQUEST FOR ALLOWABLE MINERAL AUTHORIZATION TO TRANSPORT

¹ Operator name and Address EOG RESOURCES INC PO BOX 2267 MIDLAND, TEXAS 79702		² OGRID Number 7377	
		³ Reason for Filing Code/ Effective Date NW 11/20/2023	
⁴ API Number 30 - 025-51184	⁵ Pool Name WC025 G09 S253309P; UPPER WOLFCAMP		⁶ Pool Code 98180
⁷ Property Code 329701	⁸ Property Name RUTHLESS 11 FEDERAL COM		⁹ Well Number 728H

II. ¹⁰ Surface Location

UL or lot no. D	Section 11	Township 25S	Range 32E	Lot Idn	Feet from the 682'	North/South Line NORTH	Feet from the 1330'	East/West line WEST	County LEA
--------------------	---------------	-----------------	--------------	---------	-----------------------	---------------------------	------------------------	------------------------	---------------

¹¹ Bottom Hole Location

UL or lot no. M	Section 14	Township 25S	Range 32E	Lot Idn	Feet from the 111'	North/South line SOUTH	Feet from the 1121'	East/West line WEST	County LEA
¹² Lse Code	¹³ Producing Method Code FLOWING	¹⁴ Gas Connection Date	¹⁵ C-129 Permit Number		¹⁶ C-129 Effective Date		¹⁷ C-129 Expiration Date		

III. Oil and Gas Transporters

¹⁸ Transporter OGRID	¹⁹ Transporter Name and Address	²⁰ O/G/W
372812	EOGRM	OIL
151618	ENTERPRISE FIELD SERVICES	GAS
298751	REGENCY FIELD SERVICES	GAS
36785	DCP MIDSTREAM	GAS

IV. Well Completion Data

²¹ Spud Date 03/24/2023	²² Ready Date 11/20/2023	²³ TD 22,660'	²⁴ PBDT 22,637'	²⁵ Perforations 12,594 - 22,637'	²⁶ DHC, MC
²⁷ Hole Size		²⁸ Casing & Tubing Size		²⁹ Depth Set	³⁰ Sacks Cement
12 1/4		9 5/8"		1054'	500 SXS CL C/CIRC
8 3/4"		7 5/8"		11,842'	1460 1715 SXS CL C&H/CIRC
6 3/4"		5 1/2"		22,645'	1325 SXS CL C TOC 8002' CBL

V. Well Test Data

³¹ Date New Oil 11/20/2023	³² Gas Delivery Date 11/20/2023	³³ Test Date 11/22/2023	³⁴ Test Length 24 HRS	³⁵ Tbg. Pressure	³⁶ Csg. Pressure 2975 343
³⁷ Choke Size	³⁸ Oil 2544	³⁹ Water 5995	⁴⁰ Gas 7567		⁴¹ Test Method
⁴² I hereby certify that the rules of the Oil Conservation Division have been complied with and that the information given above is true and complete to the best of my knowledge and belief. Signature: Kay Maddox			OIL CONSERVATION DIVISION Approved by: Title: Approval Date: 		
Printed name: Kay Maddox					
Title: SENIOR REGULATORY SPECIALIST					
E-mail Address: kay_maddox@eogresources.com					
Date: 12/4/2023		Phone: 432-638-8475			

State of New Mexico
Energy, Minerals & Natural Resources Department
OIL CONSERVATION DIVISION
1220 South St. Francis Dr.
Santa Fe, New Mexico 87505

Submit one copy to appropriate
District Office

☐ AMENDED REPORT
AS-COMPLETED

WELL LOCATION AND ACREAGE DEDICATION PLAT

API Number 30-025- 51184	Pool Code 98180	Pool Name WC025 G09 S253309P; UPPER WOLFCAMP
Property Code 329701	Property Name RUTHLESS 11 FED COM	Well Number 728H
OGRID No. 7377	Operator Name EOG RESOURCES, INC.	Elevation 3498'

Surface Location

UL or lot no.	Section	Township	Range	Lot Idn	Feet from the	North/South line	Feet from the	East/West line	County
D	11	25-S	32-E	-	682'	NORTH	1330'	WEST	LEA

Bottom Hole Location If Different From Surface

UL or lot no.	Section	Township	Range	Lot Idn	Feet from the	North/South line	Feet from the	East/West line	County
M	14	25-S	32-E	-	111'	SOUTH	1121'	WEST	LEA

Dedicated Acres	Joint or Infill	Consolidated Code	Order No.
640.00			PENDING COM AGREEMENT NMNM - 105774922

No allowable will be assigned to this completion until all interests have been consolidated or a non-standard unit has been approved by the division.

SURFACE LOCATION (SHL)
NEW MEXICO EAST
NAD 1983
X=752839 Y=419127
LAT.: N 32.1504142
LONG.: W 103.6499345
NAD 1927
X=711653 Y=419069
LAT.: N 32.1502900
LONG.: W 103.6494586
682' FNL 1330' FWL

KICK OFF POINT (KOP)
NEW MEXICO EAST
NAD 1983
X=752598 Y=419744
LAT.: N 32.1521135
LONG.: W 103.6507004
NAD 1927
X=711412 Y=419686
LAT.: N 32.1519893
LONG.: W 103.6502243
63' FNL 1093' FWL
MD=11977' TVD=11930'

FIRST TAKE POINT (FTP)
NEW MEXICO EAST
NAD 1983
X=752625 Y=419400
LAT.: N 32.1511673
LONG.: W 103.6506197
NAD 1927
X=711439 Y=419342
LAT.: N 32.1510430
LONG.: W 103.6501436
407' FNL 1118' FWL
MD=12594' TVD=12412'

FED PERF. POINT (FPP1)
NEW MEXICO EAST
NAD 1983
X=752639 Y=417169
LAT.: N 32.1450339
LONG.: W 103.6506205
NAD 1927
X=711453 Y=417111
LAT.: N 32.1449096
LONG.: W 103.6501448
2639' FNL 1120' FWL
MD=14840' TVD=12491'

FED PERF. POINT (FPP2)
NEW MEXICO EAST
NAD 1983
X=752651 Y=411887
LAT.: N 32.1305143
LONG.: W 103.6506874
NAD 1927
X=711466 Y=411828
LAT.: N 32.1303899
LONG.: W 103.6502125
2642' FNL 1111' FWL
MD=20126' TVD=12374'

LAST TAKE POINT (LTP)
NEW MEXICO EAST
NAD 1983
X=752659 Y=409378
LAT.: N 32.1236184
LONG.: W 103.6507147
NAD 1927
X=711473 Y=409320
LAT.: N 32.1234939
LONG.: W 103.6502403
134' FSL 1121' FWL
MD=22637' TVD=12353'


BOTTOM HOLE LOCATION (BHL)
NEW MEXICO EAST
NAD 1983
X=752659 Y=409355
LAT.: N 32.1235551
LONG.: W 103.6507150
NAD 1927
X=711473 Y=409297
LAT.: N 32.1234307
LONG.: W 103.6502406
111' FSL 1121' FWL
MD=22660' TVD=12353'

OPERATOR CERTIFICATION
I hereby certify that the information contained herein is true and complete to the best of my knowledge and belief, and that this organization either owns a working interest or unleased mineral interest in the land including the proposed bottom hole location or has a right to drill this well at this location pursuant to a contract with an owner of such a mineral or working interest, or to voluntary pooling agreement or a compulsory pooling order heretofore entered by the division.

SURVEYORS CERTIFICATION
I hereby certify that the well location shown on this plat was plotted from field notes of actual surveys made by me or under my supervision, and that the same is true and correct to the best of my belief.
Date of Survey
Signature and Seal of Professional Surveyor:
04/12/2023

ANGEL M. BAEZA
NEW MEXICO
PROFESSIONAL SURVEYOR
25116

S:\SURVEY\EOG_MIDLAND\RUTHLESS_11_FED_COM\FINAL_PRODUCT\AD_RUTHLESS_11_FED_COM_728H.dwg AFLORES 11/29/2023 7:47 AM

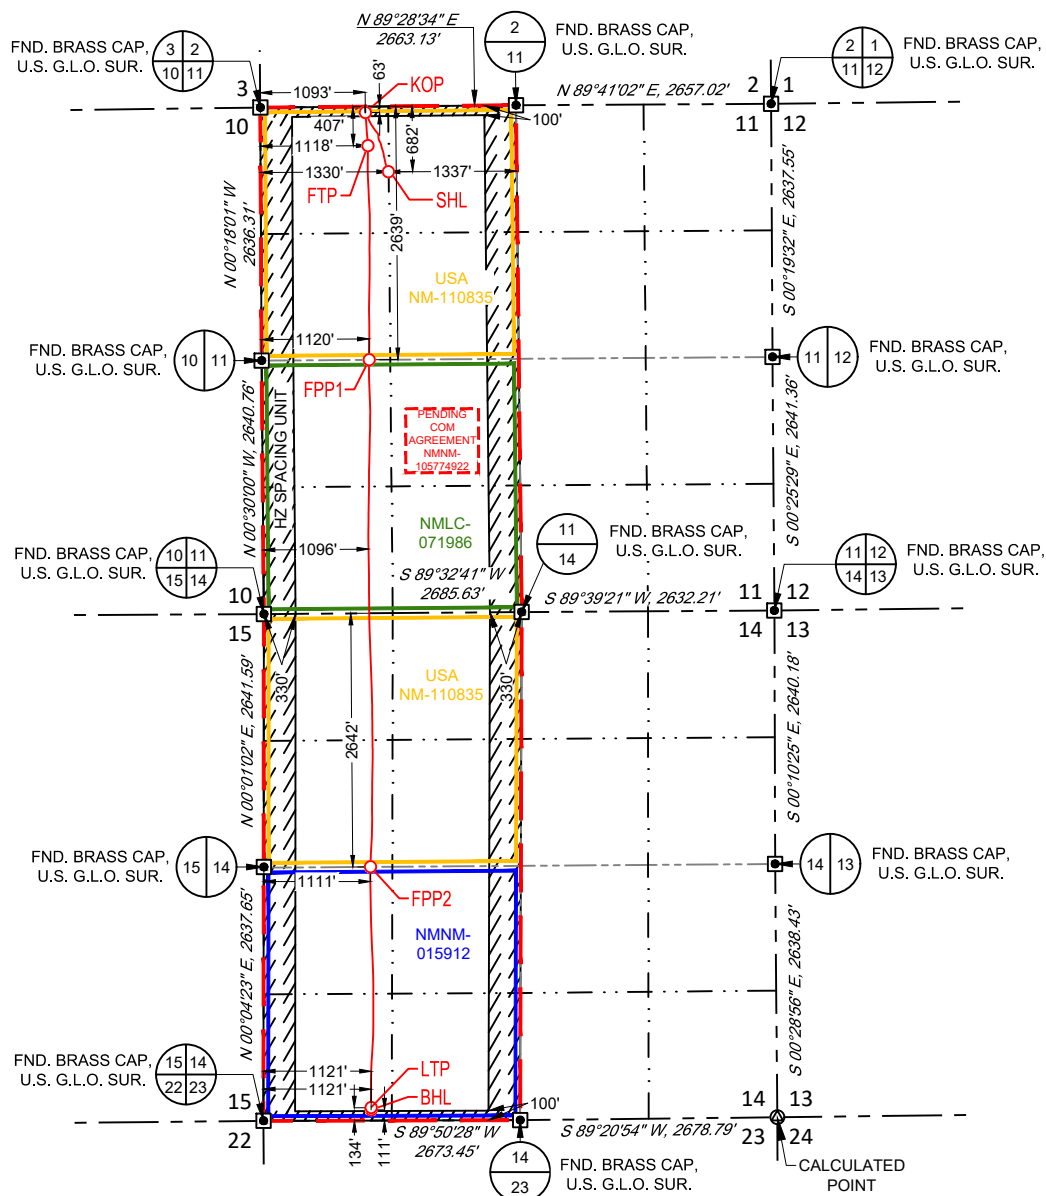SECTION 11, TOWNSHIP 25-S, RANGE 32-E, N.M.P.M.
LEA COUNTY, NEW MEXICO**SURFACE LOCATION (SHL)**

NEW MEXICO EAST
NAD 1983
X=752839 Y=419127
LAT.: N 32.1504142
LONG.: W 103.6499345
682' FNL 1330' FWL

KICK OFF POINT (KOP)

NEW MEXICO EAST
NAD 1983
X=752598 Y=419744
LAT.: N 32.1521135
LONG.: W 103.6507004
63' FNL 1093' FWL
MD=11977' TVD=11930'

FIRST TAKE POINT (FTP)

NEW MEXICO EAST
NAD 1983
X=752625 Y=419400
LAT.: N 32.1511673
LONG.: W 103.6506197
407' FNL 1118' FWL
MD=12594' TVD=12412'

FED PERF. POINT (FPP1)

NEW MEXICO EAST
NAD 1983
X=752639 Y=417169
LAT.: N 32.1450339
LONG.: W 103.6506205
2639' FNL 1120' FWL
MD=14840' TVD=12491'

FED PERF. POINT (FPP2)

NEW MEXICO EAST
NAD 1983
X=752651 Y=411887
LAT.: N 32.1305143
LONG.: W 103.6506874
2642' FNL 1111' FWL
MD=20126' TVD=12374'

LAST TAKE POINT (LTP)

NEW MEXICO EAST
NAD 1983
X=752659 Y=409378
LAT.: N 32.1236184
LONG.: W 103.6507147
134' FSL 1121' FWL
MD=22637' TVD=12353'

BOTTOM HOLE LOCATION (BHL)

NEW MEXICO EAST
NAD 1983
X=752659 Y=409355
LAT.: N 32.1235551
LONG.: W 103.6507150
111' FSL 1121' FWL
MD=22660' TVD=12353'

LEASE NAME & WELL NO.: RUTHLESS 11 FED COM 728H

SECTION 11 TWP 25-S RGE 32-E SURVEY N.M.P.M.

COUNTY LEA STATE NM ELEVATION 3498'

DESCRIPTION 682' FNL & 1330' FWL

SCALE: 1" = 2000'

0' 1000' 2000'



481 WINSBOTT ROAD, Ste. 200 • BENBROOK, TEXAS 76126

TELEPHONE: (817) 744-7512 • FAX (817) 744-7554

2903 NORTH BIG SPRING • MIDLAND, TEXAS 79705

TELEPHONE: (432) 682-1653 OR (800) 767-1653 • FAX (432) 682-1743

WWW.TOPOGRAPHIC.COM



Angel M. Baeza, P.S. No. 25116

RUTHLESS 11 FED COM
728H
AS-DRILLED

DATE: 11/22/2023

FILE:AD_RUTHLESS_11_FED_COM_728H


DRAWN BY: A.V.F.

SHEET: 2 OF 2

REVISION:

NOTES:

1. ORIGINAL DOCUMENT SIZE: 8.5" X 11"
2. ALL BEARINGS, DISTANCES, AND COORDINATE VALUES CONTAINED HEREIN ARE GRID BASED UPON THE NEW MEXICO COORDINATE SYSTEM OF 1983, EAST ZONE, U.S. SURVEY FEET.
3. THIS WELL LOCATION SHOWN HEREON HAS BEEN SURVEYED ON THE GROUND UNDER MY SUPERVISION AND PREPARED ACCORDING TO THE EVIDENCE FOUND AT THE TIME OF SURVEY, AND DATA PROVIDED BY EOG RESOURCES, INC. THIS CERTIFICATION IS MADE AND LIMITED TO THOSE PERSONS OR ENTITIES SHOWN ON THE FACE OF THIS PLAT AND IS NON-TRANSFERABLE. THIS SURVEY IS CERTIFIED FOR THIS TRANSACTION ONLY.

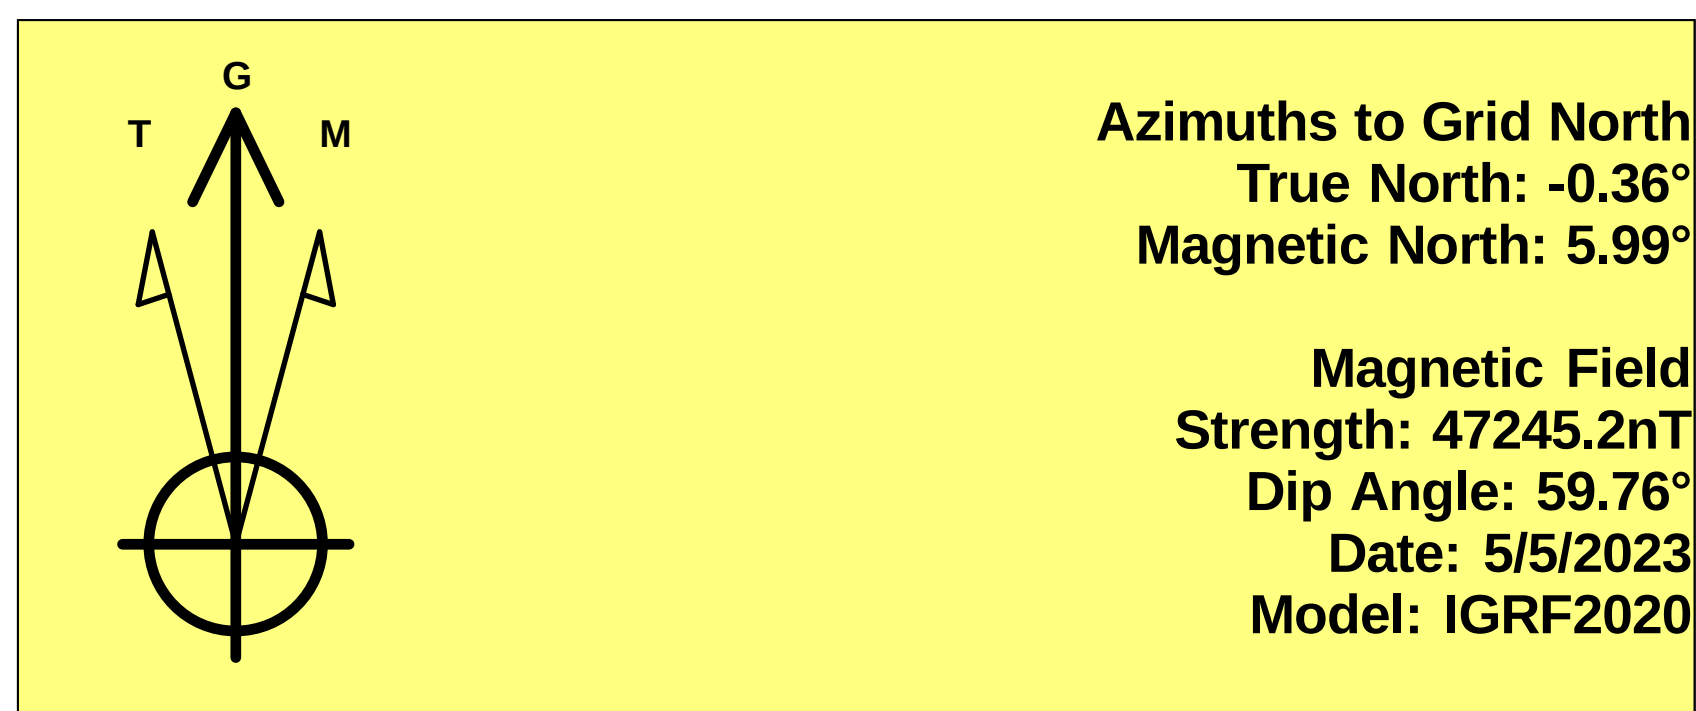

To convert a Magnetic Direction to a Grid Direction, Add 5.99°
To convert a Magnetic Direction to a True Direction, Add 6.35° East
To convert a True Direction to a Grid Direction, Subtract 0.36°








PROJECT DETAILS: Lea County, NM (NAD 83 NME)

Geodetic System: US State Plane 1983
Datum: North American Datum 1983
Ellipsoid: GRS 1980
Zone: New Mexico Eastern Zone
System Datum: Mean Sea Level

WELL DETAILS: #728H

KB = 32' @ 3530.0usft

Northring	Easting	Latitude	Longitude
419127.00	752839.00	32° 9' 1.488 N	103° 38' 59.760 W

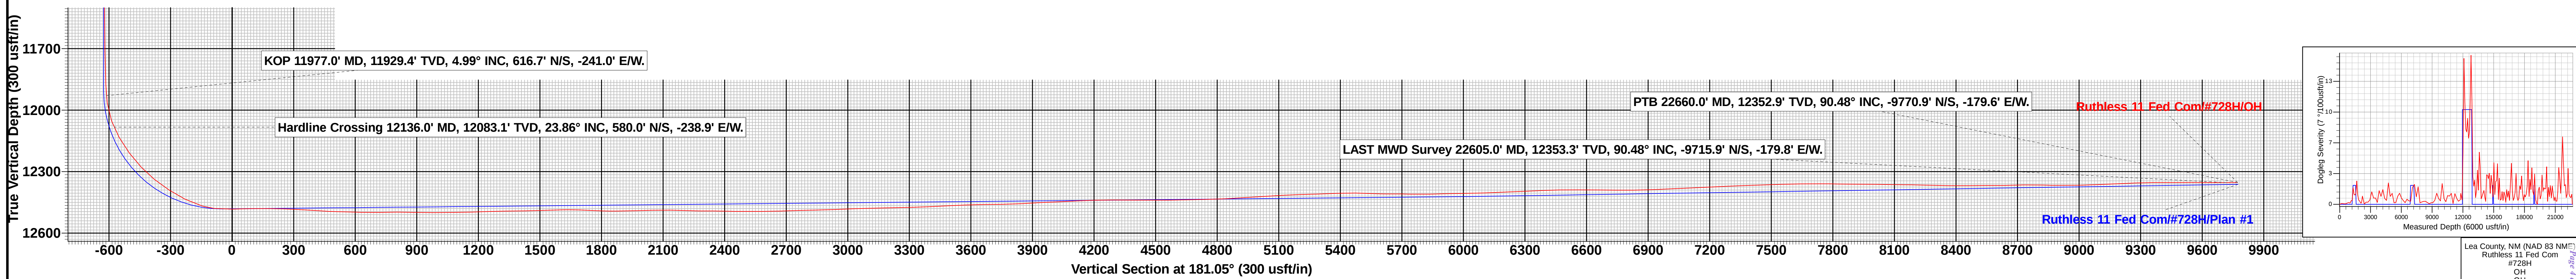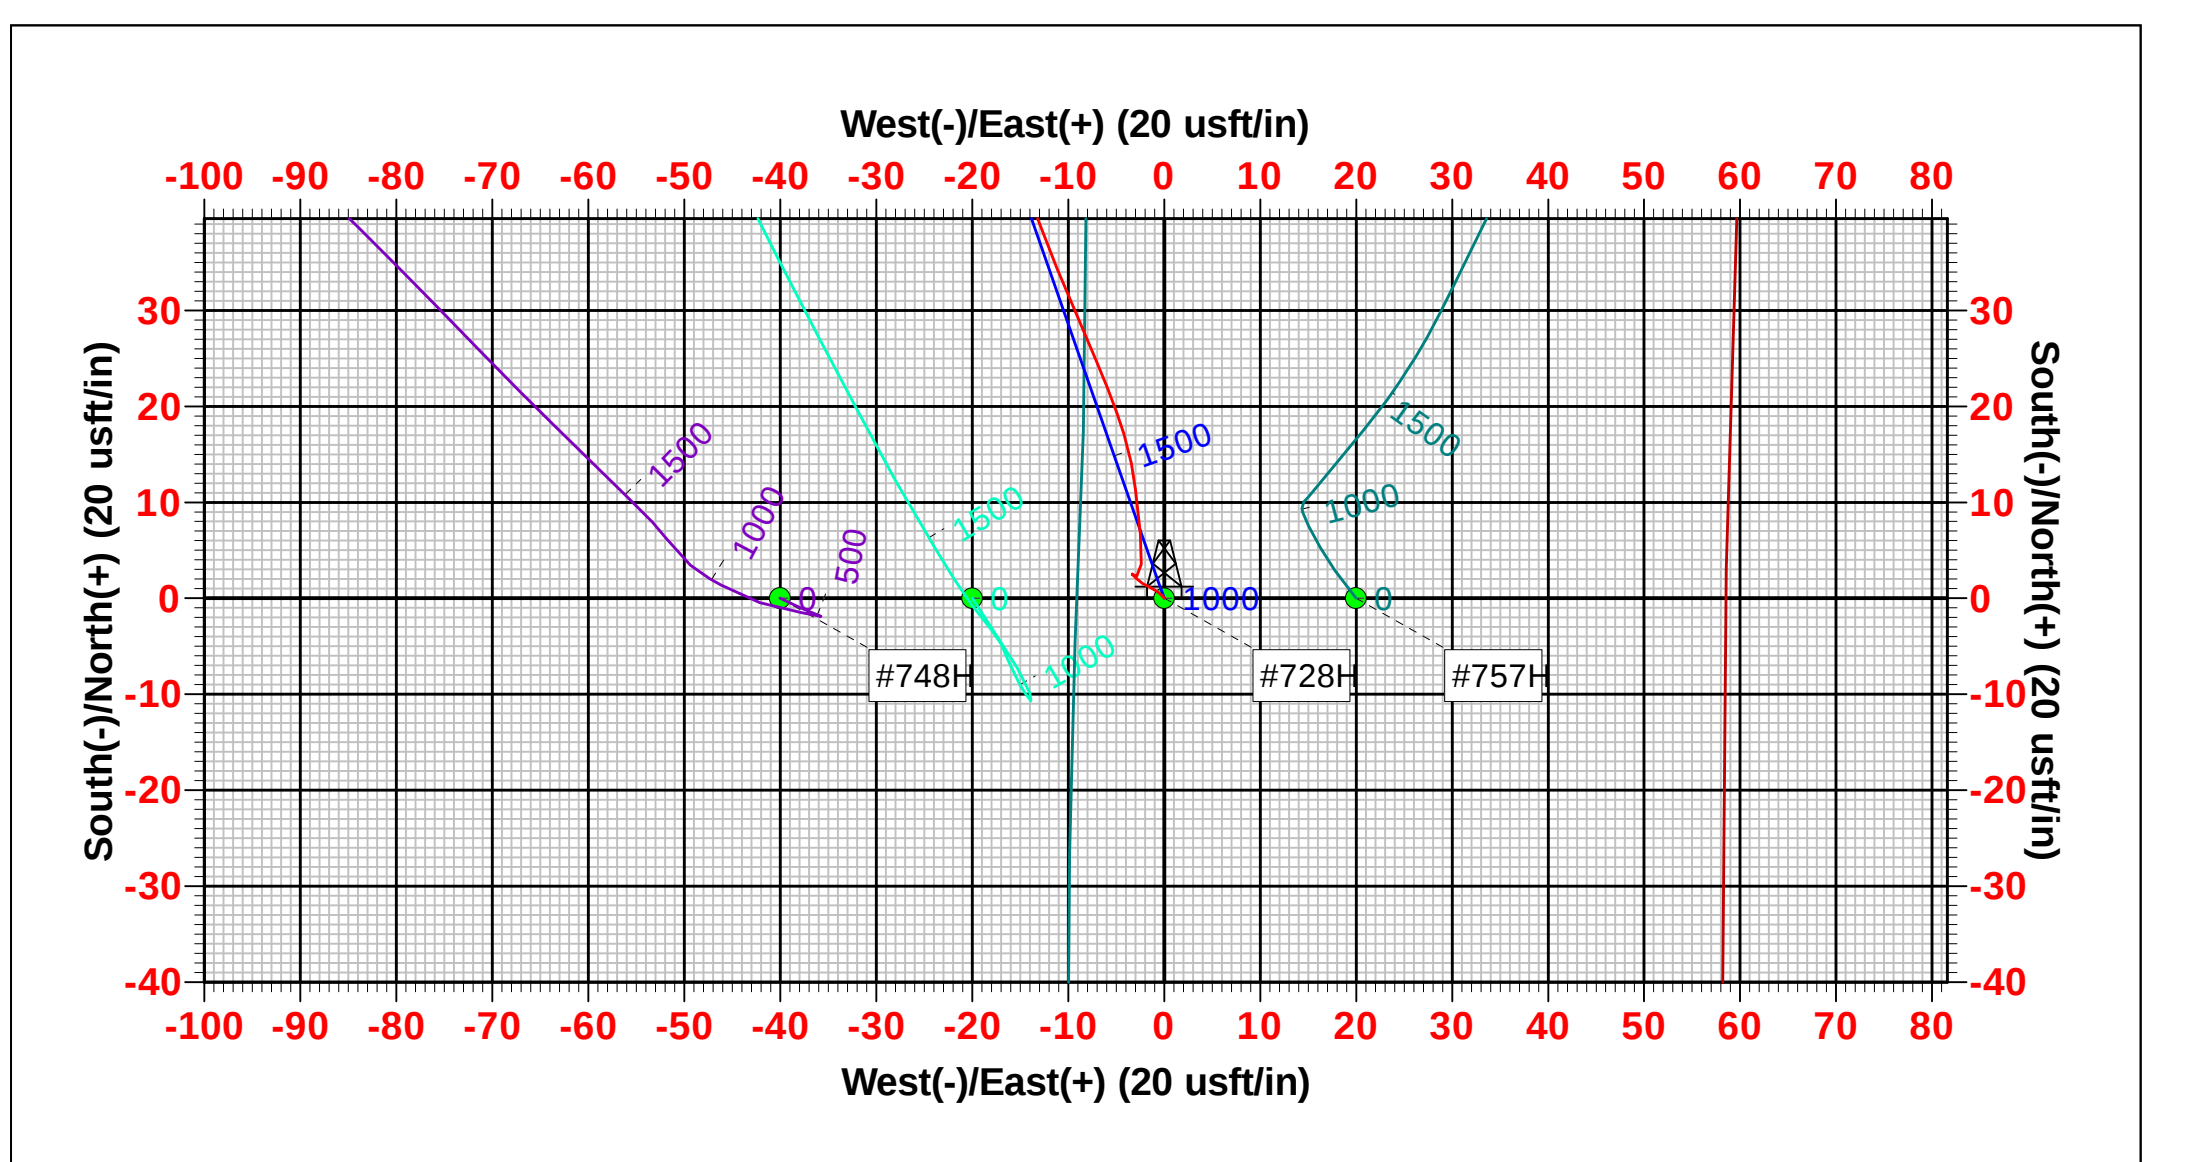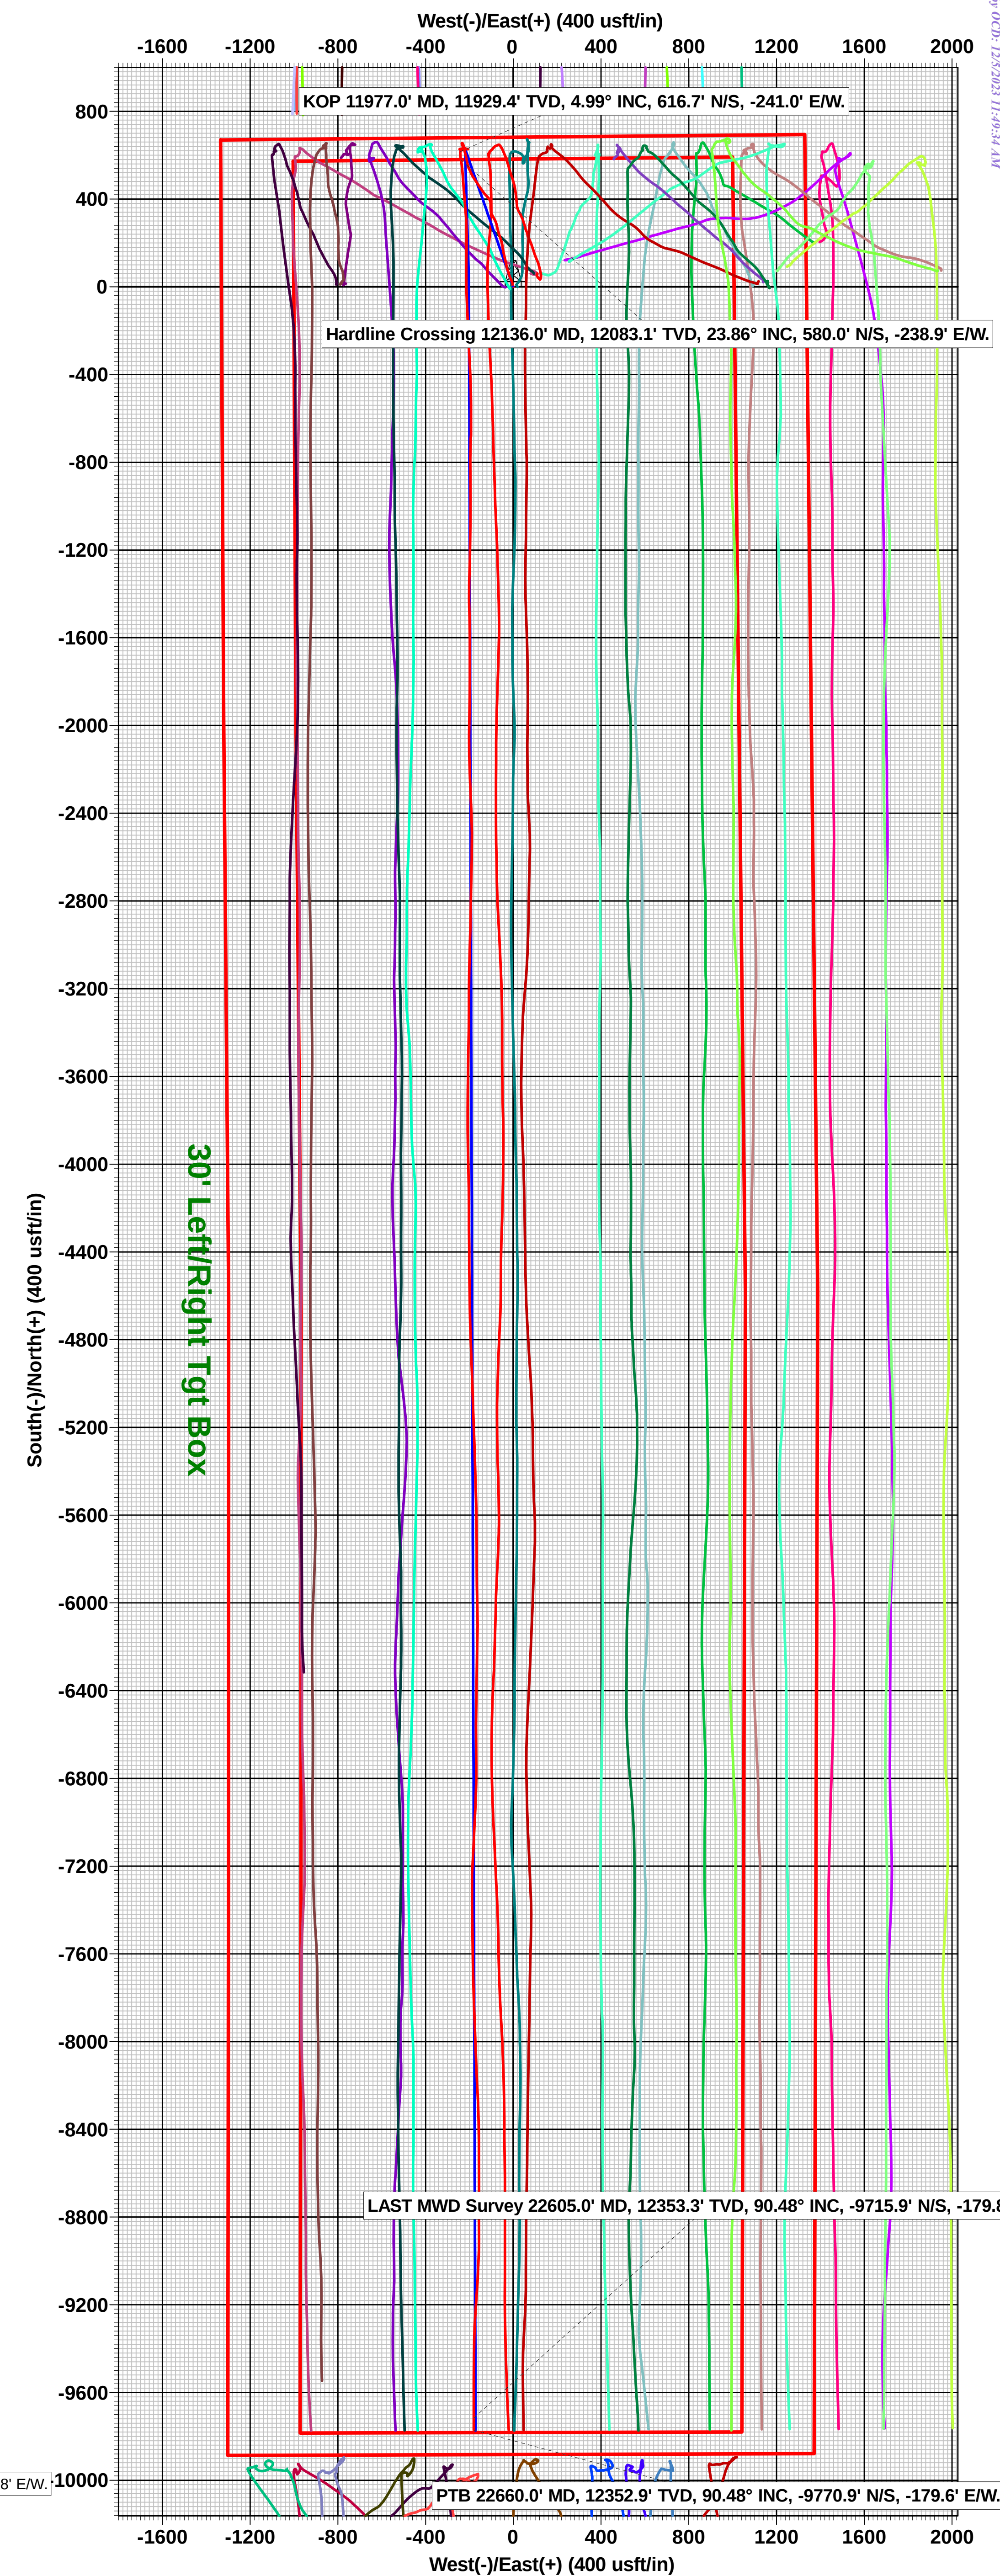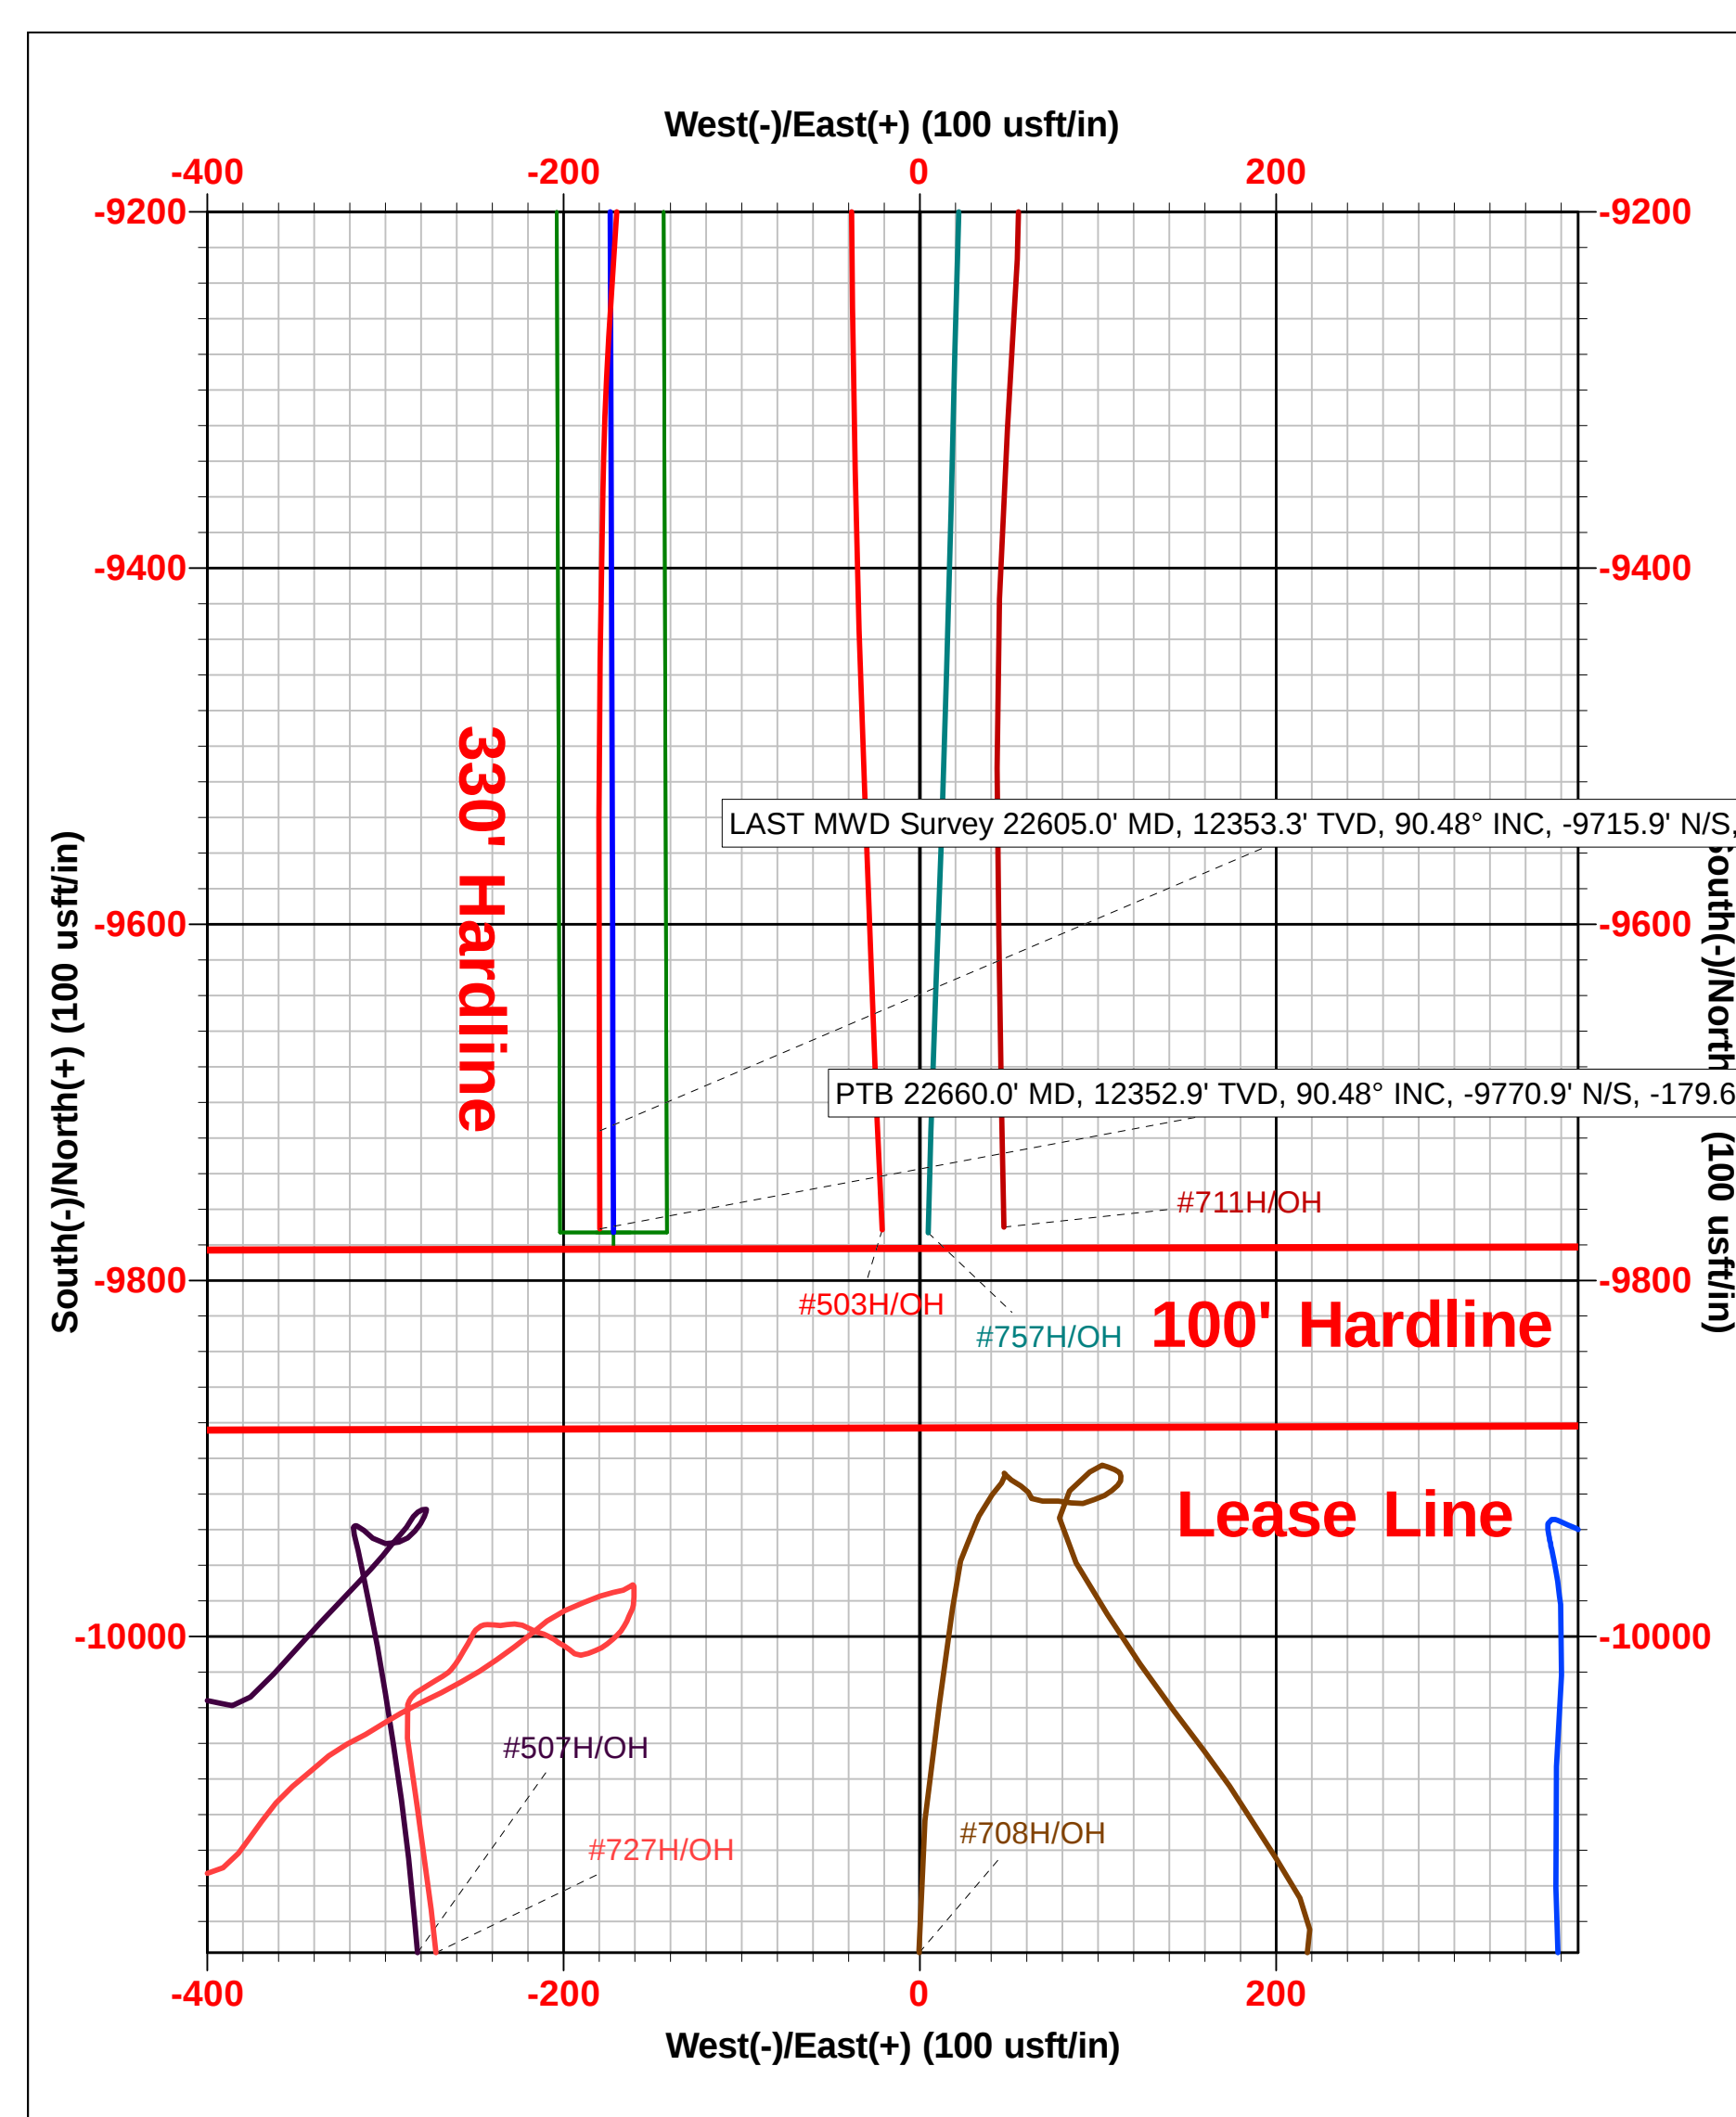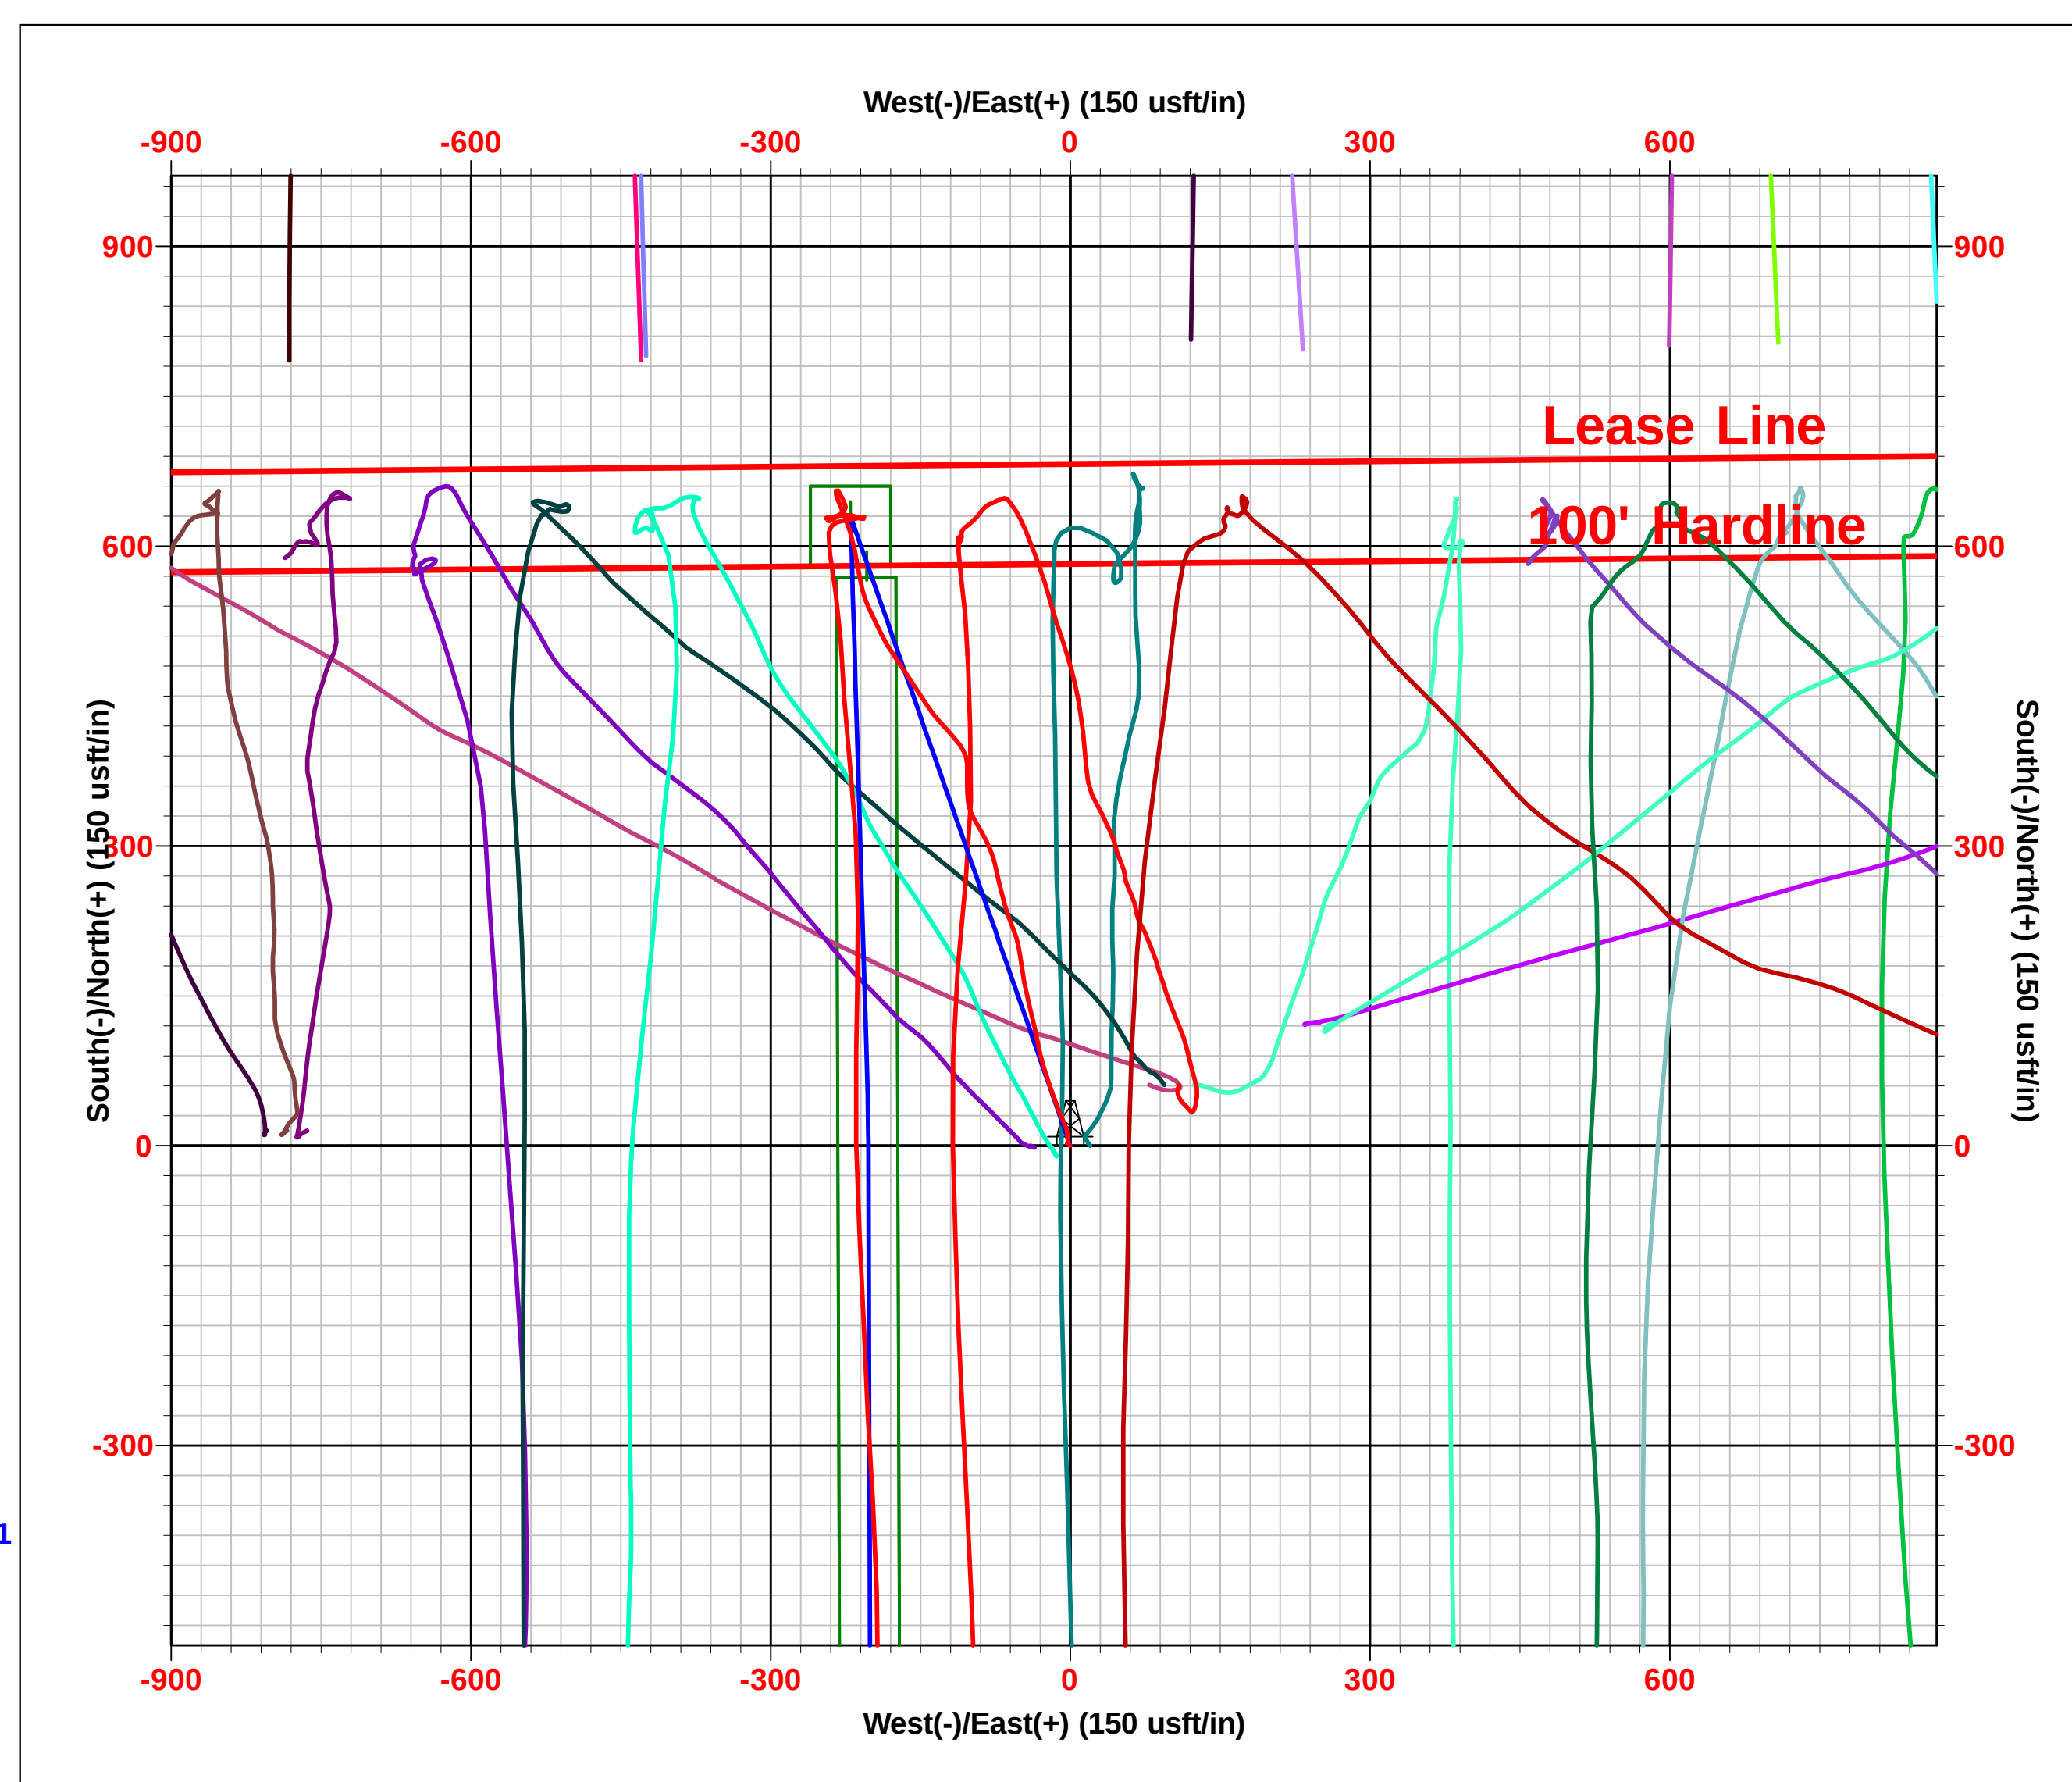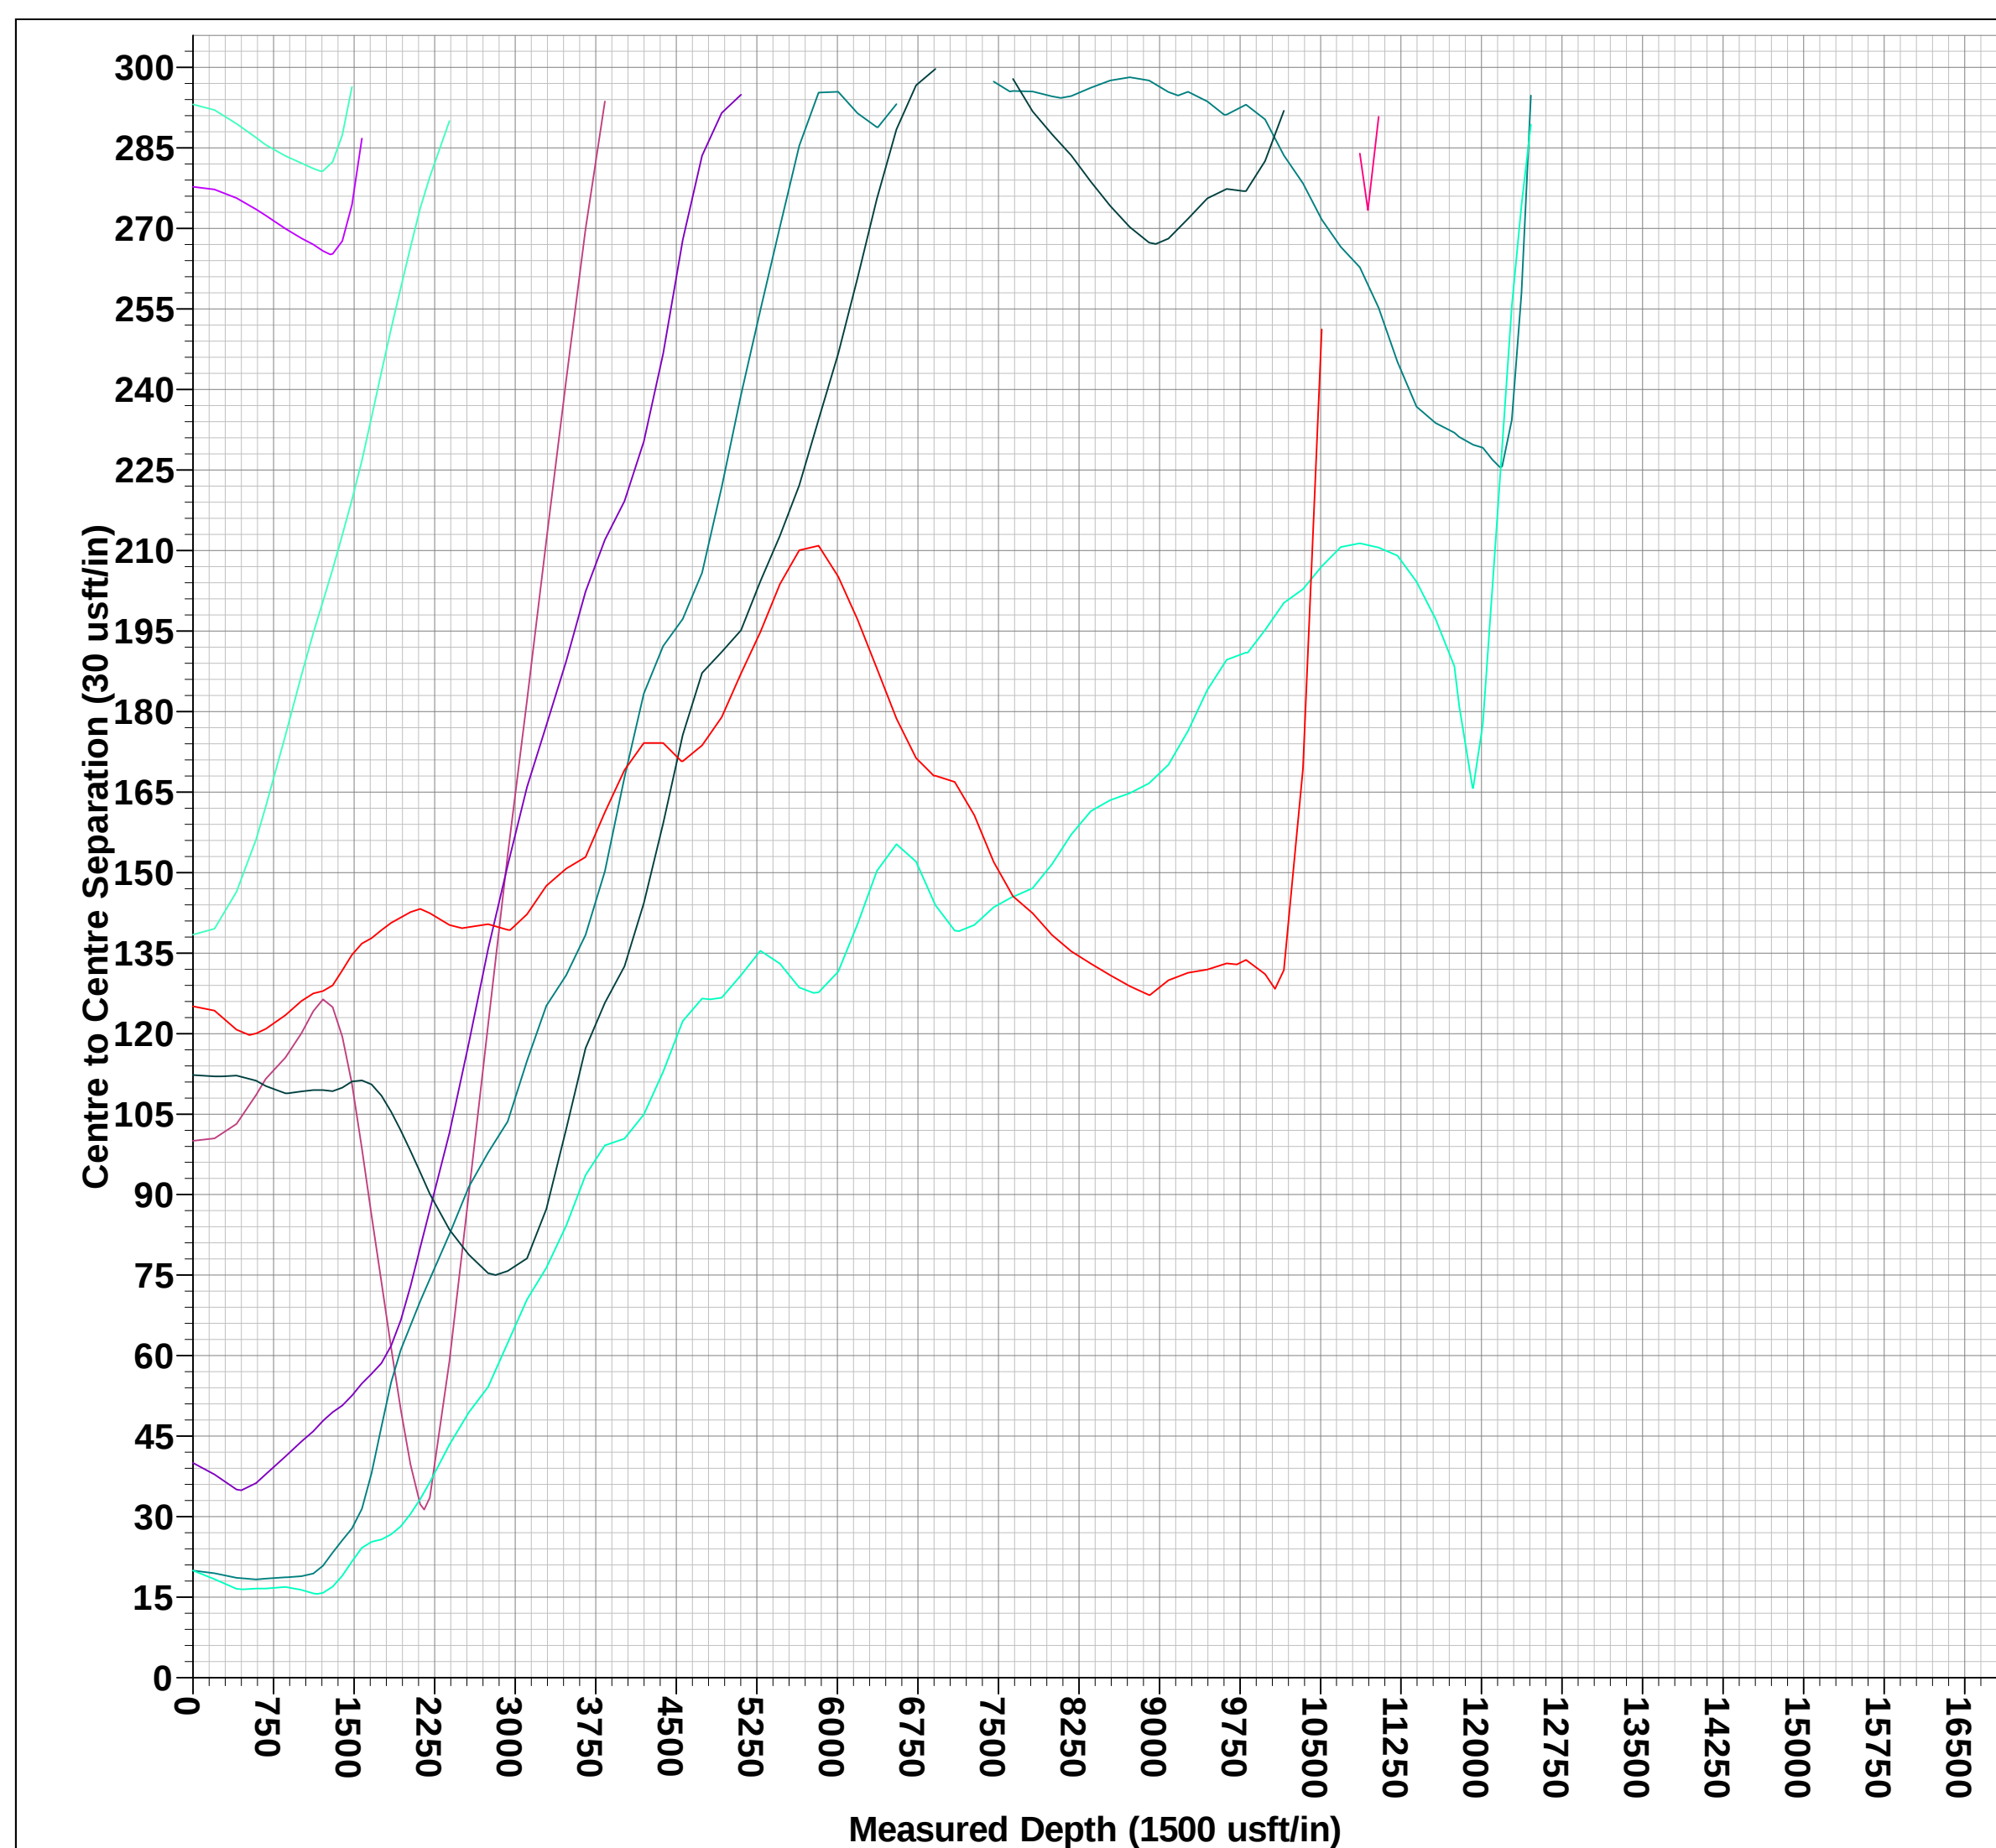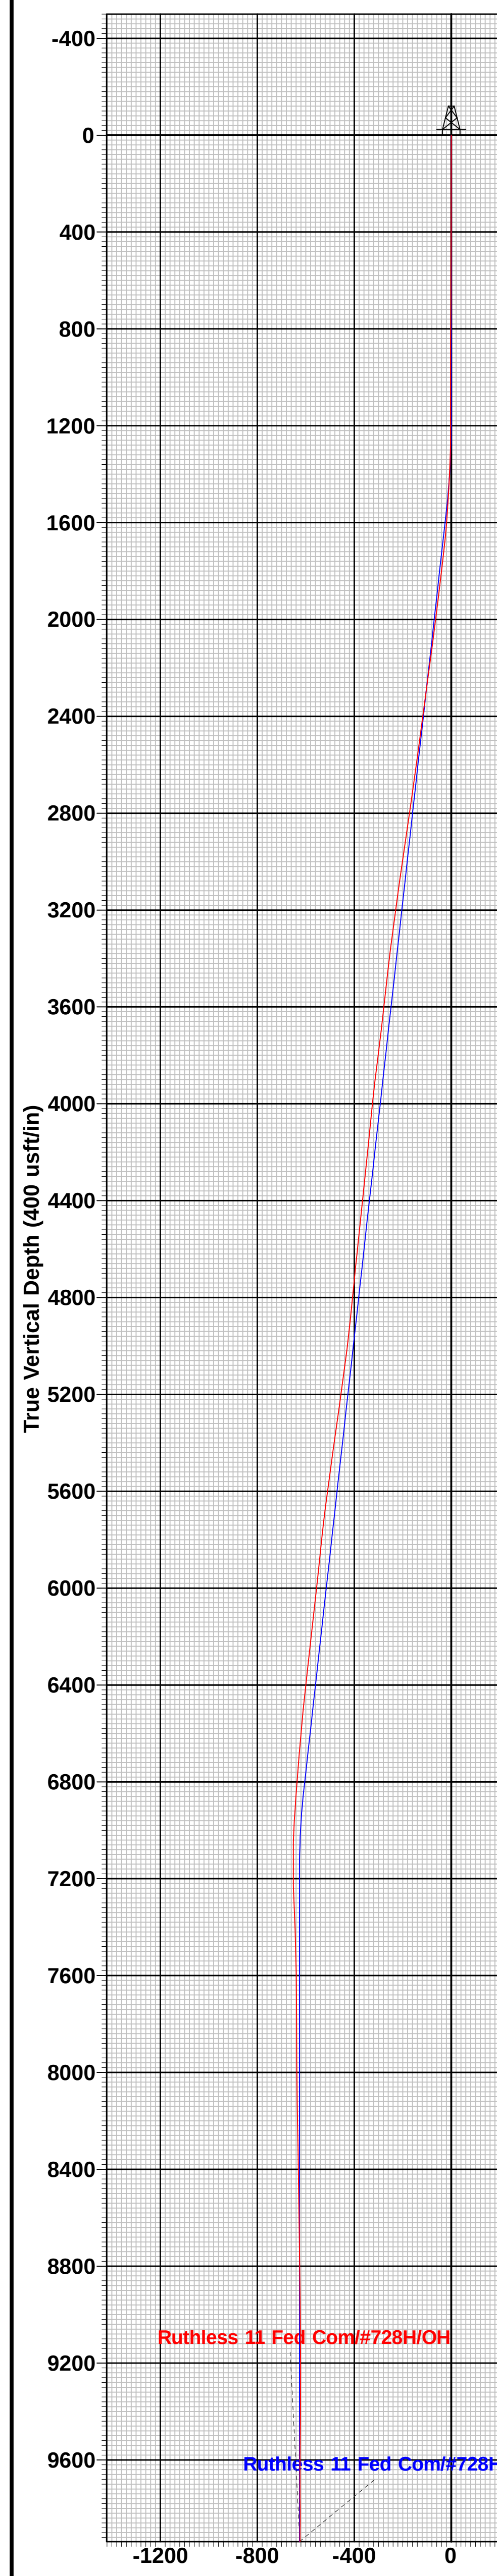



Midland

Lea County, NM (NAD 83 NME)

Ruthless 11 Fed Com

#728H

143697

OH

Design: OH

Standard Survey Report

16 June, 2023



Survey Report

Company:	Midland	Local Co-ordinate Reference:	Well #728H
Project:	Lea County, NM (NAD 83 NME)	TVD Reference:	KB = 32' @ 3530.0usft
Site:	Ruthless 11 Fed Com	MD Reference:	KB = 32' @ 3530.0usft
Well:	#728H	North Reference:	Grid
Wellbore:	OH	Survey Calculation Method:	Minimum Curvature
Design:	OH	Database:	PEDM

Project	Lea County, NM (NAD 83 NME)		
Map System:	US State Plane 1983	System Datum:	Mean Sea Level
Geo Datum:	North American Datum 1983		
Map Zone:	New Mexico Eastern Zone		

Site	Ruthless 11 Fed Com		
Site Position:		Northing:	419,142.00 usft
From:	Map	Easting:	752,042.00 usft
Position Uncertainty:	0.0 usft	Slot Radius:	13-3/16 "
		Latitude:	32° 9' 1.687 N
		Longitude:	103° 39' 9.029 W

Well	#728H		
Well Position	+N/-S	0.0 usft	Northing:
	+E/-W	0.0 usft	Easting:
Position Uncertainty	0.0 usft	Wellhead Elevation:	usft
Grid Convergence:	0.36 °	Latitude:	32° 9' 1.488 N
		Longitude:	103° 38' 59.760 W
		Ground Level:	3,498.0 usft

Wellbore	OH				
Magnetics	Model Name	Sample Date	Declination (°)	Dip Angle (°)	Field Strength (nT)
	IGRF2020	5/5/2023	6.35	59.76	47,245.21793207

Design	OH				
Audit Notes:					
Version:	1.0	Phase:	ACTUAL	Tie On Depth:	0.0
Vertical Section:	Depth From (TVD) (usft)	+N/-S (usft)	+E/-W (usft)	Direction (°)	
	12,362.0	0.0	0.0	181.01	

Survey Program	Date	6/16/2023			
From (usft)	To (usft)	Survey (Wellbore)	Tool Name	Description	
200.0	22,660.0	DrilTech MWD (OH)	EOG MWD+IFR1	MWD + IFR1	

Survey										
Measured Depth (usft)	Inclination (°)	Azimuth (°)	Vertical Depth (usft)	+N/-S (usft)	+E/-W (usft)	Vertical Section (usft)	Dogleg Rate (°/100usft)	Build Rate (°/100usft)	Turn Rate (°/100usft)	
0.0	0.00	0.00	0.0	0.0	0.0	0.0	0.00	0.00	0.00	
200.0	0.18	321.23	200.0	0.2	-0.2	-0.2	0.09	0.09	0.00	
404.0	0.26	302.60	404.0	0.7	-0.8	-0.7	0.05	0.04	-9.13	
587.0	0.35	297.76	587.0	1.2	-1.6	-1.2	0.05	0.05	-2.64	
679.0	0.44	294.42	679.0	1.5	-2.2	-1.5	0.10	0.10	-3.63	
860.0	0.26	339.16	860.0	2.2	-3.0	-2.1	0.17	-0.10	24.72	
1,010.0	0.18	290.55	1,010.0	2.6	-3.3	-2.5	0.13	-0.05	-32.41	
1,120.0	0.26	139.91	1,120.0	2.4	-3.3	-2.4	0.39	0.07	-136.95	
1,210.0	0.44	86.91	1,210.0	2.3	-2.8	-2.3	0.39	0.20	-58.89	
1,301.0	1.58	4.91	1,301.0	3.6	-2.4	-3.5	1.74	1.25	-90.11	



Survey Report

Company:	Midland	Local Co-ordinate Reference:	Well #728H
Project:	Lea County, NM (NAD 83 NME)	TVD Reference:	KB = 32' @ 3530.0usft
Site:	Ruthless 11 Fed Com	MD Reference:	KB = 32' @ 3530.0usft
Well:	#728H	North Reference:	Grid
Wellbore:	OH	Survey Calculation Method:	Minimum Curvature
Design:	OH	Database:	PEDM

Survey									
Measured Depth (usft)	Inclination (°)	Azimuth (°)	Vertical Depth (usft)	+N/-S (usft)	+E/-W (usft)	Vertical Section (usft)	Dogleg Rate (°/100usft)	Build Rate (°/100usft)	Turn Rate (°/100usft)
1,391.0	2.46	354.01	1,390.9	6.7	-2.5	-6.7	1.06	0.98	-12.11
1,482.0	3.34	353.92	1,481.8	11.3	-3.0	-11.3	0.97	0.97	-0.10
1,573.0	4.13	343.55	1,572.6	17.1	-4.2	-17.0	1.14	0.87	-11.40
1,663.0	6.24	336.43	1,662.2	24.7	-7.1	-24.6	2.45	2.34	-7.91
1,754.0	7.12	337.58	1,752.6	34.4	-11.2	-34.2	0.98	0.97	1.26
1,845.0	7.39	339.95	1,842.9	45.1	-15.3	-44.9	0.44	0.30	2.60
1,935.0	7.65	341.18	1,932.1	56.2	-19.3	-55.9	0.34	0.29	1.37
2,025.0	7.74	341.80	2,021.3	67.7	-23.1	-67.3	0.14	0.10	0.69
2,116.0	7.65	342.50	2,111.5	79.3	-26.8	-78.8	0.14	-0.10	0.77
2,206.0	7.83	348.12	2,200.7	91.0	-29.9	-90.4	0.86	0.20	6.24
2,387.0	7.83	347.95	2,380.0	115.1	-35.0	-114.5	0.01	0.00	-0.09
2,568.0	8.09	345.75	2,559.2	139.5	-40.7	-138.8	0.22	0.14	-1.22
2,748.0	8.09	348.65	2,737.4	164.2	-46.3	-163.4	0.23	0.00	1.61
2,930.0	8.44	353.84	2,917.6	190.0	-50.3	-189.1	0.45	0.19	2.85
3,111.0	8.71	338.02	3,096.6	216.0	-56.8	-214.9	1.31	0.15	-8.74
3,292.0	7.91	343.90	3,275.7	240.6	-65.4	-239.4	0.64	-0.44	3.25
3,474.0	6.77	346.98	3,456.2	263.1	-71.3	-261.8	0.66	-0.63	1.69
3,654.0	6.42	347.33	3,635.0	283.3	-75.9	-281.9	0.20	-0.19	0.19
3,835.0	8.27	333.01	3,814.5	304.8	-84.0	-303.2	1.43	1.02	-7.91
4,017.0	6.86	328.96	3,994.9	325.7	-95.6	-324.0	0.83	-0.77	-2.23
4,198.0	5.72	352.61	4,174.8	343.9	-102.3	-342.1	1.55	-0.63	13.07
4,379.0	6.42	0.87	4,354.8	363.0	-103.3	-361.1	0.62	0.39	4.56
4,560.0	5.72	358.58	4,534.8	382.1	-103.4	-380.3	0.41	-0.39	-1.27
4,741.0	7.30	324.74	4,714.7	400.6	-110.2	-398.6	2.25	0.87	-18.70
4,922.0	8.09	315.16	4,894.1	419.0	-125.9	-416.7	0.83	0.44	-5.29
5,103.0	9.41	325.89	5,073.0	440.3	-143.1	-437.7	1.16	0.73	5.93
5,284.0	9.58	327.20	5,251.5	465.2	-159.6	-462.3	0.15	0.09	0.72
5,465.0	9.41	325.45	5,430.0	490.0	-176.1	-486.8	0.19	-0.09	-0.97
5,646.0	8.79	334.32	5,608.8	514.7	-190.5	-511.2	0.85	-0.34	4.90
5,827.0	6.68	334.68	5,788.1	536.7	-201.0	-533.0	1.17	-1.17	0.20
6,008.0	6.51	345.05	5,967.9	556.1	-208.2	-552.3	0.66	-0.09	5.73
6,189.0	6.51	351.38	6,147.7	576.1	-212.4	-572.3	0.40	0.00	3.50
6,370.0	6.42	348.82	6,327.6	596.2	-215.9	-592.3	0.17	-0.05	-1.41
6,551.0	5.72	342.58	6,507.6	614.7	-220.5	-610.8	0.53	-0.39	-3.45
6,732.0	5.19	338.45	6,687.8	631.0	-226.2	-626.9	0.36	-0.29	-2.28
6,913.0	4.66	336.07	6,868.1	645.3	-232.2	-641.1	0.31	-0.29	-1.31
7,094.0	2.02	10.97	7,048.8	655.2	-234.6	-650.9	1.78	-1.46	19.28
7,275.0	2.02	149.66	7,229.7	655.5	-232.4	-651.3	2.09	0.00	76.62
7,456.0	3.43	152.47	7,410.5	648.0	-228.3	-643.9	0.78	0.78	1.55
7,637.0	0.26	221.20	7,591.4	642.9	-226.0	-638.8	1.85	-1.75	37.97
7,818.0	0.26	154.32	7,772.4	642.2	-226.1	-638.1	0.16	0.00	-36.95
7,999.0	0.70	145.09	7,953.4	640.9	-225.3	-636.8	0.25	0.24	-5.10
8,180.0	0.70	191.14	8,134.4	638.9	-224.9	-634.9	0.30	0.00	25.44



Survey Report

Company:	Midland	Local Co-ordinate Reference:	Well #728H
Project:	Lea County, NM (NAD 83 NME)	TVD Reference:	KB = 32' @ 3530.0usft
Site:	Ruthless 11 Fed Com	MD Reference:	KB = 32' @ 3530.0usft
Well:	#728H	North Reference:	Grid
Wellbore:	OH	Survey Calculation Method:	Minimum Curvature
Design:	OH	Database:	PEDM

Survey									
Measured Depth (usft)	Inclination (°)	Azimuth (°)	Vertical Depth (usft)	+N/-S (usft)	+E/-W (usft)	Vertical Section (usft)	Dogleg Rate (°/100usft)	Build Rate (°/100usft)	Turn Rate (°/100usft)
8,361.0	1.14	213.38	8,315.4	636.3	-226.1	-632.3	0.31	0.24	12.29
8,542.0	1.23	227.71	8,496.3	633.5	-228.5	-629.4	0.17	0.05	7.92
8,723.0	1.32	230.96	8,677.3	630.9	-231.6	-626.7	0.06	0.05	1.80
8,904.0	1.14	241.07	8,858.2	628.7	-234.8	-624.5	0.16	-0.10	5.59
9,085.0	0.97	226.83	9,039.2	626.8	-237.5	-622.5	0.17	-0.09	-7.87
9,266.0	1.41	257.59	9,220.2	625.3	-240.8	-620.9	0.42	0.24	16.99
9,447.0	1.06	13.60	9,401.2	626.4	-242.5	-622.1	1.16	-0.19	64.09
9,628.0	0.53	290.90	9,582.1	628.3	-242.9	-624.0	0.62	-0.29	-45.69
9,807.0	0.79	237.81	9,761.1	628.0	-244.8	-623.6	0.35	0.15	-29.66
9,983.0	3.08	77.06	9,937.1	628.4	-241.2	-624.1	2.18	1.30	-91.34
10,160.0	2.02	77.24	10,113.9	630.2	-233.5	-625.9	0.60	-0.60	0.10
10,336.0	2.46	81.19	10,289.8	631.4	-226.7	-627.3	0.26	0.25	2.24
10,512.0	3.43	106.59	10,465.5	630.5	-218.0	-626.6	0.91	0.55	14.43
10,690.0	1.93	113.27	10,643.3	627.8	-210.1	-624.0	0.86	-0.84	3.75
10,866.0	0.53	21.08	10,819.3	627.4	-207.1	-623.6	1.15	-0.80	-52.38
11,042.0	0.62	11.58	10,995.3	629.1	-206.6	-625.3	0.07	0.05	-5.40
11,218.0	1.58	249.94	11,171.3	629.2	-208.7	-625.4	1.12	0.55	-69.11
11,394.0	2.64	259.87	11,347.1	627.6	-215.0	-623.7	0.63	0.60	5.64
11,571.0	3.17	263.04	11,523.9	626.3	-223.8	-622.3	0.31	0.30	1.79
11,747.0	2.64	249.77	11,699.7	624.3	-232.5	-620.1	0.48	-0.30	-7.54
11,792.0	2.46	238.96	11,744.6	623.5	-234.3	-619.2	1.14	-0.40	-24.02
11,922.0	2.90	229.80	11,874.5	619.9	-239.2	-615.6	0.47	0.34	-7.05
11,977.0	4.99	197.59	11,929.4	616.7	-241.0	-612.4	5.40	3.80	-58.55
KOP 11977.0' MD, 11929.4' TVD, 4.99° INC, 616.7' N/S, -241.0' E/W.									
12,012.0	6.68	189.11	11,964.2	613.3	-241.7	-608.9	5.40	4.82	-24.24
12,103.0	20.31	172.67	12,052.5	592.3	-240.6	-587.9	15.41	14.98	-18.07
12,136.0	23.86	172.02	12,083.1	580.0	-238.9	-575.7	10.80	10.77	-1.96
Hardline Crossing 12136.0' MD, 12083.1' TVD, 23.86° INC, 580.0' N/S, -238.9' E/W.									
12,192.0	29.90	171.26	12,133.0	554.9	-235.2	-550.7	10.80	10.78	-1.36
12,283.0	36.67	175.92	12,209.0	505.3	-229.8	-501.2	7.95	7.44	5.12
12,372.0	43.44	176.89	12,277.1	448.2	-226.3	-444.2	7.64	7.61	1.09
12,460.0	51.09	173.73	12,336.8	383.9	-220.9	-379.9	9.08	8.69	-3.59
12,550.0	56.89	176.71	12,389.7	311.4	-214.9	-307.5	6.98	6.44	3.31
12,640.0	63.14	179.97	12,434.7	233.5	-212.7	-229.7	7.62	6.94	3.62
12,731.0	73.95	180.84	12,467.9	148.9	-213.3	-145.1	11.91	11.88	0.96
12,788.0	82.92	181.11	12,479.3	93.1	-214.3	-89.4	15.74	15.74	0.47
12,879.0	92.51	178.91	12,482.9	2.3	-214.3	1.4	10.81	10.54	-2.42
12,968.0	90.84	176.98	12,480.3	-86.6	-211.1	90.3	2.87	-1.88	-2.17
13,059.0	89.34	177.86	12,480.2	-177.5	-207.0	181.1	1.91	-1.65	0.97
13,149.0	87.41	176.63	12,482.7	-267.3	-202.7	270.8	2.54	-2.14	-1.37
13,239.0	86.88	176.98	12,487.2	-357.1	-197.6	360.5	0.71	-0.59	0.39
13,328.0	86.35	178.21	12,492.5	-445.8	-193.9	449.2	1.50	-0.60	1.38
13,416.0	88.99	179.97	12,496.1	-533.7	-192.5	537.0	3.60	3.00	2.00
13,505.0	87.67	180.05	12,498.7	-622.7	-192.5	626.0	1.49	-1.48	0.09



Survey Report

Company:	Midland	Local Co-ordinate Reference:	Well #728H
Project:	Lea County, NM (NAD 83 NME)	TVD Reference:	KB = 32' @ 3530.0usft
Site:	Ruthless 11 Fed Com	MD Reference:	KB = 32' @ 3530.0usft
Well:	#728H	North Reference:	Grid
Wellbore:	OH	Survey Calculation Method:	Minimum Curvature
Design:	OH	Database:	PEDM

Survey									
Measured Depth (usft)	Inclination (°)	Azimuth (°)	Vertical Depth (usft)	+N/-S (usft)	+E/-W (usft)	Vertical Section (usft)	Dogleg Rate (°/100usft)	Build Rate (°/100usft)	Turn Rate (°/100usft)
13,593.0	91.98	182.25	12,498.9	-710.7	-194.3	714.0	5.50	4.90	2.50
13,683.0	89.60	179.70	12,497.7	-800.6	-195.8	803.9	3.88	-2.64	-2.83
13,773.0	89.08	179.70	12,498.7	-890.6	-195.4	893.9	0.58	-0.58	0.00
13,862.0	89.78	179.88	12,499.6	-979.6	-195.0	982.9	0.81	0.79	0.20
13,953.0	90.66	180.49	12,499.3	-1,070.6	-195.3	1,073.9	1.18	0.97	0.67
14,043.0	91.89	180.93	12,497.3	-1,160.6	-196.4	1,163.9	1.45	1.37	0.49
14,132.0	91.36	181.37	12,494.7	-1,249.5	-198.2	1,252.8	0.77	-0.60	0.49
14,222.0	91.45	181.63	12,492.5	-1,339.5	-200.6	1,342.8	0.31	0.10	0.29
14,310.0	90.22	179.18	12,491.2	-1,427.4	-201.2	1,430.8	3.11	-1.40	-2.78
14,399.0	92.86	178.56	12,488.8	-1,516.4	-199.5	1,519.7	3.05	2.97	-0.70
14,486.0	90.75	179.61	12,486.1	-1,603.3	-198.1	1,606.6	2.71	-2.43	1.21
14,575.0	87.85	179.88	12,487.2	-1,692.3	-197.7	1,695.5	3.27	-3.26	0.30
14,664.0	87.49	180.84	12,490.8	-1,781.2	-198.2	1,784.4	1.15	-0.40	1.08
14,752.0	90.13	180.32	12,492.6	-1,869.2	-199.1	1,872.4	3.06	3.00	-0.59
14,840.0	91.98	180.67	12,491.0	-1,957.2	-199.9	1,960.4	2.14	2.10	0.40
14,929.0	91.45	181.11	12,488.4	-2,046.1	-201.3	2,049.4	0.77	-0.60	0.49
15,017.0	88.90	178.21	12,488.1	-2,134.1	-200.7	2,137.3	4.39	-2.90	-3.30
15,106.0	88.02	177.94	12,490.5	-2,223.0	-197.8	2,226.2	1.03	-0.99	-0.30
15,195.0	90.13	178.38	12,491.9	-2,312.0	-194.9	2,315.0	2.42	2.37	0.49
15,285.0	88.46	176.89	12,493.0	-2,401.9	-191.2	2,404.9	2.49	-1.86	-1.66
15,374.0	90.31	180.23	12,494.0	-2,490.8	-188.9	2,493.8	4.29	2.08	3.75
15,463.0	89.87	180.14	12,493.8	-2,579.8	-189.2	2,582.8	0.50	-0.49	-0.10
15,552.0	91.98	181.37	12,492.4	-2,668.8	-190.4	2,671.7	2.74	2.37	1.38
15,641.0	91.63	181.20	12,489.6	-2,757.7	-192.4	2,760.7	0.44	-0.39	-0.19
15,729.0	91.19	181.11	12,487.4	-2,845.7	-194.2	2,848.7	0.51	-0.50	-0.10
15,819.0	92.33	181.46	12,484.7	-2,935.6	-196.2	2,938.6	1.32	1.27	0.39
15,910.0	92.07	181.72	12,481.2	-3,026.5	-198.7	3,029.5	0.40	-0.29	0.29
16,001.0	91.19	180.93	12,478.6	-3,117.5	-200.8	3,120.5	1.30	-0.97	-0.87
16,091.0	91.45	180.14	12,476.5	-3,207.4	-201.7	3,210.5	0.92	0.29	-0.88
16,182.0	91.28	180.23	12,474.3	-3,298.4	-202.0	3,301.4	0.21	-0.19	0.10
16,272.0	92.42	181.02	12,471.4	-3,388.3	-202.9	3,391.4	1.54	1.27	0.88
16,362.0	93.03	181.28	12,467.2	-3,478.2	-204.7	3,481.3	0.74	0.68	0.29
16,453.0	91.98	180.58	12,463.2	-3,569.1	-206.2	3,572.2	1.39	-1.15	-0.77
16,544.0	91.63	180.67	12,460.3	-3,660.1	-207.2	3,663.2	0.40	-0.38	0.10
16,634.0	89.78	180.32	12,459.2	-3,750.1	-208.0	3,753.1	2.09	-2.06	-0.39
16,725.0	93.65	179.61	12,456.5	-3,841.0	-207.9	3,844.1	4.32	4.25	-0.78
16,815.0	92.59	178.91	12,451.6	-3,930.9	-206.8	3,933.9	1.41	-1.18	-0.78
16,906.0	92.95	178.82	12,447.2	-4,021.7	-205.0	4,024.7	0.41	0.40	-0.10
16,997.0	92.33	178.91	12,443.0	-4,112.6	-203.2	4,115.6	0.69	-0.68	0.10
17,087.0	92.24	180.05	12,439.4	-4,202.5	-202.3	4,205.4	1.27	-0.10	1.27
17,177.0	89.43	179.18	12,438.1	-4,292.5	-201.7	4,295.4	3.27	-3.12	-0.97
17,269.0	89.78	179.88	12,438.7	-4,384.5	-201.0	4,387.4	0.85	0.38	0.76
17,359.0	89.69	179.53	12,439.2	-4,474.5	-200.5	4,477.3	0.40	-0.10	-0.39



Survey Report

Company:	Midland	Local Co-ordinate Reference:	Well #728H
Project:	Lea County, NM (NAD 83 NME)	TVD Reference:	KB = 32' @ 3530.0usft
Site:	Ruthless 11 Fed Com	MD Reference:	KB = 32' @ 3530.0usft
Well:	#728H	North Reference:	Grid
Wellbore:	OH	Survey Calculation Method:	Minimum Curvature
Design:	OH	Database:	PEDM

Survey										
Measured Depth (usft)	Inclination (°)	Azimuth (°)	Vertical Depth (usft)	+N/-S (usft)	+E/-W (usft)	Vertical Section (usft)	Dogleg Rate (°/100usft)	Build Rate (°/100usft)	Turn Rate (°/100usft)	
17,450.0	90.13	179.18	12,439.3	-4,565.5	-199.5	4,568.3	0.62	0.48	-0.38	
17,540.0	91.89	179.18	12,437.7	-4,655.5	-198.2	4,658.2	1.96	1.96	0.00	
17,631.0	90.66	178.47	12,435.7	-4,746.4	-196.3	4,749.2	1.56	-1.35	-0.78	
17,722.0	93.12	177.33	12,432.7	-4,837.3	-193.0	4,840.0	2.98	2.70	-1.25	
17,813.0	93.74	178.21	12,427.2	-4,928.1	-189.5	4,930.7	1.18	0.68	0.97	
17,904.0	93.74	177.86	12,421.3	-5,018.8	-186.4	5,021.3	0.38	0.00	-0.38	
17,994.0	92.86	178.12	12,416.1	-5,108.6	-183.2	5,111.1	1.02	-0.98	0.29	
18,085.0	92.15	178.12	12,412.1	-5,199.5	-180.2	5,201.9	0.78	-0.78	0.00	
18,175.0	91.36	177.59	12,409.4	-5,289.4	-176.9	5,291.7	1.06	-0.88	-0.59	
18,266.0	92.86	178.38	12,406.0	-5,380.3	-173.7	5,382.5	1.86	1.65	0.87	
18,356.0	88.72	178.65	12,404.8	-5,470.2	-171.3	5,472.4	4.61	-4.60	0.30	
18,447.0	88.02	178.38	12,407.4	-5,561.1	-169.0	5,563.2	0.82	-0.77	-0.30	
18,537.0	89.96	179.70	12,409.0	-5,651.1	-167.5	5,653.2	2.61	2.16	1.47	
18,628.0	88.55	179.53	12,410.2	-5,742.1	-166.9	5,744.1	1.56	-1.55	-0.19	
18,718.0	91.98	179.97	12,409.7	-5,832.1	-166.5	5,834.1	3.84	3.81	0.49	
18,810.0	91.10	179.09	12,407.3	-5,924.0	-165.7	5,926.0	1.35	-0.96	-0.96	
18,900.0	90.57	178.38	12,406.0	-6,014.0	-163.7	6,016.0	0.98	-0.59	-0.79	
18,990.0	92.07	180.84	12,403.9	-6,104.0	-163.1	6,105.9	3.20	1.67	2.73	
19,081.0	92.51	181.02	12,400.2	-6,194.9	-164.6	6,196.8	0.52	0.48	0.20	
19,171.0	92.42	180.93	12,396.4	-6,284.8	-166.1	6,286.7	0.14	-0.10	-0.10	
19,262.0	92.42	180.93	12,392.5	-6,375.7	-167.6	6,377.7	0.00	0.00	0.00	
19,353.0	91.10	180.76	12,389.7	-6,466.6	-168.9	6,468.6	1.46	-1.45	-0.19	
19,443.0	89.60	180.14	12,389.2	-6,556.6	-169.6	6,558.6	1.80	-1.67	-0.69	
19,534.0	89.87	179.70	12,389.6	-6,647.6	-169.5	6,649.6	0.57	0.30	-0.48	
19,624.0	89.08	179.44	12,390.4	-6,737.6	-168.8	6,739.6	0.92	-0.88	-0.29	
19,715.0	91.19	181.28	12,390.2	-6,828.6	-169.4	6,830.5	3.08	2.32	2.02	
19,805.0	91.80	182.34	12,387.9	-6,918.5	-172.3	6,920.5	1.36	0.68	1.18	
19,896.0	93.12	183.22	12,384.0	-7,009.3	-176.7	7,011.4	1.74	1.45	0.97	
19,986.0	91.98	182.34	12,380.0	-7,099.1	-181.0	7,101.2	1.60	-1.27	-0.98	
20,076.0	92.95	183.48	12,376.1	-7,188.9	-185.6	7,191.1	1.66	1.08	1.27	
20,167.0	92.68	179.88	12,371.6	-7,279.8	-188.3	7,282.0	3.96	-0.30	-3.96	
20,257.0	92.42	179.97	12,367.6	-7,369.7	-188.1	7,371.9	0.31	-0.29	0.10	
20,348.0	91.36	178.74	12,364.6	-7,460.6	-187.1	7,462.8	1.78	-1.16	-1.35	
20,438.0	92.07	178.91	12,361.9	-7,550.6	-185.3	7,552.7	0.81	0.79	0.19	
20,528.0	90.31	179.18	12,360.1	-7,640.5	-183.8	7,642.6	1.98	-1.96	0.30	
20,619.0	90.40	178.56	12,359.5	-7,731.5	-182.0	7,733.5	0.69	0.10	-0.68	
20,709.0	88.72	178.12	12,360.2	-7,821.5	-179.4	7,823.4	1.93	-1.87	-0.49	
20,800.0	89.60	177.77	12,361.5	-7,912.4	-176.1	7,914.3	1.04	0.97	-0.38	
20,891.0	89.60	178.12	12,362.1	-8,003.3	-172.8	8,005.1	0.38	0.00	0.38	
20,981.0	89.16	177.59	12,363.1	-8,093.3	-169.5	8,095.0	0.77	-0.49	-0.59	
21,072.0	88.99	177.33	12,364.6	-8,184.2	-165.4	8,185.8	0.34	-0.19	-0.29	
21,163.0	88.72	177.24	12,366.4	-8,275.1	-161.1	8,276.6	0.31	-0.30	-0.10	
21,253.0	88.72	178.47	12,368.4	-8,365.0	-157.8	8,366.4	1.37	0.00	1.37	



Survey Report

Company:	Midland	Local Co-ordinate Reference:	Well #728H
Project:	Lea County, NM (NAD 83 NME)	TVD Reference:	KB = 32' @ 3530.0usft
Site:	Ruthless 11 Fed Com	MD Reference:	KB = 32' @ 3530.0usft
Well:	#728H	North Reference:	Grid
Wellbore:	OH	Survey Calculation Method:	Minimum Curvature
Design:	OH	Database:	PEDM

Survey										
Measured Depth (usft)	Inclination (°)	Azimuth (°)	Vertical Depth (usft)	+N/-S (usft)	+E/-W (usft)	Vertical Section (usft)	Dogleg Rate (°/100usft)	Build Rate (°/100usft)	Turn Rate (°/100usft)	
21,344.0	91.54	180.58	12,368.2	-8,455.9	-157.0	8,457.4	3.87	3.10	2.32	
21,435.0	89.52	179.35	12,367.4	-8,546.9	-157.0	8,548.4	2.60	-2.22	-1.35	
21,525.0	90.57	179.35	12,367.3	-8,636.9	-155.9	8,638.3	1.17	1.17	0.00	
21,616.0	92.33	182.07	12,365.0	-8,727.9	-157.1	8,729.3	3.56	1.93	2.99	
21,706.0	87.41	177.94	12,365.2	-8,817.8	-157.1	8,819.2	7.14	-5.47	-4.59	
21,796.0	90.04	180.76	12,367.2	-8,907.8	-156.0	8,909.2	4.28	2.92	3.13	
21,887.0	91.01	182.25	12,366.4	-8,998.8	-158.4	9,000.1	1.95	1.07	1.64	
21,977.0	92.42	183.48	12,363.7	-9,088.6	-162.9	9,090.1	2.08	1.57	1.37	
22,068.0	92.59	184.10	12,359.7	-9,179.3	-168.9	9,180.9	0.71	0.19	0.68	
22,159.0	92.59	183.13	12,355.6	-9,270.0	-174.7	9,271.7	1.06	0.00	-1.07	
22,249.0	89.78	181.20	12,353.7	-9,359.9	-178.1	9,361.6	3.79	-3.12	-2.14	
22,340.0	90.57	180.58	12,353.4	-9,450.9	-179.5	9,452.6	1.10	0.87	-0.68	
22,430.0	89.96	180.23	12,353.0	-9,540.9	-180.1	9,542.6	0.78	-0.68	-0.39	
22,521.0	89.60	179.70	12,353.4	-9,631.9	-180.1	9,633.6	0.70	-0.40	-0.58	
22,605.0	90.48	179.88	12,353.3	-9,715.9	-179.8	9,717.6	1.07	1.05	0.21	
LAST MWD Survey 22605.0' MD, 12353.3' TVD, 90.48° INC, -9715.9' N/S, -179.8' E/W.										
22,660.0	90.48	179.88	12,352.9	-9,770.9	-179.6	9,772.6	0.00	0.00	0.00	
PTB 22660.0' MD, 12352.9' TVD, 90.48° INC, -9770.9' N/S, -179.6' E/W.										

Design Annotations					
Measured Depth (usft)	Vertical Depth (usft)	Local Coordinates			
		+N/-S (usft)	+E/-W (usft)	Comment	
11,977.0	11,929.4	616.7	-241.0	KOP 11977.0' MD, 11929.4' TVD, 4.99° INC, 616.7' N/S, -241.0' E/W.	
12,136.0	12,083.1	580.0	-238.9	Hardline Crossing 12136.0' MD, 12083.1' TVD, 23.86° INC, 580.0' N/S, -238.9' E/W.	
22,605.0	12,353.3	-9,715.9	-179.8	LAST MWD Survey 22605.0' MD, 12353.3' TVD, 90.48° INC, -9715.9' N/S, -179.8' E/W.	
22,660.0	12,352.9	-9,770.9	-179.6	PTB 22660.0' MD, 12352.9' TVD, 90.48° INC, -9770.9' N/S, -179.6' E/W.	

Checked By: _____ Approved By: _____ Date: _____

I CERTIFY THIS SURVEY TO BE TRUE AND CORRECT TO THE BEST OF MY BELIEF AND KNOWLEDGE
KAY MADDOX 11/18/2023

Intent ☐ As Drilled ☐

API #		
Operator Name:	Property Name:	Well Number

Kick Off Point (KOP)

UL	Section	Township	Range	Lot	Feet	From N/S	Feet	From E/W	County
Latitude					Longitude				NAD

First Take Point (FTP)

UL	Section	Township	Range	Lot	Feet	From N/S	Feet	From E/W	County
Latitude					Longitude				NAD

Last Take Point (LTP)

UL	Section	Township	Range	Lot	Feet	From N/S	Feet	From E/W	County
Latitude					Longitude				NAD

Is this well the defining well for the Horizontal Spacing Unit? ☐Is this well an infill well? ☐

If infill is yes please provide API if available, Operator Name and well number for Defining well for Horizontal Spacing Unit.

API #		
Operator Name:	Property Name:	Well Number

KZ 06/29/2018

Submit To Appropriate District Office Two Copies <u>District I</u> 1625 N. French Dr., Hobbs, NM 88240 <u>District II</u> 811 S. First St., Artesia, NM 88210 <u>District III</u> 1000 Rio Brazos Rd., Aztec, NM 87410 <u>District IV</u> 1220 S. St. Francis Dr., Santa Fe, NM 87505		State of New Mexico Energy, Minerals and Natural Resources Oil Conservation Division 1220 South St. Francis Dr. Santa Fe, NM 87505			Form C-105 Revised August 1, 2011					
WELL COMPLETION OR RECOMPLETION REPORT AND LOG								1. WELL API NO. 30-025-51184		
4. Reason for filing: ☒ COMPLETION REPORT (Fill in boxes #1 through #31 for State and Fee wells only) ☐ C-144 CLOSURE ATTACHMENT (Fill in boxes #1 through #9, #15 Date Rig Released and #32 and/or #33; attach this and the plat to the C-144 closure report in accordance with 19.15.17.13.K NMAC)								5. Lease Name or Unit Agreement Name RUTHLESS 11 FEDERAL COM		
								6. Well Number: 728H		
7. Type of Completion: ☒ NEW WELL ☐ WORKOVER ☐ DEEPENING ☐ PLUGBACK ☐ DIFFERENT RESERVOIR ☐ OTHER _____										
8. Name of Operator EOG RESOURCES INC						9. OGRID 7377				
10. Address of Operator PO BOX 2267 MIDLAND, TEXAS 79702						11. Pool name or Wildcat WC025 G09 S253309P; UPPER WOLFCAMP				
12. Location	Unit Ltr	Section	Township	Range	Lot	Feet from the	N/S Line	Feet from the	E/W Line	County
Surface:	D	11	25S	32E		682	NORTH	1330	WEST	LEA
BH:	M	14	25S	32E		111	SOUTH	1121	WEST	LEA
13. Date Spudded 03/24/2023	14. Date T.D. Reached 06/08/2023		15. Date Rig Released 06/10/2023			16. Date Completed (Ready to Produce) 11/20/2023		17. Elevations (DF and RKB, RT, GR, etc.) 3498' GL		
18. Total Measured Depth of Well MD 22,660' TVD 12,352'			19. Plug Back Measured Depth MD 22,637' TVD 12,352'			20. Was Directional Survey Made? YES		21. Type Electric and Other Logs Run None		
22. Producing Interval(s), of this completion - Top, Bottom, Name WOLFCAMP 12,594 - 22,637'										
23. CASING RECORD (Report all strings set in well)										
CASING SIZE		WEIGHT LB./FT.		DEPTH SET		HOLE SIZE		CEMENTING RECORD		AMOUNT PULLED
9 5/8"		40# J-55		1054'		12 1/4"		500 CL C/CIRC		
7 5/8"		29.7# ICYP 110		11,842'		8 3/4"		1715 CL C & H / CIRC		
5 1/2"		20# ICYP 110		22,645'		6 3/4"		1325 CLH TOC 8002' CBL		
24. LINER RECORD						25. TUBING RECORD				
SIZE	TOP	BOTTOM	SACKS CEMENT	SCREEN		SIZE	DEPTH SET	PACKER SET		
26. Perforation record (interval, size, and number) WOLFCAMP 12,594 - 22,637' 3 1/8", 2016 holes						27. ACID, SHOT, FRACTURE, CEMENT, SQUEEZE, ETC.				
						DEPTH INTERVAL		AMOUNT AND KIND MATERIAL USED		
						12,594 - 22,637'		FRAC W/19,858,200 proppant, 493,149 bbls load fld		
28. PRODUCTION										
Date First Production 11/20/2023		Production Method (<i>Flowing, gas lift, pumping - Size and type pump</i>) Flowing				Well Status (<i>Prod. or Shut-in</i>) Producing				
Date of Test 11/22/2023	Hours Tested 24	Choke Size	Prod'n For Test Period	Oil - Bbl 2544	Gas - MCF 7567	Water - Bbl. 5995	Gas - Oil Ratio 2975			
Flow Tubing Press.	Casing Pressure 343	Calculated 24-Hour Rate	Oil - Bbl.	Gas - MCF	Water - Bbl.	Oil Gravity - API - (<i>Corr.</i>) 48				
29. Disposition of Gas (<i>Sold, used for fuel, vented, etc.</i>) SOLD								30. Test Witnessed By		
31. List Attachments C-102, C-104, Directional Survey, H spacing										
32. If a temporary pit was used at the well, attach a plat with the location of the temporary pit.										
33. If an on-site burial was used at the well, report the exact location of the on-site burial:										
Latitude _____ Longitude _____ NAD 1927 1983										
I hereby certify that the information shown on both sides of this form is true and complete to the best of my knowledge and belief Printed Signature Kay Maddox E-mail Address kay_maddox@eogresources.com Name Kay Maddox Title Senior Regulatory Specialist Date 11/30/2023										

This form is to be filed with the appropriate District Office of the Division not later than 20 days after the completion of any newly-drilled or deepened well and not later than 60 days after completion of closure. When submitted as a completion report, this shall be accompanied by one copy of all electrical and radio-activity logs run on the well and a summary of all special tests conducted, including drill stem tests. All depths reported shall be measured depths. In the case of directionally drilled wells, true vertical depths shall also be reported. For multiple completions, items 11, 12 and 26-31 shall be reported for each zone.

Southeastern New Mexico			Northwestern New Mexico		
T. Anhy	Rustler	816'	T. Canyon	Brushy	7274'
T. Salt		1041'	T. Strawn		
B. Salt		4541'	T. Atoka		
T. Yates			T. Miss		
T. 7 Rivers			T. Devonian		
T. Queen			T. Silurian		
T. Grayburg			T. Montoya		
T. San Andres			T. Simpson		
T. Glorieta			T. McKee		
T. Paddock			T. Ellenburger		
T. Blinebry			T. Gr. Wash		
T. Tubb			T. Delaware Sand		
T. Drinkard			T. Bone Springs		
T. Abo			T. 1st BS Sand	9921'	
T. Wolfcamp	12,154		T. 2nd BS Sand	10,481'	
T. Penn			T. 3rd BS Sand	11,722'	
T. Cisco (Bough C)			T.		

No. 1, from.....to.....
No. 2, from.....to.....
No. 3, from.....to.....
No. 4, from.....to.....

Include data on rate of water inflow and elevation to which water rose in hole.

No. 1, from.....to.....feet.....
 No. 2, from.....to.....feet.....
 No. 3, from.....to.....feet.....

From	To	Thickness In Feet	Lithology

From	To	Thickness In Feet	Lithology

Sante Fe Main Office
Phone: (505) 476-3441

General Information
Phone: (505) 629-6116

Online Phone Directory
<https://www.emnrd.nm.gov/ocd/contact-us>

State of New Mexico
Energy, Minerals and Natural Resources
Oil Conservation Division
1220 S. St Francis Dr.
Santa Fe, NM 87505

ACKNOWLEDGMENTS

Action 291292

ACKNOWLEDGMENTS

Operator: EOG RESOURCES INC 5509 Champions Drive Midland, TX 79706	OGRID: 7377
	Action Number: 291292
	Action Type: [C-104] Completion Packet (C-104C)

ACKNOWLEDGMENTS

☒	I hereby certify that the required Water Use Report has been, or will be, submitted for this wells completion.
☒	I hereby certify that the required FracFocus disclosure has been, or will be, submitted for this wells completion.

Sante Fe Main Office
Phone: (505) 476-3441

General Information
Phone: (505) 629-6116

Online Phone Directory
<https://www.emnrd.nm.gov/oed/contact-us>

State of New Mexico
Energy, Minerals and Natural Resources
Oil Conservation Division
1220 S. St Francis Dr.
Santa Fe, NM 87505

CONDITIONS

Action 291292

CONDITIONS

Operator: EOG RESOURCES INC 5509 Champions Drive Midland, TX 79706	OGRID: 7377
	Action Number: 291292
	Action Type: [C-104] Completion Packet (C-104C)

CONDITIONS

Created By	Condition	Condition Date
plmartinez	None	10/10/2025