

District I
1625 N. French Dr., Hobbs, NM 88240
District II
811 S. First St., Artesia, NM 88210
District III
1000 Rio Brazos Rd., Aztec, NM 87410
District IV
1220 S. St. Francis Dr., Santa Fe, NM 87505

State of New Mexico
Energy, Minerals & Natural
Resources

Form C-104
Revised August 1, 2011

Submit one copy to appropriate District Office

Oil Conservation Division
1220 South St. Francis Dr.

☐ AMENDED REPORT

I. REQUEST FOR ALLOWABLE MINERAL AUTHORIZATION TO TRANSPORT

¹ Operator name and Address EOG RESOURCES INC PO BOX 2267 MIDLAND, TEXAS 79702		² OGRID Number 7377	
		³ Reason for Filing Code/ Effective Date NW 08/29/2022	
⁴ API Number 30 - 025-49013	⁵ Pool Name WC025 G08 S253235G; LOWER BONE SPRING		⁶ Pool Code 97903
⁷ Property Code 333279	⁸ Property Name ALMOST EDDY 30 FEDERAL		⁹ Well Number 508H

II. ¹⁰ Surface Location

Ul or lot no. I	Section 30	Township 25S	Range 32E	Lot Idn	Feet from the 2182	North/South Line SOUTH	Feet from the 725	East/West line EAST	County LEA
--------------------	---------------	-----------------	--------------	---------	-----------------------	---------------------------	----------------------	------------------------	---------------

¹¹ Bottom Hole Location

UL or lot no. P	Section 31	Township 25S	Range 32E	Lot Idn	Feet from the 111	North/South line SOUTH	Feet from the 851	East/West line EAST	County LEA
¹² Lse Code	¹³ Producing Method Code FLOWING	¹⁴ Gas Connection Date	¹⁵ C-129 Permit Number		¹⁶ C-129 Effective Date		¹⁷ C-129 Expiration Date		

III. Oil and Gas Transporters

¹⁸ Transporter OGRID	¹⁹ Transporter Name and Address	²⁰ O/G/W
372812	EOGRM	OIL
151618	ENTERPRISE FIELD SERVICES	GAS
298751	REGENCY FIELD SERVICES	GAS
36785	DCP MIDSTREAM	GAS

IV. Well Completion Data

²¹ Spud Date 05/17/2022	²² Ready Date 08/29/2022	²³ TD 18,062'	²⁴ PBTD 18,032'	²⁵ Perforations 10,598 - 18,032'	²⁶ DHC, MC
²⁷ Hole Size		²⁸ Casing & Tubing Size		²⁹ Depth Set	
16"		13 3/8"		1235'	
12 1/4"		9 5/8"		4407'	
8 3/4"		5 1/2"		18,040'	
				2540 SXS CL C & H/TOC 1528' CBL	

V. Well Test Data

³¹ Date New Oil 08/29/2022	³² Gas Delivery Date 08/29/2022	³³ Test Date 09/05/2022	³⁴ Test Length 24 HRS	³⁵ Tbg. Pressure	³⁶ Csg. Pressure 729
³⁷ Choke Size 64	³⁸ Oil 2313	³⁹ Water 10,086	⁴⁰ Gas 4165		⁴¹ Test Method
⁴² I hereby certify that the rules of the Oil Conservation Division have been complied with and that the information given above is true and complete to the best of my knowledge and belief. Signature: Kay Maddox			OIL CONSERVATION DIVISION Approved by: Title: Approval Date: 		
Printed name: Kay Maddox					
Title: SENIOR REGULATORY SPECIALIST					
E-mail Address: kay_maddox@eogresources.com					
Date: 09/20/2022		Phone: 432-638-8475			

District I
1625 N. French Dr., Hobbs, NM 88240
Phone: (575) 393-6161 Fax: (575) 393-0720
District II
811 S. First St., Artesia, NM 88210
Phone: (575) 748-1283 Fax: (575) 748-9720
District III
1000 Rio Brazos Road, Aztec, NM 87410
Phone: (505) 334-6178 Fax: (505) 334-6170
District IV
1220 S. St. Francis Dr., Santa Fe, NM 87505
Phone: (505) 476-3460 Fax: (505) 476-3462

State of New Mexico
Energy, Minerals & Natural Resources
Department
OIL CONSERVATION DIVISION
1220 South St. Francis Dr.
Santa Fe, NM 87505

FORM C-102

Revised August 1, 2011

Submit one copy to appropriate

District Office

☐ AMENDED REPORT

AS-DRILLED PLAT

¹ API Number 30-025- 49013	² Pool Code 97903	³ Pool Name WC025 G08 S253235G; LOWER BONE SPRING
⁴ Property Code 333279	⁵ Property Name ALMOST EDDY 30 FED	⁶ Well Number 508H
⁷ OGRID No. 7377	⁸ Operator Name EOG RESOURCES, INC.	⁹ Elevation 3361'

¹⁰Surface Location


UL or lot no.	Section	Township	Range	Lot Idn	Feet from the	North/South line	Feet from the	East/West line	County
I	30	25-S	32-E	-	2182'	SOUTH	725'	EAST	LEA


¹¹Bottom Hole Location If Different From Surface

UL or lot no.	Section	Township	Range	Lot Idn	Feet from the	North/South line	Feet from the	East/West line	County
P	31	25-S	32-E	-	111'	SOUTH	851'	EAST	LEA

¹² Dedicated Acres 480.00	¹³ Joint or Infill	¹⁴ Consolidation Code	¹⁵ Order No.
--	-------------------------------	----------------------------------	-------------------------

No allowable will be assigned to this completion until all interests have been consolidated or a non-standard unit has been approved by the division.

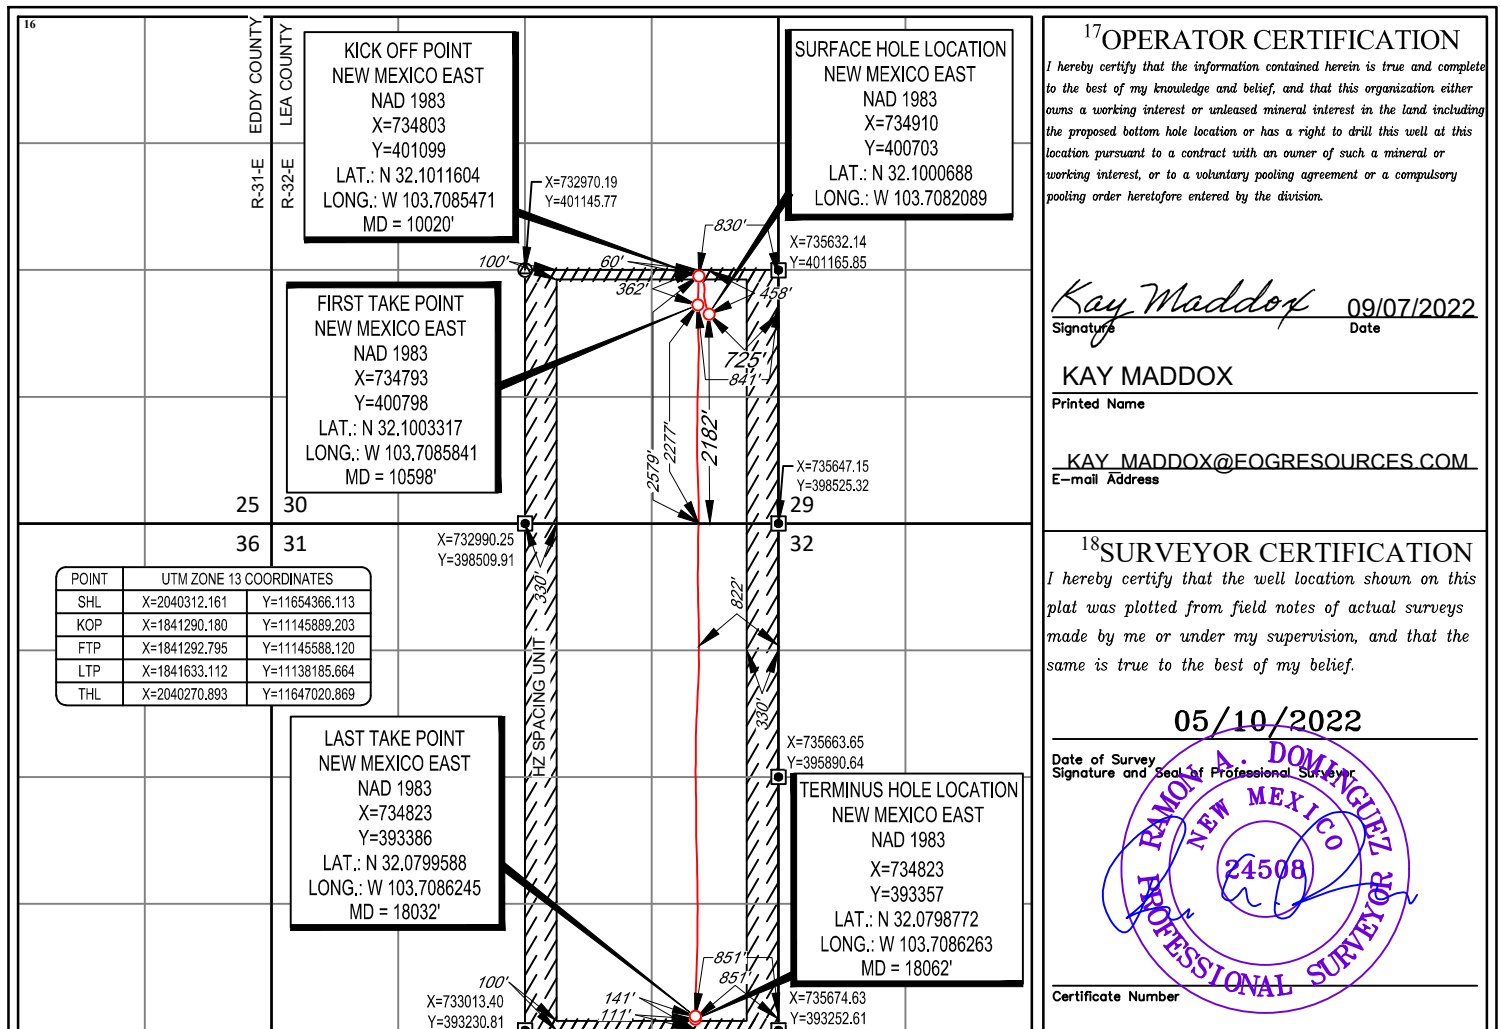

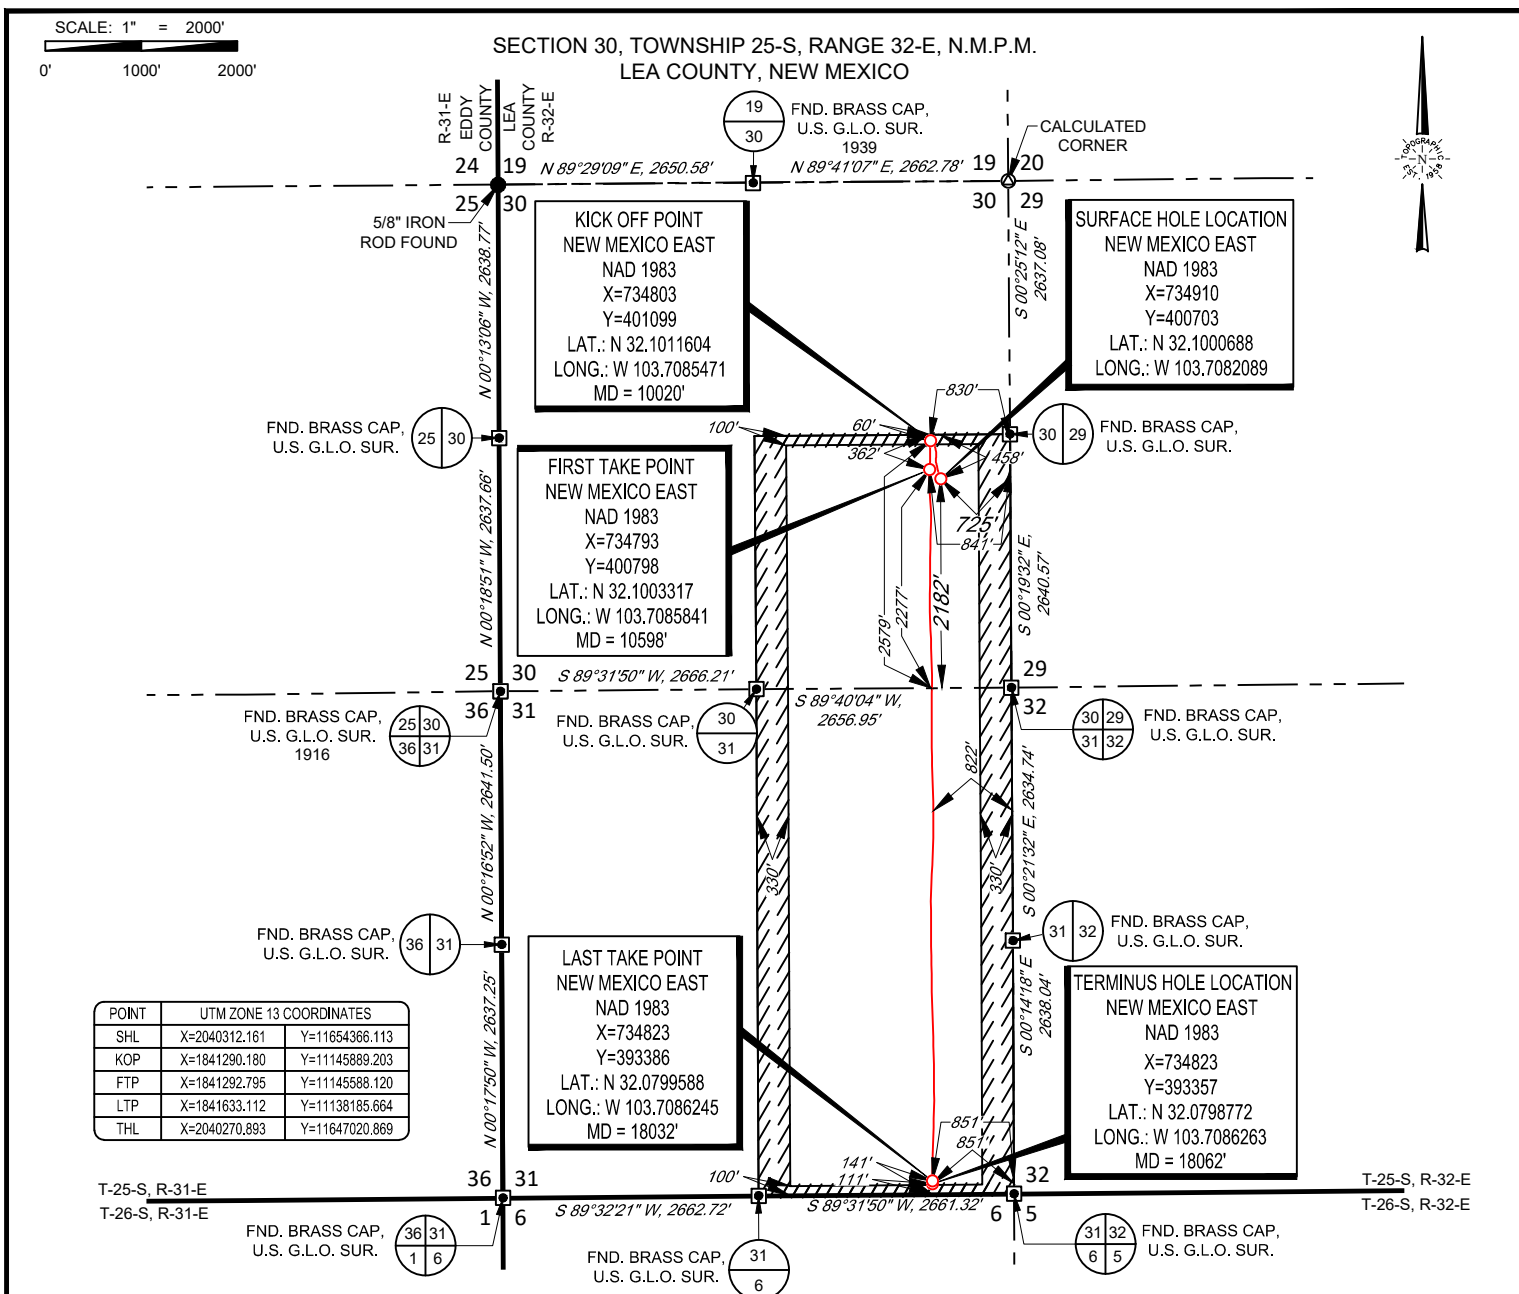

1400 EVERMAN PARKWAY, Ste. 146 • FT. WORTH, TEXAS 76140
TELEPHONE: (817) 744-7512 • FAX (817) 744-7554
2903 NORTH BIG SPRING • MIDLAND, TEXAS 79705
TELEPHONE: (432) 682-1653 OR (800) 767-1653 • FAX (432) 682-1743
WWW.TOPOGRAPHIC.COM



Ramon A. Dominguez, P.S. No. 24508
August 24, 2022

ALMOST EDDY 30 FED 508H AS-DRILLED	REVISION:		NOTES:
	INT	DATE	
DATE: 08/24/2022			1. ORIGINAL DOCUMENT SIZE: 8.5" X 11" 2. ALL BEARINGS, DISTANCES, AND COORDINATE VALUES CONTAINED HEREIN ARE GRID BASED UPON THE NEW MEXICO COORDINATE SYSTEM OF 1983, EAST ZONE, U.S. SURVEY FEET. 3. THIS WELL LOCATION SHOWN HEREON HAS BEEN SURVEYED ON THE GROUND UNDER MY SUPERVISION AND PREPARED ACCORDING TO THE EVIDENCE FOUND AT THE TIME OF SURVEY, AND DATA PROVIDED BY EOG RESOURCES, INC. THIS CERTIFICATION IS MADE AND LIMITED TO THOSE PERSONS OR ENTITIES SHOWN ON THE FACE OF THIS PLAT AND IS NON-TRANSFERABLE. THIS SURVEY IS CERTIFIED FOR THIS TRANSACTION ONLY. 4. ADJOINER INFORMATION SHOWN FOR INFORMATIONAL PURPOSES ONLY.
FILE:AD_ALMOST_EDDY_30_FED_508H			
DRAWN BY: MML			
SHEET: 2 OF 2			



Midland

Lea County, NM (NAD 83 NME)

Almost Eddy 30 Fed

#508H

OH

Design: OH

Final PVA

09 July, 2022





Final PVA



Company:	Midland	Local Co-ordinate Reference:	Well #508H
Project:	Lea County, NM (NAD 83 NME)	TVD Reference:	KB = 26' @ 3387.0usft
Site:	Almost Eddy 30 Fed	MD Reference:	KB = 26' @ 3387.0usft
Well:	#508H	North Reference:	Grid
Wellbore:	OH	Survey Calculation Method:	Minimum Curvature
Design:	OH	Database:	PEDM

Project	Lea County, NM (NAD 83 NME)		
Map System:	US State Plane 1983	System Datum:	Mean Sea Level
Geo Datum:	North American Datum 1983		
Map Zone:	New Mexico Eastern Zone		

Site	Almost Eddy 30 Fed		
Site Position:		Northing:	400,703.00 usft
From:	Map	Easting:	734,877.00 usft
Position Uncertainty:	0.0 usft	Slot Radius:	13-3/16 "
		Latitude:	32° 6' 0.251 N
		Longitude:	103° 42' 29.930 W
		Grid Convergence:	0.33 °

Well		#508H				
Well Position	+N/-S	0.0 usft	Northing:	400,703.00 usft	Latitude:	32° 6' 0.249 N
	+E/-W	0.0 usft	Easting:	734,910.00 usft	Longitude:	103° 42' 29.547 W
Position Uncertainty		0.0 usft	Wellhead Elevation:	usft	Ground Level:	3,361.0 usft

Wellbore	OH				
Magnetics	Model Name	Sample Date	Declination (°)	Dip Angle (°)	Field Strength (nT)
	IGRF2020	5/13/2022	6.49	59.74	47,312.46638228

Design	OH			
Audit Notes:				
Version:	1.0	Phase:	ACTUAL	Tie On Depth: 0.0
Vertical Section:	Depth From (TVD) (usft)	+N/-S (usft)	+E/-W (usft)	Direction (°)
	0.0	0.0	0.0	180.62

Survey Program	Date	7/9/2022		
From (usft)	To (usft)	Survey (Wellbore)	Tool Name	Description
224.0	18,063.0	Driltech MWD (OH)	EOG MWD+IFR1	MWD + IFR1



Final PVA



Company:	Midland	Local Co-ordinate Reference:	Well #508H
Project:	Lea County, NM (NAD 83 NME)	TVD Reference:	KB = 26' @ 3387.0usft
Site:	Almost Eddy 30 Fed	MD Reference:	KB = 26' @ 3387.0usft
Well:	#508H	North Reference:	Grid
Wellbore:	OH	Survey Calculation Method:	Minimum Curvature
Design:	OH	Database:	PEDM

Survey											
MD (usft)	Inc (°)	Azi (azimuth) (°)	TVD (usft)	N/S (usft)	E/W (usft)	DLeg (°/100usft)	Build (°/100usft)	Turn (°/100usft)	High to Plan (usft)	Right to Plan (usft)	
0.0	0.00	0.00	0.0	0.0	0.0	0.00	0.00	0.00	0.0	0.0	
224.0	0.44	126.75	224.0	-0.5	0.7	0.20	0.20	0.00	-0.9	0.0	
313.0	0.88	116.29	313.0	-1.0	1.6	0.51	0.49	-11.75	-1.9	-0.2	
401.0	0.79	89.48	401.0	-1.3	2.8	0.45	-0.10	-30.47	-2.8	-1.3	
488.0	1.49	59.51	488.0	-0.7	4.4	1.03	0.80	-34.45	-3.4	-2.8	
574.0	2.02	54.24	573.9	0.7	6.6	0.64	0.62	-6.13	-5.7	-3.3	
662.0	2.64	27.87	661.9	3.4	8.8	1.39	0.70	-29.97	-7.1	-6.2	
749.0	3.43	42.64	748.7	7.1	11.5	1.27	0.91	16.98	-13.0	-3.6	
815.0	2.29	43.08	814.6	9.5	13.7	1.73	-1.73	0.67	-16.3	-3.5	
847.0	1.14	22.34	846.6	10.3	14.3	4.03	-3.59	-64.81	-14.9	-9.3	
878.0	0.62	299.02	877.6	10.6	14.2	3.98	-1.68	-268.77	7.3	-16.2	
941.0	3.43	233.71	940.6	9.7	12.4	5.11	4.46	-103.67	15.7	-0.5	
1,035.0	2.64	231.78	1,034.5	6.7	8.4	0.85	-0.84	-2.05	10.8	0.0	
1,129.0	0.70	304.55	1,128.4	5.7	6.3	2.68	-2.06	77.41	1.9	-8.2	
1,179.0	1.32	308.51	1,178.4	6.2	5.6	1.25	1.24	7.92	0.5	-8.3	
1,315.0	3.08	303.50	1,314.3	9.2	1.3	1.30	1.29	-3.68	-4.0	-8.4	
1,410.0	3.52	317.03	1,409.1	12.7	-2.8	0.94	0.46	14.24	-9.4	-5.7	
1,504.0	4.04	323.89	1,502.9	17.5	-6.7	0.73	0.55	7.30	-11.3	-2.4	
1,598.0	4.48	332.68	1,596.7	23.5	-10.4	0.84	0.47	9.35	-11.3	1.2	
1,692.0	5.19	339.71	1,690.4	30.7	-13.5	0.98	0.76	7.48	-11.5	3.5	
1,787.0	5.19	345.16	1,785.0	38.9	-16.1	0.52	0.00	5.74	-12.2	4.8	
1,881.0	5.01	343.31	1,878.6	46.9	-18.4	0.26	-0.19	-1.97	-13.2	4.3	
1,975.0	5.28	346.92	1,972.2	55.1	-20.6	0.45	0.29	3.84	-13.9	4.9	
2,069.0	5.45	348.50	2,065.8	63.7	-22.4	0.24	0.18	1.68	-15.1	4.8	
2,164.0	5.36	343.75	2,160.4	72.4	-24.6	0.48	-0.09	-5.00	-16.9	3.1	
2,258.0	5.10	340.50	2,254.0	80.5	-27.2	0.42	-0.28	-3.46	-18.1	2.3	
2,352.0	5.36	344.63	2,347.6	88.7	-29.7	0.49	0.28	4.39	-19.0	3.8	



Final PVA



Company:	Midland	Local Co-ordinate Reference:	Well #508H
Project:	Lea County, NM (NAD 83 NME)	TVD Reference:	KB = 26' @ 3387.0usft
Site:	Almost Eddy 30 Fed	MD Reference:	KB = 26' @ 3387.0usft
Well:	#508H	North Reference:	Grid
Wellbore:	OH	Survey Calculation Method:	Minimum Curvature
Design:	OH	Database:	PEDM

Survey										
MD (usft)	Inc (°)	Azi (azimuth) (°)	TVD (usft)	N/S (usft)	E/W (usft)	DLeg (°/100usft)	Build (°/100usft)	Turn (°/100usft)	High to Plan (usft)	Right to Plan (usft)
2,446.0	5.89	347.44	2,441.1	97.6	-32.0	0.64	0.56	2.99	-20.6	4.4
2,541.0	6.07	349.99	2,535.6	107.3	-33.9	0.34	0.19	2.68	-22.8	4.7
2,635.0	5.89	349.20	2,629.1	117.0	-35.7	0.21	-0.19	-0.84	-25.2	3.5
2,729.0	5.63	346.39	2,722.6	126.2	-37.6	0.41	-0.28	-2.99	-27.3	1.7
2,823.0	5.45	346.92	2,816.2	135.0	-39.7	0.20	-0.19	0.56	-29.0	1.6
2,917.0	5.45	344.81	2,909.8	143.7	-41.9	0.21	0.00	-2.24	-30.5	0.2
3,011.0	5.54	347.18	3,003.3	152.4	-44.1	0.26	0.10	2.52	-32.0	1.1
3,105.0	5.36	347.36	3,096.9	161.1	-46.1	0.19	-0.19	0.19	-33.5	0.7
3,200.0	5.19	347.62	3,191.5	169.6	-48.0	0.18	-0.18	0.27	-34.7	0.4
3,294.0	5.10	353.42	3,285.1	177.9	-49.3	0.56	-0.10	6.17	-35.6	3.0
3,388.0	5.19	8.45	3,378.8	186.3	-49.2	1.43	0.10	15.99	-35.1	10.0
3,483.0	5.10	1.33	3,473.4	194.8	-48.5	0.68	-0.09	-7.49	-37.4	2.8
3,577.0	5.19	359.57	3,567.0	203.2	-48.4	0.19	0.10	-1.87	-38.7	-0.5
3,671.0	4.92	3.09	3,660.6	211.5	-48.2	0.44	-0.29	3.74	-39.9	-0.4
3,765.0	4.22	5.37	3,754.3	218.9	-47.7	0.77	-0.74	2.43	-40.5	-1.4
3,860.0	3.69	8.62	3,849.1	225.4	-46.9	0.61	-0.56	3.42	-40.2	-2.1
3,954.0	4.84	357.73	3,942.9	232.4	-46.6	1.49	1.22	-11.59	-38.8	-12.1
4,048.0	4.22	1.24	4,036.6	239.8	-46.7	0.72	-0.66	3.73	-39.7	-11.7
4,142.0	2.64	13.63	4,130.4	245.4	-46.1	1.85	-1.68	13.18	-40.4	-5.9
4,237.0	2.11	20.49	4,225.3	249.1	-45.0	0.63	-0.56	7.22	-38.7	-5.3
4,331.0	3.96	355.00	4,319.2	254.0	-44.6	2.39	1.97	-27.12	-30.2	-23.7
4,459.0	4.57	353.42	4,446.8	263.5	-45.6	0.49	0.48	-1.23	-29.0	-26.4
4,522.0	4.04	355.53	4,509.6	268.2	-46.1	0.88	-0.84	3.35	-29.8	-26.2
4,616.0	6.95	351.05	4,603.2	277.1	-47.2	3.13	3.10	-4.77	-29.2	-29.7
4,710.0	6.95	349.29	4,696.5	288.3	-49.2	0.23	0.00	-1.87	-32.3	-31.5
4,805.0	7.03	347.18	4,790.8	299.6	-51.5	0.28	0.08	-2.22	-35.2	-33.4
4,899.0	6.60	346.92	4,884.1	310.5	-54.0	0.46	-0.46	-0.28	-38.7	-34.0



Final PVA



Company:	Midland	Local Co-ordinate Reference:	Well #508H
Project:	Lea County, NM (NAD 83 NME)	TVD Reference:	KB = 26' @ 3387.0usft
Site:	Almost Eddy 30 Fed	MD Reference:	KB = 26' @ 3387.0usft
Well:	#508H	North Reference:	Grid
Wellbore:	OH	Survey Calculation Method:	Minimum Curvature
Design:	OH	Database:	PEDM

Survey											
MD (usft)	Inc (°)	Azi (azimuth) (°)	TVD (usft)	N/S (usft)	E/W (usft)	DLeg (°/100usft)	Build (°/100usft)	Turn (°/100usft)	High to Plan (usft)	Right to Plan (usft)	
4,993.0	6.24	344.28	4,977.6	320.7	-56.6	0.50	-0.38	-2.81	-40.2	-36.1	
5,087.0	5.98	343.75	5,071.0	330.3	-59.4	0.28	-0.28	-0.56	-42.4	-36.5	
5,182.0	5.98	342.70	5,165.5	339.8	-62.2	0.12	0.00	-1.11	-44.1	-37.3	
5,276.0	5.98	341.47	5,259.0	349.1	-65.2	0.14	0.00	-1.31	-45.7	-38.0	
5,369.0	5.89	344.98	5,351.5	358.3	-68.0	0.40	-0.10	3.77	-50.1	-35.1	
5,463.0	5.98	353.07	5,445.0	367.8	-69.9	0.89	0.10	8.61	-56.9	-28.3	
5,558.0	5.89	351.84	5,539.5	377.5	-71.2	0.16	-0.09	-1.29	-58.6	-30.7	
5,652.0	5.89	351.84	5,633.0	387.1	-72.5	0.00	0.00	0.00	-60.9	-31.7	
5,746.0	5.98	351.57	5,726.5	396.7	-73.9	0.10	0.10	-0.29	-63.1	-33.1	
5,840.0	5.89	350.70	5,820.0	406.3	-75.4	0.14	-0.10	-0.93	-64.9	-35.0	
5,935.0	5.54	355.53	5,914.5	415.7	-76.6	0.63	-0.37	5.08	-69.7	-30.6	
6,030.0	4.75	357.73	6,009.1	424.2	-77.1	0.86	-0.83	2.32	-72.1	-29.6	
6,124.0	3.43	358.52	6,102.9	430.9	-77.3	1.41	-1.40	0.84	-72.0	-30.5	
6,219.0	2.29	7.92	6,197.8	435.6	-77.1	1.29	-1.20	9.89	-73.8	-21.0	
6,313.0	0.44	23.74	6,291.7	437.8	-76.7	1.99	-1.97	16.83	-73.2	-4.4	
6,407.0	0.53	138.70	6,385.7	437.8	-76.3	0.87	0.10	122.30	19.8	65.4	
6,502.0	0.70	129.39	6,480.7	437.1	-75.5	0.21	0.18	-9.80	1.7	63.4	
6,596.0	0.70	117.43	6,574.7	436.5	-74.6	0.16	0.00	-12.72	-17.7	56.9	
6,690.0	0.35	192.92	6,668.7	435.9	-74.1	0.74	-0.37	80.31	44.1	35.4	
6,785.0	0.70	241.88	6,763.7	435.4	-74.7	0.57	0.37	51.54	54.0	-5.7	
6,880.0	0.70	234.93	6,858.7	434.8	-75.7	0.09	0.00	-7.32	52.8	1.9	
6,974.0	1.41	237.75	6,952.7	433.8	-77.2	0.76	0.76	3.00	51.1	-0.7	
7,069.0	1.85	246.97	7,047.6	432.6	-79.6	0.54	0.46	9.71	47.6	-8.7	
7,164.0	0.62	277.12	7,142.6	432.1	-81.5	1.42	-1.29	31.74	35.0	-30.6	
7,258.0	0.44	310.08	7,236.6	432.4	-82.3	0.37	-0.19	35.06	11.9	-44.5	
7,352.0	0.35	303.49	7,330.6	432.7	-82.8	0.11	-0.10	-7.01	16.3	-42.8	
7,447.0	0.18	236.78	7,425.6	432.8	-83.1	0.34	-0.18	-70.22	45.5	-2.2	



Final PVA



Company:	Midland	Local Co-ordinate Reference:	Well #508H
Project:	Lea County, NM (NAD 83 NME)	TVD Reference:	KB = 26' @ 3387.0usft
Site:	Almost Eddy 30 Fed	MD Reference:	KB = 26' @ 3387.0usft
Well:	#508H	North Reference:	Grid
Wellbore:	OH	Survey Calculation Method:	Minimum Curvature
Design:	OH	Database:	PEDM

Survey											
MD (usft)	Inc (°)	Azi (azimuth) (°)	TVD (usft)	N/S (usft)	E/W (usft)	DLeg (°/100usft)	Build (°/100usft)	Turn (°/100usft)	High to Plan (usft)	Right to Plan (usft)	
7,541.0	0.53	225.88	7,519.6	432.4	-83.6	0.38	0.37	-11.60	44.6	6.4	
7,635.0	0.53	243.81	7,613.6	431.9	-84.3	0.18	0.00	19.07	43.5	-7.5	
7,730.0	0.53	227.46	7,708.6	431.5	-85.0	0.16	0.00	-17.21	43.0	4.9	
7,824.0	0.53	206.46	7,802.6	430.8	-85.5	0.21	0.00	-22.34	37.5	19.8	
7,918.0	0.35	190.37	7,896.6	430.1	-85.8	0.23	-0.19	-17.12	29.9	29.3	
8,012.0	1.14	181.23	7,990.6	428.9	-85.8	0.85	0.84	-9.72	23.6	33.7	
8,106.0	1.58	192.83	8,084.6	426.7	-86.1	0.55	0.47	12.34	27.7	28.4	
8,200.0	1.49	190.55	8,178.5	424.2	-86.6	0.12	-0.10	-2.43	24.0	29.5	
8,295.0	1.85	185.63	8,273.5	421.5	-87.0	0.41	0.38	-5.18	18.6	31.3	
8,389.0	1.76	189.67	8,367.4	418.5	-87.4	0.17	-0.10	4.30	17.8	30.0	
8,483.0	1.76	195.47	8,461.4	415.7	-88.0	0.19	0.00	6.17	17.9	28.2	
8,577.0	1.58	188.00	8,555.4	413.1	-88.6	0.30	-0.19	-7.95	11.4	30.1	
8,671.0	1.41	194.59	8,649.3	410.7	-89.1	0.26	-0.18	7.01	12.3	28.8	
8,765.0	1.41	207.51	8,743.3	408.5	-89.9	0.34	0.00	13.74	16.1	25.5	
8,859.0	1.58	234.14	8,837.3	406.7	-91.5	0.75	0.18	28.33	23.5	16.1	
8,953.0	0.79	231.51	8,931.2	405.6	-93.0	0.84	-0.84	-2.80	20.8	17.1	
9,048.0	1.23	260.07	9,026.2	405.0	-94.6	0.69	0.46	30.06	24.9	5.4	
9,143.0	2.20	275.36	9,121.2	405.0	-97.4	1.12	1.02	16.09	22.6	-1.1	
9,331.0	0.79	330.12	9,309.1	406.4	-101.6	0.99	-0.75	29.13	8.8	-16.2	
9,425.0	0.62	283.89	9,403.1	407.1	-102.4	0.61	-0.18	-49.18	16.8	-5.3	
9,520.0	0.70	216.92	9,498.1	406.8	-103.3	0.77	0.08	-70.49	10.7	12.9	
9,708.0	1.41	216.30	9,686.1	404.0	-105.3	0.38	0.38	-0.33	7.1	13.0	
9,802.0	1.41	190.46	9,780.1	401.9	-106.2	0.67	0.00	-27.49	-1.5	14.3	
9,952.0	1.32	185.28	9,930.0	398.4	-106.7	0.10	-0.06	-3.45	-6.4	13.9	
10,020.0	1.86	191.30	9,998.0	396.5	-107.0	0.84	0.80	8.85	-6.7	14.6	
KOP, MD:10020.0', TVD:9998.0', N/S:396.5', E/W:-107.0', INC:1.86											
10,028.0	1.93	191.78	10,006.0	396.3	-107.1	0.84	0.81	6.04	-6.9	14.6	



Final PVA



Company:	Midland	Local Co-ordinate Reference:	Well #508H
Project:	Lea County, NM (NAD 83 NME)	TVD Reference:	KB = 26' @ 3387.0usft
Site:	Almost Eddy 30 Fed	MD Reference:	KB = 26' @ 3387.0usft
Well:	#508H	North Reference:	Grid
Wellbore:	OH	Survey Calculation Method:	Minimum Curvature
Design:	OH	Database:	PEDM

Survey										
MD (usft)	Inc (°)	Azi (azimuth) (°)	TVD (usft)	N/S (usft)	E/W (usft)	DLeg (°/100usft)	Build (°/100usft)	Turn (°/100usft)	High to Plan (usft)	Right to Plan (usft)
10,121.0	10.82	186.59	10,098.3	386.0	-108.4	9.57	9.56	-5.58	-10.6	12.8
10,216.0	23.65	184.66	10,188.9	358.1	-111.0	13.52	13.51	-2.03	-15.6	10.1
10,219.7	24.11	184.19	10,192.2	356.6	-111.1	13.35	12.32	-12.70	-16.0	9.9
FTP Crossing, MD:10219.7', TVD:10192.2', N/S:356.6', E/W:-111.1', INC:24.11										
10,310.0	35.53	176.31	10,270.5	311.8	-110.8	13.35	12.65	-8.73	-25.4	7.5
10,404.0	45.73	180.00	10,341.7	250.8	-109.0	11.14	10.85	3.93	-35.8	10.4
10,498.0	53.55	183.25	10,402.6	179.2	-111.1	8.72	8.32	3.46	-44.7	9.5
10,593.0	59.53	184.48	10,454.9	100.2	-116.5	6.39	6.29	1.29	-48.7	3.9
10,687.0	68.15	180.27	10,496.4	16.0	-119.9	10.01	9.17	-4.48	-47.7	-1.8
10,781.0	74.13	176.40	10,526.7	-72.9	-117.3	7.46	6.36	-4.12	-41.8	-0.2
10,876.0	79.84	176.22	10,548.1	-165.2	-111.3	6.01	6.01	-0.19	-28.8	5.7
10,970.0	83.10	175.34	10,562.1	-257.9	-104.5	3.59	3.47	-0.94	-14.9	12.0
11,064.0	88.37	179.47	10,569.1	-351.5	-100.2	7.11	5.61	4.39	-7.9	15.8
11,158.0	89.60	181.41	10,570.7	-445.4	-100.9	2.44	1.31	2.06	-6.2	14.6
11,253.0	89.60	181.23	10,571.4	-540.4	-103.1	0.19	0.00	-0.19	-5.6	11.9
11,347.0	90.04	180.71	10,571.7	-634.4	-104.7	0.72	0.47	-0.55	-5.3	9.8
11,441.0	90.31	181.06	10,571.4	-728.4	-106.2	0.47	0.29	0.37	-5.6	7.8
11,535.0	91.01	181.23	10,570.3	-822.4	-108.1	0.77	0.74	0.18	-6.7	5.4
11,630.0	88.46	180.79	10,570.7	-917.3	-109.7	2.72	-2.68	-0.46	-6.2	3.3
11,723.0	87.05	180.26	10,574.4	-1,010.3	-110.6	1.62	-1.52	-0.57	-2.6	1.9
11,818.0	87.49	180.09	10,578.9	-1,105.2	-110.9	0.50	0.46	-0.18	2.0	1.1
11,912.0	92.07	180.53	10,579.3	-1,199.1	-111.4	4.89	4.87	0.47	2.3	0.1
12,006.0	90.66	180.18	10,577.0	-1,293.1	-112.0	1.55	-1.50	-0.37	0.1	-0.9
12,101.0	89.25	179.03	10,577.1	-1,388.1	-111.3	1.92	-1.48	-1.21	0.1	-0.8
12,195.0	88.72	178.16	10,578.8	-1,482.0	-109.0	1.08	-0.56	-0.93	1.8	1.0
12,289.0	89.16	177.54	10,580.5	-1,576.0	-105.5	0.81	0.47	-0.66	3.5	4.0
12,384.0	89.34	177.19	10,581.8	-1,670.9	-101.1	0.41	0.19	-0.37	4.8	7.9



Final PVA



Company:	Midland	Local Co-ordinate Reference:	Well #508H
Project:	Lea County, NM (NAD 83 NME)	TVD Reference:	KB = 26' @ 3387.0usft
Site:	Almost Eddy 30 Fed	MD Reference:	KB = 26' @ 3387.0usft
Well:	#508H	North Reference:	Grid
Wellbore:	OH	Survey Calculation Method:	Minimum Curvature
Design:	OH	Database:	PEDM

Survey										
MD (usft)	Inc (°)	Azi (azimuth) (°)	TVD (usft)	N/S (usft)	E/W (usft)	DLeg (°/100usft)	Build (°/100usft)	Turn (°/100usft)	High to Plan (usft)	Right to Plan (usft)
12,478.0	89.52	178.86	10,582.7	-1,764.8	-97.9	1.79	0.19	1.78	5.7	10.7
12,573.0	89.25	178.07	10,583.7	-1,859.7	-95.3	0.88	-0.28	-0.83	6.7	12.7
12,667.0	89.08	177.28	10,585.1	-1,953.7	-91.5	0.86	-0.18	-0.84	8.1	16.0
12,761.0	89.87	179.65	10,585.9	-2,047.6	-89.0	2.66	0.84	2.52	9.0	18.0
12,856.0	92.24	181.67	10,584.2	-2,142.6	-90.1	3.28	2.49	2.13	7.2	16.4
12,950.0	90.40	180.71	10,582.0	-2,236.5	-92.0	2.21	-1.96	-1.02	5.1	14.0
13,044.0	90.66	180.00	10,581.2	-2,330.5	-92.6	0.80	0.28	-0.76	4.2	12.9
13,138.0	91.28	179.47	10,579.6	-2,424.5	-92.2	0.87	0.66	-0.56	2.6	12.8
13,233.0	89.16	180.26	10,579.2	-2,519.5	-92.0	2.38	-2.23	0.83	2.2	12.6
13,327.0	89.69	180.53	10,580.1	-2,613.5	-92.6	0.63	0.56	0.29	3.2	11.4
13,421.0	90.22	180.00	10,580.2	-2,707.5	-93.0	0.80	0.56	-0.56	3.2	10.5
13,515.0	90.40	179.04	10,579.7	-2,801.5	-92.3	1.04	0.19	-1.02	2.7	10.8
13,609.0	88.37	179.12	10,580.7	-2,895.5	-90.7	2.16	-2.16	0.09	3.7	11.8
13,703.0	88.02	178.07	10,583.7	-2,989.4	-88.4	1.18	-0.37	-1.12	6.7	13.6
13,798.0	88.55	177.19	10,586.5	-3,084.3	-84.5	1.08	0.56	-0.93	9.5	17.0
13,892.0	89.25	178.86	10,588.3	-3,178.2	-81.3	1.93	0.74	1.78	11.4	19.8
13,986.0	89.08	177.89	10,589.7	-3,272.1	-78.6	1.05	-0.18	-1.03	12.7	21.9
14,080.0	89.25	179.91	10,591.1	-3,366.1	-76.8	2.16	0.18	2.15	14.1	23.2
14,174.0	90.40	180.00	10,591.4	-3,460.1	-76.7	1.23	1.22	0.10	14.4	22.8
14,268.0	90.22	179.65	10,590.9	-3,554.1	-76.4	0.42	-0.19	-0.37	13.9	22.6
14,362.0	89.78	178.60	10,590.9	-3,648.1	-75.0	1.21	-0.47	-1.12	13.9	23.5
14,457.0	90.75	182.64	10,590.4	-3,743.1	-76.0	4.37	1.02	4.25	13.4	22.0
14,551.0	91.98	182.64	10,588.2	-3,836.9	-80.4	1.31	1.31	0.00	11.2	17.2
14,645.0	92.86	182.11	10,584.2	-3,930.8	-84.3	1.09	0.94	-0.56	7.2	12.8
14,740.0	90.22	181.85	10,581.6	-4,025.7	-87.5	2.79	-2.78	-0.27	4.7	9.0
14,834.0	87.41	182.73	10,583.6	-4,119.6	-91.3	3.13	-2.99	0.94	6.6	4.8
14,929.0	86.70	182.99	10,588.5	-4,214.3	-96.0	0.80	-0.75	0.27	11.5	-0.5



Final PVA



Company:	Midland	Local Co-ordinate Reference:	Well #508H
Project:	Lea County, NM (NAD 83 NME)	TVD Reference:	KB = 26' @ 3387.0usft
Site:	Almost Eddy 30 Fed	MD Reference:	KB = 26' @ 3387.0usft
Well:	#508H	North Reference:	Grid
Wellbore:	OH	Survey Calculation Method:	Minimum Curvature
Design:	OH	Database:	PEDM

Survey											
MD (usft)	Inc (°)	Azi (azimuth) (°)	TVD (usft)	N/S (usft)	E/W (usft)	DLeg (°/100usft)	Build (°/100usft)	Turn (°/100usft)	High to Plan (usft)	Right to Plan (usft)	
15,023.0	85.74	182.02	10,594.7	-4,308.0	-100.1	1.45	-1.02	-1.03	17.7	-5.1	
15,117.0	87.76	179.83	10,600.0	-4,401.8	-101.6	3.17	2.15	-2.33	23.0	-7.1	
15,211.0	87.67	178.51	10,603.7	-4,495.8	-100.3	1.41	-0.10	-1.40	26.8	-6.2	
15,306.0	89.69	180.53	10,605.9	-4,590.7	-99.5	3.01	2.13	2.13	29.0	-5.9	
15,400.0	89.96	180.53	10,606.2	-4,684.7	-100.4	0.29	0.29	0.00	29.2	-7.3	
15,465.0	89.96	180.53	10,606.3	-4,749.7	-101.0	0.00	0.00	0.00	29.3	-8.2	
15,494.0	89.08	179.47	10,606.5	-4,778.7	-101.0	4.75	-3.03	-3.66	29.5	-8.4	
15,589.0	89.16	178.60	10,608.0	-4,873.7	-99.4	0.92	0.08	-0.92	31.0	-7.3	
15,683.0	88.90	178.24	10,609.6	-4,967.6	-96.8	0.47	-0.28	-0.38	32.6	-5.2	
15,777.0	87.76	179.21	10,612.3	-5,061.6	-94.7	1.59	-1.21	1.03	35.3	-3.6	
15,872.0	90.48	179.74	10,613.8	-5,156.5	-93.8	2.92	2.86	0.56	36.8	-3.2	
15,966.0	91.45	179.56	10,612.2	-5,250.5	-93.2	1.05	1.03	-0.19	35.2	-3.1	
16,060.0	90.75	178.51	10,610.4	-5,344.5	-91.6	1.34	-0.74	-1.12	33.4	-2.1	
16,154.0	90.84	178.16	10,609.1	-5,438.4	-88.9	0.38	0.10	-0.37	32.1	0.2	
16,249.0	90.66	177.89	10,607.8	-5,533.4	-85.6	0.34	-0.19	-0.28	30.8	2.9	
16,342.0	90.31	176.84	10,607.0	-5,626.3	-81.4	1.19	-0.38	-1.13	30.1	6.7	
16,436.0	90.48	178.95	10,606.4	-5,720.2	-77.9	2.25	0.18	2.24	29.4	9.7	
16,531.0	88.99	179.47	10,606.8	-5,815.2	-76.6	1.66	-1.57	0.55	29.8	10.5	
16,625.0	88.02	178.60	10,609.3	-5,909.1	-75.0	1.39	-1.03	-0.93	32.3	11.6	
16,719.0	87.85	178.42	10,612.7	-6,003.1	-72.6	0.26	-0.18	-0.19	35.7	13.5	
16,814.0	88.55	178.86	10,615.7	-6,098.0	-70.3	0.87	0.74	0.46	38.7	15.3	
16,908.0	89.08	180.00	10,617.6	-6,192.0	-69.4	1.34	0.56	1.21	40.6	15.7	
17,002.0	88.46	179.91	10,619.6	-6,285.9	-69.3	0.67	-0.66	-0.10	42.6	15.3	
17,097.0	90.40	178.68	10,620.6	-6,380.9	-68.2	2.42	2.04	-1.29	43.6	16.0	
17,191.0	91.98	180.79	10,618.6	-6,474.9	-67.7	2.80	1.68	2.24	41.6	15.9	
17,285.0	93.12	181.50	10,614.4	-6,568.8	-69.6	1.43	1.21	0.76	37.4	13.5	
17,380.0	93.03	181.41	10,609.3	-6,663.6	-72.0	0.13	-0.09	-0.09	32.3	10.6	



Final PVA



Company:	Midland	Local Co-ordinate Reference:	Well #508H
Project:	Lea County, NM (NAD 83 NME)	TVD Reference:	KB = 26' @ 3387.0usft
Site:	Almost Eddy 30 Fed	MD Reference:	KB = 26' @ 3387.0usft
Well:	#508H	North Reference:	Grid
Wellbore:	OH	Survey Calculation Method:	Minimum Curvature
Design:	OH	Database:	PEDM

Survey											
MD (usft)	Inc (°)	Azi (azimuth) (°)	TVD (usft)	N/S (usft)	E/W (usft)	DLeg (°/100usft)	Build (°/100usft)	Turn (°/100usft)	High to Plan (usft)	Right to Plan (usft)	
17,474.0	92.42	181.58	10,604.9	-6,757.5	-74.4	0.67	-0.65	0.18	27.9	7.7	
17,568.0	93.39	181.14	10,600.1	-6,851.3	-76.7	1.13	1.03	-0.47	23.1	5.0	
17,663.0	91.54	181.41	10,596.0	-6,946.2	-78.8	1.97	-1.95	0.28	19.0	2.3	
17,757.0	89.87	181.58	10,594.9	-7,040.2	-81.2	1.79	-1.78	0.18	17.9	-0.6	
17,851.0	89.96	181.14	10,595.0	-7,134.1	-83.5	0.48	0.10	-0.47	18.0	-3.3	
17,945.0	91.10	180.79	10,594.1	-7,228.1	-85.1	1.27	1.21	-0.37	17.1	-5.4	
Last MWD Survey (MD=17945.0')											
18,063.0	91.10	180.79	10,591.9	-7,346.1	-86.7	0.00	0.00	0.00	14.9	-7.7	
Projection to Bit (MD=18063.0')											

Design Annotations					
Measured Depth (usft)	Vertical Depth (usft)	Local Coordinates			
		+N/-S (usft)	+E/-W (usft)	Comment	
10,020.0	9,998.0	396.5	-107.0	KOP, MD:10020.0', TVD:9998.0',N/S:396.5', E/W:-107.0', INC:1.86	
10,219.7	10,192.2	356.6	-111.1	FTP Crossing, MD:10219.7', TVD:10192.2',N/S:356.6', E/W:-111.1', INC:24.11	
17,945.0	10,594.1	-7,228.1	-85.1	Last MWD Survey (MD=17945.0')	
18,063.0	10,591.9	-7,346.1	-86.7	Projection to Bit (MD=18063.0')	

Checked By: _____ Approved By: _____ Date: _____

I CERTIFY THIS SURVEY TO BE TRUE AND CORRECT TO THE BEST OF MY BELIEF AND KNOWLEDGE
KAY MADDOX 09/06/2022



Lea County, NM (NAD 83 NME)

Almost Eddy 30 Fed #508H

Plan #1

PROJECT DETAILS: Lea County, NM (NAD 83 NME)

Geodetic System: US State Plane 1983
Datum: North American Datum 1983
Ellipsoid: GRS 1980
Zone: New Mexico Eastern Zone
System Datum: Mean Sea Level

WELL DETAILS: #508H








KB = 26' @ 3387.0usft
3361.0
Northing 400703.00 Easting 734910.00 Latitude 32° 6' 0.249 N Longitude 103° 42' 29.547 W

SECTION DETAILS

MD	Inc	Azi	TVD	+N/-S	+E/-W	Dleg	TFace	VSect	Target
0.0	0.00	0.00	0.0	0.0	0.0	0.00	0.00	0.0	
1300.0	0.00	0.00	1300.0	0.0	0.0	0.00	0.00	0.0	
1527.6	4.55	343.53	1527.3	8.7	-2.6	2.00	343.53	-8.6	
6635.0	4.55	343.53	6618.7	397.3	-117.4	0.00	0.00	-396.1	
6862.6	0.00	0.00	6846.0	406.0	-120.0	2.00	180.00	-404.7	Brushy Top(Almost Eddy 30 Fed #508H)
10020.6	0.00	0.00	10004.0	406.0	-120.0	0.00	0.00	-404.7	
10920.6	90.00	179.70	10577.0	-166.9	-117.0	10.00	179.70	168.2	
18100.7	90.00	179.70	10577.0	-7347.0	-79.0	0.00	0.00	7347.4	PBHL(Almost Eddy 30 Fed #508H)

WELLBORE TARGET DETAILS (MAP CO-ORDINATES)

Name	TVD	+N/-S	+E/-W	Northing	Easting
Brushy Top(Almost Eddy 30 Fed #508H)	6846.0	406.0	-120.0	401109.00	734790.00
FTP(Almost Eddy 30 Fed #508H)	10577.0	356.0	-120.0	401059.00	734790.00
PBHL(Almost Eddy 30 Fed #508H)	10577.0	-7347.0	-79.0	393356.00	734831.00

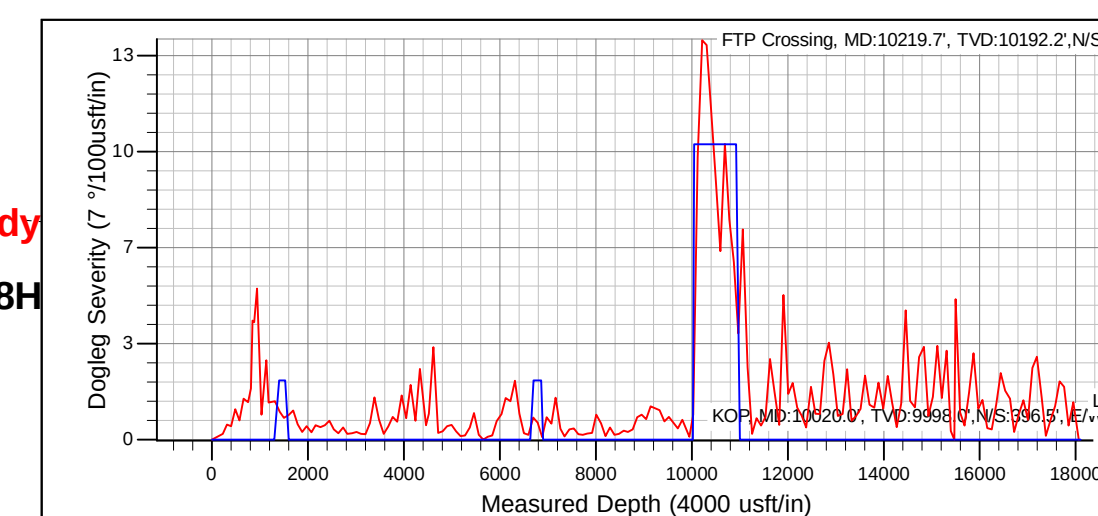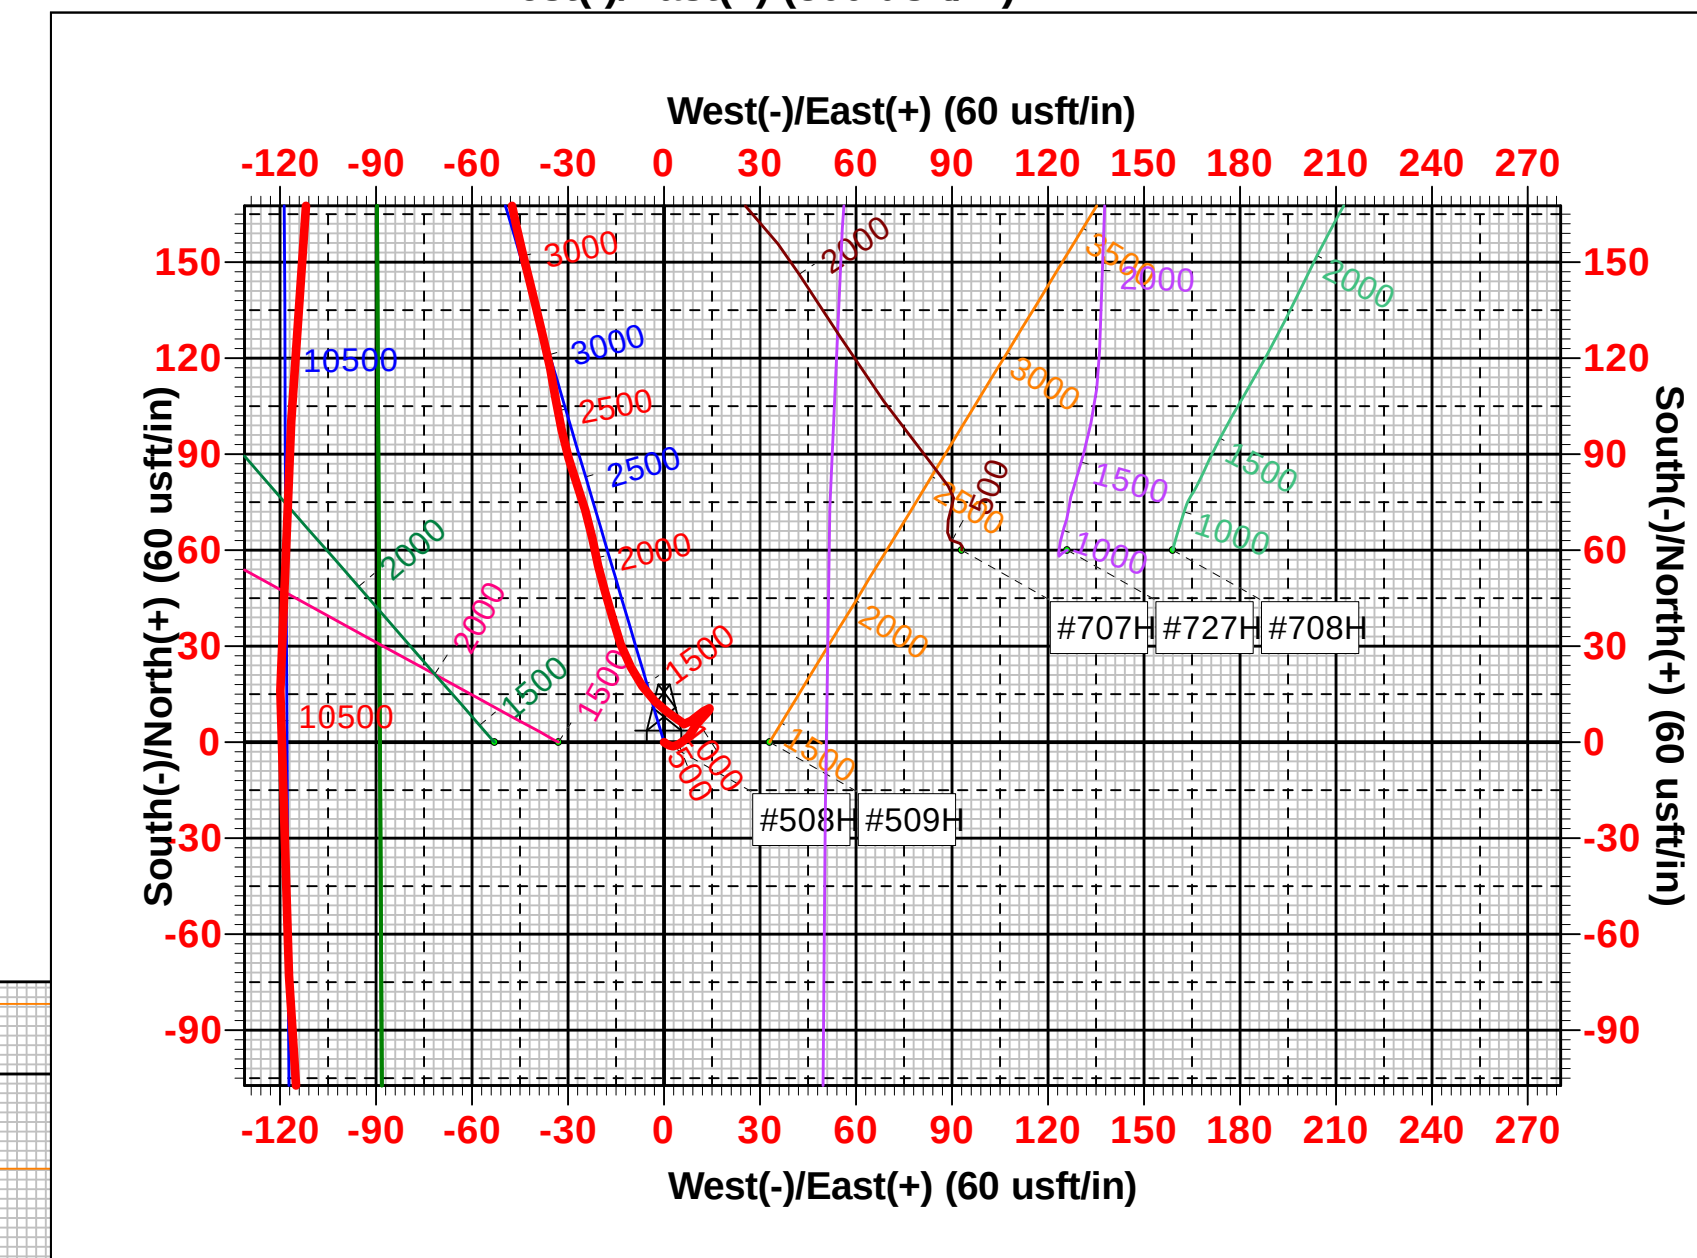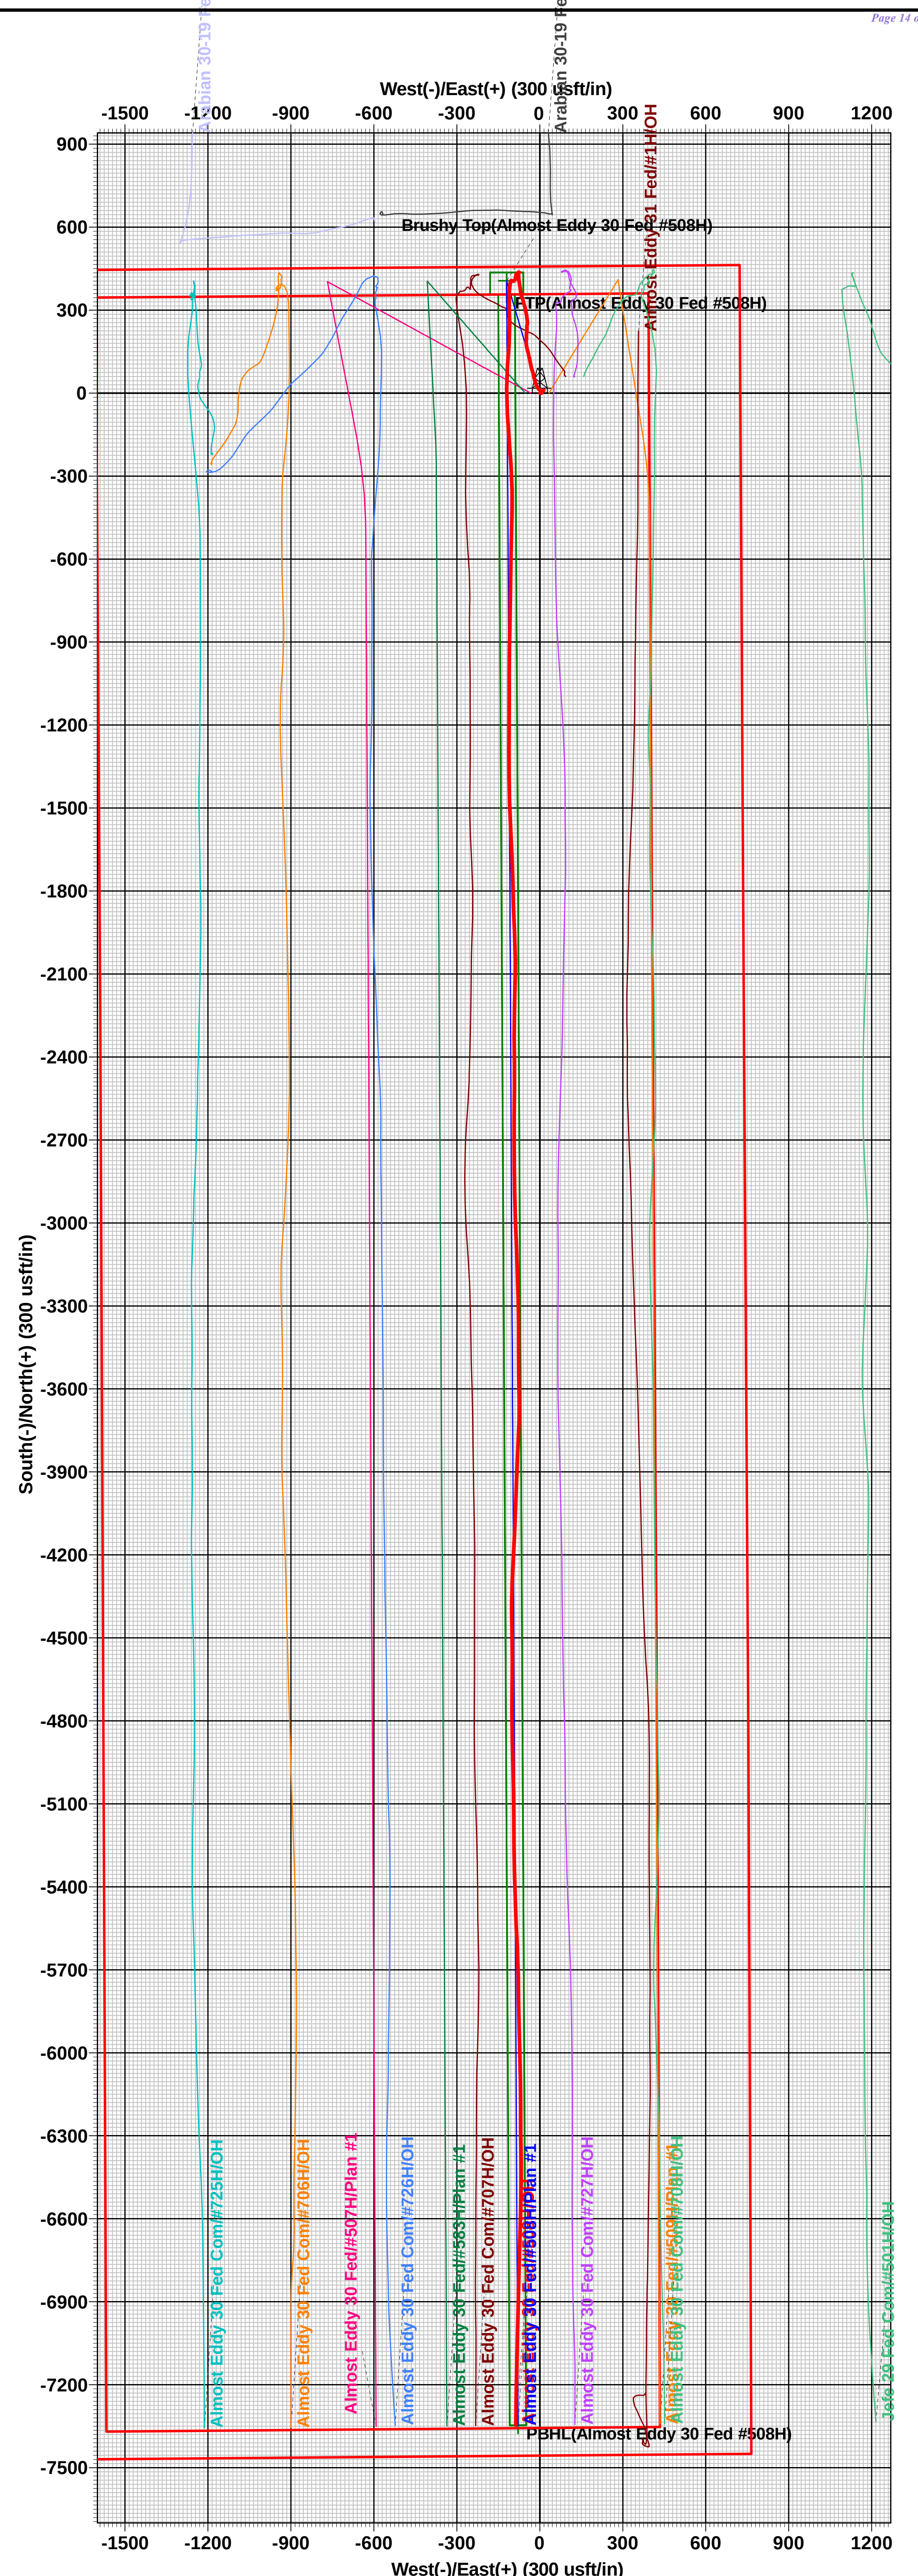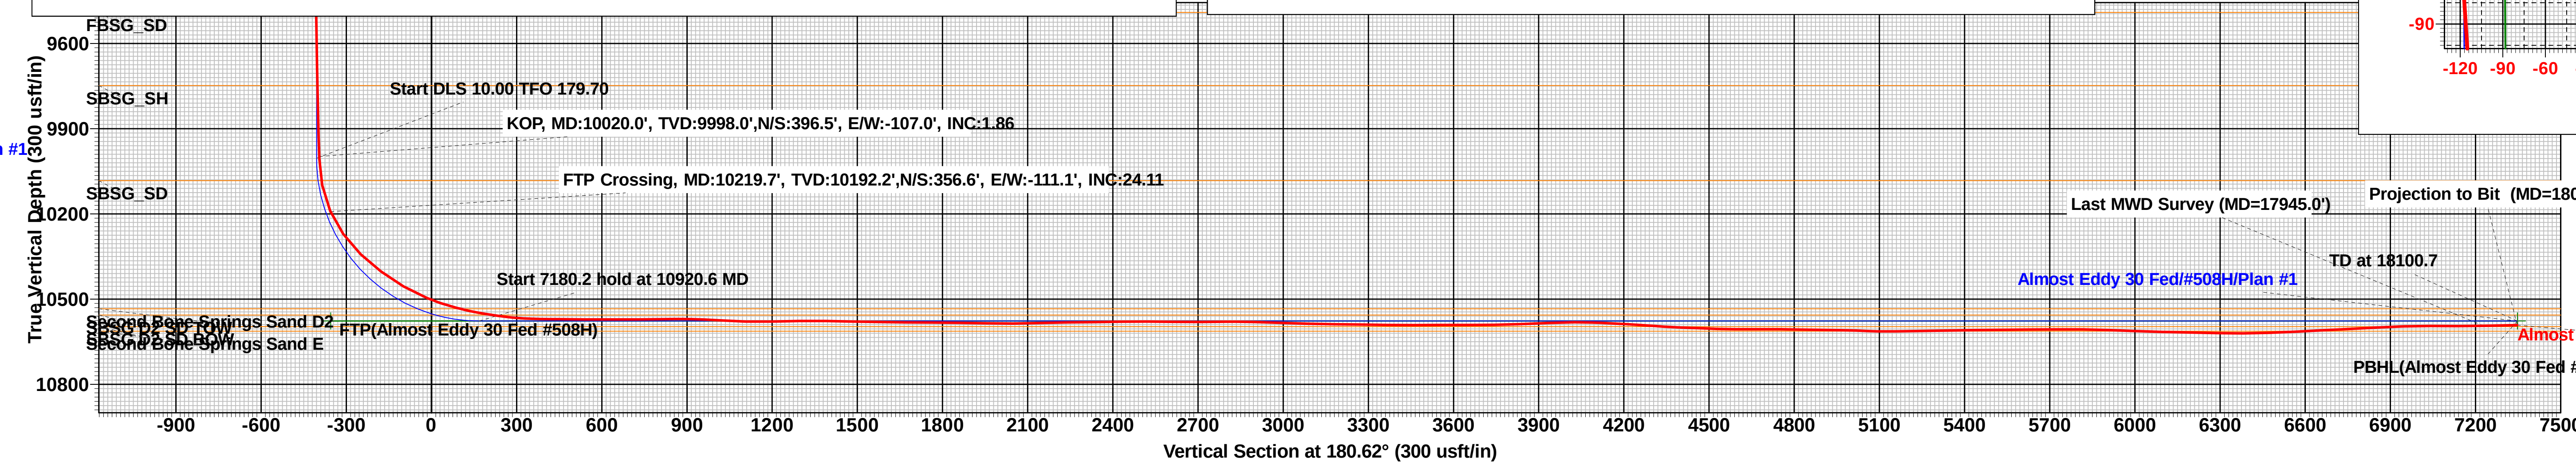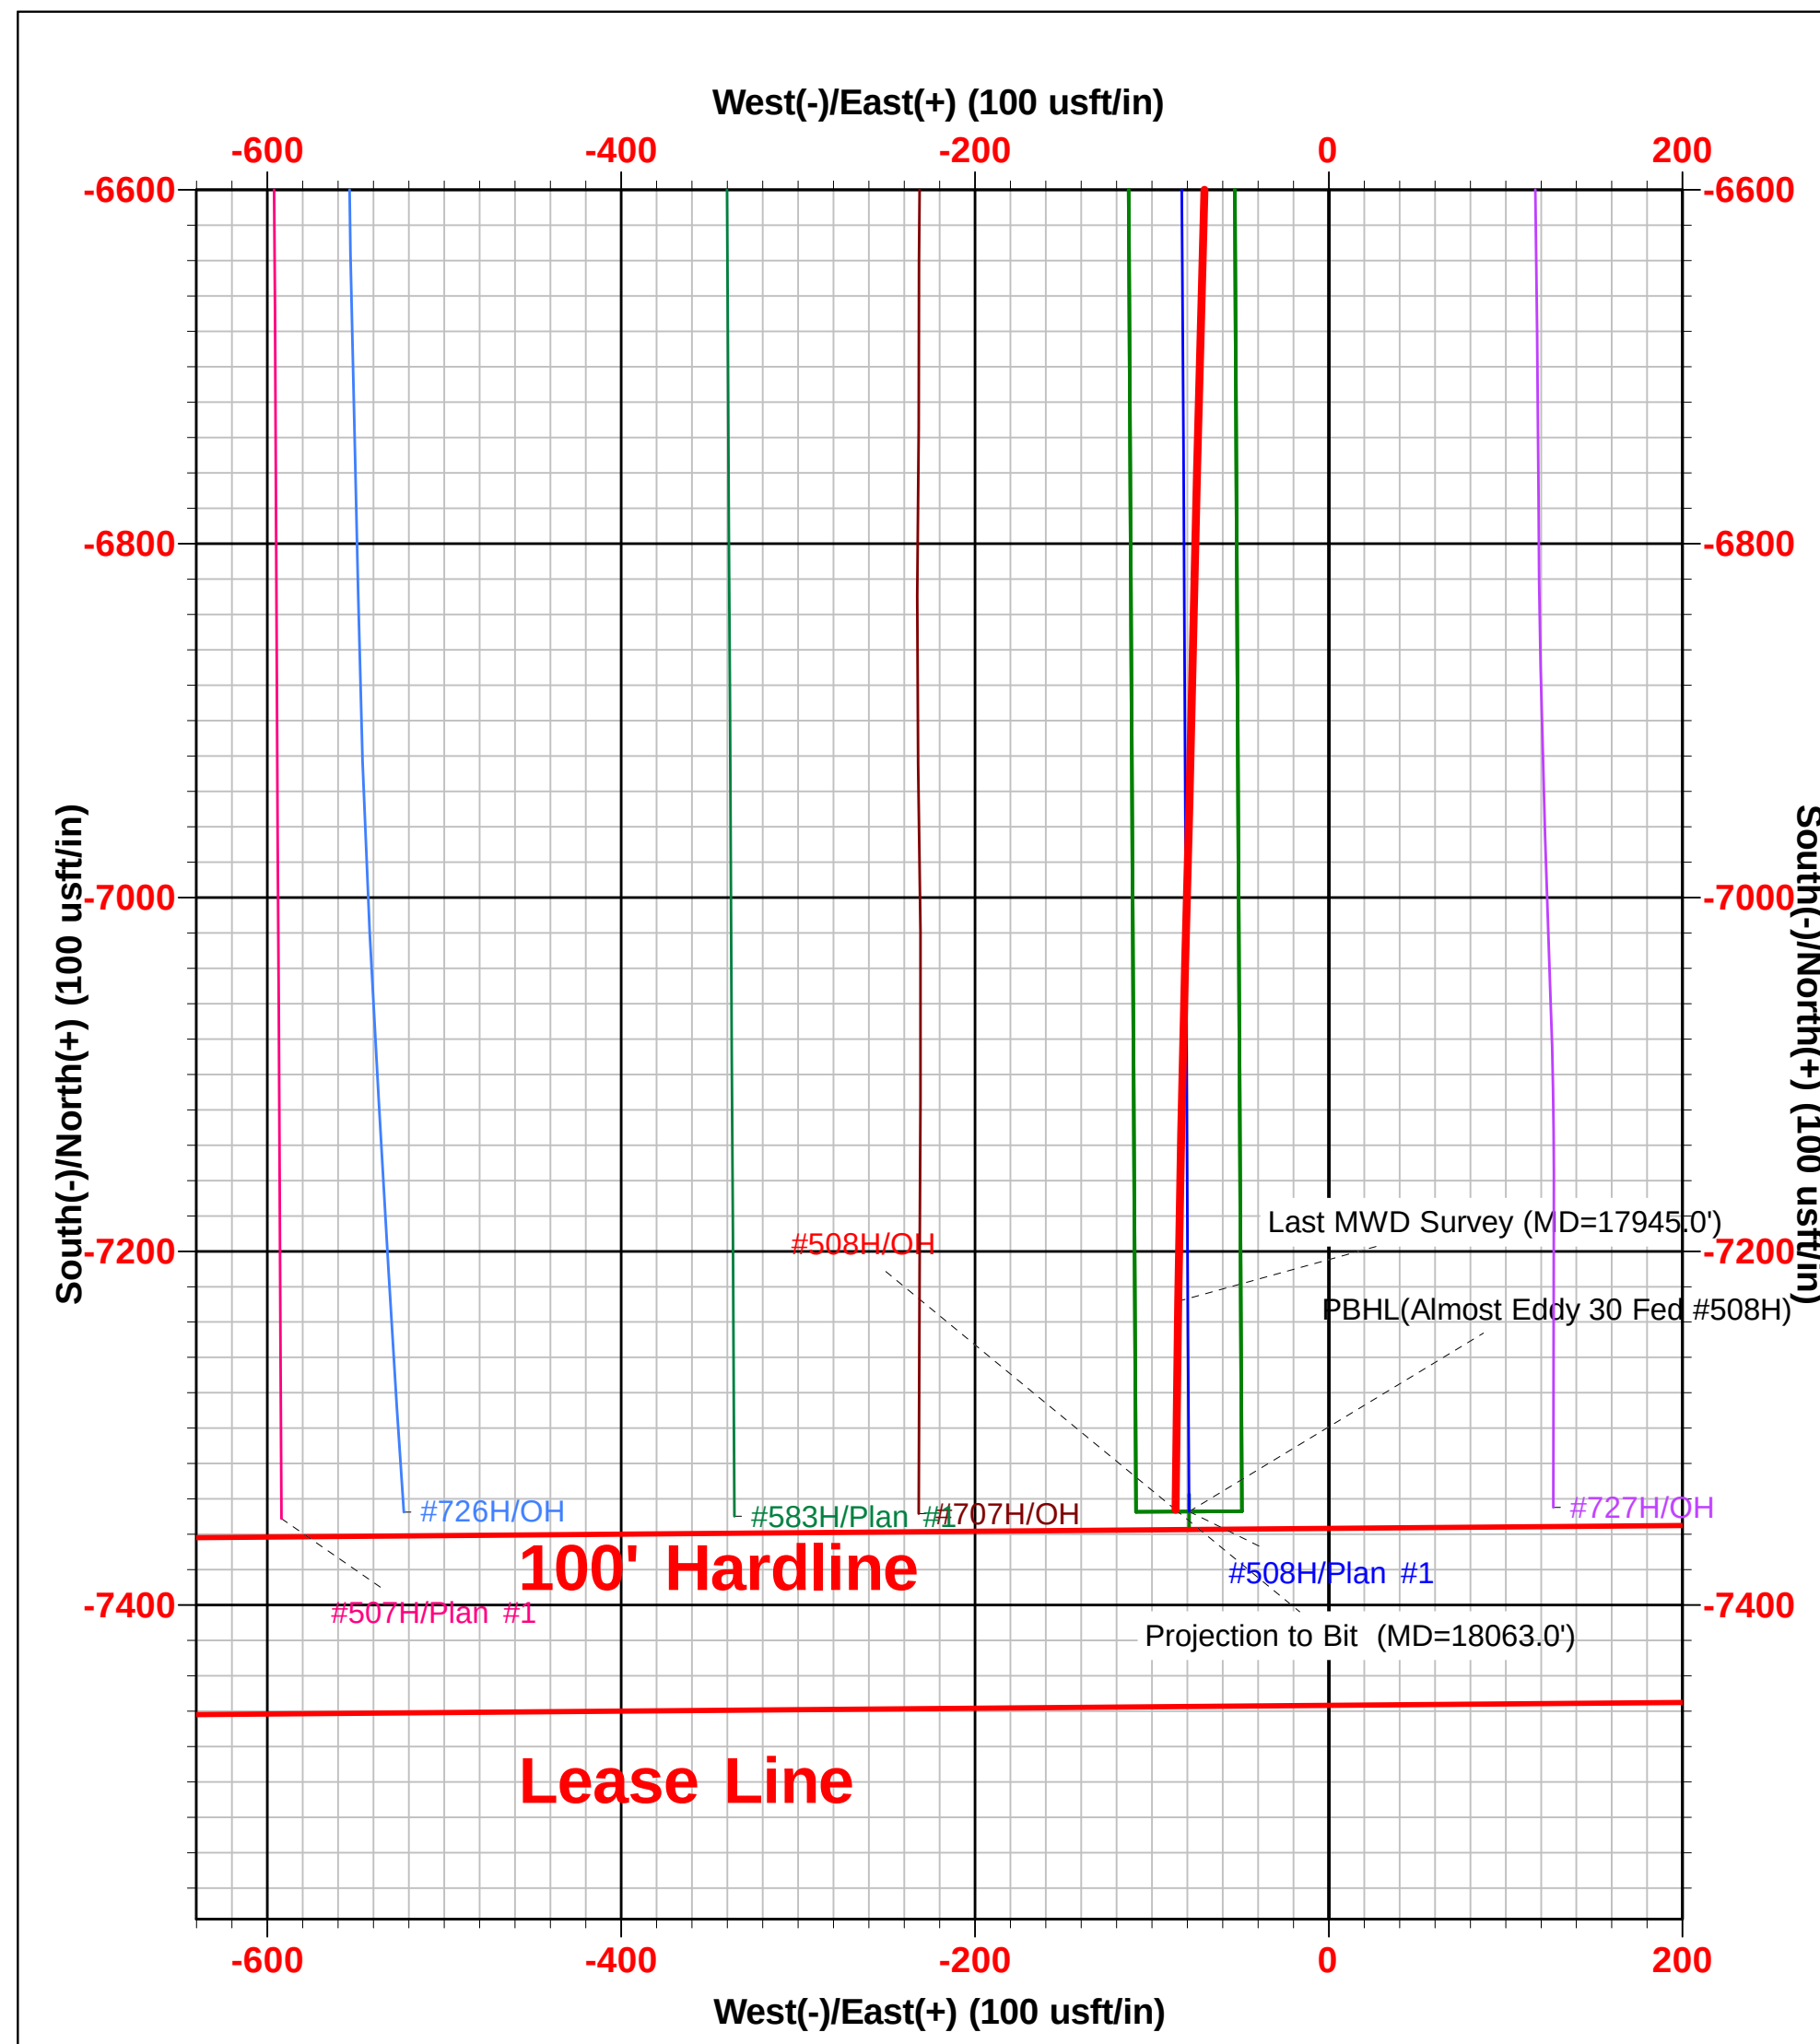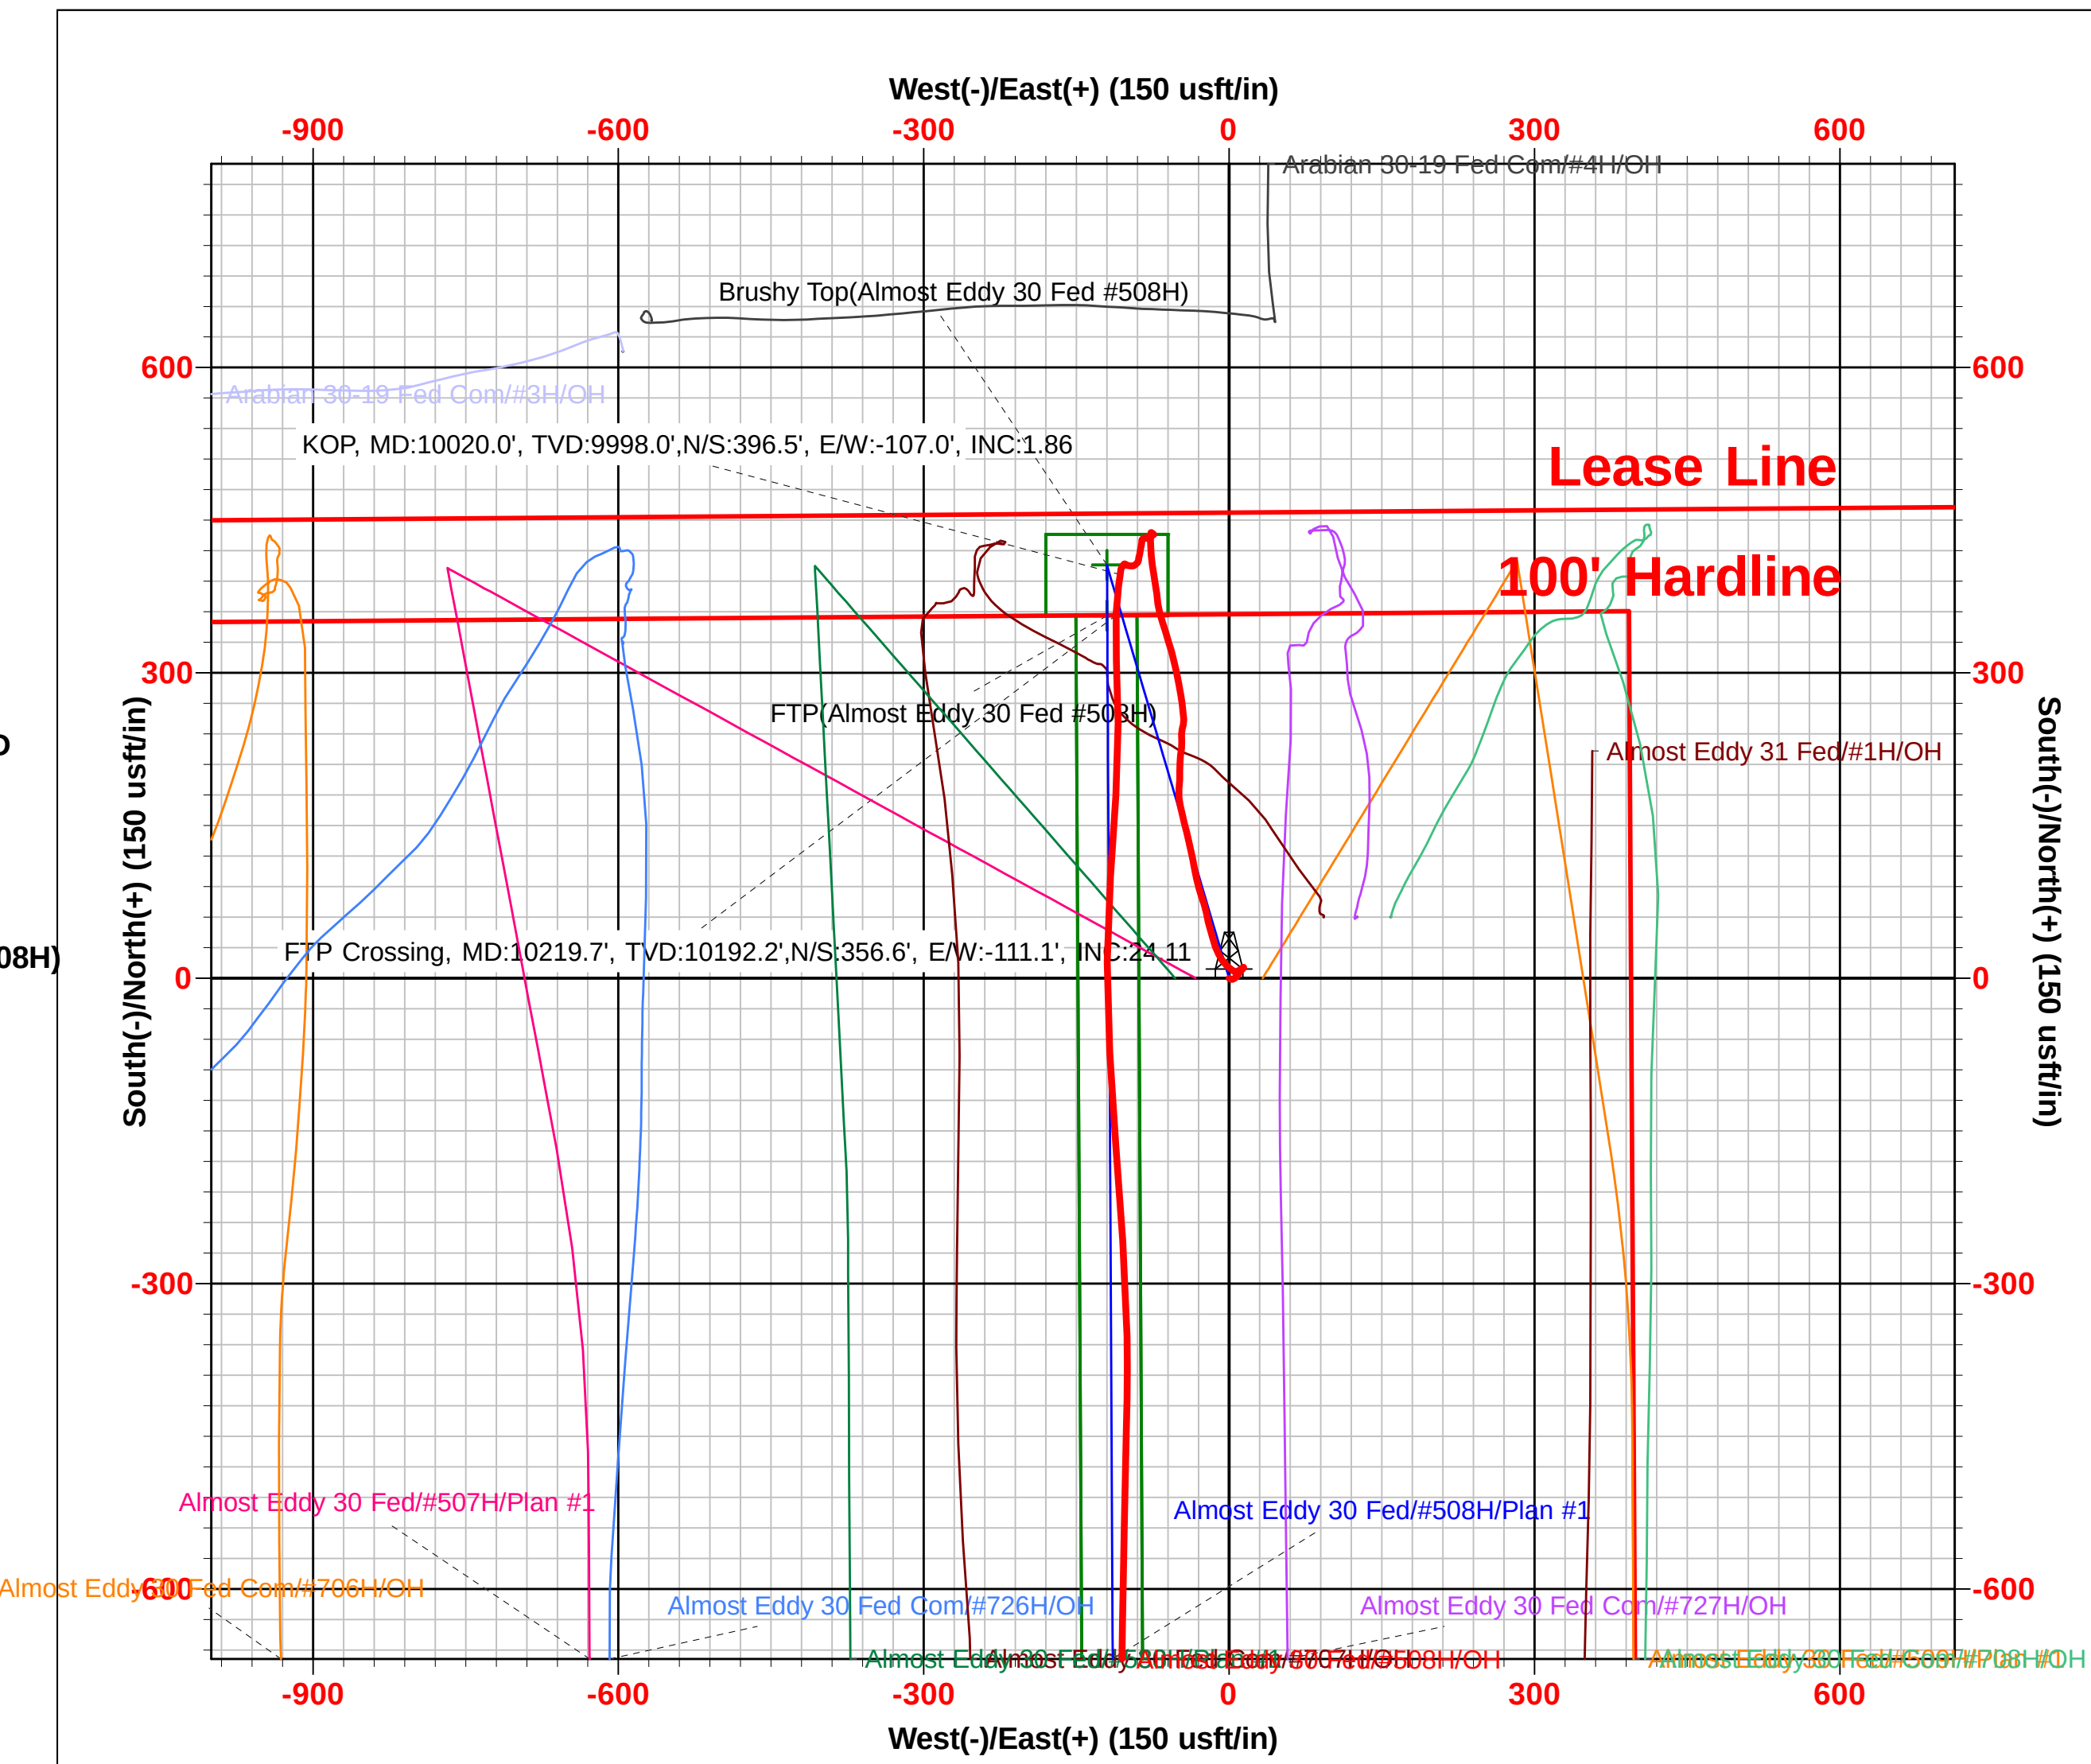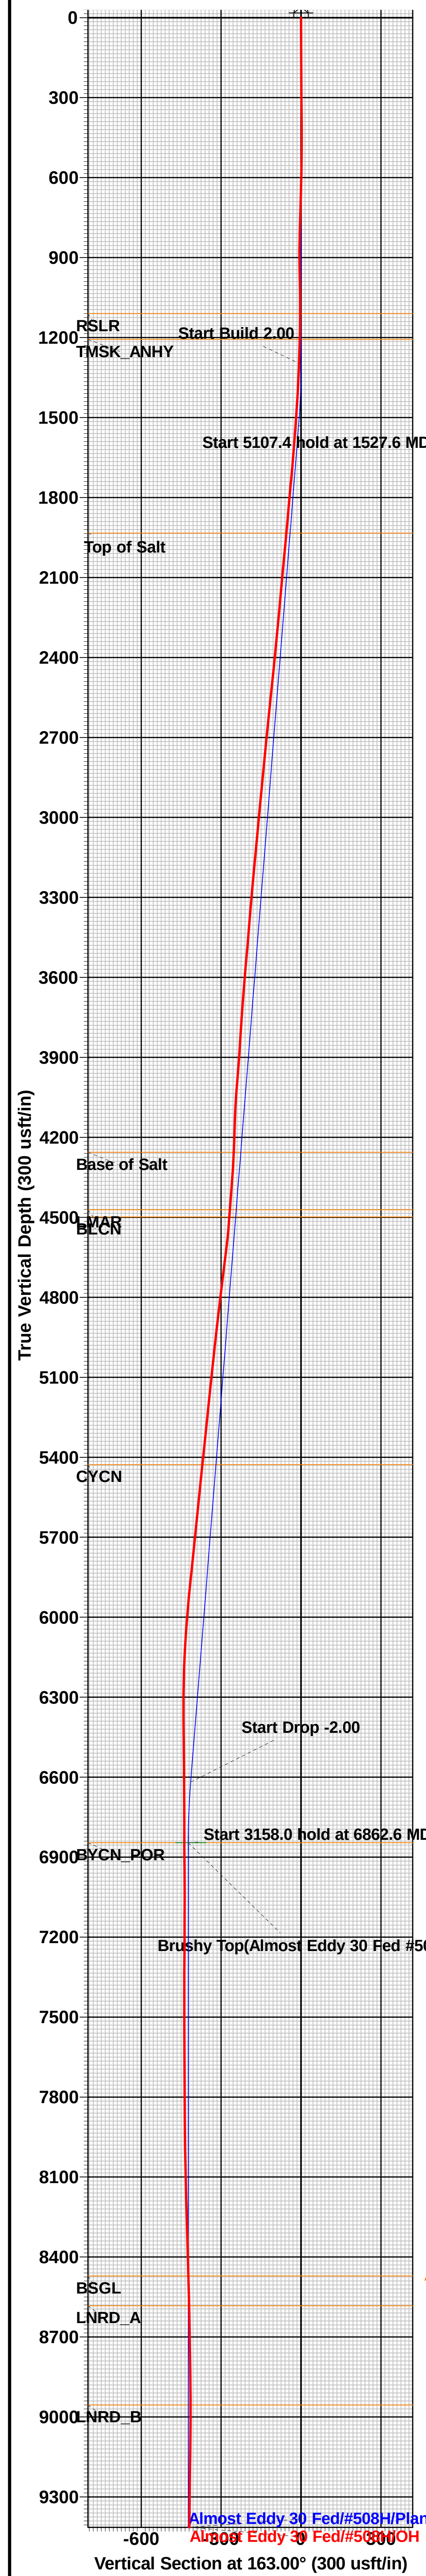

Intent ☐ As Drilled ☐

API #		
Operator Name:	Property Name:	Well Number

Kick Off Point (KOP)

UL	Section	Township	Range	Lot	Feet	From N/S	Feet	From E/W	County
Latitude					Longitude				NAD

First Take Point (FTP)

UL	Section	Township	Range	Lot	Feet	From N/S	Feet	From E/W	County
Latitude					Longitude				NAD

Last Take Point (LTP)

UL	Section	Township	Range	Lot	Feet	From N/S	Feet	From E/W	County
Latitude					Longitude				NAD

Is this well the defining well for the Horizontal Spacing Unit? ☐Is this well an infill well? ☐

If infill is yes please provide API if available, Operator Name and well number for Defining well for Horizontal Spacing Unit.

API #		
Operator Name:	Property Name:	Well Number

KZ 06/29/2018

Submit To Appropriate District Office Two Copies <u>District I</u> 1625 N. French Dr., Hobbs, NM 88240 <u>District II</u> 811 S. First St., Artesia, NM 88210 <u>District III</u> 1000 Rio Brazos Rd., Aztec, NM 87410 <u>District IV</u> 1220 S. St. Francis Dr., Santa Fe, NM 87505		State of New Mexico Energy, Minerals and Natural Resources Oil Conservation Division 1220 South St. Francis Dr. Santa Fe, NM 87505			Form C-105 Revised August 1, 2011						
WELL COMPLETION OR RECOMPLETION REPORT AND LOG											
4. Reason for filing: ☒ COMPLETION REPORT (Fill in boxes #1 through #31 for State and Fee wells only) ☐ C-144 CLOSURE ATTACHMENT (Fill in boxes #1 through #9, #15 Date Rig Released and #32 and/or #33; attach this and the plat to the C-144 closure report in accordance with 19.15.17.13.K NMAC)								5. Lease Name or Unit Agreement Name			
								ALMOST EDDY 30 FEDERAL			
								6. Well Number:			
								508H			
7. Type of Completion:											
☒ NEW WELL ☐ WORKOVER ☐ DEEPENING ☐ PLUGBACK ☐ DIFFERENT RESERVOIR ☐ OTHER _____											
8. Name of Operator							9. OGRID				
EOG RESOURCES INC							7377				
10. Address of Operator							11. Pool name or Wildcat				
PO BOX 2267 MIDLAND, TEXAS 79702							WC025 G08 S253235G; LOWER BONE SPRING (97903)				
12. Location	Unit Ltr	Section	Township	Range	Lot	Feet from the	N/S Line	Feet from the	E/W Line	County	
Surface:	I	30	25S	32E		2182	SOUTH	725	EAST	LEA	
BH:	P	31	25S	32E		111	SOUTH	851	EAST	LEA	
13. Date Spudded	14. Date T.D. Reached		15. Date Rig Released			16. Date Completed (Ready to Produce)		17. Elevations (DF and RKB, RT, GR, etc.)			
05/17/2022	06/21/2022		06/23/2022			08/29/2022		3362' GR			
18. Total Measured Depth of Well			19. Plug Back Measured Depth			20. Was Directional Survey Made?		21. Type Electric and Other Logs Run			
MD 18,062' TVD 10,591'			MD 18,032' TVD 10,591'			YES		None			
22. Producing Interval(s), of this completion - Top, Bottom, Name											
BONE SPRING 10,598 - 18,032'											
CASING RECORD (Report all strings set in well)											
CASING SIZE		WEIGHT LB./FT.		DEPTH SET		HOLE SIZE		CEMENTING RECORD		AMOUNT PULLED	
13 3/8"		54.5# J-55		1,235'		16"		715 CL C/CIRC			
9 5/8"		40# J-55		4,407'		12 1/4"		1515 CL C/CIRC			
5 1/2"		20# ICYP 110		18,040'		8 3/4"		2540 CL C & H TOC 1528		CBL '	
24. LINER RECORD						25. TUBING RECORD					
SIZE	TOP	BOTTOM	SACKS CEMENT	SCREEN	SIZE	DEPTH SET	PACKER SET				
26. Perforation record (interval, size, and number)						27. ACID, SHOT, FRACTURE, CEMENT, SQUEEZE, ETC.					
10,598 - 18,032' 3 1/8", 1596 holes						DEPTH INTERVAL		AMOUNT AND KIND MATERIAL USED			
						10,598 - 18,032'		FRAC W/18,646,104 lbs proppant, 274,749 bbls load fld			
PRODUCTION											
Date First Production		Production Method (Flowing, gas lift, pumping - Size and type pump)				Well Status (Prod. or Shut-in)					
08/29/2022		Flowing				Producing					
Date of Test	Hours Tested	Choke Size	Prod'n For Test Period	Oil - Bbl	Gas - MCF	Water - Bbl.	Gas - Oil Ratio				
09/05/2022	24	64		2313	4165	10,086	1800				
Flow Tubing Press.	Casing Pressure	Calculated 24-Hour Rate	Oil - Bbl.	Gas - MCF	Water - Bbl.	Oil Gravity - API - (Corr.)					
	729					48					
29. Disposition of Gas (Sold, used for fuel, vented, etc.)								30. Test Witnessed By			
SOLD											
31. List Attachments											
C-102, C-104, Directional Survey, H spacing											
32. If a temporary pit was used at the well, attach a plat with the location of the temporary pit.											
33. If an on-site burial was used at the well, report the exact location of the on-site burial:											
Latitude _____ Longitude _____ NAD 1927 1983											
I hereby certify that the information shown on both sides of this form is true and complete to the best of my knowledge and belief											
Signature Kay Maddox			Name Kay Maddox			Title Senior Regulatory Specialist		Date 09/20/2022			
E-mail Address kay_maddox@eogresources.com											

This form is to be filed with the appropriate District Office of the Division not later than 20 days after the completion of any newly-drilled or deepened well and not later than 60 days after completion of closure. When submitted as a completion report, this shall be accompanied by one copy of all electrical and radio-activity logs run on the well and a summary of all special tests conducted, including drill stem tests. All depths reported shall be measured depths. In the case of directionally drilled wells, true vertical depths shall also be reported. For multiple completions, items 11, 12 and 26-31 shall be reported for each zone.

Southeastern New Mexico		Northwestern New Mexico	
T. Anhy Rustler 1106'	T. Canyon Brushy 6845'	T. Ojo Alamo	T. Penn A"
T. Salt 1469'	T. Strawn	T. Kirtland	T. Penn. "B"
B. Salt 4233'	T. Atoka	T. Fruitland	T. Penn. "C"
T. Yates	T. Miss	T. Pictured Cliffs	T. Penn. "D"
T. 7 Rivers	T. Devonian	T. Cliff House	T. Leadville
T. Queen	T. Silurian	T. Menefee	T. Madison
T. Grayburg	T. Montoya	T. Point Lookout	T. Elbert
T. San Andres	T. Simpson	T. Mancos	T. McCracken
T. Glorieta	T. McKee	T. Gallup	T. Ignacio Otzte
T. Paddock	T. Ellenburger	Base Greenhorn	T. Granite
T. Blinebry	T. Gr. Wash	T. Dakota	
T. Tubb	T. Delaware Sand	T. Morrison	
T. Drinkard	T. Bone Springs	T. Todilto	
T. Abo	T. 1st BS Sand 9500'	T. Entrada	
T. Wolfcamp	T. 2nd BS Sand 10,093'	T. Wingate	
T. Penn	T.	T. Chinle	
T. Cisco (Bough C)	T.	T. Permian	

No. 1, from.....to.....
No. 2, from.....to.....
No. 3, from.....to.....
No. 4, from.....to.....

Include data on rate of water inflow and elevation to which water rose in hole.

No. 1, from.....to.....feet.....
 No. 2, from.....to.....feet.....
 No. 3, from.....to.....feet.....

From	To	Thickness In Feet	Lithology

Sante Fe Main Office
Phone: (505) 476-3441

General Information
Phone: (505) 629-6116

Online Phone Directory
<https://www.emnrd.nm.gov/oed/contact-us>

State of New Mexico
Energy, Minerals and Natural Resources
Oil Conservation Division
1220 S. St Francis Dr.
Santa Fe, NM 87505

ACKNOWLEDGMENTS

Action 145208

ACKNOWLEDGMENTS

Operator: EOG RESOURCES INC 5509 Champions Drive Midland, TX 79706	OGRID: 7377
	Action Number: 145208
	Action Type: [C-104] Completion Packet (C-104C)

ACKNOWLEDGMENTS

☒	I hereby certify that the required Water Use Report has been, or will be, submitted for this wells completion.
☒	I hereby certify that the required FracFocus disclosure has been, or will be, submitted for this wells completion.

Sante Fe Main Office
Phone: (505) 476-3441

General Information
Phone: (505) 629-6116

Online Phone Directory
<https://www.emnrd.nm.gov/oed/contact-us>

State of New Mexico
Energy, Minerals and Natural Resources
Oil Conservation Division
1220 S. St Francis Dr.
Santa Fe, NM 87505

CONDITIONS

Action 145208

CONDITIONS

Operator: EOG RESOURCES INC 5509 Champions Drive Midland, TX 79706	OGRID: 7377
	Action Number: 145208
	Action Type: [C-104] Completion Packet (C-104C)

CONDITIONS

Created By	Condition	Condition Date
plmartinez	File 3160-4 Completion Report within 10 days of BLM approval.	10/30/2025