U.S. Department of the Interior BUREAU OF LAND MANAGEMENT



Well Name	Well Number	US Well Number	Lease Number	Case Number	Operator
BIG EDDY UNIT	105H	3001546938	NMLC063667	NMNM68294T	XTO PERMIAN
BIG EDDY UNIT	103H	3001548159	NMLC063667	NMNM68294T	XTO PERMIAN
BIG EDDY UNIT	103H	3001546935	NMLC063667	NMNM68294T	XTO PERMIAN
BIG EDDY UNIT	104H	3001546937	NMLC063667	NMNM68294T	XTO PERMIAN

# **Notice of Intent**

**Sundry ID: 2879241** 

Type of Submission: Notice of Intent

Type of Action: APD Change

Date Sundry Submitted: 10/17/2025 Time Sundry Submitted: 02:17

Date proposed operation will begin: 10/17/2025

Procedure Description: XTO Permian Operating LLC respectfully requests to make the following changes for record

cleanup: Dedicated acres: f/ 320 t/640 Attached: Updated As drilled C102

# **NOI Attachments**

### **Procedure Description**

2017081256\_XTO\_BIG\_EDDY\_UNIT\_30E\_SKYWALKER\_105H\_AS\_DRILLED\_FINAL\_ORIGINALLY\_SIGNE D\_5\_18\_2022\_UPDATED\_NEW\_FORM\_8\_27\_2025\_\_1\_\_20251017141656.pdf

2017081255\_XTO\_BIG\_EDDY\_UNIT\_30E\_SKYWALKER\_104H\_ASDRILL\_\_\_UPDATED\_\_\_8\_27\_2025\_\_1\_ 20251017141616.pdf

2017081342\_XTO\_BIG\_EDDY\_UNIT\_30E\_SKYWALKER\_103H\_AS\_DRILLED\_\_\_UPDATED\_\_\_8\_27\_2025\_ \_1\_\_20251017141528.pdf

2019030745\_XTO\_BIG\_EDDY\_UNIT\_30E\_QUI\_GON\_103H\_ASDRILL\_\_\_UPDATED\_8\_27\_2025\_\_1\_\_20251 017141449.pdf

# **Operator**

I certify that the foregoing is true and correct. Title 18 U.S.C. Section 1001 and Title 43 U.S.C. Section 1212, make it a crime for any person knowingly and willfully to make to any department or agency of the United States any false, fictitious or fraudulent statements or representations as to any matter within its jurisdiction. Electronic submission of Sundry Notices through this system satisfies regulations requiring a

Operator Electronic Signature: LACEY GRANILLO Signed on: OCT 17, 2025 02:17 PM

Name: XTO PERMIAN OPERATING LLC

Title: Regulatory Analyst

Street Address: 6401 HOLIDAY HILL ROAD

City: MIDLAND State: TX

Phone: (432) 894-0057

Email address: LACEY.GRANILLO@EXXONMOBIL.COM

**Field** 

**Representative Name:** 

**Street Address:** 

City: State: Zip

Phone:

**Email address:** 

# **BLM Point of Contact**

BLM POC Name: MARIAH HUGHES BLM POC Title: Land Law Examiner

BLM POC Phone: 5752345972 BLM POC Email Address: MHUGHES@BLM.GOV

**Disposition:** Approved **Disposition Date:** 10/20/2025

Signature: CODY LAYTON ASSISTANT FIELD

MANAGER

Form 3160-5 (October 2024)

# UNITED STATES DEPARTMENT OF THE INTERIOR

	FORM APPROVED OMB No. 1004-0220 Expires: October 31, 202
-	

EIT OF THE HITERION	
F LAND MANAGEMENT	5. Lease Serial N

BURI	EAU OF LAND MANAGEMENT		5. Lease Serial No.	MULTIPLE			
	OTICES AND REPORTS ON W		6. If Indian, Allottee or Tribe Name				
	orm for proposals to drill or to Jse Form 3160-3 (APD) for sud		MULTIPLE				
SUBMIT IN 1	TRIPLICATE - Other instructions on pag	e 2	7. If Unit of CA/Agreement, MULTIPLE	Name and/or No.			
1. Type of Well  Oil Well  Gas W	ell Other		8. Well Name and No.  MULTIPLE				
2. Name of Operator XTO PERMIAN	OPERATING LLC		9. API Well No. MULTIPLE				
3a. Address 6401 HOLIDAY HILL RO		(include area code) 77	10. Field and Pool or Exploratory Area  MULTIPLE				
4. Location of Well (Footage, Sec., T.,R MULTIPLE	.,M., or Survey Description)		11. Country or Parish, State MULTIPLE				
12. CHE	CK THE APPROPRIATE BOX(ES) TO INI	DICATE NATURE C	F NOTICE, REPORT OR OT	THER DATA			
TYPE OF SUBMISSION		TYPE	OF ACTION				
✓ Notice of Intent	Acidize Deep Alter Casing Hydr	en [ aulic Fracturing [	Production (Start/Resume) Reclamation	Water Shut-Off Well Integrity			
Subsequent Report		Construction [ and Abandon [	Recomplete Temporarily Abandon	Other			
Final Abandonment Notice	Convert to Injection Plug	Back [	Water Disposal				
is ready for final inspection.)  XTO Permian Operating LLC r Dedicated acres: f/ 320 t/640  Attached: Updated As drilled C		-		the operator has detennined that the site			
14. I hereby certify that the foregoing is LACEY GRANILLO / Ph: (432) 894		Regulatory A	Analyst				
Signature (Electronic Submissio	n)	Date	10/17/2	2025			
	THE SPACE FOR FED	ERAL OR STA	TE OFICE USE				
Approved by							
MARIAH HUGHES / Ph: (575) 234	-5972 / Approved	Land L Title	aw Examiner	10/20/2025 Date			
	ned. Approval of this notice does not warran quitable title to those rights in the subject le duct operations thereon.		LSBAD				
	B U.S.C Section 1212, make it a crime for ar		and willfully to make to any d	lepartment or agency of the United States			

(Instructions on page 2)

### **GENERAL INSTRUCTIONS**

This form is designed for submitting proposals to perform certain well operations and reports of such operations when completed as indicated on Federal and Indian lands pursuant to applicable Federal law and regulations. Any necessary special instructions concerning the use of this form and the number of copies to be submitted, particularly with regard to local area or regional procedures and practices, are either shown below, will be issued by or may be obtained from the local Federal office.

### SPECIFIC INSTRUCTIONS

*Item 4* - Locations on Federal or Indian land should be described in accordance with Federal requirements. Consult the local Federal office for specific instructions.

Item 13: Proposals to abandon a well and subsequent reports of abandonment should include such special information as is required by the local Federal office. In addition, such proposals and reports should include reasons for the abandonment; data on any former or present productive zones or other zones with present significant fluid contents not sealed off by cement or otherwise; depths (top and bottom) and method of placement of cement plugs; mud or other material placed below, between and above plugs; amount, size, method of parting of any casing, liner or tubing pulled and the depth to the top of any tubing left in the hole; method of closing top of well and date well site conditioned for final inspection looking for approval of the abandonment. If the proposal will involve **hydraulic fracturing operations**, you must comply with 43 CFR 3162.3-3, including providing information about the protection of usable water. Operators should provide the best available information about all formations containing water and their depths. This information could include data and interpretation of resistivity logs run on nearby wells. Information may also be obtained from state or tribal regulatory agencies and from local BLM offices.

### **NOTICES**

The privacy Act of 1974 and the regulation in 43 CFR 2.48(d) provide that you be furnished the following information in connection with information required by this application.

AUTHORITY: 30 U.S.C. 181 et seq., 351 et seq., 25 U.S.C. 396; 43 CFR 3160.

PRINCIPAL PURPOSE: The information is used to: (1) Evaluate, when appropriate, approve applications, and report completion of subsequent well operations, on a Federal or Indian lease; and (2) document for administrative use, information for the management, disposal and use of National Resource lands and resources, such as: (a) evaluating the equipment and procedures to be used during a proposed subsequent well operation and reviewing the completed well operations for compliance with the approved plan; (b) requesting and granting approval to perform those actions covered by 43 CFR 3162.3-2, 3162.3-3, and 3162.3-4; (c) reporting the beginning or resumption of production, as required by 43 CFR 3162.4-1(c)and (d) analyzing future applications to drill or modify operations in light of data obtained and methods used.

ROUTINE USES: Information from the record and/or the record will be transferred to appropriate Federal, State, local or foreign agencies, when relevant to civil, criminal or regulatory investigations or prosecutions in connection with congressional inquiries or to consumer reporting agencies to facilitate collection of debts owed the Government.

EFFECT OF NOT PROVIDING THE INFORMATION: Filing of this notice and report and disclosure of the information is mandatory for those subsequent well operations specified in 43 CFR 3162.3-2, 3162.3-3, 3162.3-4.

The Paperwork Reduction Act of 1995 requires us to inform you that:

The BLM collects this information to evaluate proposed and/or completed subsequent well operations on Federal or Indian oil and gas leases.

Response to this request is mandatory.

The BLM would like you to know that you do not have to respond to this or any other Federal agency-sponsored information collection unless it displays a currently valid OMB control number.

**BURDEN HOURS STATEMENT:** Public reporting burden for this form is estimated to average 8 hours per response, including the time for reviewing instructions, gathering and maintaining data, and completing and reviewing the form. Direct comments regarding the burden estimate or any other aspect of this form to U.S. Department of the Interior, Bureau of Land Management (1004-0137), Bureau Information Collection Clearance Officer (WO-630), 1849 C St., N.W., Mail Stop 401 LS, Washington, D.C. 20240

(Form 3160-5, page 2)

## **Additional Information**

### **Batch Well Data**

BIG EDDY UNIT 30E QUI-GON 103H, US Well Number: 3001548159, Case Number: NMNM68294T, Lease Number: NMLC063667, Operator:XTO PERMIAN OPERATING LLC

BIG EDDY UNIT 30E SKYWALKER 103H, US Well Number: 3001546935, Case Number: NMNM68294T, Lease Number: NMLC063667, Operator:XTO PERMIAN OPERATING LLC

BIG EDDY UNIT 30E SKYWALKER 104H, US Well Number: 3001546937, Case Number: NMNM68294T, Lease Number: NMLC063667, Operator:XTO PERMIAN OPERATING LLC

BIG EDDY UNIT 30E SKYWALKER 105H, US Well Number: 3001546938, Case Number: NMNM68294T, Lease Number: NMLC063667, Operator:XTO PERMIAN OPERATING LLC

<u>C-10</u>	2		Б			lew Mexico					Revised July 9, 2024
Submit Ele	ectronically		Ene			ıral Resources I	_	nent			☐ Initial Submittal
1	Permitting			O.	IL CONSERVA	ATION DIVISION	ON		Submittal	ttal	✓ Amended Report
									Type:	-	☐ As Drilled
											Z 115 Billied
				,	WELL LOCATION	INFORMATION					
API Nu	mber 30-015-469	38	Pool Code 97650		Pool Nar V		ne /C WILLIAMS SINK; BONE SPRING				
Property	y Code 325955		Property Name	ВІ	G EDDY UNIT 30E SI	KYWALKER					ll Number 05H
ORGID ;	No. 373075		Operator Name	ХТ	O PERMIAN OPERA	TING, LLC.					ound Level Elevation 3,448'
Surface	Owner:	State 🔲 F	Fee ☐ Tribal 🛛	Federal		Mineral Owner:	State	Fee 🗌 Tribal	<b>⊠</b> Fed	leral	
					Surface	Location					
UL M	Section 14	Townshi 20 S	1	Lot	Ft. from N/S 1,065' FSL	Ft. from E/W 650' FWL	Latitude		ngitude 03.846		County EDDY
					Bottom H	ole Location		-			
UL H	Section 24	Townshi 20 S		Lot	Ft. from N/S 2,441' FNL	Ft. from E/W 11' FEL	Latitude 32.559		ngitude 03.814		County EDDY
Dedicat	ed Acres	Infill or D	Defining Well	Definin	g Well API	Overlapping Spacing U	Init (V/N)	Consolidat	ion Cod	Δ.	
64			INFILL		)-015-46937	N	) III (1/N)	U	ion cou	.c	
Order N	Jumbers.	PLC 65	52-0	•		Well setbacks are unde	r Common	Ownership:	Yes	□ N	O
					Kick Off	Point (KOP)					
UL H	Section 22	Townshi	.   -	Lot	Ft. from N/S 1,966' FNL	Ft. from E/W 487' FEL	Latitude		ngitude 03.8500		County EDDY
	<u> </u>				First Take	Point (FTP)		<u> </u>			
UL E	Section 23	Townshi 20 S	. I ~	Lot	Ft. from N/S 2,442' FNL	Ft. from E/W 234' FWL	Latitude 32.559		Longitude 7 -103.847689		County EDDY
					Last Take	Point (LTP)		1			
UL H	Section 24	Townshi 20 S		Lot	Ft. from N/S 2,438' FNL	Ft. from E/W 130' FEL	Latitude 32.559		ngitude 103.814		County EDDY
Unitize	d Area or Are	ea of Unifor NMNM1054	rm Interest 677880	Spacin	g Unit Type 🔀 Horizo	ontal					3,448'
OPE	RATOR C	ERTIFIC	CATIONS			SURVEYOR C	ERTIFIC	CATIONS			
best of r interest location an owne agreem	ny knowledge or unleased i or has a rigi er of such a n ent or a comp	e and belief, mineral inte ht to drill th nineral or w pulsory poo	, and that this org rrest in the land in his well at this lock vorking interest, o ling order heretof	anization of cluding th ation purso to a volu fore entere	d by the division.	notes of actual surv. is true and correct t  I, TIM C. PAPPAS, NEW 21209, DO HEREBY CON THE WERE PERFORMED BY M THAT I AM RESPONSIBLE MEETS THE MINIMUM ST	eys made best of the best of t	oy me or unde of my belief. IFESSIONAL SURV HIS SURVEY PLA PON WHICH IT IS R MY DIRECT SL SURVEY, THAT TI R SURVEYING IN	r my sup /EYOR NO IT AND TH S BASED IPERVISION HIS SURV NEW	oervis ). HE N;	was plotted from field sion, and that the same
the cons interest complet division	If this well is a horizontal well, I further certify that this organization has received the consent of at least one lessee or owner of a working interest or unleased mineral interest in each tract (in the target pool or formation) in which any part of the well's completed interval will be located or obtained a compulsory pooling form the division.  2acey Grandto 10/17/25										
			,			Cionotura and C1	f Drofes:	nol Cumus			
Signatu:	re Granillo		I	Oate		Signature and Seal of	riolessioi	iai surveyor			
Printed						Certificate Number		Date of Surv	ey		
	granillo@ex	xonmobil c	com			TIM C. PAPPAS	21209	ORIGIN	•	)5-12	s-2022
Email A						-		UPDAT			
						1					



IR


SHEET:

REVISION:

2017081256

This grid represents a standard section. You may superimpose a non-standard section, or a larger area, over this grid. Operators must outline the dedicated acreage in a red box, clearly show the well surface location and bottom hole location, if it is directionally drilled, with the dimensions from the section lines in the cardinal directions. If this is a horizontal wellbore show on this plat the location of the First Take Point and Last Take Point, and the point within the Completed interval (other than the First Take Point or Last Take Point) that is the closest to any outer boundary of the tract.

Surveyors shall use the latest United States government survey or dependent resurvey. Well locations will be in reference to the New Mexico Principal Meridian. If the land is not surveyed, contact the OCD Engineering Bureau. Independent subdivision surveys will not be acceptable.

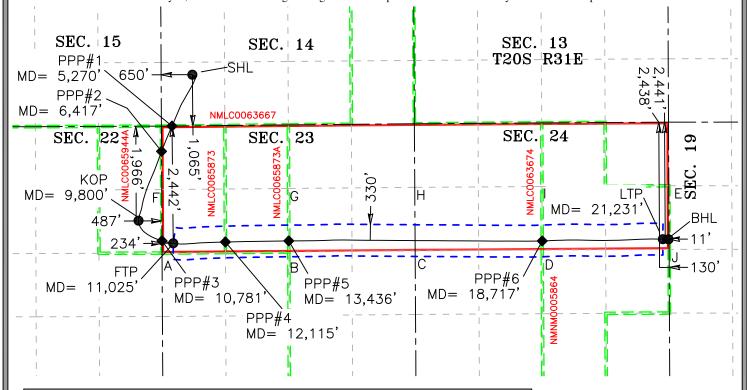

568,695.1 N

X =

660,106.6 E

SHL (I	NAD83 NME)		LTP (N	NAD83 NME)	SHL (I	NAD27 NME)	LTP (I	NAD27 NME)		
Y =	571,070.1		Y =	567,643.2	Y =	571,008.3	Y =	567,581.4		
X =	691,359.9		X =	701,161.1	X =	650,180.6	X =	659,981.6		
LAT. =	32.568984 °I	N	LAT. =	32.559437°	'N LAT. =	32.568863 °N	LAT. =	32.559316 °N		
LONG. =	103.846343 °	W	LONG. =	103.814582 °	'W LONG. =	103.845840 °W	LONG. =	103.814081 °W		
KOP (	NAD83 NME)		BHL (N	NAD83 NME)	KOP (	NAD27 NME)	BHL (I	NAD27 NME)		
Y =	568,030.3		Y =	567,640.9	Y =	567,968.5	Y =	567,579.1		
X =	690,238.2		X =	701,280.1	X =	649,058.8	X =	660,100.6		
LAT. =	32.560642 °I	N	LAT. =	32.559429°	'N LAT. =	32.560522 °N	LAT. =	32.559308 °N		
LONG. =	103.850028 °	W	LONG. =	103.814196°	W LONG. =	103.849526 °W	LONG. =	103.813695 °W		
FTP (I	NAD83 NME)				FTP (f	NAD27 NME)				
Y =	567,558.9				Y =	567,497.1				
X =	690,961.2				X =	649,781.8				
LAT. =	32.559337 °I	N			LAT. =	32.559217 °N				
LONG. =	103.847689 °	W			LONG. =	103.847187 °W				
C	ORNER COORE	)NIC	ATES (NAD	33 NME)	С	CORNER COORDINATES (NAD27 NME)				
A - Y =	567,354.4 N	I,	, X =	690,728.6 E	A - Y =	567,292.6 N	, X =	649,549.2 E		
B - Y =	567,376.6 N	I,	, X =	693,370.0 E	B - Y =	567,314.8 N	, X =	652,190.5 E		
C - Y =	567,398.6 N	Ι,	, X =	696,001.4 E	C - Y =	567,336.8 N	, X =	654,821.9 E		
D - Y =	567,415.5 N	Ι,	, X =	698,649.6 E	D - Y =	567,353.7 N	, X =	657,470.1 E		
E - Y =	567,432.4 N	Ι,	, X =	701,292.5 E	E - Y =	567,370.6 N	, X =	660,113.0 E		
F - Y =	568,676.5 N	Ι,	, X =	690,721.9 E	F - Y =	568,614.7 N	, X =	649,542.5 E		
G - Y =	568,700.8 N	Ι,	, X =	693,365.1 E		568,639.0 N	, X =	652,185.7 E		
H - Y =	568,723.3 N	Ι,	, X =	695,993.5 E	H - Y =	568,661.5 N	, X =	654,814.1 E		
I - Y =	568,740.7 N	I,	, X =	698,643.9 E	I - Y =	568,678.9 N	, X =	657,464.4 E		

LEGEND
SECTION LINE WELLBORE NEW MEXICO MINERAL LEASE LINE 330' BUFFER DEDICATED ACREAGE

PPP#1 (NAD83 NME)	PPP#2 (NAD83 NME)	PPP#3 (NAD83 NME)
Y = 570,000.8	Y = 569,473.2	Y = 567,610.4
X = 690,935.7	X = 690,717.8	X = 690,727.3
LAT. = 32.566050 °N	LAT. = 32.564602 °N	LAT. = 32.559482 °N
LONG. = 103.847735 °W	LONG. = 103.848450 °W	LONG. = 103.848447 °W
PPP#4 (NAD83 NME)	PPP#5(NAD83 NME)	PPP#6 (NAD83 NME)
Y = 567,585.1	Y = 567,607.7	Y = 567,607.2
X = 692,048.3	X = 693,369.1	X = 698,648.8
LAT. = 32.559396 °N	LAT. = 32.559441 °N	LAT. = 32.559371 °N
LONG. = 103.844160 °W	LONG. = 103.839873 °W	LONG. = 103.822737 °W
PPP#1 (NAD27 NME)	PPP#2 (NAD27 NME)	PPP#3 (NAD27 NME)
Y = 569,939.0	Y = 569,411.4	Y = 567,548.6
X = 649,756.4	X = 649,538.4	X = 649,547.9
LAT. = 32.565929 °N	LAT. = 32.564482 °N	LAT. = 32.559361 °N
LONG. = 103.847233 °W	LONG. = 103.847948 °W	LONG. = 103.847945 °W
PPP#4 (NAD27 NME)	PPP#5(NAD27 NME)	PPP#6 (NAD27 NME)
Y = 567,523.3	Y = 567,545.9	Y = 567,545.4
X = 650,868.9	X = 652,189.7	X = 657,469.3
LAT. = 32.559275 °N	LAT. = 32.559321 °N	LAT. = 32.559251 °N
LONG. = 103.843658 °W	LONG. = 103.839371 °W	LONG. = 103.822235 °W



J - Y =

568,756.9 N

X =

701,286.1 E

2205 Walnut Street - Columbus, TX 768934
Ph: 817.349.9800 - Fax: 979.732.5271
TBPE Firm 17957 | TBPL5 Firm 10000100
www.fscinc.net
© COPYRIGHT 2023 - ALL INGHIS RESERVED

 DATE:
 8-27-2025
 PRC

 DRAWN BY:
 LM
 SCA

 CHECKED BY:
 WL
 SHE

 FIELD CREW:
 IR
 REV

PROJECT NO: 2017081256

SCALE: 1" = 2,000'

SHEET: 2 OF 2

REVISION: NO

eceived	by OCD:	<del>10/20/20</del>	<del>25 12:34:24</del>	PM = -								Page 8
<u>C-10</u>	2				Sta	ite of No	ew Mexico					Revised July 9, 2024
			En	ergy, N	Minerals	& Natu	ral Resources	Departm	ent			
	ectronically Permitting			O	IL CON	SERVA	TION DIVISI	ION		Submitta	- ⊢=	Initial Submittal
	g									Type:	"   🛛	Amended Report
												As Drilled
					WELL LO	CATION	INFORMATION					
API Nu	mber 30-015-4693	37	Pool Code 97650			Pool Nam	e C WILLIAMS SINK;	BONE SPR	ING			
Propert	y Code	<u></u>	Property Name		G EDDY UN		<u>`</u>			Well Number		
ORGID	325955 No.		Operator Name		O PERMIAI					104H Ground Level Elevation		
	373075		1		OFLINIMA	NOFLIKAT	ING, LLG.				3,44	
Surface	Owner:	State   F	ee 🗌 Tribal 🗵	Federal			Mineral Owner:	State Fe	ee 🔲 Tribal	l 🛚 Fede	eral	
						Surface 1	Location					
UL M	Section 14	Township 20 S	p Range 31 E	Lot	Ft. from N	·	Ft. from E/W 620' FWL	Latitude 32.5689		ongitude 03.8464	40	County EDDY
							le Location	02,000				
UL	Section	Township	.   -	Lot	Ft. from N	/S	Ft. from E/W	Latitude		ongitude		County
Н	24	20 S	31 E		1,534	l' FNL	6' FEL	32.56192	20   -1	103.8141	77	EDDY
Dedicat	ed Acres		efining Well DEFINING	Definin	g Well API		Overlapping Spacing N	Unit (Y/N)	Consolidat	tion Code		
Order N	Order Numbers. PLC 652-0 Well setbacks are under Common Ownership: 🛛 Yes 🗌 No											
					]	Kick Off I	Point (KOP)					
UL A	Section 22	Township 20 S		Lot	Ft. from N. 1,148	·	Ft. from E/W 539' FEL	Latitude 32.5628		ongitude 03.85020	00	County EDDY
					F	irst Take	Point (FTP)					
UL E	Section 23	Township 20 S		Lot	Ft. from N. 1,560	1	Ft. from E/W 238' FWL	Latitude 32,5617		ongitude 03.84767	76	County
	I	1			L	ast Take l	Point (LTP)					
UL H	Section 24	Township 20 S		Lot	Ft. from N		Ft. from E/W 132' FEL	Latitude 32,5619		ongitude 103.8145	586	County EDDY
			012		1,000	TIVE		02.0010				
Unitize	d Area or Are	a of Unifor	m Interest	Spacin	g Unit Type	■ Horizon	tal   Vertical	Gro	ound Floor E	Elevation:	3,4	48'
		IMNM10546	577880									
OPEI	RATOR C	ERTIFIC	CATIONS				SURVEYOR C	CERTIFICA	ATIONS			
best of i	ny knowledge	and belief,	ion contained he and that this or rest in the land i	ganization	either owns a	working	I hereby certify tha notes of actual sur is true and correct	veys made by	me or unde			
locatior an own	i or has a righ er of such a m	nt to drill thi ineral or we	is well at this loo orking interest, d ling order hereto	cation purs or to a volu	uant to a cont intary pooling	tract with	I, TIM C. PAPPAS, NEW 21209, DO HEREBY CE	rtify that this	SURVEY PLAT	T AND THE		C. PAPA
	•		further certify to	,	•		ACTUAL SURVEY ON THI WERE PERFORMED BY M THAT I AM RESPONSIBLI MEETS THE MINIMUM ST	ME OR UNDER ME FOR THIS SUI	MY DIRECT SU RVEY, THAT TH	IPERVISION; HIS SURVEY		CH MEXIC TO
interest	in each tract ed interval w	(in the targe	or owner of a w et pool or forma d or obtained a	tion) in wh	ich any part c	of the well's	MEXICO, AND THAT IS T	RIJE AND CORR	FCT TO THE F	REST OF /		21209 SONAL SURVE
division	•						TIM C. PAPPAS	- 21 H	ugusi	202	TO.	100
Lасец G	ranillo				10/	17/25	REGISTERED PROFESSION STATE OF NEW MEXICO	NAL LAND SURV NO. 21209	EYOR			S/ONAL SUR!
Signatu	re			Date			Signature and Seal of					
Lacey	Granillo											

Certificate Number

TIM C. PAPPAS 21209



lacey.granillo@exxonmobil.com

Printed Name

Email Address

DATE: DRAWN BY: CHECKED BY:

FIELD CREW:

Date of Survey

8-27-2025 WL

IR

ORIGINALLY 05-18-2022 UPDATED 8-27-2025

PROJECT NO: SCALE:


SHEET:

REVISION:


2017081255 NO

This grid represents a standard section. You may superimpose a non-standard section, or a larger area, over this grid. Operators must outline the dedicated acreage in a red box, clearly show the well surface location and bottom hole location, if it is directionally drilled, with the dimensions from the section lines in the cardinal directions. If this is a horizontal wellbore show on this plat the location of the First Take Point and Last Take Point, and the point within the Completed interval (other than the First Take Point or Last Take Point) that is the closest to any outer boundary of the tract.

Surveyors shall use the latest United States government survey or dependent resurvey. Well locations will be in reference to the New Mexico Principal Meridian. If the land is not surveyed, contact the OCD Engineering Bureau. Independent subdivision surveys will not be acceptable.

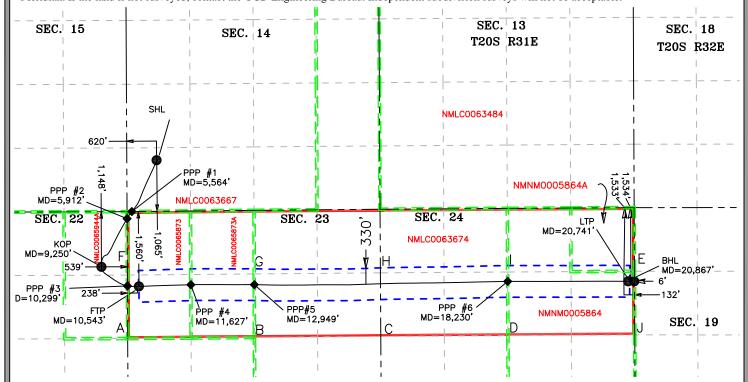

SHL (N	NAD83 NME)	LTP (N	AD83 NME)	SHL (N	IAD27 NME)	LTP (NAD27 NME)		
Y =	571,069.8	Y =	568,547.4	Y =	571,008.0	Y =	568,485.6	
X =	691,329.9	X =	701,155.6	X =	650,150.6	X =	659,976.1	
LAT. =	32.568983 °N	LAT. =	32.561922 °N	LAT. =	32.568863 °N	LAT. =	32.561802 °N	
LONG. =	103.846440 °W	LONG. =	103.814586 °W	LONG. =	103.845938 °W	LONG. =	103.814085 °W	
KOP (I	NAD83 NME)	BHL (N	IAD83 NME)	KOP (1	NAD27 NME)	BHL (f	NAD27 NME)	
Y =	568,848.0	Y =	568,547.0	Y =	568,786.2	Y =	568,485.2	
X =	690,181.7	X =	701,281.5	X =	649,002.3	X =	660,102.0	
LAT. =	32.562890 °N	LAT. =	32.561920 °N	LAT. =	32.562770 °N	LAT. =	32.561799 °N	
LONG. =	103.850200 °W	LONG. =	103.814177 °W	LONG. =	103.849698 °W	LONG. =	103.813676 °W	
FTP (N	NAD83 NME)			FTP (N	IAD27 NME)			
Y =	568,441.3			Y =	568,379.5			
X =	690,961.0			X =	649,781.6			
LAT. =	32.561763 °N			LAT. =	32.561642 °N			
LONG. =	103.847676 °W			LONG. =	103.847174 °W			
C	ORNER COORDINA	ATES (NAD	3 NME)	c	ORNER COORDINA	ATES (NAD2	7 NME)	
A - Y =	567,354.4 N ,	, X =	690,728.6 E	A - Y =	567,292.6 N	, X =	649,549.2 E	
B - Y =	567,376.6 N ,	, X =	693,370.0 E	B - Y =	567,314.8 N	, X =	652,190.5 E	
C - Y =	567,398.6 N	, X =	696,001.4 E	C - Y =	567,336.8 N	, X =	654,821.9 E	
D - Y =	567,415.5 N ,	, X =	698,649.6 E	D - Y =	567,353.7 N	, X =	657,470.1 E	
E - Y =	567,432.4 N ,	, X =	701,292.5 E	E - Y =	567,370.6 N	, X =	660,113.0 E	
F - Y =	568,676.5 N ,	, X =	690,721.9 E	F - Y =	568,614.7 N	, X =	649,542.5 E	
G - Y =	568,700.8 N	, X =	693,365.1 E	G - Y =	568,639.0 N	, X =	652,185.7 E	
H - Y =	568,723.3 N ,	, X =	695,993.5 E	H - Y =	568,661.5 N	, X =	654,814.1 E	
I - Y =	568,740.7 N ,	, X =	698,643.9 E	I - Y =	568,678.9 N	, X =	657,464.4 E	
J - Y =	568,756.9 N ,	, X =	701,286.1 E	J - Y =	568,695.1 N	, X =	660,106.6 E	
PPP #1	(NAD83 NME)	PPP #4 (	(NAD83 NME)	PPP #1	(NAD27 NME)	PPP #4	(NAD27 NME)	
Y =	569,999.6	Y =	568,475.6	Y =	569,937.8	Y =	568,413.8	
X =	690,814.7	X =	692,044.4	X =	649,635.4	X =	650,865.0	
LAT. =	32.566048 °N	LAT. =	32.561843 °N	LAT. =	32.565928 °N	LAT. =	32.561723 °N	
LONG. =	103.848128 °W	LONG. =	103.844159 °W	LONG. =	103.847626 °W	LONG. =	103.843658 °W	
PPP #2	(NAD83 NME)	PPP #5 (	(NAD83 NME)	PPP #2	(NAD27 NME)	PPP #5	(NAD27 NME)	
Y =	569,851.1	Y =	568,477.2	Y =	569,789.3	Y =	568,415.4	
X =	690,715.9	X =	693,365.9	X =	649,536.5	X =	652,186.5	
LAT. =	32.565641 °N	LAT. =	32.561831 °N	LAT. =	32.565521 °N	LAT. =	32.561711 °N	
LONG. =	103.848451 °W	LONG. =	103.839870 °W	LONG. =	103.847949 °W	LONG. =	103.839368 °W	
	(NAD83 NME)	PPP #6 (	NAD83 NME)		(NAD27 NME)		(NAD27 NME)	
Y =	598,449.9	Y =	568,544.6	Y =	598,387.6	Y =	568,482.8	
X =	690,723.0	X =	698,644.7	X =	649,544.8	X =	657,465.3	
LAT. =	32.561789 °N	LAT. =	32.561948 °N	LAT. =	32.644130 °N	LAT. =	32.561827 °N	
LONG. =	103.848449 °W	LONG. =	103.822735 °W	LONG. =	103.847498 °W	LONG. =	103.822234 °W	

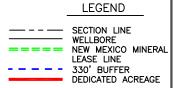



2205 Walnut Street - Columbus, Tx. 78934 Ph: 979.732.3114 - Fax: 979.732.5271 TBPE Firm 17957 | TBPLS Firm 10000100 www.fscinc.net
© COPYRIGHT 2025 ALL RIGHTS RESERVED

08/27/2025 PROJECT NO: 2017081255 DRAWN BY: SCALE: 1" = 2.000'CHECKED BY: SHEET: 2 OF 2 FIELD CREW: IR REVISION

	•											
<u>C-10</u>	2		Ene	rov. N			w Mexico al Resources D	<b>)</b> enarti	ment			Revised July 9, 2024
Submit Ele	ectronically			•			TION DIVISION	-	110111		]	Initial Submittal
Via OCD	Permitting			0.	il conslit	V 2 1	1101 ( D1 ( 151)	011		Submittal		Amended Report
										Type:		X As Drilled
												<b></b>
				,	WELL LOCATION	ON I	INFORMATION					
API Nu	mber 30-015-469	35	Pool Code 97650		Pool I	Name WC	: C WILLIAMS SINK; B	BONE SP	RING			
Property	y Code 325955		Property Name	ВІ	G EDDY UNIT 30E	SKY	WALKER					Number 3H
ORGID	No. 373075		Operator Name	ХТ	O PERMIAN OPE	RATI	NG, LLC.					nd Level Elevation 448'
Surface	Owner:	State   F	Fee ☐ Tribal 🏻	Federal			Mineral Owner:	State 🔲	Fee Tribal	<b>⊠</b> Fed	leral	
					Surfa	ace L	Location					
UL M	Section 14	Townshi 20 S	·   ·	Lot	Ft. from N/S 1,140' FSL		Ft. from E/W 620' FWL	Latitude 32.569		ngitude 03.8464	441	County EDDY
					Bottom	Hol	e Location					
UL P	Section 13	Townshi	.   -	Lot	Ft. from N/S 244' FSL		Ft. from E/W 6' FEL	Latitude 32.566		ngitude 03.814	179	County EDDY
Dedicat 64	ed Acres 0	1	Defining Well		g Well API )-015-46244	(	Overlapping Spacing Us  N	nit (Y/N)	Consolidat U	ion Code	e	
Order N	Jumbers.	PLC 652-	-0			,	Well setbacks are under	r Commor	Ownership: [	Yes [	☐ No	
	1	T			1		oint (KOP)					
UL P	Section 15	Townshi 20 S	.   -	Lot	Ft. from N/S 251' FSL		Ft. from E/W 355' FEL	22.56	"		806	County EDDY
	l a .:	T	- I B	l	1		Point (FTP)	T				la .
UL M	Section 14	Townshi	.   -	Lot	Ft. from N/S 227' FSL		Ft. from E/W 415' FWL	Latitude 32.56		ngitude 03.8471	105	County
	I				Last Ta	ake P	Point (LTP)					I
UL P	Section 13	Townshi 20 S	·   -	Lot	Ft. from N/S 241' FSL		Ft. from E/W 160' FEL	Latitude 32.56		ngitude 103.814	679	County EDDY
Unitized	d Area or Are	ea of Unifor	m Interest 677880	Spacin	g Unit Type 🛛 Hor	rizonta	al 🗌 Vertical	0	round Floor E	levation:	: 3	,448'
ODEI	RATOR C	EDTIEL	CATIONS				SURVEYOR CI	CDTICI	CATIONS			
OPE	KATOR C	EKHIFIC	LATIONS				SURVEYORCE	EKIIFI	CATIONS			
best of r interest location	ny knowledge or unleased i i or has a rigi	e and belief, nineral inte ht to drill th	, and that this orgo rest in the land in is well at this loca	anization o cluding th ution pursi	and complete to the either owns a working e proposed bottom ho uant to a contract wit	g ole	I hereby certify that notes of actual surve is true and correct to	eys made i	by me or unde		-	as plotted from field on, and that the same
1			orking interest, or ling order heretof				I, TIM C. PAPPAS, NEW 21209, DO HEREBY CEI ACTUAL SURVEY ON THI	RTIFY THAT E GROUND	THIS SURVEY PL UPON WHICH IT	AT AND T IS BASED	HE	C. PADA
					anization has receive rest or unleased mine		WERE PERFORMED BY METHAT I AM RESPONSIBLI MEETS THE MINIMUM ST	ME OR UND E FOR THIS TANDARDS F	ER MY DIRECT S SURVEY, THAT OR SURVEYING II	SUPERVISION THIS SURV N NEW	ON; VEY	TEN MEXICO TO
interest	in each tract ed interval w	(in the targ		on) in wh	ich any part of the we		MY KNÓWLEDGE AND BE					21209
Lacey 9					10/17/25		TIM C. PAPPAS REGISTERED PROFESSIOL STATE OF NEW MEXICO	NAL LAND :	SURVEYOR	202	د تا الح	21209
Signatur			т	Date	10/11/23		Signature and Seal of					
	re ⁄ Granillo		L	raic			orginature and Sear Of	1 10108810	iai suiveyoi			
Printed						-	Certificate Number		Date of Surv	ey		
lacey.	granillo@ex	xonmobil.c	com				TIM C. PAPPAS 2	21209	ORIGIN			
Email A	Address								UPDAT	ED 8-27	·-2025	0




8-27-2025

WL

IR

This grid represents a standard section. You may superimpose a non-standard section, or a larger area, over this grid. Operators must outline the dedicated acreage in a red box, clearly show the well surface location and bottom hole location, if it is directionally drilled, with the dimensions from the section lines in the cardinal directions. If this is a horizontal wellbore show on this plat the location of the First Take Point and Last Take Point, and the point within the Completed interval (other than the First Take Point or Last Take Point) that is the closest to any outer boundary of the tract.

Surveyors shall use the latest United States government survey or dependent resurvey. Well locations will be in reference to the New Mexico Principal Meridian. If the land is not surveyed, contact the OCD Engineering Bureau. Independent subdivision surveys will not be acceptable.

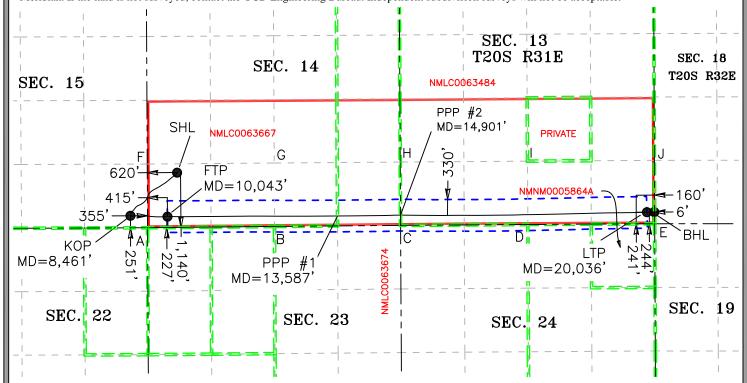

LEGEND

SECTION LINE
WELLBORE
NEW MEXICO MINERAL
LEASE LINE
JEDICATED ACREAGE

SHL (N	IAD83 NME)	LTP (N	IAD83 NME)	SHL (N	AD27 NME)	LTP (N	IAD27 NME)
Y =	571,144.8	Y =	570,322.0	Y =	571,083.0	Y =	570,260.2
X =	691,329.1	X =	701,118.1	X =	650,149.8	X =	659,938.7
LAT. =	32.569189 °N	LAT. =	32.566801 °N	LAT. =	32.569069 °N	LAT. =	32.566680 °N
LONG. =	103.846441 °W	LONG. =	103.814679 °W	LONG. =	103.845939 °W	LONG. =	103.814178 °W
KOP (I	NAD83 NME)	BHL (N	IAD83 NME)	KOP (N	IAD27 NME)	BHL (N	NAD27 NME)
Y =	570,247.6	Y =	570,325.6	Y =	570,185.8	Y =	570,263.7
X =	690,358.4	X =	701,272.1	X =	649,179.1	X =	660,092.7
LAT. =	32.566735 °N	LAT. =	32.566808 °N	LAT. =	32.566615 °N	LAT. =	32.566688 °N
LONG. =	103.849606 °W	LONG. =	103.814179 °W	LONG. =	103.849103 °W	LONG. =	103.813678 °W
FTP (N	IAD83 NME)			FTP (N	AD27 NME)		
Y =	570,229.4			Y =	570,167.6		
X =	691,128.9			X =	649,949.6		
LAT. =	32.566676 °N			LAT. =	32.566555 °N		
LONG. =	103.847105 °W			LONG. =	103.846603 °W		
CC	ORNER COORDINA	TES (NAD8	33 NME)	C	ORNER COORDINA	ATES (NAD2	7 NME)
A - Y =	569,998.6 N ,	X =	690,715.2 E	A - Y =	569,936.8 N	, X =	649,535.8 E
B - Y =	570,025.1 N ,	X =	693,360.2 E	B - Y =	569,963.3 N	, X =	652,180.8 E
C - Y =	570,048.0 N ,	X =	695,985.6 E	C - Y =	569,986.2 N	, X =	654,806.2 E
D - Y =	570,065.9 N ,	X =	698,638.1 E	D - Y =	570,004.1 N	, X =	657,458.8 E
E - Y =	570,081.5 N ,	X =	701,279.6 E	E - Y =	570,019.6 N	, X =	660,100.1 E
F - Y =	571,324.9 N ,	X =	690,708.2 E	F - Y =	571,263.1 N	, X =	649,528.9 E
G - Y =	571,346.8 N ,	X =	693,353.7 E	G - Y =	571,285.0 N	, X =	652,174.4 E
H - Y =	571,366.9 N ,	X =	695,978.6 E	H - Y =	571,305.0 N	, X =	654,799.3 E
I - Y =	571,385.2 N ,	X =	698,630.3 E	I - Y =	571,323.4 N	, X =	657,451.0 E
J - Y =	571,402.4 N ,	X =	701,274.1 E	J - Y =	571,340.6 N	, X =	660,094.7 E
PPP #1	(NAD83 NME)	PPP #2 (	(NAD83 NME)	PPP #1 (	NAD27 NME)	PPP #2	(NAD27 NME)
Y =	570,242.6	Y =	570,261.4	Y =	570,180.8	Y =	570,199.6
X =	694,671.8	X =	695,984.5	X =	653,492.4	X =	654,805.1
LAT. =	32.566667 °N	LAT. =	32.566702 °N	LAT. =	32.566547 °N	LAT. =	32.566581 °N
LONG. =	103.835605 °W	LONG. =	103.831343 °W	LONG. =	103.835103 °W	LONG. =	103.830842 °W



2205 Walnut Street - Columbus, Tx. 78934
Ph: 979.732.3114 - Fax: 979.732.5271
TBPE Firm 17957 | TBPL5 Firm 10000100
www.fscinc.net
© COPYRIGHT 2023 - ALL BIGHTS RESERVED

 DATE:
 08/27/2025
 PROJECT NO:
 2017081342

 DRAWN BY:
 WL
 SCALE:
 1" = 2,000'

 CHECKED BY:
 LM
 SHEET:
 2 OF 2

 FIELD CREW:
 IR
 REVISION:
 NO

<u>C-102</u>			State of Ne								Revised July 9, 2024		
Submit Fl	lectronically	Energy, Minerals & Natur					•					Initial Submittal	
Submit Electronically Via OCD Permitting			OIL CONSERVA					TION DIVISION			Submitt	tal H	✓ Amended Report
											Type:	<u> </u>	As Drilled
										As Dillied			
					,	WELL LO	CATION	INFORMATION					
API Nu	ımber 30-015-481	59	Pool	Code 97650			Pool Name	e C WILLIAMS SINK; B	ONE SP	RING			
Propert	ty Code 330654		Prope	erty Name	ВІ	G EDDY UNI	IT 30E QU	I GON					Number 3H
ORGIE	No. 373075		Opera	ator Name	XTO PERMIAN OPERATING, LLC.							and Level Elevation 448'	
Surface	e Owner:	State   F	ree □	Tribal 🛛	Federal			Mineral Owner:	State	Fee Tribal	✓ Fede	eral	
							Surface I	Location					
UL M	Section 14	Townshi		Range 31 E	Lot	Ft. from N/	- 1	Ft. from E/W 650' FWL	Latitude		ngitude 03.8463	844	County
	1							le Location	02.000	, ,			
UL A	Section 24	Townshi	^	Range 31 E	Lot	Ft. from N/655' F	s	Ft. from E/W 27' FEL	Latitude 32.564		ngitude 03.8142	245	County EDDY
		1											
Dedicar 64	ted Acres	Infill or D	Defining INFILL		Defining Well API 30-015-46937			** * * * * * * * * * * * * * * * * * * *		Consolidat U	idation Code		
	Numbers.						Well setbacks are under Common Ownership: ⊠ Yes ☐ No						
Order i	vuinoers.	PLC 652-	U					wen setbacks are under	Common	TOwnership. L	ZI Tes [		
						K	Kick Off P	Point (KOP)					
UL A	Section 22	Townshi 20 S		Range 31 E	Lot	Ft. from N/3 338' F	- 1	Ft. from E/W 508' FEL	Latitude 32.56		ngitude 03.8500	98	County EDDY
						Fi	rst Take I	Point (FTP)	ı	<u> </u>			
UL D	Section 23	Townshi	•	Range 31 E	Lot	Ft. from N/634' F		Ft. from E/W 204' FWL	Latitude 32.56		ngitude 03.8477	88	County
						L:	ast Take F	Point (LTP)	02.00	1000			
UL A	Section 24	Townshi	•	Range 31 E	Lot	Ft. from N/	s	Ft. from E/W 154' FEL	Latitude		ngitude   03.8146	857	County EDDY
	24	20 3	<u> </u>	316		030 F	INL	134 FEL	32.30	4335	103.0140	001	EDD1
Unitiza	d Area or Ar	a of Unifor	m Inter	rect	Spacin	a Unit Type N	V Harizant	al   Vertical		Fround Floor E	levation:		
Cintize	ed Area or Ar	NMNM1054	677880	)	Spacin	g Omi Type [	M Horizont	ai 🔲 Verticai		Hound Floor E	ievation.	3	,448'
OPE	RATOR C	ERTIFIC	CATIO	ONS				SURVEYOR CI	ERTIFI	CATIONS			
I hereb	v certify that	the informa	tion cor	ntained her	ein is true	e and complete	e to the	I hereby certify that	the well l	ocation shown	on this p	plat w	as plotted from field
I hereby certify that the information contained herein is true and complete to the best of my knowledge and belief, and that this organization either owns a working interest or unleased mineral interest in the land including the proposed bottom hole					notes of actual surveys made by me or under my supervision, and that the same is true and correct to the best of my belief.								
location	n or has a rig	ht to drill th	is well	at this loca	tion purs	uant to a contr untary pooling		I, TIM C. PAPPAS, NEW MEXICO PROFESSIONAL SURVEYOR NO. 21209, DO HEREBY CERTIFY THAT THIS SURVEY PLAT AND THE ACTUAL SURVEY ON THE GROUND UPON WHICH IT IS BASED					
1						ed by the division	on.	WERE PERFORMED BY ME THAT I AM RESPONSIBLE	E OR UNDE FOR THIS	R MY DIRECT SU SURVEY, THAT TI	IPERVISION HIS SURVE		W C. PAPP
If this well is a horizontal well, I further certify that this organization has received the consent of at least one lessee or owner of a working interest or unleased mineral				MEETS THE MINIMUM STANDARDS FOR SURVEYING IN NEW MEXICO, AND THAT IS TRUE AND CORRECT TO THE BEST OF MY KNOWLEDGE AND BELIEF.									
interest in each tract (in the target pool or formation) in which any part of the well's completed interval will be located or obtained a compulsory pooling form the				27 August 2025 (21209)									
division		iii be tocute	u or oc	натей и сс	mpuisor	y pooling jorm	ine	TIM C. PAPPAS REGISTERED PROFESSION			20	R	
Lacey Gr	zanillo					10/17	7/25	STATE OF NEW MEXICO	NO. 21209	OKVETOK		No.	SS/ONAL SURVEY
Signature Date					Signature and Seal of	Profession	nal Surveyor						
Lacey Granillo													
Printed	Name							Certificate Number		Date of Surv	ey		
lacey.c	granillo@exx	conmobil.c	om					TIM C. PAPPAS 2	21209	ORIGIN			
Email A										UPDATI			




IR

1 OF 2 NO

This grid represents a standard section. You may superimpose a non-standard section, or a larger area, over this grid. Operators must outline the dedicated acreage in a red box, clearly show the well surface location and bottom hole location, if it is directionally drilled, with the dimensions from the section lines in the cardinal directions. If this is a horizontal wellbore show on this plat the location of the First Take Point and Last Take Point, and the point within the Completed interval (other than the First Take Point or Last Take Point) that is the closest to any outer boundary of the tract.

Surveyors shall use the latest United States government survey or dependent resurvey. Well locations will be in reference to the New Mexico Principal Meridian. If the land is not surveyed, contact the OCD Engineering Bureau. Independent subdivision surveys will not be acceptable.

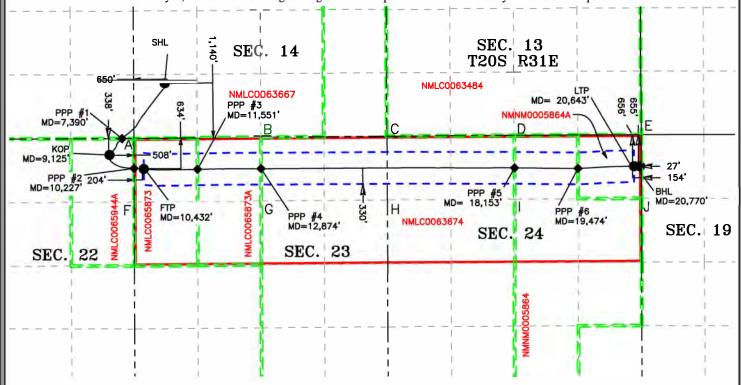

SHL (N	NAD83 NME)	LTP (NAD83 NME)	) SHL (N	SHL (NAD27 NME)			
Y =	571,145.1	Y = 569,424.9	Y =	571,083.3			
X =	691,359.1	X = 701,129.2	X =	650,179.8			
LAT. =	32.569190 °N	LAT. = 32.564335	°N LAT. =	32.569069 °N			
LONG. =	103.846344 °W	LONG. = 103.814657	°W LONG. =	103.845842 °W			
KOP (I	NAD83 NME)	BHL (NAD83 NME	) КОР (I	KOP (NAD27 NME)			
Y =	569,658.1	Y = 569,426.1	Y =	569,596.3			
X =	690,209.3	X = 701,256.2	X =	649,029.9			
LAT. =	32.565117 °N	LAT. = 32.564336	°N LAT. =	32.564996 °N			
LONG. =	103.850098 °W	LONG. = 103.814245	°W LONG. =	103.849596 °W			
FTP (N	NAD83 NME)		FTP (N	FTP (NAD27 NME)			
Y =	569,367.1		Y =	569,305.3			
X =	690,922.3		X =	649,742.9			

X = 649.742.9 LAT. = 32.564188 °N

**CORNER COORDINATES (NAD83 NME)** 569,998.6 N , 690,715.2 E

32.564308 °N

103.847788 °W

LAT. = LONG. =

> X = 693.360.2 E B - Y = 570.025.1 N C - Y = 570,048.0 N X = 695.985.6 E D - Y = 570,065.9 N 698,638.1 E 570,081.5 N 701,279.6 E E - Y = X = F - Y = 568.676.5 N X = 690.721.9 E G - Y = 568,700.8 N X = 693,365.1 E 568,723.3 N 695,993.5 E I - Y = 568.740.7 N X = 698.643.9 E I - Y = 568.756.9 N X = 701,286.1 E PPP #1 (NAD83 NME) PPP #4 (NAD83 NME) 569,997.5 Y = 569,374.5 Y = X = 690.469.4 X = 693.362.6

32.566047 °N LAT. = LAT. = 32.564297 °N LONG. = 103.849249 °W LONG. = 103.839867 °W PPP #2 (NAD83 NME) PPP #5 (NAD83 NME) Y = 569,378.9 Y = 569,390.6 690,718.3 X = 698,641.1 32.564343 °N 32.564273 °N LAT. = LAT. = LONG. = 103.848450 °W LONG. = 103.822734 °W PPP #3 (NAD83 NME) PPP #6 (NAD83 NME)

569,360.0 569,381.0 692.040.5 X = X = 699.962.0 LAT. = 32.564274 °N LAT. = 32.564230 °N 103.844159 °W LONG. = 103.818446 °W

LTP (NAD27 NME) Y = 569.363.1 X = 659,949.8 LAT. = 32.564214 °N LONG. = 103.814156 °W **BHL (NAD27 NME)** Y = 569,364.3

X = 660,076.8 LAT. = 32.564216 °N LONG. = 103.813744 °W

LONG. = 103.847286 °W **CORNER COORDINATES (NAD27 NME)** 

569,936.8 N X = 649,535.8 E B - Y = 569.963.3 N X = 652.180.8 E C - Y = 569.986.2 N X = 654,806.2 E D - Y = 570,004.1 N 657,458.8 E X = E - Y = 570,019.6 N 660,100.1 E X =

F - Y = 568.614.7 N X = 649.542.5 E G - Y = 568,639.0 N X = 652,185.7 E H - Y = 568,661.5 N 654,814.1 E I - Y = X = 657.464.4 E 568.678.9 N I - Y = 568,695.1 N X = 660,106.6 E PPP #1 (NAD27 NME) PPP #4 (NAD27 NME)

Y = 569,935.7 Y = 569,312.7 X = 649,290.1 X = 652.183.2 LAT. = 32.565926 °N LAT. = 32.564177 °N LONG. = 103.848747 °W LONG. = 103.839365 °W PPP #2 (NAD27 NME) PPP #5 (NAD27 NME) Y = 569.317.1 Y = 569.328.8 X = 649,538.9 X = 657,461.7 32.564223 °N LAT. = 103.847948 °W LONG. =

LAT. = 32.564153 °N LONG. = 103.822232 °W PPP #3 (NAD27 NME) PPP #6 (NAD27 NME) Y = 569,298.2 Y = 569,319.2 X = X = 650.861.1 658,782,6 LAT. = 32.564154 °N LAT. = 32.564109 °N LONG. = 103.843657 °W LONG. = 103.817945 °W



2205 Walnut Street - Columbus, TX 78934
Ph: 979.732.3114 - Fax: 979.732.5271
TBPE Firm 17957 | TBPL5 Firm 10000100
www.fscinc.net
© COPYRIGHT 2023 - ALL MIGHTS RESERVED

DATE: 08-27-2025 DRAWN BY: CHECKED BY-LM FIELD CREW: IR PROIECT NO: 2019030745 SCALE: SHEET: REVISION

**LEGEND** 

330' BUFFFR

SECTION LINE WELLBORE NEW MEXICO MINERAL LEASE LINE

DEDICATED ACREAGE

Sante Fe Main Office Phone: (505) 476-3441

General Information Phone: (505) 629-6116

Online Phone Directory https://www.emnrd.nm.gov/ocd/contact-us

# State of New Mexico Energy, Minerals and Natural Resources Oil Conservation Division 1220 S. St Francis Dr. Santa Fe, NM 87505

CONDITIONS

Action 518179

### **CONDITIONS**

Operator:	OGRID:		
XTO PERMIAN OPERATING LLC.	373075		
6401 HOLIDAY HILL ROAD	Action Number:		
MIDLAND, TX 79707	518179		
	Action Type:		
	[C-103] NOI Change of Plans (C-103A)		

### CONDITIONS

Created	d By		Condition Date
ward.	.rikala	Work was performed without OCD approval.	11/4/2025