ABOVE THIS LINE FOR DIVISION USE ONLY

## NEW MEXICO OIL CONSERVATION DIVISION

- Engineering Bureau -1220 South St. Francis Drive, Santa Fe, NM 87505



			17770-1-7-0000
		ADMINISTRATIVE APPLICATION CHECKLIST	
T	HIS CHECKLIST IS M	MANDATORY FOR ALL ADMINISTRATIVE APPLICATIONS FOR EXCEPTIONS TO DIVISION RULE WHICH REQUIRE PROCESSING AT THE DIVISION LEVEL IN SANTA FE	S AND REGULATIONS
Applic	[DHC-Dow [PC-Pc		mmingling] ement] 
[1]	TYPE OF AI [A]	APPLICATION - Check Those Which Apply for [A]  Location - Spacing Unit - Simultaneous Dedication  NSL NSP SD	
		ck One Only for [B] or [C]  Commingling - Storage - Measurement  DHC CTB PLC PC OLS OLM	
	SE VIIV	Injection - Disposal - Pressure Increase - Enhanced Oil Recovery  WFX PMX SWD IPI BOR PPR	
	(ED)	Other: Specify	
[2]	NOTIFICAT [A]	TION REQUIRED TO: - Check Those Which Apply, or Does Not Apply  Working, Royalty or Overriding Royalty Interest Owners	y
	[B]	Offset Operators, Leaseholders or Surface Owner	
	[C]	Application is One Which Requires Published Legal Notice	
	[D]	Notification and/or Concurrent Approval by BLM or SLO U.S. Bureau of Land Management - Commissioner of Public Lands, State Land Office	
	[E]	For all of the above, Proof of Notification or Publication is Attached	, and/or,
	[F]	Waivers are Attached	
[3]		CCURATE AND COMPLETE INFORMATION REQUIRED TO PROCATION INDICATED ABOVE.	CESS THE TYPE
	val is <b>accurate</b> a	<b>ATION:</b> I hereby certify that the information submitted with this application and <b>complete</b> to the best of my knowledge. I also understand that <b>no action</b> required information and notifications are submitted to the Division.	
Many C		te: Statement must be completed by an individual with managerial and/or supervisory cap	
Mary C Print or	Type Name	Signature  Signature  Sr. Regulatory Analyst  Title  corleyml@bp.com	72004 Date
		a mail Adduss	



May 21, 2004

Mr. Michael Stogner New Mexico Oil Conservation Division 1220 South St Francis Drive P.O. Box 6429 Santa Fe, NM 87505

Application for Non-Standard Well Location Ulibarri Gas Com Well No. 3N S/2 Section 35-T30N-R09W Basin Dakota and Blanco Mesaverde Pools San Juan County, New Mexico San Juan South Asset

Mary Corley WL1-19.171 281-366-4491 (direct) 281-366-0700 (FAX) corleyml@bp.com

P. O. Box 3092 Houston, Texas 77253-3092 501 Westlake Park Boulevard Houston, Texas 77079

> 30-045-<del>22294</del> 31205

BP America Production Company respectfully requests an administrative approval for a non-standard well location for the Ulibarri Gas Com Well No. 3N which was directionally drilled from a surface location of 2230' FNL & 715' from FWL of Section 35, T30N, R09W. The original bottom hole location was 1875' FSL & 660' FWL of Section 35, T30N, R09W, however, in the process of attempting to run production casing we encountered a tight spot and the casing became stuck. Attempts to free the casing were unsuccessful and 10 drill collars and 24 joints were left down hole. A decision was made to abandon the open hole and sidetrack downhole. Upon obtaining NMOCD verbal approval (BP's Harald Jordan spoke with Charlie Perrin with NMOCD), whipstock was set at 210 azimuth off 183 degree original.

For your review and consideration attached is a C-102 Well Location Plat showing the well location (SHL, original BHL, and sidetracked BHL although not to scale), a 9-section plat showing the offset wells and operators, and a Directional Plot with both original and actual BHL.

BP operates the 320 acre unit in which the subject well is located and has a 50/50 working interest partnership with ConocoPhillips. BP has a 100% working interest in the affected offsetting 320 acre unit in the E/2 of Section 36, T31N, R09W. This information is also reflected on the 9 Section Plat.


Your attention to this matter is greatly appreciated. Should you have any questions concerning this application please do not hesitate to call me at 281-366-4491.

Sincerely,

Mary Corley

cc: Frank Chavez, Supervisor

NMOCD District III 1000 Rio Brazos Road Aztec, NM 87410

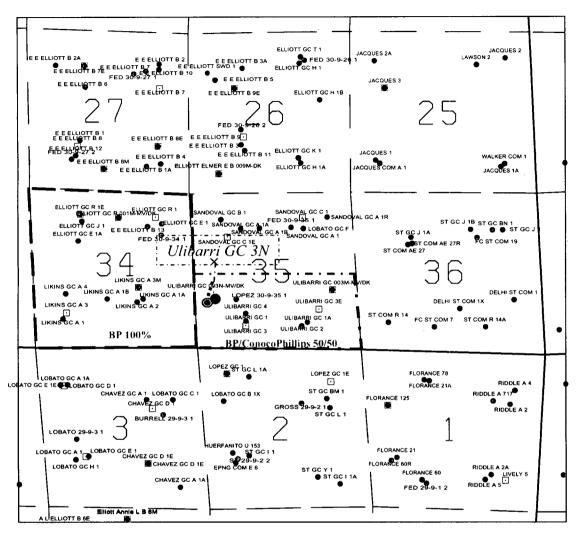

- Fruitland Coal
- Pictured Cliffs
- Mesaverde
- □ Dakota
- Original BHL

BP America Production Co. Houston, TX

San Juan Basin

T30N R9W Sec. 35

Ulibarri GC 3N - 30-045-31205

EEL | MEEN N. J. RITZ | MEEN 17-JUN-2804

I wrict I Box 1980, Hobbs NM 88241-1980 District II PO Drawer KK, Artesia, NM 87211-0719 District III 1000 Rio Brazos Rd., Aztec, NM 87410

State of New Mexico Energy, Minerals & Natural Resources Department

Form C-102 Revised February 21, 1994 Instructions on back

Submit to Appropriate District Office State Lease - 4 Copies

Fee Lease - 3 Copies

# OIL CONSERVATION DIVISION PO Box 2088 Santa Fe, NM 87504-2088


District IV PO Box 2088, Sar	nta Fe, NM 8	7504-2088			·				[	AM	ENDED REPORT
		WE	ELL LO	CATION	I AND A	CRE	AGE DEDIC	ATION PLA	ΛT		
	API Number			<sup>2</sup> Pool Code				³ Pool 1	1	4	/
			715	99 ° 12		BA	SIN DAKOT	A ? BL	AN CO	M	ESAUERDE
Property	A)	1	III TRAI	DDT CA	Property Name RI GAS COM						# 3 \/
O() // OGRID	No.		ULIBA	ICICI GA		perator l	Name			,	Elevation
0007	78	]	BP AM	ERICA	PRODU	J <b>CT</b>	ION COMPA	NY		<u>.</u>	5679
					10 Surfa	ce L	ocation			•	
UL or Lot No.	Section	Township	Range	Lot Idn	Feet from	· .	North/South line	Feet from the	Bast/West		County
E	35	30 N	9 W		223		NORTH	715	Wi	EST	SAN JUAN
T	Section	1		<del>,</del>			Different From	· · · · · · · · · · · · · · · · · · ·	East/Wes	et line	County
UL or lot no.	35	Township 30 N	Range 9 W	Lot Idn	Feet from		North/South line SOUTH	Feet from the		EST	SAN JUAN
12 Dedicated Acr	<u> </u>	t or Infill	1 - ''	on Code 15	Order No.	<u> </u>	300111	000		201	
320											
	WABLE	WILL BE	ASSIGN	ED TO TH	IS COMPI	LETIC	ON UNTIL ALL I	NTERESTS H	AVE BE	EN CC	NSOLIDATED
			NON-ST	TANDARI	UNIT HA		EN APPROVED	BY THE DIV	ISION		
ió	263	7(R)				2563	(R)	17 OPE	RATOR	CER	TIFICATION
		ļ									ation contained herein is
								true and o	omplete to ti	ne best of	my knowledge and belie
! خ	  -		. (	W					1	11	,
(S)	(73		۰٬۷	`					asul	res la	16
2559(R)		3050 6	<del>{\}'-</del>					Signature	110	a a de	150
2			ς <b>ν</b> `					Printed N	Marrier (C	RE	9
		2001						Se.	Kegu	lato	ey Malus
		1202						Title		1.2	Jan Jan
715'								Date	120	2005	<u> </u>
	Azimuth	181°55'	998'					3 ST TD	VEVOI		RTIFICATION
2	~~~			35~	***	<b>***</b>	*****	<del></del>			cation shown on this pla
8 2		İ						was plotte	d from field.	notes of ac	ctual surveys made by m
82 83				į					o the best of		hat the same is true and f.
	Better	Hole Lo	eation	<del>- i</del> i				{ <b>}</b>		72,20	002
560	10/5	F/SL 00	U·F/WL					Date of	•	Denfacel	and Commerces
N A								) Signatur	and Seed of	Holesa	ontal Surveyor
540 d		<del> </del>							/ W. S. W.	A STATE OF THE PARTY OF THE PAR	<b>6</b>
		:						- SS /		311	<b>}} </b> €
<b>  </b>								<b>}</b> }		POSE	SERVER
		<del>                                     </del>						<b>/</b>	Restriction		/ [\$]
S SPAL S	1864							<b>{}</b>	( PA)		LIN
1) 17 y 56	· • (							<b>∤</b> 701	6 TUFE	140128	IL .

Certificate Number

6. KMS GC 100%

Elliott GCR 100%

Elliott GCE 100%

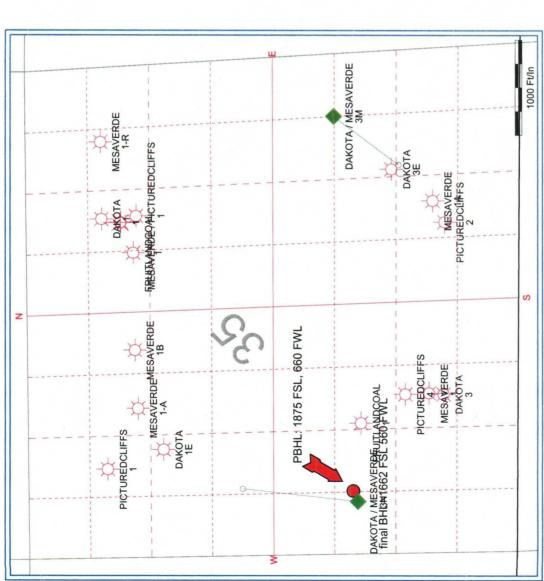


PETRA 6/17/2004 11:33:43 AM

# Schlumberger BP America Inc.



Ulibarri Gas Com 3N	San Juan County, New Mexico	AWS 54			
Magnetic Parameters	Surface Location	Plan# : Rev0 ST1 jok 03-Feb-03			
Model: BGGM 2002	Lat: N36 46 7.400 Lon: W107 45 23.200	Slot: Ulibarri Gas Com 3N (Have Lat-Long)			
Dip: 63.678° Mag Dec: 10.902°	North: 2099142.53 ftUS East: 2745611.67 ftUS	Elev Ref: RKB(5693.00ft above MSL)			
Date: February 07, 2003 FS: 51519.3 nT	Grid Conv: 0.0460° Scale Fact:0.9999	Date Drawn: 01:03:54PM 02-Apr-2003			

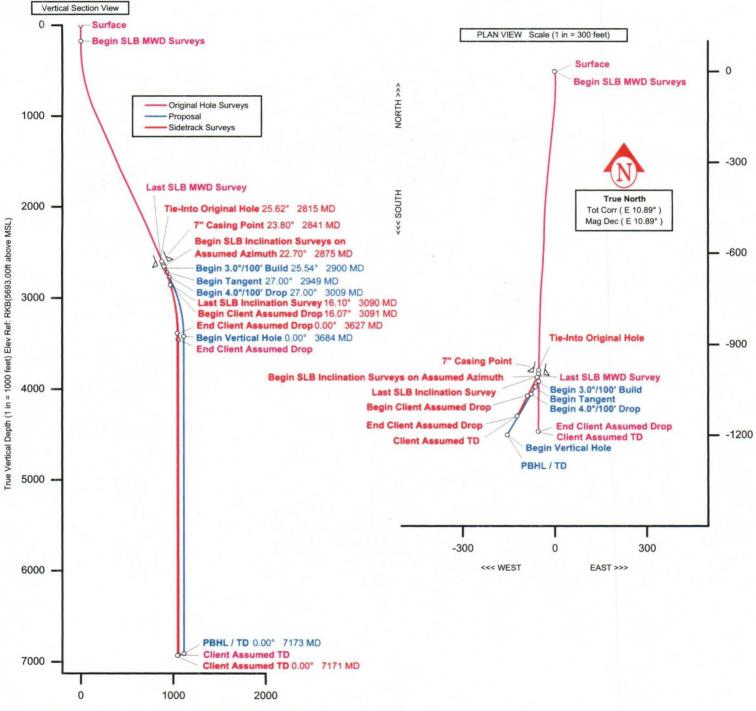

Vertical Section Departure at 210.00 deg from (0.0, 0.0). (1 in = 1000 feet)

**Quality Control** Date Drawn: 02-Apr-2003 Drawn by: James Wimberg Checked by: John O'Keefe Client OK:

### Stogner, Michael

From: Corley, Mary L [corleyml@bp.com]

Sent: Thursday, September 02, 2004 1:38 PM

To: MSTOGNER@state.nm.us

Subject: NSL Application

### Mr. Stogner,

Could you please advise on the status of an NSL application which was filed by BP America on May 21, 2004:

Ulibarri Gas Com Well No. 3N API # 30-045-31205 S/2 Section 35-T30N-R09W

Your attention to this matter is greatly appreciated. Thank you,

Mary Corley Senior Regulatory Analyst San Juan Performance Unit 281-366-4491

This email has been scanned by the MessageLabs Email Security System. For more information please visit http://www.messagelabs.com/email