
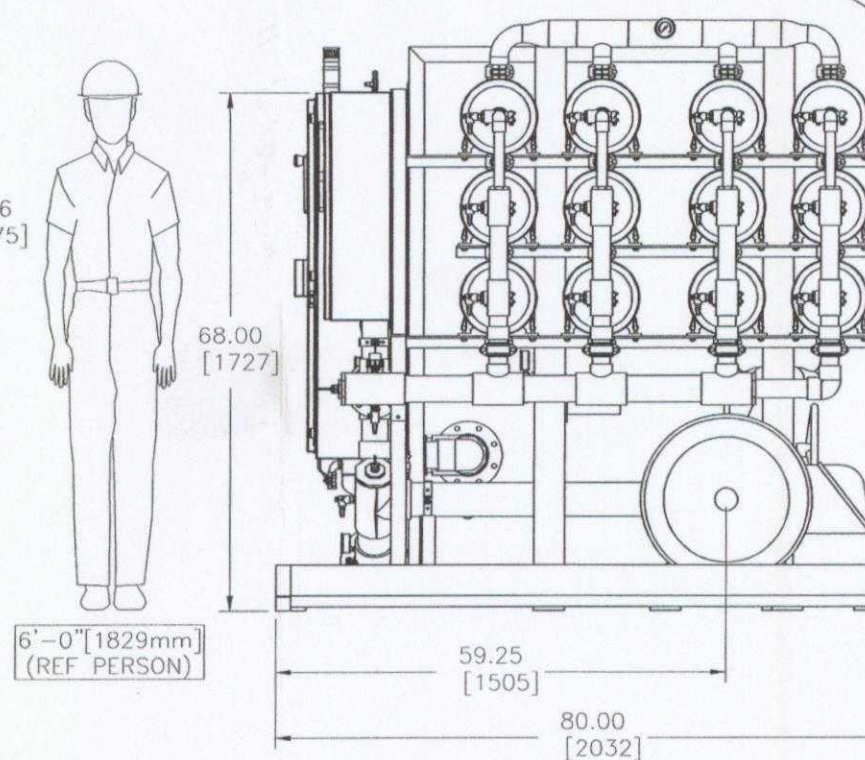
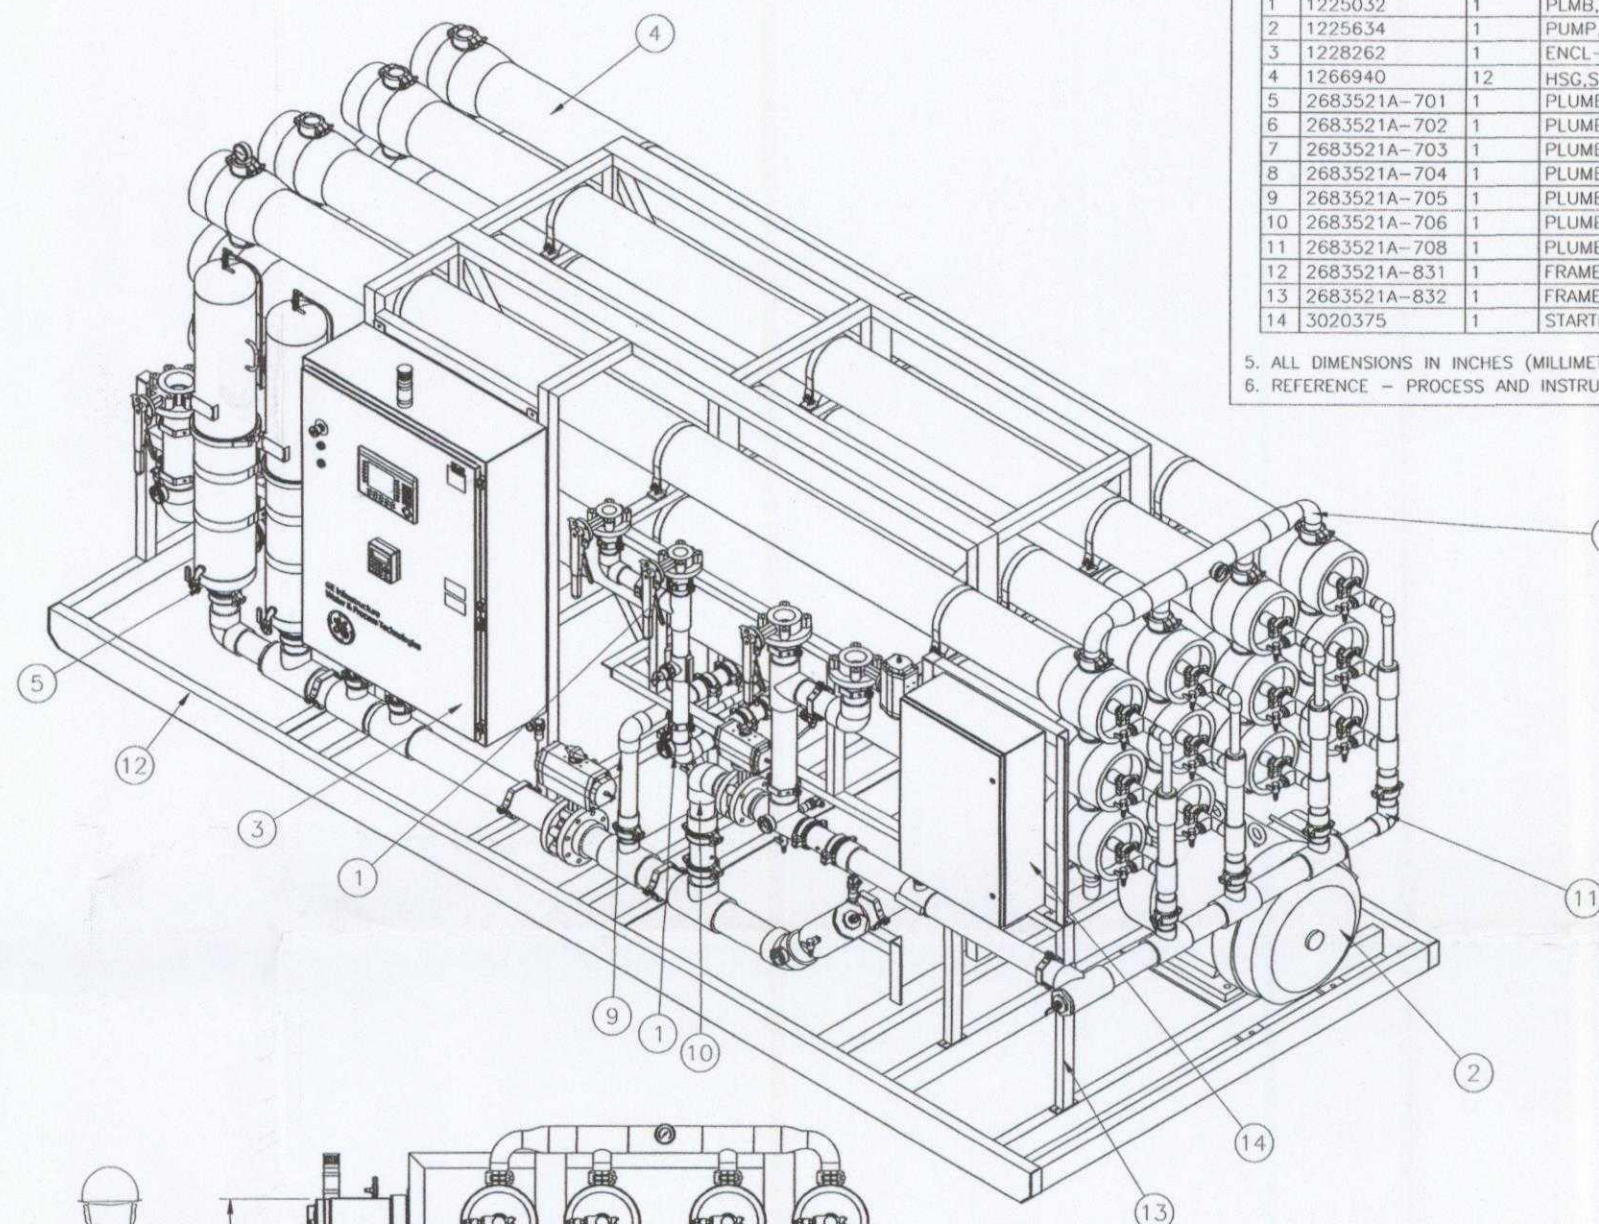
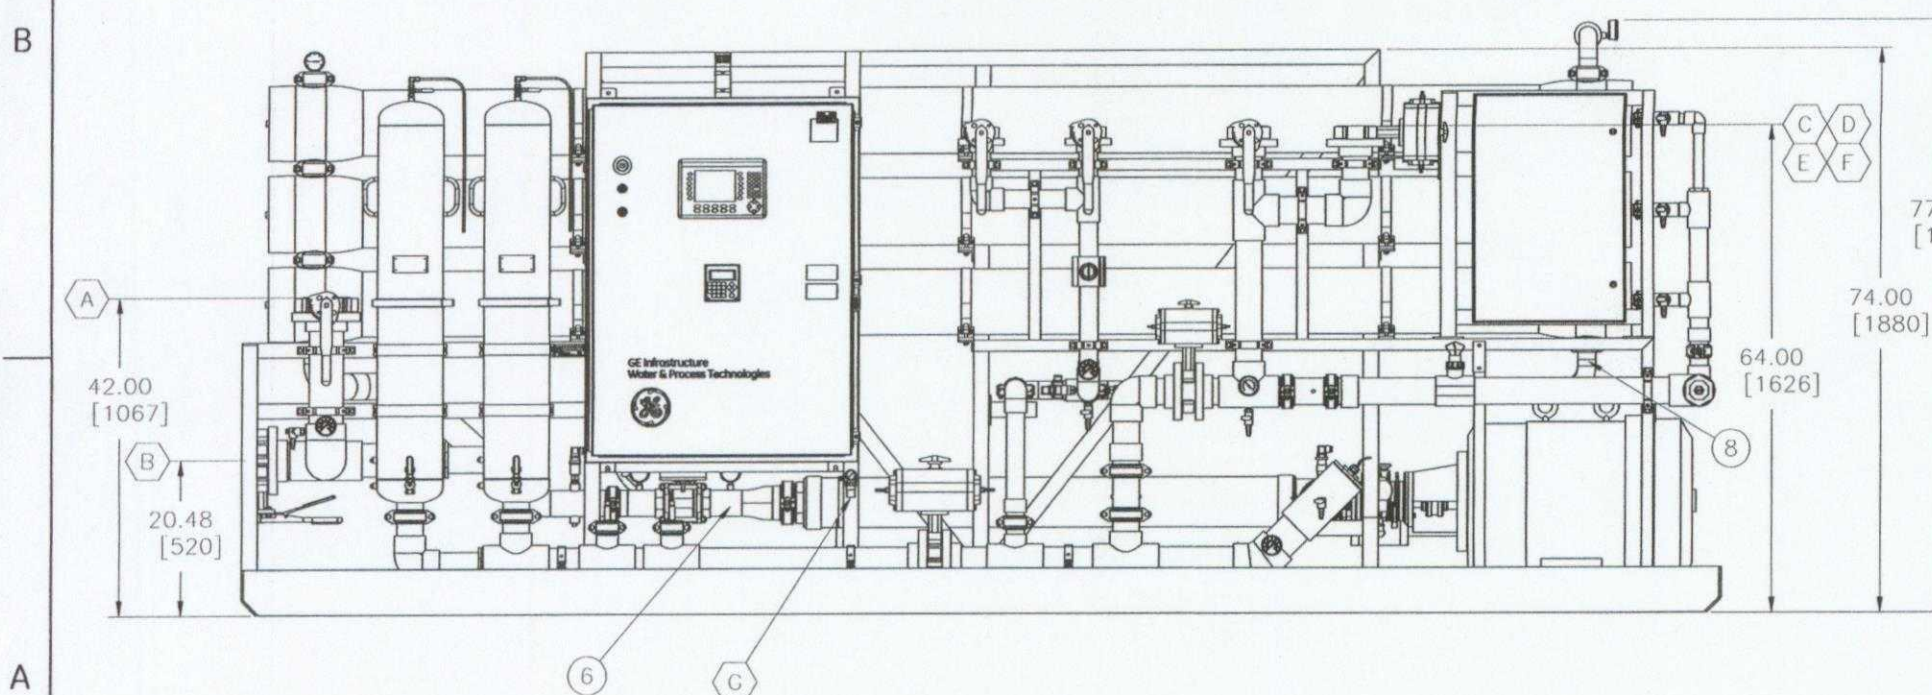


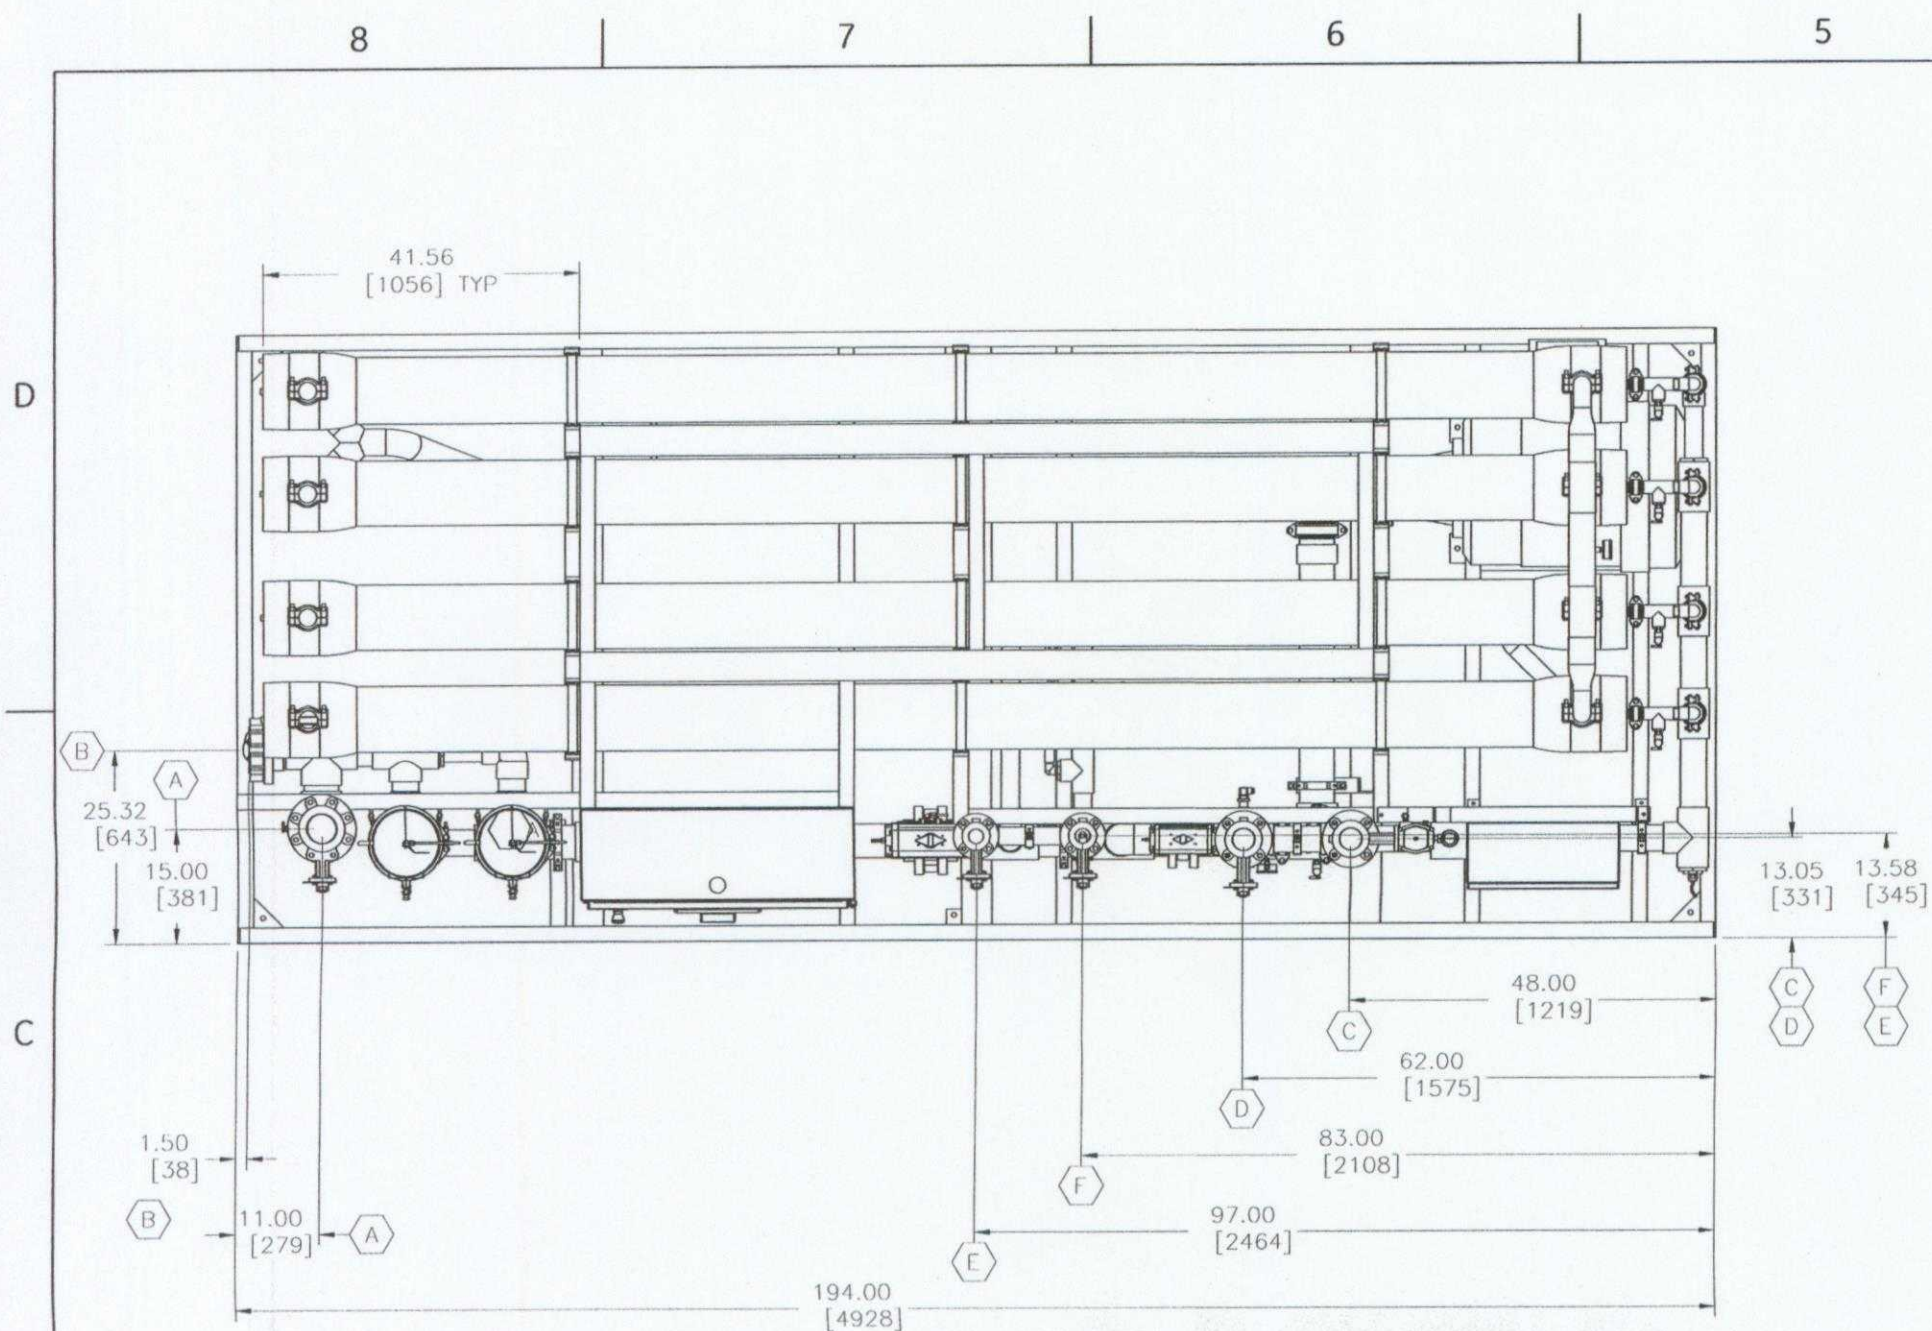

1. CONNECTION TABLE

ITEM	DESCRIPTION	MATERIAL	TYPE	SIZE
(A)	INLET	PVC	150# FLANGE	4.00
(B)	INLET CIP	PVC	150# FLANGE	4.00
(C)	PERMEATE OUTLET	PVC	150# FLANGE	3.00
(D)	PERMEATE CIP OUTLET	PVC	150# FLANGE	3.00
(E)	CONCENTRATE OUTLET	PVC	150# FLANGE	2.00
(F)	CONCENTRATE CIP OUTLET	PVC	150# FLANGE	2.00
(G)	COMPRESSED AIR INLET	ZINC	FNPT	0.25

2. SHIPPING WEIGHT - 7100 LB/[3220 Kg].

3. OPERATING WEIGHT - 10300 LB/[4682 Kg].

4. PLUMBING RUN \ EQUIPMENT TABLE:

ITEM NO.	PART NUMBER	QTY.	DESCRIPTION	U/M
1	1225032	1	PLMB, CONC, PVC, 2.0	EA
2	1225634	1	PUMP, TF, AS40412KTF, 100HP, TEFC	EA
3	1228262	1	ENCL - MACH, PRO - PRE, 48X36X12, N12	EA
4	1266940	12	HSG, SH-4/B23, FRP, 3.2VIC, 4P, WAVEC, 450, CODE	EA
5	2683521A-701	1	PLUMB, INLET, PVC, 4.0, PRO-200	EA
6	2683521A-702	1	PLUMB, PUMP DISCH, 3.16, 3.0, PRO-200	EA
7	2683521A-703	1	PLUMB, MANIFOLD, 3.16, 3.0, PRO-200	EA
8	2683521A-704	1	PLUMB, CONC - HP, 3.16, PRO-200	EA
9	2683521A-705	1	PLUMB, CONC RECYCLE, PVC, 4.0, PRO-200	EA
10	2683521A-706	1	PLUMB, PERM FLUSH, PVC, 3.0, PRO-200	EA
11	2683521A-708	1	PLUMB, PERMEATE, PVC, 4.0, PRO-200	EA
12	2683521A-831	1	FRAME, CS, 194LX80WX74H, PRO-200	EA
13	2683521A-832	1	FRAME, CS, BOLT DOWN ASSY	EA
14	3020375	1	STARTER, ABB, COMBO, IEC, 460VAC, 100HP, N12	EA

5. ALL DIMENSIONS IN INCHES (MILLIMETERS IN BRACKETS).

6. REFERENCE - PROCESS AND INSTRUMENTATION DIAGRAM : 2683521A-953.

REV	DESCRIPTION	ECO	DWN	APVD	DATE	CHKD
B	AS BUILT REVISION		SSS		15Oct07	SSS
A	INITIAL RELEASE		GAH		23Jul07	BMM

TOLERANCES UNLESS NOTED	DECIMALS	ANGLES
X ± 0.3	± 1°	
.XX ± 0.13		
.XXX ± 0.063		
FRAC	± 1/A	

DRAWN BY	DATE
GAH	13Jul07
CHECKED BY	DATE
BMM	23Jul07
APPROVED BY	DATE
HN	23Jul07
APPROVED BY	DATE

GE
Water & Process Technologies

GLOBAL HEADQUARTERS - WILMINGTON, VA, USA - 1-219-355-3300 - WWW.GEWATER.COM

THIS DRAWING, THE DESIGN AND THE PATENTS IT COVERS, IS THE PROPERTY OF GENERAL ELECTRIC COMPANY AND ITS AFFILIATES. AND THE INFORMATION CONTAINED HEREIN IS PROPRIETARY INFORMATION WHICH IS NOT TO BE DISCLOSED TO ANYONE WITHOUT PRIOR WRITTEN CONSENT OF GEC COMPANY. THIS DRAWING IS TO BE USED EXCLUSIVELY FOR THE PURPOSES EXPRESSLY AUTHORIZED BY GENERAL ELECTRIC COMPANY AND ITS AFFILIATES THROUGH ITS OFFICERS AND QUALIFIED REPRESENTATIVES AND FOR NO OTHER PURPOSE. NEITHER THIS DRAWING, NOR ANY PORTION THEREOF, SHALL BE REPRODUCED WITHOUT THE PRIOR WRITTEN CONSENT OF GEC COMPANY, AND ANY SUCH REPRODUCTION SHALL BEAR THIS NOTICE.

CLIENT/JOB	DWG DESCRIPTION
MARALEX DISPOSAL IGNACIO, CO	GA, RO, PRO-200-PRE, FRP, 460, 60, AB, SS PIPE
FILE	MATERIAL/BOM NO.
ACR2004	2683521A

SIZE	DRAWING NO.	REV
D	2683521A-951	B
PROJECT	SCALE	SHEET
2683521	3/4"=1'-0"	1 OF 2

P/N 1161662-RGP01