

June 5, 2003

RECEIVED

To Whom It May Concern:

JUN 30 2003

Oil Conservation Division

Re: WTYSRU Well #945 – West Teas Field  
2612' FNL – 330' FEL  
Sec 9-T20S-R33E  
Lea County, New Mexico

Chesapeake Energy, Inc. is making application to convert the #945, an oil well, to injection in an effort to further our recovery at the previously approved West Teas Yates Seven River Unit (Order # R-11375). Water will be injected into the Yates Sand interval per the attached schematic. There are no known oil or gas bearing zones relatively close to the unitized formations which could be affected by this proposed conversion. A copy of the application is enclosed which we anticipate will be administratively approved.

As one who may be affected by this application, we are notifying you of your right to participate in this process, including the right to provide evidence to the NMOGCD either in support or in opposition to the application. Interested parties must file objections or requests for hearing with the Oil Conservation Division, 1220 South St. Francis Dr., Santa Fe, New Mexico 87505, within 15 days of receipt of this notice. If you desire more information, you may contact Andrew McCalmont at (405) 879-7852.

Very truly yours,



Andrew McCalmont  
Asset Manager – Permian Basin  
Chesapeake Energy, Inc.

APPLICATION FOR AUTHORIZATION TO INJECT

I. PURPOSE:  Secondary Recovery  Pressure Maintenance  Disposal  Storage  
Application qualifies for administrative approval?  Yes  No

II. OPERATOR: Chesapeake Energy Inc.

ADDRESS: PO Box 18496 Oklahoma City, OK 73154-0496

CONTACT PARTY: Andrew McCalmont PHONE: 405-879-7852

III. WELL DATA: Complete the data required on the reverse side of this form for each well proposed for injection.  
Additional sheets may be attached if necessary.

IV. Is this an expansion of an existing project?  Yes  No  
If yes, give the Division order number authorizing the project: R-11375

V. Attach a map that identifies all wells and leases within two miles of any proposed injection well with a one-half mile radius circle drawn around each proposed injection well. This circle identifies the well's area of review.

VI. Attach a tabulation of data on all wells of public record within the area of review which penetrate the proposed injection zone. Such data shall include a description of each well's type, construction, date drilled, location, depth, record of completion, and a schematic of any plugged well illustrating all plugging detail.

VII. Attach data on the proposed operation, including:  
1. Proposed average and maximum daily rate and volume of fluids to be injected;  
2. Whether the system is open or closed;  
3. Proposed average and maximum injection pressure;  
4. Sources and an appropriate analysis of injection fluid and compatibility with the receiving formation if other than reinjected produced water; and,  
5. If injection is for disposal purposes into a zone not productive of oil or gas at or within one mile of the proposed well, attach a chemical analysis of the disposal zone formation water (may be measured or inferred from existing literature, studies, nearby wells, etc.).

\*VIII. Attach appropriate geologic data on the injection zone including appropriate lithologic detail, geologic name, thickness, and depth. Give the geologic name, and depth to bottom of all underground sources of drinking water (aquifers containing waters with total dissolved solids concentrations of 10,000 mg/l or less) overlying the proposed injection zone as well as any such sources known to be immediately underlying the injection interval.

IX. Describe the proposed stimulation program, if any.

\*X. Attach appropriate logging and test data on the well. (If well logs have been filed with the Division, they need not be resubmitted).

\*XI. Attach a chemical analysis of fresh water from two or more fresh water wells (if available and producing) within one mile of any injection or disposal well showing location of wells and dates samples were taken.

XII. Applicants for disposal wells must make an affirmative statement that they have examined available geologic and engineering data and find no evidence of open faults or any other hydrologic connection between the disposal zone and any underground sources of drinking water.

XIII. Applicants must complete the "Proof of Notice" section on the reverse side of this form.

XIV. Certification: I hereby certify that the information submitted with this application is true and correct to the best of my knowledge and belief.

NAME: Andrew McCalmont TITLE: Asset Manager

SIGNATURE: Andrew McCalmont DATE: 6/5/03

\* If the information required under Sections VI, VIII, X, and XI above has been previously submitted, it need not be resubmitted. Please show the date and circumstances of the earlier submittal: Case No. 12272, Order No. R-11375, 5/18/2000.

# PROPOSED WELLBORE SCHEMATIC


## CHESAPEAKE OPERATING INC

**WELL** : WTU #945  
**FIELD** : WEST TEAS  
**COUNTY** : LEA **STATE** : NM  
**LOCATION** : 2,612' FNL & 330' FEL, SEC. 9-T20S-R33E  
**ELEVATION** : GL 3,553' RKB 3,569'  
**API NO.** : 30-025-36079  
**SERIAL NO.** : NMNM 104724



30-025-36079  
 2612 FNL - 330 FEL  
 H

HOLE SIZE TOC @ Surface

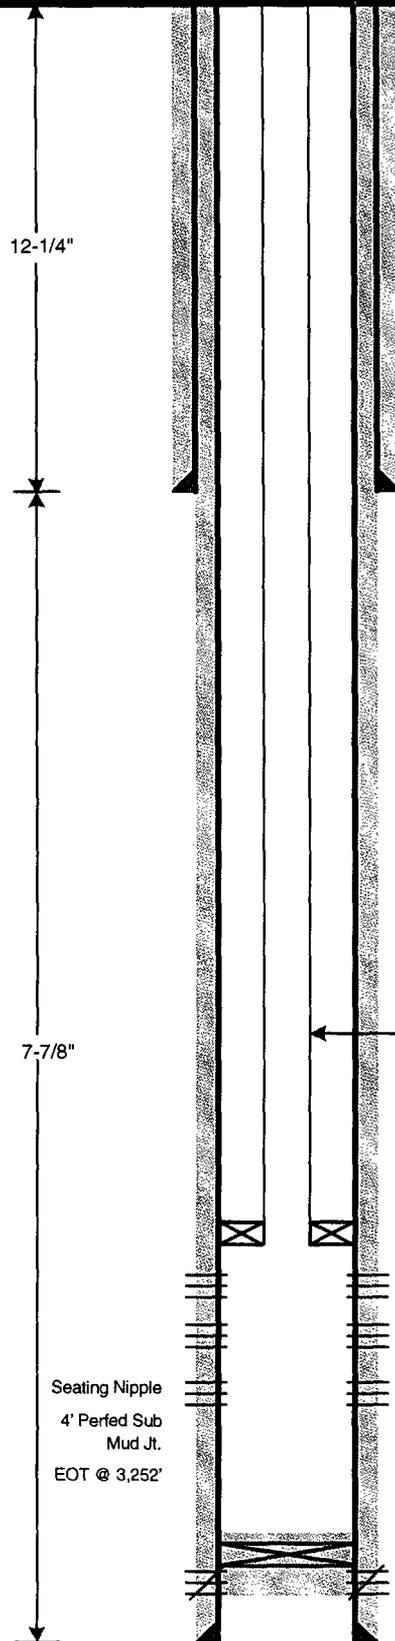

**Surface Casing:**  
 8-5/8" 32# J-55 LT&C @ 1,329'  
**Cmt.**  
 Lead: 405 sx HLP + 0.25 pps flocele + 2% CaCl<sub>2</sub> @ 12.7 ppg & 1.89 yd.  
 Tail: 250 sx Prem. Plus + 2% CaCl<sub>2</sub> @ 14.8 ppg & 1.32 yd.  
 Circ. 93 bbls cmt. to surface

**Well History**

2/15/03: Spud Well @ 3:30 pm  
 2/18/03: Run 29 Jts. 8-5/8" surface csg; cmt. to surface  
 2/23/03: Run OH logs; LDDP  
 2/24/03: Run 95 jts. 5-1/2" production casing; cmt. to surface  
 2/25/03: Release Drilling Rig @ 5:00 am  
 3/19/03: RIH w/ GR, tag bottom @ 3,290'; not deep enough. Did not log.  
 3/21/03: RU & NU BOP  
 3/22/03: Drill FC @ 3,310'. Drill down to 3,350'.  
 3/24/03: Log well from 3350-2300'. Perf Seven Rivers @ 3118-3122'.  
 3/25/03: Load tbg. w/ acid. Press. up, broke back @ 1150 psi. & 0.2 bpm. ISIP 975 psi. RU to swab. FL @ 900' FS. Swab back 10 bbls, FL @ 200' FS; trace oil.  
 3/26/03: RIH w/ swab; FL @ 1900' FS. Swab down to 3000'. Acidize Seven Rivers perfs w/ 500 gal 28% NeFe. Well went on vacuum @ .5 min over flush. RU to Swab. FL @ 900' FS, swab down to 2900' FS (static)  
 3/27-28/03: Set Cmt. Rtr. @ 3300'. Sqz. 7 Rivers perfs w/ 75 sx cmt.  
 3/29-31/03: Perf Yates "2". Acidize w/ 1000 gal 15% NeFe acid & 30 BS. Frac. w/ 20,000 gal. gelled borate & 40,000# 20/40 sd. ISIP 2620 psi, 5 min. 2150 psi, 10 min. 1940 psi, 15 min. 1820 psi. MTP 3120 psi, MTR 31.6 bpm. ATR 29.8 bpm. Set CIBP @ 3,170'. Perf Yates "1L" @ 3,128-3,152' w/ 1 spf. Perf Yates "1U" @ 3,096-3,108' w/ 1 spf. Acidize w/ 1000 gal 15% NeFe & 35 BS. Frac w/ 20,000 gal. gelled borate & 45,000# 20/40 sd. ISIP 1950 psi, 5 min. 2800 psi, 10 min. 1690 psi, 15 min. 1600 psi. MTP 2100 psi, MTR 30.6 bpm. ATP 1950 psi. SISD.  
 4/1-2/03: GIH w/ bit & DC & tag sand @ 3154'. CO sand w/ foam unit to 3170' CIBP. DO CIBP; plug fell to 3270'. CO sand to 3292' PBTB. Circ. clean, RD foam unit. SISD.  
 4/3-4/03: RIH w/ tbg. string. RIG w/ swab, FL @ 1500' FS. Swab down to 1800', FL staying static @ 1800'; 10% oil cut. Total 7 BO, 71 BW.  
 4/4/03: RIH w/ RHBC pump & rod string. MIPU & hook up electricity.  
 4/5/03: First sales 4/5/03; Prod. to WTU central oil & gas batteries.  
 4/14/03: 24 hr. rate on 20/64" ck: 103 BO, 22 BW, 13 MCF, TP 48 psi, CP 30 psi

IPC Baker AD-1 Pkr. @ 3,046'  
 Yates "1U" Perfs @ 3,096-3,108' (1 spf)  
 Yates "1L" Perfs @ 3,128-3,152' (1 spf)  
 Yates "2" Perfs @ 3,188-3,218' (1spf)  
 PBTB @ 3,292'  
 Cmt. Rtr. @ 3,300' w/ 75 sx cmt.  
 Seven Rivers Perfs @ 3,318-3,322' (4spf) - Sqzd.


**Production Casing:**  
 5-1/2" 15.5# J-55 LT&C @ 3,360'  
**Cmt.**  
 Lead: 440 sx HLP + 0.25 pps flocele @ 12.4 ppg & 2.1 yd.  
 Tail: 280 sx 50:50 Poz + adds. @ 14.2 ppg & 1.39 yd.  
 Circ. 13 bbls cmt. to surface

**PREPARED BY:** Ginni A. Kennedy  
**UPDATED BY:** \_\_\_\_\_

**DATE:** 6/6/03  
**DATE:** \_\_\_\_\_

Item V

Only Chesapeake Operating operates any well producing from the Yates -Seven Rivers Formation within 1/2 mile radius of any proposed injectors

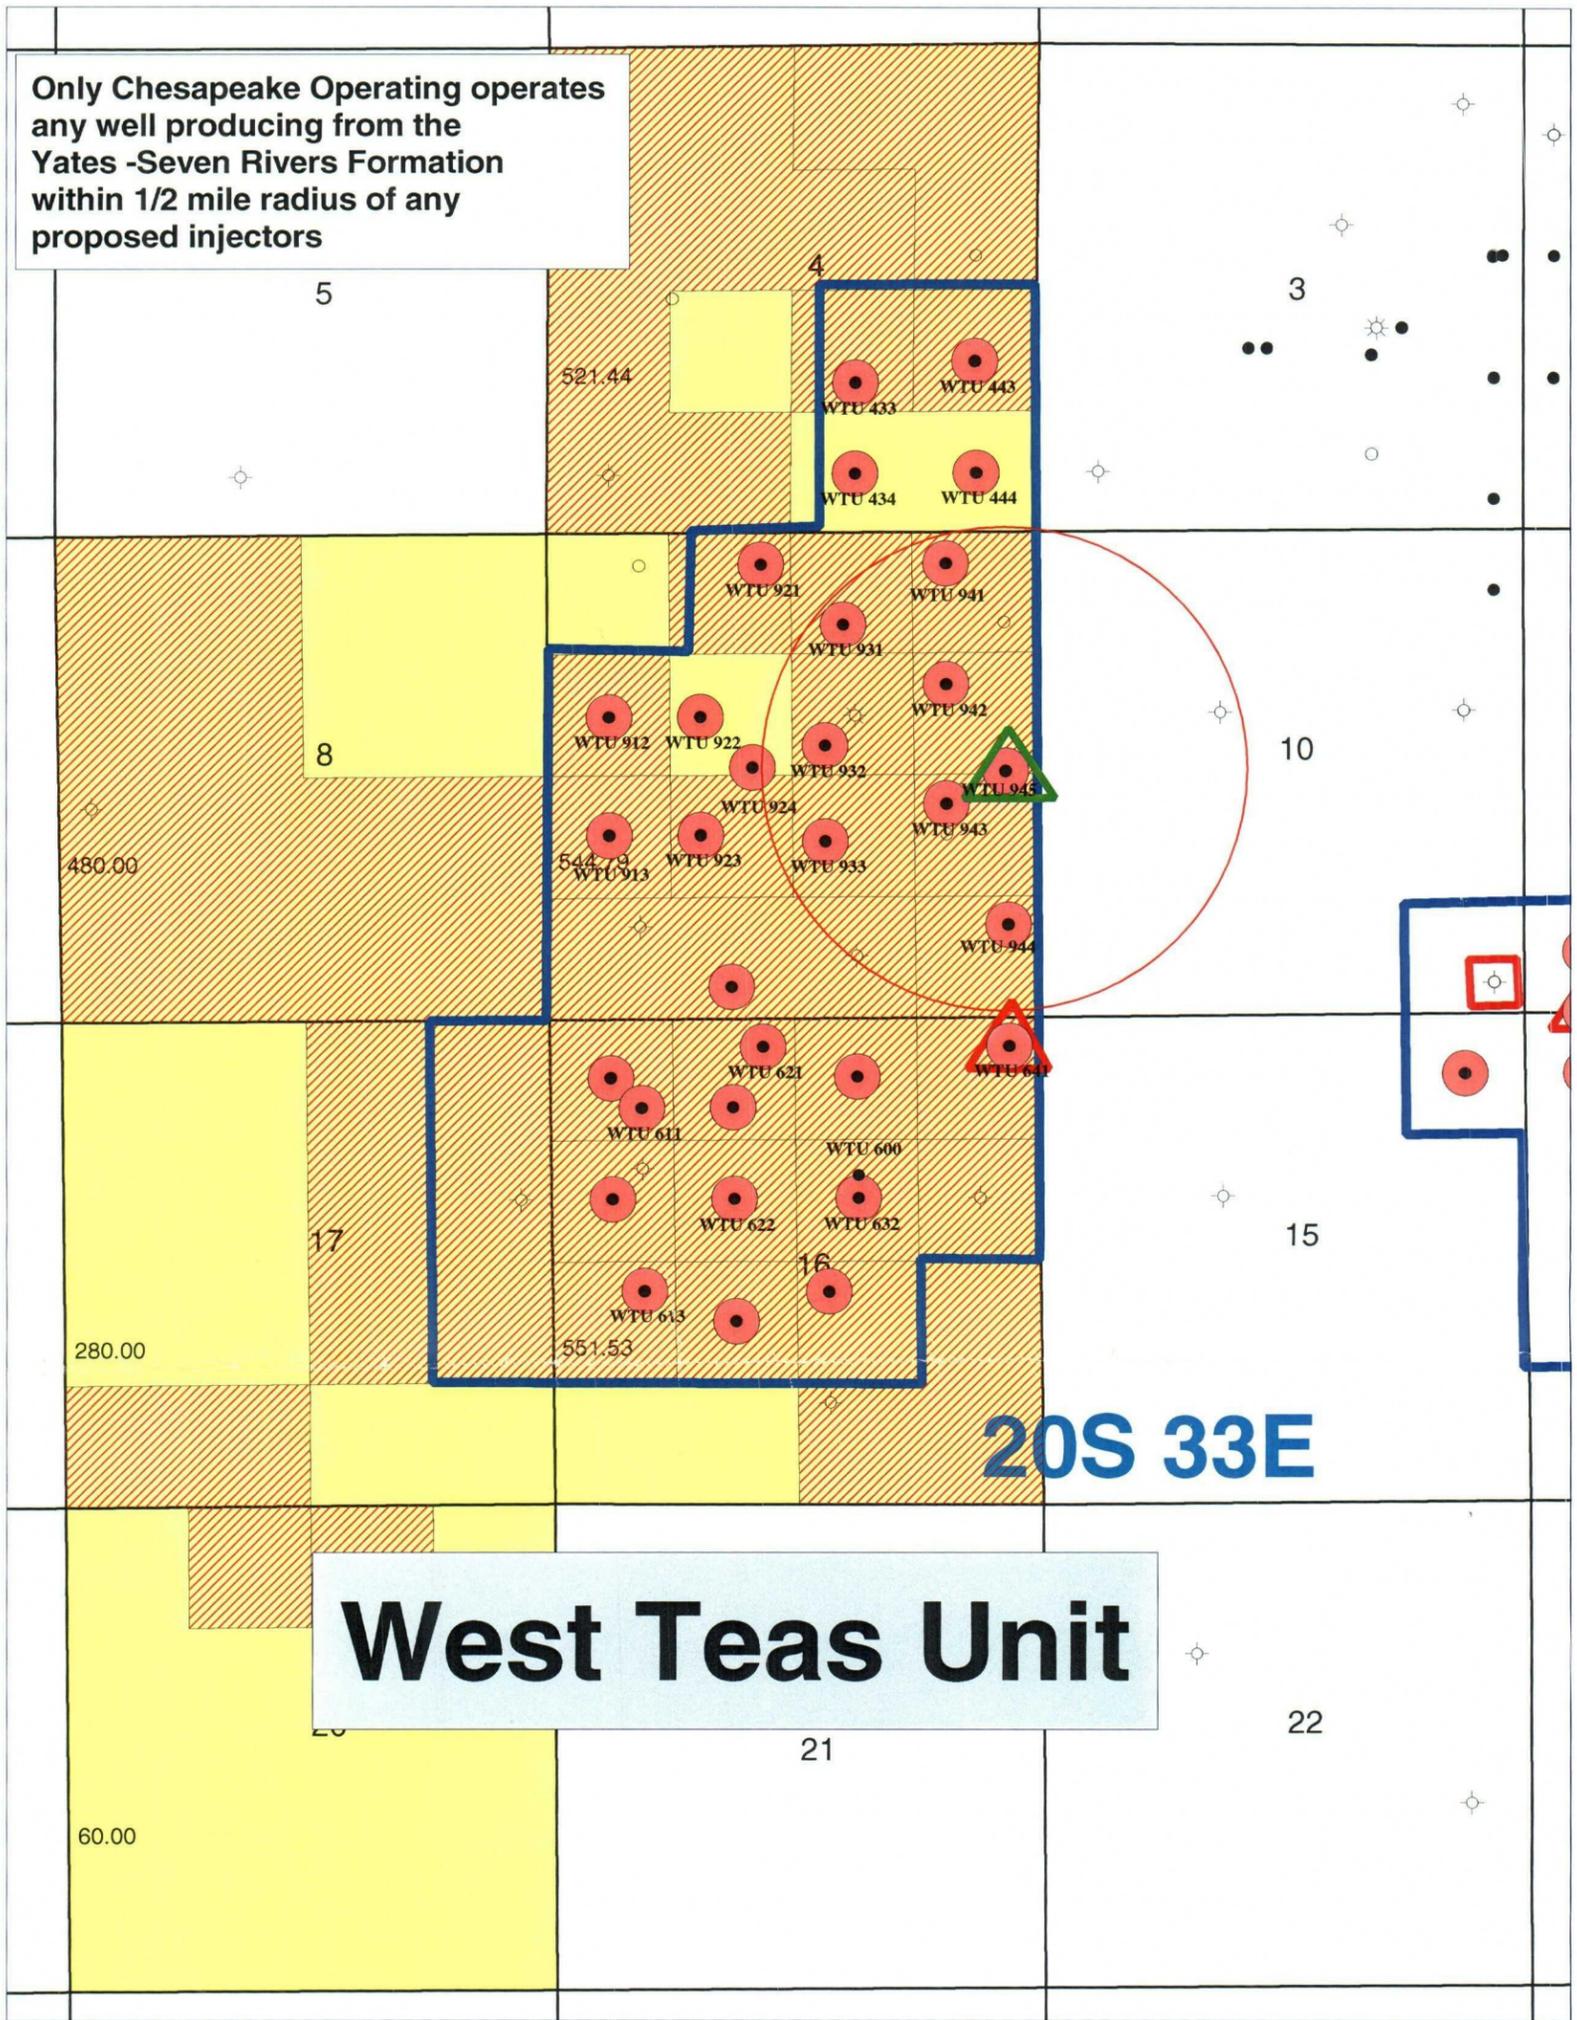


# West Teas Unit

20S 33E

- YATES/SEVEN RIVERS PRODUCERS
- WATER FLOOD UNITS
- △ YATES INJECTORS
- △ PLANNED YATES INJECTORS
- COI ACREAGE
- COI TRACT OWNERSHIP

 <b>CHESAPEAKE OPERATING, INC.</b>	
<b>WEST TEAS YATES SEVEN RIVERS          WATERFLOOD UNIT 945          1/2 MILE RADIUS OF PROPOSED INJECTOR</b> Lea County, New Mexico	
Date: 2 June, 2003 Scale: 1" = 2000'	Geol/Eng: DB / BL / AM

Item V

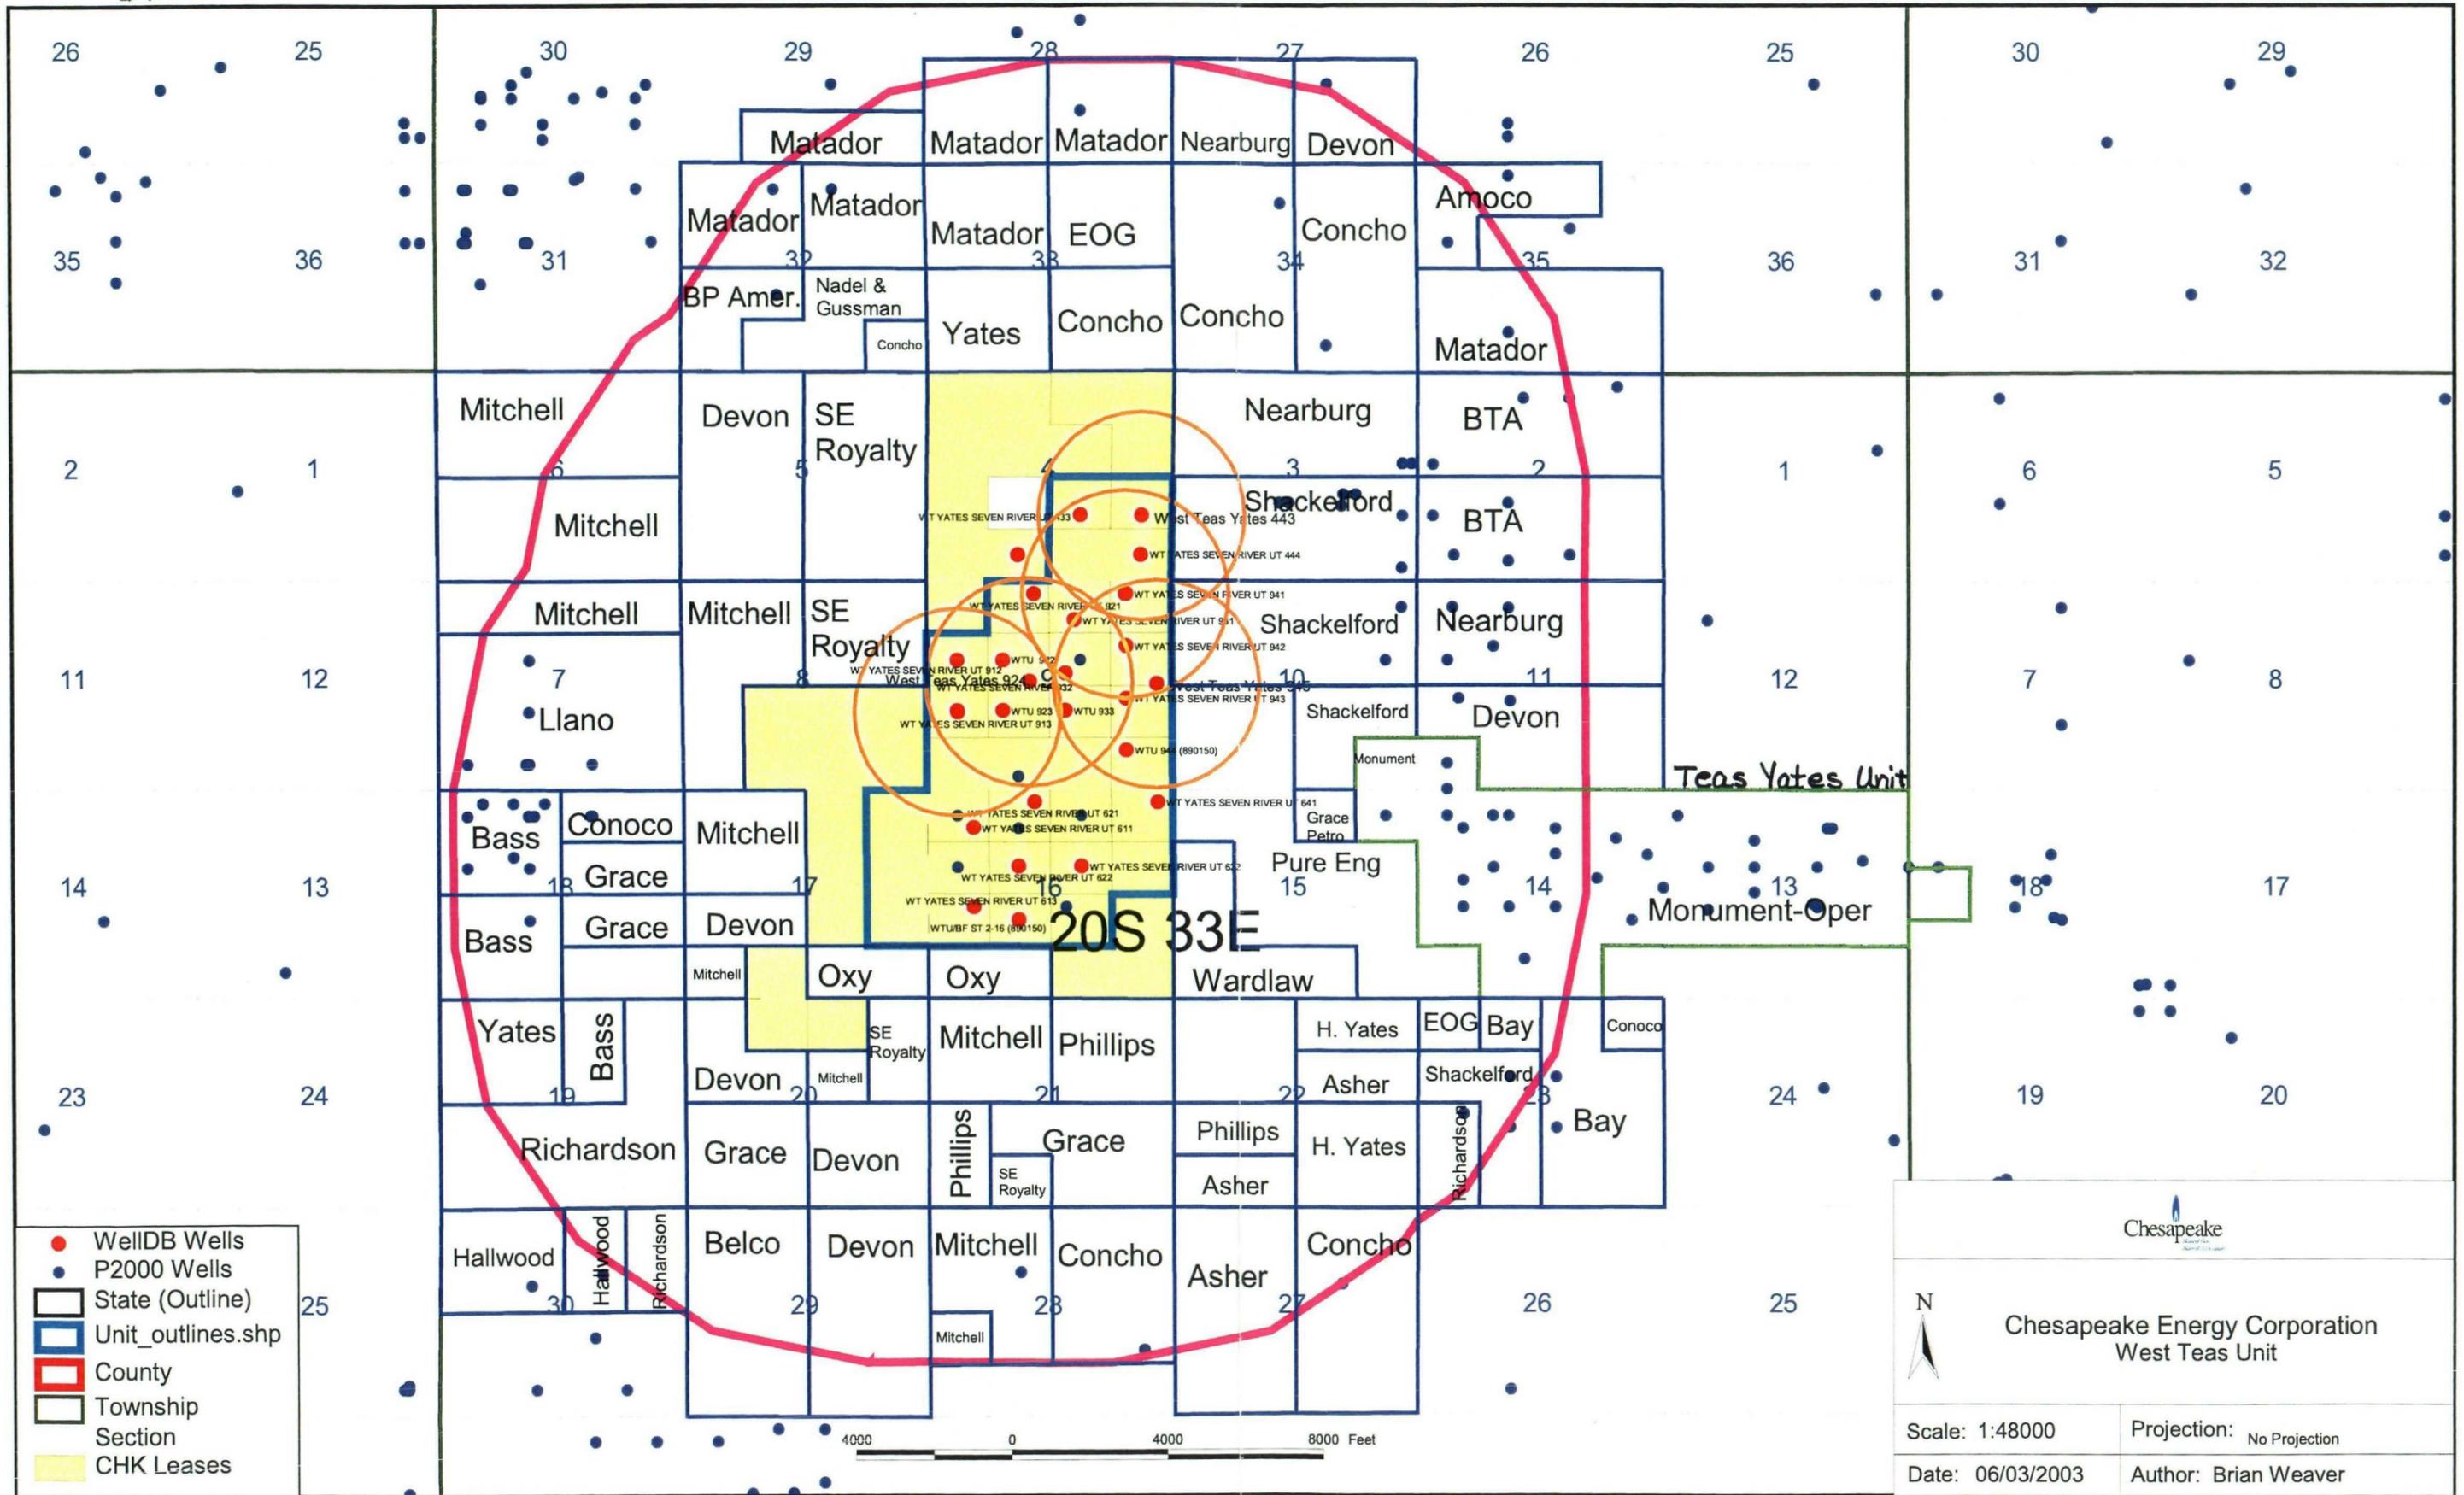

- WellIDB Wells
- P2000 Wells
- ▭ State (Outline)
- ▭ Unit\_outlines.shp
- ▭ County
- ▭ Township Section
- ▭ CHK Leases

Chesapeake

Chesapeake Energy Corporation  
West Teas Unit

Scale: 1:48000      Projection: No Projection

Date: 06/03/2003      Author: Brian Weaver


**WTU 945 - C108 - Item VI**  
**Wellbore Schematic/Data Tabulation**

	Well Name	Prior Name	Location	Status
1	WTU 941	Federal 9 #5	9F-20S-33E	Producing
2	Tonto #1	NA	10F-20S-33E	P&A
3	WTU 931	Federal 9 #2	9B-20S-33E	Producing
4	WTU 932	Federal 9 #1	9G-20S-33E	Producing
5	WTU 942	Federal 9 #6	9H-20S-33E	Producing
6	WTU 933	Grover Fed #3	9J-20S-33E	Producing
7	WTU 943	Federal 9 #7	9I-20S-33E	Producing
8	WTU 944	Federal 9 #8	9P-20S-33E	Producing
9	Anasazi 9 Federal	NA	9G-20S-33E	Producing

# Falcon Creek Resources, Inc.

RT. 4

**WTU #941**  
 (Federal "9" #5)  
 West Teas Field  
 "A" Section 9, T20S, R33E  
 Lea County, New Mexico  
 GL: 3,555'; KB: 3,566' (11')

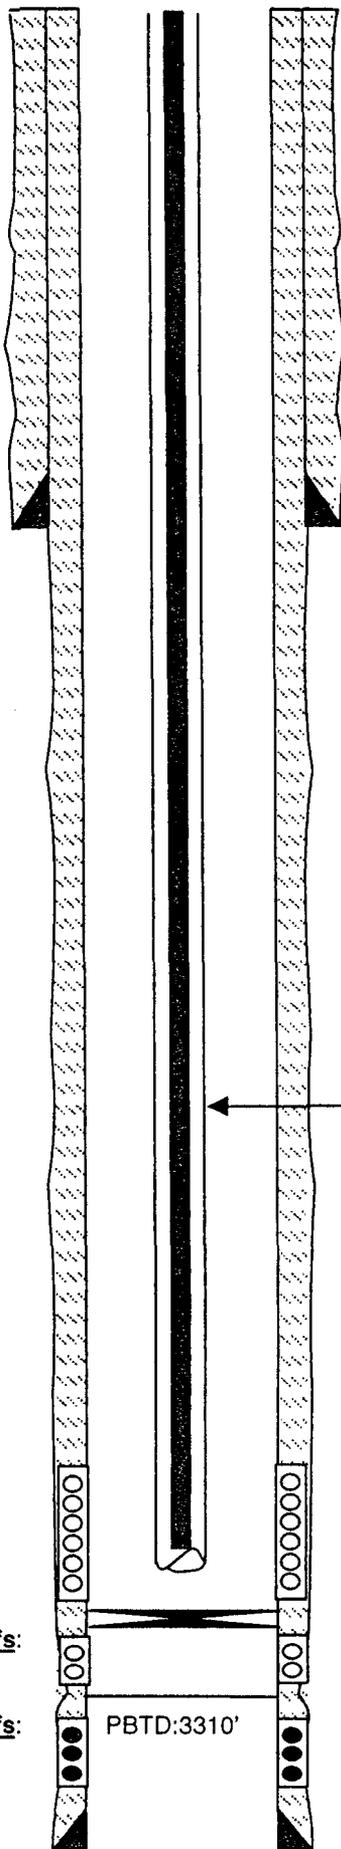

12-1/4" Hole  
 1,320' - 8-5/8", 23#, J-55 Casing,  
 cmt to surface w/680 sx "C"

2-3/8" Tubing (~3250')  
 Rods in hole:  
 129 3/4" Rods  
 1.5" Insert Pump

Yates Y1 Perfs:  
 3,076' - 3,158'

Seven Rivers Perfs:  
 3,302' - 3,306'

Seven Rivers Perfs:  
 3,322' - 3,326'  
 w/ 4 JSPF

RBP @3,200'

PBTD:3310'

7-7/8" Hole  
 3,384' - 5-1/2", 15.5# Casing, cmt w/685 sx Class "C"  
 Circ 70 sx to surface

**Initial Completion**

Spud well 4-2-94  
 Perf 7 Rivers @ 3302'-3306' 4 JSPF  
 Acidize w/1000 gals 28% HCl  
 Perf 7 Rivers @ 3322'-3326' 4 JSPF  
 Set cmt retainer @ 3215' & squeeze  
 w/ 50 sx cmt  
 IP: 51 BO, 54 BW, 1 MCF

**5/94**

Perf Yates Y1 3076'-3158' (68 holes)  
 Acidize w/ 2500 gals 7.5% NeFe acid  
 Frac w/ 35,000 gal Berate gel &  
 120,000# 12/20 sd  
 IP: 72 BO, 105 BW, 4 MCF

**9/94**

DOCR @ 3215'?, CO sd  
 Reperf 7 Rivers 3302' - 3306' (16 holes)  
 IP: 300 BO

**10/95**

Clean out hole to PBTD 3310'  
 Acidize w/ 750 gal gel acid

**5/00**

Set RBP over 7R zone at 3,200'

Cement Information is from State Reports

Updated: 6/29/00

COUNTY LEA, N.M. FIELD TEAS (BS)  
 OPR SIETE OIL & GAS CORP.  
 LSE TONTO WELL NO. I  
 LOC Sec 10, T-20-S, R-33-E (H)  
 1980 FNL & 660 FEL of Sec  
 REISSUE TO ADD INFO  
 30-025-29265  
 API NO. 5-15-85 OBJ 11,000' RT CO-ORD  
 F.R. Sierra #4 SPUD 6-2-85 ELEV KB  
 CTR 10,710 P & A 10-11-85 DF 3576' op ✓  
 TD PBD GL

H 10  
 KB  
 3595

PAY ZONE	PROD INTERVAL	IP	BO	W	HRS	CHK	TEST BASIS
PLUGGED AND ABANDONED							

GOR	GTY	CP	TP	BHP	POT DATE	TREATMENT
CSG	13	3/8-523-400		5 1/2	10,710-1535	
	8	5/8-5000-2900				

MIDLAND OIL SCOUTS ASSOCIATION WELL RECORD


DATE	WELL	SPL (LOG) MARKERS
	LEA, N.M. TEAS (BS) SIETE OIL & GAS CORP. #1 TONTO	
	TD 10,710'; P&A 10-11-85	B/Salt (3132)
	Gd show in Dela, shot SWC's	Yates (3360)
	DST #1 10,218-294, op 65", R/24 bbls	Dela Mtn (5354)
	mud, SC R/2500cc mud, 60"/4738,	BS 1m (7927)
	pkrl leaked, no press rptd	Wife (10,395)
	DST #2 10,320-706, op 75", R/220'	
	GCM, SC R/.8 CFG @ 180#, 60"/957,	FP 384-317,
	180"/1256, HP 5195-5185	
	Pf/BS/15/10,446-455, S/dwn, SSO, BP @ 10,300';	
	Pf/BS/6/10,240-247, 9/9812-24, A/500, P/15-10 BOPD,	
	(9812-10,247), BP @ 8110'; Pf/Dela/10/8081-90, A/500	
	P/1d, 5% oil, BP @ 3590'; Pf/L Yates/12/3545-79,	
	S/dry, NS O&G, BP @ 3470'; Pf/Yates/25/3380-3456,	
	A/500, P/27 BOPD, P/5 BO, 170 BW/24'	
	(3-26-86)	
	(4-2-86)	
	(4-16-86)	
	THE SUBSURFACE LIBRARY	
	P. O. BOX 2588	
	MIDLAND, TX 79703	

4ts  
 3358  
 +237



# Falcon Creek Resources, Inc.

**WTU #931**  
 (Federal "9" #2)  
 West Teas Field  
 "B" Section 9, T20S, R33E  
 Lea County, New Mexico  
 GL: 3,550'; KB: 3,559'

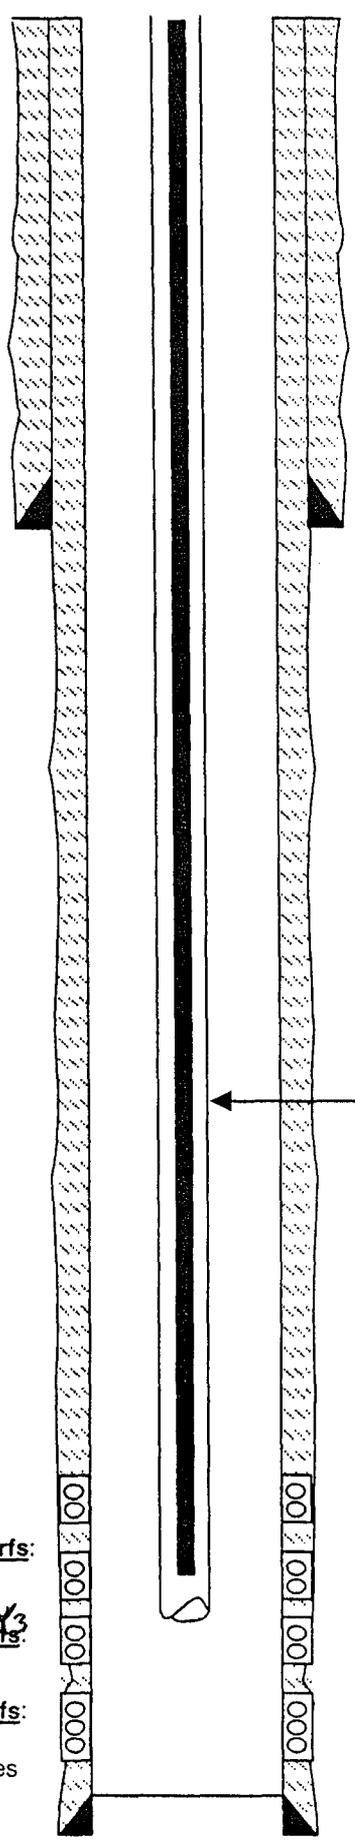

12-1/4" Hole  
 1,300' - 8-5/8", 23#, J-55 Casing,  
 cmt to surface w/ 640 sx "C"

2-3/8" Tubing (~3200')  
 Rods in hole:  
 126 3/4" Rods  
 1.25" Insert Pump

7-7/8" Hole  
 3,311' - 5-1/2", 17#, J-55 Casing, cmt w/475 sx Class "C"  
 Circulate 8 sx to surface

**Yates Y1 Perfs:**  
 3,062' - 3,073'

**Yates Y1 & Y2 Perfs:**  
 3,108' - 3,190'  
 26 holes

**Seven Rivers Perfs:**  
 3,234' - 3,250'

**Seven Rivers Perfs:**  
 3,297' - 3,308'  
 w/4 JSPF - 44 holes


### Initial Completion

Spud well 10-7-92  
 Perf Yates Lower Y1 & Y2 Zone  
 @ 3108'-3190' (26 Holes)  
 Acidize w/ 1250 gals 7.5% acid  
 IPP: 89 BOPD, 29 MCFD, 10 BWPD  
**5/94**  
 Perf Yates Y3 @ 3234'-3250' (32 Holes)  
 Acidize w/ 15% NeFe  
**6/94**  
 Perf Zone Upper Y1 from 3062'-3073'  
 (11 holes)  
 Frac Y2 w/20,000 gal Xlink gel  
 & 50,000# 20/40 sd  
 Frac U & L Y1 w/ 20,000 gal Xlink gel &  
 45,000# 20/40 sd  
 IP: 79 BOPD  
**10/95**  
 Perf Seven Rivers 3302'-3308'  
 Perf Seven Rivers 3297'-3303'  
 Acidize w/ 750 gals gelled acid  
**9/97**  
 Acidize w/ 1000 gals 15% Acid  
 Dump job down csg flush w/ 100 BW

Note: U Y1 not broken after perf  
 & prior to frac  
 Note: Y3 never fraced

Cmt information is estimated by  
 calculations.

**WTU #932**  
 (Federal "9" #1)  
 West Teas Field  
 "G" Section 9, T20S, R33E  
 Lea County, New Mexico  
 GL: 3,545'; KB: 3,556' (11')

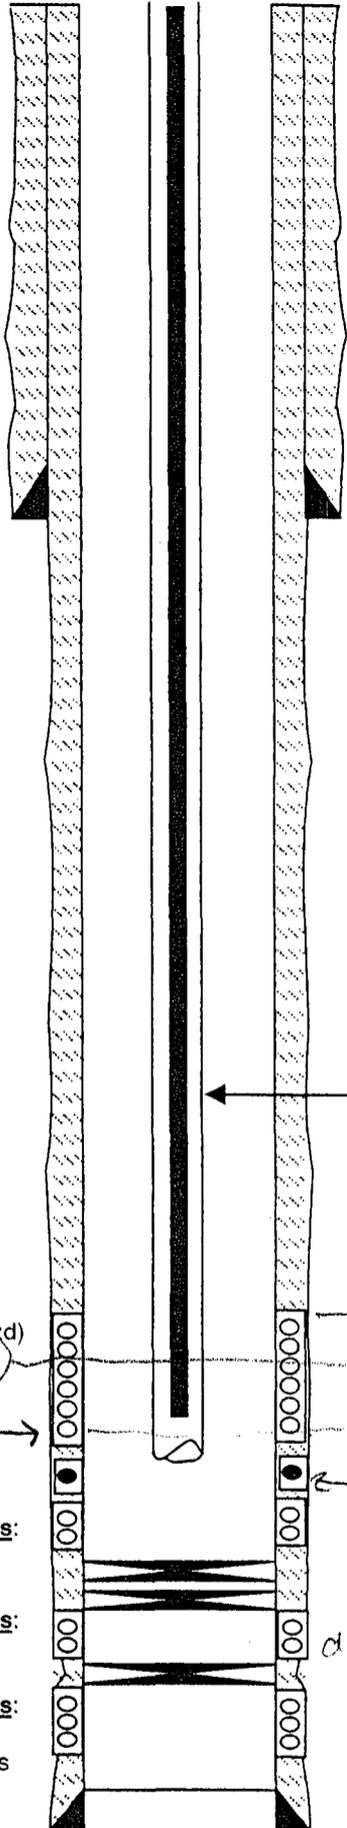

12-1/4" Hole  
 1,243' - 8-5/8", 24#, J-55 Casing,  
 cmt to surface w/ 450 sx "C"

2-3/8" Tubing (3123')  
 Rods in hole:  
 124 3/4" Rods  
 1.5" Insert Pump

**Yates Y1 Perfs:**  
 3,042' - 3,062' (Sqzd)  
**Yates Y1 Perfs:**  
 3,049' - 3,098'  
**Yates Y2 Perfs**  
 3,152' - 3,162'  
**Yates Y3 Perfs:**  
 41' - 3,257'  
**Seven Rivers Perfs:**  
 3,270' - 3,286'  
**Seven Rivers Perfs:**  
 3,330' - 3,343'  
**Seven Rivers Perfs:**  
 3,365' - 3,374'  
 w 2 JSPF - 40 holes

3,295' - CIBP  
 3,305' - CIBP (Milled and pushed down hole)  
 3,325' - CIBP

3,360' - CIBP

Est Hole Size: 7-7/8"  
 3,445' - 5-1/2", 17#, J-55 Casing, cmt w/775 sx Class "C"  
 Cmt to Surface, circ 317 cu ft.

**Initial Completion**

Spud well 11-10-90  
 Perf 7 Rivers @ 3365'-3367' & 3369-3374'  
 Acidize w/ 500 gals 15% NeFe  
 Set CIBP 3360'  
 Perf 7 Rivers @ 3330'-3343'  
 Acidize w/ 750 gals 15% NeFe  
 Set CIBP 3325' w/ 2 sx cmt  
 Perf Y3 from 3241-3257' (4 holes)  
 Acidize w/ 1000 gals 15% NeFe acid  
 Set CIBP 3235'  
 Perf Y1 3042'-3062' (18 holes)  
 Acidize w/ 2000 gals 15% NeFe acid  
 Well Dry.

**11/91**

Set Cmt retainer @ 2904'  
 Tried to squeeze w/ 100 sxs "C", displaced  
 Squeeze w/ 100 sx "C" to 2500#  
 Drill cmt to 3230'  
 Perf Y2 3152'-3157' (20 holes)  
 Acidize w/ 1500 gals NeFe  
 Perf Y2 3159'-3162'  
 Perf Y1 3094'-3098', 3049'-3054'  
 Acidize w/ 1500 gals Methanol  
 IPP: 99 BO, 36 BW, 98 MCF

**8/94**

Frac Y2 3152'-3162- w/ 11,800 gal Amfrac w  
 30,000# 12:20 mesh sand


**9/95**

Set CIBP @ 3295'  
 Perf 7 Rivers 3278'-3286' (25 holes)  
 Acidize w/ 750 gal 20% NeFe gelled acid  
 Perf from 7 Rivers 3270'-3276'  
 Acidize w/ 1500 gals 20% gel acid.  
 Swab set 50 BOPD, 30 BWPD

Cement Information is estimated by  
 calculations.

# Falcon Creek Resources, Inc.

**WTU #942**  
 (Federal "9" #6)  
 West Teas Field  
 "H" Section 9, T20S, R33E  
 Lea County, New Mexico  
 GL: 3,551'; KB: 3,562'

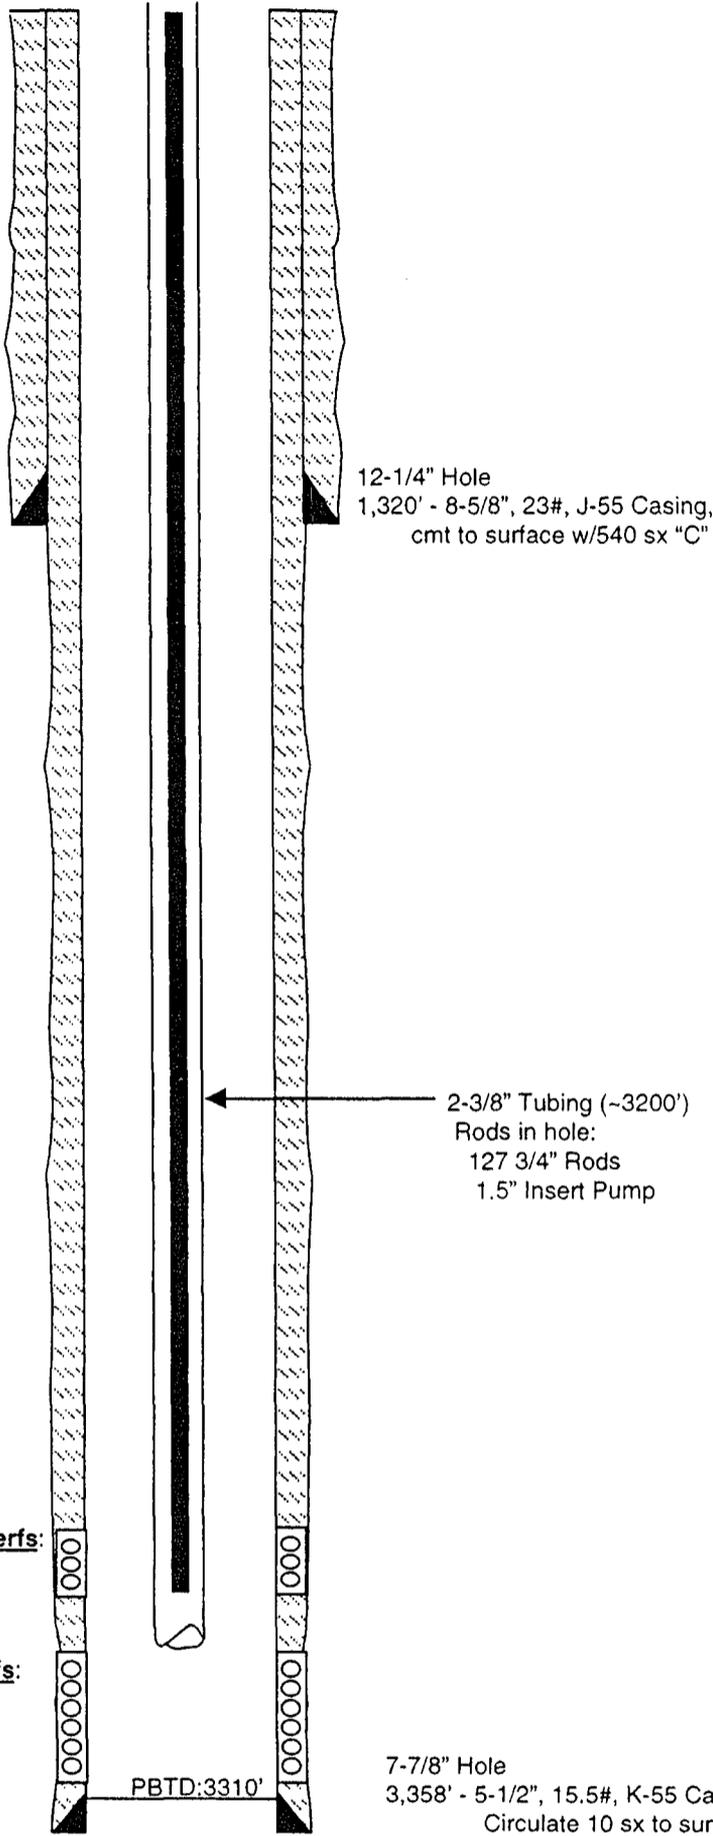

### Initial Completion

Spud well 5-16-94  
 Perf Seven Rivers @ 3285'-3288' 4 JSPF  
 Acidize w/1000 gals 15% NeFe  
 Perf Seven Rivers from 3288'-3300' 1 JSPF  
 Acidize w/1000 gals 15% NeFe and ?,  
 Set CIBP @ 3270'  
 Perf Yates Y1 & Y2 3060'-3176' 2 JSPF  
 Acidize w/2500 gals 15% NeFe  
 Frac w/ 42,000 gal xlink gel &  
 133,000# of 12/20 sd.  
 IPP: 97 BO, 14 BW, 1 MCF  
**4/95**  
 CO ~125' sd and drill CIBP, push to PBTD  
 (added 7R 3285-88' to prod.)  
**10/96**  
 Tag fill @ 3287, CO to 3310'

Cement Information is from State Reports

Note: History of 7R frac sd. prod.  
May need another clean out

**Yates Y1 & Y2 Perfs:**  
 3,060' - 3,176'  
 2 JSPF

**Seven Rivers Perfs:**  
 3,285' - 3,288'  
 4 JSPF  
 3,288' - 3,300'  
 1 JSPF

PBTD: 3310'

7-7/8" Hole  
 3,358' - 5-1/2", 15.5#, K-55 Casing, cmt w/785 sx Class "C"  
 Circulate 10 sx to surface


# CURRENT WELLBORE SCHEMATIC

## CHESAPEAKE OPERATING INC



**WELL** : WTU #933 (FORMER GROVER FEDERAL #3)  
**FIELD** : WEST TEAS  
**COUNTY** : LEA **STATE** : NM  
**LOCATION** : "J" SECTION 9-T20S-R33E  
**ELEVATION** : GL 3,541' KB 3,549'  
**API NO.** : 30-025-

HOLE SIZE

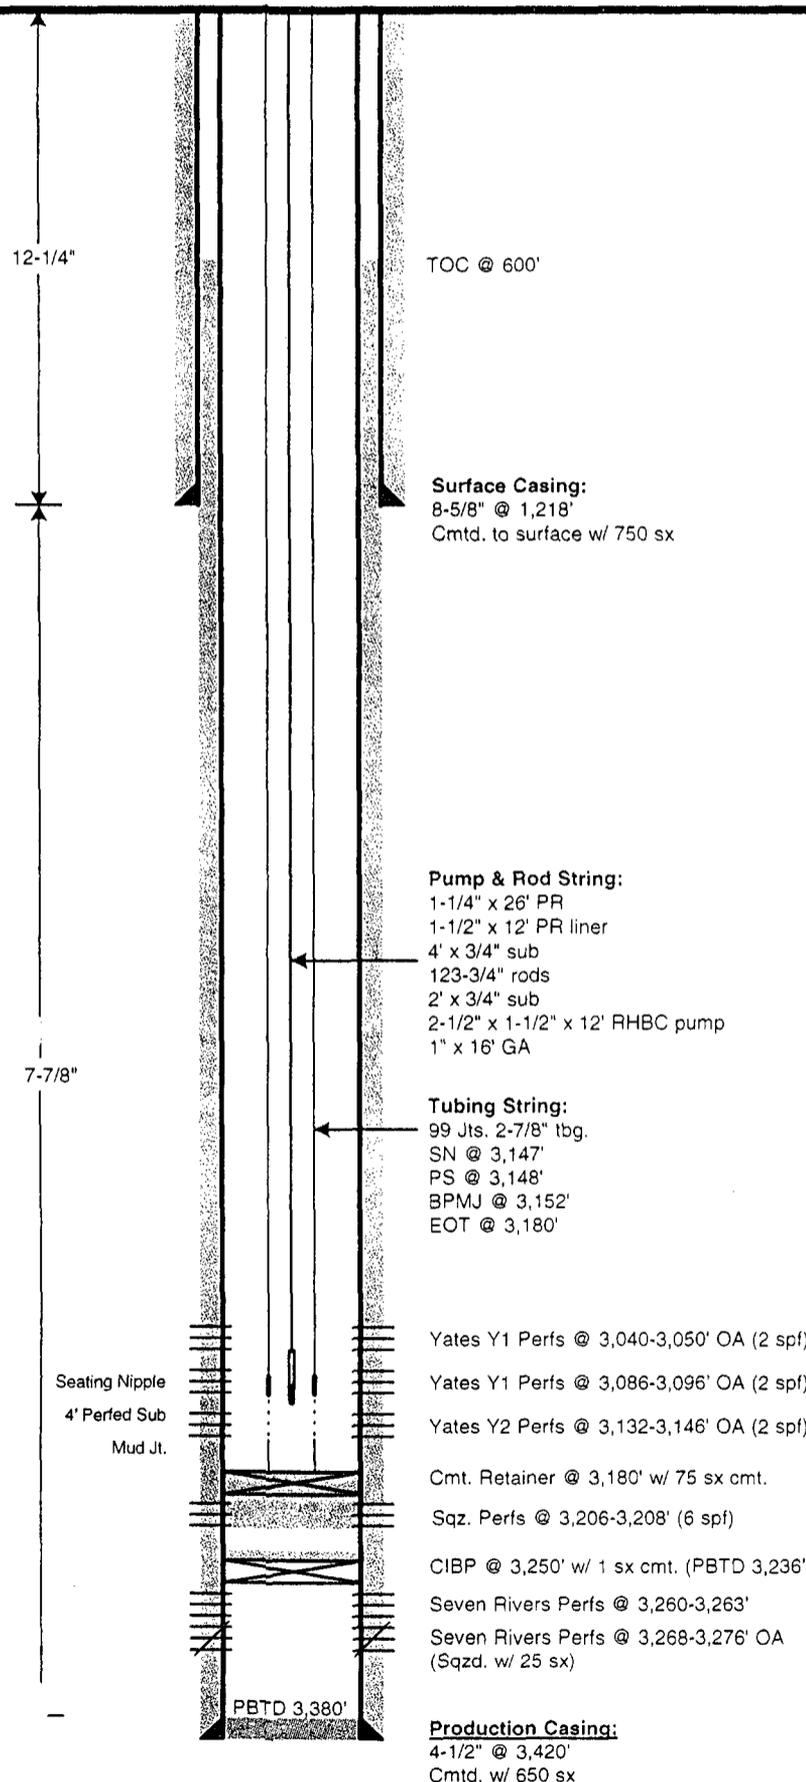

### Well History

**2-26-88:** Spud well  
 Initial Completion:  
 Perf Yates Y1 from 3022', 3024', 3034', 3036', 3040', 3043', 3045', 3050', 3086', 3088', 3092', 3094', & 3100' w/ 2 JSPF  
 Acidize w/ 500 gals of 15% NeFe  
 Frac w/ 375 BW, 75 tons CO<sub>2</sub>, & 42,000# of 20/40 sd and 30,800# 12/20  
 IPP: 85 BOPD; 5 BWPD  
**9/97:** Perf 7 Rivers from 3,268'-3276'. Acidize w/ 750 gal of 15% Ferchek  
**11/97:** Set CIBP @ 3240', Sqz 7 Rivers w/ 25 sx "C", Sqz Yates from 3022'-3100' w/ 250 sx "C". Perf 7 Rivers from 3260'-3263' w/ 3 JSPF.  
 Acidize w/ 650 gal 15% NeFe  
 IPP: 115 BW, 1 BO,  
**10/98:** Set CIBP @ 3250' w/ 20 sx on top. Perf Y2 from 3132'-3142' w/ 2 JSPF. Acidize w/ 500 gal of 15% NeFe.  
 IPP: 2 BO, 2 BW, 0 MCF  
**2/25/02:** SFL 1683' from surf.  
**11/2/02:** Frac Yates "2". POOH w/ tubulars. Ran bit & scraper. Ran pkr. to 3124'. Started acidizing. Communicated to squeezed Yates "1" perfs. Set pkr. @ 2975'. Tested backside to 1000 psi--OK. Frac w/ 22,766 gal, 60,000# 12/20 sd. ISIP 2190#. Clean out sand to PBTD 3250'. PWOP.  
 Testing 0 BO, 115 BW  
**12/11/02:** Spot 1 sx cmt. on CIBP @ 3250'. PWOP. All water.  
**3/6/03:** Pull pump, rods, & tbg. RU BOP, GIH w/ 4-1/2" scraper to 3236' PBTD.  
**3/7/03:** Shoot sqz. perfs from 3206-08'. Set Cmt. Retainer @ 3180'. Pump 75 sx 50/50 Pozmix w/ 2% CaCl<sub>2</sub>. Would not pressure up.  
**3/8/03:** Sting into retainer. Pump 16 bbls. cmt. into sqz. perfs.  
**3/10/03:** GIH w/ bit; tag cmt. @ 3,112'. Drill out cmt. to 3,180'. RU to swab, tag fluid @ 200' FS. Swab down to 2700' FS, total 31 bbls.  
**3/11/03:** RIH w/ swab; FL @ 1200' FS, trace oil. Swab down to SN, swabbed dry after 11 runs. Making 1 hr. runs, 200' fluid entry. RD swab, POOH w/ tbg. SWI.  
**3/12/03:** TIH w/ perf guns. Re-perf Yates 2 @ 3132-46' w/ 2 spf. Re-perf Yates 1 @ 3086-90' & 3040-50' w/ 2 spf. TIH w/ tbg., NU WH. Pumped 10 bbls. fsw dwn tbg, drop SV. Press. tbg up to 300 psi, pumped 500 gal. 15% NeFe down csg. @ 350 psi, 2 bpm. Acid bubbling from around surface pipe. Dug down to surface valves, 2" nipple w/ hole. Replaced nipple and valve, repaired pinhole in 4-1/2" csg. @ welded bell nipple. Could not pump down surface pipe. Pumped 50 bbl fsw dwn 4-1/2" @ 1 bbl/hr. & 500 psi. Did not circ to surface pipe. SISD.  
**3/13/03:** Fish SV. NUWH & BOP, TOOH w/ tbg. string. RIH w/ pkr, repair pinhole in 4-1/2" csg. at ground level. Pressure test csg. at various intervals; held pressure. TOH w/ pkr, TIH w/ BPMJ, PS, SN & 99 jts. tbg. ND BOP, NU WH. Swab; IFL 50' FS, FFL 1100' FS. 37 bbls. water recovered, no gas.  
**3/14/03:** Open well, no pressure. Swab; IFL 800' FS. Made 15 runs, FL stayed @ 2400'. Rec. 54 bbls. water, no gas. RIH w/ BH pump & rods. Hung well on, RDPU.

**PREPARED BY:** Ginni A. Kennedy  
**UPDATED BY:** Ginni A. Kennedy


**DATE:** 2/18/03  
**DATE:** 3/18/03

# CURRENT WELLBORE SCHEMATIC

## CHESAPEAKE OPERATING INC



**WELL** : WTU #943 (FORMER FEDERAL "9" #7)  
**FIELD** : WEST TEAS  
**COUNTY** : LEA **STATE** : NM  
**LOCATION** : "I" SECTION 9-T20S-R33E  
**ELEVATION** : GL 3,548' KB 3,559'  
**API NO.** : 30-025-

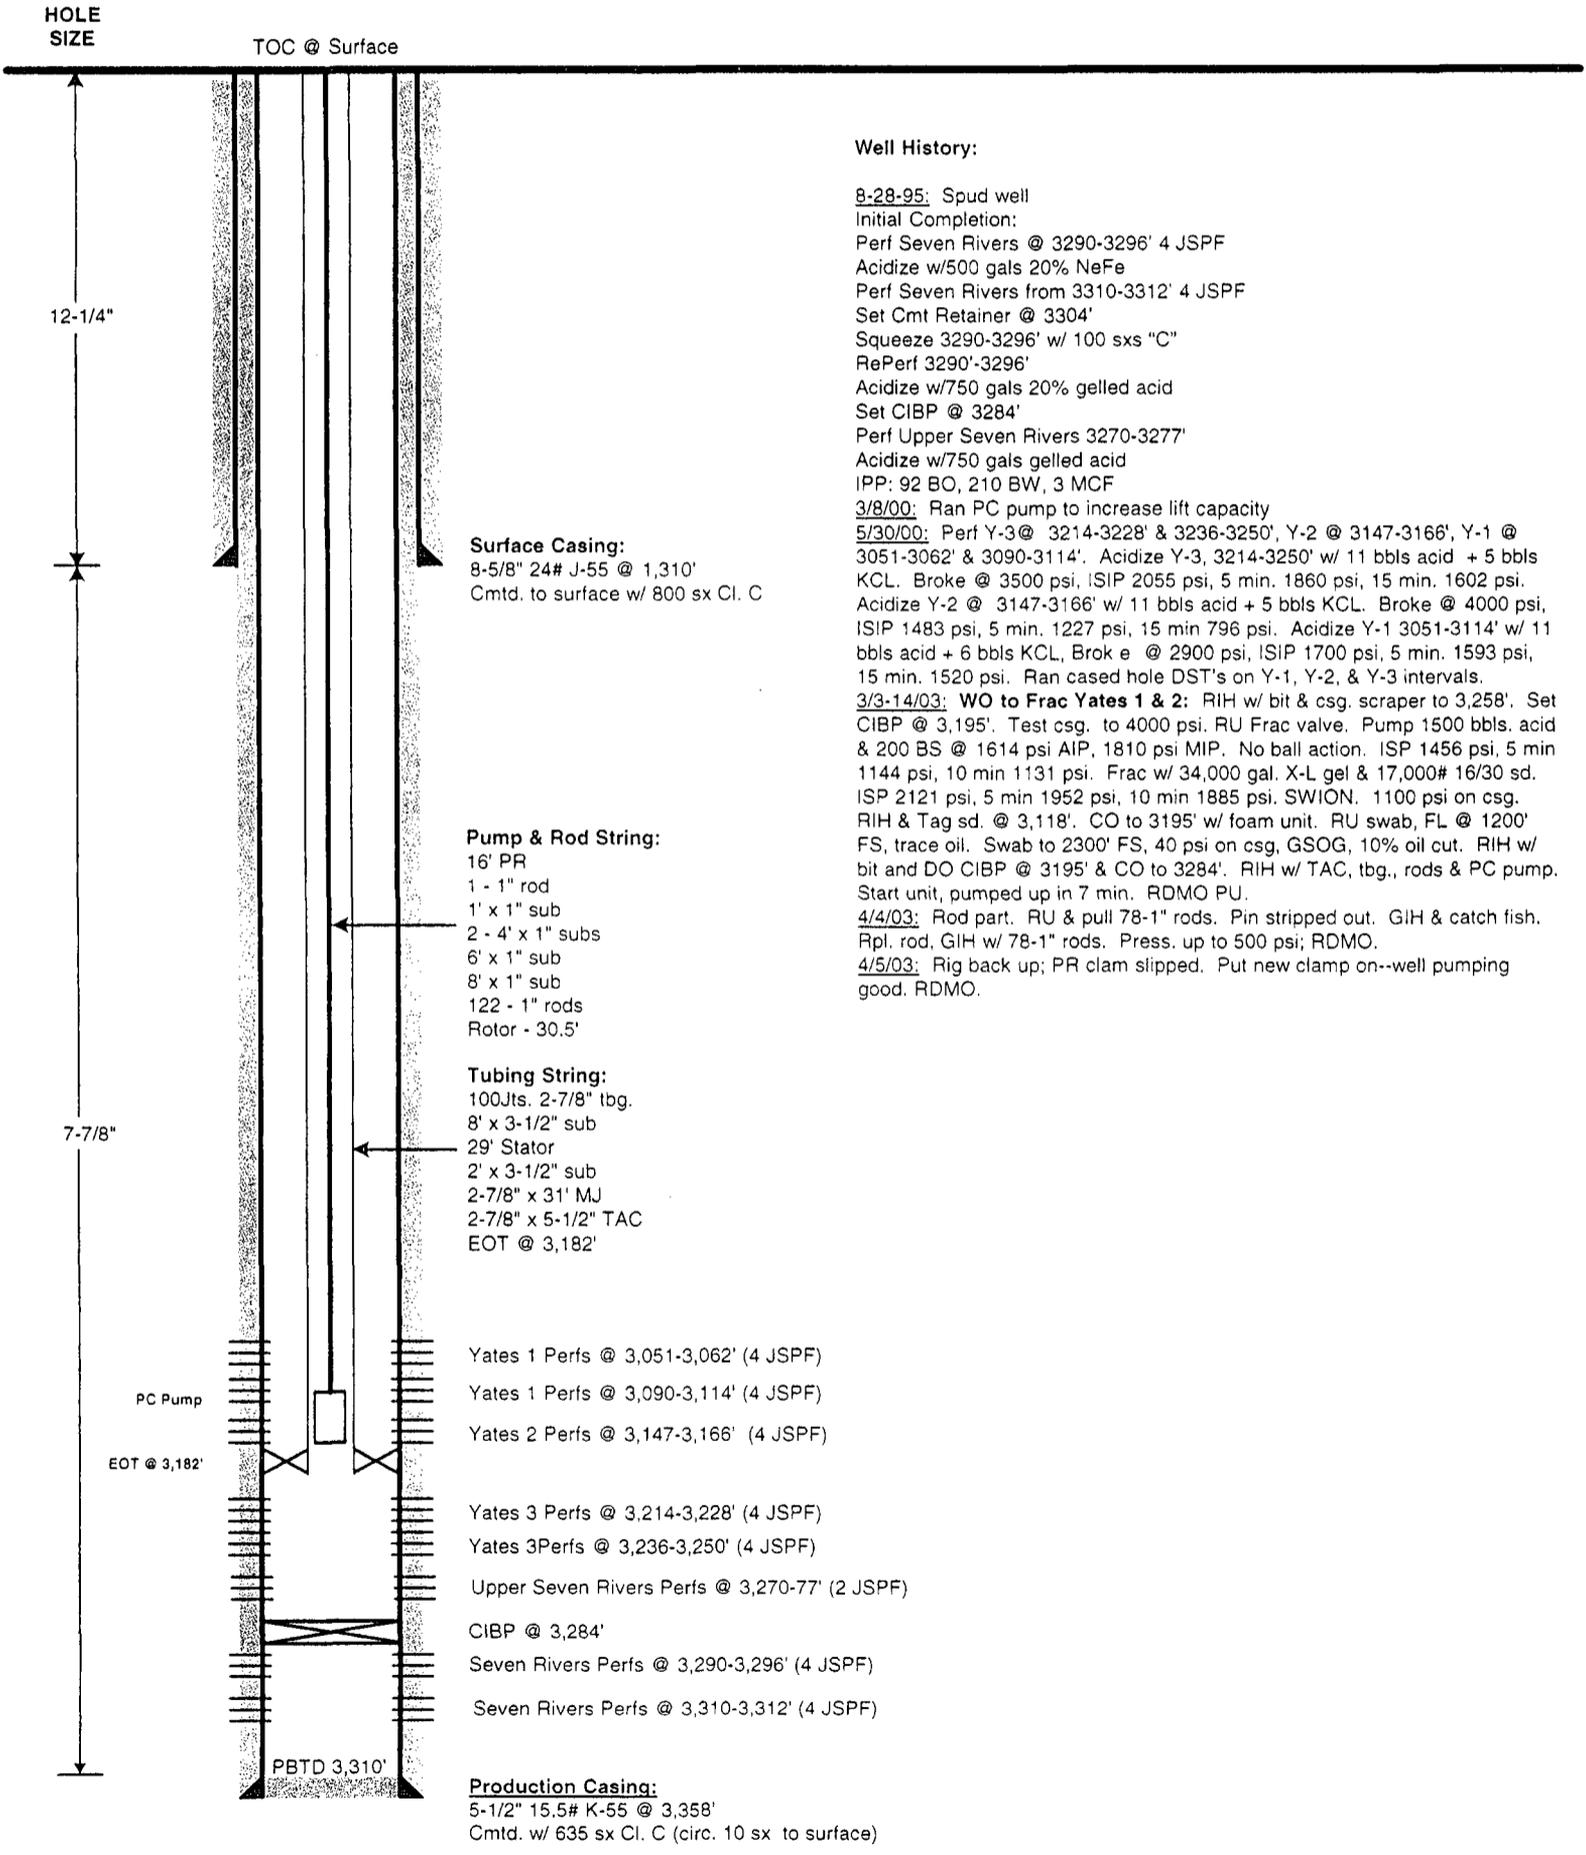


**PREPARED BY:** Ginni A. Kennedy  
**UPDATED BY:** Ginni A. Kennedy

**DATE:** 3/19/03  
**DATE:** 4/25/03

# Falcon Creek Resources, Inc.

RT. 4

**WTU #944**  
 (Federal "9" #8)  
 West Teas Field  
 "P" Section 9, T20S, R33E  
 Lea County, New Mexico  
 GL: 3,546'; KB: 3,567'

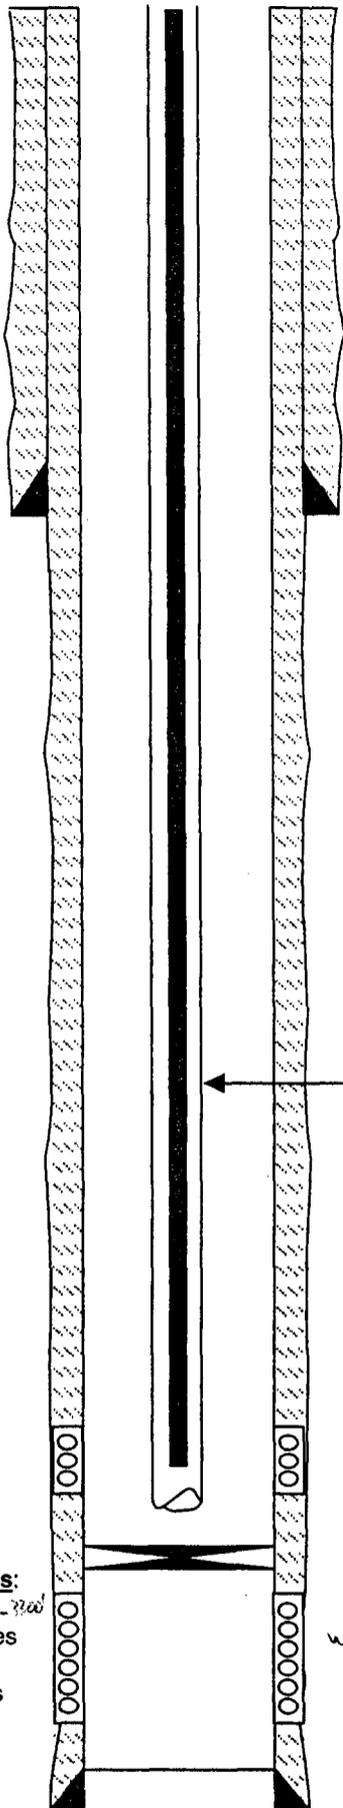

12-1/4" Hole  
 1,313' - 8-5/8", 24#, J-55 Casing,  
 cmt to surface w/800 sx "C"

2-7/8" Tubing (3240')  
 Rods in hole:  
 12 1" Rods  
 8 7/8" Rods  
 109 3/4" Rods  
 2.5" Insert Pump

**Yates Y1 Perfs:**  
 3,116' - 3,144'  
 holes

**Seven Rivers Perfs:**  
 3,308' - 3,314', 3290-3300'  
 w/ 2 JSPF - 12 holes  
 3,316' - 3,318'  
 w/ 2 JSPF - 8 holes

3,275' - CIBP

wet

7-7/8" Hole  
 3,462' - 5-1/2", 17#, J-55 Casing, cmt w/610 sx Class "C"  
 Circulate 55 sx to surface

**Initial Completion**


Spud well 7-12-96  
 Perf Seven Rivers @ 3316'-3318' (8 holes)  
 Acidize w/ 500 gals gelled 15% HCl  
 Perf 3290-3300'  
 Swab 100 BWPDP  
 Acidize w/ 2000 gals gelled 15% HCl  
 Frac w/ 24,000# 20/40 sd  
 Perf Yates L. Y1 from 3116'-3144' - 57 holes  
 Acidize w/ 2000 gals 15% NeFe  
 Frac w/ 30,600# 12/20 sd and 388 bbls Borate gel  
 Perf Add'l 7 Rivers 3308'-3314' - 12 Holes  
 Acidize w/ 1000 gal 15% NeFe  
 Set CIBP @ 3275' - PB over 7 Rivers  
 IPP: 60 BOPD, 17 MCFD, 2 BWPDP (Y1)

Cement Information is from State Reports

# WELLBORE SCHEMATIC

**WELL :** ANASAZI 9 FEDERAL #1 (MITCHELL ENERGY CORP.)  
**FIELD :** WILDCAT  
**LOCATION :** 1,980' FNL & 1,980' FEL, UNIT G, SEC. 9-T20S-R33E  
**COUNTY :** LEA **STATE :** NM  
**SERIAL NO. :** NM 57280  
**ELEVATION :** GL - 3,546'

**SPUD DATE:** 5/13/92  
**TD DATE:** 6/29/92  
**COMPL. DATE:** 7/16/92

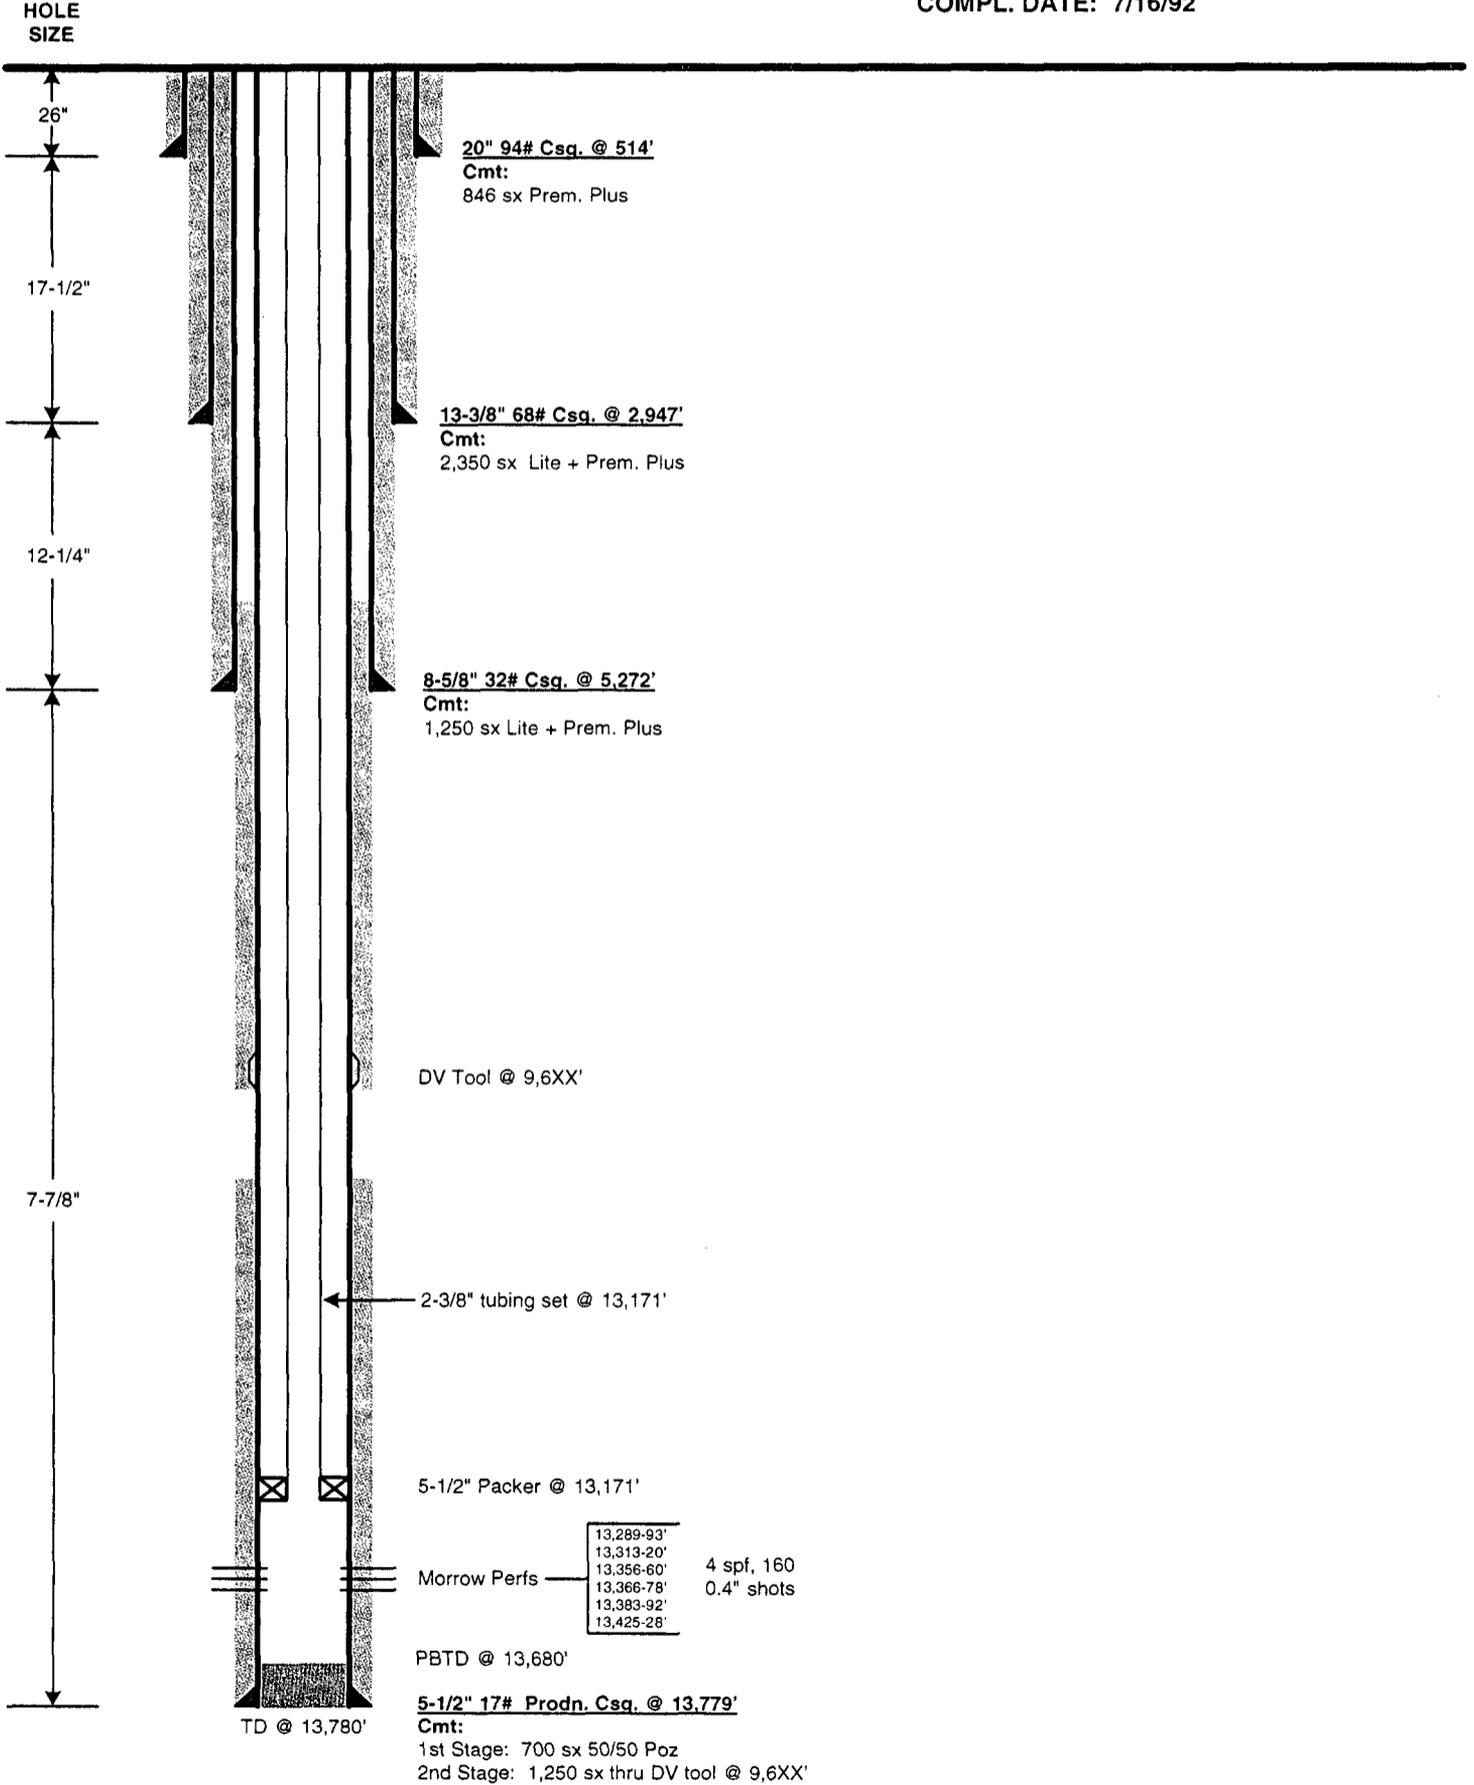

PREPARED BY: Ginni A. Kennedy

DATE: 6/5/03

UPDATED BY: \_\_\_\_\_

DATE: \_\_\_\_\_

## WTU 945 - C108 - Item VII

1. The average daily rate will approximate 500 BWPD, a maximum rate of 750 BWPD, total volume will approach 1 million bbls.
2. Per the unitization hearings and the original order, this system is closed.
3. Average pressure will approach 600 psi. Maximum authorized pressure is currently .2 psi per foot or approximately 600 psi.
4. Water is reinjected from unitized zones
5. NA.

## WTU 945 - C108 - Item IX

The Yates is typically stimulated as follows:

1. Tie onto casing. Establish rate and bull head 1000 gallons of 15% NeFe acid into the Yates '3'. Launch 14 balls throughout job. Note rates and pressures. Surge balls off perfs. Fracture the Yates '3' with 20,000 gal of gelled borate containing 40,000# of 20/40 sand per the attached treatment schedule. Maintain rates approaching 30 BPM, max pressure 4000 psi.
2. Set a CIBP @ 3,200'. Run casing gun and perforate the Yates '2' 3,142 – 3,170' (28') w/ 1 SPF, 23 gram charge, 60 degree phasing.
3. Tie onto casing. Establish rate and bull head 1000 gallons of 15% NeFe acid into the Yates '2'. Launch 28 balls throughout job. Note rates and pressures. Surge balls off perfs. Fracture the Yates '2' with 40,000 gal of gelled borate containing 75,000# of 20/40 sand per the attached treatment schedule. Maintain rates approaching 30 BPM, max pressure 4000 psi.
4. Set a CIBP @ 3,130'. Run casing gun and perforate the Yates '1L' 3,082 – 3,115' (33') and Yates '1U' 3,038 – 3,159' (21') w/ 1 SPF, 23 gram charge, 60 degree phasing.
5. Tie onto casing. Establish rate and bull head 1000 gallons of 15% NeFe acid into Yates '1'. Launch 54 balls throughout job. Note rates and pressures. Surge balls off perfs. Fracture the Yates '1' with 40,000 gal of gelled borate containing 75,000# of 20/40 sand per the attached treatment schedule. Maintain rates approaching 30 BPM, max pressure 4000 psi.



Geology Department

May 6, 2003

To: Andrew McCalmont  
Assett Manager  
Chesapeake Energy Corporation.

Having reviewed all pertinent geologic data within 2 miles of the West Teas Yates - Seven Rivers Unit, it is my opinion that there is no evidence of open faults or any hydrologic connection between the Yates-Seven Rivers Reservoirs and any known underground sources of drinking water.

Sincerely,

A handwritten signature in cursive script that reads "Doug Bellis".

Doug Bellis  
Geologist  
Chesapeake Energy Corporation

AFFIDAVIT OF PUBLICATION

State of New Mexico,  
County of Lea.

I, KATHI BEARDEN

Publisher

of the Hobbs News-Sun, a newspaper published at Hobbs, New Mexico, do solemnly swear that the clipping attached hereto was published once a week in the regular and entire issue of said paper, and not a supplement thereof for a period.

of 6 weeks.

Beginning with the issue dated

May 16 2003

and ending with the issue dated

May 22 2003

*Kathi Bearden*

Publisher

Sworn and subscribed to before

me this 22nd day of

May 2003

*Jodi Benson*

Notary Public.

My Commission expires  
October 18, 2004  
(Seal)

This newspaper is duly qualified to publish legal notices or advertisements within the meaning of Section 3, Chapter 167, Laws of 1937, and payment of fees for said publication has been made.

LEGAL NOTICE  
May 16, 17, 18, 20, 21, 22, 2003

PROPOSED INJECTION WELLS

Chesapeake Operating, Inc. proposes the conversion of the following described wells to water injection service for the existing waterflood Order No. R-11375; West Teas (Yates Seven Rivers) Unit 913, 1980' FSL & 660' FWL, Section 9-20S-33E, West Teas (Yates Seven Rivers) Unit 941, 330' FNL & 990' FEL, Section 9-20S-33E, West Teas (Yates Seven Rivers) Unit 443, 1650' FSL & 660' FEL, Section 4-20S-33E, West Teas (Yates Seven Rivers) Unit 924, 2560' FNL & 2210' FWL, Section 9-20S-33E, West Teas (Yates Seven Rivers) 9452612' FNL & 330' FEL. All wells are located in Lea County, New Mexico. The zones to be injected into are the Yates Sand from 3000' to 3300' with a maximum injection rate of 600 BWPD/well at a maximum pressure of 600 psi. Any interested parties with objection or request for hearing should notify the Oil Conservation Division at P.O. Box 2088, Santa Fe, New Mexico 87501 within 15 days of this notice. Any questions should be directed to Andrew McCalmont, Agent for Chesapeake Operating, Inc., at P.O. Box 18496, Oklahoma City, OK 73118, telephone number 405-848-8000, ext. 7852.  
#19820

01104307000      02563986  
Chesapeake Operating, Inc.  
P.O. Box 18496  
Oklahoma City, OK 73154-0496

N.M. Oil Cor.  
P.O. Box 1980  
Hobbs, NM 88241

FORM APPROVED  
Budget Bureau No. 1004-0135  
Expires: March 31, 1993

UNITED STATES  
DEPARTMENT OF THE INTERIOR  
BUREAU OF LAND MANAGEMENT  
SUNDRY NOTICES AND REPORTS ON WELLS

Do not use this form for proposals to drill or to deepen or reentry to a different reservoir.  
Use "APPLICATION FOR PERMIT-" for such proposals

SUBMIT IN TRIPLICATE

1. Type of Well  
 Oil Well    Gas Well    Other

2. Name of Operator  
 SNACKELFORD Oil Company

3. Address and Telephone No.  
 P.O. Box 10665 Midland, TX 79702 (915) 682-9784

4. Location of Well (Footage, Sec., T., R., M., or Survey Description)  
 SET 1980 FNL AND 660 FEL SECTION 10 T28S R33E

5. Lease Designation and Serial No.  
 NMMN 17439

6. If Indian, Allottee or Tribe Name

7. If Unit or CA, Agreement Designation

8. Well Name and No.  
 Tank Federal #

9. API Well No.  
 30-025-28265

10. Field and Pool, or Exploratory Area  
 UNDESIGNATED OIL

11. County or Parish, State  
 LEA

12. CHECK APPROPRIATE BOX(S) TO INDICATE NATURE OF NOTICE, REPORT, OR OTHER DATA

TYPE OF SUBMISSION	TYPE OF ACTION
<input type="checkbox"/> Notice of Intent	<input type="checkbox"/> Abandonment
<input checked="" type="checkbox"/> Subsequent Report	<input type="checkbox"/> Recompletion
<input type="checkbox"/> Final Abandonment Notice	<input checked="" type="checkbox"/> Plugging Back
	<input type="checkbox"/> Casing Repair
	<input type="checkbox"/> Altering Casing
	<input type="checkbox"/> Other _____
	<input type="checkbox"/> Change of Plans
	<input type="checkbox"/> New Construction
	<input type="checkbox"/> Non-Routine Fracturing
	<input type="checkbox"/> Water Shut-Off
	<input type="checkbox"/> Conversion to Injection
	<input type="checkbox"/> Dispose Water

(Note: Report results of multiple completion on Well Completion or Recompletion Report and Log form.)

13. Describe Proposed or Completed Operations (Clearly state all pertinent details, and give pertinent dates, including estimated date of starting any proposed work. If well is directionally drilled give subsurface locations and measured and true vertical depths for all markers and zones pertinent to their work.)

1) Set CROP AT 6720'

2) Perforated from 6524-6534

3) Acidize w/ 1000 gallons of 15% NEEF Acid AND FRACED w/ 30,000 # of 20-40 SAND

4) Put well back on to production.

ACCEPTED FOR RECORD  
(ORIG. SGD.) DAVID R. GLASS  
SEP 29 1998  
BLM

14. I hereby certify that the foregoing is true and correct

Signed [Signature] Title President Date 2/20/88

(This space for Federal or State office use)

Approved by \_\_\_\_\_ Title \_\_\_\_\_ Date \_\_\_\_\_

Conditions of approval, if any: \_\_\_\_\_