

June 5, 2003

RECEIVED

To Whom It May Concern:

JUN 30 2003

Re: WTYSRU Well #913 – West Teas Field
1980' FSL – 660' FWL
Sec 9-T20S-R33E
Lea County, New Mexico

Oil Conservation Division

Chesapeake Energy, Inc. is making application to convert the #913, an oil well, to injection in an effort to further our recovery at the previously approved West Teas Yates Seven River Unit (Order # R-11375). Water will be injected into the Yates Sand interval per the attached schematic. There are no known oil or gas bearing zones relatively close to the unitized formations which could be affected by this proposed conversion. A copy of the application is enclosed which we anticipate will be administratively approved.

As one who may be affected by this application, we are notifying you of your right to participate in this process, including the right to provide evidence to the NMOGCD either in support or in opposition to the application. Interested parties must file objections or requests for hearing with the Oil Conservation Division, 1220 South St. Francis Dr., Santa Fe, New Mexico 87505, within 15 days of receipt of this notice. If you desire more information, you may contact Andrew McCalmont at (405) 879-7852.

Very truly yours,



Andrew McCalmont
Asset Manager – Permian Basin
Chesapeake Energy, Inc.

APPLICATION FOR AUTHORIZATION TO INJECT

I. PURPOSE: Secondary Recovery Pressure Maintenance Disposal Storage
Application qualifies for administrative approval? Yes No

II. OPERATOR: Chesapeake Energy Inc.

ADDRESS: PO Box 18496 Oklahoma City, Ok 73154 - 0496

CONTACT PARTY: Andrew McCalmont PHONE: 405-879-7852

III. WELL DATA: Complete the data required on the reverse side of this form for each well proposed for injection.
Additional sheets may be attached if necessary.

IV. Is this an expansion of an existing project? Yes No
If yes, give the Division order number authorizing the project: R-11375

V. Attach a map that identifies all wells and leases within two miles of any proposed injection well with a one-half mile radius circle drawn around each proposed injection well. This circle identifies the well's area of review.

VI. Attach a tabulation of data on all wells of public record within the area of review which penetrate the proposed injection zone. Such data shall include a description of each well's type, construction, date drilled, location, depth, record of completion, and a schematic of any plugged well illustrating all plugging detail.

VII. Attach data on the proposed operation, including:

1. Proposed average and maximum daily rate and volume of fluids to be injected;
2. Whether the system is open or closed;
3. Proposed average and maximum injection pressure;
4. Sources and an appropriate analysis of injection fluid and compatibility with the receiving formation if other than reinjected produced water; and
5. If injection is for disposal purposes into a zone not productive of oil or gas at or within one mile of the proposed well, attach a chemical analysis of the disposal zone formation water (may be measured or inferred from existing literature, studies, nearby wells, etc.).

*VIII. Attach appropriate geologic data on the injection zone including appropriate lithologic detail, geologic name, thickness, and depth. Give the geologic name, and depth to bottom of all underground sources of drinking water (aquifers containing waters with total dissolved solids concentrations of 10,000 mg/l or less) overlying the proposed injection zone as well as any such sources known to be immediately underlying the injection interval.

IX. Describe the proposed stimulation program, if any.

*X. Attach appropriate logging and test data on the well. (If well logs have been filed with the Division, they need not be resubmitted).

*XI. Attach a chemical analysis of fresh water from two or more fresh water wells (if available and producing) within one mile of any injection or disposal well showing location of wells and dates samples were taken.

XII. Applicants for disposal wells must make an affirmative statement that they have examined available geologic and engineering data and find no evidence of open faults or any other hydrologic connection between the disposal zone and any underground sources of drinking water.

XIII. Applicants must complete the "Proof of Notice" section on the reverse side of this form.

XIV. Certification: I hereby certify that the information submitted with this application is true and correct to the best of my knowledge and belief.

NAME: Andrew McCalmont TITLE: Asset Manager

SIGNATURE: Andrew J. McCalmont DATE: 6/5/03


* If the information required under Sections VI, VIII, X, and XI above has been previously submitted, it need not be resubmitted. Please show the date and circumstances of the earlier submittal: Case No. 12272, Order No. R-11375, 5/18/2000.

Chesapeake Operating, Inc.

WTU #913
Injection Well
 (Grover Federal #2)
 West Teas Field
 "L" Section 9, T20S, R33E
 Lea County, New Mexico
 GL: 3,543'; KB: 3,553'

1980' FSL - 660' FWL

30-025-29972
990 FFL
660 FWL
L

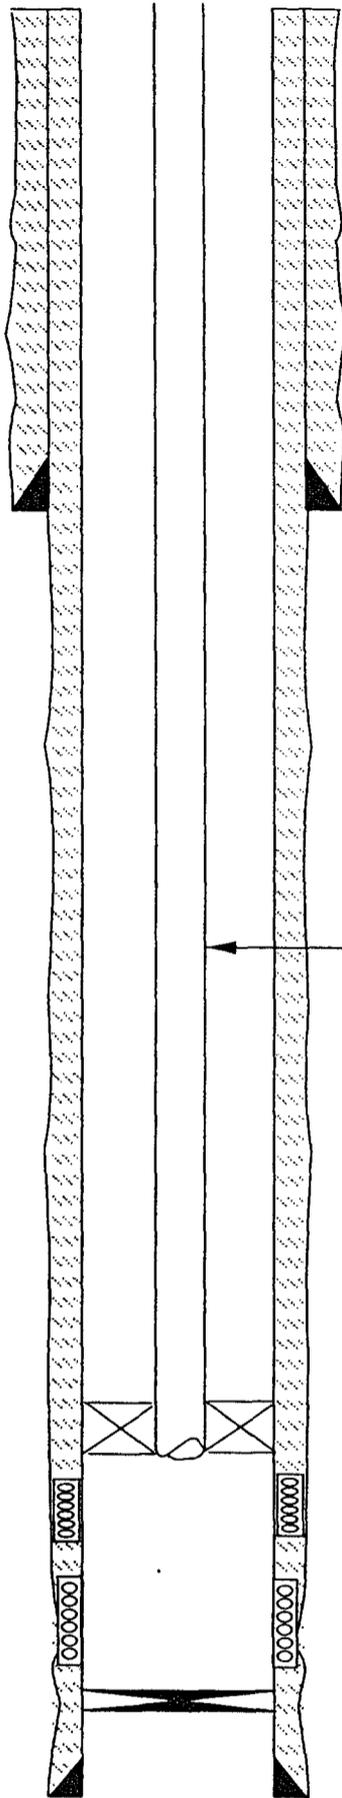

1,256' - 8-5/8" Casing,
 cmt to surface w/500 sx
 circ 230 sx

98 Jts. 2-3/8" Poly core lined tbg.

Uni 1 Pkr @ 3075'

3286' PBT
 (DO CIBP, pushed to 3,286')

7-7/8" Hole
 3,400' - 4-1/2" 10.5#, J-55 Casing, cmt w/1100 sx Class "C"
 Cmt to surface, circ 39 sx to surface

Yates Perfs:
 3,114' - 3,124'
 3,158' - 3,172'
 3,217' - 3,239'
 w/2 JSPF-12 holes

Initial Completion

Spud well 11-12-87
 DST #1 3075'-3250'. 32 min PF, Strong,
 60 min ISI. 63 min 2nd F, 240 min FSI.
 Rec 450 total FL, 300' O&G cut mud &
 150' DF. Sampler Recovered:
 100 cc GCO 240 cc water, 1240 cc total
 FSIP: 1061 PSI
 Perf Yates Y2 from 3217', 3220',
 3227', 3231', 3237', and 3239' w/ 2 JSPF
 Acidize w/500 gals 15% NeFe
 IPP: 20 BO

1/88

Frac w/ 380 bbls H2O, 60 tons CO2
 35,000# 20/40 & 28,500 12/20 sd
 IPP: 80 BO, 35 BW

3/7 - 3/8/02


Repair tubing. POOH w. tbg, pump &
 rods, load well w/ 12 BPW, test for 1500#,
 good pump action.

4/22 - 4/30/03

Convert to WIW
 Reperf Yates 3217' - 3237', acidize, set
 CIBP @ 3200', reperf Yates 3114' - 3124'
 3158' - 3172', acidize & frac Yates perfs
 3114' - 3172', RIH w/ 3-7/8" bit, CO w/
 foam unit to CIBP @ 3,200'. DO CIBP,
 push down to 3,286'--unable to go further.
 Circ clean. RIH w/ tbg & 4-1/2" Uni 1 Pkr.
 to 3,075'. Load csg. w/ pkr. fluid, test to
 350 psi for 30 mins for state MIT. RDMO.

All Cement Information was from
 State Sundry Notices

Only Chesapeake Operating operates any well producing from the Yates -Seven Rivers Formation within 1/2 mile radius of any proposed injectors

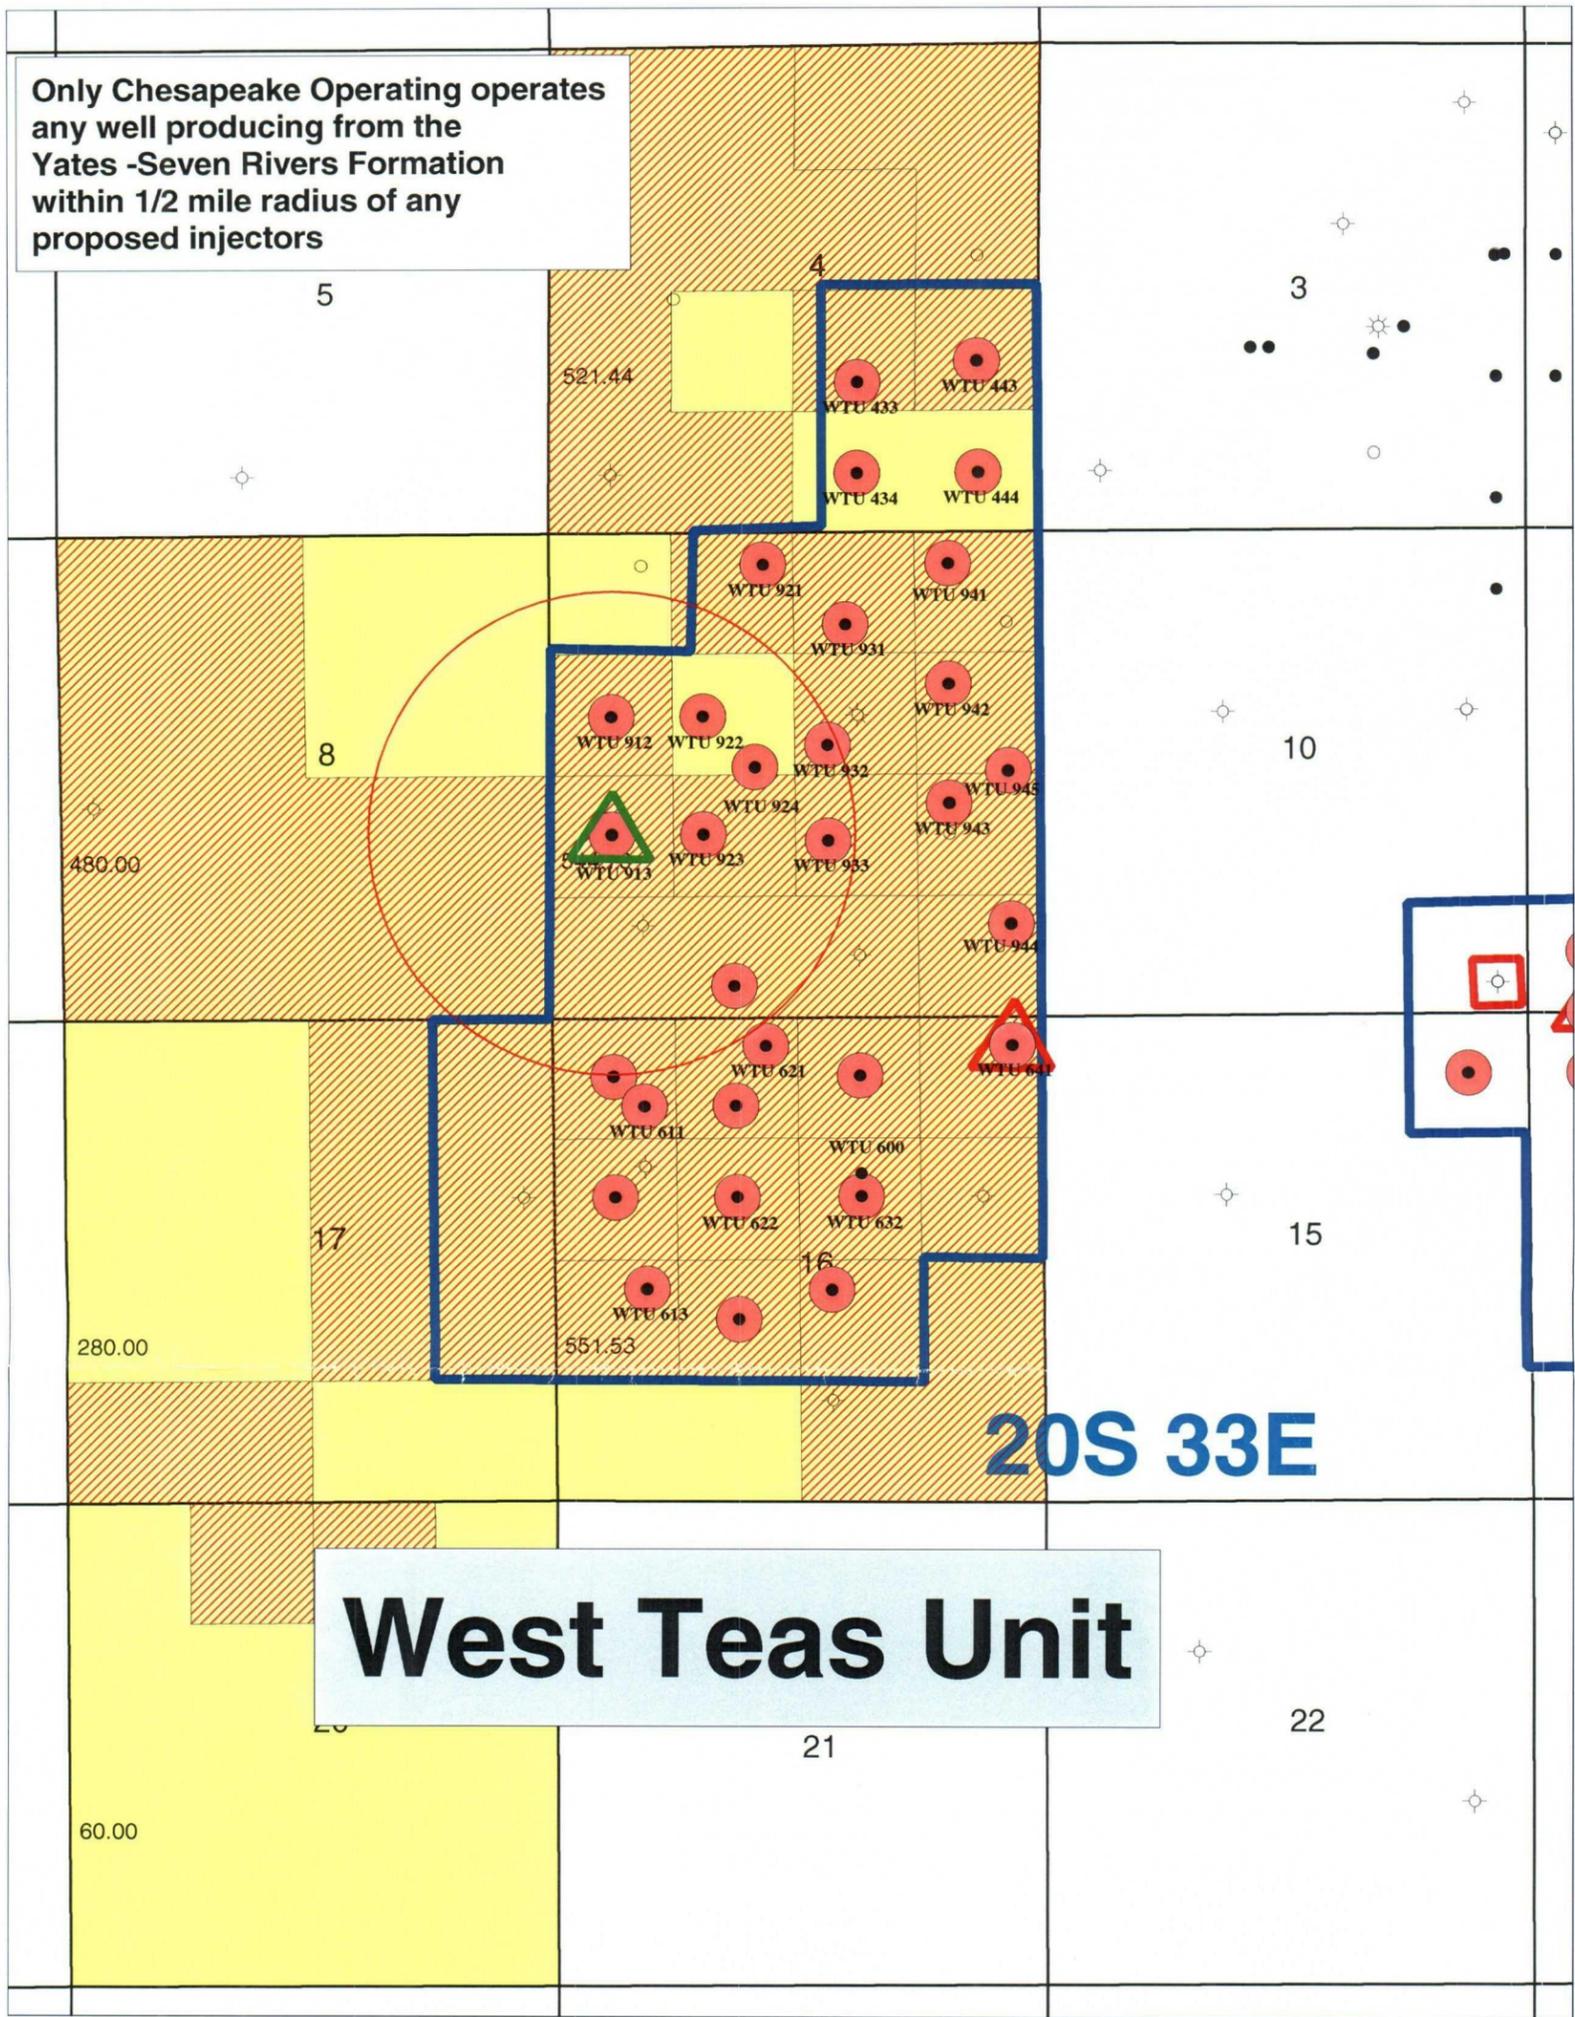


20S 33E

West Teas Unit

-  YATES/SEVEN RIVERS PRODUCERS
-  WATER FLOOD UNITS
-  YATES INJECTORS
-  PLANNED YATES INJECTORS
-  COI ACREAGE
-  COI TRACT OWNERSHIP

	CHESAPEAKE OPERATING, INC.
	WEST TEAS YATES SEVEN RIVERS WATERFLOOD UNIT 913 1/2 MILE RADIUS OF PROPOSED INJECTOR Lea County, New Mexico
Date: 2 June, 2003 Scale: 1" = 2000'	Geol/Eng: DB / BL / AM

Item V

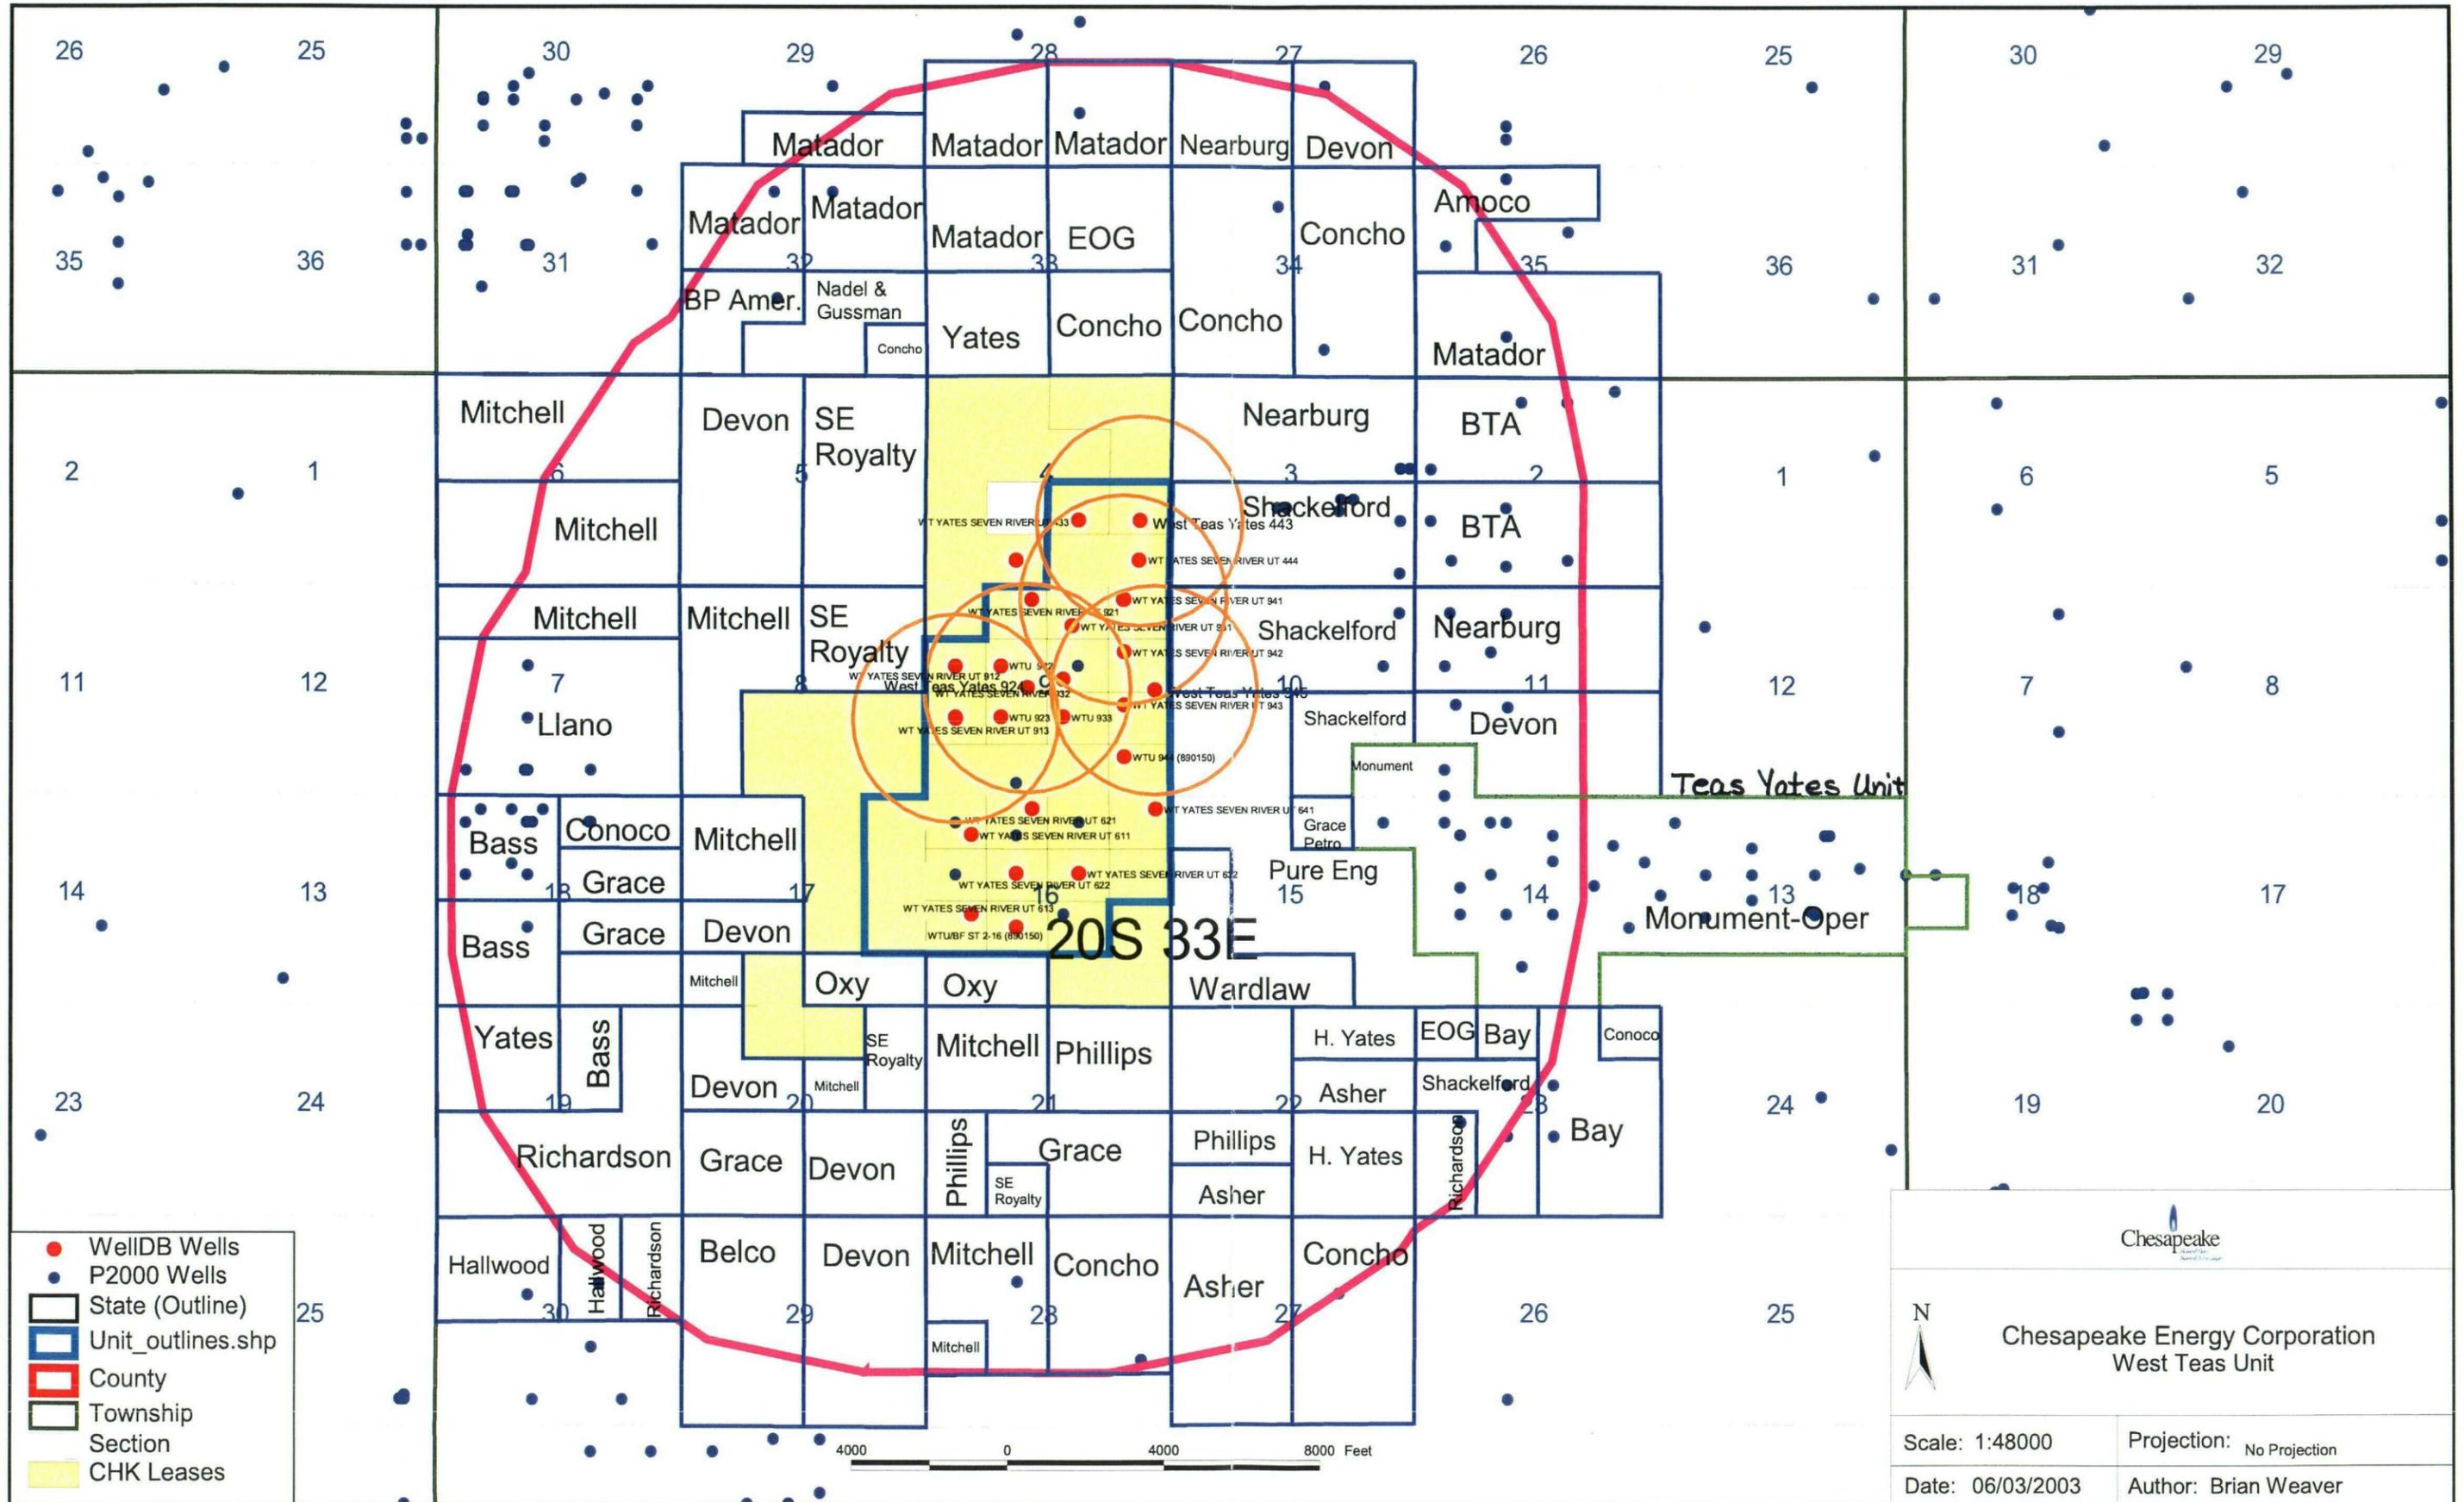

- WellIDB Wells
- P2000 Wells
- ▭ State (Outline)
- ▭ Unit_outlines.shp
- ▭ County
- ▭ Township Section
- ▭ CHK Leases

Chesapeake

Chesapeake Energy Corporation
West Teas Unit

Scale: 1:48000 Projection: No Projection


Date: 06/03/2003 Author: Brian Weaver

WTU 913 - C108 - Item VI
Wellbore Schematic/Data Tabulation

	Well Name	Prior Name	Location	Status
1	WTU 912	Barber Federal #2	9E-20S-33E	WIW
2	WTU 922	Barber Federal #1	9F-20S-33E	Producing
3	WTU 932	Federal 9 #1	9G-20S-33E	Producing
4	WTU 924	NA	9F-20S-33E	Producing
5	WTU 933	Grover Fed #3	9J-20S-33E	Producing
6	WTU 923	Grover Fed #1	9K-20S-33E	Producing
7	Federa #4	NA	9M-20S-33E	P&A
8	Lea 6015 Federal #2	NA	9N-20S-33E	P&A
9	Lea 6019 #2	NA	16D-20S-33E	P&A

Chesapeake Operating, Inc.

WTU #912
Injection Well
 (Barber Federal #2)
 West Teas Field
 "E" Section 9, T20S, R33E
 Lea County, New Mexico
 GL: 3,555'; KB; 3,565'

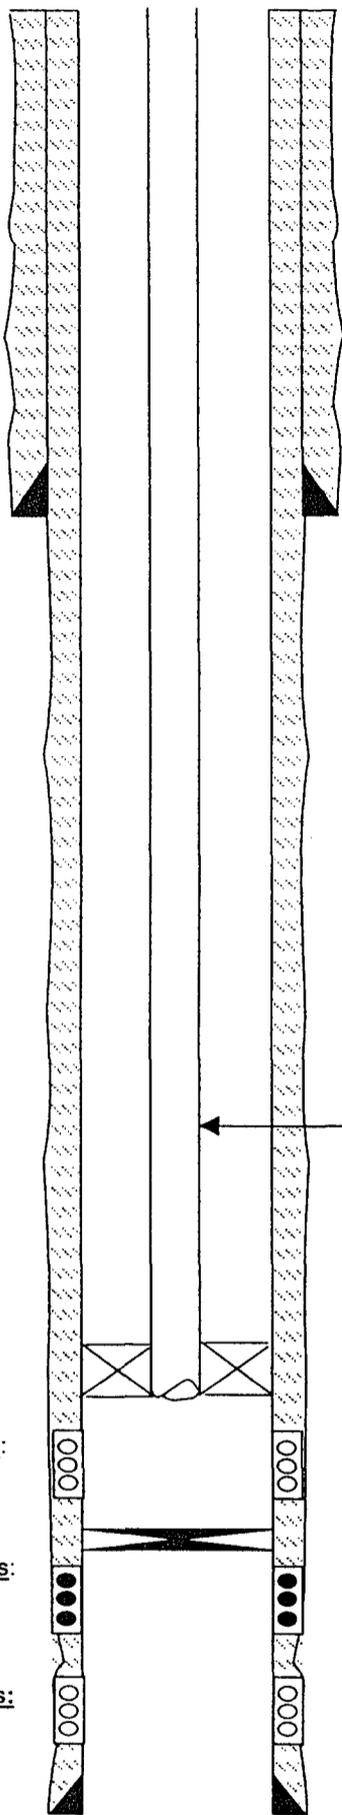

1,256' - 8-5/8" Casing,
 cmt to surface w/ 750 sx

96 jts. 2-3/8" tbg.

4-1/2" Pkr. @ 3,118'

CICR @ 3,250' - PBTD

7-7/8" Hole
 3,400' - 4-1/2" Casing, cmt w/1100 sx Class
 Cement to Surface & circ 67 sx

Yates Y1 Perfs:
 3,138' - 3,219'

Sqzd Yates 2 Perfs:
 3,260' - 3,268'
 3,278' - 1 shot

Proposed Y3 Perfs:
 3,296' - 3,304'
 3,310' - 3,320'
 3,336' - 3,352'

Initial Completion

Spud well 8-24-87
 Perf 3278' 1 Shot
 Perf 3260'-3268'
 Acidize w/ 750 gals 15% NeFe
 Set cement retainer @ 3250'
 Sqz w/ 50 sx
 Perf Y1 3138'-3222'
 Acidize w/ 1000 gal 15% NeFe

Includes carbonate between Y1 & Y2
 3135'-3222' Y1 w/ carbonate below


5/6/06 - 5/8/03:

Convert to WIW
 POOH w/ pump, rods & tbg. Test tbg. OOH
 burst 4 jts. RIH w/ 3-7/8" bit. RU foam unit; tag fill
 @ 3,203'. CO to PBTD 3250', circ. 3 hrs. RD
 foam unit & POOH. RIH w/ 4-1/2" pkr., hydro
 test tbg. To 1000 psi. Set pkr. @ 3,118'; SIW.
 RU pump truck, pump 24 bbls 15% Ne-Fe
 acid, flush w/ 50 BPW @ 2 BPM, max 1800 psi.
 ISP 1300 psi, leave well SI, WO Injection.

All cement information was from
 State Sundry Notices

Falcon Creek Resources, Inc.

WTU #922
 (Barber Federal #1)
 West Teas Field
 "F" Section 9, T20S, R33E
 Lea County, New Mexico
 GL: 3,545'; KB: 3,556'

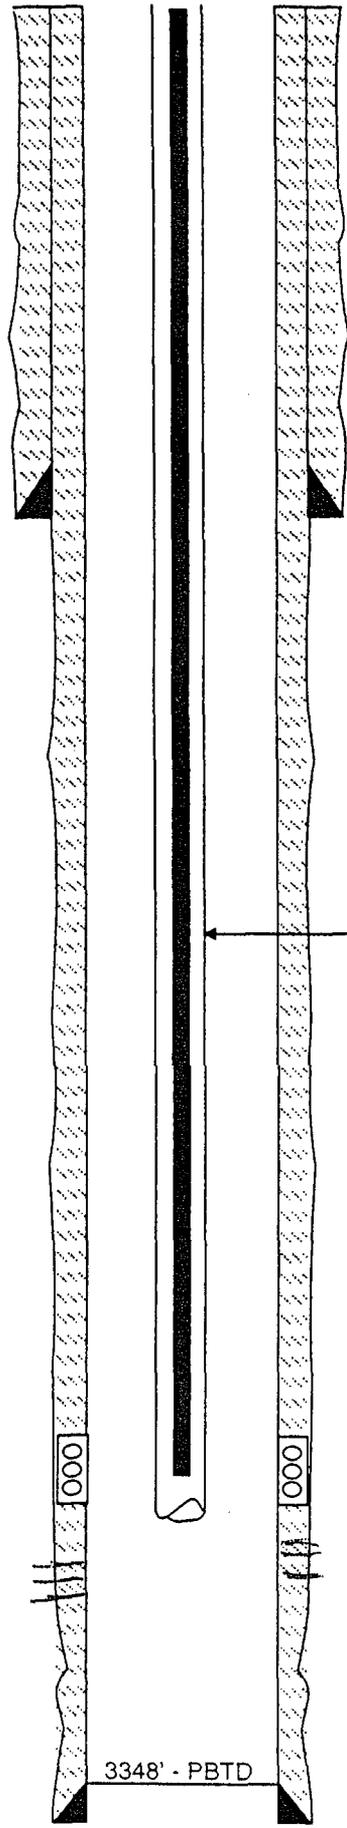

12-1/4" Hole
 1,261' - 8-5/8" Casing,
 cmt to surface w/650 sx

2-3/8" Tubing
 124 5/8" Rods
 2" x 1-1/2" x 12' Pump

Initial Completion

Spud well 4-29-87
 Perf Yates Y1 from 3092', 3095', 3099,
 3102', 3104', 3106', 3141', 3142,
 3146' & 3147' w/ 2 JSPF
 Acidize w/ 1000 gals 15% NeFe
 IPP: 30 BOPD
7/87
 Frac w/ 405 BW, 72 tons of CO2
 and 70,000# 20/40 sd
 IPP: 115 BO, 40 BW, 0 MCF

All cement information is from
 State Sundry Notices

10/4/02: Perf 3251, 53, 71, 75
 3201, 02, 05, 17, 19 25PF
 Ac w/ 2000 gal


Yates Perfs:
 3,092' - 3,147'

Y1 3092 - 3108'
 3136 - 3147'
 3251, 53, 71, 75 ; 3201, 02, 05, 17, 19 25PF

3348' - PBD

Hole Size: 7-7/8"
 3,400' - 4-1/2" Casing, cmt w/900 sx Class
 cmt to surface, and circ 73 sx

WTU #932
 (Federal "9" #1)
 West Teas Field
 "G" Section 9, T20S, R33E
 Lea County, New Mexico
 GL: 3,545'; KB: 3,556' (11')

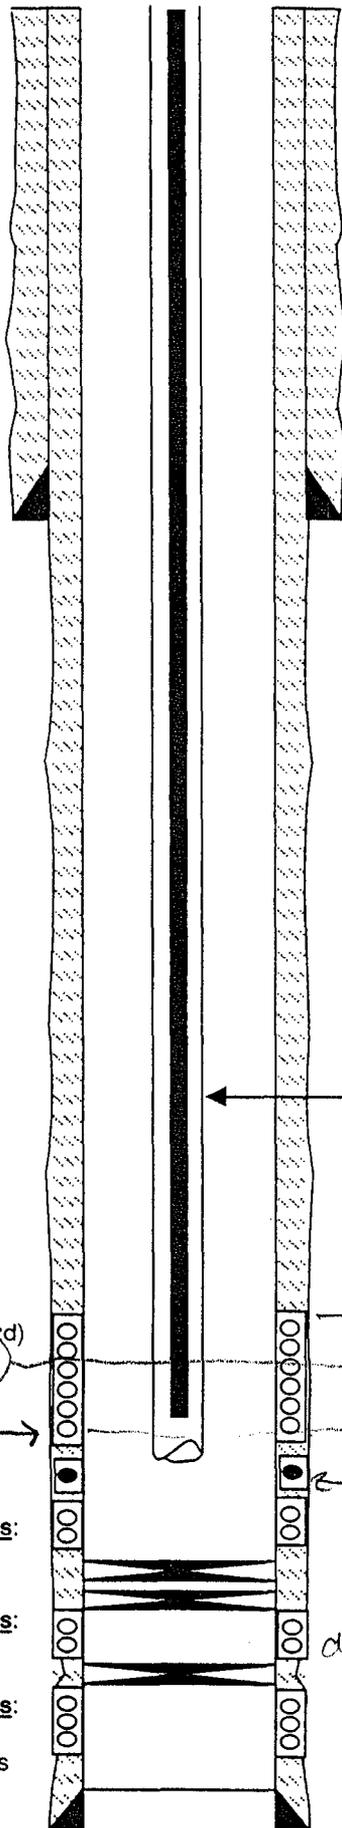

12-1/4" Hole
 1,243' - 8-5/8", 24#, J-55 Casing,
 cmt to surface w/ 450 sx "C"

2-3/8" Tubing (3123')
 Rods in hole:
 124 3/4" Rods
 1.5" Insert Pump

Yates Y1 Perfs:
 3,042' - 3,062' (Sqzd)
Yates Y1 Perfs:
 3,049' - 3,098'
Yates Y2 Perfs
 3,152' - 3,162'
Yates Y3 Perfs:
 41' - 3,257'
Seven Rivers Perfs:
 3,270' - 3,286'
Seven Rivers Perfs:
 3,330' - 3,343'
Seven Rivers Perfs:
 3,365' - 3,374'
 w 2 JSPF - 40 holes

dry
 Good IP
 Frac
 dry
 dry
 3,295' - CIBP
 3,305' - CIBP (Milled and pushed down hole)
 3,325' - CIBP
 3,360' - CIBP
 Est Hole Size: 7-7/8"
 3,445' - 5-1/2", 17#, J-55 Casing, cmt w/775 sx Class "C"
 Cmt to Surface, circ 317 cu ft.

Initial Completion

Spud well 11-10-90
 Perf 7 Rivers @ 3365'-3367' & 3369-3374'
 Acidize w/ 500 gals 15% NeFe
 Set CIBP 3360'
 Perf 7 Rivers @ 3330'-3343'
 Acidize w/ 750 gals 15% NeFe
 Set CIBP 3325' w/ 2 sx cmt
 Perf Y3 from 3241-3257' (4 holes)
 Acidize w/ 1000 gals 15% NeFe acid
 Set CIBP 3235'
 Perf Y1 3042'-3062' (18 holes)
 Acidize w/ 2000 gals 15% NeFe acid
 Well Dry.

11/91

Set Cmt retainer @ 2904'
 Tried to squeeze w/ 100 sxs "C", displaced
 Squeeze w/ 100 sx "C" to 2500#
 Drill cmt to 3230'
 Perf Y2 3152'-3157' (20 holes)
 Acidize w/ 1500 gals NeFe
 Perf Y2 3159'-3162'
 Perf Y1 3094'-3098', 3049'-3054'
 Acidize w/ 1500 gals Methanol
 IPP: 99 BO, 36 BW, 98 MCF

8/94

Frac Y2 3152'-3162- w/ 11,800 gal Amfrac w
 30,000# 12:20 mesh sand

9/95

Set CIBP @ 3295'
 Perf 7 Rivers 3278'-3286' (25 holes)
 Acidize w/ 750 gal 20% NeFe gelled acid
 Perf from 7 Rivers 3270'-3276'
 Acidize w/ 1500 gals 20% gel acid.
 Swab set 50 BOPD, 30 BWPD


Cement Information is estimated by
 calculations.

PROPOSED WELLBORE SCHEMATIC

CHESAPEAKE OPERATING INC



WELL : WTU #924
FIELD : WEST TEAS
COUNTY : LEA **STATE** : NM
LOCATION : 2,560' FNL & 2,210' FWL; SECTION 9-T20S-R33E
ELEVATION : GL 3,540' RKB 3,555'
API NO. : 30-025-36073
SERIAL NO. : NMNM 104724

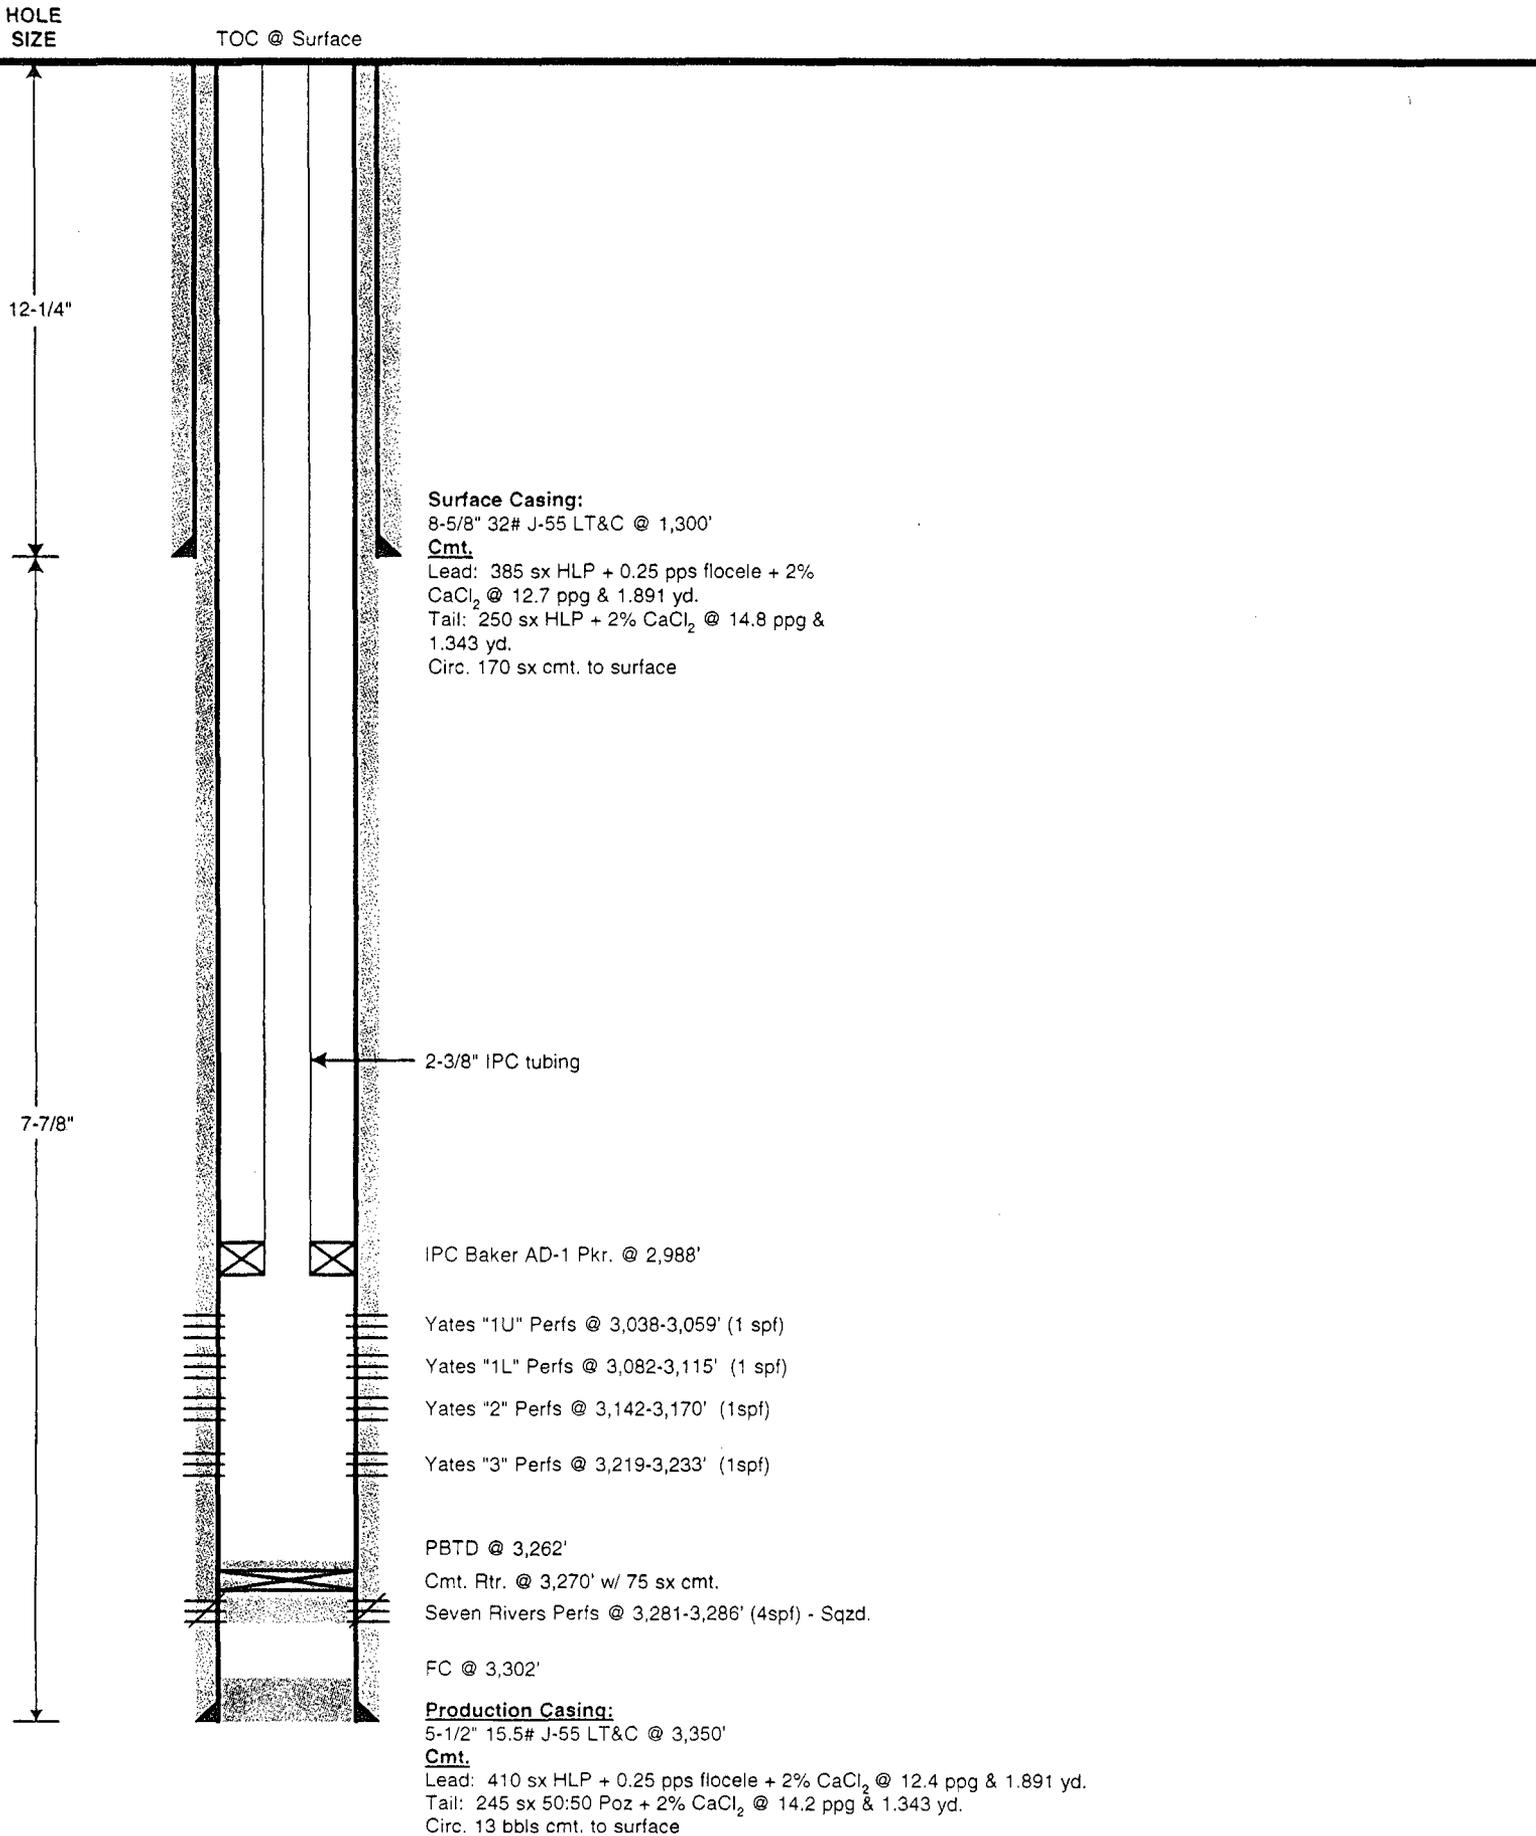

PREPARED BY: Ginni A. Kennedy
UPDATED BY: _____

DATE: 6/5/03
DATE: _____


CURRENT WELLBORE SCHEMATIC

CHESAPEAKE OPERATING INC



WELL : WTU #933 (FORMER GROVER FEDERAL #3)
FIELD : WEST TEAS
COUNTY : LEA **STATE** : NM
LOCATION : "J" SECTION 9-T20S-R33E
ELEVATION : GL 3,541' KB 3,549'
API NO. : 30-025-

HOLE SIZE

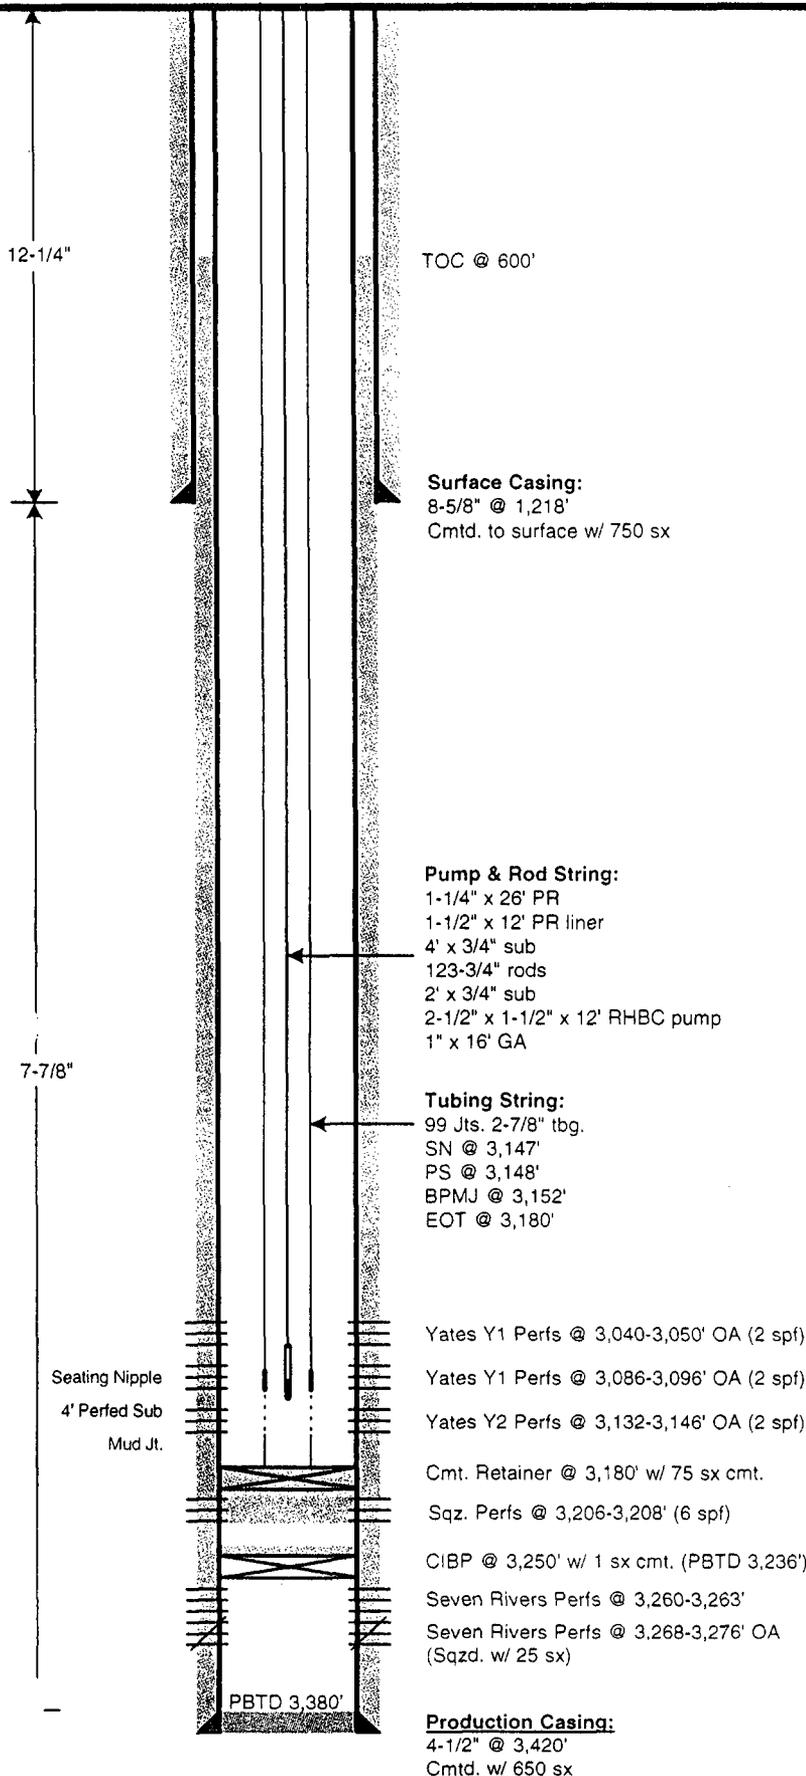

Well History


2-26-88: Spud well
 Initial Completion:
 Perf Yates Y1 from 3022', 3024', 3034', 3036', 3040', 3043', 3045', 3050', 3086', 3088', 3092', 3094', & 3100' w/ 2 JSPF
 Acidize w/ 500 gals of 15% NeFe
 Frac w/ 375 BW, 75 tons CO₂, & 42,000# of 20/40 sd and 30,800# 12/20
 IPP: 85 BOPD; 5 BWPD
 9/97: Perf 7 Rivers from 3,268'-3,276'. Acidize w/ 750 gal of 15% Ferchek
 11/97: Set CIBP @ 3240', Sqz 7 Rivers w/ 25 sx "C", Sqz Yates from 3022'-3100' w/ 250 sx "C". Perf 7 Rivers from 3260'-3263' w/ 3 JSPF. Acidize w/ 650 gal 15% NeFe
 IPP: 115 BW, 1 BO,
 10/98: Set CIBP @ 3250' w/ 20 sx on top. Perf Y2 from 3132'-3142' w/ 2 JSPF. Acidize w/ 500 gal of 15% NeFe.
 IPP: 2 BO, 2 BW, 0 MCF
 2/25/02: SFL 1683' from surf.
 11/2/02: Frac Yates "2". POOH w/ tubulars. Ran bit & scraper. Ran pkr. to 3124'. Started acidizing. Communicated to squeezed Yates "1" perfs. Set pkr. @ 2975'. Tested backside to 1000 psi--OK. Frac w/ 22,766 gal. 60,000# 12/20 sd. ISIP 2190#. Clean out sand to PBTD 3250'. PWOP.
 Testing 0 BO, 115 BW
 12/11/02: Spot 1 sx cmt. on CIBP @ 3250'. PWOP. All water.
 3/6/03: Pull pump, rods, & tbg. RU BOP, GIH w/ 4-1/2" scraper to 3236' PBTD.
 3/7/03: Shoot sqz. perfs from 3206-08'. Set Cmt. Retainer @ 3180'. Pump 75 sx 50/50 Pozmix w/ 2% CaCl₂. Would not pressure up.
 3/8/03: Sting into retainer. Pump 16 bbls. cmt. into sqz. perfs.
 3/10/03: GIH w/ bit; tag cmt. @ 3,112'. Drill out cmt. to 3,180'. RU to swab, tag fluid @ 200' FS. Swab down to 2700' FS, total 31 bbls.
 3/11/03: RIH w/ swab; FL @ 1200' FS, trace oil. Swab down to SN, swabbed dry after 11 runs. Making 1 hr. runs, 200' fluid entry. RD swab, POOH w/ tbg. SWI.
 3/12/03: TIH w/ perf guns. Re-perf Yates 2 @ 3132-46' w/ 2 spf. Re-perf Yates 1 @ 3086-90' & 3040-50' w/ 2 spf. TIH w/ tbg., NU WH. Pumped 10 bbls. fsw dwn tbg, drop SV. Press. tbg up to 300 psi, pumped 500 gal. 15% NeFe down csg. @ 350 psi, 2 bpm. Acid bubbling from around surface pipe. Dug down to surface valves, 2" nipple w/ hole. Replaced nipple and valve, repaired pinhole in 4-1/2" csg. @ welded bell nipple. Could not pump down surface pipe. Pumped 50 bbl fsw dwn 4-1/2" @ 1 bbl/hr. & 500 psi. Did not circ to surface pipe. SISD.
 3/13/03: Fish SV. NUWH & BOP, TOOH w/ tbg. string. RIH w/ pkr, repair pinhole in 4-1/2" csg. at ground level. Pressure test csg. at various intervals; held pressure. TOH w/ pkr, TIH w/ BPMJ, PS, SN & 99 jts. tbg. ND BOP, NU WH. Swab; IFL 50' FS, FFL 1100' FS. 37 bbls. water recovered, no gas.
 3/14/03: Open well, no pressure. Swab; IFL 800' FS. Made 15 runs, FL stayed @ 2400'. Rec. 54 bbls. water, no gas. RIH w/ BH pump & rods. Hung well on, RDPU.

Production Casing:
 4-1/2" @ 3,420'
 Cmtd. w/ 650 sx

PREPARED BY: Ginni A. Kennedy
UPDATED BY: Ginni A. Kennedy

DATE: 2/18/03
DATE: 3/18/03

Grover Federal #1
 West Teas Field
 "K" Section 9, T20S, R33E
 Lea County, New Mexico
 GL: 3,543'; KB 3,554'

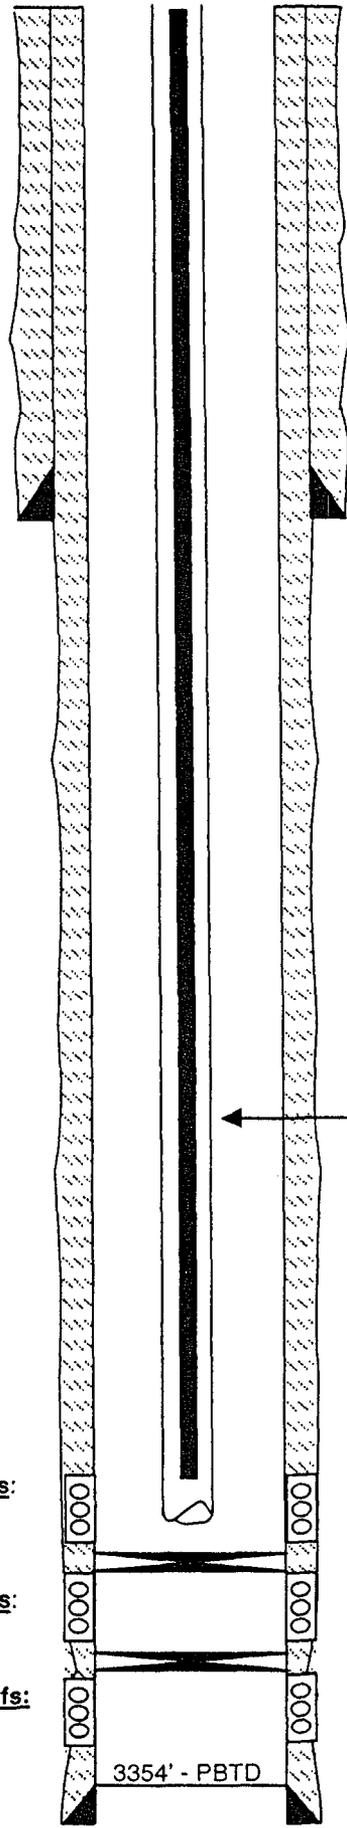

12-1/4" Hole
 1,265' - 8-5/8" Casing,
 cmt to surface w/750 sx

2-3/8" Tubing
 126 5/8" Rods
 2"x 1-1/4" x 10' pump

Yates Y2 Perfs:
 3,154' - 3,180'

Yates Y3 Perfs:
 3,263' - 3,270'

Seven Rivers Perfs:
 3,292' - 3,305'

3,250' - Bridge Plug

3,285' - Bridge Plug

3354' - PBTD

3,398' - 4-1/2" Casing, cmt w/820 sx Class
 Cmt to Surface, circulated 90 sx

Initial Completion

Spud well 2-16-87
 DST #1 3021'-3150'
 Perf Seven Rivers from 3292', 3293',
 3294', 3295', 3298', 3299', 3300', 3301',
 3302', 3303', 3304' & 3305'
 Acidize w/ 250 gals acid
 Set CIBP @ 3285'
 Perf Y3 3263', 3255', 3268',
 3270' w/ 2 JSPF,
 Acidize w/ 250 gal 15% NEFE
 Set CIBP @ 3250'
 Perf Yates Y2 from 3154', 3159', 3164',
 3168', 3174', & 3180' w/ 2 JSPF
 Acidize w/ 500 gals 15% NEFE
 IPP: 65 BOPD


11/87

Frac Yates w/ 18,900 gal gelled water,
 95 tons CO2, 40,000# 20/40 sd, &
 33,000# of 12/20 sd
 IPP: 85 BO

All Cement Information was from
 State Sundry Notices

Falcon Creek Resources, Inc.

Federal #4
West Teas Field
"M" Section 9, T20S, R33E
Lea County, New Mexico
GL: 3,531'; KB: 3,541'

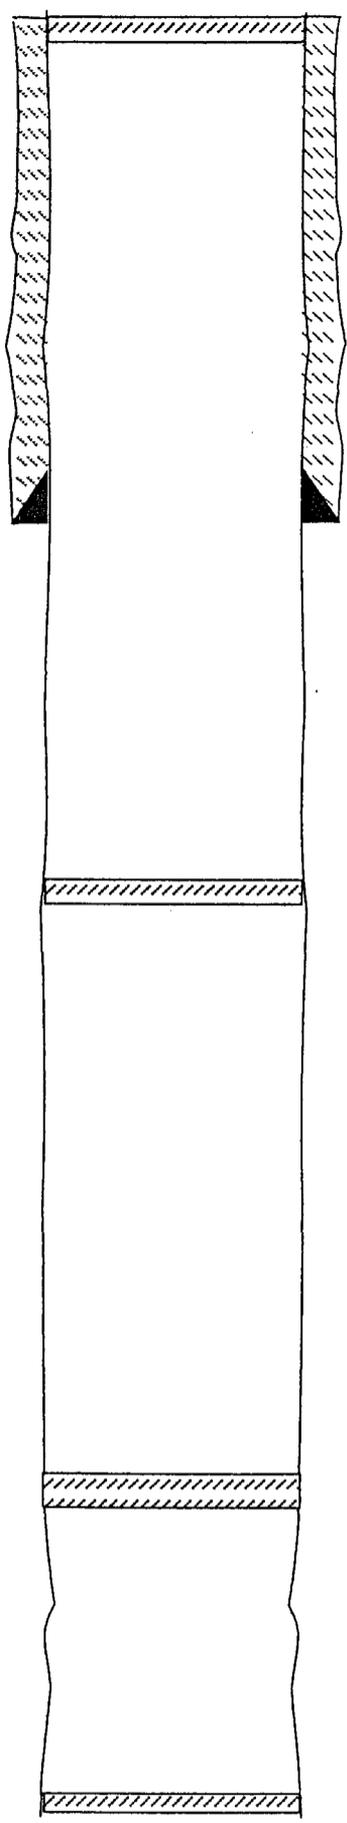

Cmt Plug @ surface w/ 15 sx

12-1/4" Hole
1,252' - 8-5/8" Casing,
cmt to surface w/700 sx

1100' - 1445' Cmt Plug w/ 175 sx

2,650' - 2950' Cmt Plug w/90 sx

3300' - 3400' Cmt Plug w/ 30 sx

TD: 3400'


Initial Completion

Spud well 3-2-88
DST 3023'-3195'
R/60' DF, PFFP 114-114,
ISIP=343, FP 114-114, FSIP 251,
HP 1646-1646.
P&A

Plugging information is from
State Reports

Sapient Energy Corp.

Lea 6015 Federal #2
 West Teas Field
 "N" Section 9, T20S, R33E
 Lea County, New Mexico
 GL: 3,532'

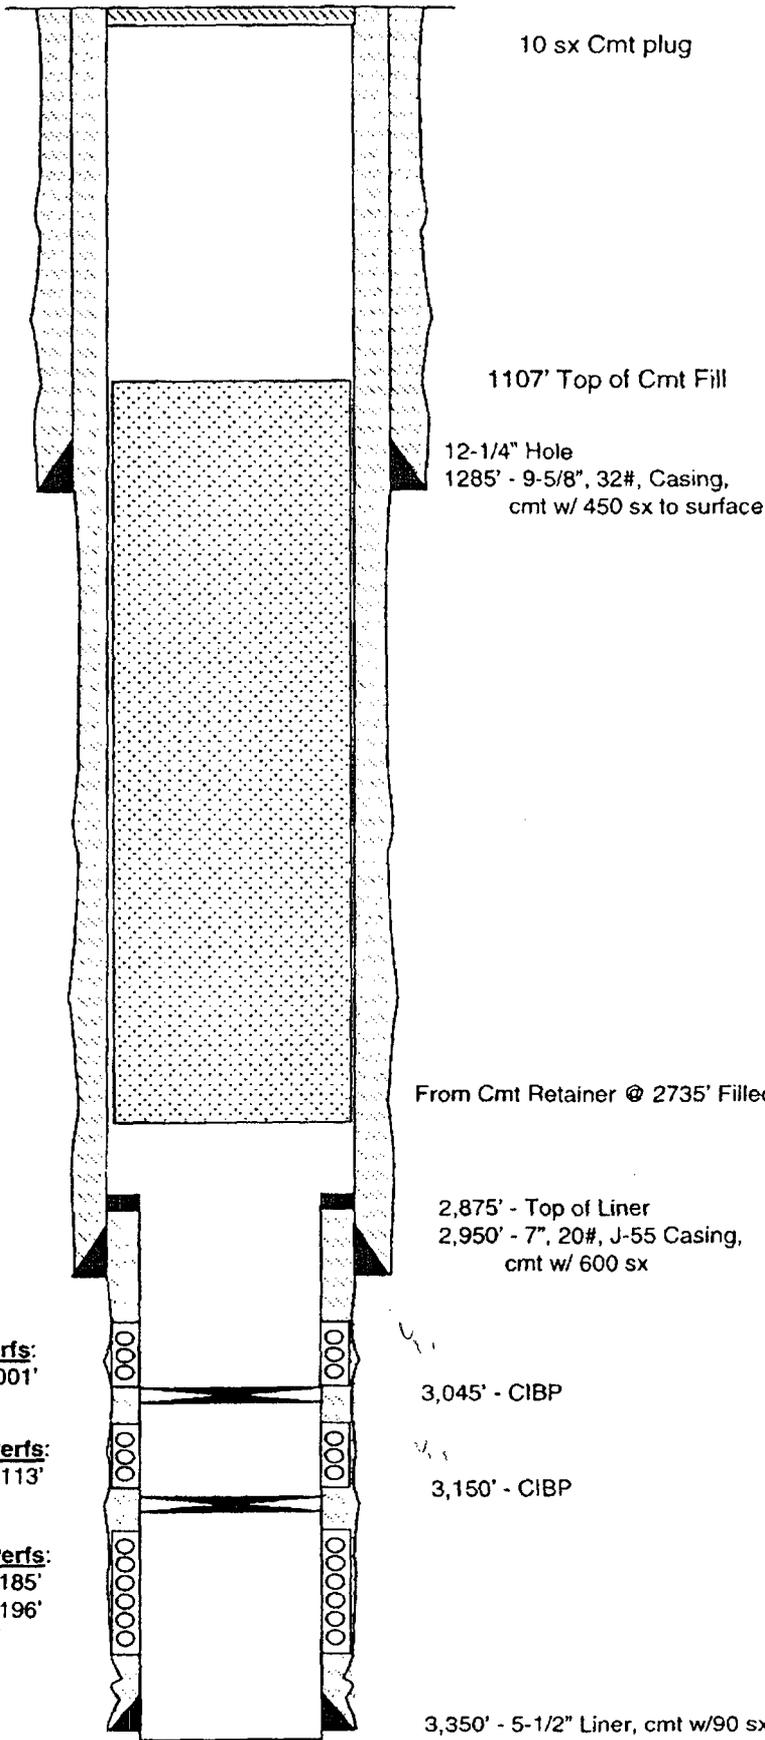

Initial Completion

Spud 7-30-63
 Perf Yates B 3180'-3196' - 44 holes
 Acidize w/ 500 gals
 Frac w/ 10,000 gal & 10,000# sd
 IPP: 58 BO, 2 BW

2/70

Set CIBP @ 3150'
 Perf Yates G 3085'-3113'
 Acidize w/ 500 gals
 IP: 69 BW (Y2 test wet)
 Set BP @ 3045'
 Perf Yates I 2980'-3001'
 Acidize w/ 1500 gal
 Frac w/ 20,000 gal & 20,000# sd
 IP: 4 BW
 TA

Scout ticket Note:
 2/71 "May convert to SWD"

2/75

Set Cmt retainer @ 2735' Spotted 250 sx "C" cement on top of retr. Tag top of cmt @ 1107'. Hole filled w/ mud-laden material 1107'-40. 10 sx cmt plug to surface

From Cmt Retainer @ 2735' Filled w/ 250 sx
 All cement information from State Forms.

Yates I Perfs:
 2,980' - 3,001'

Yates F Perfs:
 3,085' - 3,113'

Yates B Perfs:
 3,180' - 3,185'
 3,190' - 3,196'
 w/ 4 JSPF


3,045' - CIBP

3,150' - CIBP

3,350' - 5-1/2" Liner, cmt w/90 sx

Sapient Energy Corp.

Lea State 6019 #2
 (aka Lea State #2)
 West Teas Field
 "D" Section 16, T20S, R33E
 Lea County, New Mexico
 GL: 3,530'

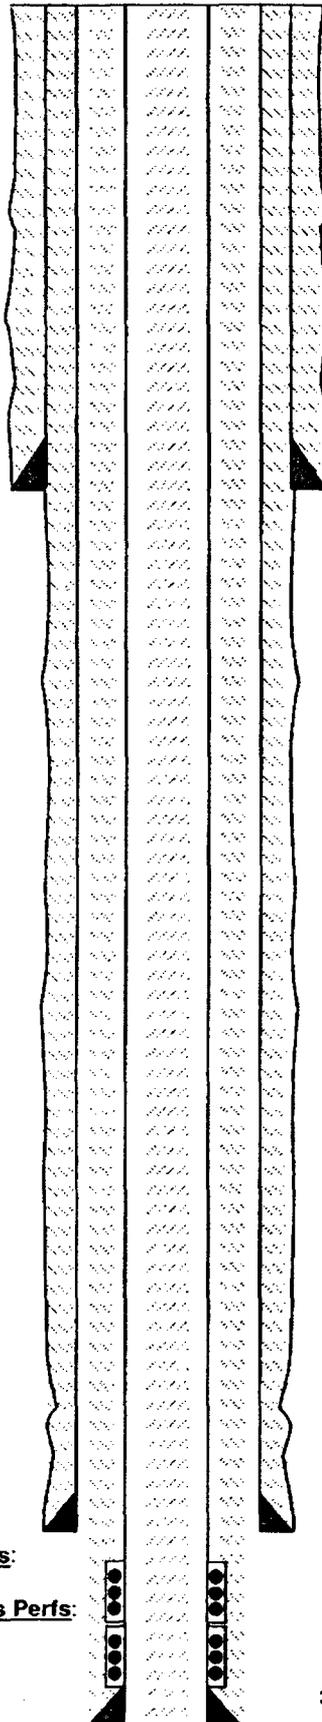

1,350' - 9-5/8" Casing,
 cmt to surface w/608 sx

2,975' - 7" Casing, cmt w/15 sx Class

3,297' - 2-7/8", cmt w/1028 sx

Initial Completion

Spud well 4-20-60
 Perf Yates B from 3194'-3199'
 Acidize w/ 250 gals
 Frac w/ 1500 gals
 IPP: 40 BOPD
6/64
 Frac w/ 10,000 gal oil & 10,000# sd
8/64
 Perf Seven Rivers from 3250-3251
 Sqz 3194-99 & 3250-51 w/ 250 sx cmt
 Perf Upper Seven Rivers from 3222-23
 w/ 4 holes
 Acidize w/ 1000 gal mud acid.
 Sqz w/ 325 sx
 Perf Seven Rivers from 3232-40 w/ 32 hole
 IP: Trace oil & formation water
 Shut well in
2/65
 Sqz perms w/ 150 sx.
 Left 2-7/8" full of cement to surface
 Installed P&A marker

Sqzd Yates B Perfs:

3,194' - 3,199'

Sqzd Seven Rivers Perfs:

3,222' - 3,223'

3,232' - 3,240'

3,250' - 3,251'

WTU 913 - C108 - Item VII

1. The average daily rate will approximate 500 BWPD, a maximum rate of 750 BWPD, total volume will approach 1 million bbls.
2. Per the unitization hearings and the original order, this system is closed.
3. Average pressure will approach 600 psi. Maximum authorized pressure is currently .2 psi per foot or approximately 600 psi.
4. Water is reinjected from unitized zones
5. NA.

WTU 913 - C108 - Item IX

The Yates is typically stimulated as follows:

- | | |
|----|--|
| 1. | Tie onto casing. Establish rate and bull head 1000 gallons of 15% NeFe acid into the Yates '3'. Launch 14 balls throughout job. Note rates and pressures. Surge balls off perfs. Fracture the Yates '3' with 20,000 gal of gelled borate containing 40,000# of 20/40 sand per the attached treatment schedule. Maintain rates approaching 30 BPM, max pressure 4000 psi. |
| 2. | Set a CIBP @ 3,200'. Run casing gun and perforate the Yates '2' 3,142 – 3,170' (28') w/ 1 SPF, 23 gram charge, 60 degree phasing. |
| 3. | Tie onto casing. Establish rate and bull head 1000 gallons of 15% NeFe acid into the Yates '2'. Launch 28 balls throughout job. Note rates and pressures. Surge balls off perfs. Fracture the Yates '2' with 40,000 gal of gelled borate containing 75,000# of 20/40 sand per the attached treatment schedule. Maintain rates approaching 30 BPM, max pressure 4000 psi. |
| 4. | Set a CIBP @ 3,130'. Run casing gun and perforate the Yates '1L' 3,082 – 3,115' (33') and Yates '1U' 3,038 – 3,159' (21') w/ 1 SPF, 23 gram charge, 60 degree phasing. |
| 5. | Tie onto casing. Establish rate and bull head 1000 gallons of 15% NeFe acid into Yates '1'. Launch 54 balls throughout job. Note rates and pressures. Surge balls off perfs. Fracture the Yates '1' with 40,000 gal of gelled borate containing 75,000# of 20/40 sand per the attached treatment schedule. Maintain rates approaching 30 BPM, max pressure 4000 psi. |



Geology Department

May 6, 2003

To: Andrew McCalmont
Assett Manager
Chesapeake Energy Corporation.

Having reviewed all pertinent geologic data within 2 miles of the West Teas Yates - Seven Rivers Unit, it is my opinion that there is no evidence of open faults or any hydrologic connection between the Yates-Seven Rivers Reservoirs and any known underground sources of drinking water.

Sincerely,

A handwritten signature in cursive script that reads "Doug Bellis".

Doug Bellis
Geologist
Chesapeake Energy Corporation

AFFIDAVIT OF PUBLICATION

State of New Mexico,
County of Lea.

I, KATHI BEARDEN

Publisher

of the Hobbs News-Sun, a newspaper published at Hobbs, New Mexico, do solemnly swear that the clipping attached hereto was published once a week in the regular and entire issue of said paper, and not a supplement thereof for a period.

of 6 weeks.

Beginning with the issue dated May 16 2003

and ending with the issue dated May 22 2003

Kathi Bearden
Publisher

Sworn and subscribed to before me this 22nd day of

May 2003

Joel Henson
Notary Public.

My Commission expires
October 18, 2004
(Seal)

This newspaper is duly qualified to publish legal notices or advertisements within the meaning of Section 3, Chapter 167, Laws of 1937, and payment of fees for said publication has been made.

LEGAL NOTICE
May 16, 17, 18, 20, 21, 22, 2003

PROPOSED INJECTION WELLS

Chesapeake Operating, Inc. proposes the conversion of the following described wells to water injection service for the existing waterflood Order No. R-11375; West Teas (Yates Seven Rivers) Unit 913, 1980' FSL & 660' FWL, Section 9-20S-33E, West Teas (Yates Seven Rivers) Unit 941, 330' FNL & 990' FEL, Section 9-20S-33E, West Teas (Yates Seven Rivers Unit 443, 1650' FSL & 660' FEL, Section 4-20S-33E, West Teas (Yates Seven Rivers Unit 924, 2560' FNL & 2210' FWL, Section 9-20S-33E, West Teas (Yates Seven Rivers 9452612' FNL & 330' FEL. All wells are located in Lea County, New Mexico. The zones to be injected into are the Yates Sand from 3000' to 3300' with a maximum injection rate of 600 BWPD/well at a maximum pressure of 600 psi. Any interested parties with objection or request for hearing should notify the Oil Conservation Division at P.O. Box 2088, Santa Fe, New Mexico 87501 within 15 days of this notice. Any questions should be directed to Andrew McCalmont, Agent for Chesapeake Operating, Inc., at P.O. Box 18496, Oklahoma City, OK 73118, telephone number 405-848-8000, ext. 7852.
#19820

01104307000 02563986
Chesapeake Operating, Inc.
P.O. Box 18496
Oklahoma City, OK 73154-0496