


PLC

3/27/00  
166



February 29, 2000

**Chevron U.S.A. Production Company**  
P.O. Box 1150  
Midland, TX 79702

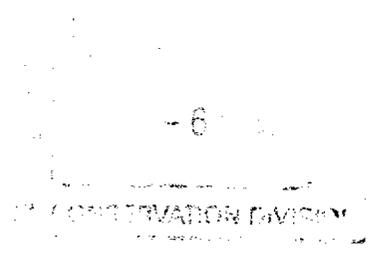

**Administrative Application for Surface Commingling  
Wildcat;Drinkard**  
- **Monument 13 State #17**  
1912' FNL & 1732' FWL, Unit F, Sec. 13, T19S, R36E  
13 State #27  
785' FNL & 1980' FEL, Unit B, Sec. 13, T19S, R36E  
**Monument 12 State #10**  
677' FSL & 791' FWL, Unit M, Sec. 12, T19S, R36E  
**Monument 13 State #29**  
1650' FSL & 990' FWL, Unit L, Sec. 13, T19S, R36E  
Lea County, New Mexico

State of New Mexico  
Energy, Minerals & Natural Resources Department  
Oil Conservation Division  
2040 South Pacheco  
Santa Fe, New Mexico 87505

Attention: Mr. William J. LeMay - Director

Dear Mr. LeMay:

Chevron U.S.A., Inc. respectfully requests administrative approval for surface commingling of the production of the above described wells.

Monument 13 State #17 has been recompleted in Wildcat; Drinkard. Initial potential was 3 BOPD, 2200 MCFPD, 0 BWPD. 13 State #27 was initially drilled in Wildcat;Drinkard. Initial potential was 17 BOPD, 23 MCFPD, 216 BWPD. Monument 12 State #10 has been recompleted in Wildcat;Drinkard. Initial potential was 1 BOPD, 774 MCFPD, 1 BWPD. Monument 13 State #29 was initially drilled in Wildcat;Drinkard. Initial potential was 6 BOPD, 663 MCFPD, 96 BWPD.


The commingling of these wells will allow producing the wells into one battery at a considerable savings. The oils are from the same zone and will be compatible. The value of the commingled oil will be the same as the individual oils.

Monument;Abo and Monument;Abo, North production is also commingled at the battery location. However, there is a complete and separate Drinkard battery that the captioned wells produce into. Gas is being metered separately for each well since working interest owners are not the same.

<sup>MISSING RECORD UNIT</sup>  
Location of the battery is F-12-19S-36E, Lea County. A schematic of the battery is attached.

If you have any questions, or if you require further information, please contact Lloyd Trautman at (915) 687-7152


Sincerely,

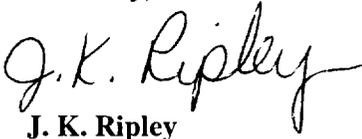

J. K. Ripley

Attachment

cc: NMOCD – Hobbs, NM  
NM State Land Office – Santa Fe, NM

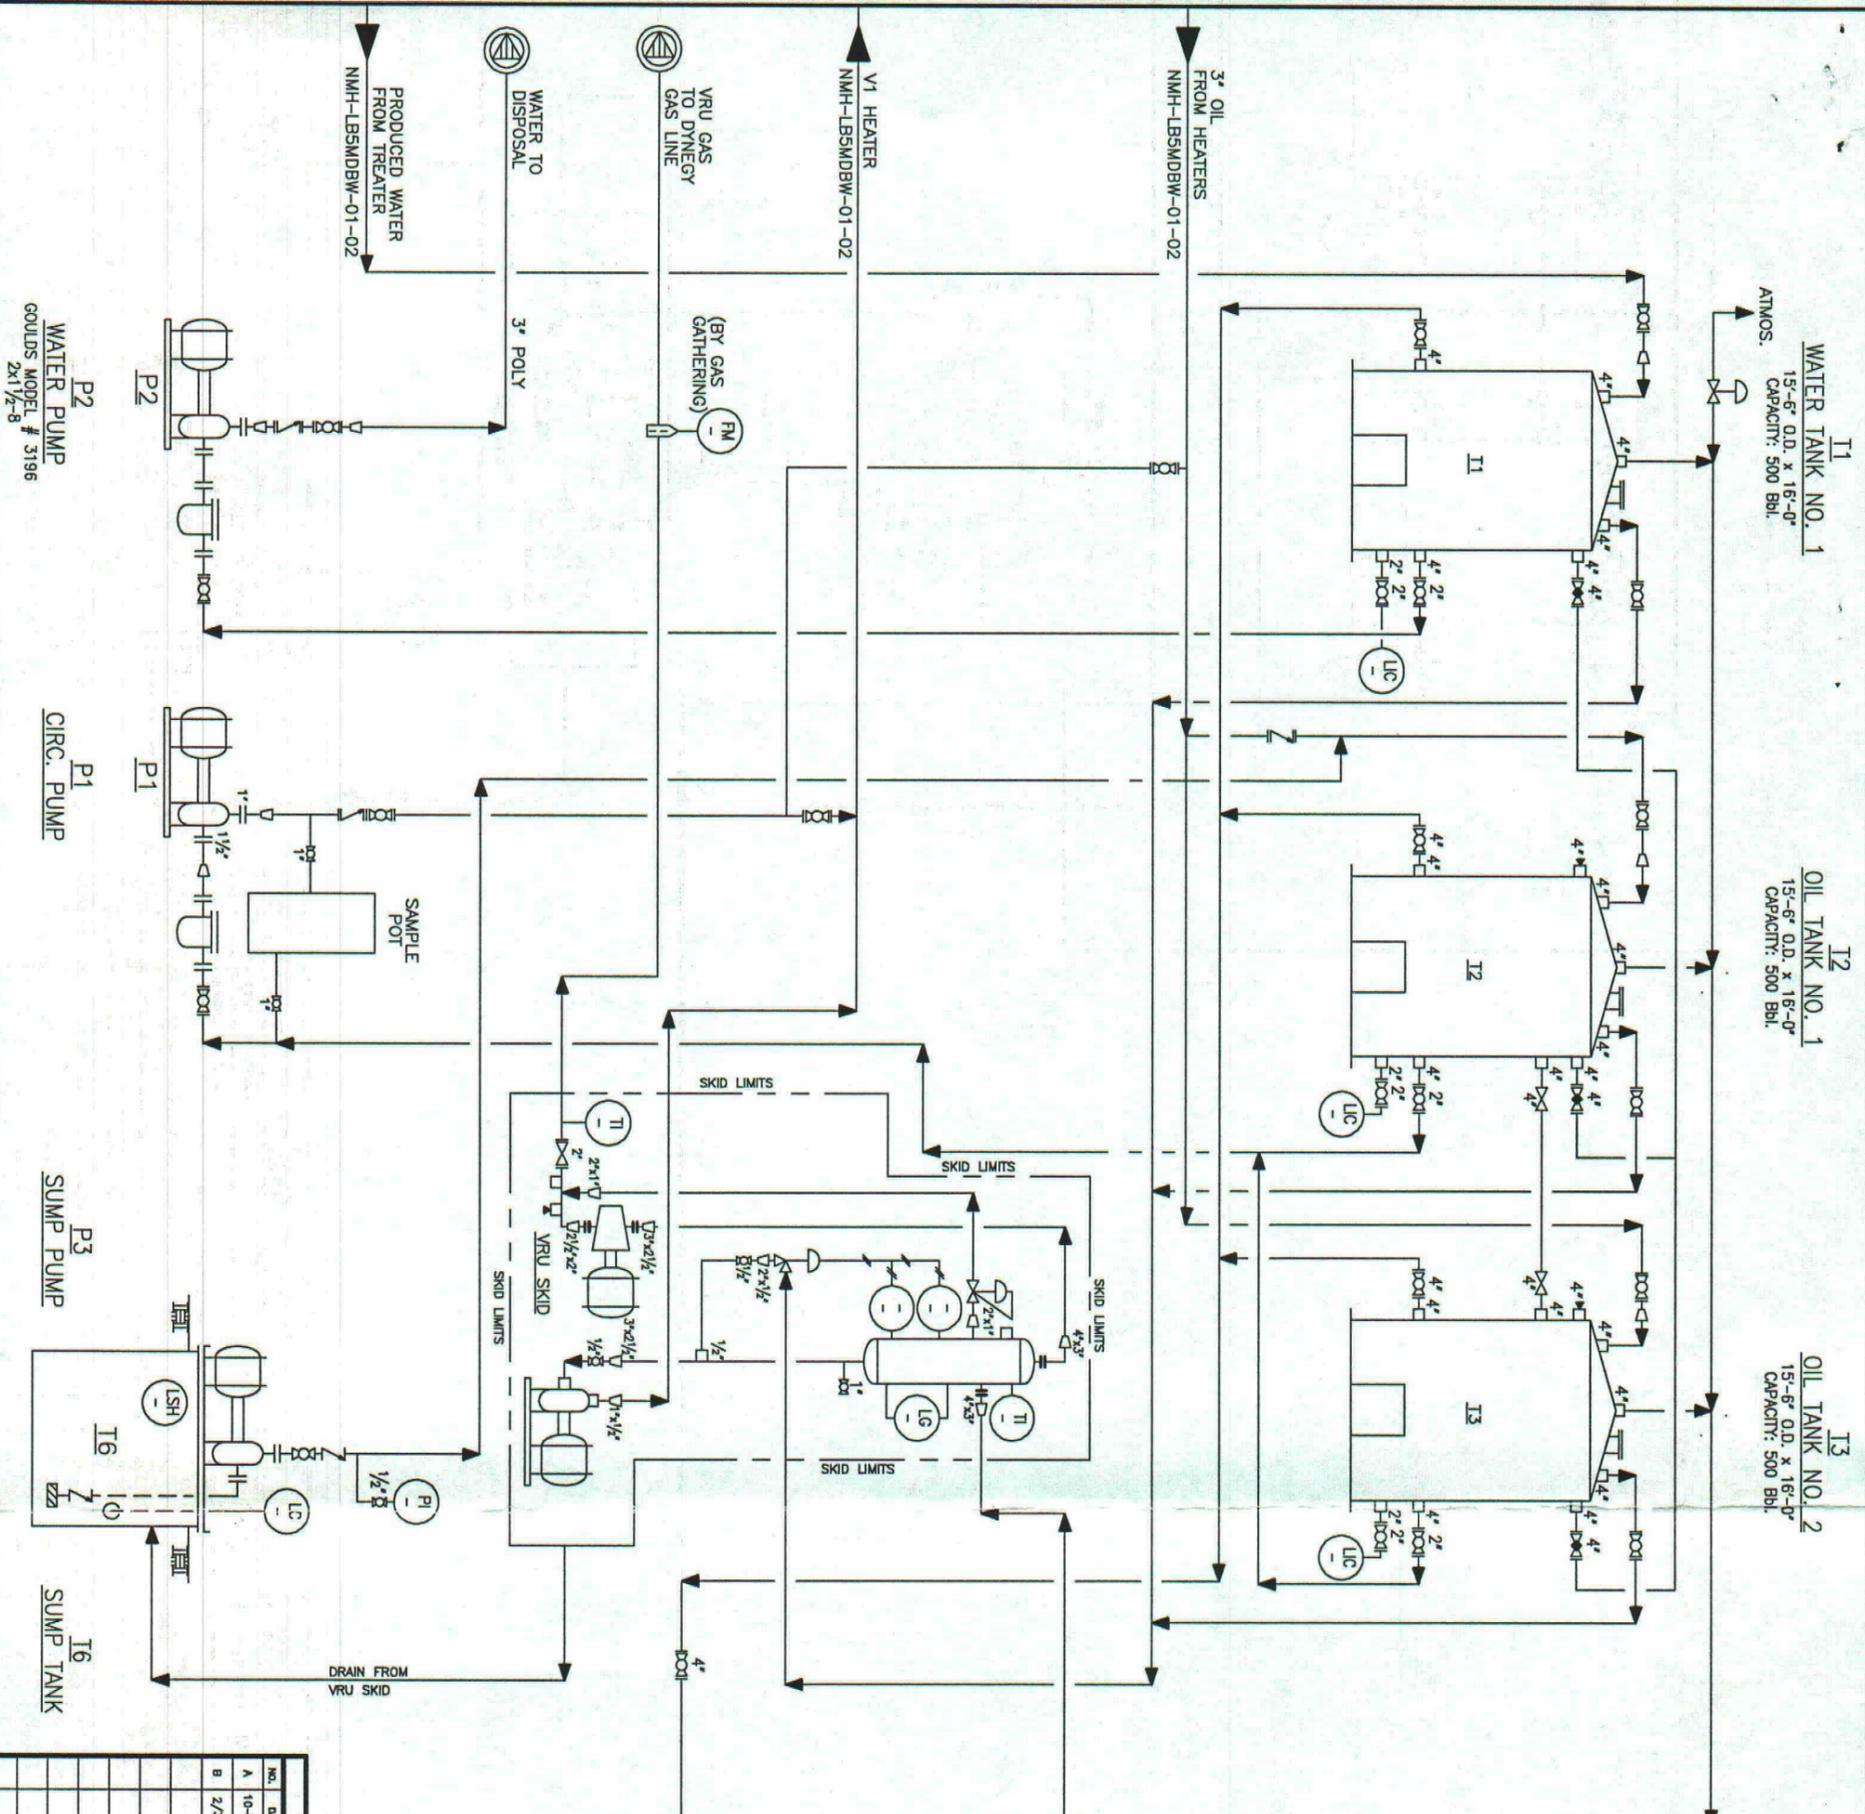

NO.	DATE	DESCRIPTION	BY	CHKD	APPD
A	10-5-99	ISSUED FOR APPROVAL	TTO	-	-
B	2/3/00	UPDATED DWG NO.S	JAM	-	-

**Chevron U.S.A. Inc.**  
 Permian Profit Centers

WILDCAT DRINKARD FIELD  
 NORTH MONUMENT DRINKARD BATTERY  
 LBSMDW  
 P & ID


LEA COUNTY, NEW MEXICO

ENGINEERING :  
 OPERATIONS :

ENG. : R. HOLZER  
 DRAWN : TTO

DATE : 10-5-99  
 SHEET : 3 OF 3

FILE : NMH-LBSMDW0103  
 DWG NO. : NMH-LBSMDW-01-03  
 REV : 8

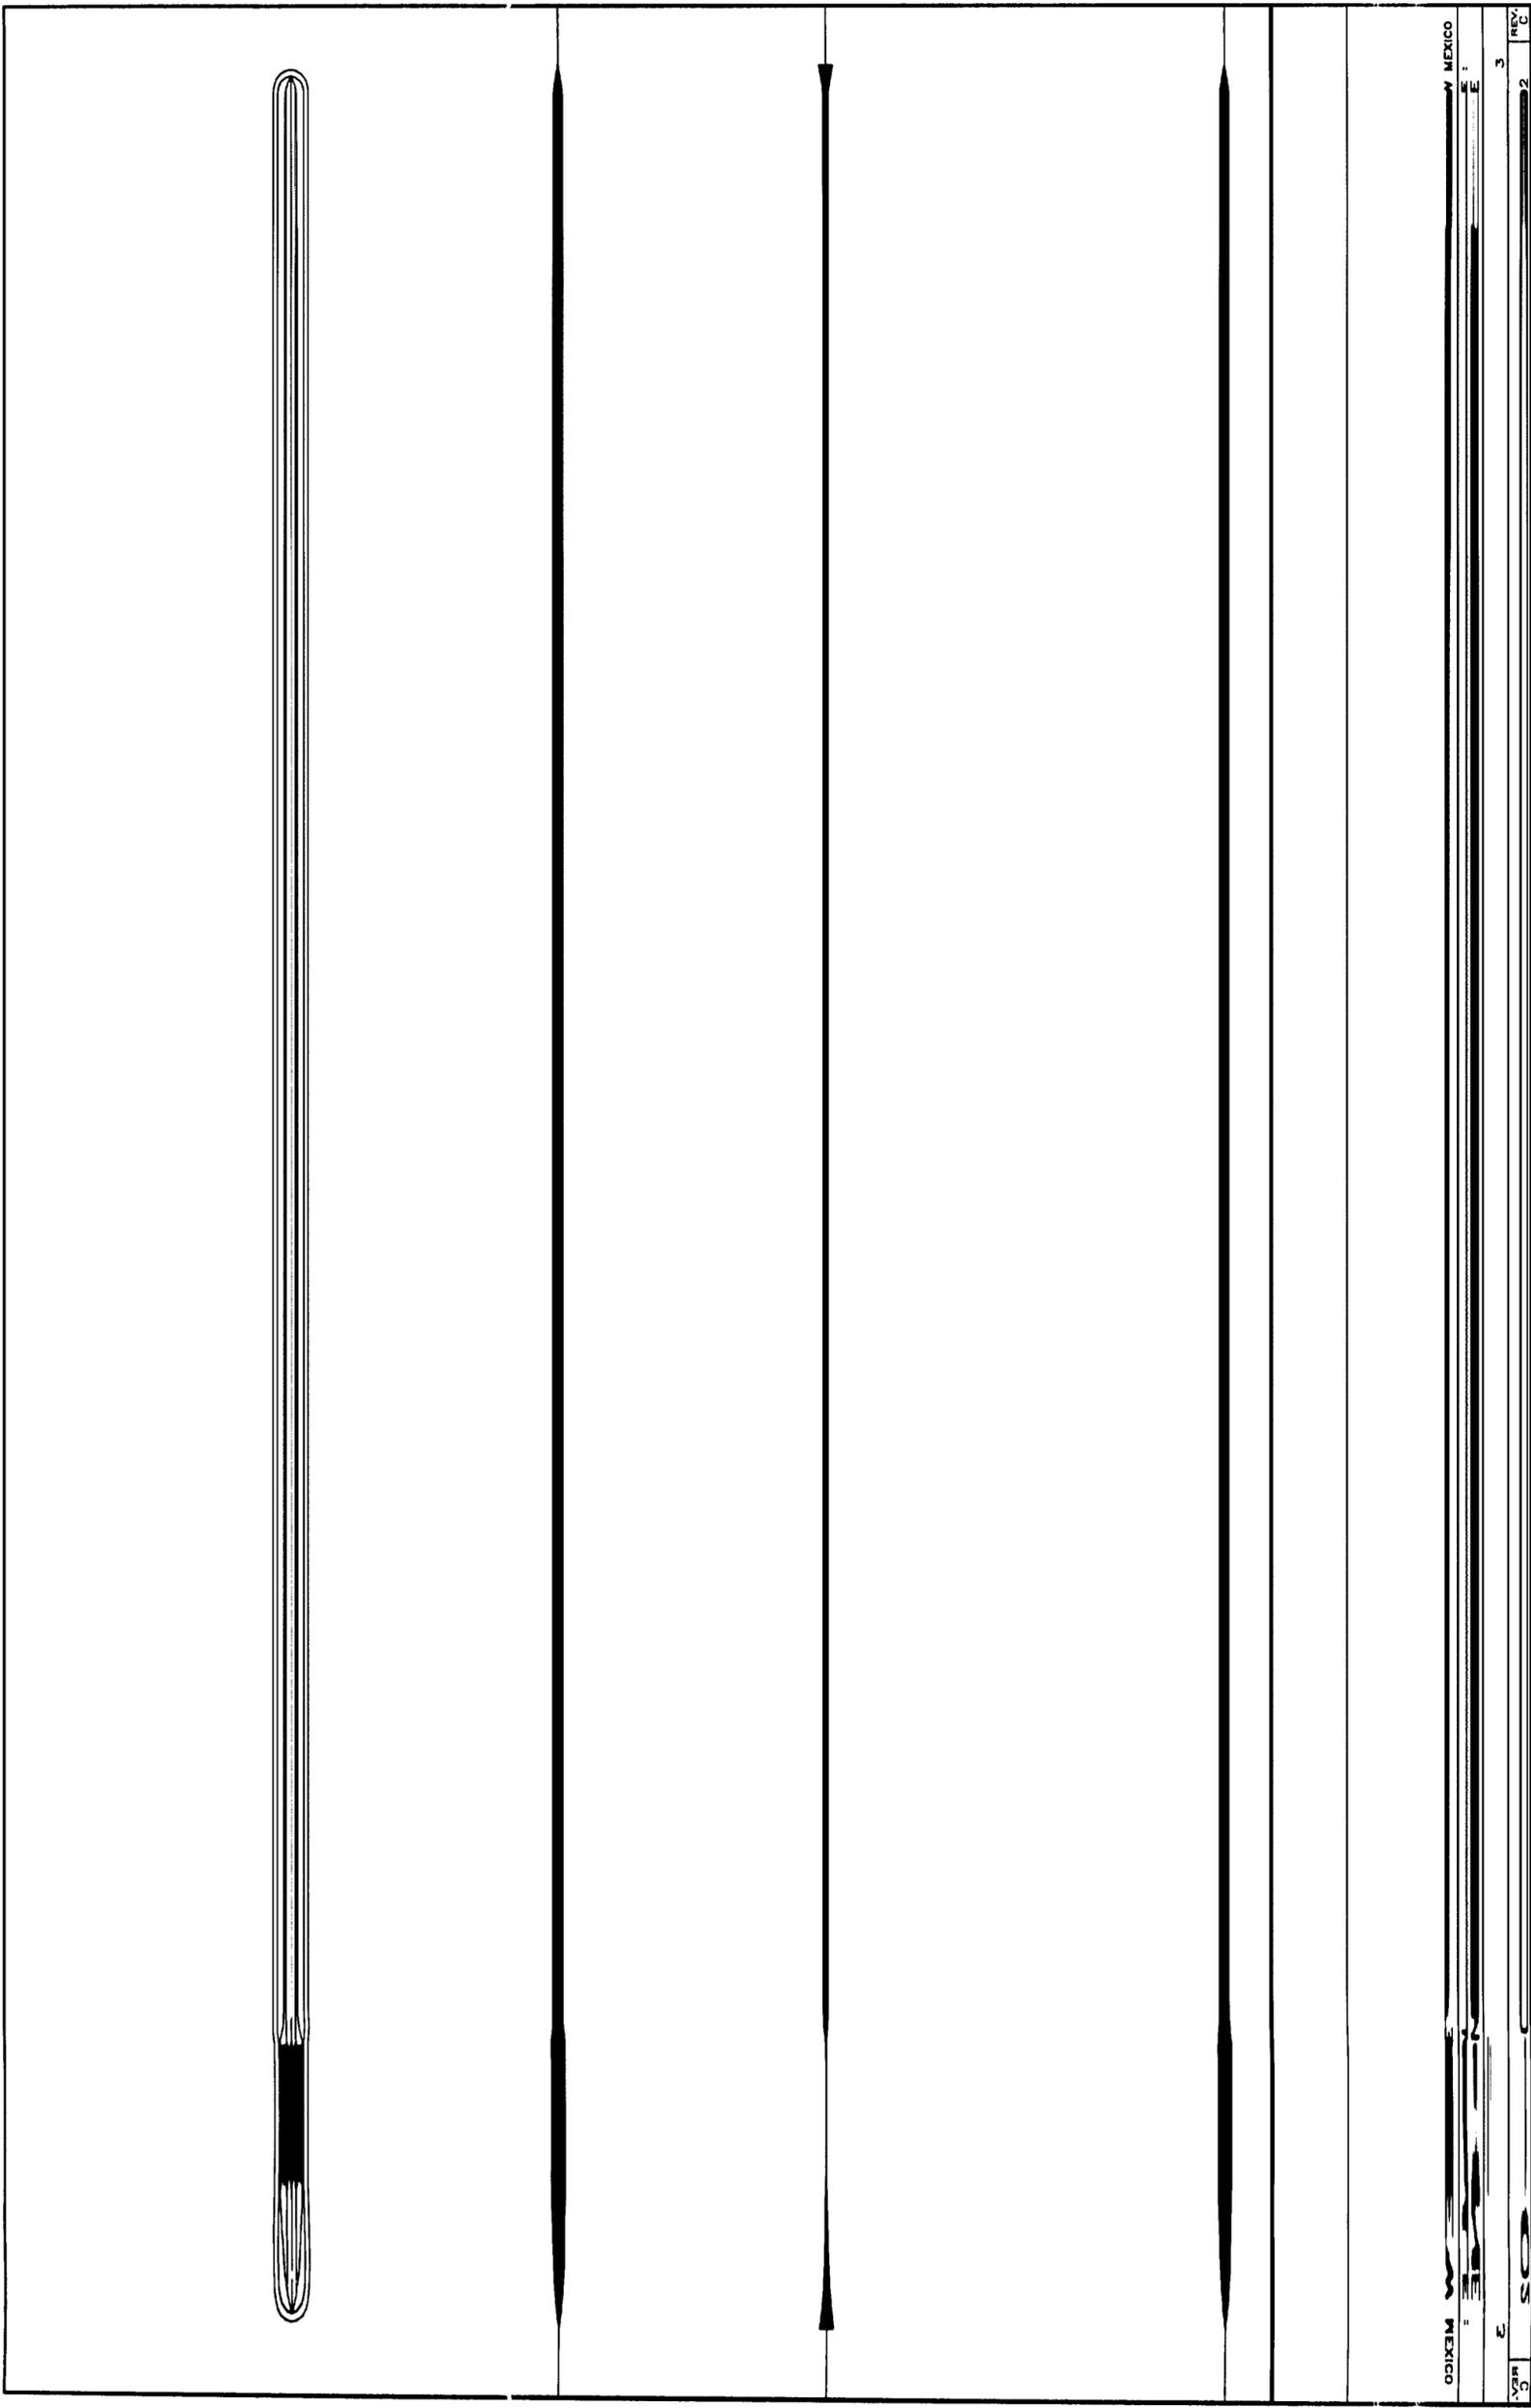

MEXICO MEXICO

3 2

3 2

3 2




V5 (79A0050579)  
 METERING SEPARATOR  
 36" O.D. x 8'-0"  
 MAMP: 250 PSI @ 7°F  
 MDM: 71 @ 250 PSI

V6 (79A0050088)  
 GAS SCRUBBER  
 36" O.D. x 10'-0"  
 MAMP: 125 PSI @ 7°F  
 MDM: 71 @ 68 PSI

V7 (79A0051180)  
 METERING SEPARATOR  
 30" O.D. x 10'-0"  
 MAMP: 125 PSI @ 150°F  
 MDM: 150°F @ 125 PSI

V3  
 PRODUCTION SEPARATOR  
 4'-0" O.D. x 15'-0" S/S  
 MAMP: 125 PSI

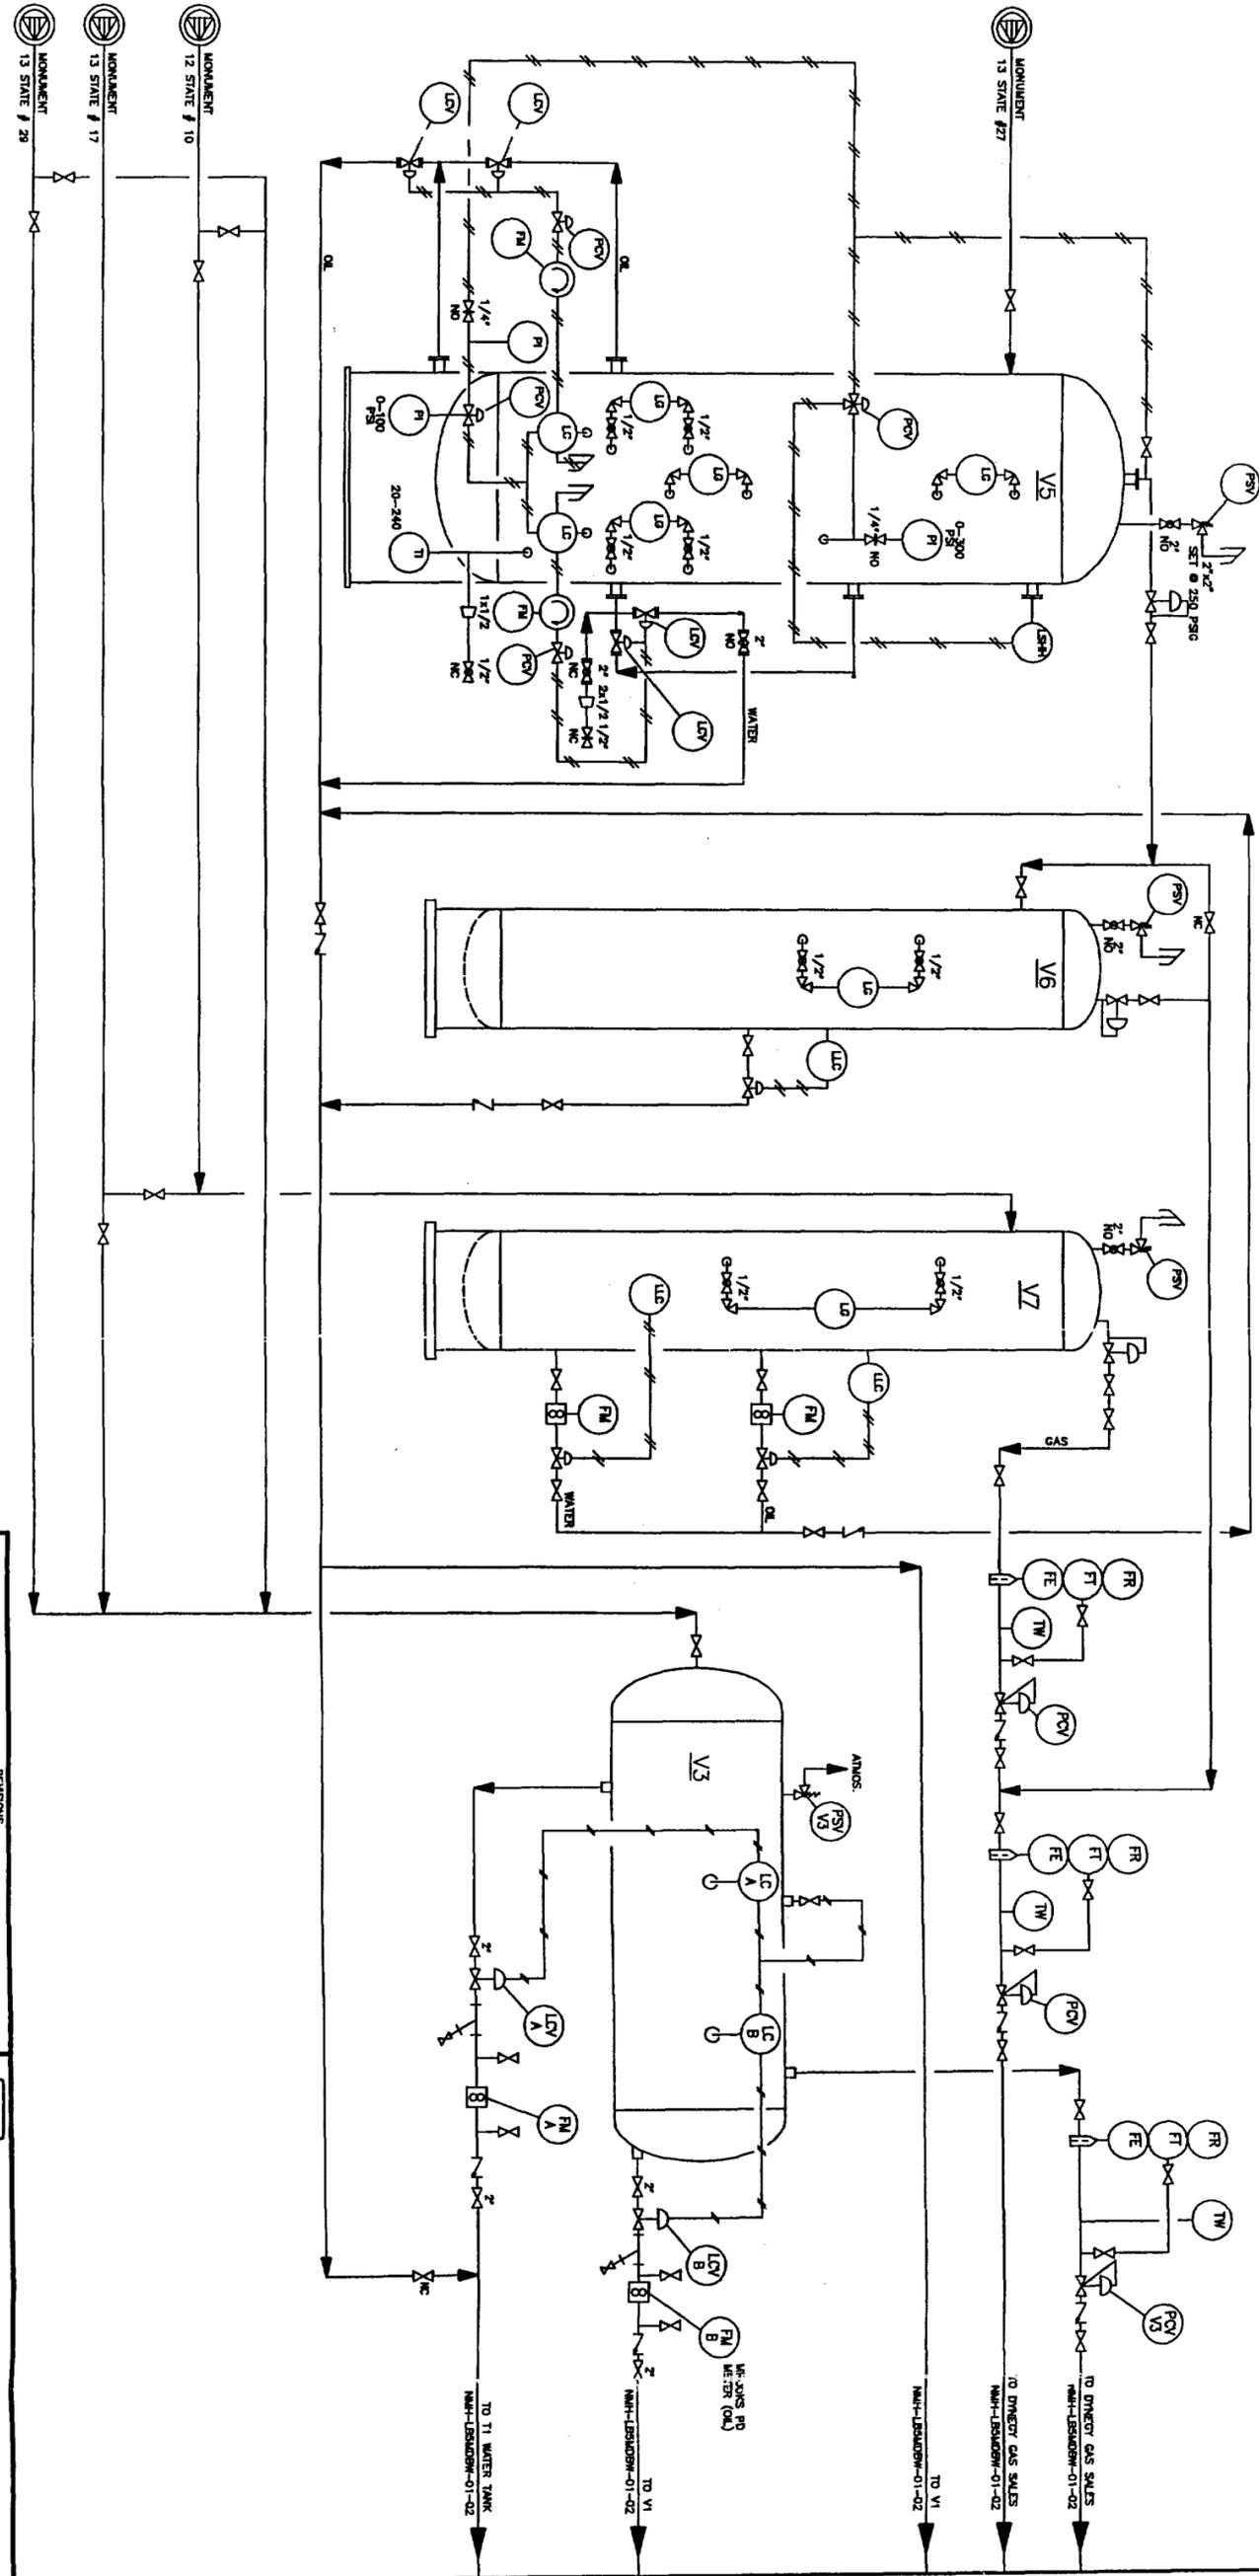

REV.	DATE	DESCRIPTION	BY	CHKD	APPD
A	11/9/98	ISSUED FOR APPROVAL	TTD	-	-
B	1/21/00	ISSUED AS PER RECORD'S RED LINES	JAA	-	-
C	3/2/00	UPDATED Dwg NO. 3 & ADDED Dwg NO. 4 PER RECORD'S RED LINES	JAA	-	-

**Chevron U.S.A. Inc.**  
 Permian Oil & Gas Profit Centers


WILDCAT DRINKARD FIELD  
 NORTH MONUMENT DRINKARD BATTERY  
 LESANDW P & ID

Edley County  
 OPERATIONS :  
 ENGINEER : R. HOLZER  
 DRAWN : TTD  
 SHEET : 1 OF 3  
 DATE : 11/9/98  
 SCALE : NONE  
 DWG NO : LESANDW-01-01  
 REV. :

V2  
FUEL GAS SCRUBBER  
10 3/4" X 2'-6"  
MAWP: 125 PSI

V1  
HEATER TREATER  
8'-0" X 20'-0" S/S  
MAWP: 50 PSI @ 150 F

V4  
GAS SCRUBBER  
3'-0" X 10'-0" VERTICAL  
MAWP: 125 PSI

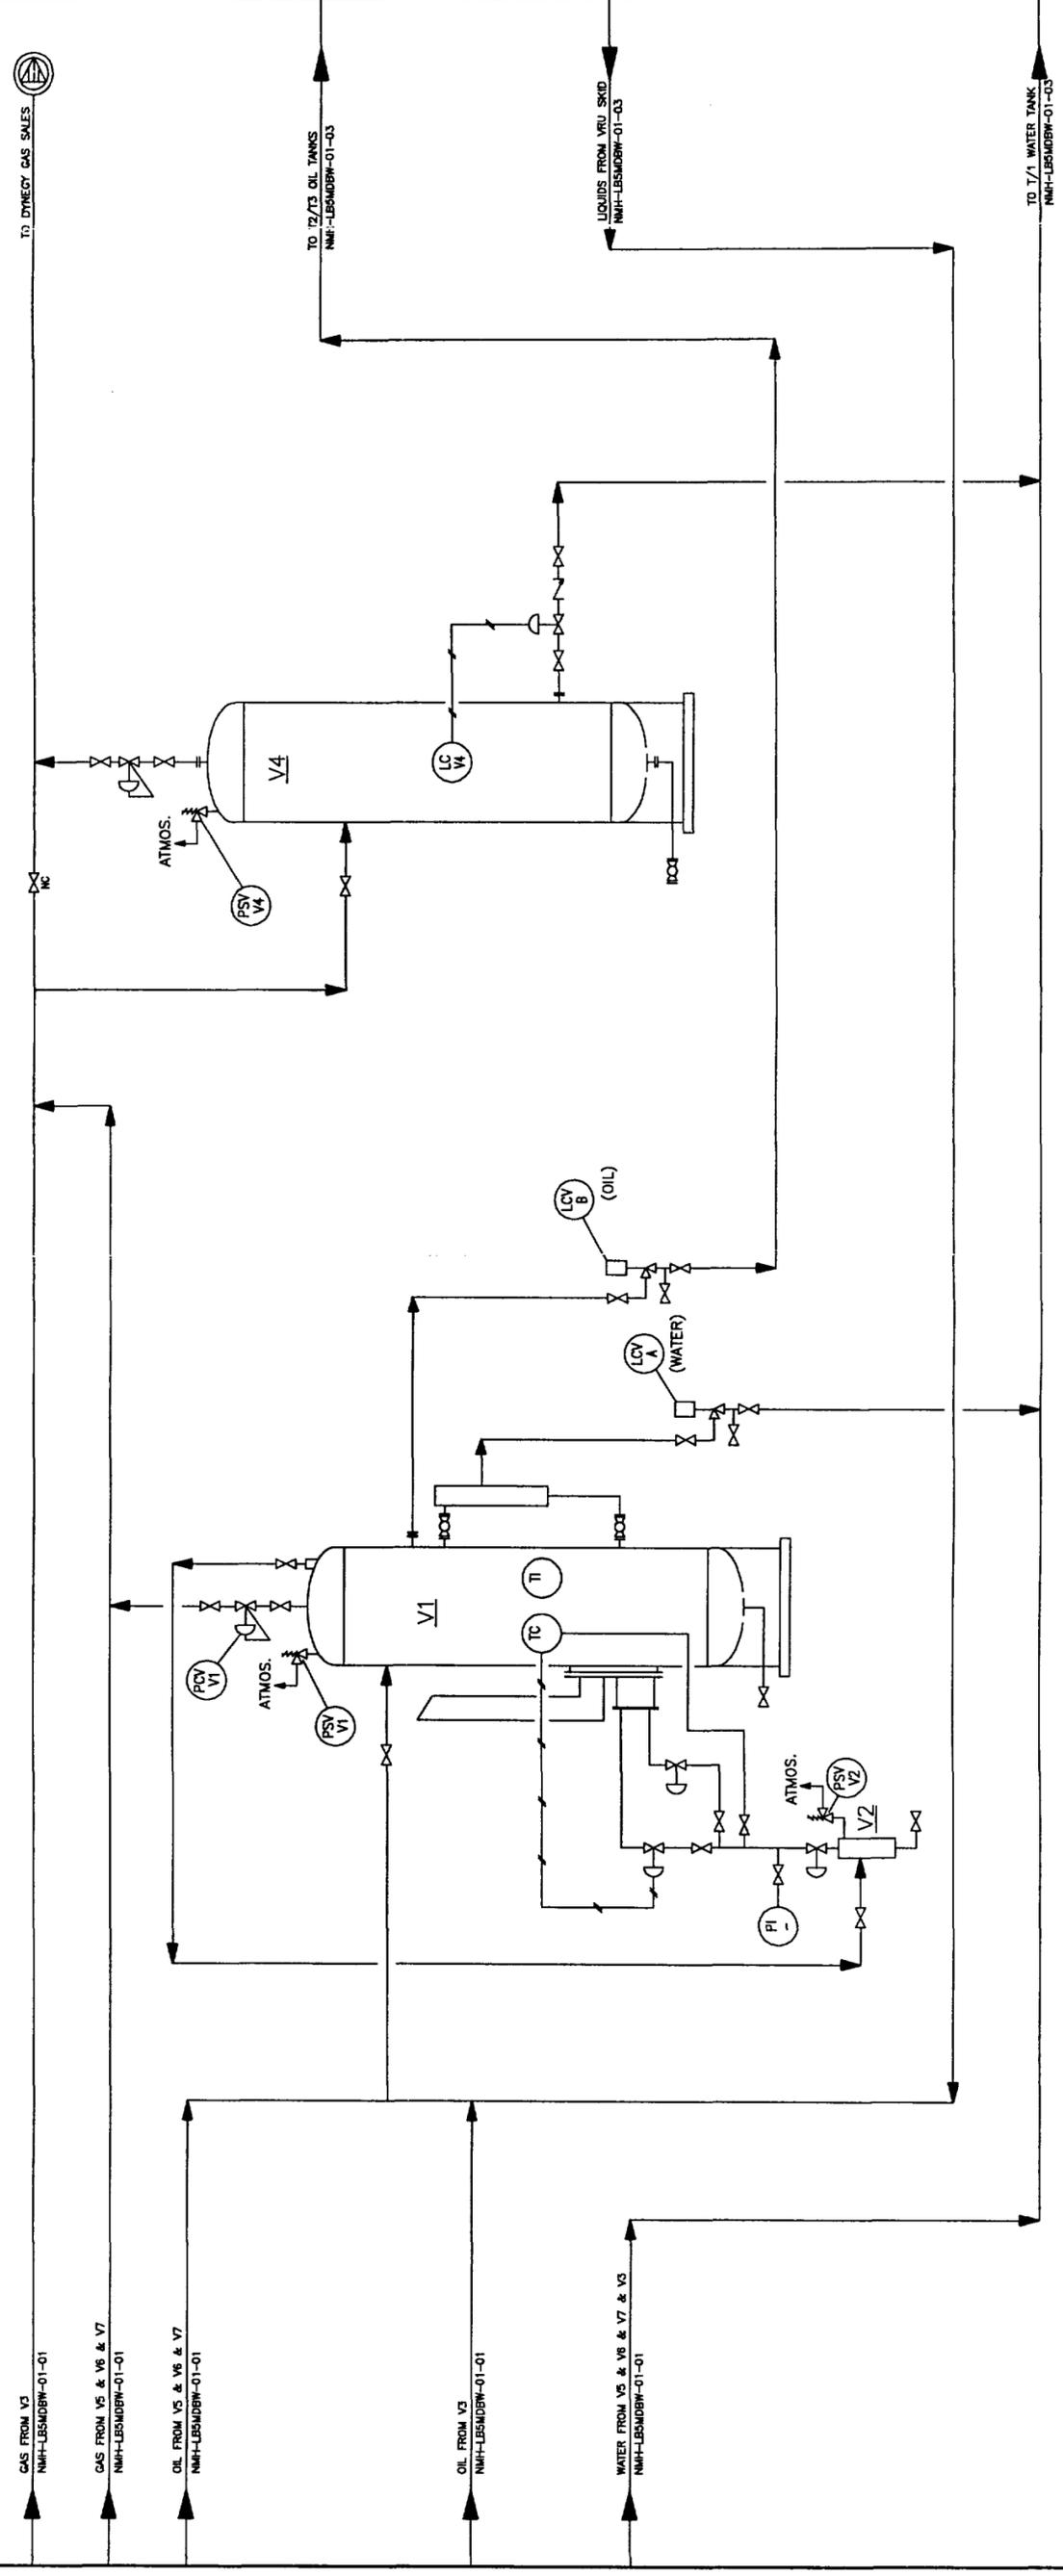

NO.	DATE	REVISIONS	BY	CHKD	APPD
A	10-5-99	ISSUED FOR APPROVAL	TTO	-	-
B	1/21/00	MODIFIED AS PER REGGIE'S REVISIONS	JAA	-	-
C	2/3/00	UPDATED Dwg NO.'S	JAA	-	-

**Chevron U.S.A. Inc.**  
Permian Profit Centers


NMHOBBS  
WILDCAT DRINKARD FIELD  
NORTH MONUMENT DRINKARD BATTERY  
LBSMDBW  
P & ID

LEA COUNTY, NEW MEXICO

ENGINEERING : R. HOLZER  
OPERATIONS : TITO

DATE : 10-5-99  
SCALE : NONE  
DRAWN : TITO  
SHEET : 2 OF 3

DWG. NO. NMH-LBSMDBW-01-02  
CHK. BY : TITO

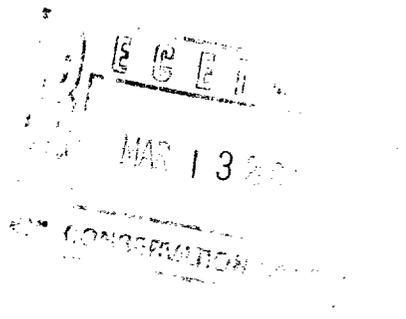

March 9, 2000

**Chevron U.S.A. Production Company**  
P.O. Box 1150  
Midland, TX 79702

**Administrative Application for Surface Commingling  
Wildcat;Drinkard  
Monument 13 State #17  
1912' FNL & 1732' FWL, Unit F, Sec. 13, T19S, R36E  
13 State #27  
785' FNL & 1980' FEL, Unit B, Sec. 13, T19S, R36E  
Monument 12 State #10  
677' FSL & 791' FWL, Unit M, Sec. 12, T19S, R36E  
Monument 13 State #29  
1650' FSL & 990' FWL, Unit L, Sec. 13, T19S, R36E  
Lea County, New Mexico**

**State of New Mexico  
Energy, Minerals & Natural Resources Department  
Oil Conservation Division  
2040 South Pacheco  
Santa Fe, New Mexico 87505**

**Attention: Lori Wrotenberry - Director**

**Dear Ms. Wrotenberry:**


**Mark Ashley contacted Lloyd Trautman on March 8, 2000, requesting additional information relating to this commingle request. The following is in response to that request.**

**Working Interest Owners for Monument 13 State #29, Monument 13 State #17 and Monument 12 State #10 are Chevron, Amerada Hess Corporation, Leede Operating Company and Phillips Petroleum Company. Working Interest Owners for 13 State #27 are Chevron and Texaco. Lloyd Trautman verbally discussed the surface commingling with each Working Interest Owner. None of the Working Interest Owners had an objection.**

**I am also attaching a map showing the location of the captioned wells.**

**If you have any questions, or if you require further information, please contact Lloyd Trautman at (915) 687-7152**

Sincerely,

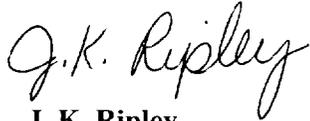A handwritten signature in black ink that reads "J. K. Ripley". The signature is written in a cursive style with a large, sweeping "R" and a long tail on the "y".

**J. K. Ripley**

**Attachment**

**cc: NMOCD – Hobbs, NM**

2

1

• 26

• 15

• 20


• 25

• 14

11

• 16

12

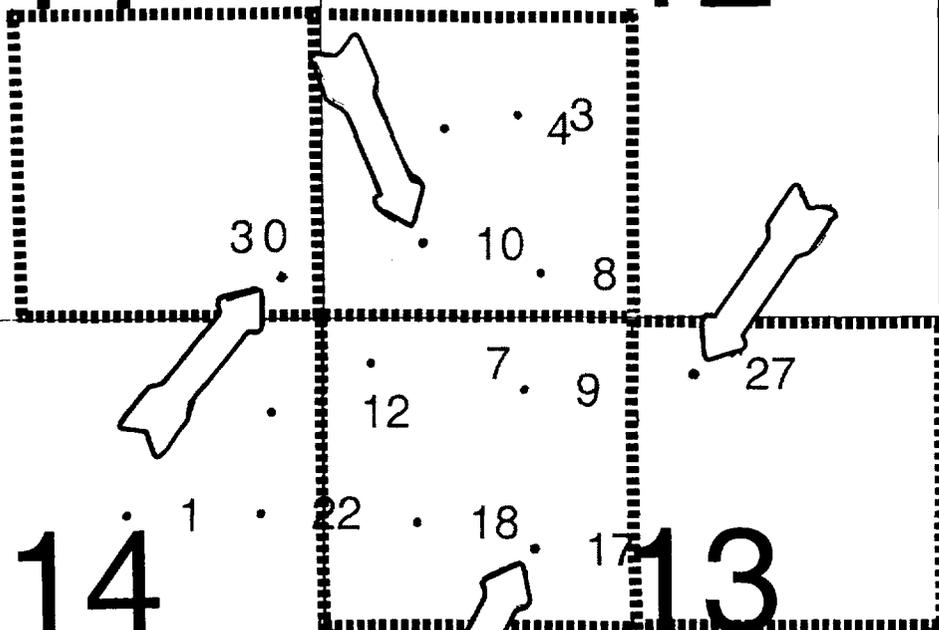

14

13

-R036E

• 5 • 6

22

24

**COMMISSIONER'S OFFICE**

Phone (505) 827-5760

Fax (505) 827-5766

**ADMINISTRATION**

Phone (505) 827-5700

Fax (505) 827-5853

**GENERAL COUNSEL**

Phone (505) 827-5713

Fax (505) 827-4262

**PUBLIC AFFAIRS**

Phone (505) 827-5765

Fax (505) 827-5766



PLC-166

**COMMERCIAL RESOURCES**

Phone (505) 827-5724

Fax (505) 827-6157

**MINERAL RESOURCES**

Phone (505) 827-5744

Fax (505) 827-4739

**ROYALTY MANAGEMENT**

Phone (505) 827-5772

Fax (505) 827-4739

**SURFACE RESOURCES**

Phone (505) 827-5793

Fax (505) 827-5711

**New Mexico State Land Office  
Commissioner of Public Lands  
Ray Powell, M.S., D.V.M.**

April 11, 2000

Chevron U.S.A. Production Company  
P. O. Box 1150  
Midland, Texas 79702

Attn: Ms. J. K. Ripley

Re: Surface Commingling Application  
Wildcat; Drinkard  
Monument 13 State # 17-F Sec. 13-19S-36E (E-7355-1)  
Monument 13 State # 27-B Sec. 13-19S-36E (B-1327-1)  
Monument 12 State # 10-M Sec. 12-19S-36E (B-1023-0)  
Monument 13 State # 29-L Sec. 13-19S-36E (B-10230-0)  
Monument Drinkard Tank Battery (F) Sec. 12-19S-36E  
Lea County, New Mexico

Dear Ms. Ripley:

We are in receipt of your letter of February 29, 2000. Your letter requests our approval to surface commingle the production from the above captioned wells at the Monument Drinkard Tank battery facility located in the SE/4NW/4 of Section 12, Township 19 South, Range 36 East.

It is our understanding that the production will be allocated to each lease by separately metering the production from each lease prior to commingling.

Since it appears that all the New Mexico Oil Conservation Division's rules and regulations have been complied with, and there will be no loss of revenue to the State of New Mexico as a result of your proposed operation, your request is hereby approved. Our approval is subject to like approval by the New Mexico Oil Conservation Division.

Please contact Ms. Debbie Padilla of our Right-of-Way Division at (505) 827-5729 for a right-of-way through Section 12, Township 19 South, Range 36 East. Our approval is contingent upon you acquiring the appropriate easements.

Your \$30.00 dollar filing fee has been received.

WE WARE FOR THE STATE

Chevron U.S.A. Production Company  
April 11, 2000  
Page 2

If you have any questions or if we may be of further help, please contact Pete Martinez at (505) 827-5791.

Very truly yours,

RAY POWELL, M.S., D.V.M.  
COMMISSIONER OF PUBLIC LANDS

BY: *Anthony H. Neal*

FOC

JAMI BAILEY, Director  
Oil, Gas and Minerals Division  
(505) 827-5744

RP/JB/pm

pc: Reader File

~~CCP Attention: David Catafano~~, Ben Stone,  
Debbie Padilla