


**AP - 007**

---

**STAGE 1 & 2  
WORKPLANS**

**DATE:**

**JAN. 2006**

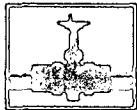

**PLAINS  
PIPELINE**

February 6, 2006

Mr. Ed Martin  
New Mexico Oil Conservation Division  
Environmental Bureau  
1220 South St. Francis Drive  
Santa Fe, New Mexico 87505

**Re:** Plains Pipeline Site Restoration Work Plan  
And Proposed Soil Closure Strategy  
Darr Angell #2 Release Site  
Section 14, Township 15 South, Range 37 East  
Lea County, New Mexico

Dear Mr. Martin:

Please find attached for your approval the Site Restoration Work Plan and Proposed Soil Closure Strategy, dated February 2006, for the Darr Angell #2 release site located in Section 14 of Township 15 South, and Range 37 East of Lea County, New Mexico. The Work Plan details site activities to be conducted for soil remediation.

Should you have any questions or comments, please contact me at (505) 441-0965.

Sincerely,

*Camille Reynolds*

Camille Reynolds  
Remediation Coordinator  
Plains All American Pipeline

Cc: Larry Johnson, NMOCD, Hobbs Office

Enclosure



# SITE RESTORATION WORK PLAN AND PROPOSED SOIL CLOSURE STRATEGY

## DARR ANGELL NO. 2 SITE

Lea County, New Mexico

SW  $\frac{1}{4}$  of the SE  $\frac{1}{4}$  of Section 11, Township 15 South, Range 37 East  
NW  $\frac{1}{4}$  of the NE  $\frac{1}{4}$  of Section 14, Township 15 South, Range 37 East

Latitude: North 33° 01' 47.0"

Longitude: West 103° 10' 10.7"

PLAINS EMS No.: LF-1999-62

NMOCD ID No.: AP-07





Prepared For:  
**Plains Marketing, L.P.**  
333 Clay Street, Suite 1600  
Houston, Texas 77002

Prepared By:  
**NOVA Safety and Environmental**  
2057 Commerce  
Midland, Texas 79703

## VOLUME #1

January 2006

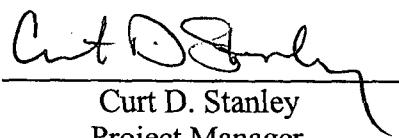  
\_\_\_\_\_  
Curt D. Stanley  
Project Manager

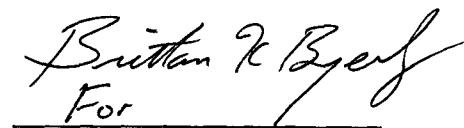  
\_\_\_\_\_  
Todd K. Choban  
Vice President, Technical Services

## **Table of Contents**

1.0	INTRODUCTION AND SITE BACKGROUND	1
2.0	SUMMARY OF FIELD ACTIVITIES	1
3.0	SOIL CLOSURE STRATEGY	2
4.0	CLOSURE REQUEST	2
5.0	QA/QC PROCEDURES	3
5.1	Soil Sampling	3
5.2	Decontamination of Equipment	3
5.3	Laboratory Protocol	3
6.0	LIMITATIONS	4
7.0	DISTRIBUTION	5

## **Figures**

- FIGURE 1: Site Location Map  
FIGURE 2: Site Map

## **Tables**

- TABLE 1: Concentrations of BTEX and TPH in Soil

## **Appendices**

- APPENDIX A: Soil Boring Logs  
Volume #2
- APPENDIX B: Laboratory Reports  
APPENDIX C: Release Notification and Corrective Action (Form C-141)

## **1.0 INTRODUCTION AND SITE BACKGROUND**

The site is located approximately 12.5 miles east of the town of Lovington, New Mexico south of State Highway 82 in the SW  $\frac{1}{4}$  of the SE  $\frac{1}{4}$  of Section 11, Township 15 South, Range 37 East and the NW  $\frac{1}{4}$  of the NE  $\frac{1}{4}$  of Section 14, Township 15 South and Range 37 East. More specifically at latitude 33° 01' 47.0" North and longitude 103° 10' 10.7" West. For reference, a site location map and a site map are provided as Figures 1 and 2, respectively. On July 29, 1999, EOTT Energy, LLC (EOTT) personnel discovered that a release of crude oil had occurred from its pipeline. The on-site crude release was attributed to structural failure due to external corrosion on the 8-inch steel pipeline operated by EOTT. The release was reported to the New Mexico Oil Conservation Division (NMOCD) on July 29, 1999. According to the EOTT Spill Reporting Form, approximately 60 barrels were released and none were recovered. The Darr Angell #2 crude oil release site, formerly the responsibility of EOTT and the Link Energy is now the responsibility of Plains Marketing, L.P.

## **2.0 SUMMARY OF FIELD ACTIVITIES**

On August 30, 1999, Environmental Technology Group, Inc. (ETGI) began initial site characterization activities, consisting of advancing 40 Geoprobe® sampling points within and adjacent to the surface stained area. In April and May 2000, the impacted soil identified during the Geoprobe® investigation was excavated by ETGI to a depth of approximately 4.5 feet bgs. Impacted soil was stockpiled on-site following the initial excavation activities. In June 2000, ETGI installed monitor wells MW-1 through MW-3, recovery wells RW-1 and RW-2 and advanced soil borings SB-1 through SB-10. In July 2000, ETGI installed monitor well MW-4. In April and May 2001, approximately 3,000 cubic yards (cy) of soil was excavated and added to the existing stockpiles. The soil and caliche generated from these excavation activities was screened and the caliche was segregated from the soil. The excavated soil was then shredded before being placed in a stockpile. In August 2001, ETGI installed monitor wells MW-5 through MW-9. On December 12, 2001, ETGI installed monitor well MW-10. In November and December 2002, ETGI installed recovery wells RW-4 through RW-7. Soil boring, monitor well and recovery well boring and completion logs are included in Appendix A.

On March 11, 2002, ETGI on behalf of EOTT requested permission from the NMOCD to partially backfill the excavation with excavated caliche segregated during previous screening activities. Authorization was granted by the NMOCD and the excavation was partially backfilled with this material.

On October 29, 2003, approximately 3,128 cy of soil removed during excavation activities was spread onto the soil treatment area. ETGI supervised the spreading of the stockpiled soil onto a soil treatment area utilizing a front-end loader and a dozer. The stockpiled soil was spread to an approximate depth of two to three feet.

On February 06, 2004, the soil treatment cell was divided into equal grid cells of approximately 250 cy per cell and a five-point composite soil sample was obtained from each cell. Ten composite samples were collected utilizing both a stainless steel sampling trowel and a hand auger from each cell. Each sample was split during acquisition into two pre-

labeled zip-lock baggies, one for field screening and the other stored on ice for laboratory analysis. All soil samples were submitted under a completed chain-of-custody to the Environmental Lab of Texas in Odessa, Texas and analyzed for TPH GRO/DRO concentrations utilizing EPA SW 846-8015M GRO/DRO.

Analytical results of the February 06, 2004 sampling event indicated total petroleum hydrocarbons (TPH) concentrations ranging from 287 to 1,030 mg/Kg total TPH. The average TPH concentration was 536 mg/Kg.

The soil treatment cell was mechanically tilled on a quarterly basis to aerate and enhance the remediation of the soil. On December 18, 2004, the soil treatment area was sampled and four (4) five-point composite soil samples were obtained. The samples were obtained utilizing both a stainless steel sampling trowel and a hand auger from each cell. Each sample was split during acquisition into two pre-labeled zip-lock baggies, one for field screening and the other stored on ice for laboratory analysis. All soil samples were submitted under a completed chain-of-custody to TraceAnalysis, Inc of Lubbock, Texas and analyzed for TPH GRO/DRO concentrations utilizing EPA SW 846-8015M GRO/DRO.

Analytical results of the December 18, 2004 sampling event indicated TPH concentrations ranging from <50 to 60.2 mg/Kg Total TPH. The analytical results indicate soil contained within the soil treatment cell at the Darr Angell #2 release site is below the NMOCD guidelines for TPH. The analytical table is included as Table 1 and laboratory results are included in Appendix B.

### **3.0 SOIL CLOSURE STRATEGY**

The analytical results of the December 18, 2004 treatment cell sampling event indicate TPH concentrations are below NMOCD guidelines of 100 mg/Kg TPH. Plains proposes to mobilize heavy equipment and utilize the remediated treatment cell soil to backfill the excavation. The soil will be placed in the excavations in twelve inch lifts and compacted. The topography will be graded to as near original contours as practical. The affected area will be reseeded with grass acceptable to the land owner.

### **4.0 CLOSURE REQUEST**

Plains is prepared to begin field activities and perform the corrective actions summarized in the Site Restoration Work Plan and Proposed Closure Strategy upon review and approval of the work plan by the NMOCD. Upon completion of the field activities summarized in this plan, Plains will submit a Soil Closure Report to the NMOCD, documenting the final topographic restoration activities. In this report, Plains will request that the NMOCD grant closure to soil issues at the site. A groundwater closure report will follow after eight successive quarterly groundwater sampling events have demonstrated that the hydrocarbon concentrations are below regulatory guidelines. The Notification of Release and Corrective Action (Form C-141) is included as Appendix C.

## **5.0 QA/QC PROCEDURES**

### **5.1 Soil Sampling**

Samples of subsurface soils were obtained during installation of the soil borings, monitor wells and recovery wells utilizing a split-spoon sampling tool. Representative soil samples were divided into two separate portions using clean, disposable gloves. The sample was split between two labeled zip-lock baggies. One baggie was sealed for headspace analysis using a PID calibrated to a 100-ppm isobutylene standard. Each screening sample was allowed to volatilize for approximately thirty minutes in the sunlight at ambient temperature prior to conducting the screening analysis.

The other portion of the soil sample was placed in a sterile glass container equipped with a Teflon-lined lid furnished by the laboratory. The container was filled to capacity to limit the amount of headspace present. Each container was labeled and placed on ice in an insulated cooler. Upon selection of samples for laboratory analysis, the cooler was sealed for shipment to the laboratory. Field screening samples and those samples not selected for shipment to the laboratory were emptied onto the existing on-site soil stockpiles awaiting treatment. Proper chain-of-custody documentation was maintained throughout the sampling and shipping process.

Soil samples were delivered to Environmental Lab of Texas, in Odessa, Texas and TraceAnalysis, Inc. of Lubbock, Texas and analyzed within fourteen days following the collection date for BTEX and TPH analyses using the methods described below:

- BTEX concentrations in accordance with EPA SW 846 Method 8021B/5030; and
- TPH concentrations in accordance with EPA SW 846 Method 8015M  
GRO/DRO.

### **5.2 Decontamination of Equipment**

In general, the decontamination procedure consisted of using high-pressure steam to wash the drilling and sampling equipment prior to drilling and prior to starting each hole. Prior to use, the sampling equipment was cleaned with Liqui-Nox® detergent and rinsed with distilled water.

### **5.3 Laboratory Protocol**

The laboratory was responsible for proper QA/QC procedures after signing the chain-of-custody form. These procedures were either transmitted with the laboratory reports or are on file at the laboratory.

## **6.0 LIMITATIONS**

NOVA Safety and Environmental has prepared this Site Restoration Work Plan and Proposed Soil Closure Strategy Report to the best of its ability. No other warranty, expressed or implied, is made or intended.


NOVA Safety and Environmental has examined and relied upon documents referenced in the report and has relied on oral statements made by certain individuals. NOVA Safety and Environmental has not conducted an independent examination of the facts contained in referenced materials and statements. We have presumed the genuineness of the documents and that the information provided in documents or statements is true and accurate. NOVA Safety and Environmental has prepared this report in a professional manner, using the degree of skill and care exercised by similar environmental consultants. NOVA Safety and Environmental notes that the facts and conditions referenced in this report may change over time and the conclusions and recommendations set forth herein are applicable only to the facts and conditions as described at the time of this report.

This report has been prepared for the benefit of Plains Marketing, L.P. The information contained in this report, including all exhibits and attachments, may not be used by any other party without the express consent of NOVA Safety and Environmental and/or Plains Marketing, L.P.

## **7.0 DISTRIBUTION**

- Copy 1: Ed Martin  
New Mexico Energy, Minerals and Natural Resources  
Oil Conservation Division  
1220 South St. Francis Drive  
Santa Fe, NM 87505
- Copy 2: Paul Sheeley and Larry Johnson  
New Mexico Energy, Minerals and Natural Resources  
Oil Conservation Division, District 1  
1625 North French Drive  
Hobbs, New Mexico 88240
- Copy 3: Camille Reynolds  
Plains Marketing, L.P.  
3112 Highway 82  
Lovington, New Mexico 88260  
[cjreynolds@paalp.com](mailto:cjreynolds@paalp.com)
- Copy 4: Jeff Dann  
Plains Marketing, L.P.  
333 Clay Street  
Suite 600  
Houston, Texas, 77002  
[jpdann@paalp.com](mailto:jpdann@paalp.com)
- Copy 5: NOVA Safety and Environmental  
2057 Commerce  
Midland, Texas 79703  
[cstanley@novatraining.cc](mailto:cstanley@novatraining.cc)

## Figures

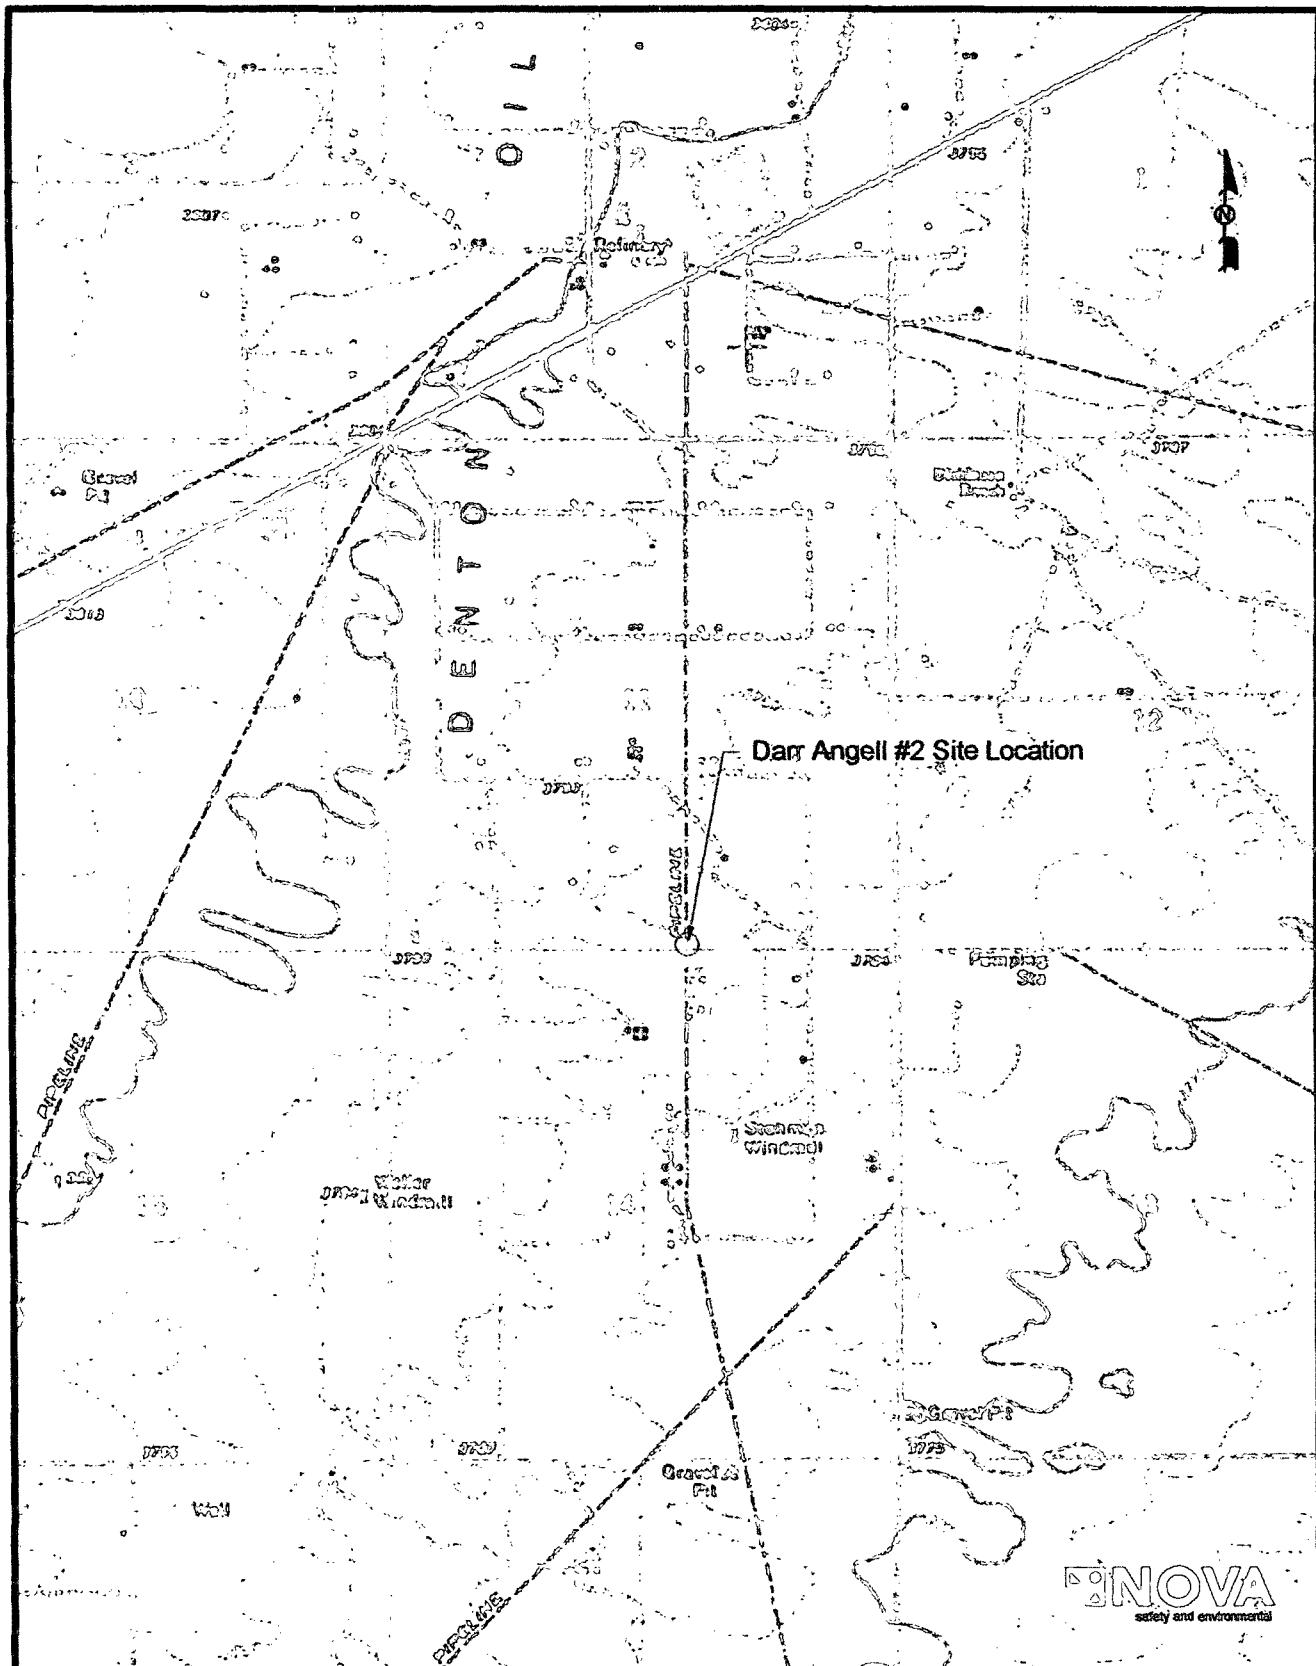

**Site Location**

33° 01' 47.0" N 103° 10' 10.5" W

SW 1/4 of SE1/4 of Sec 11 T15S R37E  
NW 1/4 of NE 1/4 of Sec 14 T15S R37E


**Figure 1**  
**Site Location Map**

Plains Marketing, L.P.  
Darr Angell #2  
Lea County, NM

**NOVA Safety and Environmental**

Scale: 1"=2000'	Prep By: CDS	Checked By: TKC
February 20, 2005		

**NOVA**  
safety and environmental

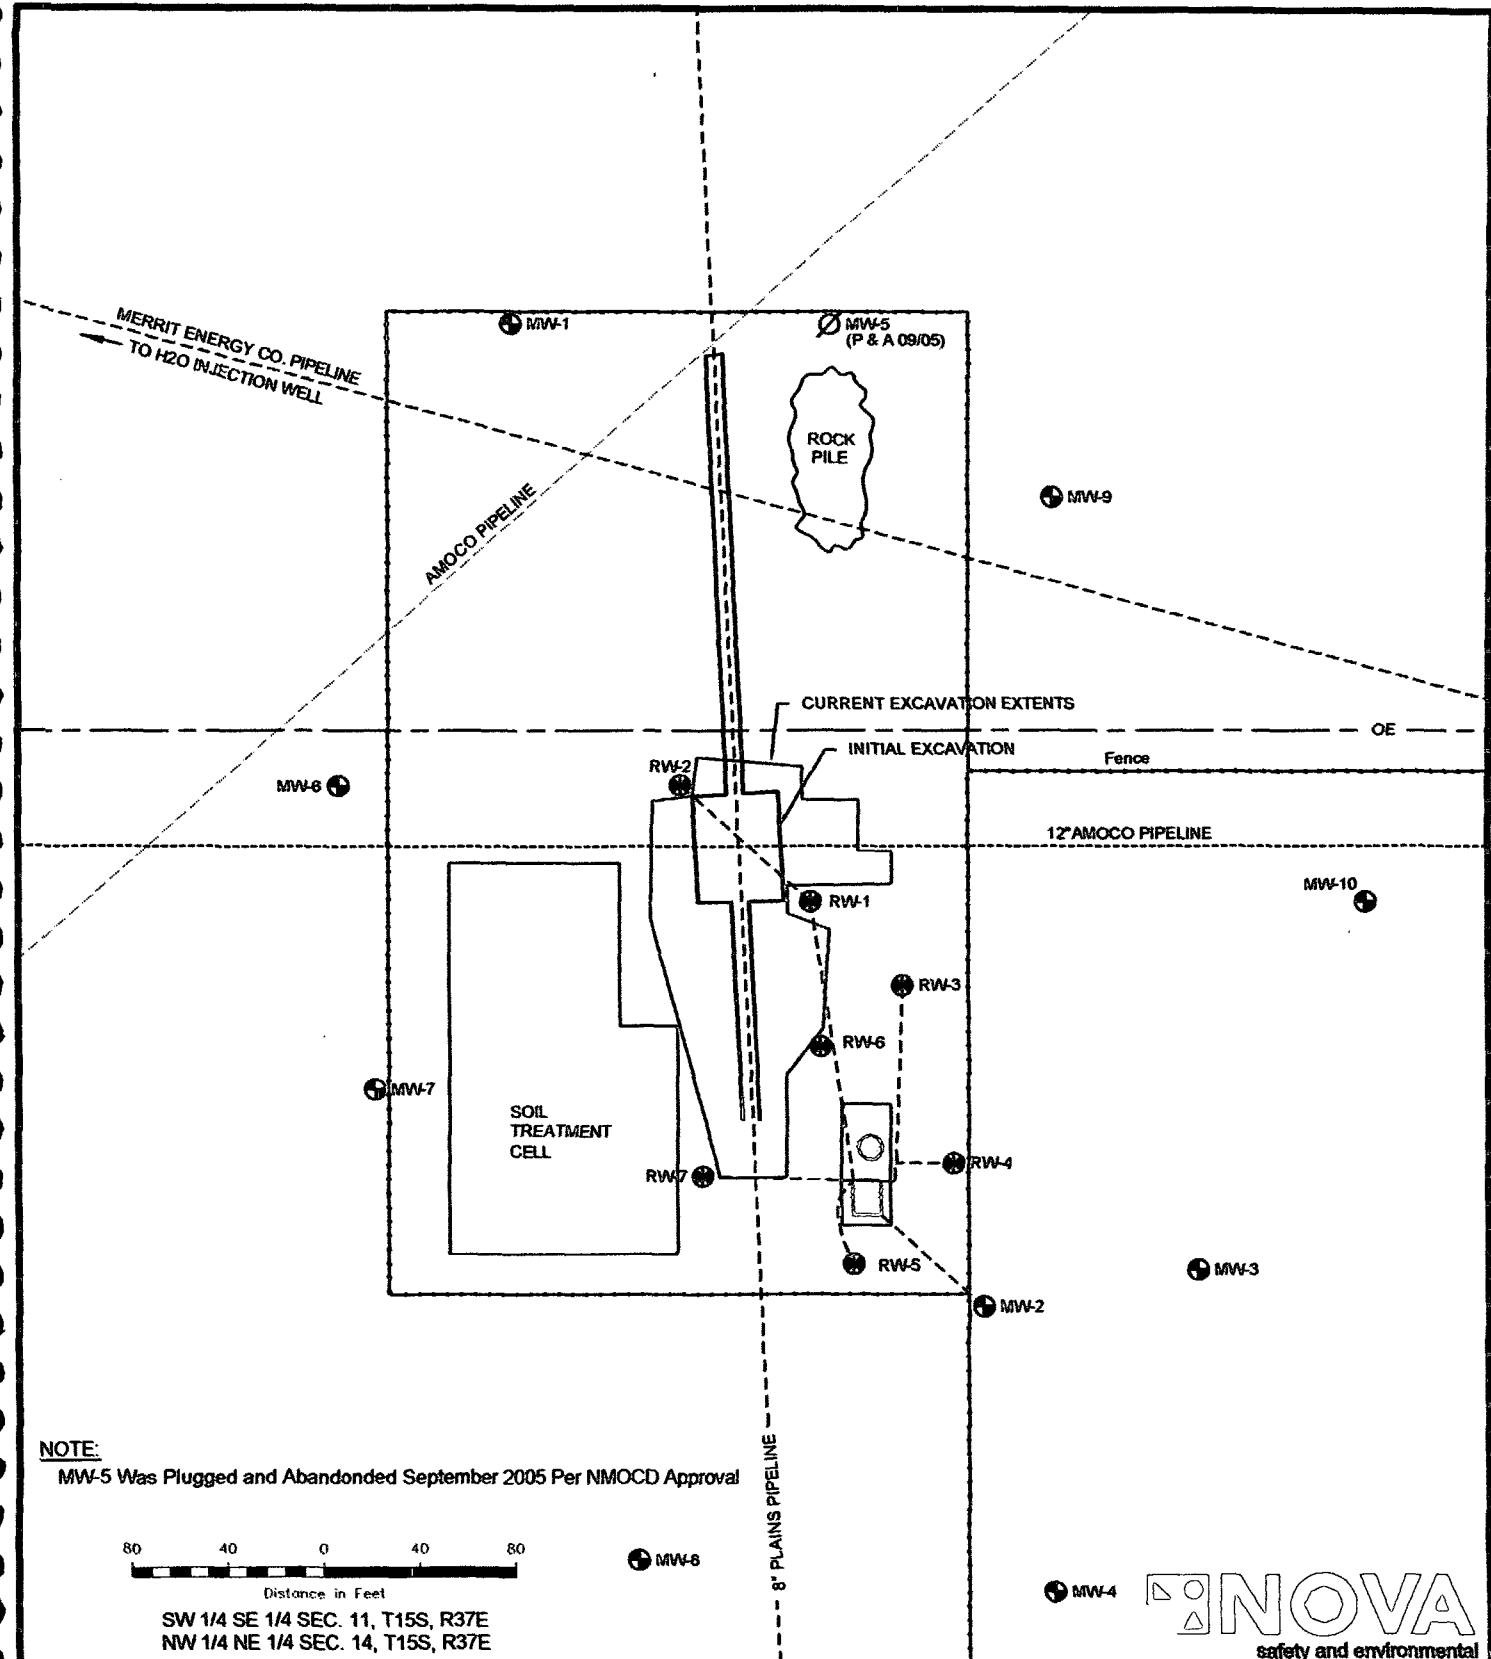

**Figure 2**  
Site Map  
Plains Marketing, L.P.  
Darr Angel # 2  
Lea County, NM

**NOVA Safety and Environmental**

Scale: 1"=80'	Prep By: DPM	Checked By: CDS
---------------	--------------	-----------------

September 21, 2005

**NOVA**  
safety and environmental

# Table

**TABLE 1**  
**CONCENTRATIONS OF BTEX AND TPH IN SOIL**

**PLAINS MARKETING, L.P.**  
**DARR ANGELL 2**  
**LEA COUNTY, NEW MEXICO**

*All concentrations are reported in mg/kg*

SAMPLE LOCATION	SAMPLE DATE	EPA SW 8746-8021B, 5030						EPA SW 846-8015M		
		BENZENE	TOLUENE	ETHYL-BENZENE	m,p-XYLENE	o-XYLENE	TOTAL BTEX	GRO (C <sub>6</sub> -C <sub>10</sub> )	DRO (>C <sub>10</sub> C <sub>25</sub> )	TOTAL TPH
<b>NMOC D REGULATORY LIMITS</b>		10 mg/Kg					50 mg/Kg			100 mg/Kg
NE of Source - 3' Deep	8/20/1999	<0.100	<0.100	4.82	40.92	14.82	<b>60.56</b>		4571	<b>4571</b>
SE of Source - 1 1/2' Deep		<0.100	<0.100	4.86	27.55	11.27	43.68		2170	<b>2170</b>
NW of Source - 2 1/2' Deep		<0.100	<0.100	8.82	37.55	17.66	<b>64.03</b>		5361	<b>5361</b>
SW of Source - 1 1/2' Deep		<0.100	0.332	0.179	0.431	<0.100	0.942		1884	<b>1884</b>
25' SE of Source - 1 1/2' Deep		<0.100	<0.100	0.229	1.01	<0.100	1.239		253	<b>253</b>
GP1-001	8/30/1999							3413	9468	<b>12881</b>
GP2-001								1967	6696	<b>8663</b>
GP3-001								<10	228	<b>228</b>
GP4-001								4737	10674	<b>15411</b>
GP5-001								<10	251	<b>251</b>
GP6-001								130	4647	<b>4777</b>
GP7-001								<10	241	<b>241</b>
GP8-001								3146	8294	<b>11440</b>
GP9-001								<10	176	<b>176</b>
GP10-001								445	7557	<b>8002</b>
GP11-001								<10	97	<b>97</b>
GP12-001								5802	16145	<b>21947</b>
GP13-001								2739	8058	<b>10797</b>
GP14-001								941	16284	<b>17225</b>
GP15-001								43	865	<b>908</b>
SS01 North Wall Pipeline 2'	5/17/2000	<0.100	0.122	<0.100	0.121	<0.100	0.243	<10	<10	<10
SS02 North Wall West 2'		<0.100	0.136	<0.100	0.147	0.112	0.395	594	13720	<b>14314</b>
SS03 North Wall East 2'		<0.100	<0.100	<0.100	<0.100	<0.100	<0.100	12	5284	<b>5296</b>
SS04 West Wall A. Pipeline 2'		<0.100	0.173	0.171	0.203	0.341	0.888	661	24538	<b>25199</b>
SS05 East Wall A. Pipeline 2'		<0.100	0.282	0.188	0.335	0.272	1.077	626	19579	<b>20205</b>
SS06 South Wall West 2'		<0.100	<0.100	<0.100	0.279	0.162	0.441	561	8977	<b>9538</b>
SS07 South Wall East 2'		<0.100	0.254	0.184	1.83	1.42	3.688	902	3656	<b>4558</b>
SS08 South Wall Pipeline 2'		<0.100	<0.100	<0.100	<0.100	<0.100	<0.100	<10	197	<b>197</b>
SS10 Stock Pile NW 1'		0.123	2.21	1.08	1.64	0.681	5.734	381	8749	<b>9130</b>
SS10 Stock Pile B NG 1'		<0.100	0.199	0.339	0.361	0.303	1.202	451	7743	<b>8194</b>
SS11 Stock Pile B SW 1'		<0.100	0.142	0.259	0.243	0.25	0.894	199	6863	<b>7062</b>
SS12 Stock Pile B SE 1'		<0.100	<0.100	0.467	0.371	0.353	1.191	243	7697	<b>7940</b>
SS13 Stock Pile A South 1'		<0.100	0.25	<0.100	0.164	<0.100	0.414	<10	933	<b>933</b>
SS14 Stock Pile A North 1'		<0.100	<0.100	<0.100	0.172	<0.100	0.172	<10	112	<b>112</b>
RW-1C 5'	6/1/2000	<0.100	1.77	0.836	5.34	0.965	8.911	60	823	<b>883</b>
RW-1SS 10'		<0.100	16.3	9.34	41.9	13.4	<b>80.94</b>	781	2257	<b>3038</b>
RW-1C 15'		<0.100	3.4	1.59	6.64	2.47	14.1	81	965	<b>1046</b>
RW-1SS 20'								<10	<10	<10
RW-1SS 25'								<10	<10	<10
RW-1SS 30'								<10	<10	<10
RW-1SS 35'								<10	<10	<10
RW-1SS 40'								<10	<10	<10
RW-1SS 45'								<10	<10	<10
RW-1SS 50'		<0.100	3.34	3.28	12.1	4.45	23.17	454	1264	<b>1718</b>
RW-1SS 55'		<b>29.9</b>	169	63.8	183	59.1	<b>504.8</b>	7092	10152	<b>17244</b>
RW-1SS 60'		<0.100	4.37	3.02	9.97	3.66	21.02	388	1227	<b>1615</b>
RW-2C 5'	6/1/2000	<0.100	11.1	4.76	19.3	8.12	43.28	910	2850	<b>3760</b>
RW-2C 10'		<0.100	5.54	2.99	11.9	4.43	24.86	515	2041	<b>2556</b>
RW-2C 15'		0.666	14.3	6.05	24.7	9.15	<b>54.866</b>	1456	4764	<b>6220</b>
RW-2C 20'		<0.100	5	2.95	12.2	4.65	24.8	563	2857	<b>3420</b>

**TABLE 1**  
**CONCENTRATIONS OF BTEX AND TPH IN SOIL**

**PLAINS MARKETING, L.P.**  
**DARR ANGELL 2**  
**LEA COUNTY, NEW MEXICO**

*All concentrations are reported in mg/kg*

SAMPLE LOCATION	SAMPLE DATE	EPA SW 8746-8021B, 5030						EPA SW 846-8015M		
		BENZENE	TOLUENE	ETHYL-BENZENE	m,p-XYLENE	o-XYLENE	TOTAL BTEX	GRO (C <sub>6</sub> -C <sub>10</sub> )	DRO (>C <sub>10</sub> C <sub>25</sub> )	TOTAL TPH
<b>NMOCD REGULATORY LIMITS</b>		10 mg/Kg					50 mg/Kg			100 mg/Kg
RW-2SS 25'	6/1/2000							<10	102	102
RW-2SS 30'								<10	<10	<10
RW-2SS 35'								<10	32	32
RW-2SS 40'								<10	<10	<10
RW-2SS 45'								<10	<10	<10
RW-2SS 50'								53	648	701
RW-2SS 55'		<0.100	4.9	3.6	8.06	4.2	20.76	916	3716	4632
RW-2SS 60'								12	285	297
RW-2SS 65'								<10	221	221
SB-1C 5'	6/2/2000							<10	<10	<10
SB-1C 10'								<10	<10	<10
SB-1C 15'								<10	<10	<10
SB-1C 20'								<10	<10	<10
SB-1SS 25'								<10	<10	<10
SB-1C 30'								<10	<10	<10
SB-1SS 35'								<10	<10	<10
SB-1SS 40'								<10	<10	<10
SB-1SS 45'								<10	<10	<10
SB-1SS 50'								<10	<10	<10
SB-1SS 55'								<10	<10	<10
SB-1SS 57'								<10	<10	<10
SB-2C 5'	6/5/2000							<10	<10	<10
SB-2C 10'								<10	<10	<10
SB-2SS 15'								<10	<10	<10
SB-2SS 20'								<10	<10	<10
SB-2SS 25'								<10	<10	<10
SB-2SS 30'								<10	<10	<10
SB-2SS 35'								<10	<10	<10
SB-2SS 40'								<10	<10	<10
SB-2SS 45'								<10	<10	<10
SB-2SS 50'								<10	<10	<10
SB-2SS 57'								<10	<10	<10
SB-3C 5'	6/5/2000							<10	<10	<10
SB-3C 10'								<10	<10	<10
SB-3C 15'								<10	<10	<10
SB-3C 20'								<10	<10	<10
SB-3C 25'								<10	<10	<10
SB-3C 30'								<10	<10	<10
SB-3C 35'								<10	<10	<10
SB-3C 40'								<10	<10	<10
SB-3C 45'								<10	<10	<10
SB-3C 50'								<10	<10	<10
SB-3C 60'								<10	<10	<10
SB-4C 5'	6/6/2000							<10	<10	<10
SB-4C 10'								<10	<10	<10
SB-4C 15'								<10	<10	<10
SB-5C 5'	6/6/2000							<10	<10	<10
SB-5C 10'								<10	<10	<10
SB-5C 15'								<10	<10	<10

TABLE 1  
CONCENTRATIONS OF BTEX AND TPH IN SOIL

PLAINS MARKETING, L.P.  
DARR ANGELL 2  
LEA COUNTY, NEW MEXICO

*All concentrations are reported in mg/kg*

SAMPLE LOCATION	SAMPLE DATE	EPA SW 8746-8021B, 5030						EPA SW 846-8015M		
		BENZENE	TOLUENE	ETHYL-BENZENE	m,p-XYLENE	o-XYLENE	TOTAL BTEX	GRO (C <sub>6</sub> -C <sub>10</sub> )	DRO (>C <sub>10</sub> C <sub>25</sub> )	TOTAL TPH
NMOCD REGULATORY LIMITS	10 mg/Kg						50 mg/Kg			100 mg/Kg
SB-6C 5'	6/6/2000							<10	<10	<10
SB-6C 10'								<10	<10	<10
SB-6C 15'								<10	<10	<10
SB-7C 5'	6/6/2000							<10	<10	<10
SB-7C 10'								<10	<10	<10
SB-7C 15'								<10	<10	<10
SB-8C 5'	6/6/2000							<10	<10	<10
SB-8C 10'								<10	<10	<10
SB-8C 15'								<10	<10	<10
SB-9C 5'	6/6/2000							<10	<10	<10
SB-9C 10'								<10	<10	<10
SB-9C 15'								<10	<10	<10
SB-10C 5'	6/6/2000							<10	<10	<10
SB-10C 10'								<10	<10	<10
SB-10C 15'								<10	<10	<10
MW-1C 5'	6/6/2000							<10	<10	<10
MW-1C 10'								<10	<10	<10
MW-1C 15'								<10	<10	<10
MW-1C 20'								<10	<10	<10
MW-1SS 25'								<10	<10	<10
MW-1SS 30'								<10	<10	<10
MW-1SS 35'								<10	<10	<10
MW-1SS 40'								<10	<10	<10
MW-1SS 45'								<10	<10	<10
MW-1SS 52'								<10	<10	<10
MW-1C 65'								<10	<10	<10
MW-2C 5'	6/16/2000							<10	<10	<10
MW-2C 10'								<10	<10	<10
MW-2C 15'								<10	<10	<10
MW-2C 20'								<10	<10	<10
MW-2C 25'								<10	<10	<10
MW-2C 30'								<10	<10	<10
MW-2C 35'								<10	<10	<10
MW-2C 40'								<10	<10	<10
MW-2C 45'								<10	<10	<10
MW-2C 50'								<10	<10	<10
MW-2C 55'	<0.100	0.724	<0.100	1.27	0.318	2.312	15	2251	2266	
MW-2C 65'								<10	229	229
MW-3C 5'	6/16/2000							<10	<10	<10
MW-3C 10'								<10	<10	<10
MW-3C 15'								<10	<10	<10
MW-3C 20'								<10	<10	<10
MW-3C 25'								<10	<10	<10
MW-3C 30'								<10	<10	<10
MW-3C 35'								<10	<10	<10
MW-3C 40'								<10	<10	<10

**TABLE 1**  
**CONCENTRATIONS OF BTEX AND TPH IN SOIL**

**PLAINS MARKETING, L.P.**  
**DARR ANGELL 2**  
**LEA COUNTY, NEW MEXICO**

*All concentrations are reported in mg/kg*

SAMPLE LOCATION	SAMPLE DATE	EPA SW 8746-8021B, 5030						EPA SW 846-8015M		
		BENZENE	TOLUENE	ETHYL-BENZENE	m,p-XYLENE	o-XYLENE	TOTAL BTEX	GRO (C <sub>6</sub> -C <sub>10</sub> )	DRO (>C <sub>10</sub> C <sub>25</sub> )	TOTAL TPH
NMOCD REGULATORY LIMITS	10 mg/Kg						50 mg/Kg			100 mg/Kg
MW-3C 45'	6/16/2000							<10	<10	<10
MW-3C 50'								<10	<10	<10
MW-3C 55'								<10	<10	<10
MW-3C 65'								<10	<10	<10
MW-4 0-2'	7/11/2000							<10	<10	<10
MW-4 3-5'								<10	<10	<10
MW-4 8-10'								<10	<10	<10
MW-4 13-15'								<10	<10	<10
MW-4 18-20'								<10	<10	<10
MW-4 23-25'								<10	<10	<10
MW-4 28-30'								<10	<10	<10
MW-4 33-35'								<10	<10	<10
MW-4 38-40'								<10	<10	<10
MW-4 43-45'								<10	<10	<10
MW-4 48-50'								<10	<10	<10
MW-4 53-55'								<10	<10	<10
MW-4 58-60'								<10	<10	<10
MW-5 0-2'	8/14/2001							<5	5.79	5.79
MW-5 5-7'								<5	10.1	10.1
MW-5 10-12'								<5	5.68	5.68
MW-5 15-17'								<5	5.85	5.85
MW-5 20-22'								<5	5.34	5.34
MW-5 25-27'								<5	2.11	2.11
MW-5 30-32'								<5	8.1	8.1
MW-5 35-37'								<5	5.23	5.23
MW-5 40-42'								<5	4.78	4.78
MW-5 45-47'								<5	<1	<5
MW-5 50-52'								<5	<1	<5
MW-5 55-57'								<5	10.8	10.8
MW-5 60-62'								<5	8.61	8.61
MW-5 65-67'								<5	8.91	8.91
MW-6 0-2'	8/15/2001							<5	<1	<5
MW-6 5-7'								<5	2.67	2.67
MW-6 10-12'								<5	8.92	8.92
MW-6 15-17'								<5	10.1	10.1
MW-6 20-22'								<5	4	4
MW-6 25-27'								<5	6.41	6.41
MW-6 30-32'								<5	6.34	6.34
MW-6 35-37'								<5	33	33
MW-6 40-42'								10.2	167	177.2
MW-6 45-47'								18.5	194	212.5
MW-6 50-52'								<5	13.8	13.8
MW-6 55-57'								<5	5.68	5.68
MW-6 60-62'								<5	6.12	6.12
MW-7 0-2'	8/16/2001							<5	<1	<5
MW-7 5-7'								<5	2.58	2.58
MW-7 10-12'								<5	2.65	2.65
MW-7 15-17'								<5	2.9	2.9
MW-7 20-22'								<5	2.58	2.58
MW-7 25-27'								<5	1.39	1.39

**TABLE 1**  
**CONCENTRATIONS OF BTEX AND TPH IN SOIL**

PLAINS MARKETING, L.P.  
DARR ANGELL 2  
LEA COUNTY, NEW MEXICO

*All concentrations are reported in mg/kg*

SAMPLE LOCATION	SAMPLE DATE	EPA SW 8746-8021B, 5030						EPA SW 846-8015M		
		BENZENE	TOLUENE	ETHYL-BENZENE	m,p-XYLENE	o-XYLENE	TOTAL BTEX	GRO (C <sub>6</sub> -C <sub>10</sub> )	DRO (>C <sub>10</sub> C <sub>25</sub> )	TOTAL TPH
NMOCD REGULATORY LIMITS	10 mg/Kg						50 mg/Kg			100 mg/Kg
MW-7 30-32'	8/16/2001							<5	2.04	2.04
MW-7 35-37'								<5	5.83	5.83
MW-7 40-42'								<5	4.68	4.68
MW-7 45-47'								<5	4.45	4.45
MW-7 50-52'								<5	8.32	8.32
MW-7 55-57'								<5	<1	<5
MW-7 60-62'								<5	5.86	5.86
MW-8 0-2'	8/16/2001							<5	14.5	14.5
MW-8 5-7'								<5	3.57	3.57
MW-8 10-12'								<5	10.9	10.9
MW-8 15-17'								<5	4.25	4.25
MW-8 20-22'								<5	3.69	3.69
MW-8 25-27'								<5	3.99	3.99
MW-8 30-32'								<5	4.09	4.09
MW-8 35-37'								<5	11.5	11.5
MW-8 40-42'								<5	3.11	3.11
MW-8 45-47'								<5	3.32	3.32
MW-8 50-52'								<5	2.82	2.82
MW-8 55-57'								<5	6.53	6.53
MW-8 60-62'								<5	8.12	8.12
MW-9 0-2'	8/16/2001							<5	<1	<5
MW-9 5-7'								<5	3.62	3.61
MW-9 10-12'								<5	7.28	7.28
MW-9 15-17'								<5	6.19	6.19
MW-9 20-22'								<5	6.73	6.73
MW-9 20-27'								<5	4.46	4.46
MW-9 30-32'								<5	4.81	4.81
MW-9 35-37'								<5	3.79	3.79
MW-9 40-42'								<5	1.92	1.92
MW-9 45-47'								<5	5.24	5.24
MW-9 50-52'								<5	2.5	2.5
MW-9 55-57'								<5	3.57	3.57
MW-9 60-62'								<5	9.33	9.33
MW-10 5-7'	12/12/2001							<5	<5	<5
MW-10 10-12'								<5	<5	<5
MW-10 15-17'								<5	<5	<5
MW-10 20-22'								<5	<5	<5
MW-10 25-27'								<5	<5	<5
MW-10 30-32'								<5	<5	<5
MW-10 35-37'								<5	<5	<5
MW-10 40-42'								<5	<5	<5
MW-10 45-47'								<5	<5	<5
MW-10 50-52'								<5	<5	<5
MW-10 55-57'								<5	<5	<5
MW-10 60-62'								<5	<5	<5
MW-10 65-67'								<5	<5	<5
North Wall -1	3/12/2002							<10	<10	<10
North West Wall -2								<10	<10	<10
Far SW Wall -7								<10	107	107
South West Wall -8								<10	<10	<10

TABLE 1  
CONCENTRATIONS OF BTEX AND TPH IN SOIL

PLAINS MARKETING, L.P.  
DARR ANGELL 2  
LEA COUNTY, NEW MEXICO

*All concentrations are reported in mg/kg*

SAMPLE LOCATION	SAMPLE DATE	EPA SW 8746-8021B, 5030						EPA SW 846-8015M		
		BENZENE	TOLUENE	ETHYL-BENZENE	m,p-XYLENE	o-XYLENE	TOTAL BTEX	GRO (C <sub>6</sub> -C <sub>10</sub> )	DRO (>C <sub>10</sub> C <sub>25</sub> )	TOTAL TPH
<b>NMOCD REGULATORY LIMITS</b>		10 mg/Kg					50 mg/Kg			100 mg/Kg
West Wall -9	3/12/2002							<10	61.9	61.9
RW-3 Surface	11/26/2002	<0.025	<0.025	<0.025	<0.025	<0.025	<0.025	<10.0	<10.0	<10.0
RW-3 10'		<0.025	<0.025	<0.025	<0.025	<0.025	<0.025	<10.0	<10.0	<10.0
RW-3 20'		<0.025	<0.025	<0.025	<0.025	<0.025	<0.025	<10.0	<10.0	<10.0
RW-3 30'		<0.025	<0.025	<0.025	<0.025	<0.025	<0.025	<10.0	<10.0	<10.0
RW-3 40'		<0.025	<0.025	<0.025	0.087	<0.025	0.087	<10.0	<10.0	<10.0
RW-3 50'		<0.025	<0.025	<0.025	<0.025	<0.025	<0.025	<10.0	17	17
RW-3 58'		9.7	36.6	23.6	53.8	19.5	<b>143.2</b>	3550	7940	<b>11490</b>
RW-3 63'		<0.025	0.05	0.075	0.226	0.046	0.397	60.4	552	<b>612.4</b>
RW-4 Surface	11/26/2002	<0.025	<0.025	<0.025	<0.025	<0.025	<0.025	<10.0	<10.0	<10.0
RW-4 10'		<0.025	<0.025	<0.025	<0.025	<0.025	<0.025	<10.0	<10.0	<10.0
RW-4 20'		<0.025	<0.025	<0.025	<0.025	<0.025	<0.025	<10.0	<10.0	<10.0
RW-4 30'		<0.025	<0.025	<0.025	<0.025	<0.025	<0.025	<10.0	<10.0	<10.0
RW-4 40'		<0.025	<0.025	<0.025	<0.025	<0.025	<0.025	<10.0	<10.0	<10.0
RW-4 50'		<0.025	0.054	0.065	0.34	0.084	0.543	59.9	446	<b>506</b>
RW-4 58'		<b>12.1</b>	44.4	27.2	62.8	23.2	<b>169.7</b>	3780	8340	<b>12120</b>
RW-4 63'		0.025	0.056	0.052	0.232	<0.025	0.365	<10.0	84.2	84.2
RW-5 Surface	11/27/2002	<0.025	<0.025	<0.025	<0.025	<0.025	<0.025	<10.0	<10.0	<10.0
RW-5 10'		<0.025	<0.025	<0.025	<0.025	<0.025	<0.025	<10.0	40.2	40.2
RW-5 20'		<0.025	0.08	0.036	0.196	<0.025	0.312	<10.0	<10.0	<10.0
RW-5 30'		<0.025	<0.025	<0.025	<0.025	<0.025	<0.025	<10.0	<10.0	<10.0
RW-5 40'		<0.025	<0.025	<0.025	<0.025	<0.025	<0.025	<10.0	<10.0	<10.0
RW-5 50'		<0.025	<0.025	<0.025	<0.025	<0.025	<0.025	<10.0	<10.0	<10.0
RW-5 57'		<b>12.6</b>	61.5	40.4	96.2	32.8	<b>243.5</b>	3750	6160	<b>9910</b>
RW-5 62'		0.046	0.09	0.072	0.247	0.061	0.516	55.4	635	<b>690.4</b>
RW-6 Surface	11/27/2002	<0.025	<0.025	<0.025	<0.025	<0.025	<0.025	<10.0	<10.0	<10.0
RW-6 10'		<0.025	<0.025	<0.025	<0.025	<0.025	<0.025	<10.0	<10.0	<10.0
RW-6 20'		<0.025	<0.025	<0.025	<0.025	<0.025	<0.025	<10.0	<10.0	<10.0
RW-6 30'		<0.025	<0.025	<0.025	<0.025	<0.025	<0.025	<10.0	<10.0	<10.0
RW-6 40'		<0.025	<0.025	<0.025	<0.025	<0.025	<0.025	<10.0	<10.0	<10.0
RW-6 50'		<0.025	<0.025	<0.025	<0.025	<0.025	<0.025	20.5	318	<b>338.5</b>
RW-6 57'		<b>47.8</b>	180	103	226	79.8	<b>636.6</b>	14100	22600	<b>36700</b>
RW-6 62'		0.037	0.118	0.243	0.75	0.15	1.298	119	818	<b>937</b>
RW-7 Surface	12/2/2002	<0.025	<0.025	<0.025	<0.025	<0.025	<0.025	<10.0	<10.0	<10.0
RW-7 10'		<0.025	<0.025	<0.025	<0.025	<0.025	<0.025	<10.0	<10.0	<10.0
RW-7 20'		<0.025	<0.025	<0.025	<0.025	<0.025	<0.025	<10.0	<10.0	<10.0
RW-7 30'		<0.025	<0.025	<0.025	<0.025	<0.025	<0.025	<10.0	<10.0	<10.0
RW-7 40'		<0.025	<0.025	<0.025	<0.025	<0.025	<0.025	75	75	
RW-7 50'		<0.025	<0.025	<0.025	<0.025	<0.025	<0.025	<10.0	18.2	18.2
RW-7 57'		17.4	73.3	47.2	110	41.1	<b>289</b>	4600	8320	<b>12920</b>
RW-7 62'		<0.025	0.049	0.034	0.108	<0.025	0.191	<10.0	153	<b>153</b>
SB-11 Surface	12/2/2002	<0.025	<0.025	<0.025	0.034	<0.025	0.034	<10.0	<10.0	<10.0
SB-11 10'		<0.025	0.098	<0.025	0.286	<0.025	0.384	<10.0	<10.0	<10.0
SB-11 20'		<0.025	0.038	<0.025	0.055	<0.025	0.093	<10.0	<10.0	<10.0
SB-11 30'		<0.025	<0.025	<0.025	<0.025	<0.025	<0.025	<10.0	<10.0	<10.0
SB-11 40'		<0.025	<0.025	<0.025	<0.025	<0.025	<0.025	<10.0	<10.0	<10.0
SB-11 50'		<0.025	<0.025	<0.025	<0.025	<0.025	<0.025	<10.0	<10.0	<10.0

**TABLE 1**  
**CONCENTRATIONS OF BTEX AND TPH IN SOIL**

**PLAINS MARKETING, L.P.**  
**DARR ANGELL 2**  
**LEA COUNTY, NEW MEXICO**


*All concentrations are reported in mg/kg*

SAMPLE LOCATION	SAMPLE DATE	EPA SW 8746-8021B, 5030						EPA SW 846-8015M		
		BENZENE	TOLUENE	ETHYL-BENZENE	m,p-XYLENE	o-XYLENE	TOTAL BTEX	GRO (C <sub>6</sub> -C <sub>10</sub> )	DRO (>C <sub>10</sub> C <sub>25</sub> )	TOTAL TPH
<b>NMOCRD REGULATORY LIMITS</b>		10 mg/Kg					50 mg/Kg			100 mg/Kg
SB-11 58'	12/2/2002	<0.025	<0.025	<0.025	<0.025	<0.025	<0.025	<10.0	<10.0	<10.0
SB-11 63'		<0.025	<0.025	<0.025	<0.025	<0.025	<0.025	<10.0	<10.0	<10.0
Soil Treatment Cell Sample Results										
Section 1	2/6/2004							13.9	273	287
Section 2								<10	473	473
Section 3								73.5	960	1030
Section 4								13.8	212	226
Section 5								20.2	453	473
Section 6								<10	395	395
Section 7								18.3	426	444
Section 8								33.7	772	806
Section 9								13.6	767	781
Section 10								<10	453	453
SS-1	12/18/2004							<5	60.2	60.2
SS-2								<5	58.4	58.4
SS-3								<5	53.3	53.3
SS-4								<1	<50	<50

## Appendices

Appendix A  
Soil Boring Logs

## Monitoring Well MW - 1

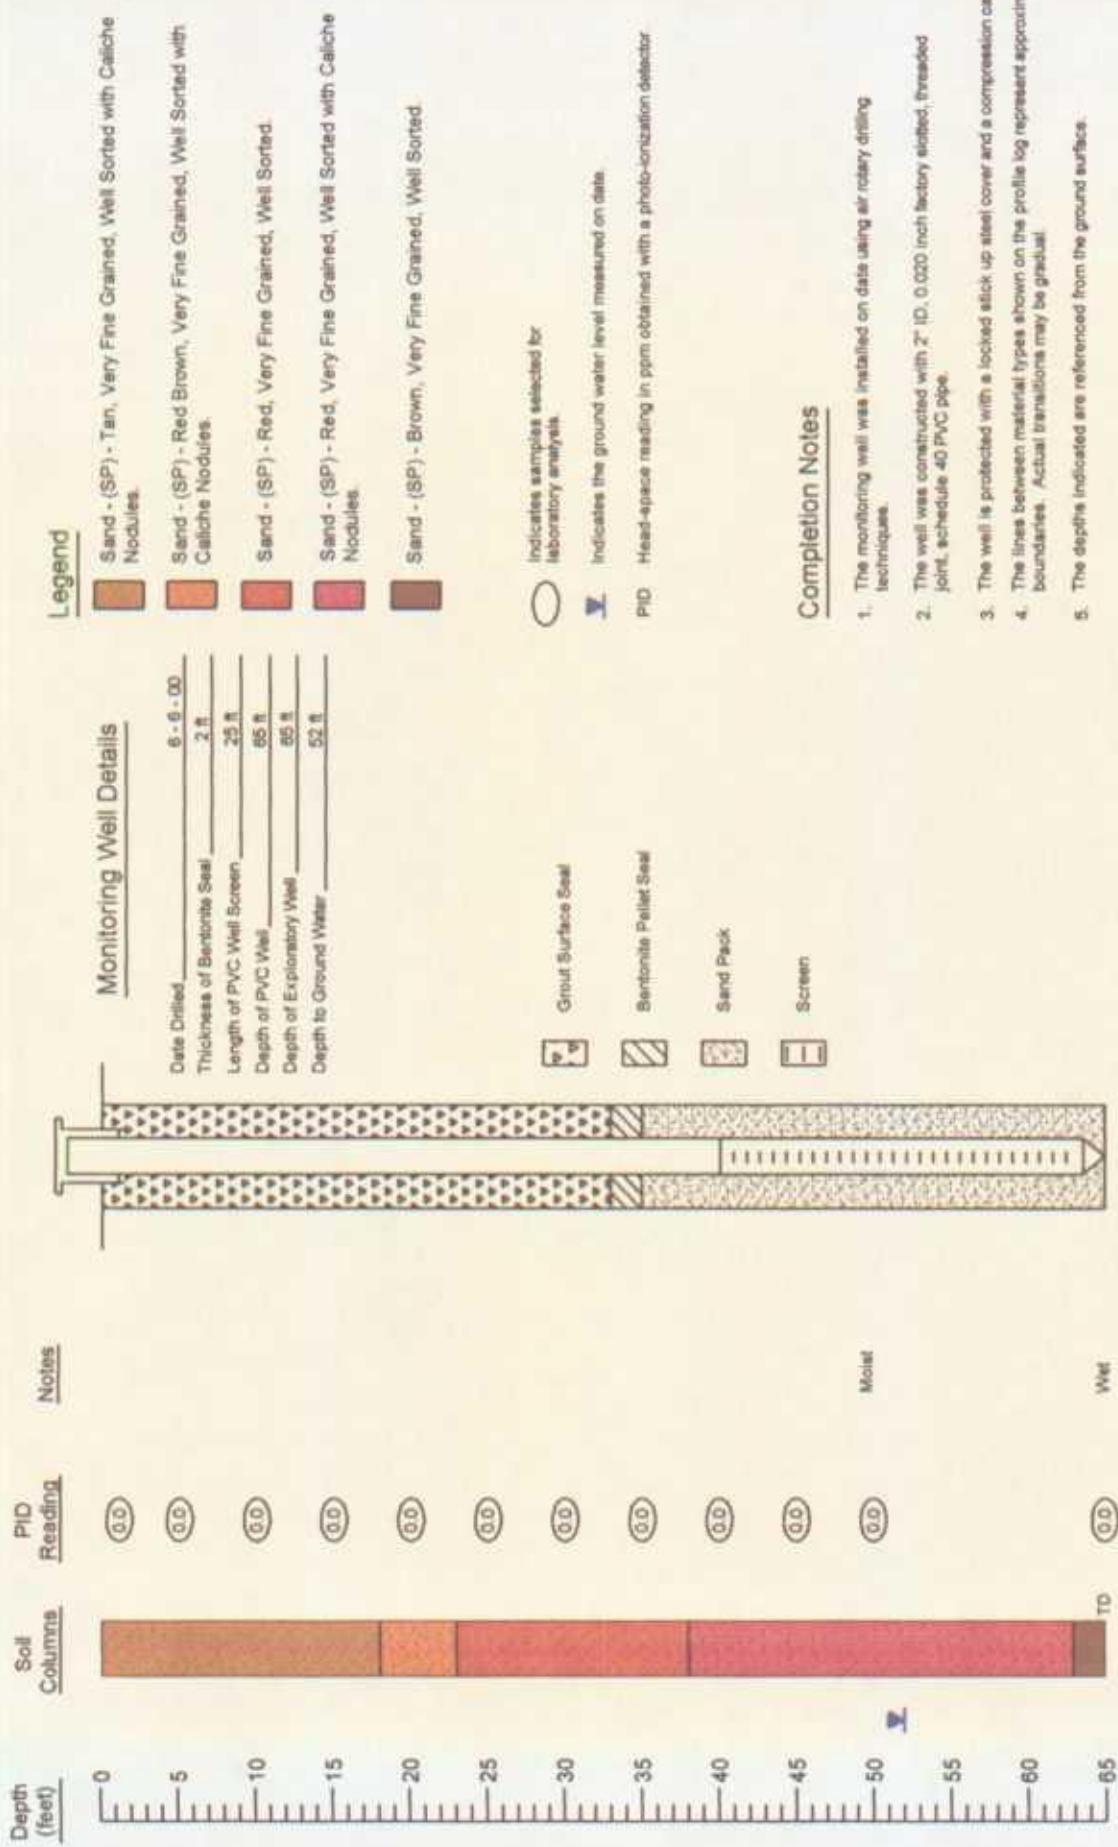

## Boring Log And Monitoring Well Details

### Monitoring Well - 1


Plains Pipeline, L.P. Darr Angell #2 Lea County, NM

## NOVA Safety and Environmental



Facility Use Permit Prep By: JG Checked By: JT  
July 14, 2000

## Monitoring Well MW - 2

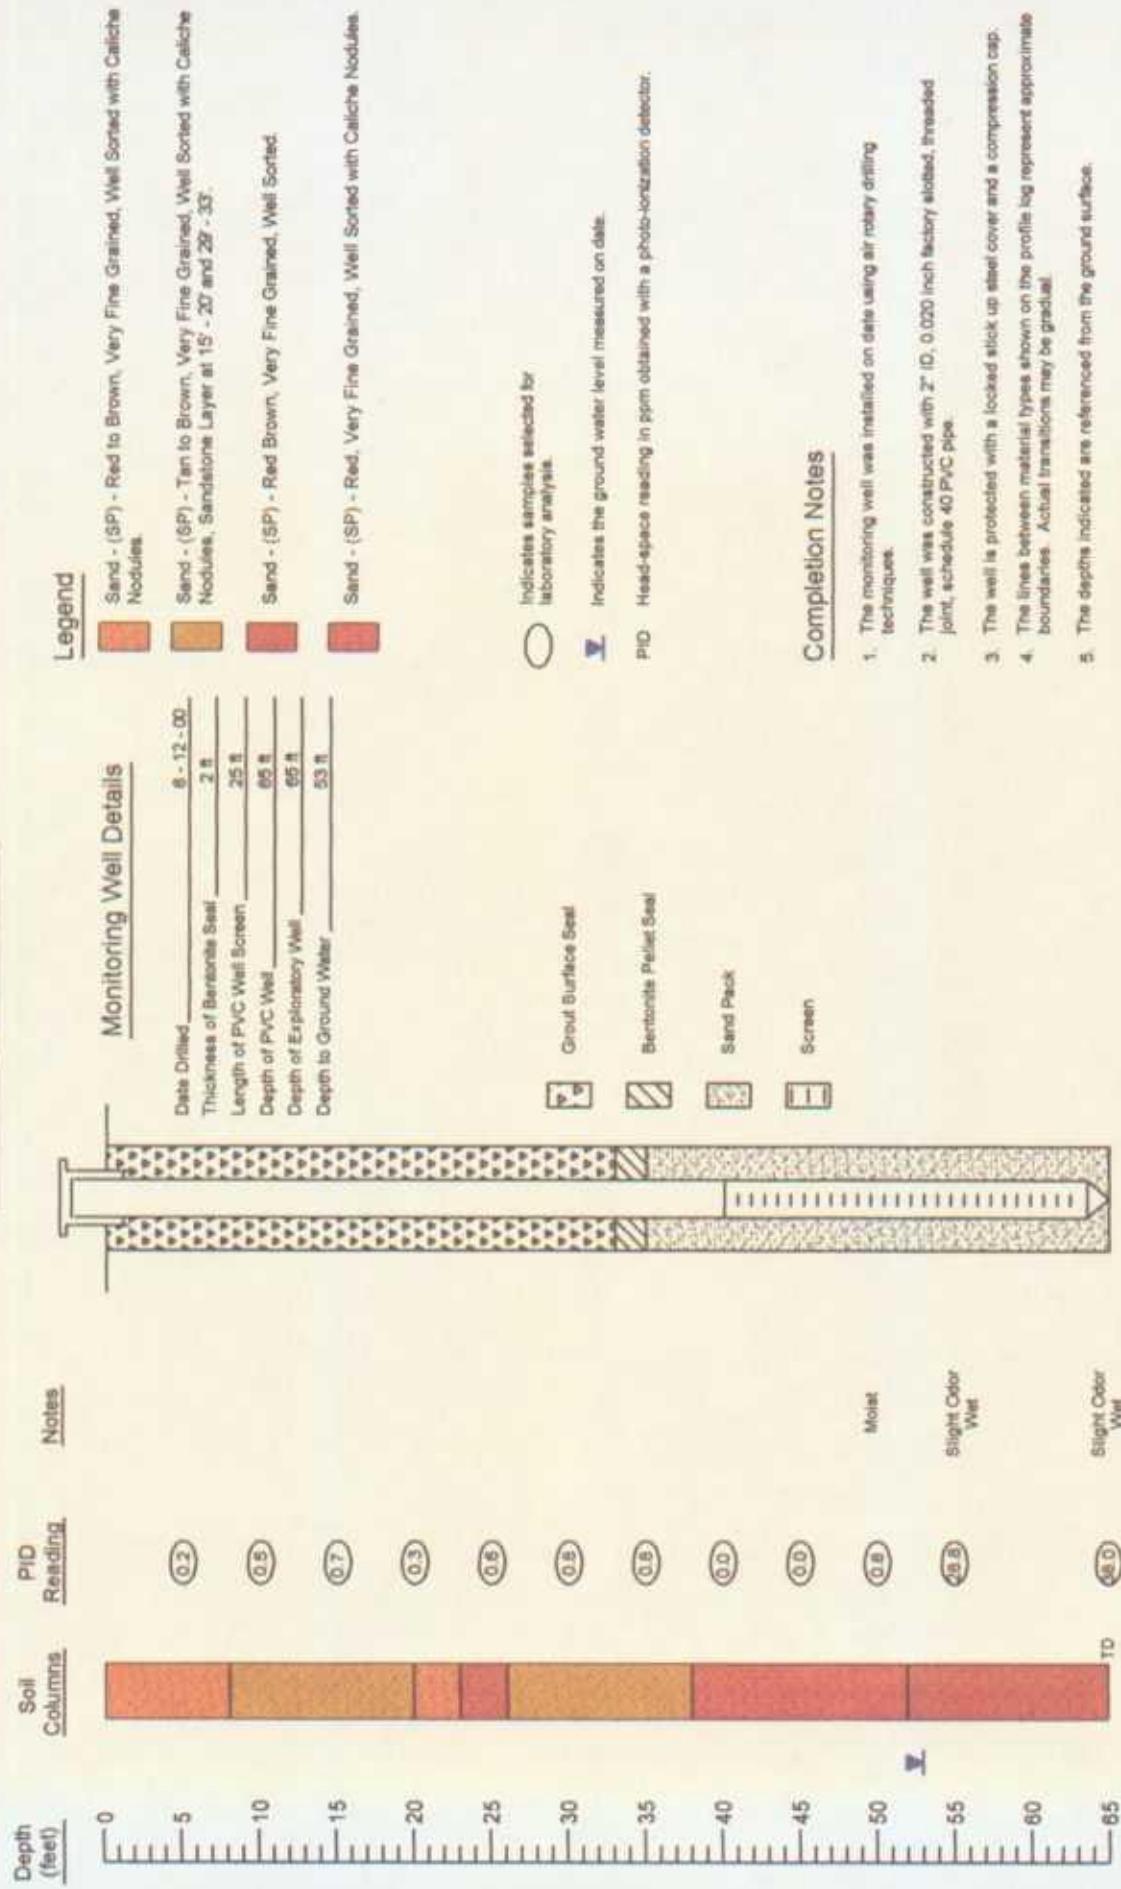

## Boring Log And Monitoring Well/Recovery Well Details

### Monitoring Well - 2


Plains Pipeline, L.P. Darr Angell #2 Lea County, NM

## NOVA Safety and Environmental



Soil Core Analysis	Print By: JCU	Checked By: JT
July 14, 2000		

## Monitoring Well MW - 3

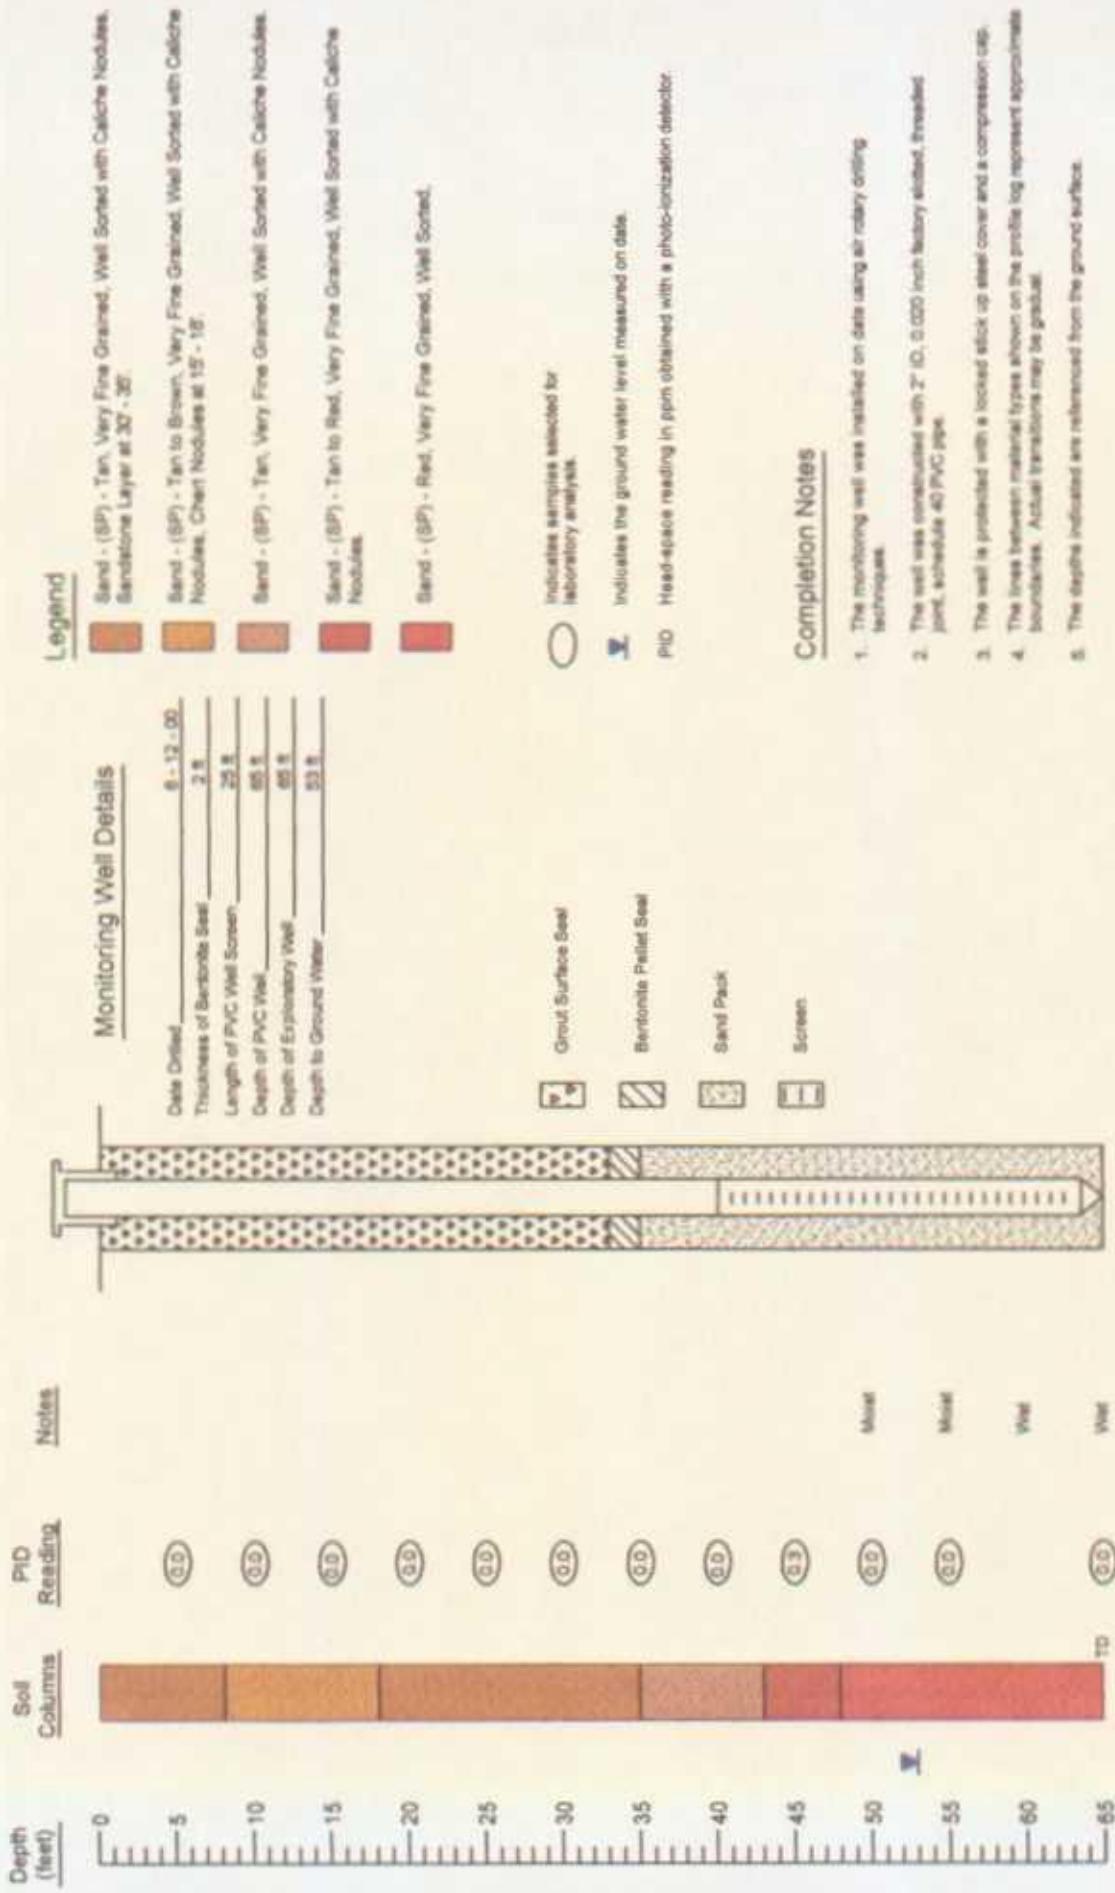


## NOVA Safety and Environmental



Plains Pipeline, L.P. Darr Angell #2 Lea County, NM

State/ City/ State	Prep By / DU	Checked By / JT
July 14, 2000		

## Monitoring Well MW - 4

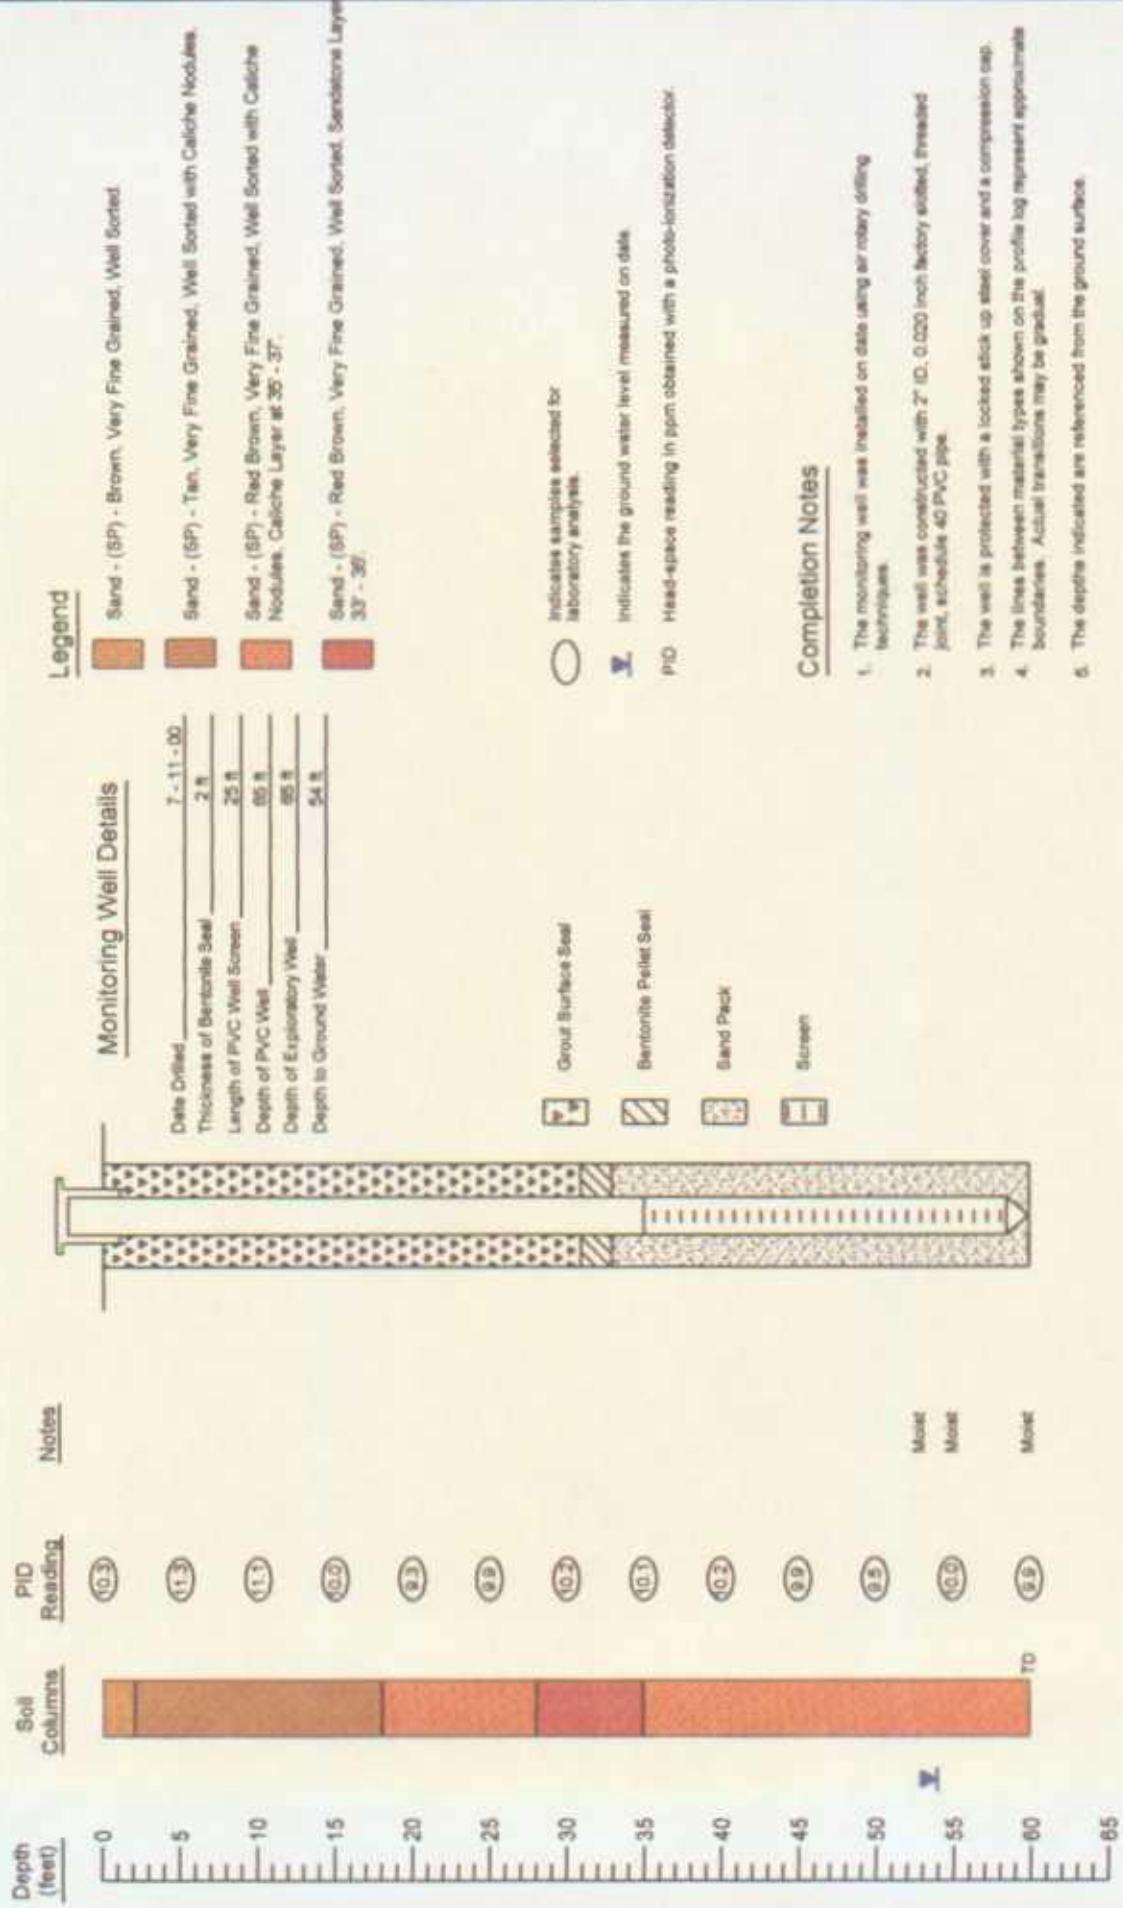

## Boring Log And Monitoring Well

### Monitoring Well - 4

Plains Pipeline, L.P. Darr Angell #2 Lea County, NM



## NOVA Safety and Environmental

Blanks can issue Prep By / Due Checked By / IT

July 25, 2000

Monitoring Well MW - 5

**Legend**

**Monitoring Well Details**

Depth (feet)	PID	Reading	Notes
0	(D)	60	
5	(D)	60	
10	(D)	60	
**Completion Notes**

- The monitoring well was installed in place using air rotary drilling techniques.
- The well was constructed with 2" ID, 0.020 inch factory slotted, threaded joint, schedule 40 PVC pipe.
- The well is protected with a locked stock up steel cover and a compartment cap.
- The bore between material types shown on the profile log represent approximate boundaries. Actual boundaries may be gradational.
- The depths indicated are referenced from the ground surface.

**Borehole Diagram**

Soil Columns:

- 0 - 20 feet: Sand - (SP) - Brown, Very Fine Grained, Well Sorted, at 0' - 2'.
- 20 - 30 feet: Caliche Layer at 2' - 20'.
- 30 - 40 feet: Sand - (SP) - Tan, Very Fine Grained, Well Sorted with Caliche Nodules, at 20' - 30'.
- 40 - 50 feet: Sand - (SP) - Red - Tan, Very Fine Grained, Moderately Sorted, Sandstone Debris at 20' - 30'.
- 50 - 60 feet: Sand - (SP) - Red, Very Fine Grained, Well Sorted with Caliche Debris, at 30' - 40'.
- 60 - 70 feet: Sand - (SP) - Tan - Red, Very Fine Grained, Well Sorted, at 40' - 45'.
- 70 - 75 feet: Sand - (SP) - Red - Brown, Very Fine Grained, Well Sorted, at 45' - 50'.


Geological Units:

- Ground Surface Seal
- Bentonite Pellet Seal
- Sand Pack
- Screen

Water Level Indicators:

- WHT: Indicate samples selected for laboratory analysis.
- WL: Indicate the ground water level measured on date.
- HD: Head space reading in mm obtained with a photo-luminescence detector.

### Legend

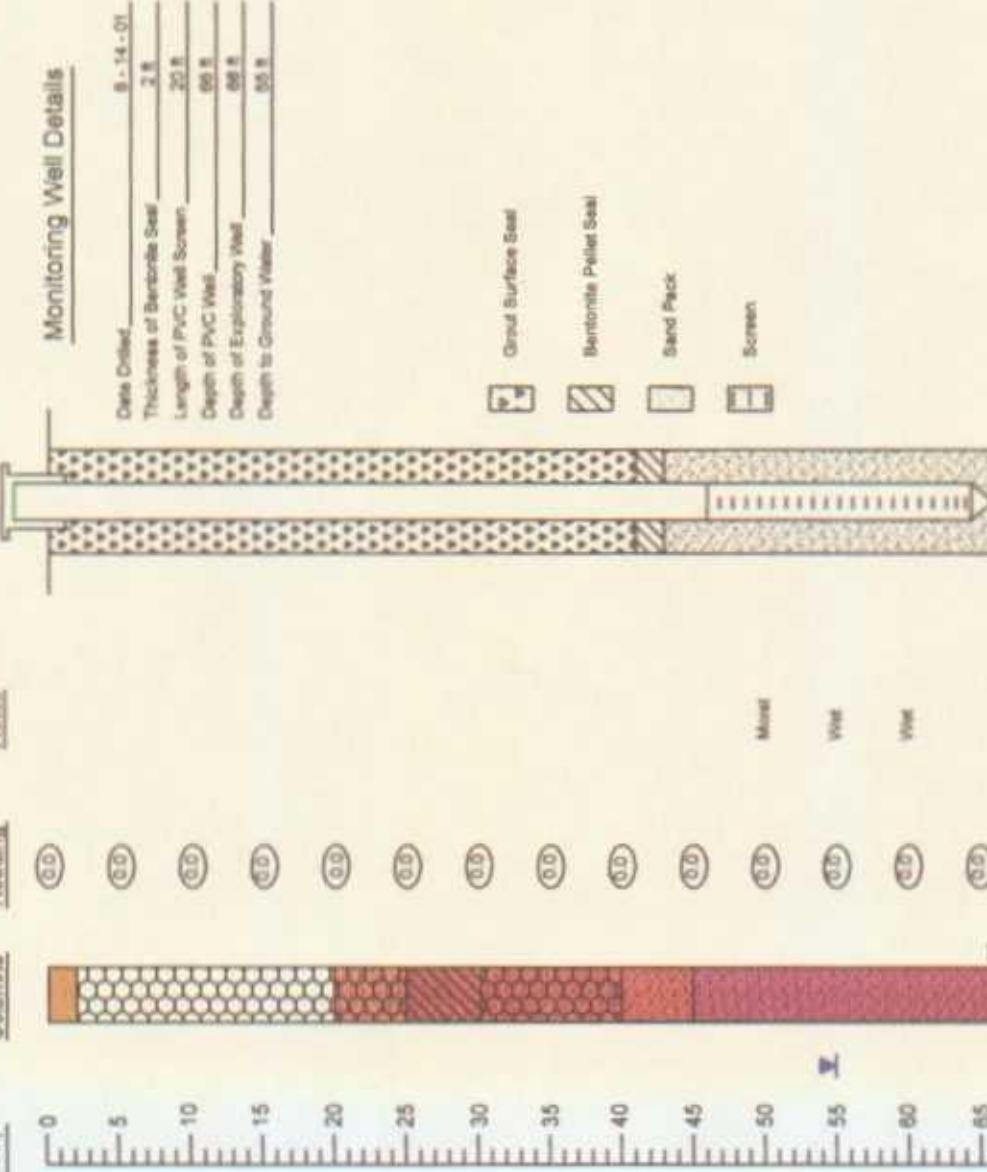

卷之三

Monitoring Well - 5


Plains Pipeline L.P. Barr Angell #2 Lea County, NM



NOVA Safety and Environmental

Start Date: 2022-07-21 Checked by: H.E.

## Monitoring Well MW - 6

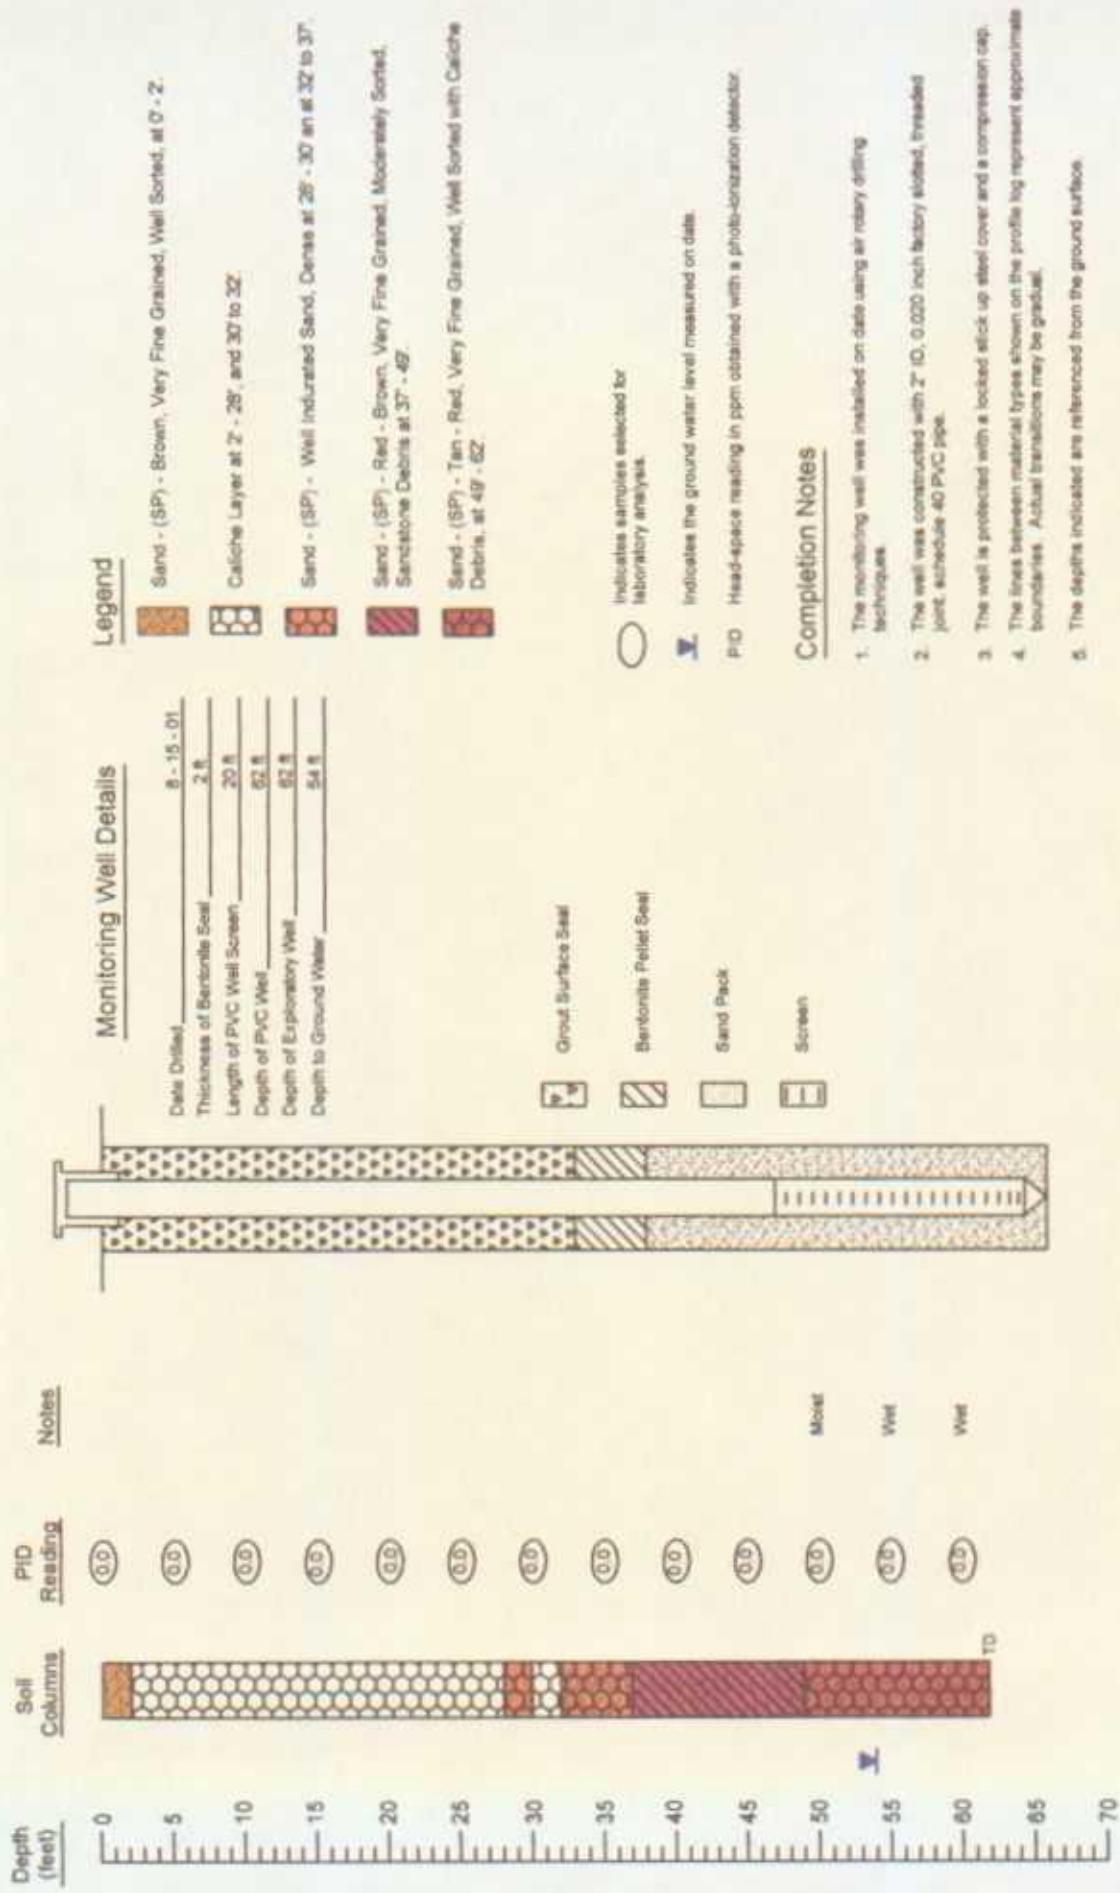

Boring Log And Monitoring Well

Monitoring Well - 6

Plains Pipeline, L.P. Darr Angell #2 Lea County, NM

NOVA Safety and Environmental


Printed on: Sept 27, 2002

NOVA Energy and Infrastructure

Plains Pipeline, L.P. Darr Angell #2 Lea County, NM

Printed on: Sept 27, 2002

## Monitoring Well MW - 7

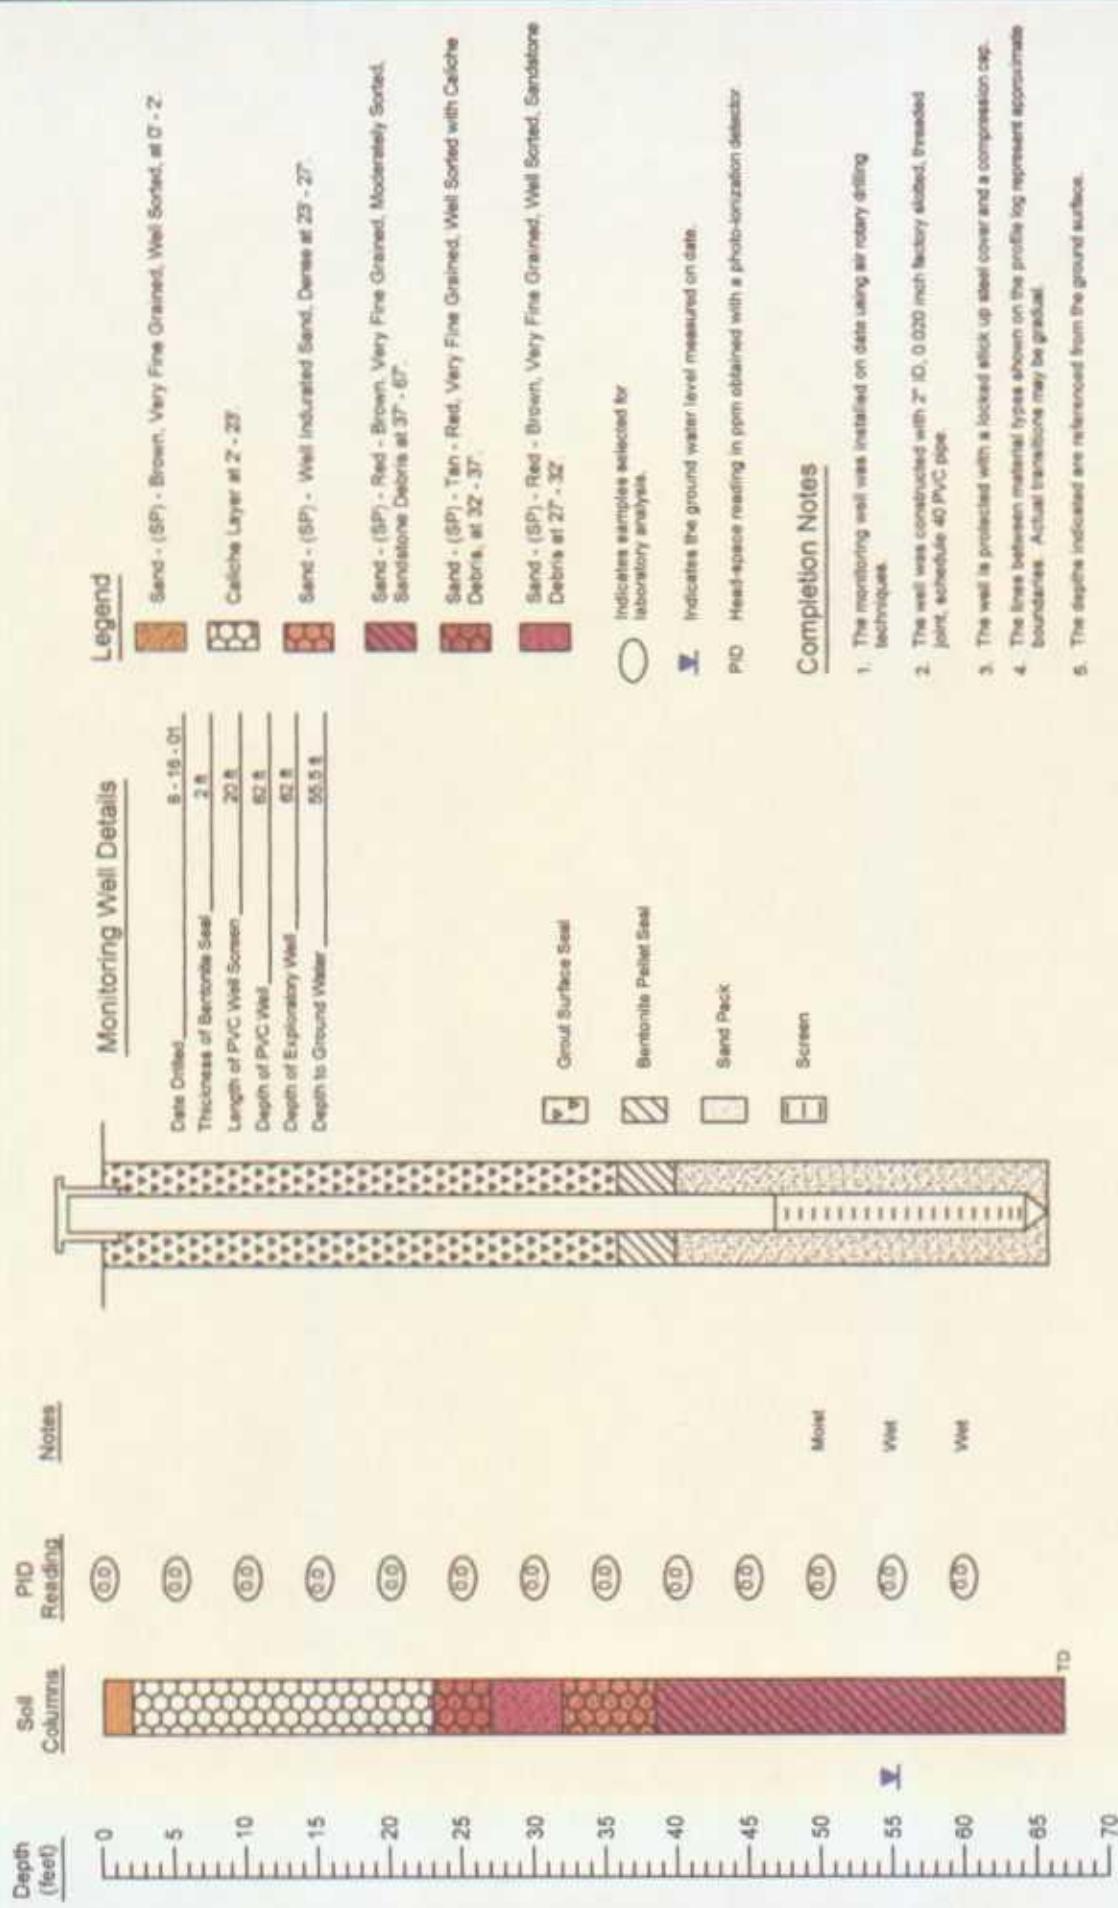

Plains Pipeline, L.P. Darr Angell #2 Lea County, NM



## NOVA Safety and Environmental


State Law Name	Print By LOM	Checked By REC
Reed 27, 2000		

## Boring Log And Monitoring Well

### Monitoring Well - 7

Monitoring Well - 7  
Lea County, NM

## Monitoring Well MW - 8

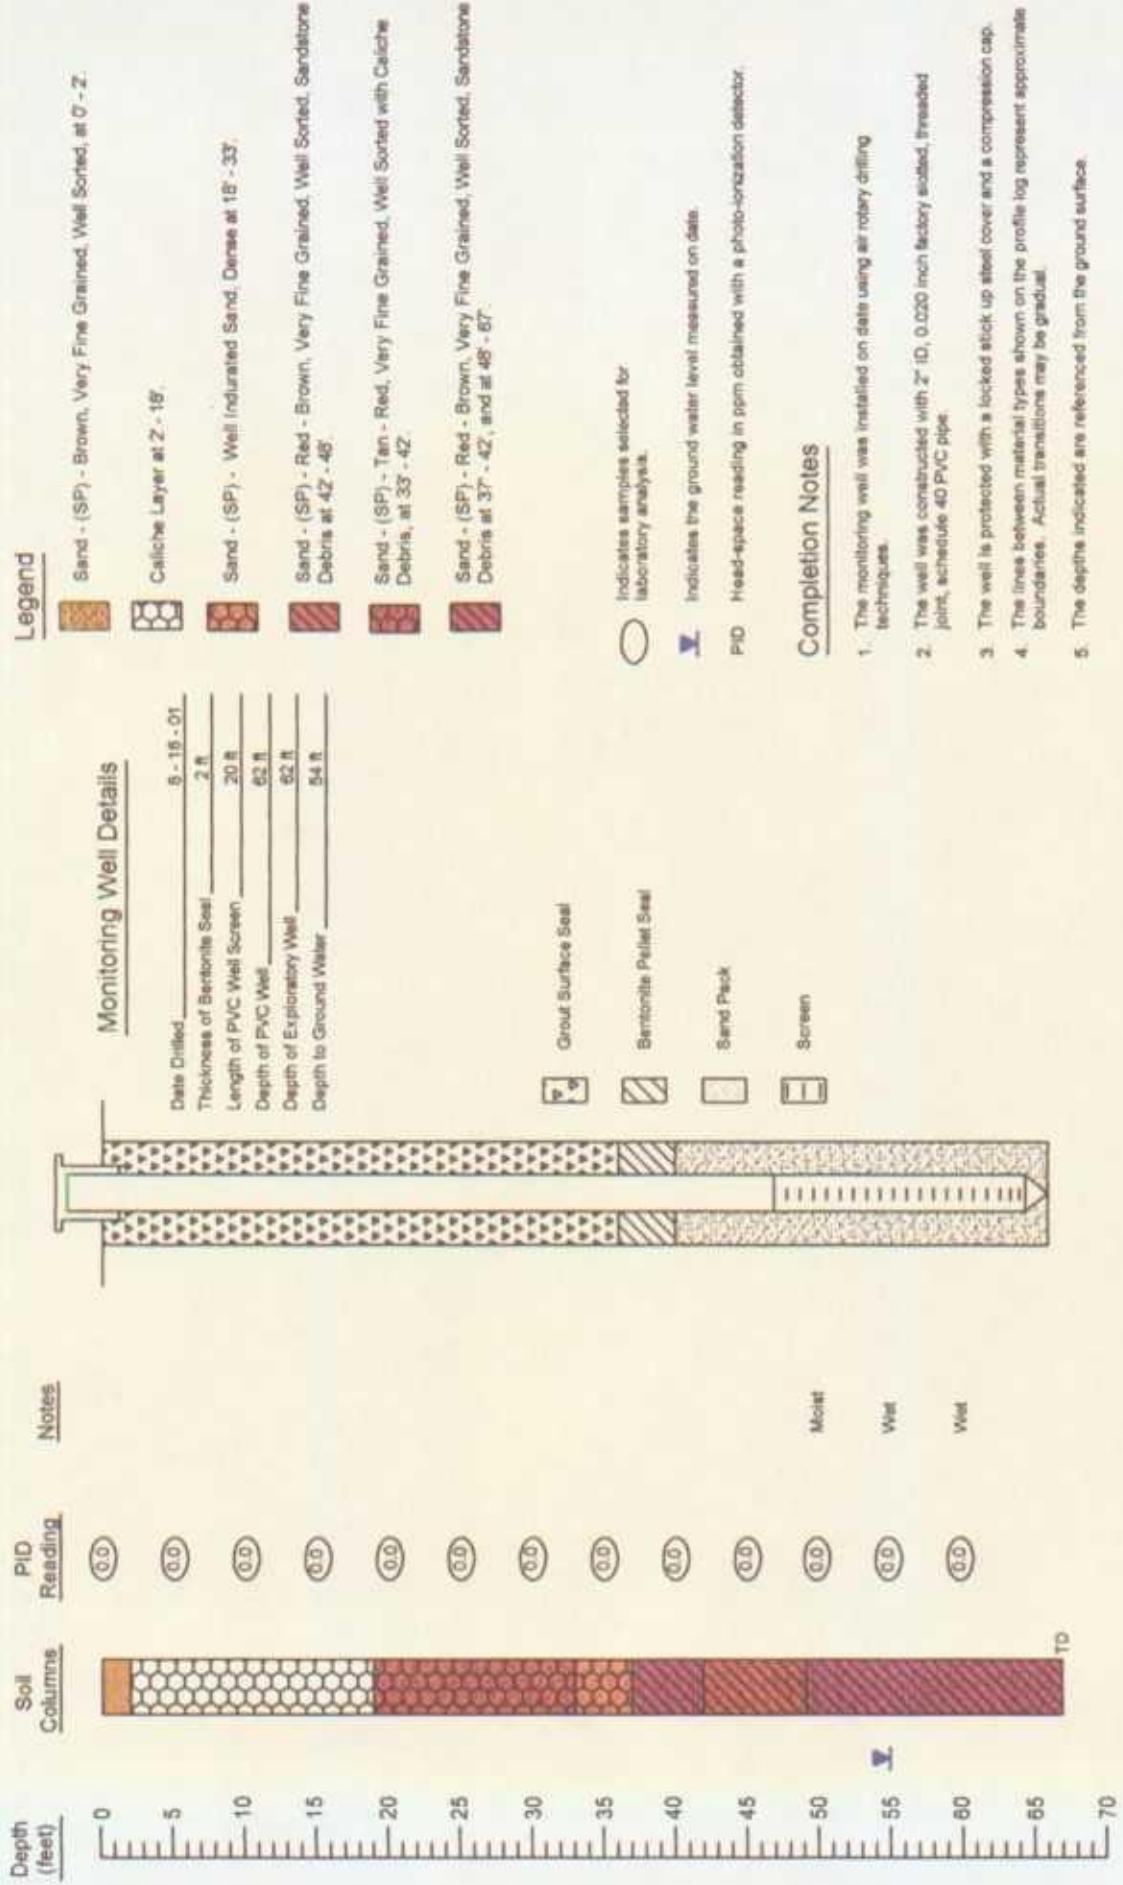


Plains Pipeline, L.P. Dart Angel #2 Lea County, NM



## NOVA Safety and Environmental

State wide scale	Print By: LGM	Created By: FG
Sheet 27, 2002		

## Monitoring Well MW - 9

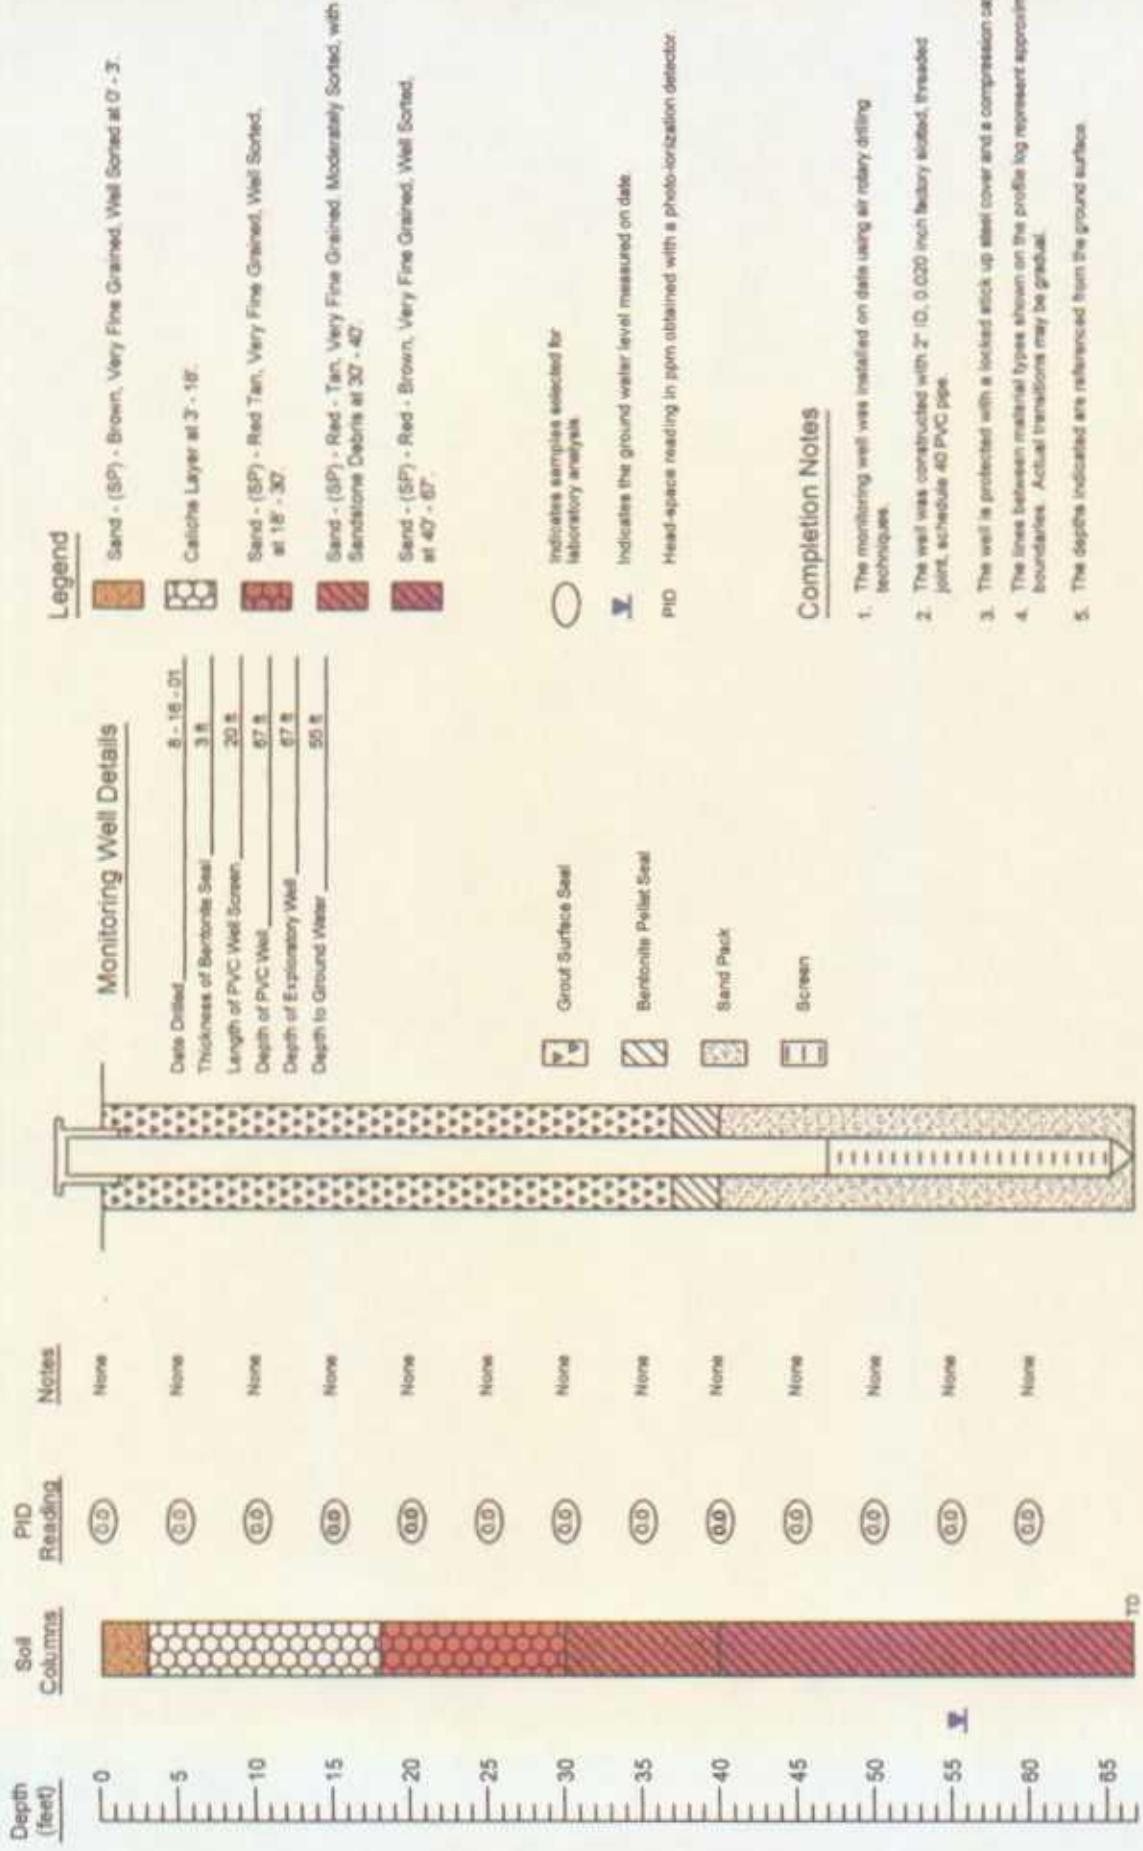

## Boring Log And Monitoring Well


Monitoring Well - 9  
Plains Pipeline, L.P. Darr Angell #2 Lea County, NM

## NOVA Safety and Environmental



Print By: LJM Created By: EG  
Date: 27/3/2012

## Monitoring Well MW - 10

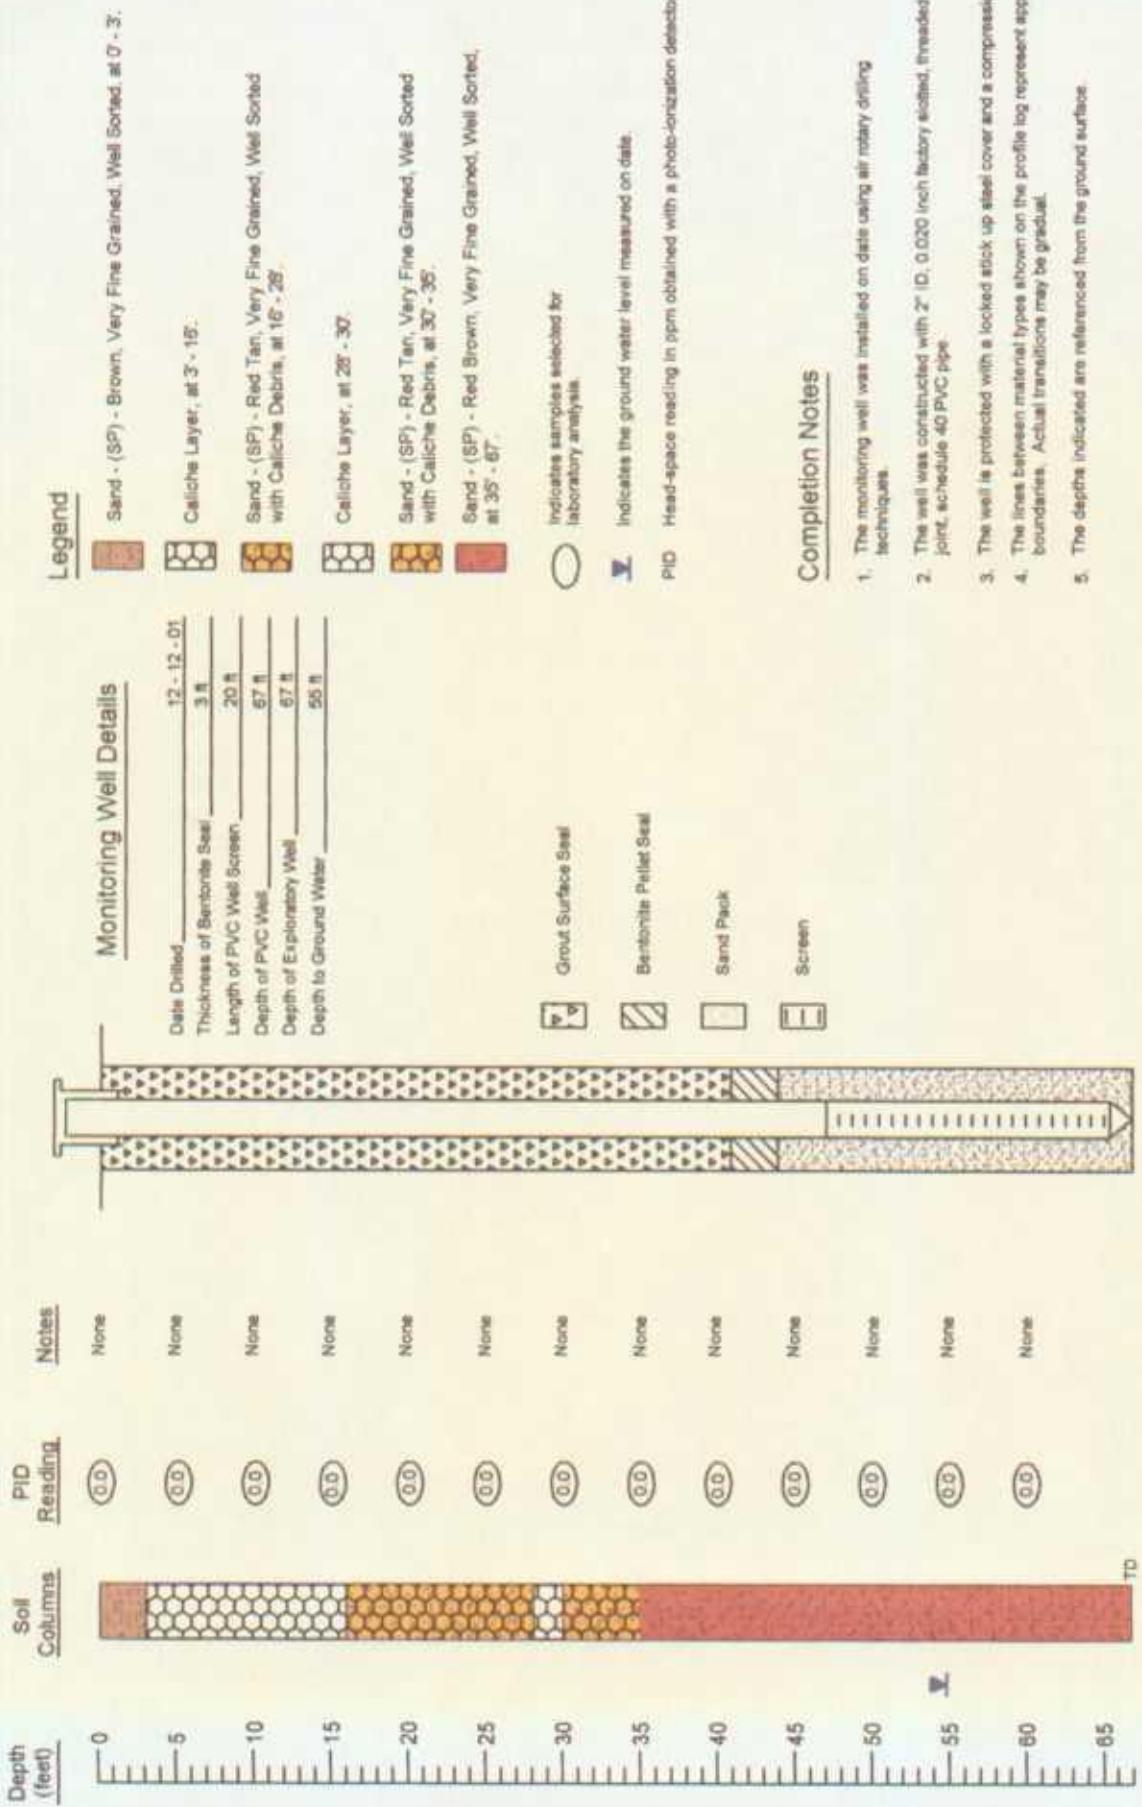


## NOVA Safety and Environmental

Plains Pipeline, L.P. Darr Angell #2 Lea County, NM



Scale One Kilometer	Print By LGM	Checked By J/T
Sept. 27, 2002		

Recovery Well RW - 1

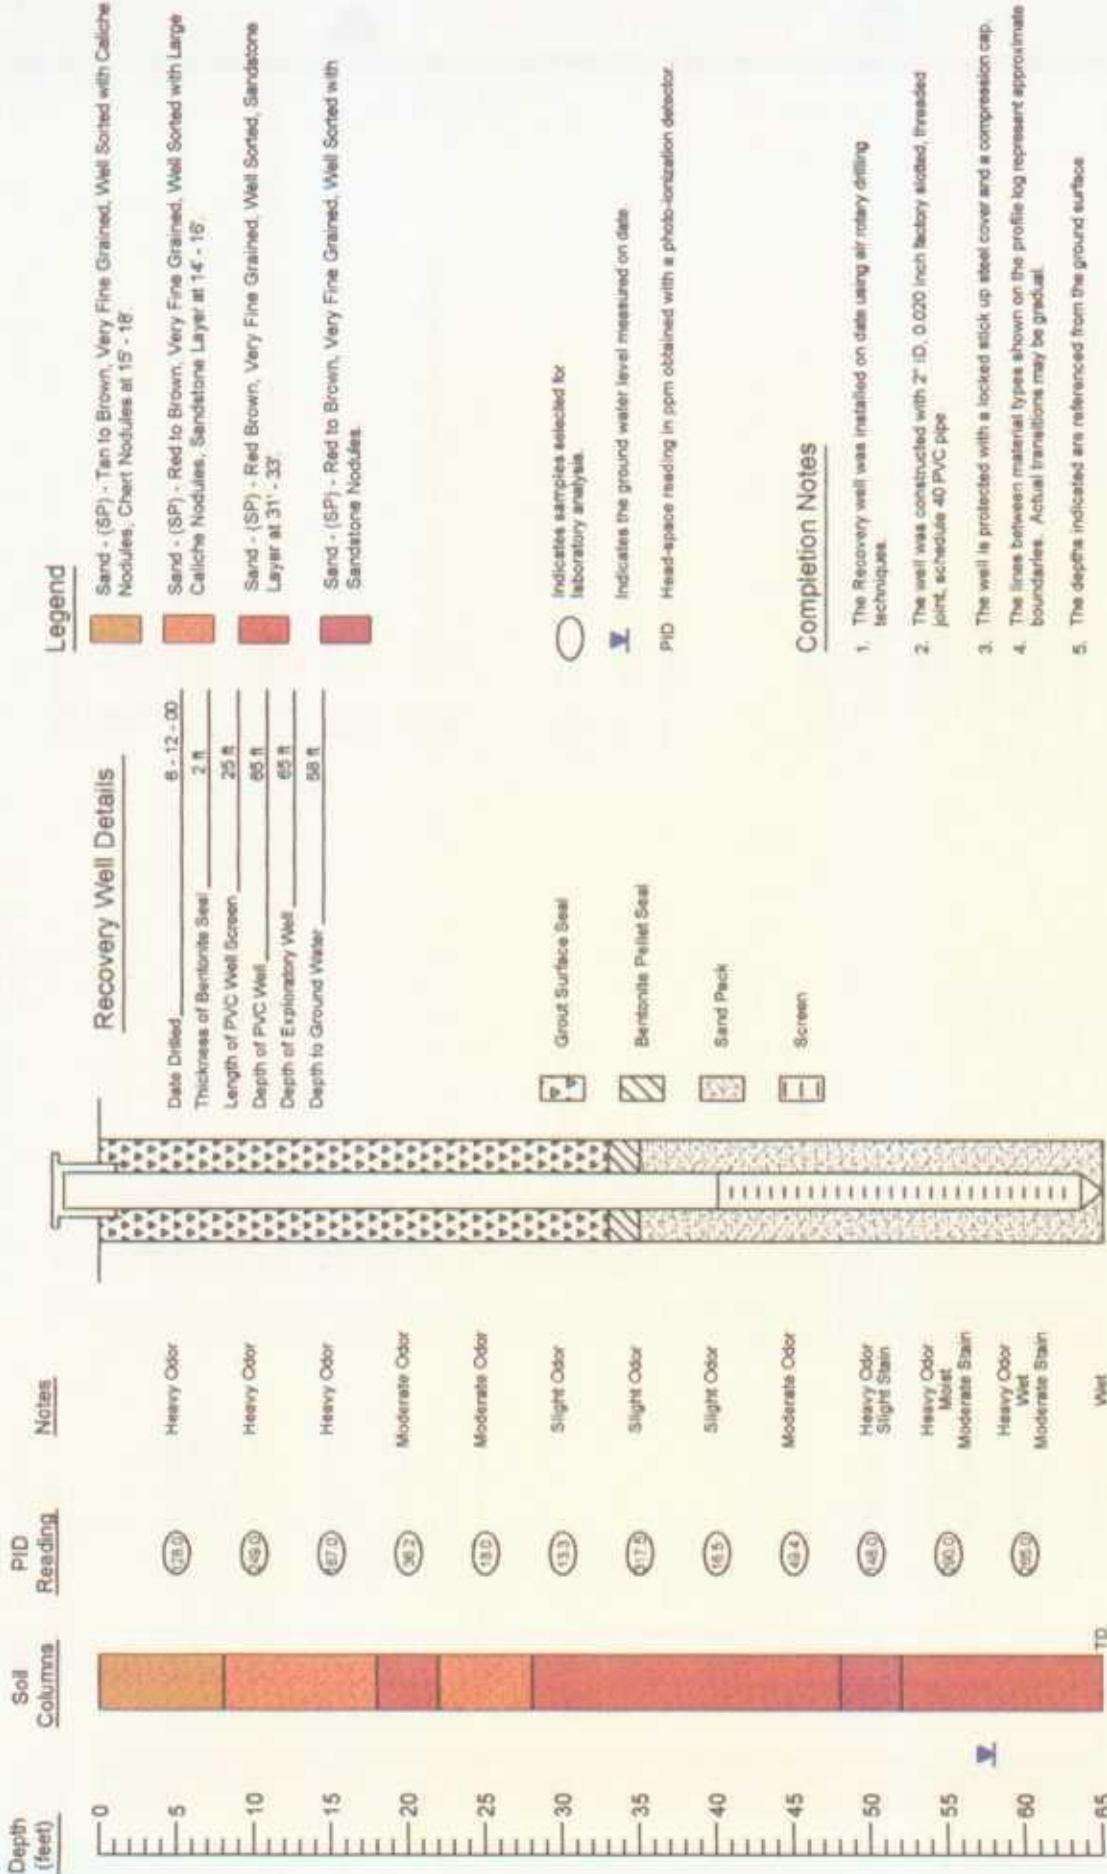

INDIA Safety and ENVIRONMENT



EOTT Energy Corp.      Darr Angell #2      Lea County, NM  
Recovery Well - 1

Boring Log And Recovery Well

Becoming Well - 1


1. The Recovery well was installed on site using air rotary drilling techniques.
2. The well was constructed with 2" ID, 0.020 inch factory slotted, threaded joint, schedule 40 PVC pipe
3. The well is protected with a locked stick up steel cover and a compression cap.
4. The lines between material types shown on the profile log represent approximate boundaries. Actual transitions may be gradual.
5. The depths indicated are referenced from the ground surface

**Heavy Odor**  
Slight Stain

**Heavy Odor**  
Mild  
Moderate Stain

**Heavy Odor**  
Wet  
Moderate Stain

## Recovery Well RW - 3

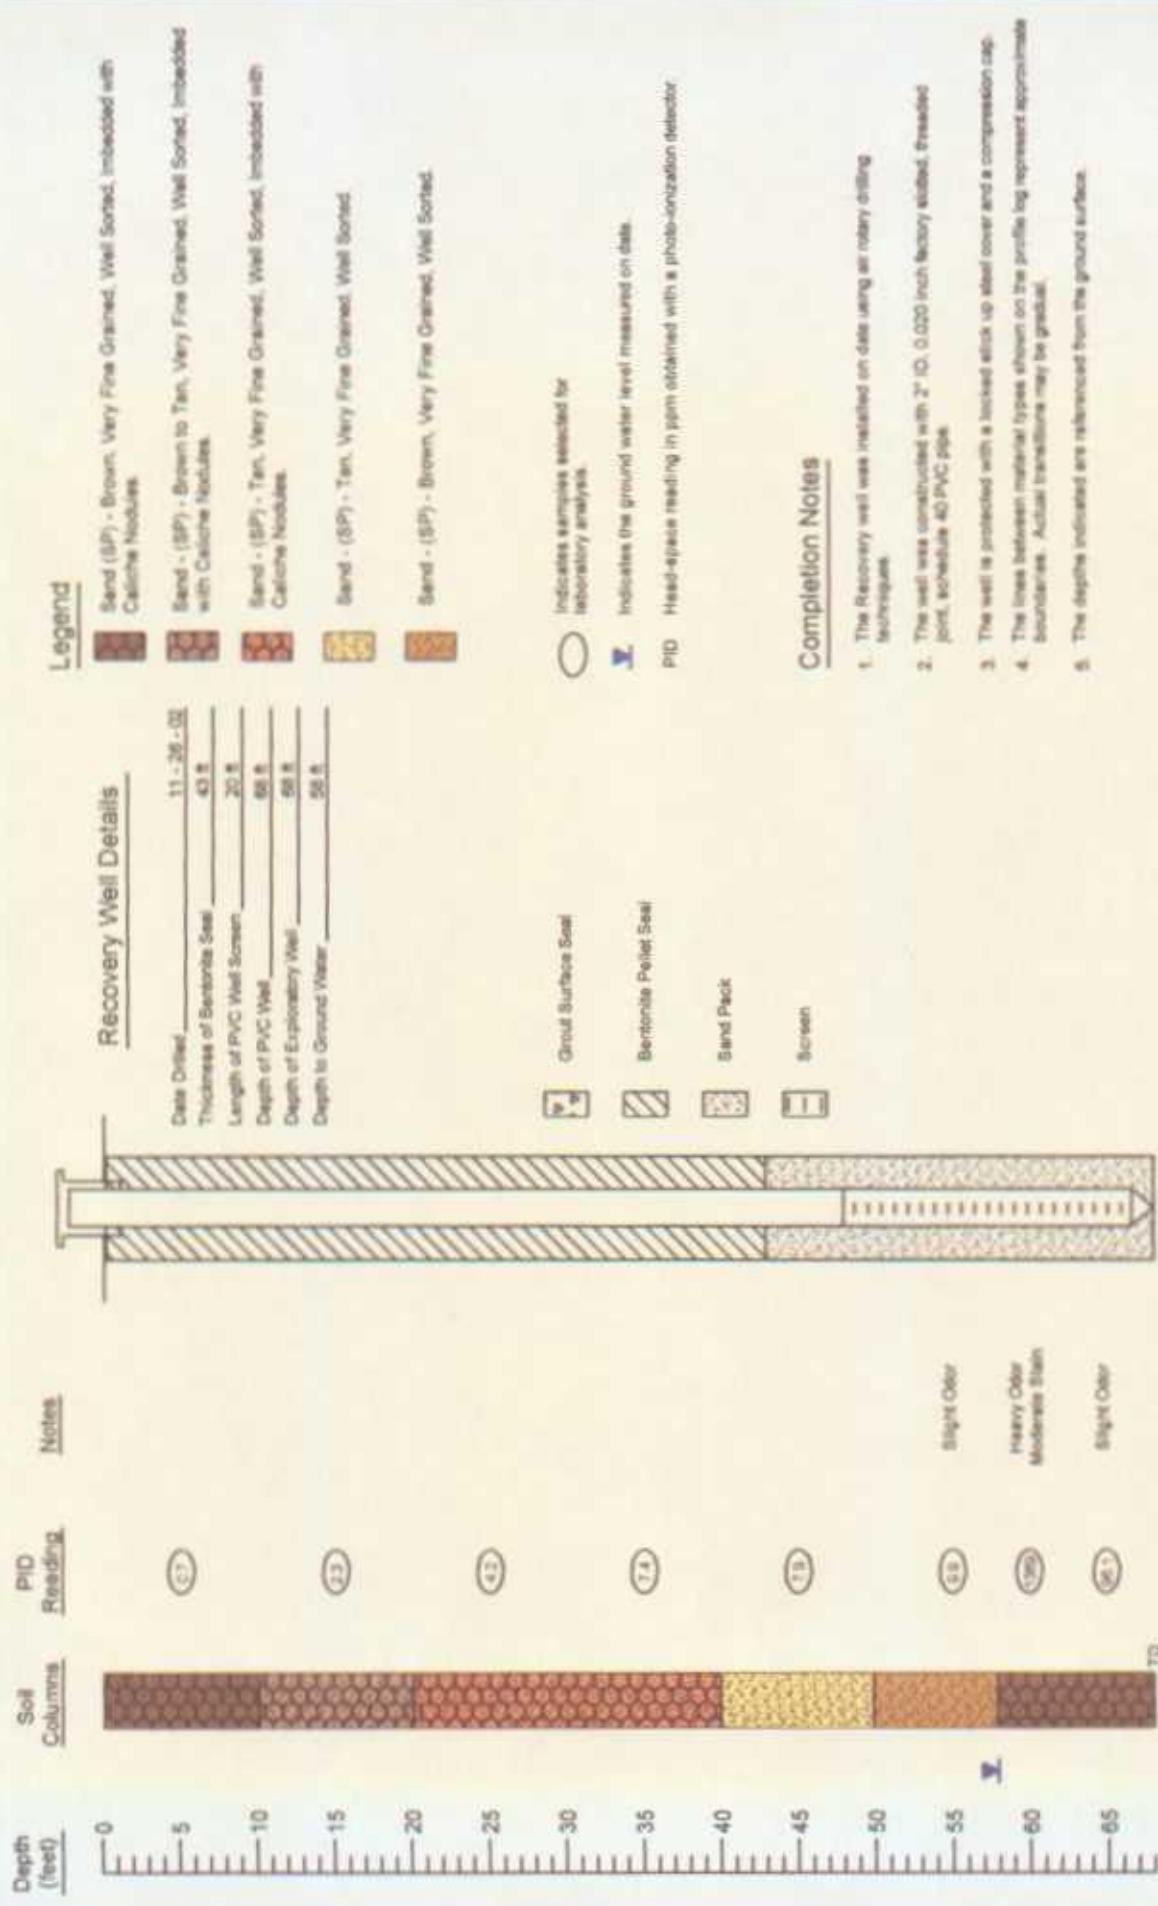

Boring Log And Recovery Well Detail  
Recovery Well - 3


EOTT Energy Corp. Darr Angel #2 Lea County, NM

NOVA Safety and Environmental



State: New Mexico  
Print By: CDR  
Created By: TEC  
January 21, 2008

## Recovery Well RW - 4

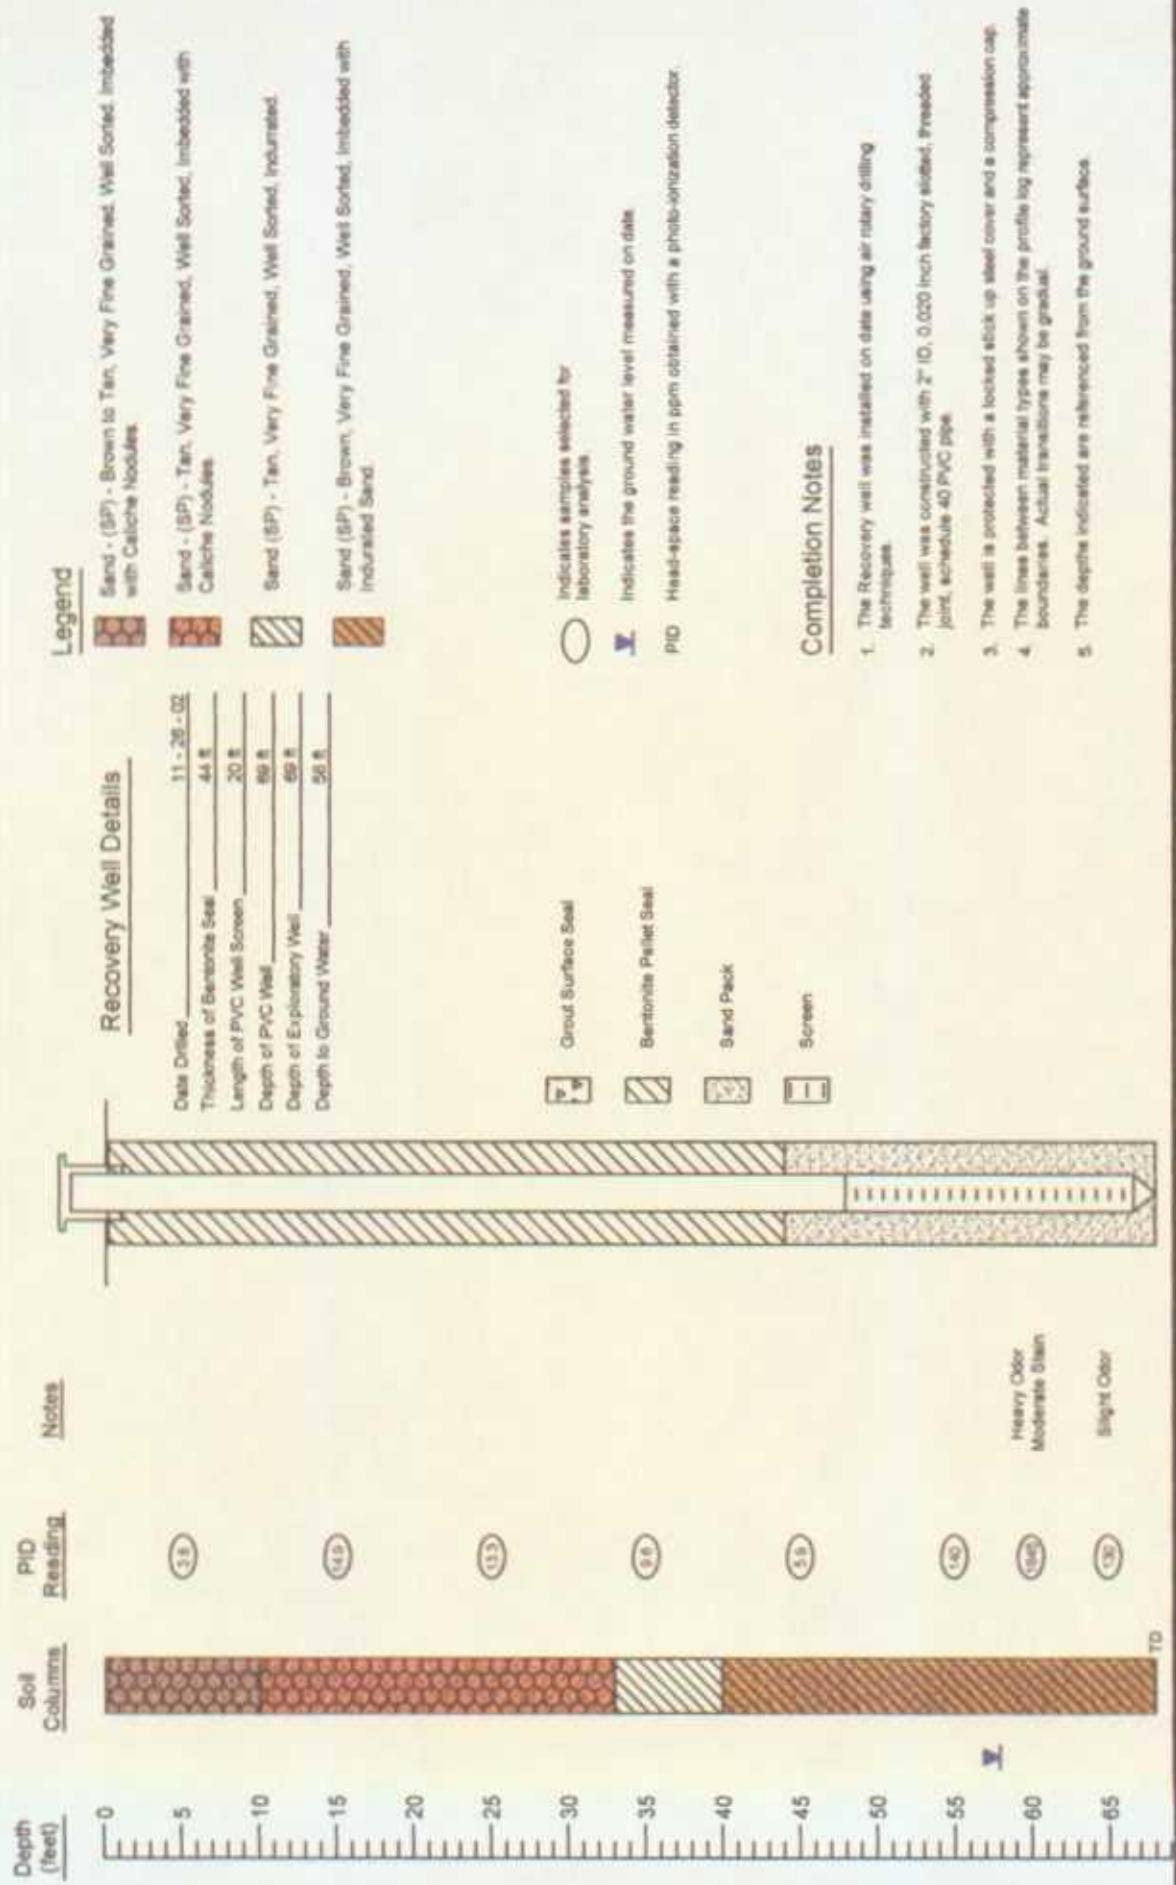

## Boring Log And Recovery Well Detail

### Recovery Well - 4


EOTT Energy Corp. Darr Angell #2 Lea County, NM



## NOVA Safety and Environmental

File No. 00000000  
Prepared By: NOVA  
Date: January 21, 2003

## Recovery Well RW - 5

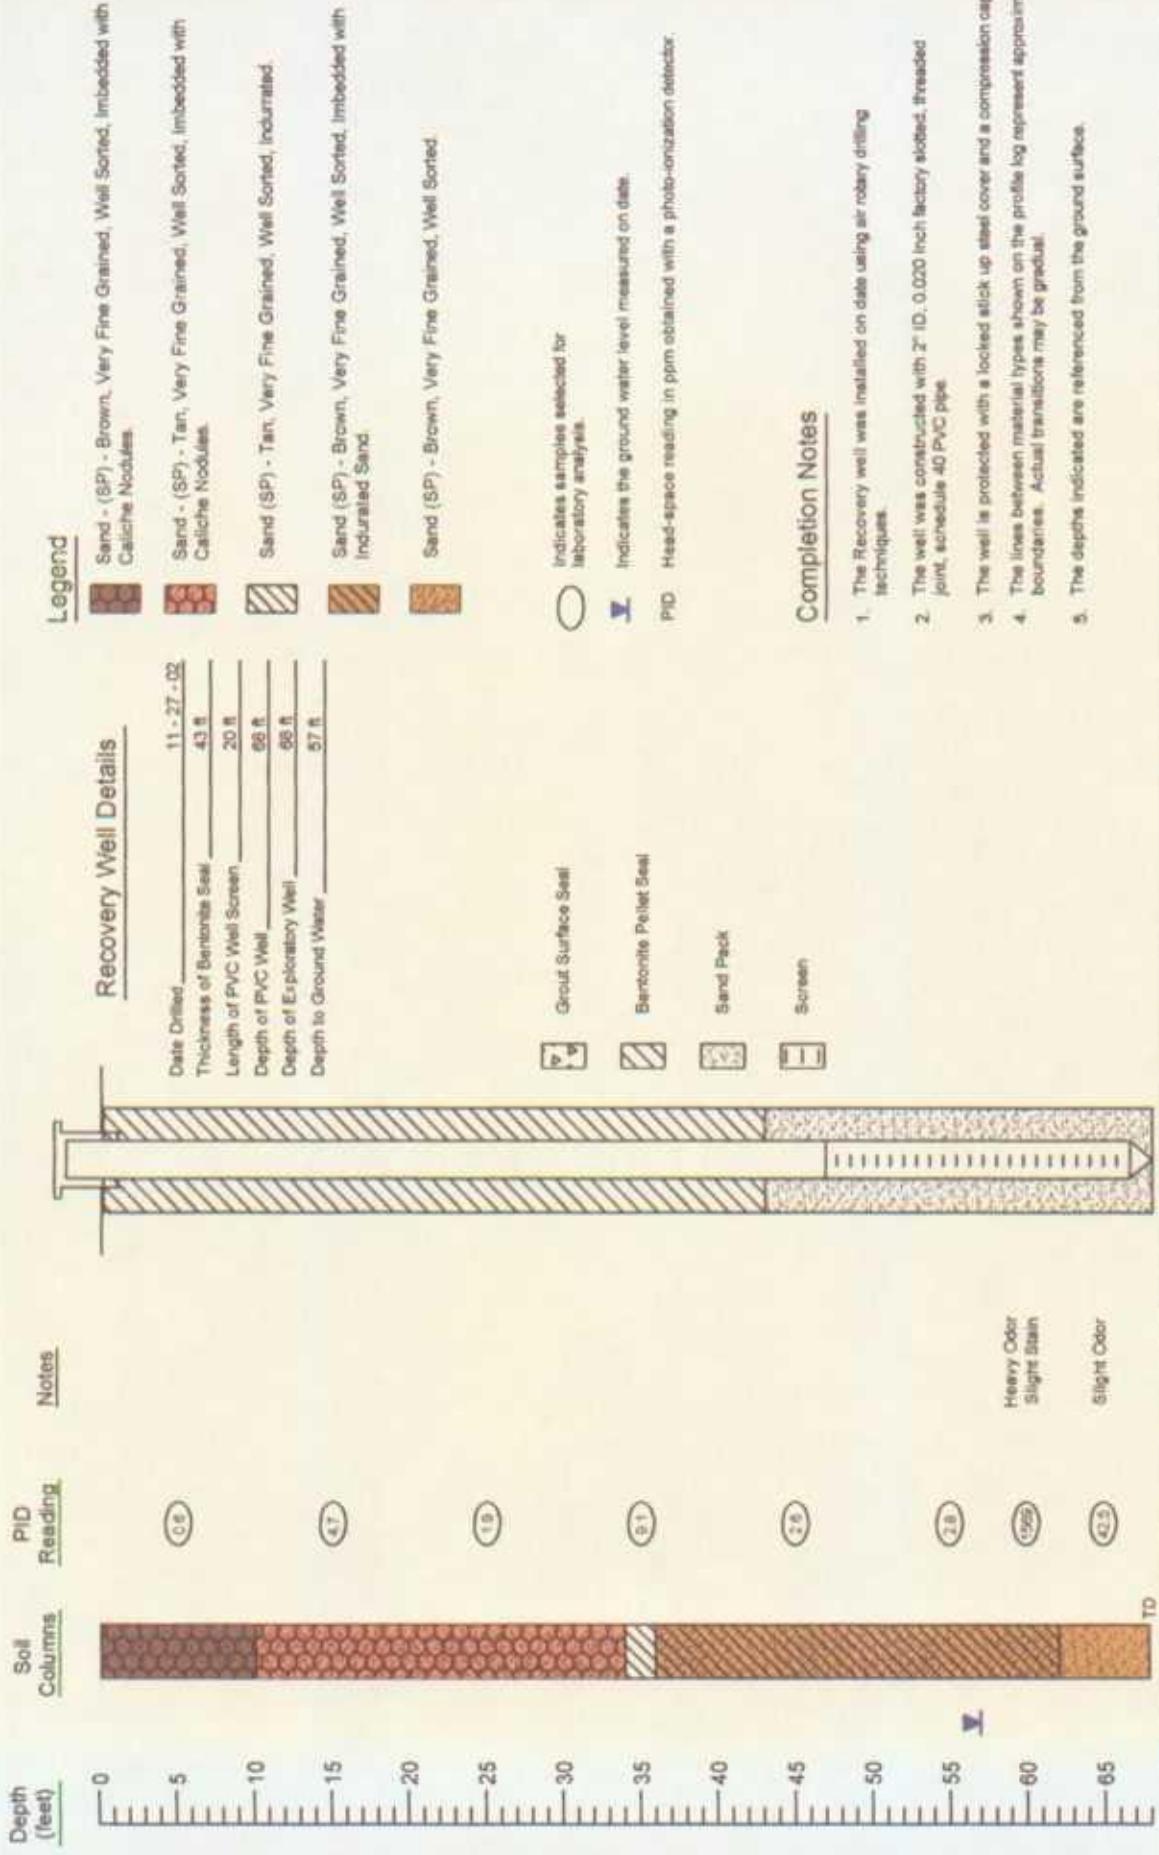


## NOVA Safety and Environmental



Boring Log And Recovery Well Detail  
Recovery Well - 5  
Lea County, NM

Boring Log Date: 00/00 Checked By: TNC  
January 21, 2006

## Recovery Well RW - 6

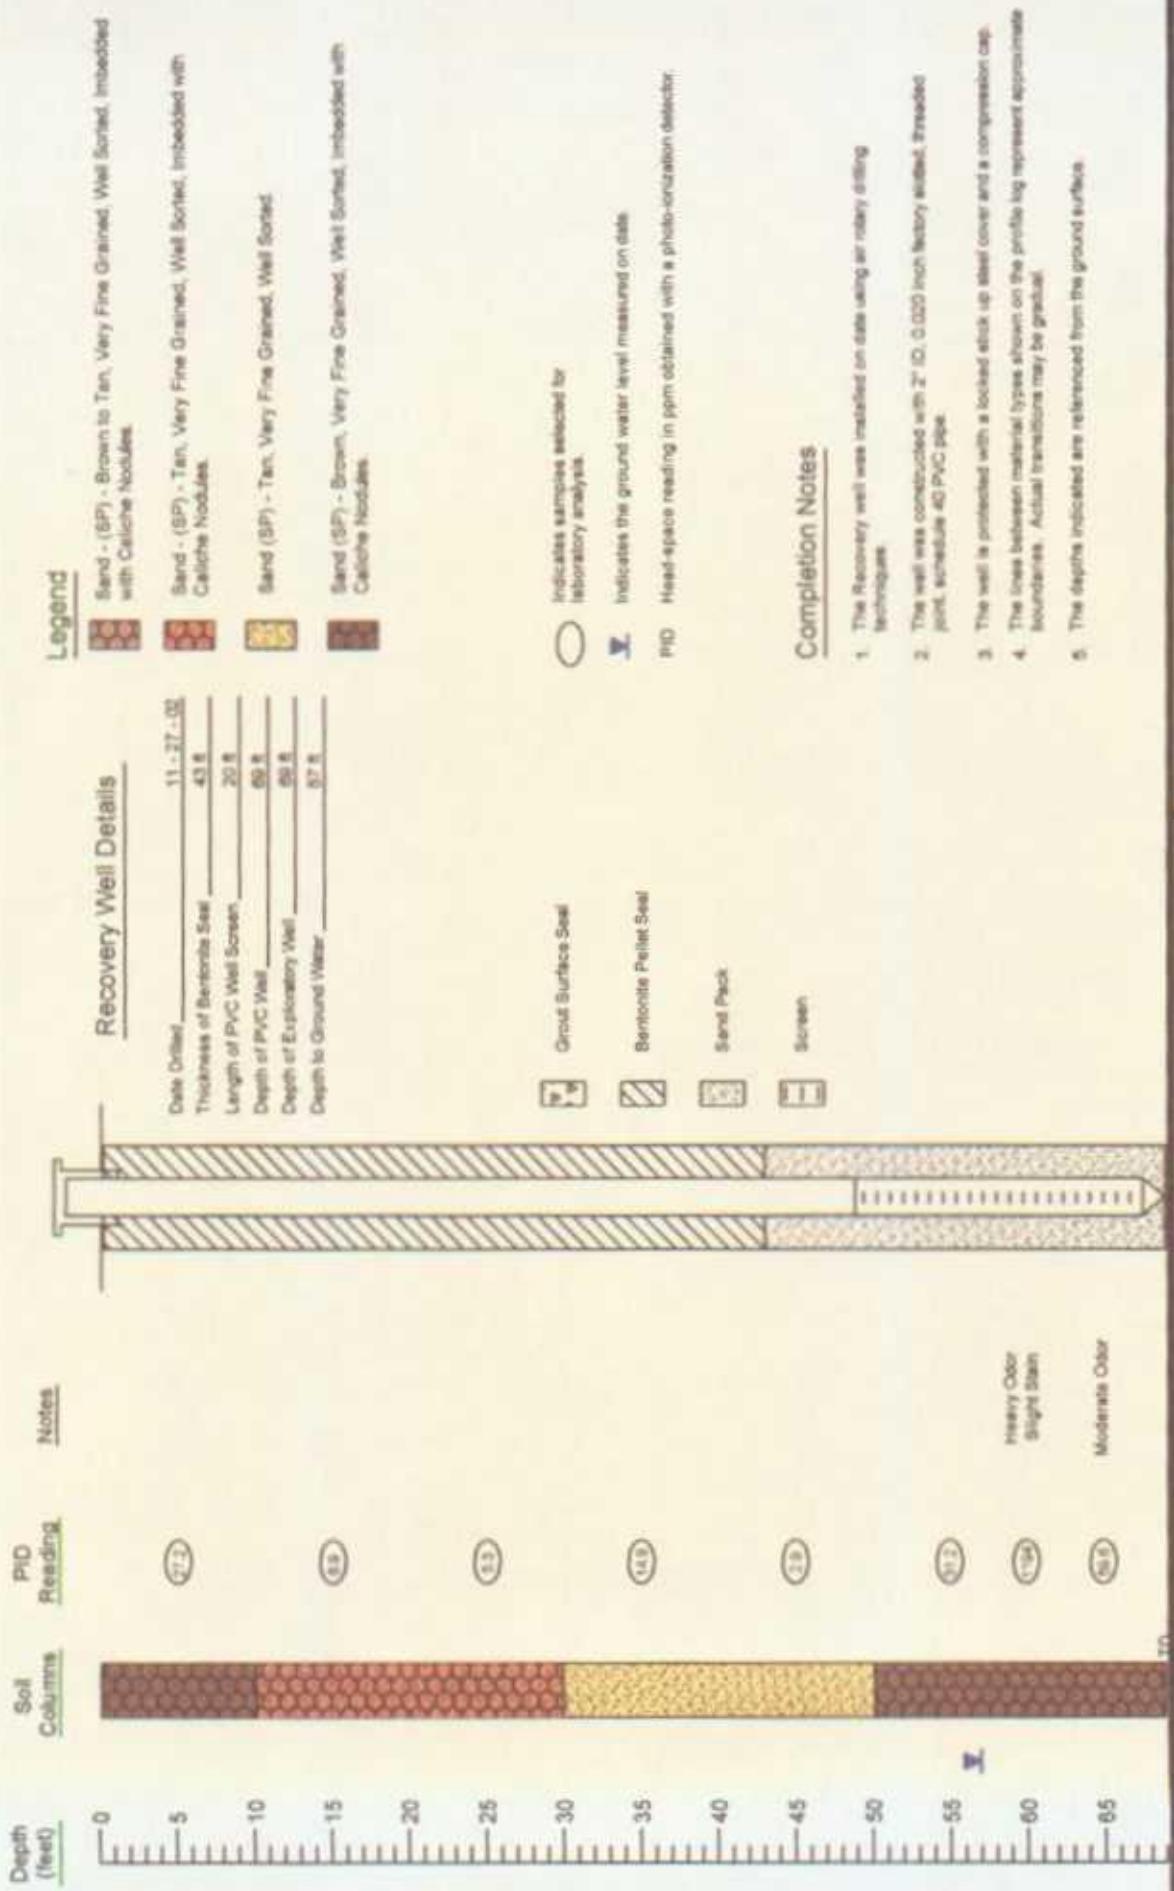

## Boring Log And Recovery Well Detail

### Recovery Well - 6

EOTT Energy Corp. Darr Angell #2 Lea County, NM

## NOVA Safety and Environmental




Stone, lime, sand, pebbles, gravel, etc.

Preo 8000 Chloride No. TNC

January 21, 2006

## Recovery Well RW - 7

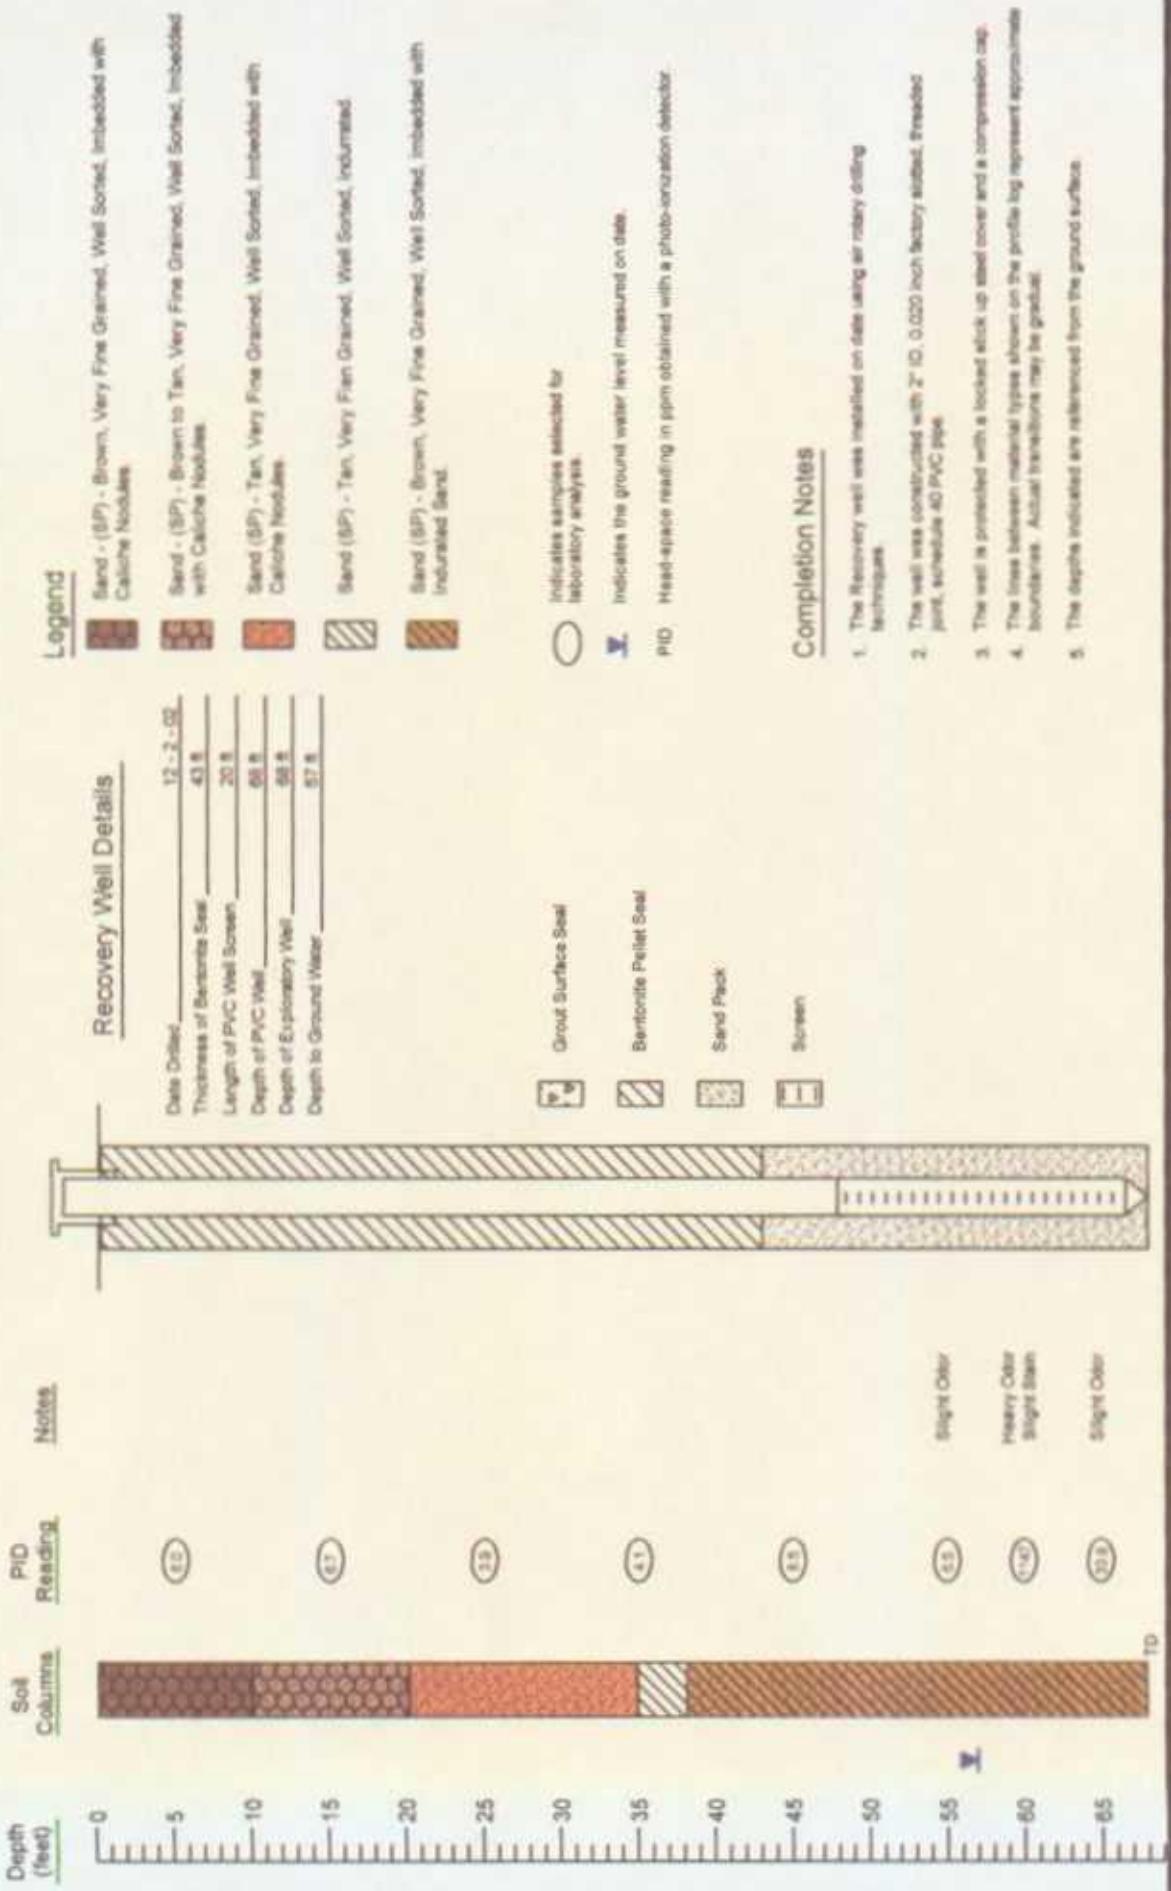


EOTT Energy Corp. Darr Angell #2 Lea County, NM



Printed on 06/26/2006 Checked By: TNC  
July 21, 2006

**NOVA Safety and Environmental**

## Soil Boring SB - 1

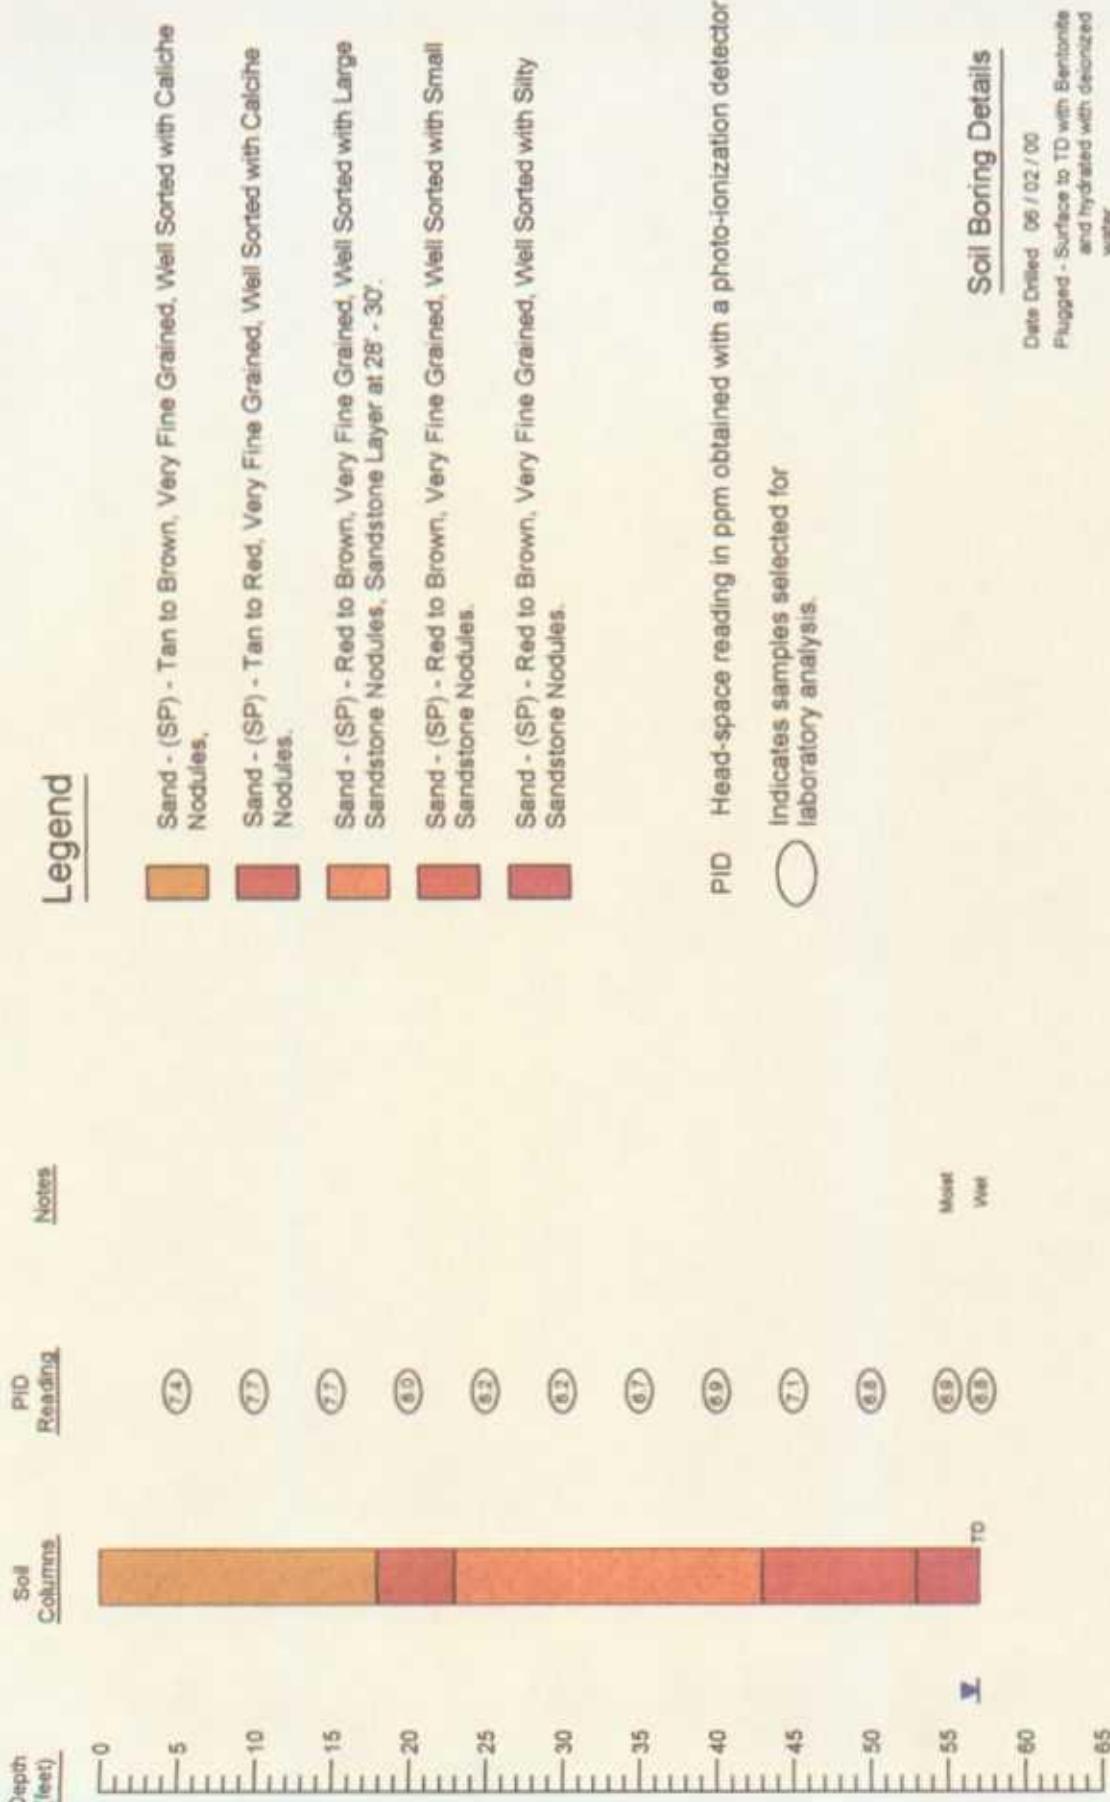

**Soil Boring Details**

Date Drilled 06 / 02 / 00  
 Plugged - Surface to TD with Bentonite and hydrated with deionized water

**NOVA Safety and Environmental**

Sample ID# Date By CCS Checked By TNC  
 JUN-21-2006




EOTT Energy Corp. Darr Angell #2 Lea County, NM

**Soil Boring Log Details**

**Soil Boring SB - 1**

## Soil Boring SB - 2

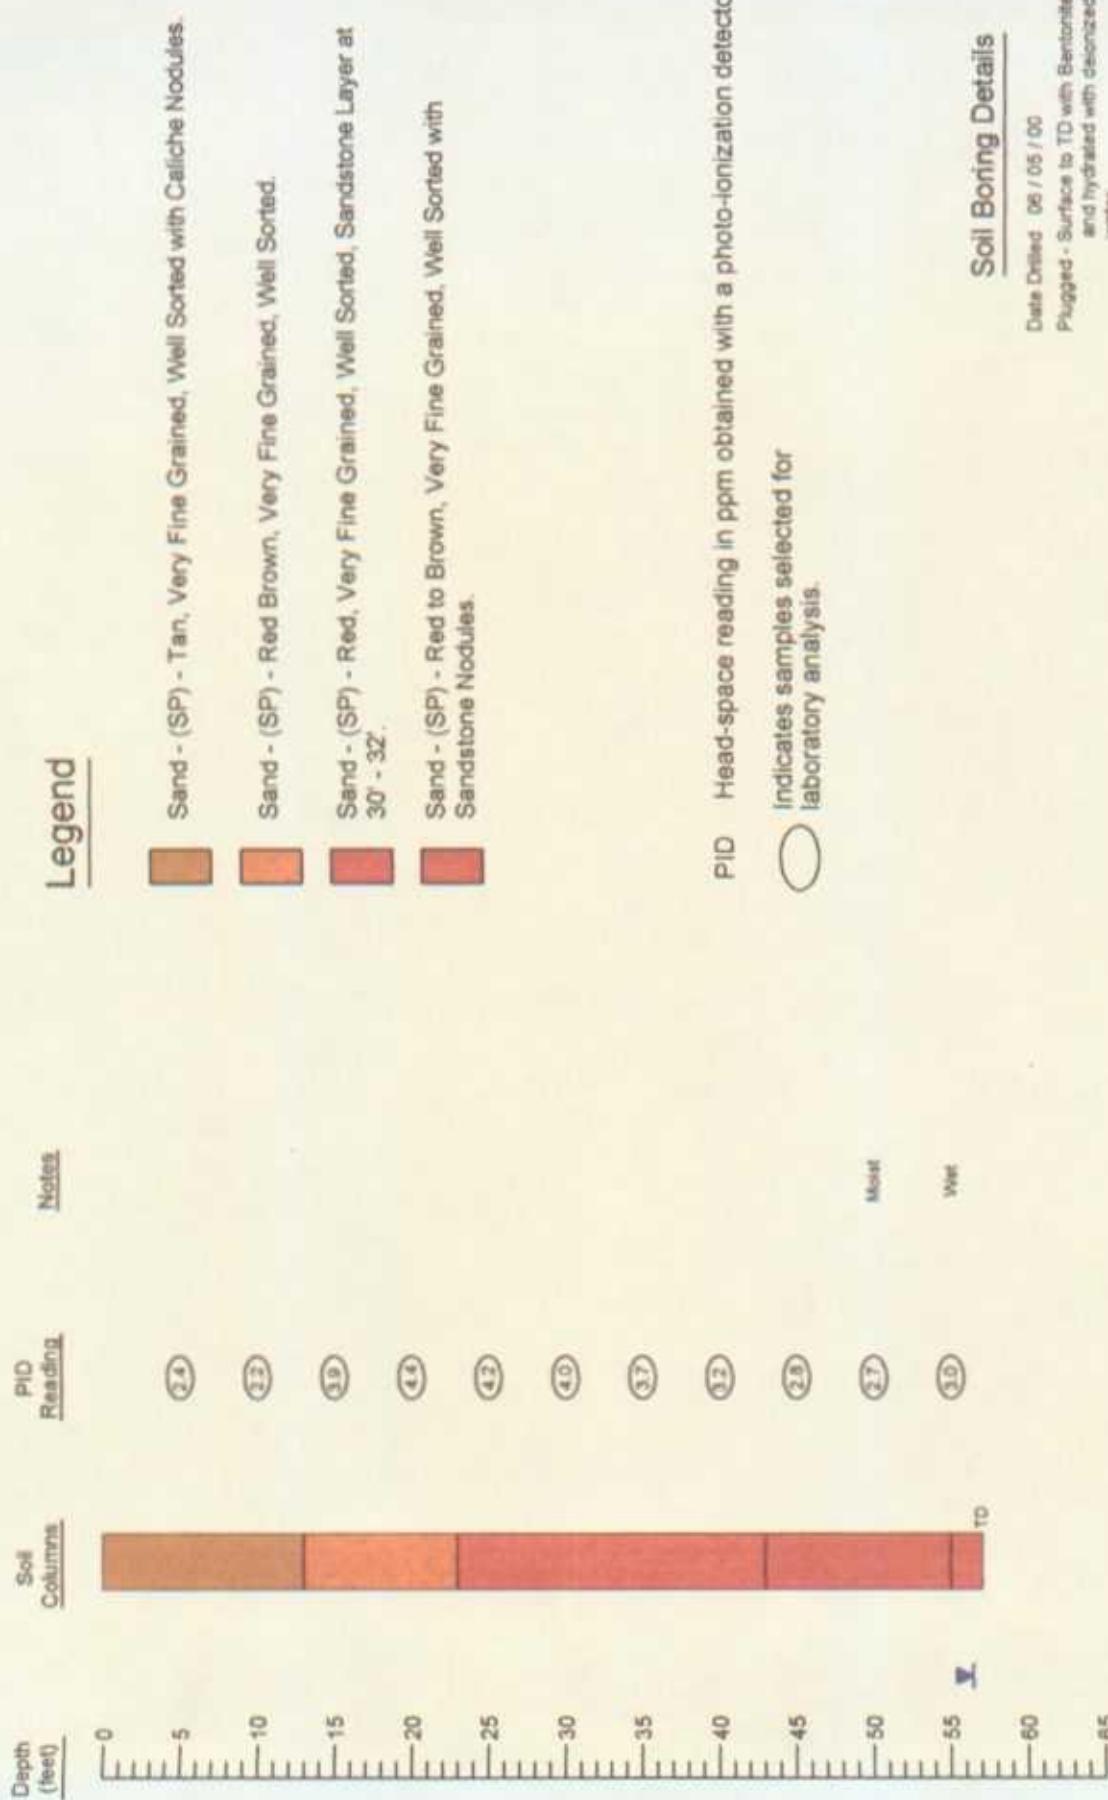

**Soil Boring Details**

Date Drilled: 06 / 05 / 00  
 Plugged - Surface to TD with Bentonite and hydrated with deionized water

## NOVA Safety and Environmental




EOTT Energy Corp. Darr Angell #2 Lea County, NM

### Soil Boring Log Details

Soil Boring SB - 2

Recorded By: CDG Checked By: THC  
 January 21, 2006

## Soil Boring SB - 3

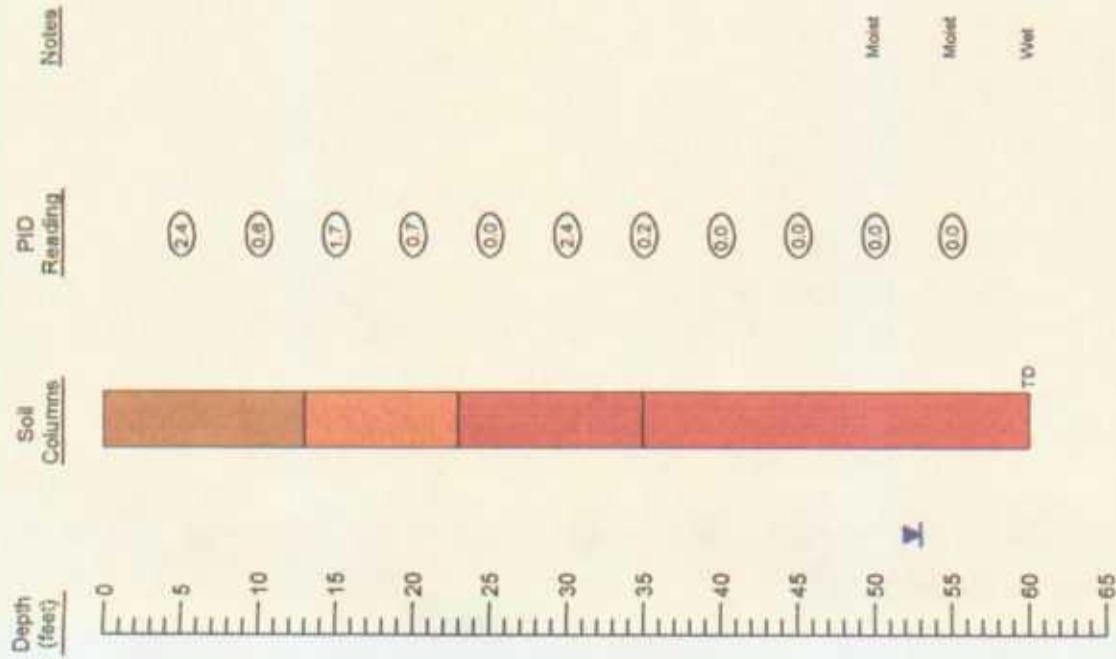

PID Head-space reading in ppm obtained with a photo-ionization detector.  
 ( ) Indicates samples selected for laboratory analysis.

Soil Boring Details

Date Drilled 06 / 05 / 00  
 Plugged - Surface to TD with Bentonite and hydrated with deionized water

## NOVA Safety and Environmental

EOTT Energy Corp. Darr Angell #2 Lea County, NM



State: NM	Print By: CCS	Checked By: TMC
January 21, 2008		

## Soil Boring SB - 4

Depth (feet)	Soil Columns	PID Reading	Notes
0.0			
5			
10		0.0	

### Legend

- Sand - (SP) - Tan, Very Fine Grained, Well Sorted with Caliche Nodules.
- Sand - (SP) - Red to Brown, Very Fine Grained, Well Sorted with Caliche Nodules.

PID Head-space reading in ppm obtained with a photo-ionization detector.

 Indicates samples selected for laboratory analysis.

### Soil Boring Details

Date Drilled: 06 / 08 / 00  
Plugged - Surface to TD with Bentonite and hydrated with deionized water

### Soil Boring Log Details

Soil Boring SB - 4

EOTT Energy Corp. Darr Angell #2 Lea County, NM

### NOVA Safety and Environmental




SOILS

Print By: CDS Checked By: TMC

JULY 21, 2006

## Soil Boring SB - 5

Depth (feet)	Soil Columns	PID Reading	Notes
0			
5			
10		0.0	
15		0.0	

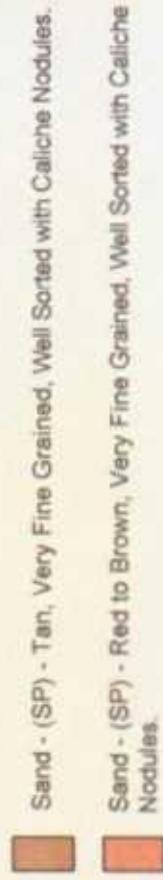

PID Head-space reading in ppm obtained with a photo-ionization detector.

Indicates samples selected for laboratory analysis.

### Soil Boring Details

Date Drilled 06 / 06 / 00  
Plugged - Surface to TD with Bentonite and hydrated with deionized water:

### NOVA Safety and Environmental

EOTT Energy Corp. Darr Angell #2 Lea County, NM




Report No. 00000000000000000000000000000000  
January 21, 2006

### Soil Boring Log Details

### Soil Boring SB - 5

## Soil Boring SB - 6

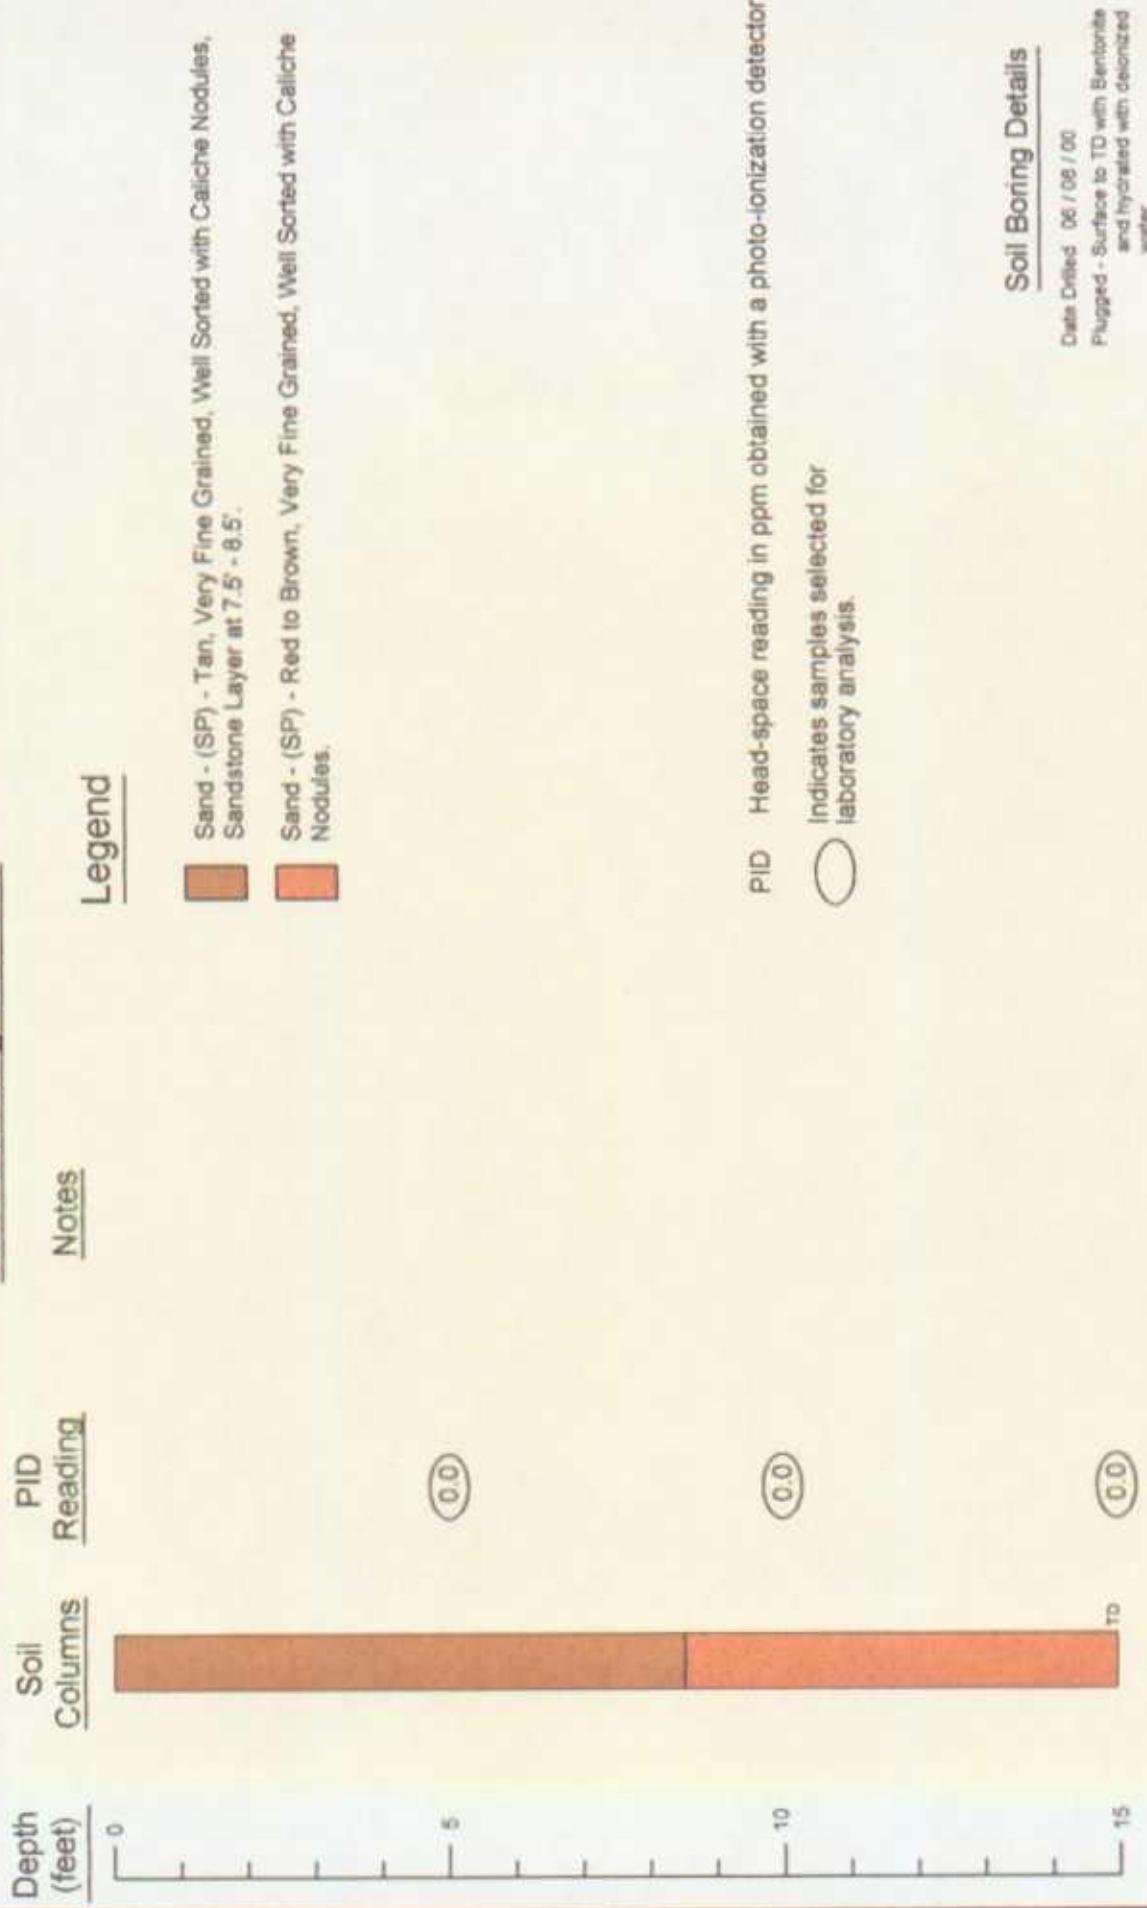

PID Head-space reading in ppm obtained with a photo-ionization detector.

( ) Indicates samples selected for laboratory analysis.

### Soil Boring Details

Date Drilled: 06 / 06 / 00  
Plugged - Surface to TD with Bentonite  
and hydrated with deionized  
water.

### NOVA Safety and Environmental



#### Soil Boring Log Details

#### Soil Boring SB - 6

EOTT Energy Corp. Darr Angell #2 Lea County, NM

Soil Test	Prep By CC6	Checked By TMC
July 21, 2006		

## Soil Boring SB - 7

Depth  
(feet)

PID  
Reading

Notes

Soil  
Columns

### Legend

- Sand - (SP) - Tan, Very Fine Grained, Well Sorted with Caliche Nodules, Sandstone Layer at 8 - 9.5'.
- Sand - (SP) - Red to Brown, Very Fine Grained, Well Sorted with Caliche Nodules.

0

5

10

15

TD

0.0

0.0

0.0

PID Head-space reading in ppm obtained with a photo-ionization detector.

 Indicates samples selected for laboratory analysis.

### Soil Boring Details

Date Drilled 06 / 06 / 00  
Plugged - Surface to TD with Bentonite and hydrated with dechlorinated water.

### NOVA Safety and Environmental

EOTT Energy Corp. Darr Angell #2 Lea County, NM




Scale: NTS Prepared By: CCS Checked By: TAC  
January 21, 2006

### Soil Boring Log Details

### Soil Boring SB - 7

## Soil Boring SB - 8

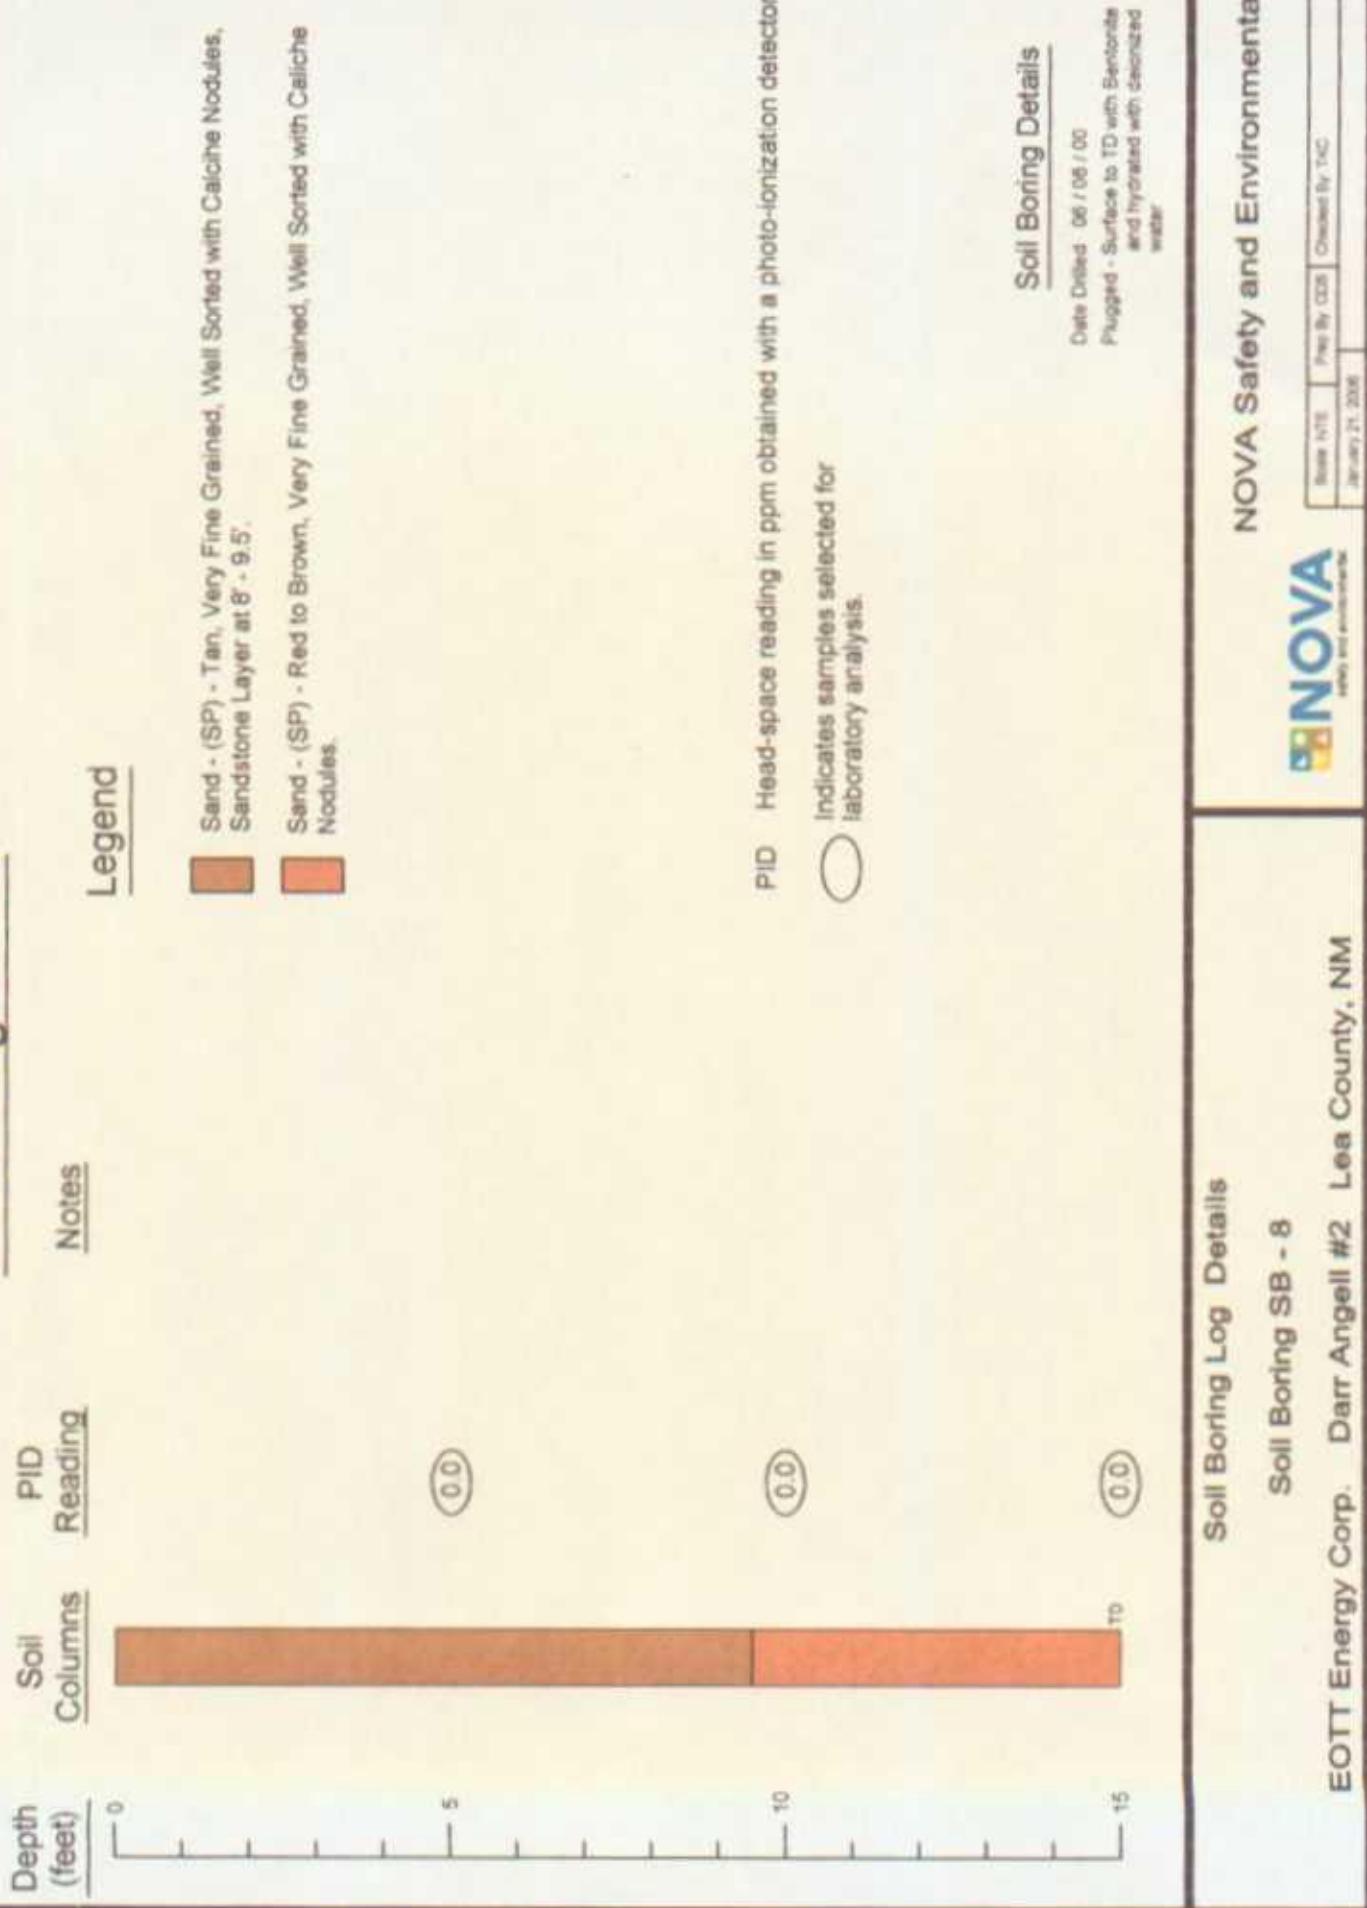

### Soil Boring Details

Date Drilled: 06 / 06 / 00  
 Plugged - Surface to TD with Bentonite and hydrated with deionized water

### NOVA Safety and Environmental



NOVA Energy and Environmental  
 January 21, 2006

### Soil Boring Log Details

#### Soil Boring SB - 8

EOTT Energy Corp. Darr Angell #2 Lea County, NM

## Soil Boring SB - 9

Depth (feet)	Soil Columns	PID Reading	Notes
0		00	

**Legend**

Sand - (SP) - Red to Brown, Very Fine Grained, Well Sorted with Calcite Nodules, Sandstone Layer at 8' - g.

PID Head-space reading in ppm obtained with a photo-ionization detector.

Indicates samples selected for laboratory analysis.

### Soil Boring Details

Date Drilled: 06 / 06 / 00  
Plugged - Surface to TD with Bentonite and hydrated with deionized water

### NOVA Safety and Environmental

EOTT Energy Corp. Darr Angell #2 Lea County, NM



Report #: 1718 Date By: CCR Created By: TGC  
January 21, 2000

## Soil Boring SB - 10

Depth (feet)	Soil Columns	PID Reading	Notes
0		0.0	

### Legend

- Sand - (SP) - Red to Brown, Very Fine Grained, Well Sorted with Calcite Nodules, Sandstone Layer at 8' - 9.5'.
- Sand - (SP) - Tan, Very Fine Grained, Well Sorted with Calcite Nodules.

PID Head-space reading in ppm obtained with a photo-ionization detector.

Indicates samples selected for laboratory analysis.

### Soil Boring Details

Date Drilled 06 / 06 / 00  
Plugged - Surface to TD with Bentonite and hydrated with deionized water

### **NOVA** Safety and Environmental

Soil Boring Log Details  
Soil Boring SB - 10

EOTT Energy Corp. Darr Angel #2 Lea County, NM



State: NM File By: OCS Created By: TGC  
January 21, 2006