

UNITED STATES
DEPARTMENT OF THE INTERIOR
BUREAU OF LAND MANAGEMENT

SUNDRY NOTICES AND REPORTS ON WELLS
Do not use this form for proposals to drill or to re-enter an abandoned well. Use form 3160-3 (APD) for such proposals.

FORM APPROVED
OMB NO. 1004-0135
Expires: July 31, 2010

5. Lease Serial No.
NMNM2748

6. If Indian, Allottee or Tribe Name

7. If Unit or CA/Agreement, Name and/or No.

8. Well Name and No.
GISSLER B 91

9. API Well No.
30-015-41001-00-S1

10. Field and Pool, or Exploratory
LOCO HILLS-QU-GB-SA

11. County or Parish, and State
EDDY COUNTY, NM

SUBMIT IN TRIPLICATE - Other instructions on reverse side.

1. Type of Well

☒ Oil Well ☐ Gas Well ☐ Other

2. Name of Operator
BURNETT OIL COMPANY INC

Contact: LESLIE GARVIS
E-Mail: lgarvis@burnettoil.com

3a. Address
801 CHERRY STREET UNIT 9
FORT WORTH, TX 76102-6881

3b. Phone No. (include area code)
Ph: 817-583-8730

4. Location of Well (Footage, Sec., T., R., M., or Survey Description)
Sec 11 T17S R30E SESW 1265FSL 1626FWL

12. CHECK APPROPRIATE BOX(ES) TO INDICATE NATURE OF NOTICE, REPORT, OR OTHER DATA

TYPE OF SUBMISSION	TYPE OF ACTION			
<input type="checkbox"/> Notice of Intent	<input type="checkbox"/> Acidize	<input type="checkbox"/> Deepen	<input type="checkbox"/> Production (Start/Resume)	<input type="checkbox"/> Water Shut-Off
<input checked="" type="checkbox"/> Subsequent Report	<input type="checkbox"/> Alter Casing	<input type="checkbox"/> Fracture Treat	<input type="checkbox"/> Reclamation	<input type="checkbox"/> Well Integrity
<input type="checkbox"/> Final Abandonment Notice	<input type="checkbox"/> Casing Repair	<input type="checkbox"/> New Construction	<input type="checkbox"/> Recomplete	<input checked="" type="checkbox"/> Other
	<input type="checkbox"/> Change Plans	<input type="checkbox"/> Plug and Abandon	<input type="checkbox"/> Temporarily Abandon	Change to Original APD
	<input type="checkbox"/> Convert to Injection	<input type="checkbox"/> Plug Back	<input type="checkbox"/> Water Disposal	

13. Describe Proposed or Completed Operation (clearly state all pertinent details, including estimated starting date of any proposed work and approximate duration thereof. If the proposal is to deepen directionally or recomplete horizontally, give subsurface locations and measured and true vertical depths of all pertinent markers and zones. Attach the Bond under which the work will be performed or provide the Bond No. on file with BLM/BIA. Required subsequent reports shall be filed within 30 days following completion of the involved operations. If the operation results in a multiple completion or recompletion in a new interval, a Form 3160-4 shall be filed once testing has been completed. Final Abandonment Notices shall be filed only after all requirements, including reclamation, have been completed, and the operator has determined that the site is ready for final inspection.)

Burnett is requesting a variance to the original APD Interim Reclamation Plat. The actual interim reclamation was completed but varies from the original specifications in the APD. I have attached a copy of the as built reclamation plat. We reclaimed approximately 20' more than the original design called for.

See attached as built interim reclamation plat.

Accepted for record
NMOCB
R.L.B.

14. I hereby certify that the foregoing is true and correct.

Electronic Submission #346888 verified by the BLM Well Information System
For BURNETT OIL COMPANY INC, sent to the Carlsbad
Committed to AFMSS for processing by PRISCILLA PEREZ on 08/12/2016 (16PP2023SE)

Name (Printed/Typed) LESLIE GARVIS

Title REGULATORY COORDINATOR

Signature (Electronic Submission)

Date 08/04/2016

THIS SPACE FOR FEDERAL OR STATE OFFICE USE

Approved By <u>James C. Peters</u>	Title <u>SPEET</u>	Date <u>3.20.17</u>
Conditions of approval, if any, are attached. Approval of this notice does not warrant or certify that the applicant holds legal or equitable title to those rights in the subject lease which would entitle the applicant to conduct operations thereon.	Office <u>CFD</u>	

Title 18 U.S.C. Section 1001 and Title 43 U.S.C. Section 1212, make it a crime for any person knowingly and willfully to make to any department or agency of the United States any false, fictitious or fraudulent statements or representations as to any matter within its jurisdiction.

**** BLM REVISED ** BLM REVISED ** BLM REVISED ** BLM REVISED ** BLM REVISED ****


Inspection Form Attached

BURNETT OIL CO., INC.
AS BUILT INTERIM RECLAMATION

GISSLER B 91

1265' FSL, 1626' FWL

SEC 11, T17S, R30E

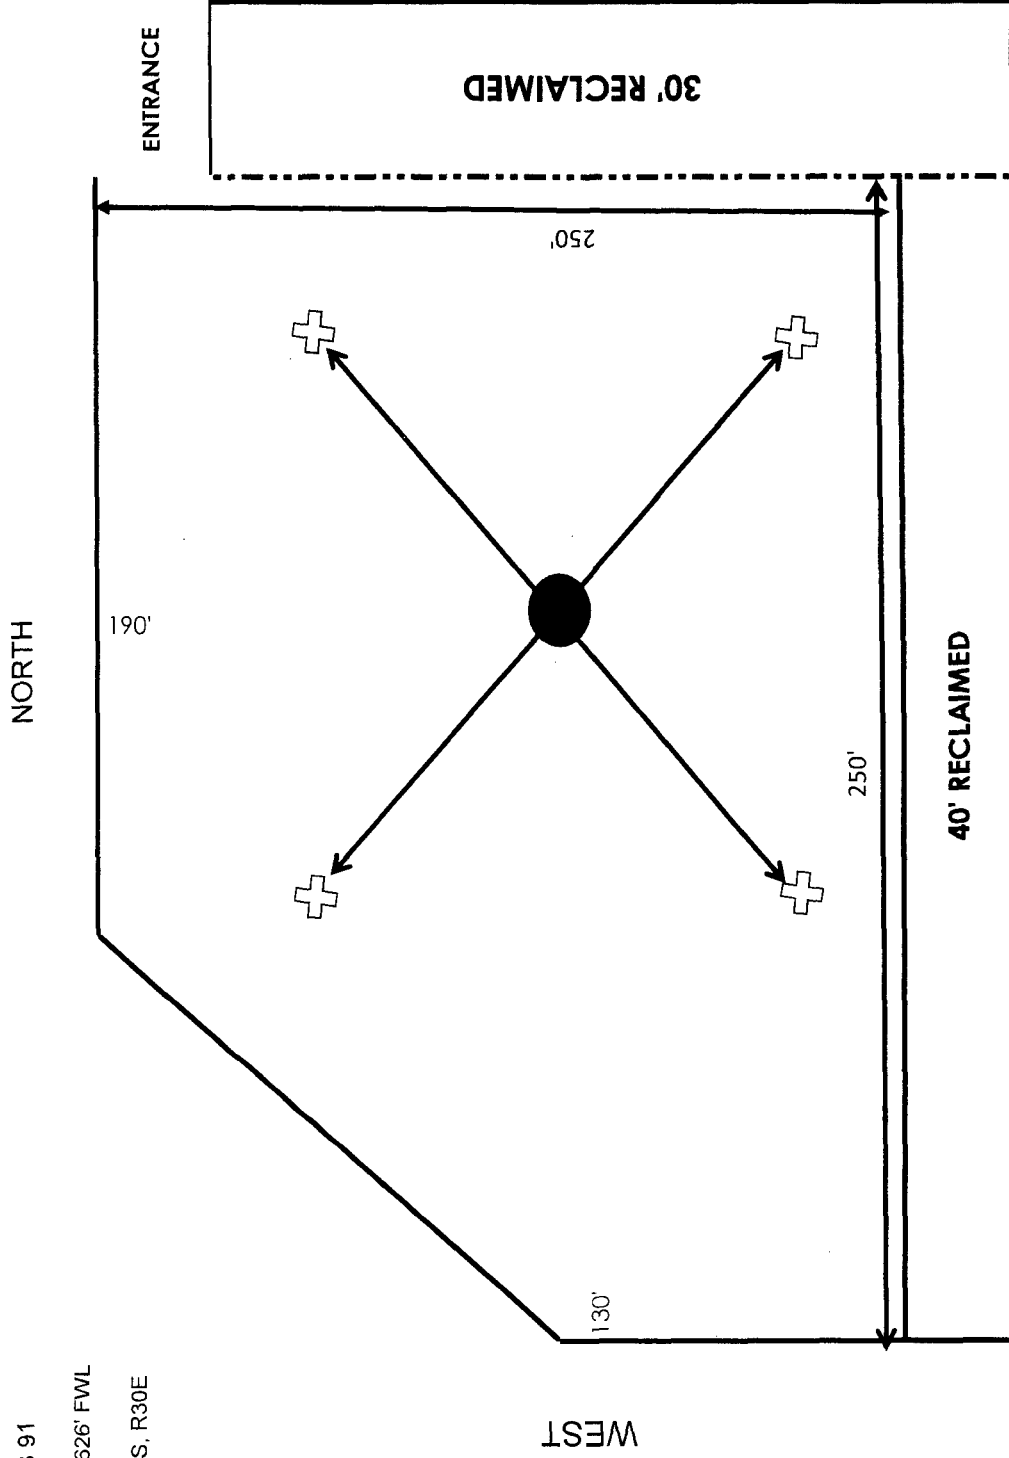

ANCHOR
WELLHEAD

75' FROM WELLHEAD TO ANCHORS

NOT TO SCALE