

UNITED STATES
DEPARTMENT OF THE INTERIOR
BUREAU OF LAND MANAGEMENT

FORM APPROVED
OMB NO. 1004-0135
Expires: July 31, 2010

SUNDRY NOTICES AND REPORTS ON WELLS
Do not use this form for proposals to drill or to re-enter an abandoned well. Use form 3160-3 (APD) for such proposals.

OCD-ARTESIA

SUBMIT IN TRIPLICATE - Other instructions on reverse side.

1. Type of Well <input checked="" type="checkbox"/> Oil Well <input type="checkbox"/> Gas Well <input type="checkbox"/> Other	8. Well Name and No. SANTA FE FEDERAL 8 SWD
2. Name of Operator RKI EXPLORATION&PRODUCTION LLC Contact: JESSICA M DEMARCE Email: jessica.demarce@wpenergy.com	9. API Well No. 30-015-27126
3a. Address 3500 ONE WILLIAMS CENTER MD35 TULSA, OK 74172	10. Field and Pool, or Exploratory EAST HERRADURA BEND
3b. Phone No. (include area code) Ph: 539-573-3521	11. County or Parish, and State EDDY COUNTY, NM
4. Location of Well (Footage, Sec., T., R., M., or Survey Description) Sec 35 T22S R28E 760FNL 460FEL	

12. CHECK APPROPRIATE BOX(ES) TO INDICATE NATURE OF NOTICE, REPORT, OR OTHER DATA

TYPE OF SUBMISSION	TYPE OF ACTION
<input type="checkbox"/> Notice of Intent	<input type="checkbox"/> Acidize
<input checked="" type="checkbox"/> Subsequent Report	<input type="checkbox"/> Deepen
<input type="checkbox"/> Final Abandonment Notice	<input type="checkbox"/> Fracture Treat
	<input type="checkbox"/> Production (Start/Resume)
	<input type="checkbox"/> Reclamation
	<input type="checkbox"/> Water Shut-Off
	<input type="checkbox"/> Well Integrity
	<input checked="" type="checkbox"/> Other
	Site Facility Diagram/Security Plan
	<input type="checkbox"/> Alter Casing
	<input type="checkbox"/> New Construction
	<input type="checkbox"/> Recombine
	<input type="checkbox"/> Plug and Abandon
	<input type="checkbox"/> Temporarily Abandon
	<input type="checkbox"/> Water Disposal
	<input type="checkbox"/> Change Plans
	<input type="checkbox"/> Plug Back
	<input type="checkbox"/> Convert to Injection

13. Describe Proposed or Completed Operation (clearly state all pertinent details, including estimated starting date of any proposed work and approximate duration thereof. If the proposal is to deepen directionally or recomple horizontally, give subsurface locations and measured and true vertical depths of all pertinent markers and zones. Attach the Bond under which the work will be performed or provide the Bond No. on file with BLM/BIA. Required subsequent reports shall be filed within 30 days following completion of the involved operations. If the operation results in a multiple completion or recomple in a new interval, a Form 3160-4 shall be filed once testing has been completed. Final Abandonment Notices shall be filed only after all requirements, including reclamation, have been completed, and the operator has determined that the site is ready for final inspection.)

Attached are updated SFD from 10/18/2016 and updated ABSM from 10/18/2016.

ENTERED 2/3/17
INTO AFMSS

Accepted for record - NMOCB
BC 4-11-17

Accepted for Record Purposes.
Approval Subject to Onsite Inspection.
Date: 2/3/17

OIL CONSERVATION
ARTESIA DISTRICT

14. I hereby certify that the foregoing is true and correct.

Electronic Submission #355521 verified by the BLM Well Information System
For RKI EXPLORATION&PRODUCTION LLC, sent to the Carlsbad
Committed to AFMSS for processing by DEBORAH MCKINNEY on 10/21/2016 ()

Name (Printed/Typed) JESSICA M DEMARCE	Title REGULATORY TECHNICIAN	APR 10 2017
Signature (Electronic Submission)	Date 10/21/2016	RECEIVED

THIS SPACE FOR FEDERAL OR STATE OFFICE USE

Approved By <u>Jessica Demarce</u>	Title <u>EPS, UE</u>	Date <u>2/3/17</u>
Conditions of approval, if any, are attached. Approval of this notice does not warrant or certify that the applicant holds legal or equitable title to those rights in the subject lease which would entitle the applicant to conduct operations thereon.		Office


Title 18 U.S.C. Section 1001 and Title 43 U.S.C. Section 1212, make it a crime for any person knowingly and willfully to make to any department or agency of the United States any false, fictitious or fraudulent statements or representations as to any matter within its jurisdiction.

** OPERATOR-SUBMITTED ** OPERATOR-SUBMITTED ** OPERATOR-SUBMITTED **

LEGEND

UC	UNDERGROUND
AG	ABOVE GROUND
UP	UTILITY POLE
EP	ELECTRICAL PANEL/BOX
SP	SOLAR PANEL
GEN	GENERATOR
---	OVERHEAD POWER LINE
---	ELECTRIC LINE (UG)
---	ELECTRIC LINE (AG)
---	OIL FLOWLINE (UG)
---	OIL FLOWLINE (AG)
---	RECYCLE FLOWLINE (UG)
---	RECYCLE FLOWLINE (AG)
---	WATER FLOWLINE (UG)
---	WATER FLOWLINE (AG)
---	GAS FLOWLINE (UG)
---	GAS FLOWLINE (AG)
---	UNKNOWN FLOWLINE (UG)
---	UNKNOWN FLOWLINE (AG)
---	EDGE OF PAD
---	FENCE
(FWK)	FREE WATER KNOCKOUT
(L)	LOAD OUT VALVE (OIL)
(W)	LOAD OUT VALVE (WATER)
(M)	METER
(P)	PUMPING UNIT
(R)	RECYCLE PUMP
(S)	SEPARATOR
(T)	TANK (OIL)
(TW)	TANK (WATER)
(B)	BUILDING
(C)	COMBUSTOR
(HT)	HEATER TREATER
(F)	FLARE
(FS)	FLARE SEPARATOR
(W)	WELLHEAD
(SC)	SURVEY CONTROL POINT
(W)	WELD
(R)	RISER (SIZE)
(S)	STAIRS
(TP)	TRANSFER PUMP

SANTA FE FEDERAL 8 SWD
1"=40'

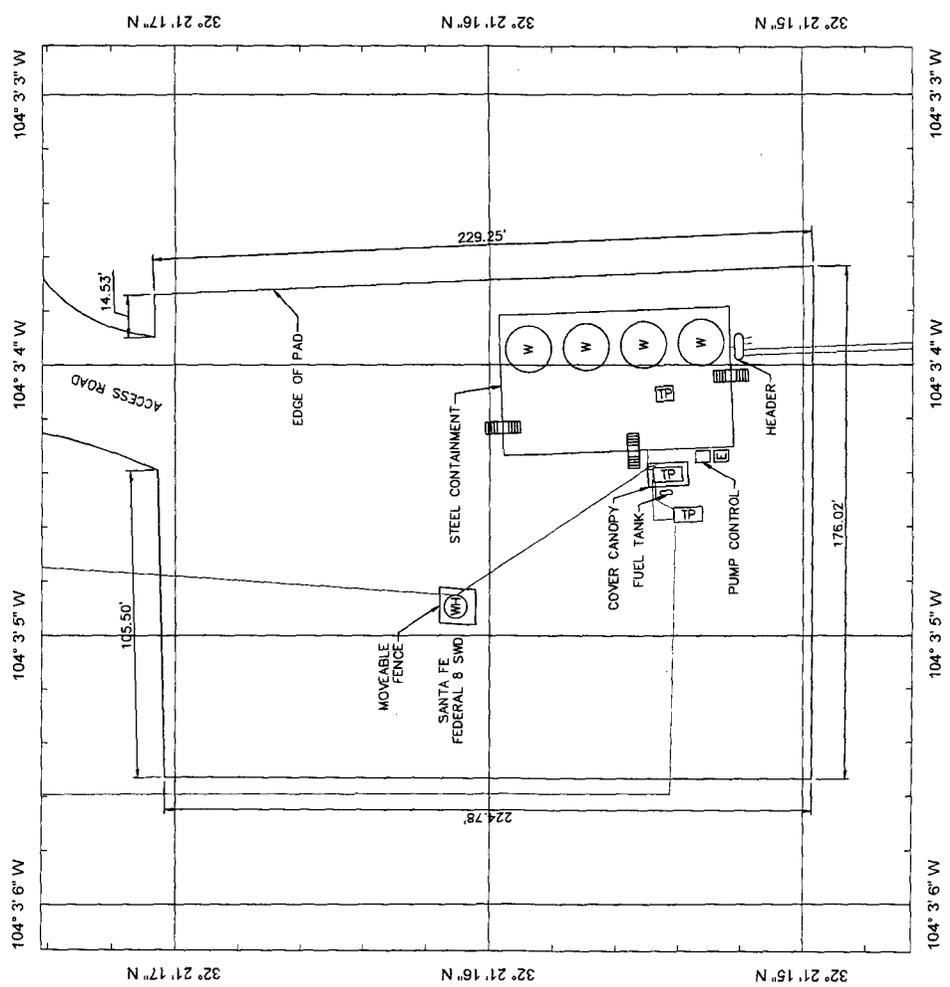

K
CONSTRUCTION
AS-BUILT SITE MAP
EDDY COUNTY, N.M.

DATE: 10/19/2016
SCALE: 1" = 40'
PROJECT: SANTA FE FEDERAL 8 SWD
WELL SITE

NO.	DATE	PROJECT DESCRIPTION	PROJ. FILE	BY	CHKD.	APPR.	ISSUE STATUS	DATE	REV. #	DESCRIPTION
1	10/19/2016	SANTA FE FEDERAL 8 SWD					AS-BUILT		1	AS-BUILT SITE MAP

Accepted for Record Purposes
Approved Date: 10/19/2016
Page:

WPX ENERGY
 FEDERAL 8 SWD
 SANTA FE FEDERAL 8 SWD
 760' FILL & 460' FILL
 UNIT A, SEC. 35-7225-R2BE
 ADJ. 30-015-2712B
 EDDY COUNTY, NEW MEXICO

General setting of valves, sales by tank gauge.

Production Phases: Sales valves --- and --- sealed closed. Fill valve to tank is open. Circulating valves will be open. Equalizer valves to tank that is in production will be open. Circulating valves will be opened as necessary, then released.

Sales Phases: The tank from which sales are being made will be isolated by sealing opening the sales valve. Upon completion of the sale the sales valve will be released. Sales by truck will be by tank gauge.

Valves:
 E1 Open
 E2 Open
 E3 Open

Recirculation Phases:
 Closed
 Closed
 Closed


Sales Phases:
 Closed
 Closed
 Closed

Circulation:
 Closed
 Closed
 Closed

The Site Security Plan is kept at WPX's office located at:
 5315 Buena Vista Dr. Coriobad, NM.

SANTA FE FEDERAL 8 SWD
 N.T.S.

ACCESS ROAD

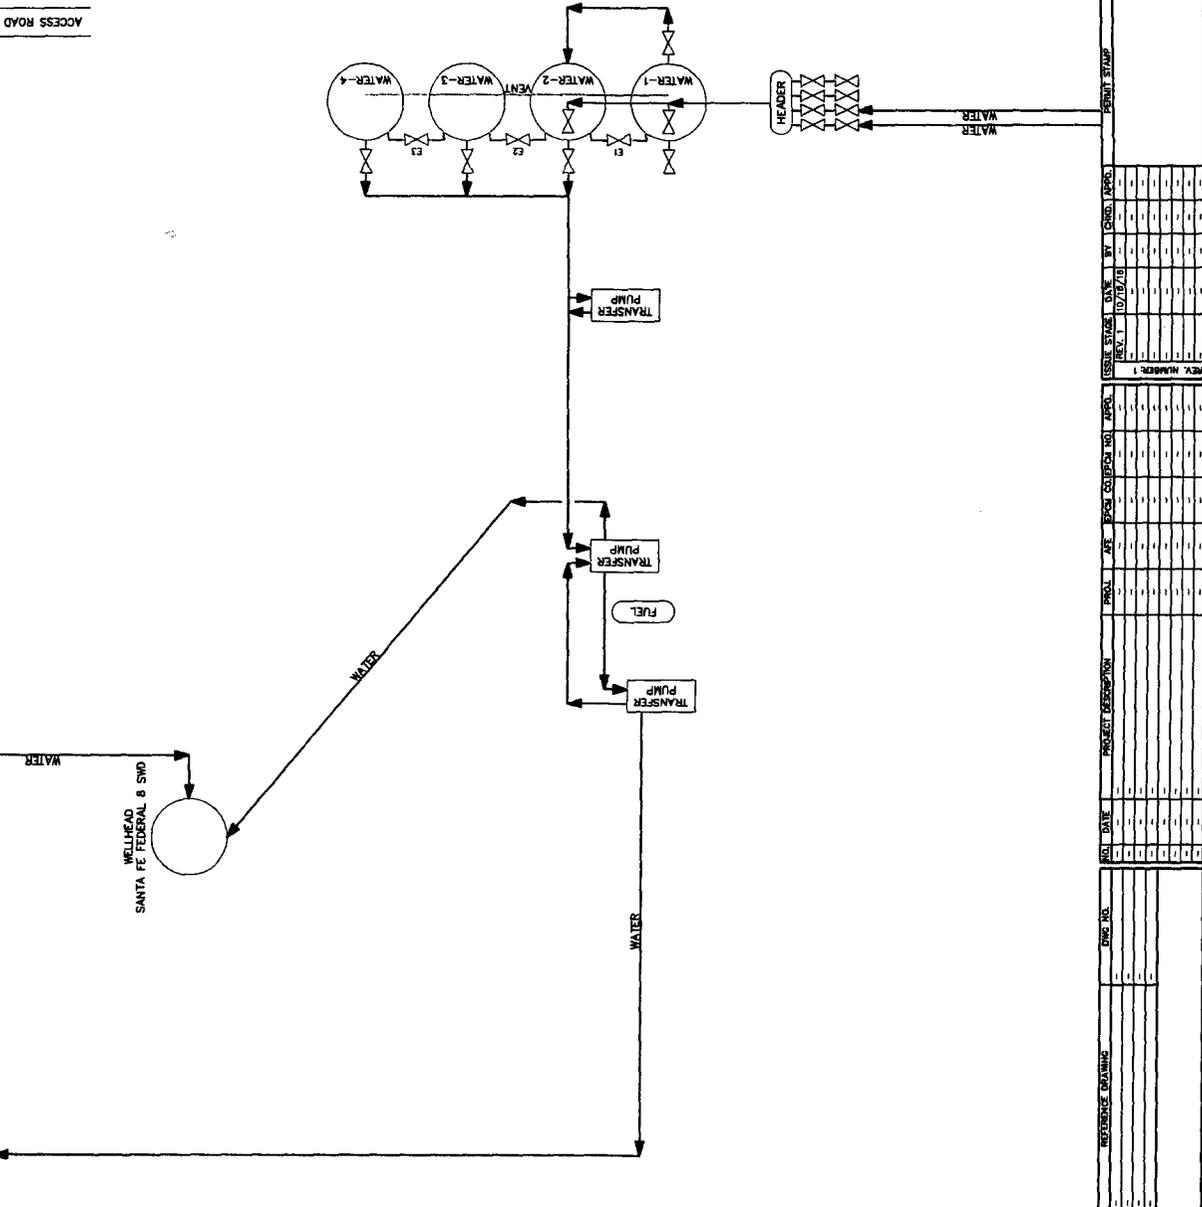

WPX ENERGY
 SITE FACILITY DIAGRAM
 EDDY COUNTY, NEW MEXICO

REV. NUMBER	DATE	BY	CHKD.	APPD.	PROJECT DESCRIPTION	PROJ. #	DATE	APPD.	ISSUE STATUS	DATE	BY	CHKD.	APPD.	ENGINEER'S STAMP
1	10/26/19													

Handwritten notes and signatures at the bottom of the page.