

UNITED STATES
DEPARTMENT OF THE INTERIOR
BUREAU OF LAND MANAGEMENT

FORM APPROVED
OMB NO. 1004-0135
Expires: July 31, 2010

SUNDRY NOTICES AND REPORTS ON WELLS
Do not use this form for proposals to drill or to re-enter an abandoned well. Use form 3160-3 (APD) for such proposals.

000-ARTESIA

5. Lease Serial No.
NMNM88115

6. If Indian, Allottee or Tribe Name

7. If Unit or CA/Agreement, Name and/or No.

SUBMIT IN TRIPLICATE - Other instructions on reverse side.

1. Type of Well
 Oil Well Gas Well Other

8. Well Name and No.
DALL FEDERAL 1

2. Name of Operator
RKI EXPLORATION & PROD LLC
Contact: JESSICA M DEMARCE
E-Mail: jessica.demarce@wpenergy.com

9. API Well No.
30-015-27632-00-S1

3a. Address
3500 ONE WILLIAMS CENTER MD 35
TULSA, OK 74172

3b. Phone No. (include area code)
Ph: 539-573-3521

10. Field and Pool, or Exploratory
HAPPY VALLEY

4. Location of Well (Footage, Sec., T., R., M., or Survey Description)
Sec 33 T22S R26E NESW 1980FSL 1980FWL

11. County or Parish, and State
EDDY COUNTY, NM

12. CHECK APPROPRIATE BOX(ES) TO INDICATE NATURE OF NOTICE, REPORT, OR OTHER DATA

TYPE OF SUBMISSION	TYPE OF ACTION			
<input type="checkbox"/> Notice of Intent	<input type="checkbox"/> Acidize	<input type="checkbox"/> Deepen	<input type="checkbox"/> Production (Start/Resume)	<input type="checkbox"/> Water Shut-Off
<input checked="" type="checkbox"/> Subsequent Report	<input type="checkbox"/> Alter Casing	<input type="checkbox"/> Fracture Treat	<input type="checkbox"/> Reclamation	<input type="checkbox"/> Well Integrity
<input type="checkbox"/> Final Abandonment Notice	<input type="checkbox"/> Casing Repair	<input type="checkbox"/> New Construction	<input type="checkbox"/> Recomplete	<input checked="" type="checkbox"/> Other
	<input type="checkbox"/> Change Plans	<input type="checkbox"/> Plug and Abandon	<input type="checkbox"/> Temporarily Abandon	Site Facility Diagram/Security Plan
	<input type="checkbox"/> Convert to Injection	<input type="checkbox"/> Plug Back	<input type="checkbox"/> Water Disposal	

13. Describe Proposed or Completed Operation (clearly state all pertinent details, including estimated starting date of any proposed work and approximate duration thereof. If the proposal is to deepen directionally or recompleat horizontally, give subsurface locations and measured and true vertical depths of all pertinent markers and zones. Attach the Bond under which the work will be performed or provide the Bond No. on file with BLM/BIA. Required subsequent reports shall be filed within 30 days following completion of the involved operations. If the operation results in a multiple completion or recompleat in a new interval, a Form 3160-4 shall be filed once testing has been completed. Final Abandonment Notices shall be filed only after all requirements, including reclamation, have been completed, and the operator has determined that the site is ready for final inspection.)

Attached are updated SFD from 10/11/2016 and updated ABSM from 10/11/2016.

ENTERED 2/3/17
INTO AFMSS

Accepted for record - NMOCD
BC 4-11-17

Accepted for Record Purposes.
Approval Subject to Onsite Inspection.
Date: 2/3/17

WATER CONSERVATION
ARTESIA DISTRICT
APR 10 2017
RECEIVED

14. I hereby certify that the foregoing is true and correct.

Electronic Submission #354969 verified by the BLM Well Information System
For RKI EXPLORATION & PROD LLC, sent to the Carlsbad
Committed to AFMSS for processing by PRISCILLA PEREZ on 10/17/2016 (17PP0051SE)

Name (Printed/Typed) JESSICA M DEMARCE Title REGULATORY TECH

Signature (Electronic Submission) Date 10/17/2016


THIS SPACE FOR FEDERAL OR STATE OFFICE USE

Approved By *Jessica Demarce* Title EPS. UIC Date 2/3/17

Conditions of approval, if any, are attached. Approval of this notice does not warrant or certify that the applicant holds legal or equitable title to those rights in the subject lease which would entitle the applicant to conduct operations thereon.

Office

Title 18 U.S.C. Section 1001 and Title 43 U.S.C. Section 1212, make it a crime for any person knowingly and willfully to make to any department or agency of the United States any false, fictitious or fraudulent statements or representations as to any matter within its jurisdiction.

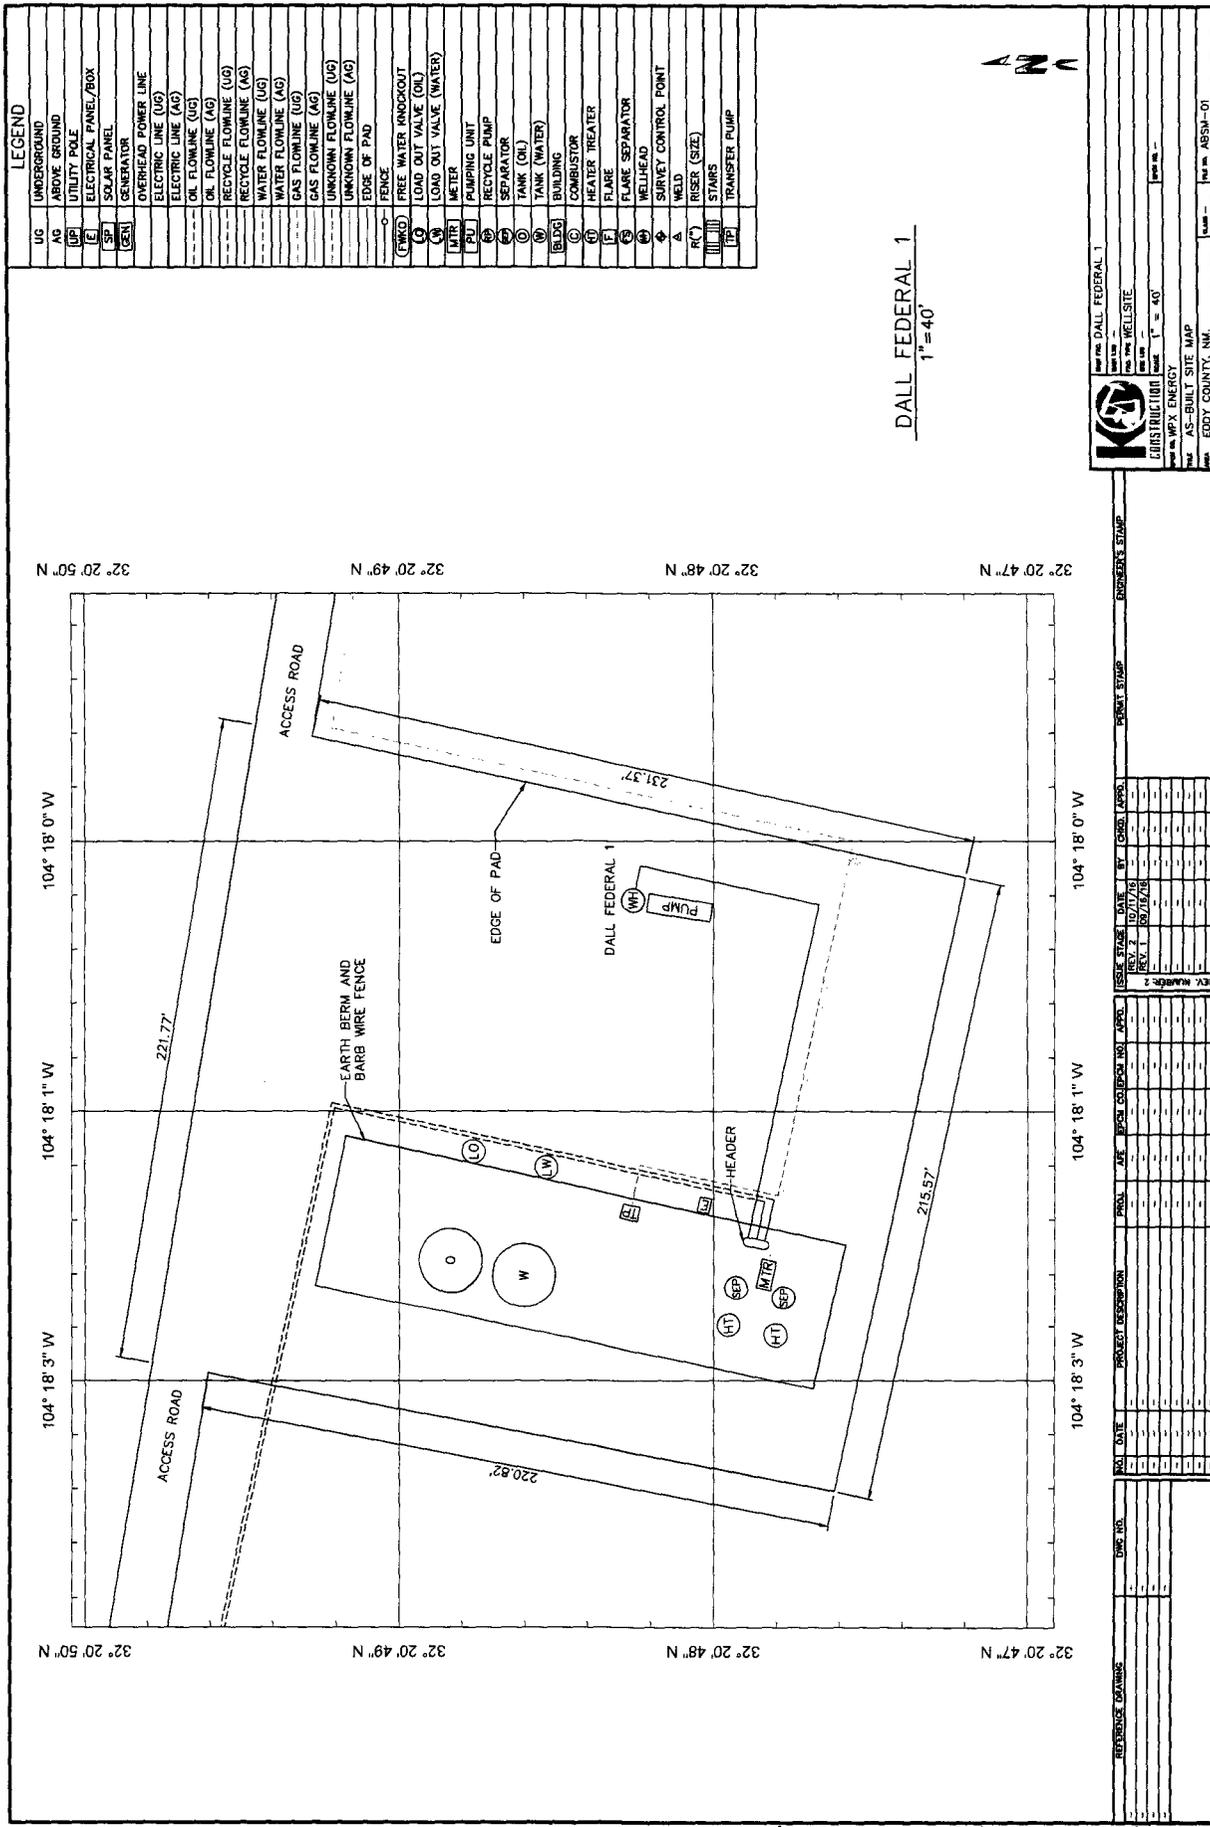

LEGEND

UG	UNDERGROUND
AG	ABOVE GROUND
UP	UTILITY POLE
EP	ELECTRICAL PANEL/BOX
SP	SOLAR PANEL
GEN	GENERATOR
OP	OVERHEAD POWER LINE
EL	ELECTRIC LINE (UG)
EL	ELECTRIC LINE (AG)
FL	OIL FLOWLINE (UG)
FL	OIL FLOWLINE (AG)
RF	RECYCLE FLOWLINE (UG)
RF	RECYCLE FLOWLINE (AG)
WF	WATER FLOWLINE (UG)
WF	WATER FLOWLINE (AG)
GF	GAS FLOWLINE (UG)
GF	GAS FLOWLINE (AG)
UF	UNKNOWN FLOWLINE (UG)
UF	UNKNOWN FLOWLINE (AG)
○	EDGE OF PAD
○	FENCE
○	FREE WATER KNOCKOUT
○	LOAD OUT VALVE (OIL)
○	LOAD OUT VALVE (WATER)
MTR	METER
PUMP	PUMPING UNIT
SEP	RECYCLE PUMP
SEP	SEPARATOR
TANK	TANK (OIL)
TANK	TANK (WATER)
BLDG	BUILDING
CB	COMBUSTOR
HT	HEATER TREATER
FL	FLARE
FS	FLARE SEPARATOR
WH	WELLHEAD
SC	SAFETY CONTROL POINT
WELD	WELD
R(S)	RISER (SIZE)
STAIRS	STAIRS
TP	TRANSFER PUMP

DALL FEDERAL 1
1"=40'



DALL FEDERAL 1

DATE: 10/17/18
 REV. 1: 10/17/18
 REV. 2: 10/17/18

PROJECT: WPE ENERGY
 AS-BUILT SITE MAP
 EDDY COUNTY, NM

SCALE: 1"=40'

DESIGNER'S STAMP
 ENGINEER'S STAMP

WFX ENERGY
 DALL FEDERAL 1
 1900 P.O. BOX 1900
 1900 P.O. BOX 1900
 LEASE # NN-88115
 EDDY COUNTY, NEW MEXICO

General setting of valves, sales by tank gauge.

Production Phase: Sales valve S1 sealed closed. Fill valve to tank that is in production will be open. Equalizer valve to tank that is in production will be open. Circulating valves will be opened as necessary, then released.

Sales Phase: The tank from which sales are being made will be isolated by sealing closed the fill valve, circulating valve and the equalizer valve during sales and opening the sales valve. Sales by truck will be by tank gauge.


Valves:
 F1
 F1
 F1

Production Phase:
 Open or Closed
 Open or Closed
 Open or Closed

Sales Phase:
 Closed
 Closed
 Closed or Open

Calculating:
 Closed
 Closed or Open

The Site Security Plan is kept at WFX's office located at:
 5315 Buena Vista Dr. Corrao, NM.

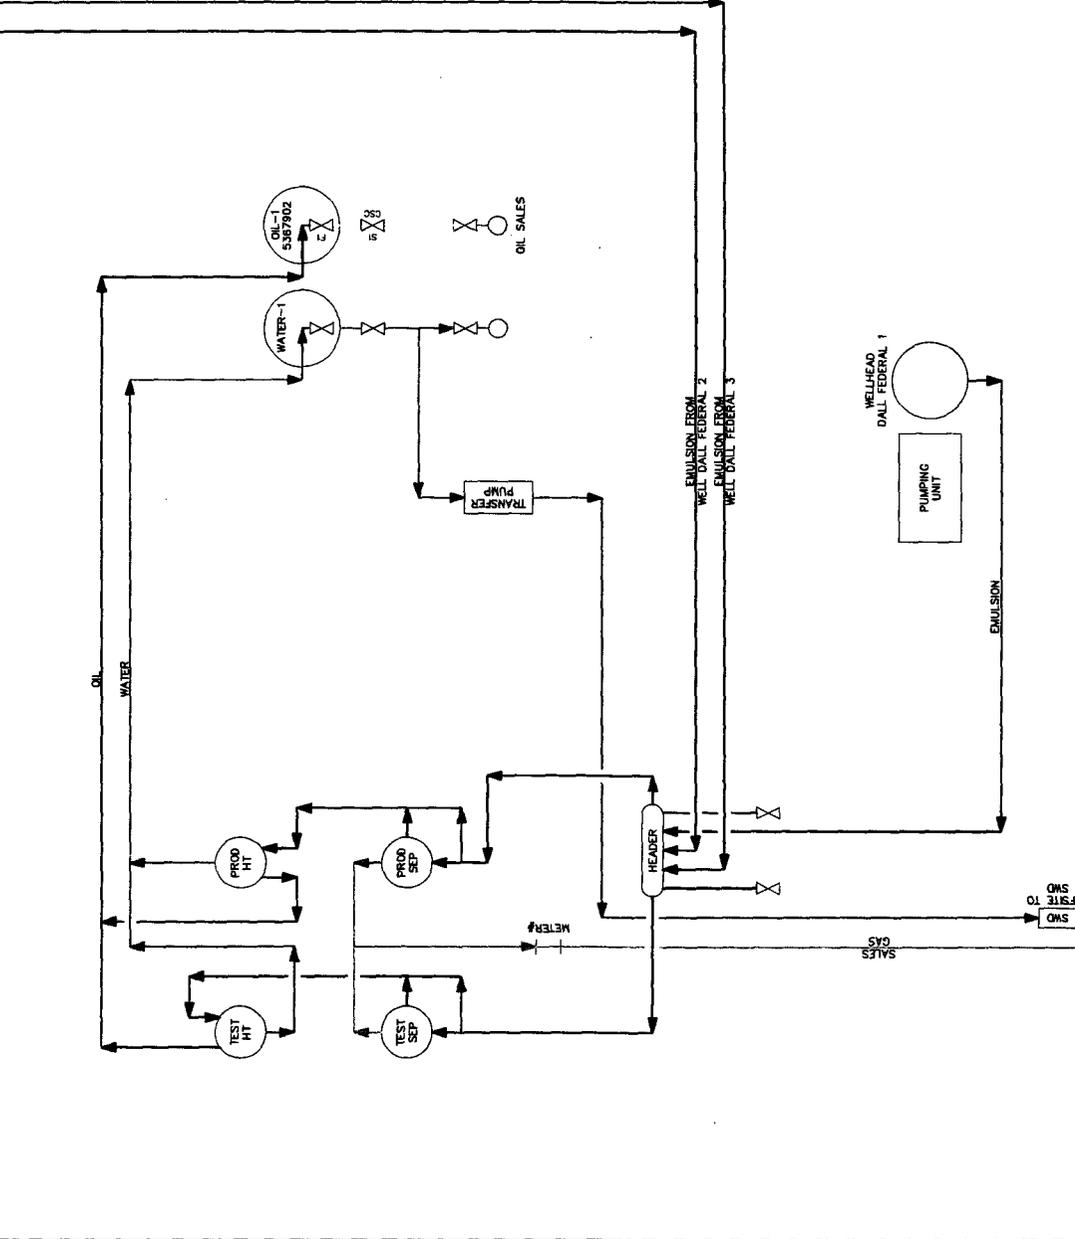

DALL FEDERAL 1
 N.T.S.

		DALL FEDERAL 1 WELL SITE	
WFX ENERGY SITE FACILITY DIAGRAM EDDY COUNTY, NEW MEXICO		SHEET NO. SFD-01	
ISSUE NO. REV. 1 REV. 2	DATE 10/11/16 10/11/16	BY J. GARDNER J. GARDNER	APPROV.
PROJECT DESCRIPTION DALL FEDERAL 1	PICAL ARE FROM COLLECTION NO.	APPROV.	ENGINEER'S STAMP
SHEET NO.	OFFSITE TO SHD	SHD GAS	SALES GAS