

Submit 1 Copy To Appropriate District Office
District I – (575) 393-6161
1625 N. French Dr., Hobbs, NM 88240
District II – (575) 748-1283
811 S. First St., Artesia, NM 88210
District III – (505) 334-6178
1000 Rio Brazos Rd., Aztec, NM 87410
District IV – (505) 476-3460
1220 S. St. Francis Dr., Santa Fe, NM 87505

State of New Mexico
Energy, Minerals and Natural Resources

Form C-103
Revised July 18, 2013

OIL CONSERVATION DIVISION
1220 South St. Francis Dr.
Santa Fe, NM 87505

WELL API NO. 30-043-35530
5. Indicate Type of Lease STATE ☒ FEE ☐
6. State Oil & Gas Lease No. VO-5292, B-10889
7. Lease Name or Unit Agreement Name PinonUnit
8. Well Number 302H
9. OGRID Number 282327
10. Pool name or Wildcat PinonUnit Hz (Oil) Pool
11. Elevation (Show whether DR, RKB, RT, GR, etc.) 6924' GR

SUNDRY NOTICES AND REPORTS ON WELLS
(DO NOT USE THIS FORM FOR PROPOSALS TO DRILL OR TO DEEPEN OR PLUG BACK TO A DIFFERENT RESERVOIR. USE "APPLICATION FOR PERMIT" (FORM C-101) FOR SUCH PROPOSALS.)

1. Type of Well: Oil Well ☒ Gas Well ☐ Other ☐

2. Name of Operator
Encana Oil & Gas (USA) Inc.

3. Address of Operator
370 17th Street, Suite 1700, Denver CO 80202

4. Well Location

Unit Letter D : 1348 feet from the North line and 436 feet from the West line
Section 14 Township 24N Range 10W NMPM San Juan County

12. Check Appropriate Box to Indicate Nature of Notice, Report or Other Data

NOTICE OF INTENTION TO:

PERFORM REMEDIAL WORK ☐ PLUG AND ABANDON ☐
TEMPORARILY ABANDON ☐ CHANGE PLANS ☐
PULL OR ALTER CASING ☐ MULTIPLE COMPL ☐
DOWNHOLE COMMINGLE ☐
CLOSED-LOOP SYSTEM ☐
OTHER: ☐

SUBSEQUENT REPORT OF:

REMEDIAL WORK ☐ ALTERING CASING ☐
COMMENCE DRILLING OPNS. ☐ P AND A ☐
CASING/CEMENT JOB ☐
OTHER: Unit Well Re-naming ☒

13. Describe proposed or completed operations. (Clearly state all pertinent details, and give pertinent dates, including estimated date of starting any proposed work). SEE RULE 19.15.7.14 NMAC. For Multiple Completions: Attach wellbore diagram of proposed completion or recompletion.

Encana is submitting the following Well Name change and Well Number change for this well per OCD order R-13857, effective 07/03/14. The Well Name and Well Number will change from the Pinon Unit D14-2410 02H to the Pinon Unit 302H. The Well Name and Well Number changes were approved by the BLM on 05/27/15 (see previous sundry on Federal form).

Spud Date:

11/03/14

Rig Release Date:

11/12/14

I hereby certify that the information above is true and complete to the best of my knowledge and belief.

SIGNATURE Holly Hill TITLE Senior Regulatory Analyst DATE July 23, 2015

Type or print name Holly Hill E-mail address: holly.hill@encana.com PHONE: 720-876-5331

For State Use Only

APPROVED BY [Signature] TITLE Line Manager II DATE 9-8-15
Conditions of Approval (if any):

DISTRICT I

1625 N. French Dr., Hobbs, N.M. 88240
Phone: (575) 393-6161 Fax: (575) 393-0720

DISTRICT II

811 S. First St., Artesia, N.M. 88210
Phone: (575) 748-1283 Fax: (575) 748-9720

DISTRICT III

1000 Rio Brazos Rd., Artec, N.M. 87410
Phone: (505) 334-6178 Fax: (505) 334-6170

DISTRICT IV

1220 S. St. Francis Dr., Santa Fe, NM 87505
Phone: (505) 476-3460 Fax: (505) 476-3462

State of New Mexico
Energy, Minerals & Natural Resources Department

Form C-102
Revised August 1, 2011

Submit one copy to appropriate
District Office

OIL CONSERVATION DIVISION

1220 South St. Francis Dr.
Santa Fe, NM 87505

☐ AMENDED REPORT

☒ AS-DRILLED

WELL LOCATION AND ACREAGE DEDICATION PLAT

¹ API Number 30-045-35530		² Pool Code 98102	³ Pool Name Pinon Unit HZ (Oil)
⁴ Property Code 313588 315245	⁵ Property Name PINON UNIT		⁶ Well Number 302H
⁷ OGRID No. 282327	⁸ Operator Name ENCANA OIL & GAS (USA) INC.		⁹ Elevation 6876.9'

¹⁰ Surface Location

UL or lot no.	Section	Township	Range	Lot Idn	Feet from the	North/South line	Feet from the	East/West line	County
E	14	24N	10W		1348'	NORTH	436'	WEST	SAN JUAN

¹¹ Bottom Hole Location If Different From Surface

UL or lot no.	Section	Township	Range	Lot Idn	Feet from the	North/South line	Feet from the	East/West line	County
B	16	24N	10W		2228'	NORTH	292'	EAST	SAN JUAN

¹² Dedicated Acres - 640 ACRES
8,005.44 ACRES W/2 OF SEC. 4, SEC. 5-10,
15-18, 21, N/2 OF SEC. 22, & N/2 OF
SEC. 28 - UNDIVIDED UNIT, PENETRATED
SPACING UNITS: N/2 SEC. 15, E/2 SEC. 16 (640 ACRES)

¹³ Joint or Infill¹⁴ Consolidation Code¹⁵ Order No.

R - 13857-A (8,005.44 Acres)


NO ALLOWABLE WILL BE ASSIGNED TO THIS COMPLETION UNTIL ALL INTERESTS HAVE BEEN CONSOLIDATED
OR A NON-STANDARD UNIT HAS BEEN APPROVED BY THE DIVISION

16

OIL CONS. DIV DIST. 3

JUN 04 2015

ASB WELL HEAD
LAT. 36.317553° N (NAD83)
LONG. 107.873085° W (NAD83)
LAT. 36.317542° N (NAD27)
LONG. 107.872467° W (NAD27)

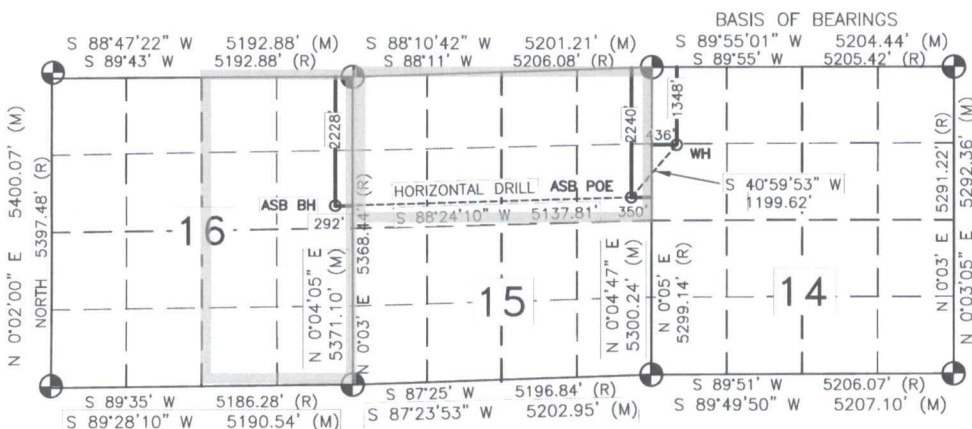

ASB - BHL
LAT. 36.314669° N (NAD83)
LONG. 107.893180° W (NAD83)
LAT. 36.314658° N (NAD27)
LONG. 107.892561° W (NAD27)

ASB - POE
LAT. 36.315067° N (NAD83)
LONG. 107.875754° W (NAD83)
LAT. 36.315055° N (NAD27)
LONG. 107.875136° W (NAD27)

17 OPERATOR CERTIFICATION

I hereby certify that the information contained herein is true and complete to the best of my knowledge and belief, and that this organization either owns a working interest or unleased mineral interest in the land including the proposed bottom hole location or has a right to drill this well at this location pursuant to a contract with an owner of such a mineral or working interest, or to a voluntary pooling agreement or a compulsory pooling order heretofore entered by the division.

Signature: *Katie Wegner* Date: 05/06/15

Printed Name: Katie Wegner

E-mail Address: katie.wegner@encana.com

SURVEYOR CERTIFICATION


I hereby certify that the well location shown on this plat was plotted from field notes of actual surveys made by me or under my supervision, and that the same is true and correct to the best of my belief.

AS-BUILT SURVEY JANUARY 20, 2015

Date of Survey

JUNE 18, 2013

Signature and Seal of Professional Surveyor:

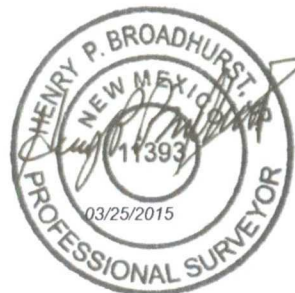

Certificate Number

11393

DISTRICT I

1625 N. French Dr., Hobbs, N.M. 88240
Phone: (575) 393-6161 Fax: (575) 393-0720

DISTRICT II

811 S. First St., Artesia, N.M. 88210
Phone: (575) 748-1283 Fax: (575) 748-9720

DISTRICT III

1000 Rio Bravos Rd., Artec, N.M. 87410
Phone: (505) 334-6178 Fax: (505) 334-6170

DISTRICT IV

1220 S. St. Francis Dr., Santa Fe, NM 87505
Phone: (505) 476-3480 Fax: (505) 476-3462

State of New Mexico
Energy, Minerals & Natural Resources Department

Form C-102
Revised August 1, 2011

OIL CONSERVATION DIVISION

1220 South St. Francis Dr.
Santa Fe, NM 87505

Submit one copy to appropriate
District Office

☒ AS-DRILLED

ENCANA OIL & GAS (USA) INC.
PINON UNIT 302H

